

**FOR REVIEW ONLY**

First Harley Knox

DPR 20-00014

City of Perris, Riverside County, California

## Preliminary Drainage Study

*Prepared for:*

First Industrial Realty Trust

898 N. Sepulveda Boulevard, Suite 175

El Segundo, CA 90245

*Prepared By:*



3788 McCray Street

Riverside, CA 92506

Original Date Prepared: August 2021

Revision Date(s):



---

Scott Hildebrandt, P.E.  
Senior Engineer



[www.webbassociates.com](http://www.webbassociates.com)

## TABLE OF CONTENTS

<b>SECTION 1 - SUMMARY</b> .....	<b>1-1</b>
PURPOSE .....	1-1
DESCRIPTION OF WATERSHED .....	1-1
PROPOSED CONDITIONS .....	1-1
METHODOLOGY .....	1-2
FIG. 1 VICINITY MAP	
FIG. 2 USGS TOPOGRAPHY MAP	
FIG. 3 AERIAL PHOTOGRAPH	
FIG. 4 RECEIVING WATERBODIES	
FIG. 5 SOILS MAP	
<b>SECTION 2 - HYDROLOGY ANALYSIS</b> .....	<b>2-1</b>
HYDROLOGY PARAMETERS .....	2-1
ON-SITE RATIONAL METHOD HYDROLOGY .....	2-1
<b>SECTION 3 - HYDRAULIC ANALYSIS</b> .....	<b>3-1</b>
ON-SITE STORM DRAIN FACILITIES .....	3-1
OFF-SITE STORM DRAIN FACILITIES .....	3-1
<b>SECTION 4 - CONCLUSION</b> .....	<b>4-1</b>
<b>APPENDIX A - HYDROLOGY</b> .....	<b>A</b>
HYDROLOGIC SOILS GROUP MAP (PLATE C-1.30)	
ISOHYETAL MAPS	
10-YEAR ONSITE HYDROLOGY (RATIONAL METHOD)	
100-YEAR ONSITE HYDROLOGY (RATIONAL METHOD)	
HYDROLOGY MAPS	
<b>APPENDIX B - HYDRAULICS</b> .....	<b>B</b>
HYDRAULIC CALCULATIONS	
INLET AND CATCH BASIN CALCULATIONS	
<b>APPENDIX C - REFERENCES</b> .....	<b>C</b>
PERRIS VALLEY MDP LAT D-3A PLANS	

## SECTION 1 - SUMMARY

### PURPOSE

The purpose of this report is to document the hydrologic and hydraulic analyses performed in support of the First Harley Knox logistics project located in the City of Perris, County of Riverside, California. The project site is located at the northwest corner of Harley Knox Boulevard and Redlands Ave. The project is bounded by Oleander Ave to the north, existing light industrial complex to the west, Harley Knox Boulevard to the south, and the Redlands Avenue to the east. The project proposes to build an industrial warehouse on approximately 9.5 acres. This report will summarize the hydrologic and hydraulic analyses that were conducted in order to determine the necessary drainage improvements required to provide flood protection for the proposed building and safely convey the runoff through the site.

The scope of this report will include the following:

- Determine the peak 100-year and 10-year flow rates for the developed condition using the Riverside County Flood Control and Water Conservation District (RCFC&WCD) Rational Method.
- Determine the required storm drain facilities, alignment, and sizes required to flood protect the project site.
- Determine the necessary underground storage area and volume required for water quality treatment and to mitigate for increases in runoff.
- Preparation of a preliminary report summarizing the hydrology and hydraulic results.

### DESCRIPTION OF WATERSHED

The project is proposing an industrial warehouse (approximately 158,550square feet) on approximately 9.5 acres of vacant land. Existing elevations across the site vary from 1459 at the northwest corner to 1458 at the southeast corner (NAVD88 Datum). The site currently slopes down at approximately 0.3% to the southeast corner. The existing drainage pattern for the site and the general area is characterized by sheet flow that currently flows to Harley Knox Boulevard. Flows are captured by an existing catch basin located on the north side of Harley Knox Boulevard and then conveyed within the existing Lat D-3A-4 towards the Perris Valley Storm Drain Channel.

### PROPOSED CONDITIONS

The project site is not impacted by off-site flows as there are existing streets around the perimeter of the project that convey any offsite flow away from the site. The balanced earthwork does not allow for conventional gravity storm drains due to lack of drop across the site from the south to the north. In order to convey on-site flows, the project will utilize subsurface storm drain to discharge into underground storage chambers. The chambers are located at the east side of the auto parking stalls along Redlands Avenue and they are sized to hold only the water quality design capture volume for the project. Large flows will be forced out of the chambers at an outlet above the chamber soffit and gravity flow to the existing 48" storm drain line (Lat D-3A) at Harley Knox Boulevard. Water quality runoff will be pumped from the chambers into a Contech Filterra unit.

## METHODOLOGY

### HYDROLOGY

Hydrologic calculations were performed in accordance with the RCFC&WCD Hydrology Manual, dated April 1978. The Rational Method was utilized in determining peak flow rates.

The hydrological parameters, including rainfall values and soil types were derived from the RCFC&WCD Hydrology Manual. The isohyetal maps and soil map have been included in Section 2.

Rational Method calculations were performed using a computer program developed by CivilDesign Corporation and Joseph E. Bonadiman and Associates Inc. The computer program is commonly referred to as CivilD which incorporates the hydrological parameters outlined in the RCFC&WCD Hydrology Manual.

The Rational Method was used to determine the peak flow rates to size and design the drainage facilities need to convey onsite flows through the site to the proposed basin. The flow rates were computed by generating a hydrologic “link-node” model in which the overall area is divided into separate drainage sub-areas, each tributary to a concentration point (node) determined by the proposed layout and grading.

The Unit Hydrograph Method was used to determine the peak flow rates and volumes associated with the 100-year storm events for the site. Calculations were performed for both the existing condition and developed condition to be used in the analysis of the proposed basin. See Section 2 for additional information and results regarding the hydrologic analyses performed for this project.

### HYDRAULICS

Water quality basin calculations were performed using spreadsheets that were created by RCFC&WCD. preliminary calculations and additional details can be found in the preliminary-WQMP.

Basin routing calculations were performed using the CivilD computer program. The CivilD program utilizes the Modified-Puls methodology to routes unit hydrographs through a basin using the stage-storage and stage-discharge curves determined from the proposed basin design. See Section 3 for additional discussion and results.

Hydraulic calculations to determine the required pipe sizes of the proposed onsite storm drain facilities will be provided in the Final Drainage Study.

**FIG. 1 VICINITY MAP**

**FIG. 2 USGS TOPOGRAPHY MAP**

**FIG. 3 AERIAL PHOTOGRAPH**

**FIG. 4 RECEIVING WATERBODIES**

**FIG. 5 SOILS MAP**



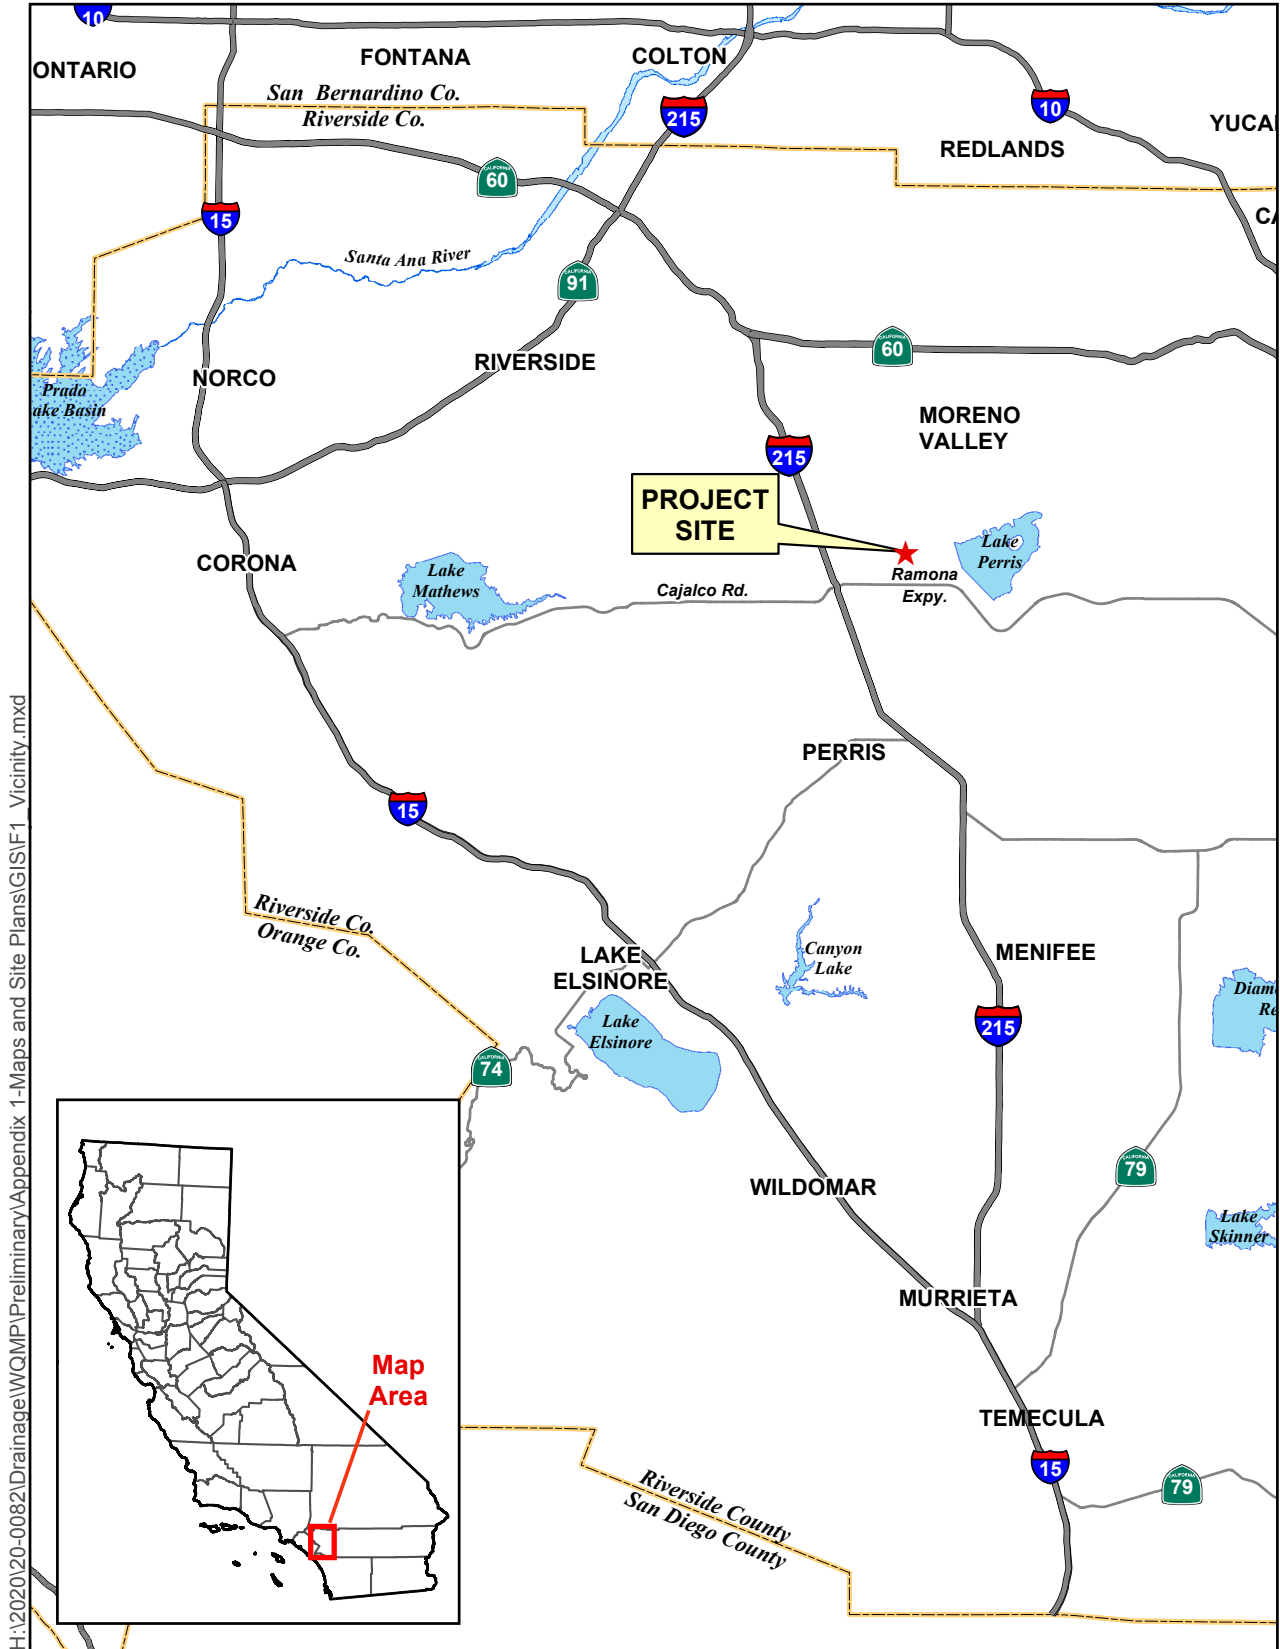


Figure 1. Vicinity Map

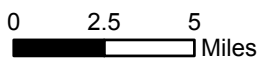


H:\2020\20-0082\Drainage\WQMP\Preliminary\Appendix 1-Maps and Site Plans\GIS\F2\_USGS.mxd

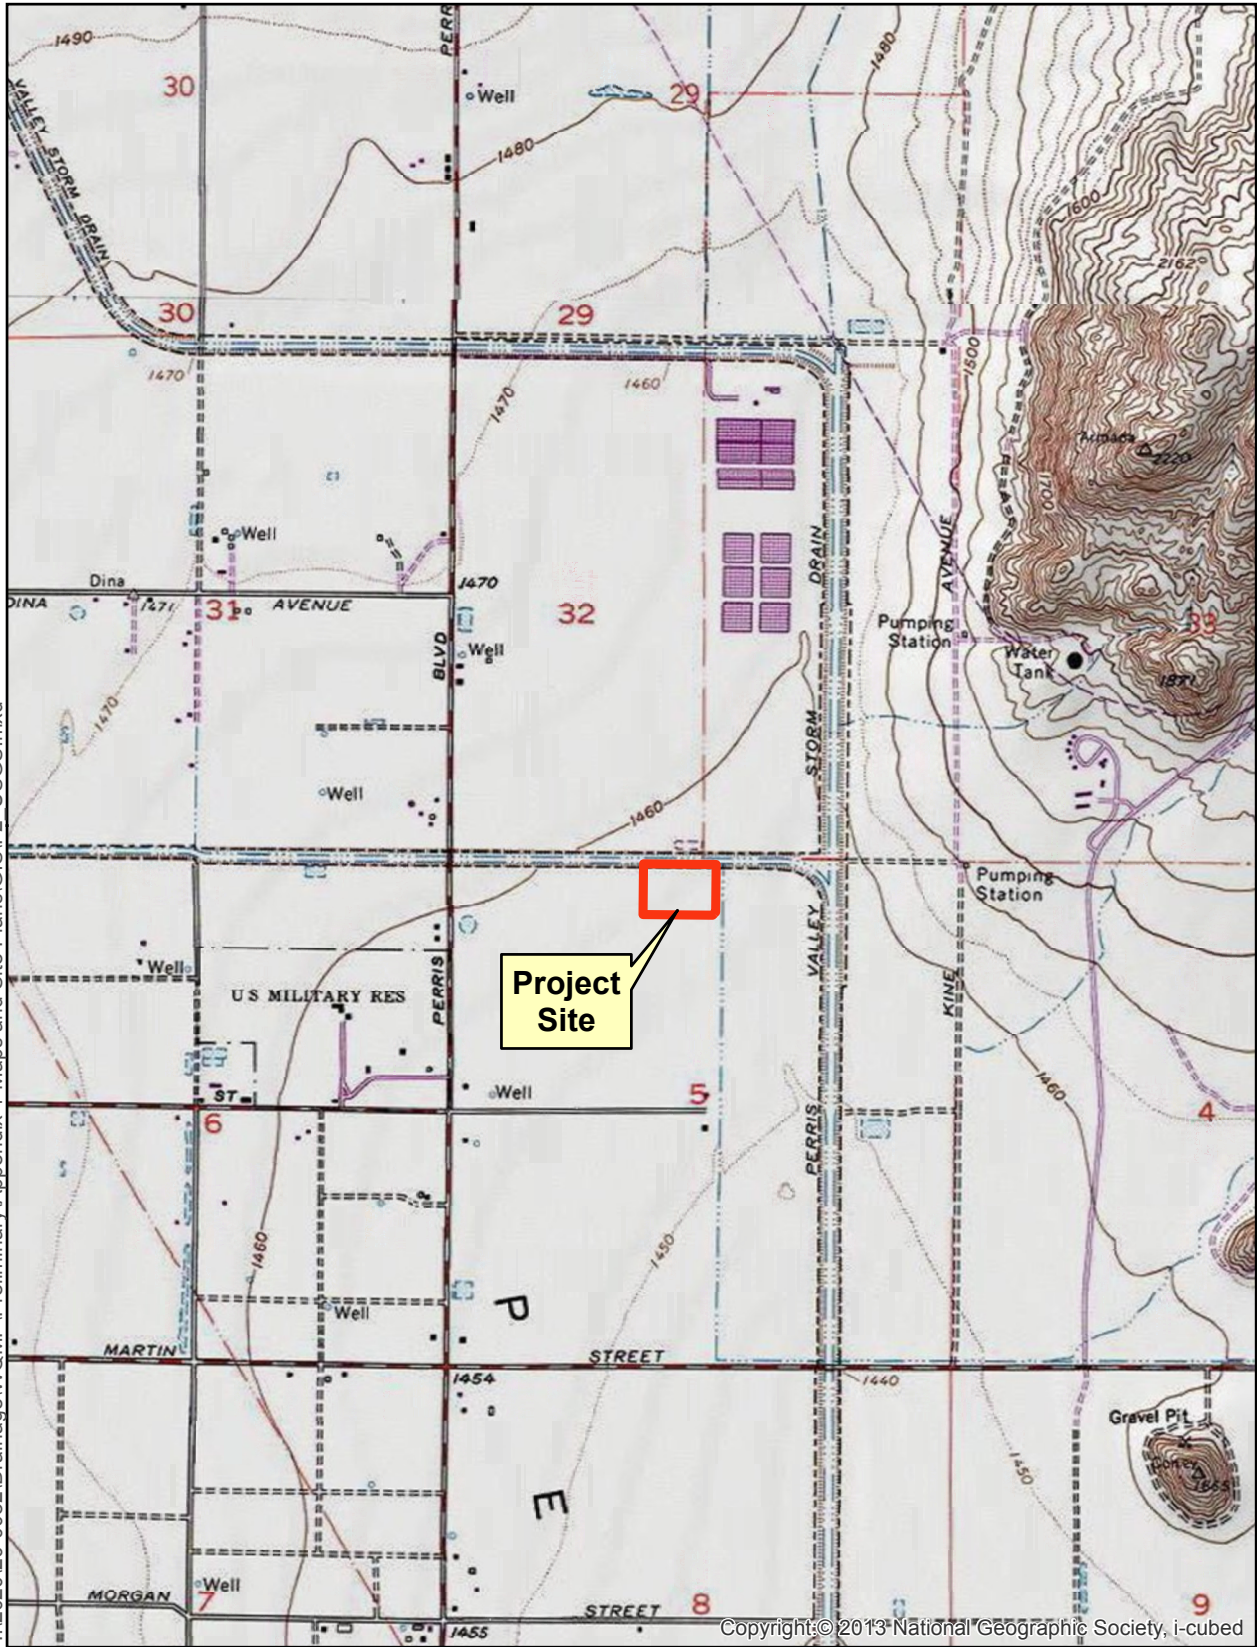

Copyright © 2013 National Geographic Society, i-cubed

Sources: ESRI / USGS 7.5min Quad  
DRGs: PERRIS

Figure 2. USGS Topography Map

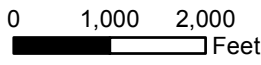

H:\2020\20-0082\Drainage\WQMP\Preliminary\Appendix 1-Maps and Site Plans\GIS\F3 Aerial.mxd




Sources: County of Riverside GIS, 2016

Figure 3. Aerial Photograph

0 400 800  
Feet





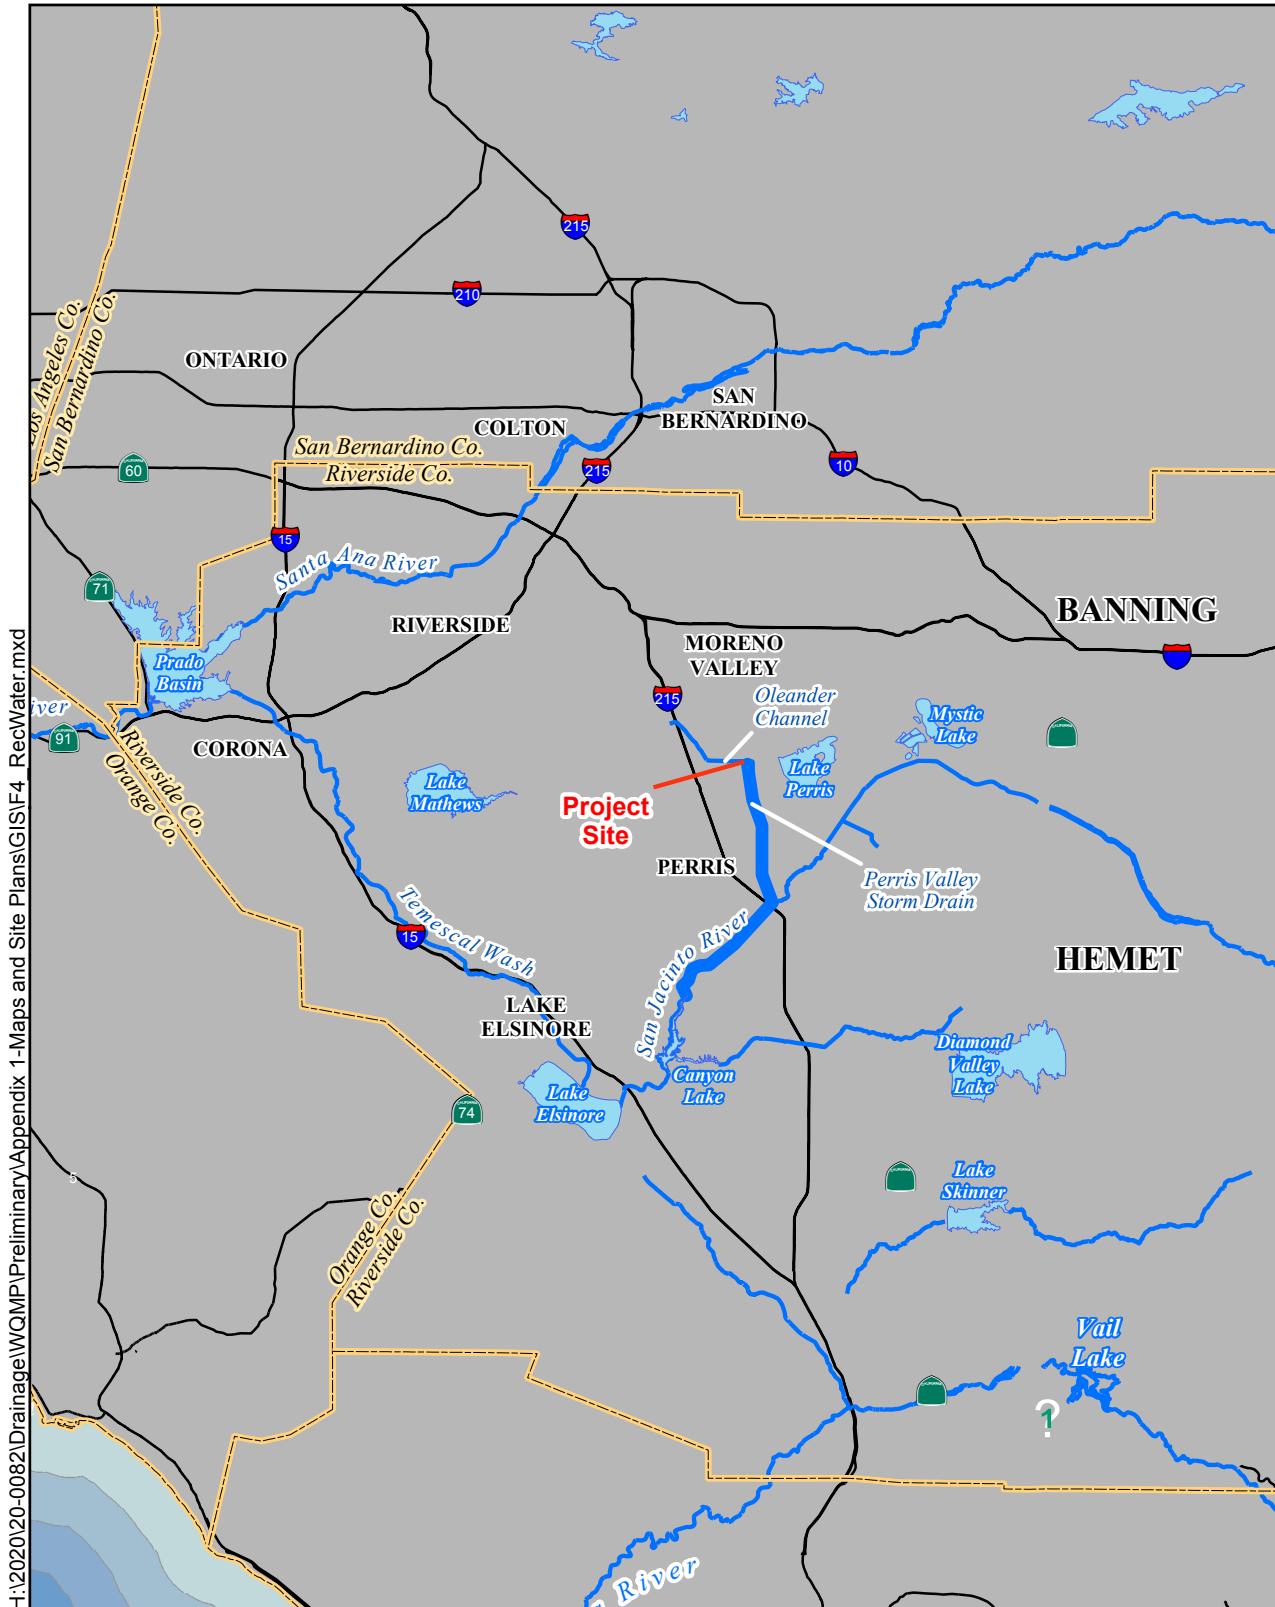

H:\2020\20-0082\Drainage\WQMP\Preliminary\Appendix 1-Maps and Site Plans\GIS\F4\_RecWater.mxd

Sources: USGS 30 Meter DEM;  
USGS Digital Line Graph

**Figure 4. Receiving Waterbodies**

0 2 4 6  
Miles



Flowpath


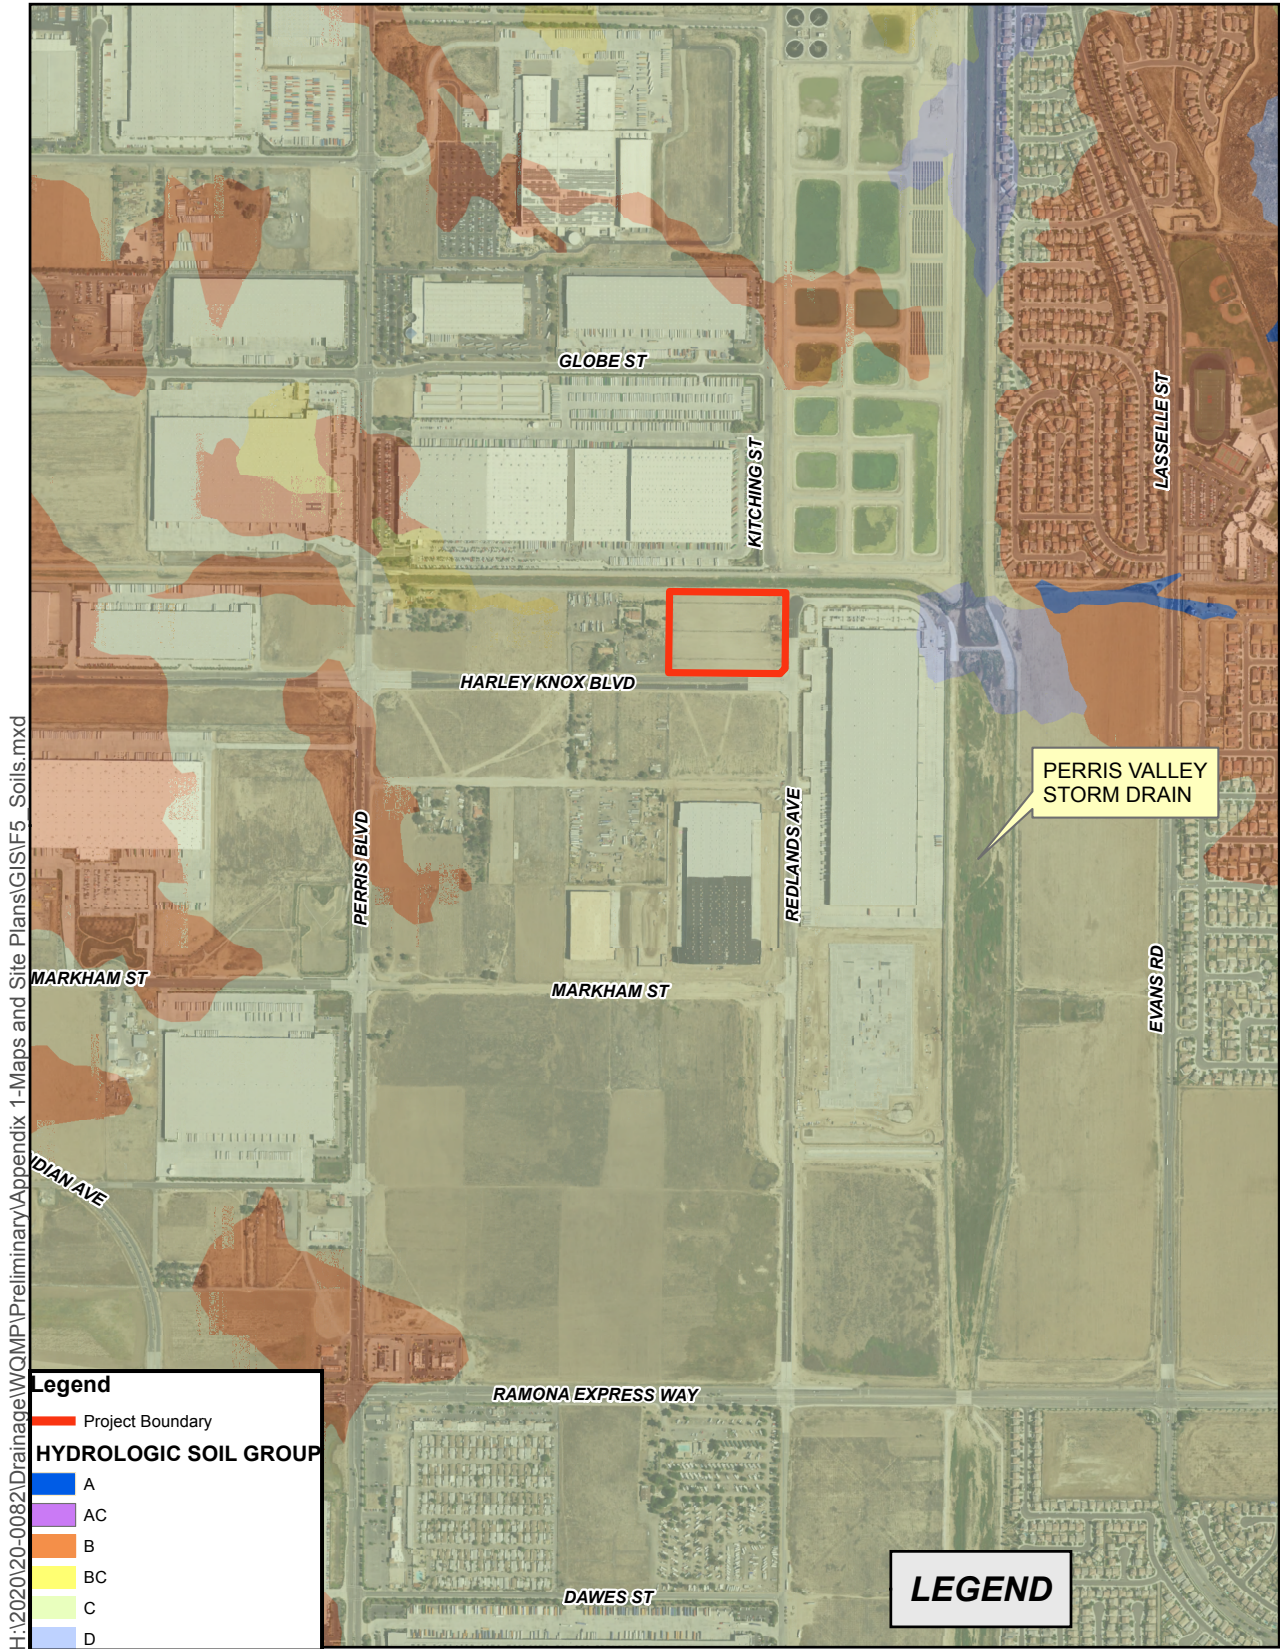


Figure 5. Soils Map

0 500 1,000 Feet

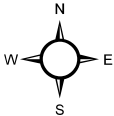

## SECTION 2 - HYDROLOGY ANALYSIS

### HYDROLOGY PARAMETERS

The RCFC&WCD Hydrology Manual was used to determine several of the hydrological parameters. The following rainfall depths were utilized in the hydrology analyses, which were obtained from the isohyetal maps provided in the RCFC&WCD Hydrology Manual:

Table 1 - Precipitation Values

	Duration
Storm Event	1-Hour (inches)
10-Year	0.78
100-Year	1.12

The value for slope of intensity was determined to be 0.49. The isohyetal maps have been included in Appendix A.

Based on the Plate C-1.30 (Perris) in the RCFC&WCD Hydrology Manual, the project site is classified as soil type C. The soils map is included in Appendix A.

The residential\commercial landscaping cover type was used to represent the developed condition. Table 2 below summarizes the runoff index values and the recommended values for percentage of impervious cover for each category:

Table 2 - Cover Type

Cover Type	Soil Group A	Soil Group B	Soil Group C	Soil Group D	Percentage of Impervious Cover
Commercial Landscaping	32	56	69	75	90%

### ON-SITE RATIONAL METHOD HYDROLOGY

The rational method was used to determine peak flow rates in order to adequately size the proposed subsurface storm drains and associated inlets used to convey on-site flows to the proposed underground storage chambers. The project site was separated into four subareas. Subarea 1 (5.6 acres) is essentially the northerly half of the site and is tributary to inlet 102. Subarea 2 (0.9 acres) is the northernly half of the eastern parking area and is tributary to inlet 202. Subarea 3 (0.3 acres) is the southernly half of the eastern parking area and is tributary to inlet 302. Subarea 4 (2.4 acres) is the southerly half of the site and is tributary to inlet 402. The project is comprised of approximately 15% pervious cover (landscaping). The project was modeled as commercial land use which assumes a 10% pervious cover which is slightly more conservative than what is proposed. As previously described, the underground storage chambers will utilize an outlet structure where high flow will gravity feed to the existing Lat D-3A line located in

Harley Knox Boulevard. Low flows from the underground storage chambers will discharge to a Contech Filterra unit for water quality treatment.

The rational method was used to determine peak flow rates in order to adequately size the proposed subsurface storm drains and associated inlets used to convey on-site flows through the site and into the existing Lat D-3A storm drain. The project site area was divided into 4 subareas.

Area-1 (approximately 5.6 acres) surface flows into a trench drain along the truck docking stalls. A 100-year peak flow of 14.3 cfs is generated by this subarea. The runoff will be conveyed around the building towards Area-2 using Line-A.

Area-2 (approximately 0.9 acres) surface flows into 1 low point on the east side of the project. A 100-year peak flow of 2.3 cfs is generated by this subarea. The runoff will be conveyed towards the underground storage chambers using Lat A-1.

Area-3 (approximately 0.3 acres) surface flows into 1 low point on the east side of the project. A 100-year peak flow of 1.0 cfs is generated by this subarea. The runoff will be conveyed towards the underground storage chambers using Lat A-2.

Area-4 (approximately 2.4 acres) surface flows into several low points on the south side of the project. A 100-year peak flow of 8.0 cfs is generated by this subarea. The runoff will be conveyed towards the underground storage chambers using Line-B.

A peak 100 year flow rate of 23.7 cfs is generated by the site, including the off-site areas and underground storage area. An emergency escape route will be provided capable of bypassing the peak 100 year flow rate.

The following table summarizes the rational method results at key points:

**Table 3 – Rational Method Results**

Point of Interest	10-Year Peak Flow Rate (cfs)	100-Year Peak Flow Rate (cfs)
Node 102 - Flow tributary to proposed inlet and Line A	9.9	14.3
Node 103 - Total Flow tributary to line A	16.4	23.7
Node 202 - Flow tributary to proposed inlet and Lat A-1	1.6	2.3
Node 203 - Total Flow tributary to Lat A-1	16.4	23.7
Node 302 - Flow tributary to proposed inlet and Lat A-2	0.7	1.0
Node 303 - Total Flow tributary to Lat A-2	16.4	23.7
Node 402 - Flow tributary to proposed inlet and Line B	5.8	8.0
Node 403 - Total Flow tributary to Line B	16.4	23.7

The rational method output files and hydrology map have been included in Appendix A.

## SECTION 3 - HYDRAULIC ANALYSIS

### ON-SITE STORM DRAIN FACILITIES

The project proposes minimal subsurface storm drain and will utilize curb and gutter and ribbon gutters to convey onsite high flows to the proposed underground storage chamber. The proposed underground storage chambers will receive the runoff generated by 9.5 acres of the site primarily on the easterly side of the site for water quality treatment.

The project proposes one subsurface storm drain system to convey on-site flows. The runoff will discharge into the underground storage chambers. The discharge from the underground storage chambers will be conveyed to a pump facility where it will outflow for water quality purposes. High flows discharged from the underground storage chambers will gravity flow to the existing Line D-3A located in Harley Knox Boulevard.

A brief summary of each system has been provided and the results of the hydraulic analyses are included at the end of the section. The peak flow rates determined during the 100-year rational method on-site hydrology analysis were utilized to evaluate the proposed storm drain systems.

#### Line-A (Onsite)

The north portion of the project site will surface flow to a trench drain along the truck docking stalls and be collected by Line A-1, a 24" HDPE pipe. Line-A proposes to convey the 100-year peak flow rate to the underground storage chamber. A hydraulic model for Line A-1 will be provided during final engineering to further assess the storm drain design.

#### Line-B (Onsite)

The south portion of the project site will surface flow to several low points in the south side landscaping area and be collected by Line B-1, a 24" HDPE pipe. Line-B proposes to convey the 100-year peak flow rate to the underground storage chamber. A hydraulic model for Line B-1 will be provided during final engineering to further assess the storm drain design.

### OFF-SITE STORM DRAIN FACILITIES

As part of this project, the only offsite improvements proposed for Harley Knox Blvd include the construction of a driveway and sidewalk along the project frontage. There is an existing low point (Lat D-3A-4), within Harley Knox Boulevard. A 30" RCP offsite storm drain connection is proposed to convey all collected, onsite flows towards the existing 48" RCP lateral D-3A located along Harley Knox Boulevard. A peak flow rate of 21.1 cfs is expected per the rational method analysis (See Section 2 and Appendix A for more detail).

## SECTION 4 - CONCLUSION

Based on the analyses and results of this report, the following conclusions were derived from the hydrology and hydraulic results:

- The proposed drainage improvements will adequately convey flows to the underground storage chambers and provide flood protection for the 100-year storm event.
- The proposed Contech Filterra unit will provide adequate water quality treatment.
- The proposed project will not impact flooding condition to upstream or downstream properties.


## **APPENDIX A – HYDROLOGY**

---

**HYDROLOGIC SOILS GROUP MAP (PLATE C-1.30)**

---



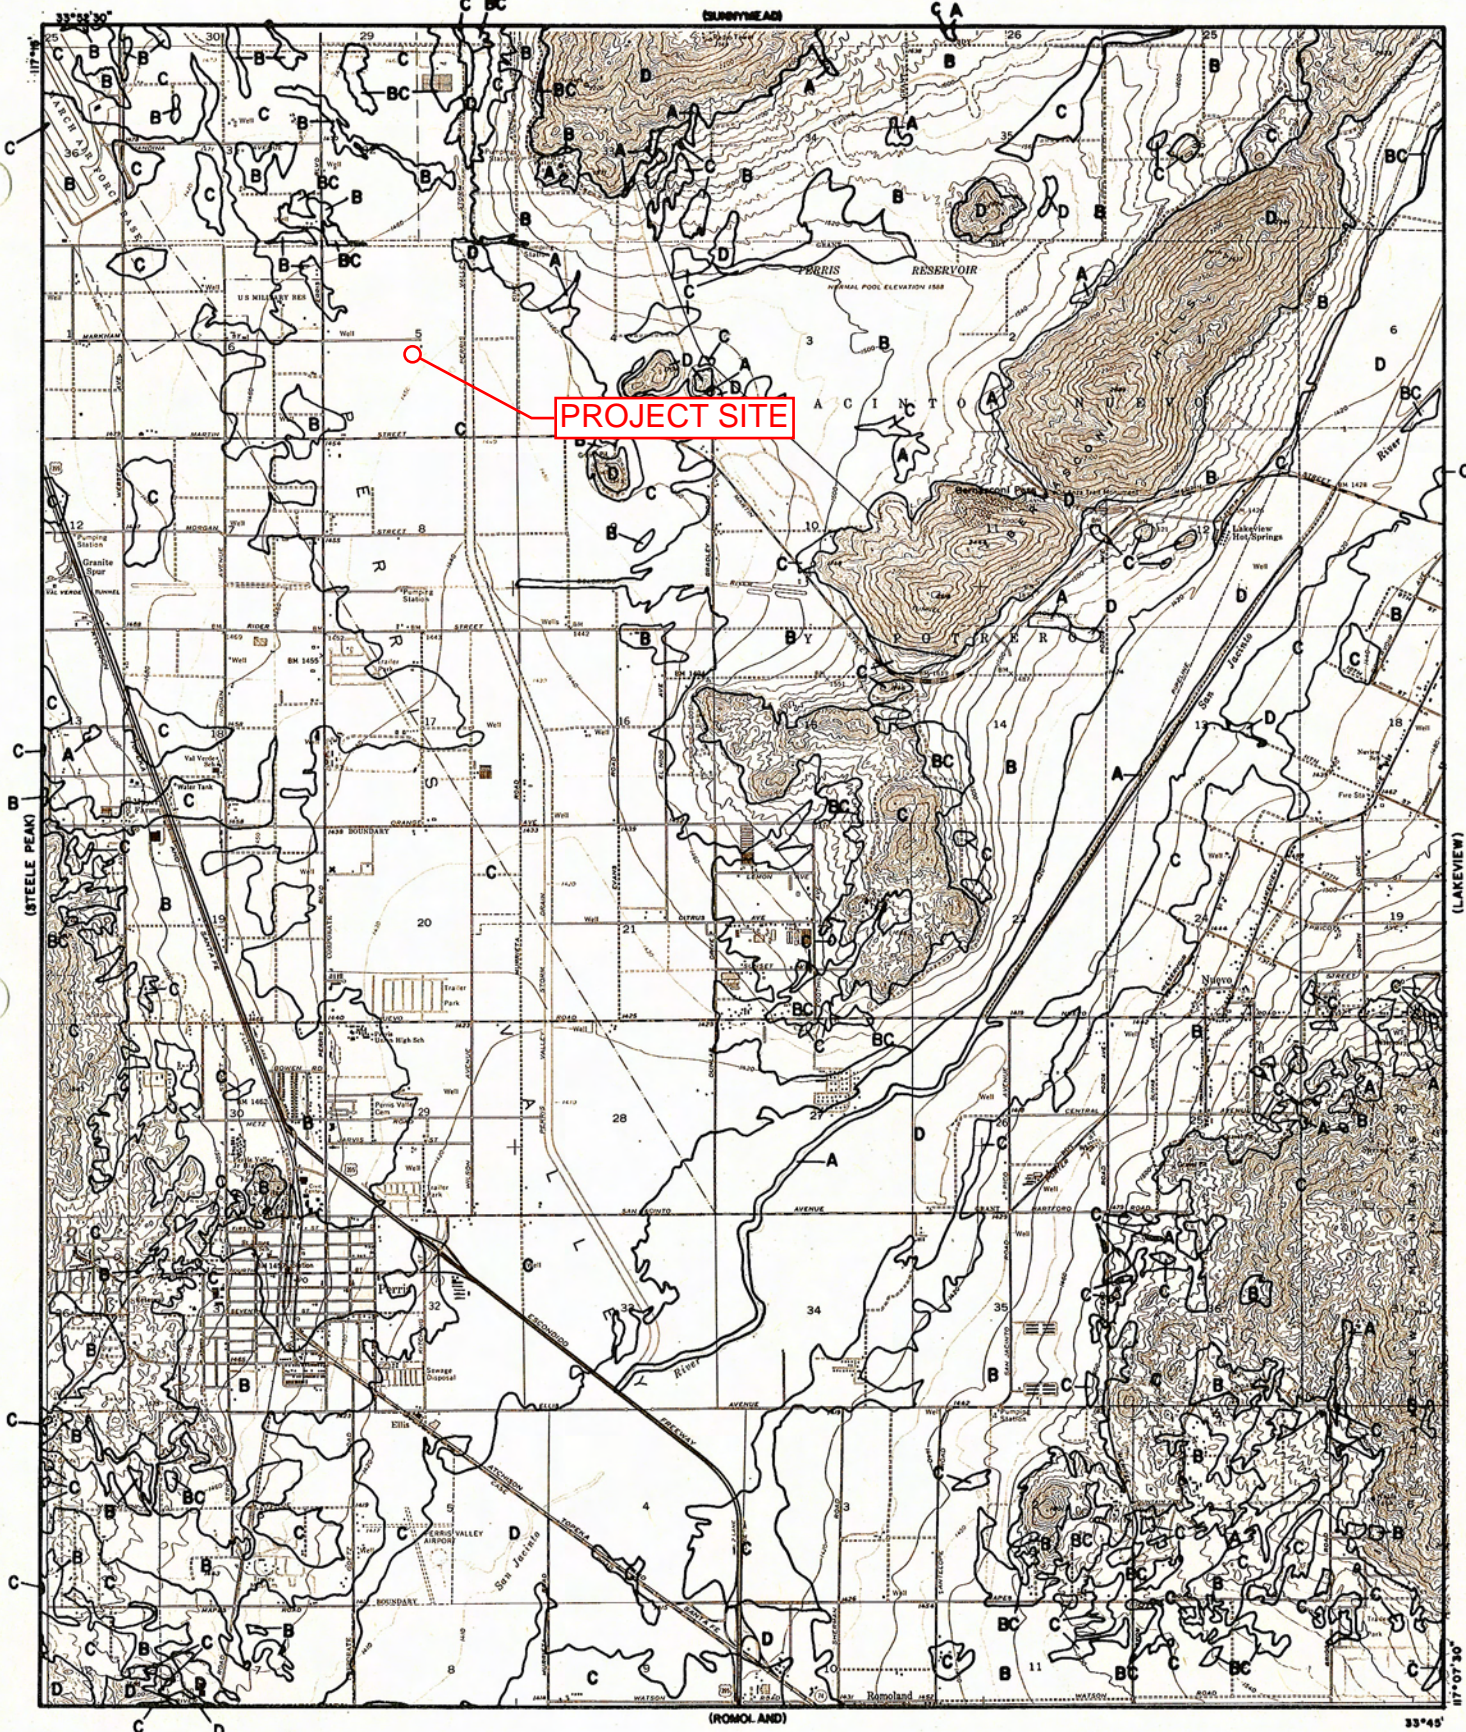

**LEGEND**

— SOILS GROUP BOUNDARY  
 A SOILS GROUP DESIGNATION

**RCFC & WCD**  
 HYDROLOGY MANUAL

**HYDROLOGIC SOILS GROUP MAP  
 FOR  
 PERRIS**

**ISOHYETAL MAPS**

---

# RAINFALL INTENSITY—INCHES PER HOUR

**RCFC & WCD**  
 HYDROLOGY MANUAL

STANDARD  
 INTENSITY - DURATION  
 CURVES DATA

MIRA LOMA			MURRIETA - TEMECULA & RANCHO CALIFORNIA			NORCO			PALM SPRINGS			PERRIS VALLEY		
DURATION MINUTES	FREQUENCY		DURATION MINUTES	FREQUENCY		DURATION MINUTES	FREQUENCY		DURATION MINUTES	FREQUENCY		DURATION MINUTES	FREQUENCY	
	10 YEAR	100 YEAR		10 YEAR	100 YEAR		10 YEAR	100 YEAR		10 YEAR	100 YEAR		10 YEAR	100 YEAR
5	2.84	4.48	5	3.45	5.10	5	2.77	4.16	5	4.23	6.76	5	2.64	3.78
6	2.58	4.07	6	3.12	4.61	6	2.53	3.79	6	3.80	6.08	6	2.41	3.46
7	2.37	3.75	7	2.87	4.24	7	2.34	3.51	7	3.48	5.56	7	2.24	3.21
8	2.21	3.49	8	2.67	3.94	8	2.19	3.29	8	3.22	5.15	8	2.09	3.01
9	2.08	3.28	9	2.50	3.69	9	2.07	3.10	9	3.01	4.81	9	1.98	2.84
10	1.96	3.10	10	2.36	3.48	10	1.96	2.94	10	2.83	4.52	10	1.88	2.69
11	1.87	2.95	11	2.24	3.30	11	1.87	2.80	11	2.67	4.28	11	1.79	2.57
12	1.78	2.82	12	2.13	3.15	12	1.79	2.68	12	2.54	4.07	12	1.72	2.46
13	1.71	2.70	13	2.04	3.01	13	1.72	2.58	13	2.43	3.88	13	1.65	2.37
14	1.64	2.60	14	1.96	2.89	14	1.66	2.48	14	2.33	3.72	14	1.59	2.29
15	1.58	2.50	15	1.89	2.79	15	1.60	2.40	15	2.23	3.58	15	1.54	2.21
16	1.53	2.42	16	1.82	2.69	16	1.55	2.32	16	2.15	3.44	16	1.49	2.14
17	1.48	2.34	17	1.76	2.60	17	1.50	2.25	17	2.08	3.32	17	1.45	2.08
18	1.44	2.27	18	1.71	2.52	18	1.46	2.19	18	2.01	3.22	18	1.41	2.02
19	1.40	2.21	19	1.66	2.45	19	1.42	2.13	19	1.95	3.12	19	1.37	1.97
20	1.36	2.15	20	1.61	2.38	20	1.39	2.08	20	1.89	3.03	20	1.34	1.92
22	1.29	2.04	22	1.53	2.26	22	1.32	1.98	22	1.79	2.86	22	1.28	1.83
24	1.24	1.95	24	1.46	2.15	24	1.26	1.90	24	1.70	2.72	24	1.22	1.75
26	1.18	1.87	26	1.39	2.06	26	1.22	1.82	26	1.62	2.60	26	1.18	1.69
28	1.14	1.80	28	1.34	1.98	28	1.17	1.76	28	1.56	2.49	28	1.13	1.63
30	1.10	1.73	30	1.29	1.90	30	1.13	1.70	30	1.49	2.39	30	1.10	1.57
32	1.06	1.67	32	1.24	1.84	32	1.10	1.64	32	1.44	2.30	32	1.06	1.52
34	1.03	1.62	34	1.20	1.78	34	1.06	1.59	34	1.39	2.22	34	1.03	1.48
36	1.00	1.57	36	1.17	1.72	36	1.03	1.55	36	1.34	2.15	36	1.00	1.44
38	.97	1.53	38	1.13	1.67	38	1.01	1.51	38	1.30	2.09	38	.98	1.40
40	.94	1.49	40	1.10	1.62	40	.98	1.47	40	1.27	2.02	40	.95	1.37
45	.89	1.40	45	1.03	1.52	45	.92	1.39	45	1.18	1.89	45	.90	1.29
50	.84	1.32	50	.97	1.44	50	.88	1.31	50	1.11	1.78	50	.85	1.22
55	.80	1.26	55	.92	1.36	55	.84	1.25	55	1.05	1.68	55	.81	1.17
60	.76	1.20	60	.88	1.30	60	.80	1.20	60	1.00	1.60	60	.78	1.12
65	.73	1.15	65	.84	1.24	65	.77	1.15	65	.95	1.53	65	.75	1.08
70	.70	1.11	70	.81	1.19	70	.74	1.11	70	.91	1.46	70	.72	1.04
75	.68	1.07	75	.78	1.15	75	.72	1.07	75	.88	1.41	75	.70	1.00
80	.65	1.03	80	.75	1.11	80	.69	1.04	80	.85	1.35	80	.68	.97
85	.63	1.00	85	.73	1.07	85	.67	1.01	85	.82	1.31	85	.66	.94
SLOPE = .530			SLOPE = .550			SLOPE = .500			SLOPE = .580			SLOPE = .490		

**10-YEAR ONSITE HYDROLOGY (RATIONAL METHOD)**

---

Riverside County Rational Hydrology Program

CIVILCADD/CIVILDESIGN Engineering Software,(c) 1989 - 2004 Version 7.0  
Rational Hydrology Study Date: 08/12/21 File:prop10.out

-----  
20-0082 - FIR HK  
ONSITE RATIONAL METHOD HYDROLOGY  
10 YEAR STORM EVENT  
FN: PROP10.OUT RC  
-----

\*\*\*\*\* Hydrology Study Control Information \*\*\*\*\*

English (in-lb) Units used in input data file  
-----

Program License Serial Number 4010  
-----

Rational Method Hydrology Program based on  
Riverside County Flood Control & Water Conservation District  
1978 hydrology manual

Storm event (year) = 10.00 Antecedent Moisture Condition = 2

Standard intensity-duration curves data (Plate D-4.1)

For the [ Perris Valley ] area used.

10 year storm 10 minute intensity = 1.880(In/Hr)

10 year storm 60 minute intensity = 0.780(In/Hr)

100 year storm 10 minute intensity = 2.690(In/Hr)

100 year storm 60 minute intensity = 1.120(In/Hr)

Storm event year = 10.0

Calculated rainfall intensity data:

1 hour intensity = 0.780(In/Hr)

Slope of intensity duration curve = 0.4900

++++  
Process from Point/Station 101.000 to Point/Station 102.000  
\*\*\*\* INITIAL AREA EVALUATION \*\*\*\*

-----  
Initial area flow distance = 363.000(Ft.)

Top (of initial area) elevation = 1459.100(Ft.)

Bottom (of initial area) elevation = 1456.800(Ft.)

Difference in elevation = 2.300(Ft.)  
Slope = 0.00634 s(percent)= 0.63  
TC =  $k(0.300)*[(\text{length}^3)/(\text{elevation change})]^{0.2}$   
Initial area time of concentration = 8.724 min.  
Rainfall intensity = 2.006(In/Hr) for a 10.0 year storm  
COMMERCIAL subarea type  
Runoff Coefficient = 0.879  
Decimal fraction soil group A = 0.000  
Decimal fraction soil group B = 0.000  
Decimal fraction soil group C = 1.000  
Decimal fraction soil group D = 0.000  
RI index for soil(AMC 2) = 69.00  
Pervious area fraction = 0.100; Impervious fraction = 0.900  
Initial subarea runoff = 9.880(CFS)  
Total initial stream area = 5.600(Ac.)  
Pervious area fraction = 0.100

++++  
Process from Point/Station 102.000 to Point/Station 103.000  
\*\*\*\* PIPEFLOW TRAVEL TIME (Program estimated size) \*\*\*\*

---

Upstream point/station elevation = 1451.900(Ft.)  
Downstream point/station elevation = 1450.300(Ft.)  
Pipe length = 512.00(Ft.) Manning's N = 0.012  
No. of pipes = 1 Required pipe flow = 9.880(CFS)  
Nearest computed pipe diameter = 21.00(In.)  
Calculated individual pipe flow = 9.880(CFS)  
Normal flow depth in pipe = 17.81(In.)  
Flow top width inside pipe = 15.07(In.)  
Critical Depth = 14.04(In.)  
Pipe flow velocity = 4.54(Ft/s)  
Travel time through pipe = 1.88 min.  
Time of concentration (TC) = 10.60 min.

++++  
Process from Point/Station 102.000 to Point/Station 103.000  
\*\*\*\* CONFLUENCE OF MINOR STREAMS \*\*\*\*

---

Along Main Stream number: 1 in normal stream number 1  
Stream flow area = 5.600(Ac.)  
Runoff from this stream = 9.880(CFS)  
Time of concentration = 10.60 min.  
Rainfall intensity = 1.823(In/Hr)

++++  
Process from Point/Station 201.000 to Point/Station 202.000  
\*\*\*\* INITIAL AREA EVALUATION \*\*\*\*

---

Initial area flow distance = 395.000(Ft.)  
Top (of initial area) elevation = 1460.100(Ft.)  
Bottom (of initial area) elevation = 1457.400(Ft.)  
Difference in elevation = 2.700(Ft.)  
Slope = 0.00684 s(percent)= 0.68  
TC =  $k(0.300)*[(\text{length}^3)/(\text{elevation change})]^{0.2}$   
Initial area time of concentration = 8.888 min.  
Rainfall intensity = 1.988(In/Hr) for a 10.0 year storm  
COMMERCIAL subarea type  
Runoff Coefficient = 0.879  
Decimal fraction soil group A = 0.000  
Decimal fraction soil group B = 0.000  
Decimal fraction soil group C = 1.000  
Decimal fraction soil group D = 0.000  
RI index for soil(AMC 2) = 69.00  
Pervious area fraction = 0.100; Impervious fraction = 0.900  
Initial subarea runoff = 1.573(CFS)  
Total initial stream area = 0.900(Ac.)  
Pervious area fraction = 0.100

++++  
Process from Point/Station 202.000 to Point/Station 203.000  
\*\*\*\* PIPEFLOW TRAVEL TIME (Program estimated size) \*\*\*\*

---

Upstream point/station elevation = 1451.800(Ft.)  
Downstream point/station elevation = 1451.500(Ft.)  
Pipe length = 29.00(Ft.) Manning's N = 0.012  
No. of pipes = 1 Required pipe flow = 1.573(CFS)  
Nearest computed pipe diameter = 9.00(In.)  
Calculated individual pipe flow = 1.573(CFS)  
Normal flow depth in pipe = 6.45(In.)  
Flow top width inside pipe = 8.11(In.)  
Critical Depth = 6.93(In.)  
Pipe flow velocity = 4.64(Ft/s)  
Travel time through pipe = 0.10 min.  
Time of concentration (TC) = 8.99 min.

++++  
Process from Point/Station 202.000 to Point/Station 203.000  
\*\*\*\* CONFLUENCE OF MINOR STREAMS \*\*\*\*

---

Along Main Stream number: 1 in normal stream number 2  
Stream flow area = 0.900(Ac.)  
Runoff from this stream = 1.573(CFS)  
Time of concentration = 8.99 min.  
Rainfall intensity = 1.977(In/Hr)

++++  
Process from Point/Station 301.000 to Point/Station 302.000  
\*\*\*\* INITIAL AREA EVALUATION \*\*\*\*

---

Initial area flow distance = 120.000(Ft.)  
Top (of initial area) elevation = 1461.000(Ft.)  
Bottom (of initial area) elevation = 1458.600(Ft.)  
Difference in elevation = 2.400(Ft.)  
Slope = 0.02000 s(percent)= 2.00  
TC =  $k(0.300)*[(\text{length}^3)/(\text{elevation change})]^{0.2}$   
Warning: TC computed to be less than 5 min.; program is assuming the  
time of concentration is 5 minutes.  
Initial area time of concentration = 5.000 min.  
Rainfall intensity = 2.636(In/Hr) for a 10.0 year storm  
COMMERCIAL subarea type  
Runoff Coefficient = 0.883  
Decimal fraction soil group A = 0.000  
Decimal fraction soil group B = 0.000  
Decimal fraction soil group C = 1.000  
Decimal fraction soil group D = 0.000  
RI index for soil(AMC 2) = 69.00  
Pervious area fraction = 0.100; Impervious fraction = 0.900  
Initial subarea runoff = 0.698(CFS)  
Total initial stream area = 0.300(Ac.)  
Pervious area fraction = 0.100

++++  
Process from Point/Station 302.000 to Point/Station 303.000  
\*\*\*\* PIPEFLOW TRAVEL TIME (Program estimated size) \*\*\*\*

---

Upstream point/station elevation = 1451.800(Ft.)  
Downstream point/station elevation = 1451.500(Ft.)  
Pipe length = 41.00(Ft.) Manning's N = 0.012  
No. of pipes = 1 Required pipe flow = 0.698(CFS)  
Nearest computed pipe diameter = 9.00(In.)  
Calculated individual pipe flow = 0.698(CFS)  
Normal flow depth in pipe = 4.27(In.)  
Flow top width inside pipe = 8.99(In.)  
Critical Depth = 4.56(In.)  
Pipe flow velocity = 3.39(Ft/s)  
Travel time through pipe = 0.20 min.  
Time of concentration (TC) = 5.20 min.

++++  
Process from Point/Station 302.000 to Point/Station 303.000  
\*\*\*\* CONFLUENCE OF MINOR STREAMS \*\*\*\*

---



Along Main Stream number: 1 in normal stream number 3  
Stream flow area = 0.300(Ac.)  
Runoff from this stream = 0.698(CFS)  
Time of concentration = 5.20 min.  
Rainfall intensity = 2.585(In/Hr)

++++  
Process from Point/Station 401.000 to Point/Station 402.000  
\*\*\*\* INITIAL AREA EVALUATION \*\*\*\*

---

Initial area flow distance = 171.000(Ft.)  
Top (of initial area) elevation = 1462.100(Ft.)  
Bottom (of initial area) elevation = 1458.300(Ft.)  
Difference in elevation = 3.800(Ft.)  
Slope = 0.02222 s(percent)= 2.22  
TC =  $k(0.300)*[(\text{length}^3)/(\text{elevation change})]^{0.2}$   
Initial area time of concentration = 5.023 min.  
Rainfall intensity = 2.630(In/Hr) for a 10.0 year storm  
COMMERCIAL subarea type  
Runoff Coefficient = 0.883  
Decimal fraction soil group A = 0.000  
Decimal fraction soil group B = 0.000  
Decimal fraction soil group C = 1.000  
Decimal fraction soil group D = 0.000  
RI index for soil(AMC 2) = 69.00  
Pervious area fraction = 0.100; Impervious fraction = 0.900  
Initial subarea runoff = 5.575(CFS)  
Total initial stream area = 2.400(Ac.)  
Pervious area fraction = 0.100

++++  
Process from Point/Station 402.000 to Point/Station 403.000  
\*\*\*\* PIPEFLOW TRAVEL TIME (Program estimated size) \*\*\*\*

---

Upstream point/station elevation = 1454.200(Ft.)  
Downstream point/station elevation = 1451.300(Ft.)  
Pipe length = 597.00(Ft.) Manning's N = 0.012  
No. of pipes = 1 Required pipe flow = 5.575(CFS)  
Nearest computed pipe diameter = 18.00(In.)  
Calculated individual pipe flow = 5.575(CFS)  
Normal flow depth in pipe = 11.13(In.)  
Flow top width inside pipe = 17.49(In.)  
Critical Depth = 10.93(In.)  
Pipe flow velocity = 4.86(Ft/s)  
Travel time through pipe = 2.05 min.  
Time of concentration (TC) = 7.07 min.

+++++  
 Process from Point/Station 402.000 to Point/Station 403.000  
 \*\*\*\* CONFLUENCE OF MINOR STREAMS \*\*\*\*

Along Main Stream number: 1 in normal stream number 4  
 Stream flow area = 2.400(Ac.)  
 Runoff from this stream = 5.575(CFS)  
 Time of concentration = 7.07 min.  
 Rainfall intensity = 2.224(In/Hr)  
 Summary of stream data:

Stream No.	Flow rate (CFS)	TC (min)	Rainfall Intensity (In/Hr)
1	9.880	10.60	1.823
2	1.573	8.99	1.977
3	0.698	5.20	2.585
4	5.575	7.07	2.224

Largest stream flow has longer time of concentration

Qp = 9.880 + sum of  

$$\frac{Q_b}{I_a/I_b} = \frac{1.573}{0.922} = 1.451$$
  

$$\frac{Q_b}{I_a/I_b} = \frac{0.698}{0.705} = 0.493$$
  

$$\frac{Q_b}{I_a/I_b} = \frac{5.575}{0.820} = 4.571$$
  
 Qp = 16.394

Total of 4 streams to confluence:  
 Flow rates before confluence point:  
 9.880      1.573      0.698      5.575  
 Area of streams before confluence:  
 5.600      0.900      0.300      2.400

Results of confluence:  
 Total flow rate = 16.394(CFS)  
 Time of concentration = 10.604 min.  
 Effective stream area after confluence = 9.200(Ac.)  
 End of computations, total study area = 9.20 (Ac.)  
 The following figures may  
 be used for a unit hydrograph study of the same area.

Area averaged pervious area fraction(Ap) = 0.100  
 Area averaged RI index number = 69.0

**100-YEAR ONSITE HYDROLOGY (RATIONAL METHOD)**

Riverside County Rational Hydrology Program

CIVILCADD/CIVILDESIGN Engineering Software,(c) 1989 - 2004 Version 7.0  
Rational Hydrology Study Date: 08/12/21 File:prop100.out

-----  
20-0082 - FIR HK  
ONSITE RATIONAL METHOD HYDROLOGY  
100 YEAR STORM EVENT  
FN: PROP100.OUT RC  
-----

\*\*\*\*\* Hydrology Study Control Information \*\*\*\*\*

English (in-lb) Units used in input data file  
-----

Program License Serial Number 4010  
-----

Rational Method Hydrology Program based on  
Riverside County Flood Control & Water Conservation District  
1978 hydrology manual

Storm event (year) = 100.00 Antecedent Moisture Condition = 2

Standard intensity-duration curves data (Plate D-4.1)  
For the [ Perris Valley ] area used.  
10 year storm 10 minute intensity = 1.880(In/Hr)  
10 year storm 60 minute intensity = 0.780(In/Hr)  
100 year storm 10 minute intensity = 2.690(In/Hr)  
100 year storm 60 minute intensity = 1.120(In/Hr)

Storm event year = 100.0  
Calculated rainfall intensity data:  
1 hour intensity = 1.120(In/Hr)  
Slope of intensity duration curve = 0.4900

++++  
Process from Point/Station 101.000 to Point/Station 102.000  
\*\*\*\* INITIAL AREA EVALUATION \*\*\*\*

-----  
Initial area flow distance = 363.000(Ft.)  
Top (of initial area) elevation = 1459.100(Ft.)  
Bottom (of initial area) elevation = 1456.800(Ft.)

Difference in elevation = 2.300(Ft.)  
Slope = 0.00634 s(percent)= 0.63  
TC =  $k(0.300)*[(\text{length}^3)/(\text{elevation change})]^{0.2}$   
Initial area time of concentration = 8.724 min.  
Rainfall intensity = 2.881(In/Hr) for a 100.0 year storm  
COMMERCIAL subarea type  
Runoff Coefficient = 0.885  
Decimal fraction soil group A = 0.000  
Decimal fraction soil group B = 0.000  
Decimal fraction soil group C = 1.000  
Decimal fraction soil group D = 0.000  
RI index for soil(AMC 2) = 69.00  
Pervious area fraction = 0.100; Impervious fraction = 0.900  
Initial subarea runoff = 14.271(CFS)  
Total initial stream area = 5.600(Ac.)  
Pervious area fraction = 0.100

++++  
Process from Point/Station 102.000 to Point/Station 103.000  
\*\*\*\* PIPEFLOW TRAVEL TIME (Program estimated size) \*\*\*\*

---

Upstream point/station elevation = 1451.900(Ft.)  
Downstream point/station elevation = 1450.300(Ft.)  
Pipe length = 512.00(Ft.) Manning's N = 0.012  
No. of pipes = 1 Required pipe flow = 14.271(CFS)  
Nearest computed pipe diameter = 24.00(In.)  
Calculated individual pipe flow = 14.271(CFS)  
Normal flow depth in pipe = 20.72(In.)  
Flow top width inside pipe = 16.49(In.)  
Critical Depth = 16.33(In.)  
Pipe flow velocity = 4.95(Ft/s)  
Travel time through pipe = 1.72 min.  
Time of concentration (TC) = 10.45 min.

++++  
Process from Point/Station 102.000 to Point/Station 103.000  
\*\*\*\* CONFLUENCE OF MINOR STREAMS \*\*\*\*

---

Along Main Stream number: 1 in normal stream number 1  
Stream flow area = 5.600(Ac.)  
Runoff from this stream = 14.271(CFS)  
Time of concentration = 10.45 min.  
Rainfall intensity = 2.637(In/Hr)

++++  
Process from Point/Station 201.000 to Point/Station 202.000  
\*\*\*\* INITIAL AREA EVALUATION \*\*\*\*

---

Initial area flow distance = 395.000(Ft.)  
Top (of initial area) elevation = 1460.100(Ft.)  
Bottom (of initial area) elevation = 1457.400(Ft.)  
Difference in elevation = 2.700(Ft.)  
Slope = 0.00684 s(percent)= 0.68  
TC =  $k(0.300)*[(\text{length}^3)/(\text{elevation change})]^{0.2}$   
Initial area time of concentration = 8.888 min.  
Rainfall intensity = 2.855(In/Hr) for a 100.0 year storm  
COMMERCIAL subarea type  
Runoff Coefficient = 0.884  
Decimal fraction soil group A = 0.000  
Decimal fraction soil group B = 0.000  
Decimal fraction soil group C = 1.000  
Decimal fraction soil group D = 0.000  
RI index for soil(AMC 2) = 69.00  
Pervious area fraction = 0.100; Impervious fraction = 0.900  
Initial subarea runoff = 2.272(CFS)  
Total initial stream area = 0.900(Ac.)  
Pervious area fraction = 0.100

++++  
Process from Point/Station 202.000 to Point/Station 203.000  
\*\*\*\* PIPEFLOW TRAVEL TIME (Program estimated size) \*\*\*\*

---

Upstream point/station elevation = 1451.800(Ft.)  
Downstream point/station elevation = 1451.500(Ft.)  
Pipe length = 29.00(Ft.) Manning's N = 0.012  
No. of pipes = 1 Required pipe flow = 2.272(CFS)  
Nearest computed pipe diameter = 12.00(In.)  
Calculated individual pipe flow = 2.272(CFS)  
Normal flow depth in pipe = 6.55(In.)  
Flow top width inside pipe = 11.95(In.)  
Critical Depth = 7.73(In.)  
Pipe flow velocity = 5.18(Ft/s)  
Travel time through pipe = 0.09 min.  
Time of concentration (TC) = 8.98 min.

++++  
Process from Point/Station 202.000 to Point/Station 203.000  
\*\*\*\* CONFLUENCE OF MINOR STREAMS \*\*\*\*

---

Along Main Stream number: 1 in normal stream number 2  
Stream flow area = 0.900(Ac.)  
Runoff from this stream = 2.272(CFS)  
Time of concentration = 8.98 min.  
Rainfall intensity = 2.840(In/Hr)

++++  
Process from Point/Station 301.000 to Point/Station 302.000  
\*\*\*\* INITIAL AREA EVALUATION \*\*\*\*

---

Initial area flow distance = 120.000(Ft.)  
Top (of initial area) elevation = 1461.000(Ft.)  
Bottom (of initial area) elevation = 1458.600(Ft.)  
Difference in elevation = 2.400(Ft.)  
Slope = 0.02000 s(percent)= 2.00  
TC =  $k(0.300)*[(\text{length}^3)/(\text{elevation change})]^{0.2}$   
Warning: TC computed to be less than 5 min.; program is assuming the  
time of concentration is 5 minutes.  
Initial area time of concentration = 5.000 min.  
Rainfall intensity = 3.785(In/Hr) for a 100.0 year storm  
COMMERCIAL subarea type  
Runoff Coefficient = 0.888  
Decimal fraction soil group A = 0.000  
Decimal fraction soil group B = 0.000  
Decimal fraction soil group C = 1.000  
Decimal fraction soil group D = 0.000  
RI index for soil(AMC 2) = 69.00  
Pervious area fraction = 0.100; Impervious fraction = 0.900  
Initial subarea runoff = 1.008(CFS)  
Total initial stream area = 0.300(Ac.)  
Pervious area fraction = 0.100

++++  
Process from Point/Station 302.000 to Point/Station 303.000  
\*\*\*\* PIPEFLOW TRAVEL TIME (Program estimated size) \*\*\*\*

---

Upstream point/station elevation = 1451.800(Ft.)  
Downstream point/station elevation = 1451.500(Ft.)  
Pipe length = 41.00(Ft.) Manning's N = 0.012  
No. of pipes = 1 Required pipe flow = 1.008(CFS)  
Nearest computed pipe diameter = 9.00(In.)  
Calculated individual pipe flow = 1.008(CFS)  
Normal flow depth in pipe = 5.33(In.)  
Flow top width inside pipe = 8.85(In.)  
Critical Depth = 5.53(In.)  
Pipe flow velocity = 3.70(Ft/s)  
Travel time through pipe = 0.18 min.  
Time of concentration (TC) = 5.18 min.

++++  
Process from Point/Station 302.000 to Point/Station 303.000  
\*\*\*\* CONFLUENCE OF MINOR STREAMS \*\*\*\*

---

Along Main Stream number: 1 in normal stream number 3  
Stream flow area = 0.300(Ac.)  
Runoff from this stream = 1.008(CFS)  
Time of concentration = 5.18 min.  
Rainfall intensity = 3.718(In/Hr)

++++  
Process from Point/Station 401.000 to Point/Station 402.000  
\*\*\*\* INITIAL AREA EVALUATION \*\*\*\*

---

Initial area flow distance = 171.000(Ft.)  
Top (of initial area) elevation = 1462.100(Ft.)  
Bottom (of initial area) elevation = 1458.300(Ft.)  
Difference in elevation = 3.800(Ft.)  
Slope = 0.02222 s(percent)= 2.22  
TC =  $k(0.300)*[(\text{length}^3)/(\text{elevation change})]^{0.2}$   
Initial area time of concentration = 5.023 min.  
Rainfall intensity = 3.776(In/Hr) for a 100.0 year storm  
COMMERCIAL subarea type  
Runoff Coefficient = 0.888  
Decimal fraction soil group A = 0.000  
Decimal fraction soil group B = 0.000  
Decimal fraction soil group C = 1.000  
Decimal fraction soil group D = 0.000  
RI index for soil(AMC 2) = 69.00  
Pervious area fraction = 0.100; Impervious fraction = 0.900  
Initial subarea runoff = 8.045(CFS)  
Total initial stream area = 2.400(Ac.)  
Pervious area fraction = 0.100

++++  
Process from Point/Station 402.000 to Point/Station 403.000  
\*\*\*\* PIPEFLOW TRAVEL TIME (Program estimated size) \*\*\*\*

---

Upstream point/station elevation = 1454.200(Ft.)  
Downstream point/station elevation = 1451.300(Ft.)  
Pipe length = 597.00(Ft.) Manning's N = 0.012  
No. of pipes = 1 Required pipe flow = 8.045(CFS)  
Nearest computed pipe diameter = 18.00(In.)  
Calculated individual pipe flow = 8.045(CFS)  
Normal flow depth in pipe = 15.00(In.)  
Flow top width inside pipe = 13.42(In.)  
Critical Depth = 13.18(In.)  
Pipe flow velocity = 5.11(Ft/s)  
Travel time through pipe = 1.95 min.  
Time of concentration (TC) = 6.97 min.



+++++  
 Process from Point/Station 402.000 to Point/Station 403.000  
 \*\*\*\* CONFLUENCE OF MINOR STREAMS \*\*\*\*

Along Main Stream number: 1 in normal stream number 4  
 Stream flow area = 2.400(Ac.)  
 Runoff from this stream = 8.045(CFS)  
 Time of concentration = 6.97 min.  
 Rainfall intensity = 3.216(In/Hr)  
 Summary of stream data:

Stream No.	Flow rate (CFS)	TC (min)	Rainfall Intensity (In/Hr)
1	14.271	10.45	2.637
2	2.272	8.98	2.840
3	1.008	5.18	3.718
4	8.045	6.97	3.216

Largest stream flow has longer time of concentration

Qp = 14.271 + sum of  

$$\frac{Q_b}{I_a/I_b} = \frac{2.272}{0.929} = 2.110$$
  

$$\frac{Q_b}{I_a/I_b} = \frac{1.008}{0.709} = 0.715$$
  

$$\frac{Q_b}{I_a/I_b} = \frac{8.045}{0.820} = 6.597$$
  
 Qp = 23.693

Total of 4 streams to confluence:  
 Flow rates before confluence point:  
 14.271      2.272      1.008      8.045


Area of streams before confluence:  
 5.600      0.900      0.300      2.400

Results of confluence:  
 Total flow rate = 23.693(CFS)  
 Time of concentration = 10.448 min.  
 Effective stream area after confluence = 9.200(Ac.)  
 End of computations, total study area = 9.20 (Ac.)



The following figures may be used for a unit hydrograph study of the same area.

Area averaged pervious area fraction(Ap) = 0.100  
 Area averaged RI index number = 69.0

**HYDROLOGY MAPS**

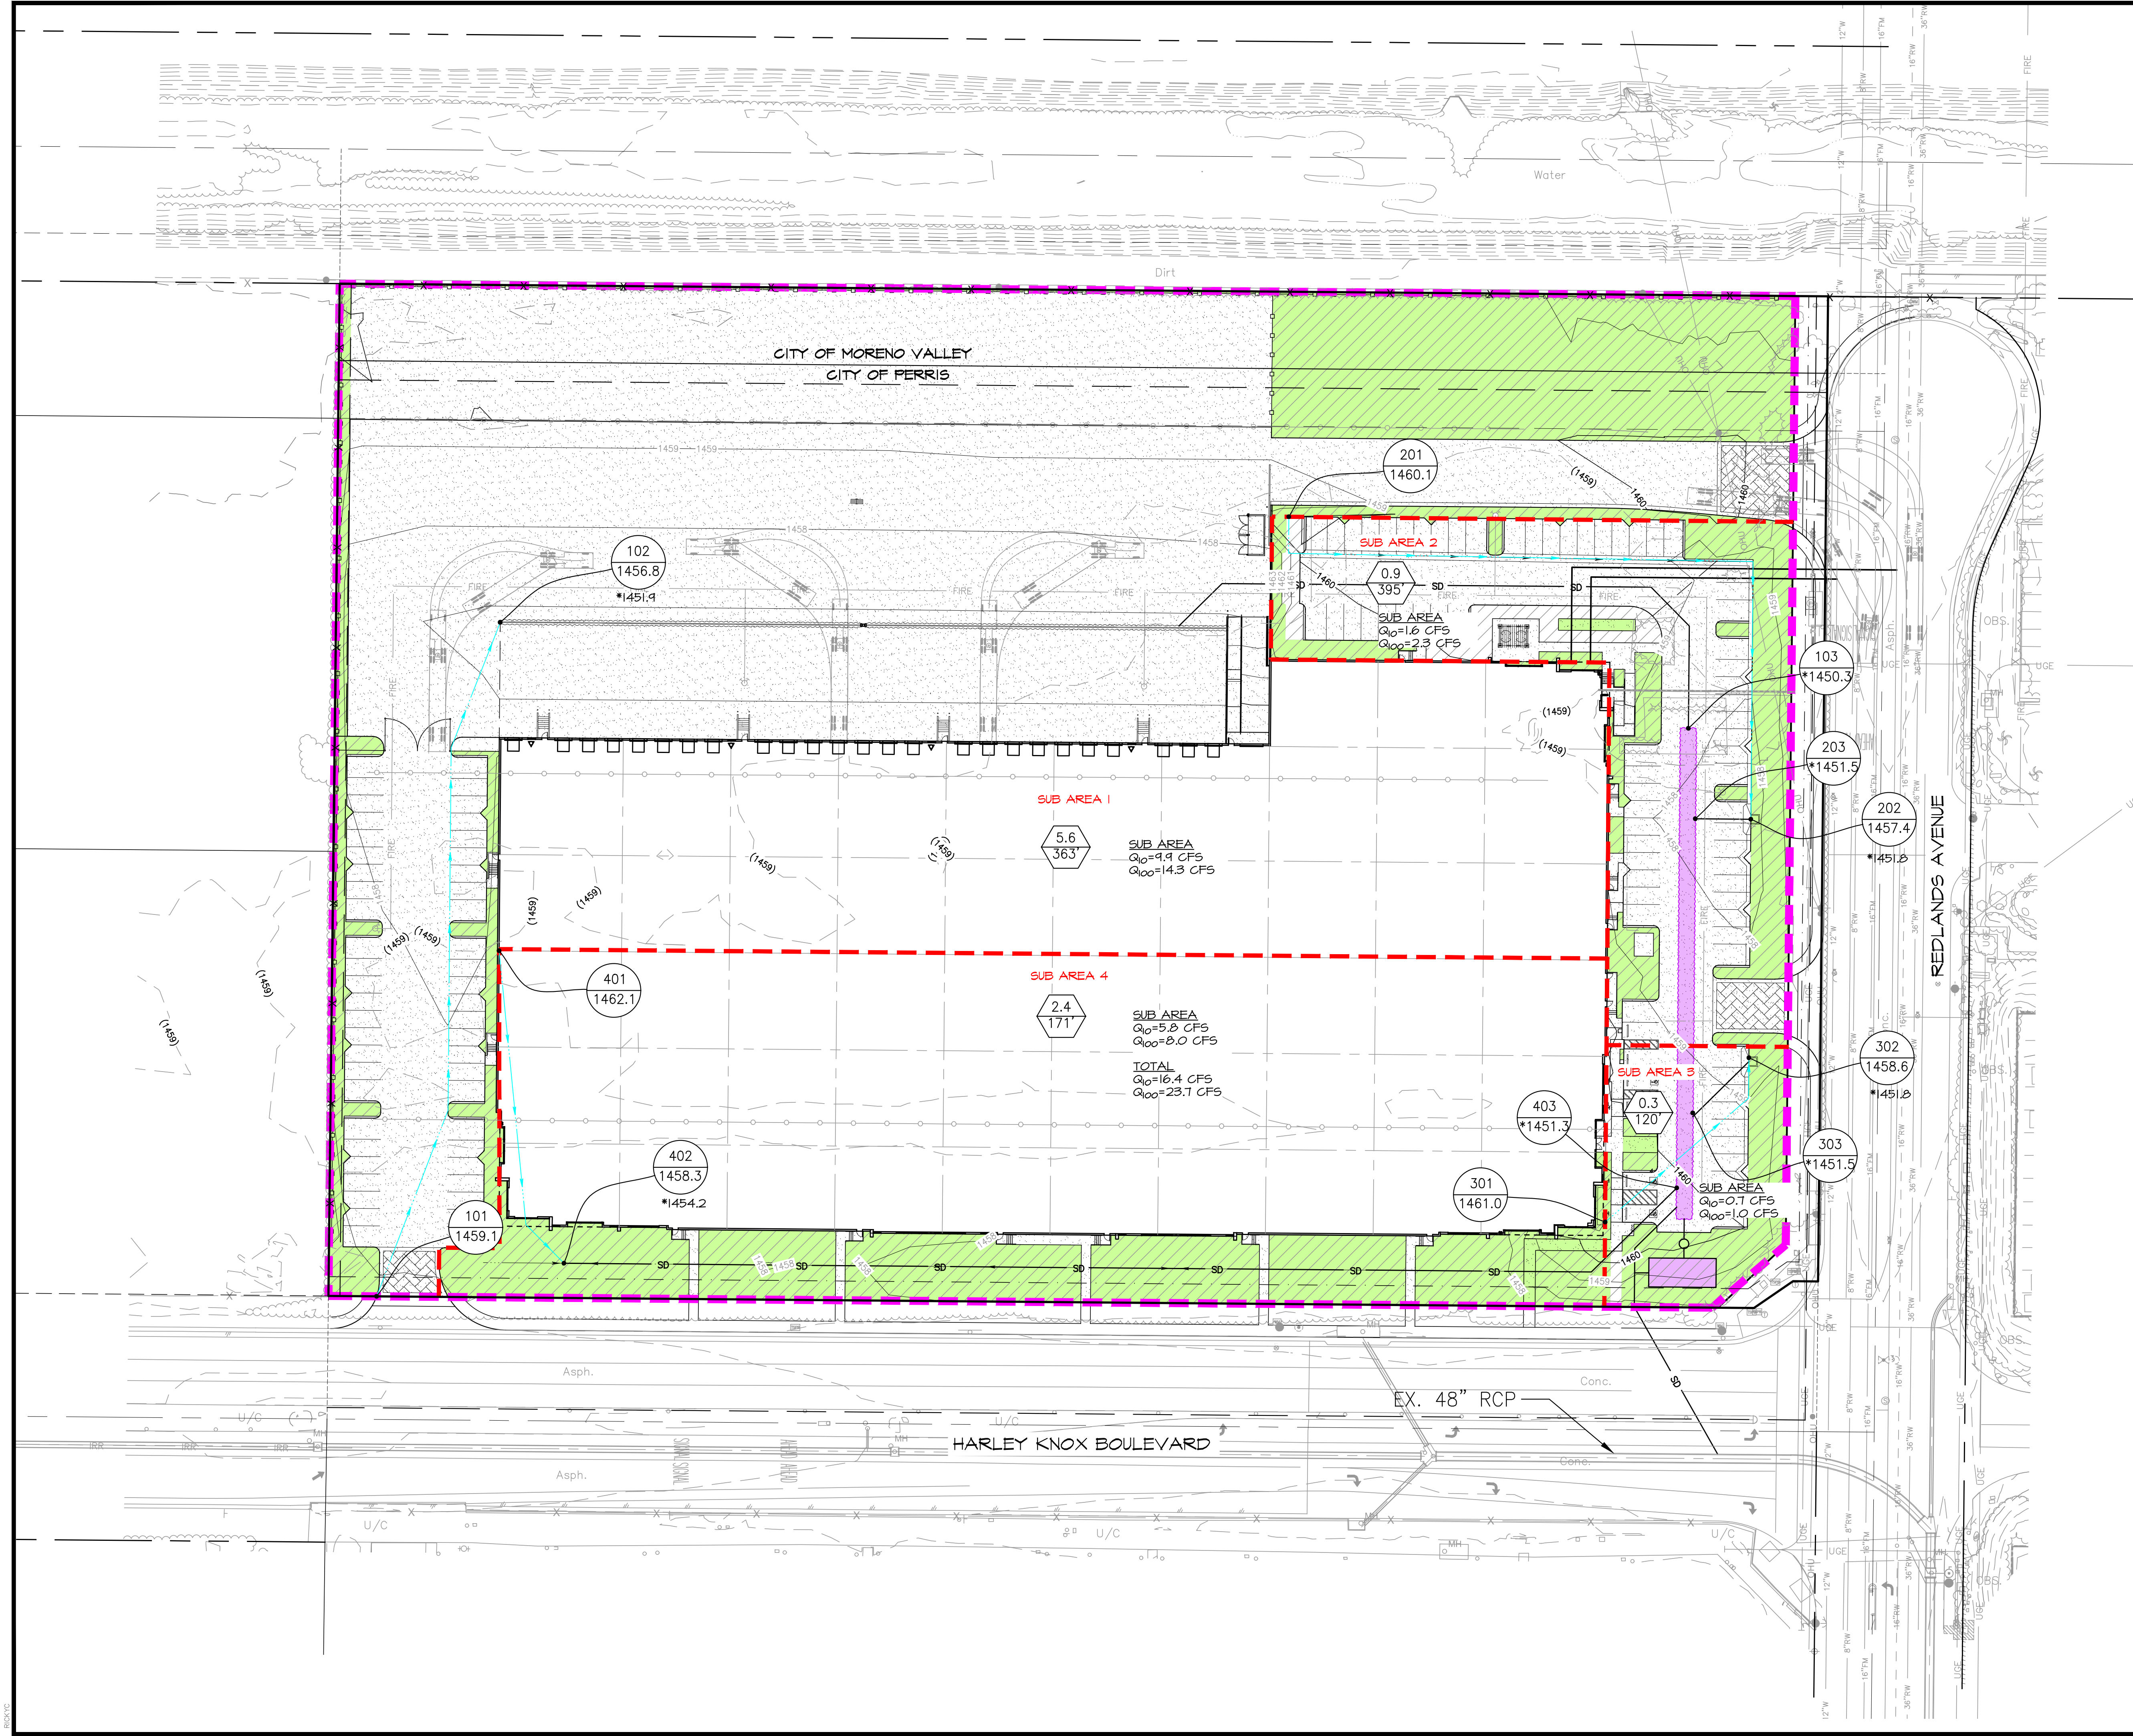

- LEGEND**
- DRAINAGE MANAGEMENT BOUNDARY
  - FLOW DIRECTION
  - 101  
14xx  
\*14XX NODE DESIGNATION  
NODE ELEVATION  
\*INVERT ELEVATION
  - 5.0  
1000 WATERSHED AREA (ACRES)  
LONGEST WATER PATH (FT)
  - LANDSCAPING
  - CONCRETE OR ASPHALT
  - BMP (FILTERRA UNIT/ UNDERGROUND CHAMBERS)

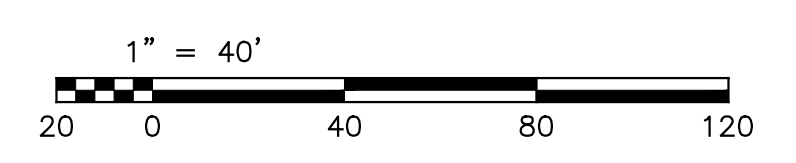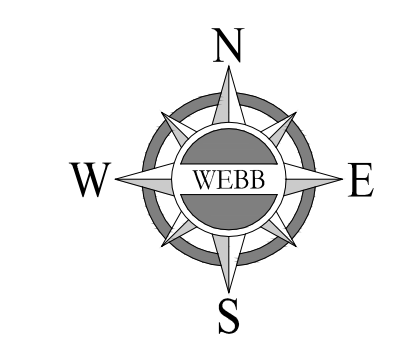

<b>CITY OF PERRIS</b>			
DEVELOPED CONDITION PRELIMINARY RATIONAL METHOD HYDROLOGY MAP FIRST INDUSTRIAL - HARLEY KNOX DPR NO. XX-XXXX			
SCALE: 1"=40'	<b>ALBERT A. ENGINEERING CONSULTANTS</b>	3788 McCRAY STREET RIVERSIDE CA 92506 PH. (951) 686-1070 FAX (951) 788-1256	W.O. MO SHEET 1 OF 1 SHEETS DWG. NO.
DATE: 8/12/21	DESIGNED: RC	CHECKED: SRH	PLN CK REF: F.B.

H:\2020\20-0082\DRAINAGE\HYD.DWG FOLDER\20-0082-PHYD-RATIONAL.DWG 8/12/2021 2:24:47 PM

## APPENDIX B – HYDRAULICS

---

**HYDRAULIC CALCULATIONS**


---

Hydraulic calculations to be provided in Final Engineering.

**INLET AND CATCH BASIN CALCULATIONS**

---

# Nyloplast 2' x 3' Road & Highway Grate Inlet Capacity Chart

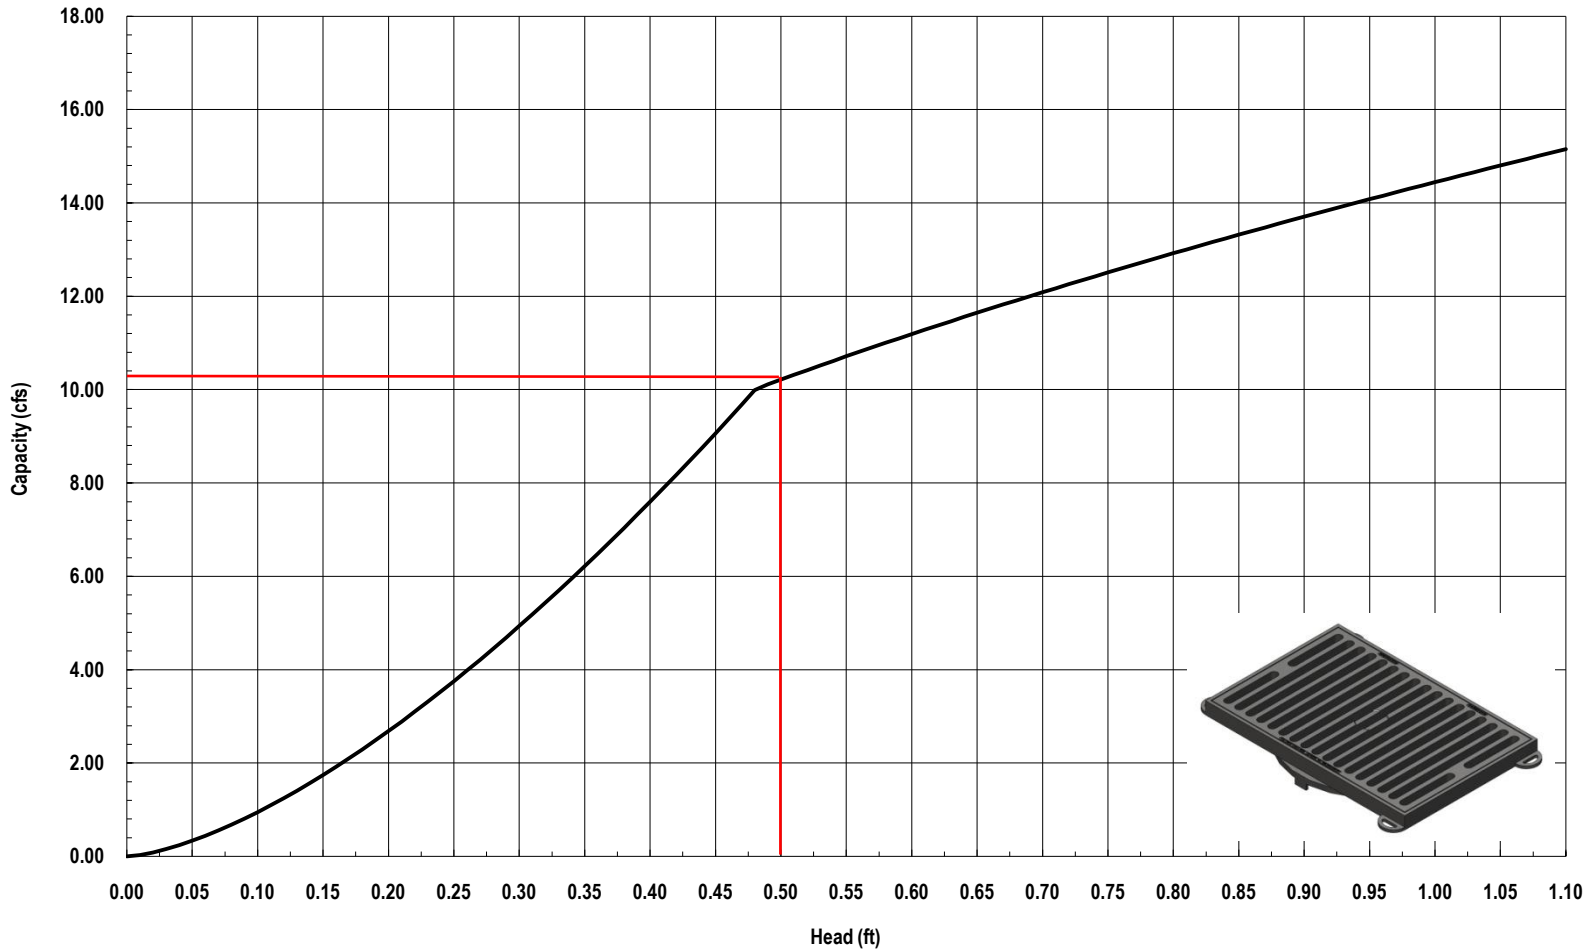

3130 Verona Avenue • Buford, GA 30518  
(866) 888-8479 / (770) 932-2443 • Fax: (770) 932-2490  
© Nyloplast Inlet Capacity Charts June 2012





## **APPENDIX C – REFERENCES**

---



**PERRIS VALLEY MDP LAT D-3A PLANS**

---

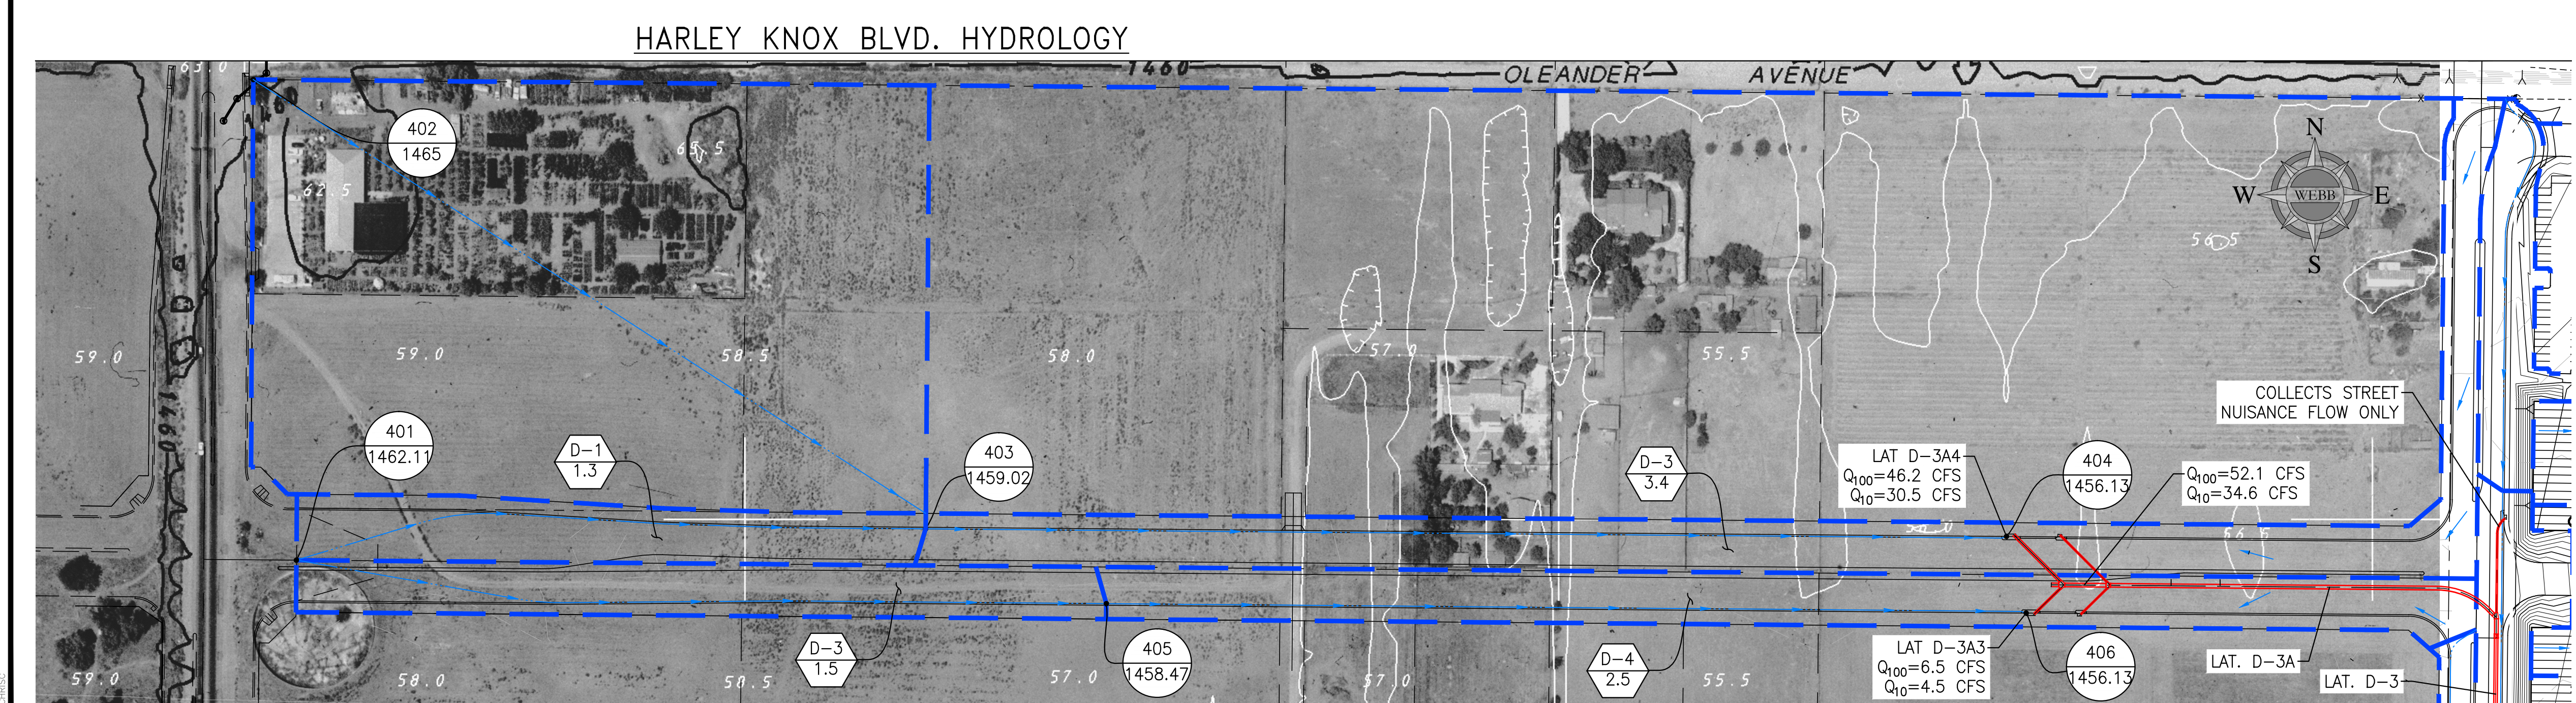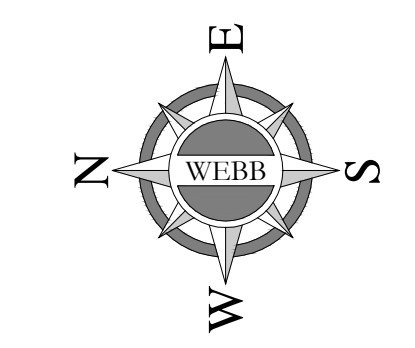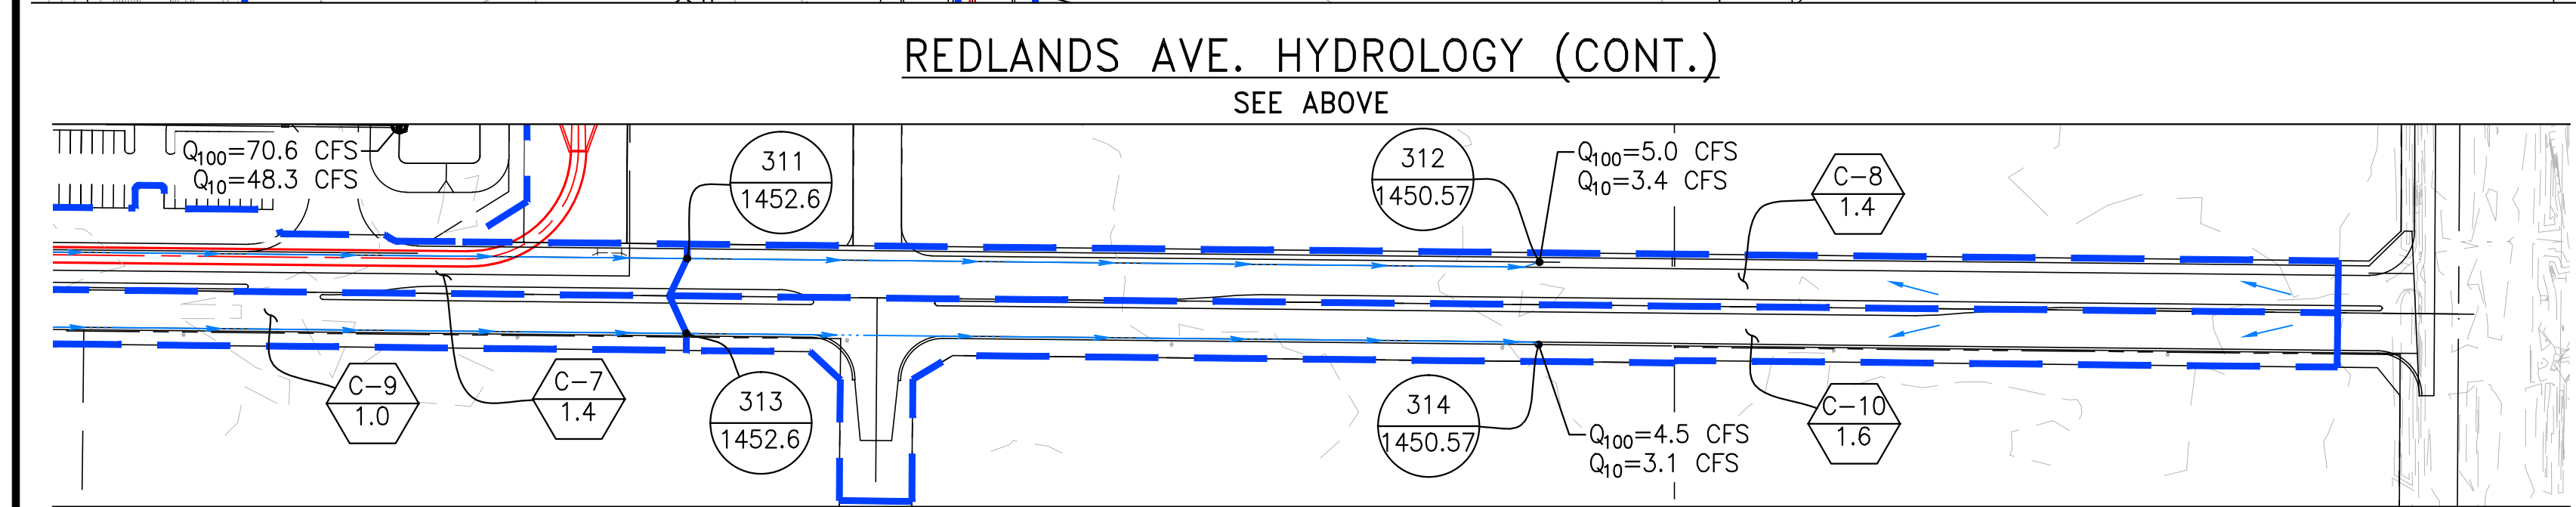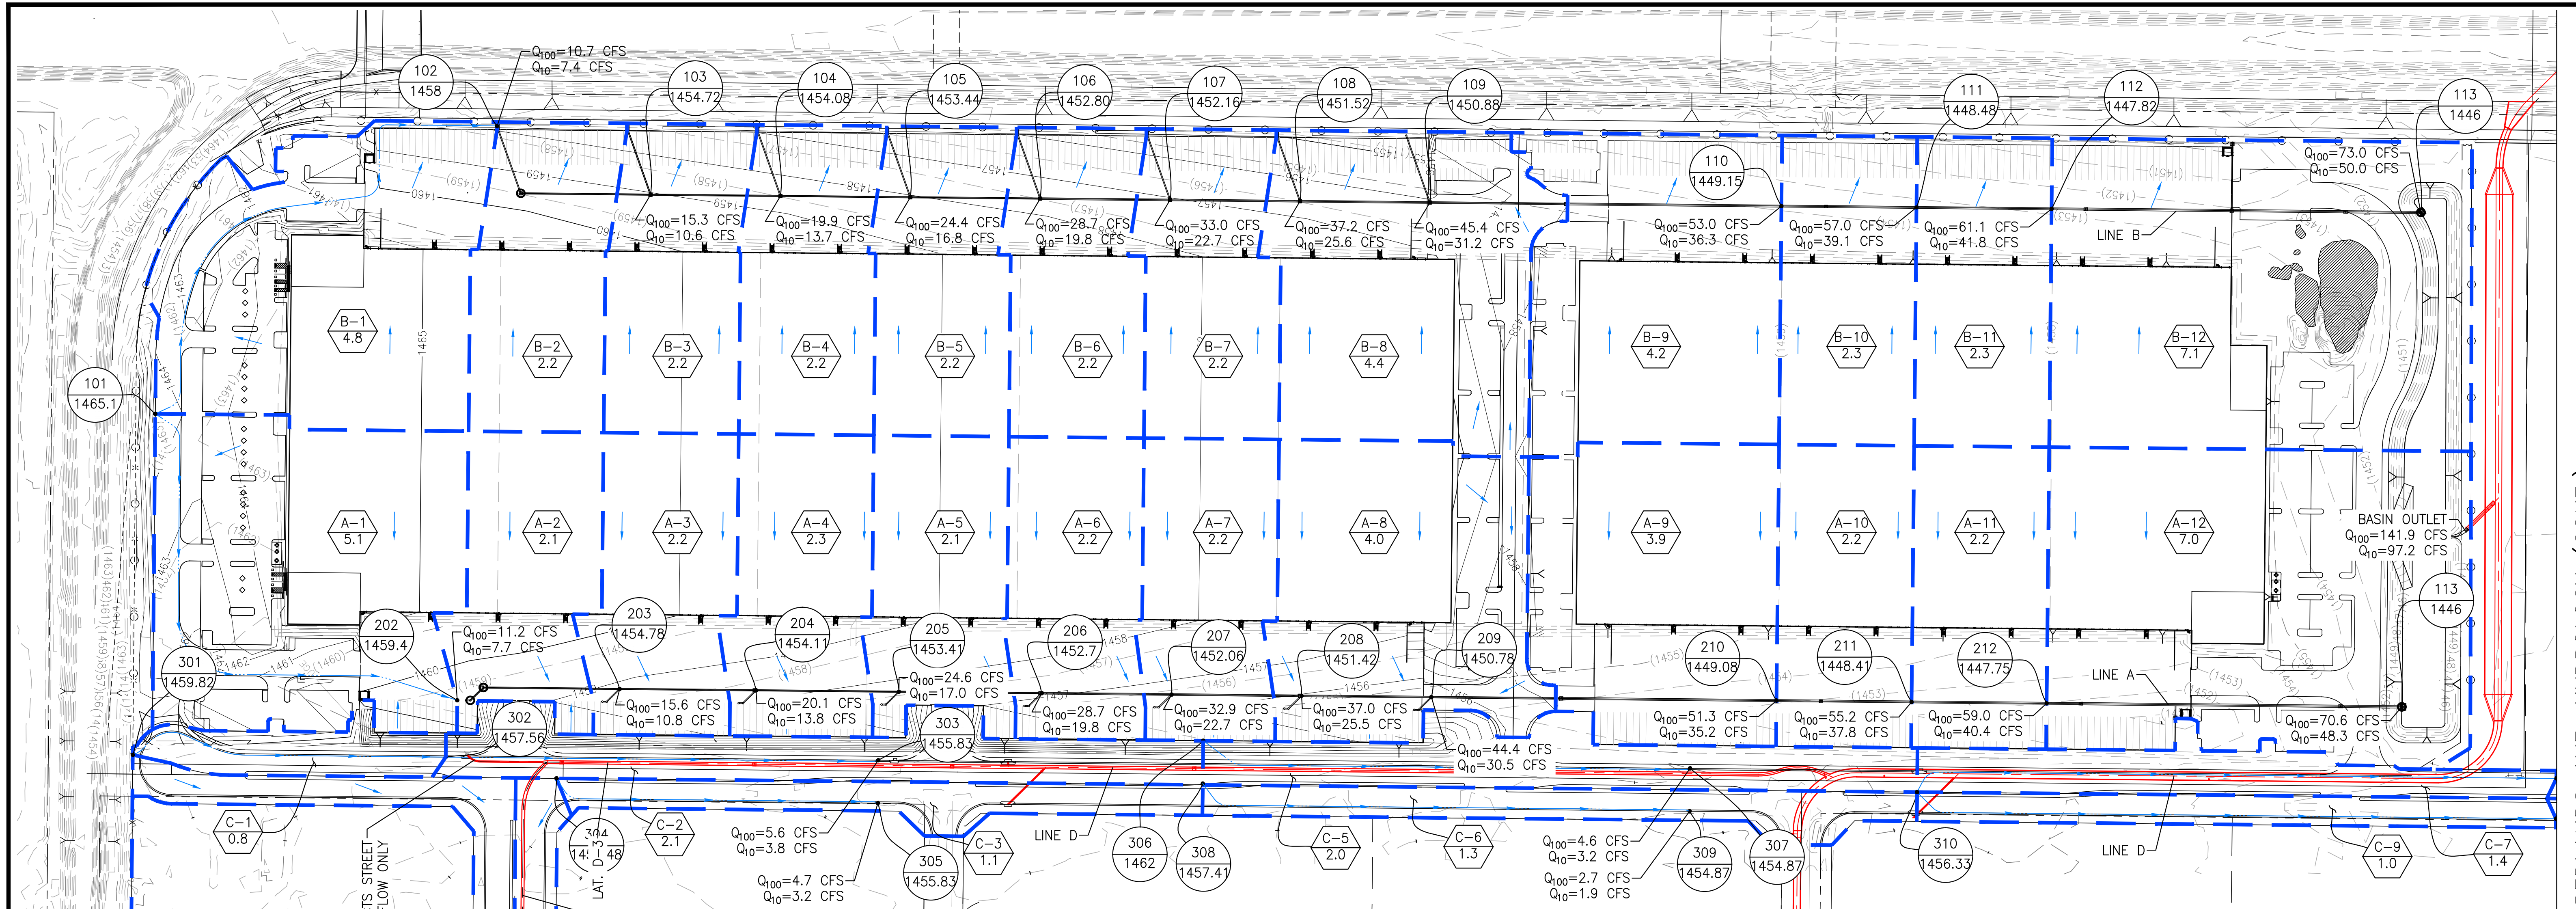

- LEGEND**
- WATERSHED BOUNDARY
  - WATER COURSE
  - FLOW DIRECTION
  - ###  
XXXX.X  
NODE  
ELEVATION
  - X-X  
XXXX  
SUBAREA DESIGNATION  
ACREAGE - ACRES

**PROPOSED CONDITION  
HYDROLOGY MAP**

**STRATFORD RANCH  
INDUSTRIAL SITE  
ON-SITE & STREET  
HYDROLOGY**

SCALE: 1"=120'  
DATE: 12/6/2013  
DESIGNED: CRC  
CHECKED: EA  
PLN CK REF: F.B.

**ALBERT A. WEBB  
ENGINEERING CONSULTANTS**  
3788 McCRAE STREET  
RIVERSIDE, CA 92506  
PH. (951) 686-1070  
FAX (951) 788-1256

W.O. 13-0239  
SHEET 1  
OF 1 SHEETS  
DWG. NO.

REDLANDS AVE. HYDROLOGY (CONT.)  
SEE BELOW

C:\2013\13-0239\13-0239-CD-10D.dwg 12/17/2013 4:06:43 PM

**GENERAL NOTES**

- IT SHALL BE THE RESPONSIBILITY OF THE DEVELOPER/OWNER CONTRACTOR TO APPLY TO THE CITY OF PERRIS ENGINEERING DEPARTMENT, PERMIT SECTION, FOR AN ENCROACHMENT PERMIT FOR ALL WORK PERFORMED WITHIN PUBLIC RIGHT-OF-WAY, DEDICATED AND ACCEPTED FOR PUBLIC USE; AND TO BE RESPONSIBLE FOR SATISFACTORY COMPLIANCE FOR ALL CURRENT ENVIRONMENTAL REGULATIONS DURING THE LIFE OF CONSTRUCTION ACTIVITIES FOR THIS PROJECT, ADDITIONAL STUDIES AND/OR PERMITS MAY BE REQUIRED.
- THE CONTRACTOR/DEVELOPER SHALL BE RESPONSIBLE FOR THE CLEARING OF THE WORK AREA, AND RELOCATION COSTS OF ALL EXISTING UTILITIES. THIS INCLUDES UNDERGROUNDING OF EXISTING OVERHEAD LINES ALONG THE PROJECT FRONTAGE AS REQUIRED BY THE CONDITIONS OF APPROVAL. PERMITEE MUST INFORM CITY OF CONSTRUCTION SCHEDULE AT LEAST 48 HOURS PRIOR TO BEGINNING OF CONSTRUCTION. PHONE: (951) 943-6504.
- THE DEVELOPER WILL INSTALL STREET NAME SIGNS CONFORMING TO COUNTY STANDARD NO. 816 OR AS APPROVED BY THE CITY ENGINEER.
- ALL WORK SHALL CONFORM TO THE REQUIREMENTS OF THE RIVERSIDE COUNTY TRANSPORTATION DEPARTMENT IMPROVEMENT STANDARDS AND SPECIFICATIONS, LATEST EDITION, COUNTY ORDINANCE NO. 461 AND SUBSEQUENT AMENDMENTS.
- IT SHALL BE THE RESPONSIBILITY OF THE DEVELOPER TO NOTIFY THE ENGINEER TO INSTALL STREET CENTERLINE MONUMENTS AS REQUIRED BY RIVERSIDE COUNTY ORDINANCE NO. 461 (TRACTS AND PARCEL MAPS ONLY). ALL EXISTING SURVEY MONUMENTS SHALL BE PROTECTED IN PLACE OR RELOCATED BY A LICENSED PROFESSIONAL PRIOR TO CONSTRUCTION.
- ALL UNDERGROUND FACILITIES, WITH LATERALS, SHALL BE IN PLACE PRIOR TO PAVING THE STREET, INCLUDING, BUT NOT LIMITED TO, THE FOLLOWING: SEWER, WATER, ELECTRIC, GAS, STORM DRAINS.
- CURB DEPRESSIONS AND DRIVEWAY APPROACHES WILL BE INSTALLED AND CONSTRUCTED ACCORDING TO COUNTY STANDARD NO. 207A, AS DIRECTED IN THE FIELD AND AS APPROVED BY THE CITY ENGINEER.
- IT SHALL BE THE RESPONSIBILITY OF THE DEVELOPER OR CONTRACTOR TO INSTALL AND MAINTAIN ALL CONSTRUCTION, REGULATORY, GUIDE AND WARNING SIGNS WITHIN THE PROJECT LIMITS AND ITS SURROUNDINGS TO PROVIDE SAFE PASSAGE FOR THE TRAVELING PUBLIC AND WORKERS UNTIL THE FINAL COMPLETION AND ACCEPTANCE OF THE PROJECT BY THE CITY. A TRAFFIC CONTROL PLAN MUST BE SUBMITTED FOR REVIEW TO THE PERMITS SECTION OR INSPECTION SECTION PRIOR TO OBTAINING AN ENCROACHMENT PERMIT.
- ALL STREET SECTIONS ARE MINIMUM REQUIREMENTS. ADDITIONAL SOIL TESTS SHALL BE TAKEN AFTER ROUGH GRADING TO DETERMINE THE RECOMMENDED STREET SECTION REQUIREMENTS. USE COUNTY STD. NO. 401 IF EXPANSIVE SOILS ARE ENCOUNTERED.
- ASPHALTIC EMULSION (FOG SEAL) SHALL BE APPLIED NOT LESS THAN FOURTEEN DAYS FOLLOWING PLACEMENT OF THE ASPHALT SURFACING. FOG SEAL AND PAINT BINDER SHALL BE APPLIED AT A RATE OF 0.05 AND 0.03 GALLON PER SQUARE YARD RESPECTIVELY. ASPHALTIC EMULSION SHALL CONFORM TO SECTION 37, 39 AND 94 OF THE STATE STANDARD SPECIFICATIONS.
- INSTALL STREET TREES IN ACCORDANCE WITH ORDINANCE NO. 461 AND THE COMPREHENSIVE LANDSCAPING GUIDELINES.
- STREET LIGHTS SHALL BE INSTALLED PER RIVERSIDE COUNTY STANDARDS AND IN ACCORDANCE WITH THE APPROVED STREET LIGHTING PLAN.
- AS DETERMINED BY THE CITY ENGINEER, THE DEVELOPER IS RESPONSIBLE AT A MINIMUM FOR ROAD IMPROVEMENTS TO CENTERLINE, AND MAY BE REQUIRED TO RECONSTRUCT EXISTING PAVEMENT, INCLUDING BASE, AND MATCHING OVERLAY REQUIRED TO MEET THE STRUCTURAL STANDARDS FOR THE CURRENT ASSIGNED TRAFFIC INDEX PER ENGINEERING CONDITION OF APPROVAL.
- ANY PRIVATE DRAINAGE FACILITIES SHOWN ON THESE PLANS ARE FOR INFORMATION ONLY. BY SIGNING THESE IMPROVEMENT PLANS, NO REVIEW OR APPROVAL OF THOSE PRIVATE FACILITIES IS IMPLIED OR INTENDED BY THE CITY OF PERRIS ENGINEERING DEPARTMENT.
- CONSTRUCTION PROJECTS MUST OBTAIN A NATIONAL POLLUTANT DISCHARGE ELIMINATION SYSTEM (NPDES) PERMIT. OWNERS/DEVELOPERS ARE REQUIRED TO FILE A NOTICE OF INTENT (NOI) WITH THE STATE WATER RESOURCES CONTROL BOARD (SWRCB), PREPARE A STORM WATER POLLUTION PREVENTION PLAN (SWPPP) AND MONITORING PLAN FOR THE SITE.  
PRIOR TO ANY CONSTRUCTION, THE DEVELOPER SHALL PROVIDE THE CITY A COPY OF THE NOI WITH A VALID WQID NUMBER.
- THE DEVELOPER SHALL BE RESPONSIBLE FOR THE INSTALLATION OF ADDITIONAL SIGNS AND MARKINGS NOT INCLUDED IN THE SIGNING AND STRIPING PLAN WITHIN THE PROJECT AREAS, OR ON ROADWAYS ADJACENT TO THE PROJECT BOUNDARIES, UPON THE REQUEST OF THE CITY ENGINEER OR HIS DESIGNEE TO IMPROVE TRAFFIC SAFETY ON THE ROADS UNDER THE JURISDICTION OF THE DEVELOPER.
- EXISTING STORM DRAIN PIPES / CULVERTS (WHETHER TO BE CONNECTED TO, EXTENDED, ADJUSTED, DRAINED TO, OR JUST IN THE PROJECT VICINITY) MUST BE REPAIRED, AND/OR CLEANED TO MAKE THEM FUNCTIONAL AND ACCEPTABLE APPROVED BY THE CITY ENGINEER.
- FOR ALL DRIVEWAY RECONSTRUCTION BEYOND RIGHT-OF-WAY, PROOF OF DRIVEWAY OWNER NOTIFICATION IS REQUIRED PRIOR TO CONSTRUCTION.
- IN THE EVENT OF ANY DAMAGE TO ADJACENT STREETS CAUSED BY THE CONSTRUCTION, CONTRACTOR SHALL REMOVE AND REPLACE DAMAGES AS DIRECTED BY CITY ENGINEER.

**NOTICE TO CONTRACTORS**

CONTRACTOR AGREES THAT HE SHALL ASSUME COMPLETE AND SOLE RESPONSIBILITY FOR JOB SITE CONDITIONS DURING THE COURSE OF CONSTRUCTION, INCLUDING SAFETY OF ALL PERSONS AND PROPERTY; THAT THIS REQUIREMENT SHALL CONTINUOUSLY AND NOT BE LIMITED TO NORMAL WORKING HOURS; AND THAT THE CONTRACTOR SHALL DEFEND, INDEMNIFY AND HOLD THE OWNER AND ENGINEER HARMLESS FROM ANY AND ALL LIABILITY, REAL OR ALLEGED, IN CONNECTION WITH THE PERFORMANCE OF WORK ON THIS PROJECT, EXCEPTING FROM LIABILITY ARISING FROM THE SOLE NEGLIGENCE OF THE OWNER OR ENGINEER.

**UNDERGROUND STRUCTURES**

ALL UNDERGROUND STRUCTURES OR UTILITIES REPORTED BY THE OWNER OR OTHERS AND THOSE SHOWN ON THE RECORDS EXAMINED ARE INDICATED WITH THEIR APPROXIMATE LOCATION AND EXTENT.

THE OWNER, BY ACCEPTING THESE PLANS OR PROCEEDING WITH THE IMPROVEMENTS PURSUANT THERETO AGREES TO ASSUME LIABILITY AND TO HOLD THE UNDERSIGNED HARMLESS FOR ANY DAMAGES RESULTING FROM THE EXISTENCE OF UNDERGROUND UTILITIES OR STRUCTURES NOT REPORTED TO THE UNDERSIGNED, NOT INDICATED ON THE PUBLIC RECORDS EXAMINED, OR LOCATED AT VARIANCE WITH THAT REPORTED OR SHOWN ON THE RECORDS EXAMINED.

THE CONTRACTOR IS REQUIRED TO TAKE DUE PRECAUTIONARY MEASURES TO PROTECT THE UTILITIES OR STRUCTURES SHOWN AND ANY OTHER UTILITIES OR STRUCTURES FOUND AT THE SITE. IT SHALL BE THE CONTRACTOR'S RESPONSIBILITY TO NOTIFY THE OWNERS OF THE UTILITIES OR STRUCTURES CONCERNED BEFORE STARTING WORK.

**BASIS OF BEARINGS**

THE BASIS OF BEARINGS FOR THIS SURVEY IS THE CALIFORNIA COORDINATE SYSTEM ZONE 6, NAD 83, 1991.35 EPOCH AS DETERMINED LOCALLY BY A LINE BETWEEN 40 Y (PID DX2103) AND SANTA FE (PID DX3719) BEING NORTH 80°43'18" WEST AS DERIVED FROM GEODETIC VALUES PUBLISHED BY NATIONAL GEODETIC SURVEY (NGS)

DISTANCES SHOWN HEREON ARE GROUND DISTANCES UNLESS OTHERWISE NOTED. TO OBTAIN GRID DISTANCES MULTIPLY GROUND DISTANCES BY 0.99999207.

CALCULATIONS FROM GRID TO GROUND VALUES AND CONVERGENCE ANGLE FOR THIS SURVEY WERE MADE AT POINT #653 WITH COORDINATES OF N=2,252,331.06, E=6,265,288.22, USING AN ELEVATION OF 1454.22(NAVD88)



**BENCHMARK**

USC & GS BENCHMARKS:  
40Y (PID #DX2103) - 3" BRASS DISK, SET IN BOULDER.

STATION IS ABOUT 4-1/2 MILES W OF LAKEVIEW, ABOUT ONE MILE W OF THE PASS THROUGH THE BERNASCONI MOUNTAINS, ABOUT 200 FEET SW OF THE INTERSECTION OF BRADLEY ROAD AND WALNUT AVENUE, 70 FEET S OF CENTER LINE OF WALNUT AVENUE, IN A LARGE BOULDER, AND MARKED WITH A TEE. MARK IS A METROPOLITAN WATER DISTRICT OF SOUTHERN CALIFORNIA STANDARD DISK STAMPED 40 Y 1931.

ELEV. = 1496.35, (NAVD 88)      NGVD88 - 2.58 = NAVD2011

**INDEX MAP**

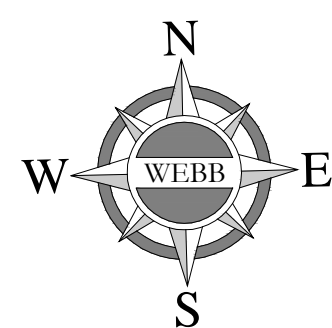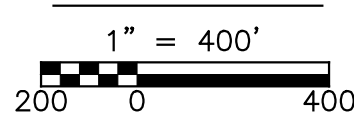

# STREET IMPROVEMENT PLANS FOR STRATFORD RANCH-PARCEL MAP 36469 AMENDED DPR NO. 11-12-0004 CITY OF PERRIS, CALIFORNIA

**AS BUILT**

THESE PLANS REFLECT ANY SUBSTANTIAL DESIGN MODIFICATIONS AS PROVIDED TO WEBB ASSOCIATES BY THE CONTRACTOR

SIGNATURE: \_\_\_\_\_ DATE: 05/19/2016




**UTILITIES:**

- WATER: EASTERN MUNICIPAL WATER DISTRICT  
PHONE: (909) 820-3713
- SEWER: EASTERN MUNICIPAL WATER DISTRICT  
PHONE: (909) 820-2525
- ELECTRIC: SOUTHERN CALIFORNIA EDISON COMPANY  
PHONE: (800) 655-4555
- TELEPHONE: GENERAL TELEPHONE COMPANY  
PHONE: (800) 834-4966
- GAS: SOUTHERN CALIFORNIA GAS COMPANY  
PHONE: (800) 427-2200

**LEGEND:**

- \*\* [Symbol] CONSTRUCT 8" AC OVER 18" AGGREGATE BASE
- [Symbol] REMOVE EXISTING AC PAVING
- \*\* [Symbol] INSTALL 8" PCC CONCRETE OVER 16" AGGREGATE BASE
- (XX.XX) EXISTING ELEVATION
- EXISTING CONTOURS
- FG FINISHED GRADE
- FL FLOW LINE
- F.S FINISH SURFACE
- GB GRADE BREAK
- HP HIGH POINT
- INV INVERT
- LP LOW POINT
- PL PROPERTY LINE
- PI POINT OF INTERSECTION
- R/W RIGHT OF WAY
- STA STATION
- TOP OF CURB
- TYF TYPICAL
- VC VERTICAL CURVE
- AP ANGLE POINT
- BCR BEGIN CURB RETURN
- ECP END CURB RETURN
- PIV POINT OF VERTICAL INTERSECTION
- MH MANHOLE
- UGE UNDERGROUND ELECTRIC

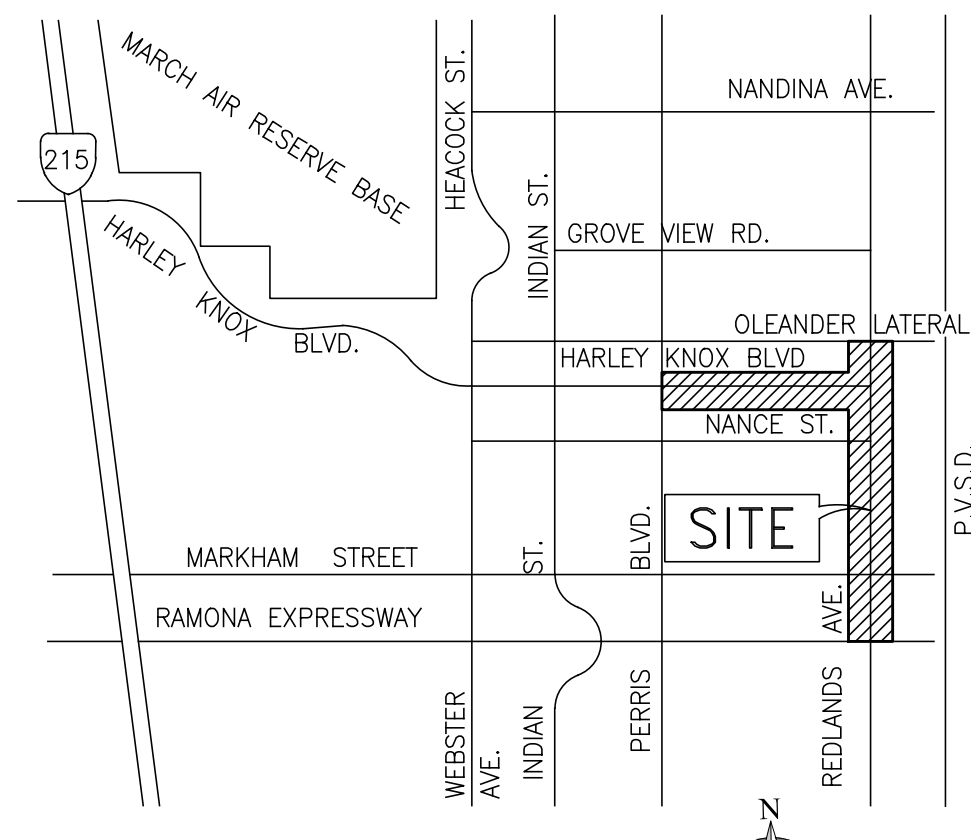


**SHEET INDEX**

- SHEET 1 TITLE SHEET
- SHEET 2 DETAILS & SECTIONS
- SHEET 3-6 PLAN & PROFILE - HARLEY KNOX BOULEVARD
- SHEET 7-13 PLAN & PROFILE - REDLANDS AVENUE
- SHEET 14 PLAN & PROFILE - RAMONA EXPRESSWAY
- SHEET 15-18 STORM DRAIN PLAN
- SHEET 19-21 CAST IN PLACE CONCRETE PIPE ALTERNATE BID
- SHEET 22 HARLEY KNOX BOULEVARD CROSS SECTIONS
- SHEET 23 REDLANDS AVENUE CROSS SECTIONS

**CONSTRUCTION NOTES AND QUANTITY ESTIMATE**

NO.	DESCRIPTION	QUANTITY	UNIT
1	CONSTRUCT MINIMUM 8" AC OVER 18" AB CLASS II (401,625 SF)	19,370 TONS AC	AC
2	CONSTRUCT MIN. 8" (4,000 PSI) PCC OVER 16" CLASS II AB (C.J. @ 20' O.C.) 122,134 SF	22,310 CY CONC.	CONC.
3	CONSTRUCT TYPE "A-8" CURB & GUTTER PER RIV. CO. STD. NO. 201	15,120	LF
4	CONSTRUCT 6" TYPE "D" CURB PER RIV. CO. STD. NO. 204	13,325	SF
5	CONSTRUCT COMMERCIAL DRIVE PER RIV. CO. STD. NO. 207A	4,550	LF
6	CONSTRUCT 6" WIDE SIDEWALK PER RIV. CO. STD. 401	30,700	LF
7	CONSTRUCT CURB RAMP PER RIV. CO. STD. NO. 403, CASE A	18	EA
8	COORD UNDERGROUNDING/RELOCATION OF PP & GUY WIRE - BY UTILITY COMPANY	5	EA
9	RELOCATE EX. UTILITY RISER - BY UTILITY COMPANY	16	EA
10	REMOVE AC PAVEMENT AND DISPOSE OF LEGALLY	1,150	SF
11	SAWCUT & JOIN EX. A.C. PAVEMENT PER DETAIL ON SHEET 2	700	LF
12	RELOCATE	4	EA
13	ADJUST TO GRADE	19	EA
14	PROTECT IN PLACE	-	-
15	INSTALL 3" AC OVER 95% COMPACTED NATIVE	1,455	SF
16	REMOVE EX. FENCE	1,900	LF
17	CONSTRUCT CROSS GUTTER PER RIV. CO. STD. NO. 209	1,425	SF
18	CONSTRUCT 6" TYPE "D-1" CURB PER RIV. CO. STD. NO. 203	-	LF
19	0.15' GRIND AND OVERLAY	3,550	SF
20	INSTALL 48" RCP (D-LOAD PER PLAN)	280	LF
21	INSTALL 36" RCP (D-LOAD PER PLAN)	860	LF
22	INSTALL 24" RCP (D-LOAD PER PLAN)	2,110	LF
23	INSTALL 18" RCP (D-LOAD PER PLAN)	560	LF
24	CONSTRUCT JUNCTION STRUCTURE NO 2 PER RFC&WCD STD. JS227	6	EA
25	CONSTRUCT JUNCTION STRUCTURE NO 3 PER RFC&WCD STD. JS228	1	EA
26	CONSTRUCT JUNCTION STRUCTURE NO 4 PER RFC&WCD STD. JS229	1	EA
27	CONSTRUCT CURB INLET CATCH BASIN PER RIV. CO. STD. NO. 300	17	EA
28	CONSTRUCT LOCAL DEPRESSION PER RIV. CO. STD. NO. 311	17	EA
29	CONSTRUCT MANHOLE NO.1 PER RFC&WCD STD. MH251	5	EA
30	CONSTRUCT MANHOLE NO.2 PER RFC&WCD STD. MH252	2	EA
31	CONSTRUCT MANHOLE NO.4 PER RFC&WCD STD. MH254	4	EA
32	CONSTRUCT DRAINAGE INLET TYPE G3 PER CALTRANS PLAN D73, AND DETAIL ON SHEET 2	1	EA
33	REMOVE CONCRETE BULKHEAD	1	EA
34	INSTALL 12" DIA. HDPE N-12 STORM DRAIN PIPE ("ADS" OR APPROVED EQUAL)	190	LF
35	INSTALL 18" DRAIN BASIN ("NYLOPLAST" OR EQUAL) WITH DOME GRATE	6	EA
36	REMOVE BACKFLOW AND SERVICE. COORDINATE WITH EMWD	1	EA
37	CONSTRUCT 8" THICK CONCRETE CLASS 560-C-3250; "B" AGGREGATE GRADATION 4	EA	
38	CONSTRUCT BUS TURNOUT PER RIV. CO. STD. NO. 814	2	EA
39	INSTALL 48" CIPCD PER MANUFACTURES SPECS	280	LF
40	INSTALL 36" CIPCD PER MANUFACTURES SPECS	860	LF
41	INSTALL 24" CIPCD PER MANUFACTURES SPECS	1,300	LF
42	INSTALL 6" SLURRY BACKFILL (2 SACK)	395	LF
43	INSTALL CONCRETE COLLAR PER RFC&WCD STD. M803	1	EA
44	INSTALL 24" CMP HEL-COR PIPE ("CONTECH" OR APPROVED EQUAL)	100	LF
45	INSTALL 24" FLARED END SECTION ("CONTECH" OR APPROVED EQUAL)	2	EA
46	CONSTRUCT CONCRETE BULKHEAD	1	EA
47	CONSTRUCT MODIFIED GRATING CATCH BASIN PER SPPWC STD 303-3 AND DETAIL ON SHEET 16	1	EA
48	CONSTRUCT LOCAL DEPRESSION PER SPPWC STD 313-3 CASE C	1	EA


THE QUANTITY ESTIMATE SHOWN HEREON IS FOR THE USE OF GOVERNING AGENCIES IN DETERMINING BOND AMOUNT AND/OR FEES AND IS NOT TO BE USED FOR BID PURPOSES.  
\*\* SEE GENERAL NOTE NO. 9

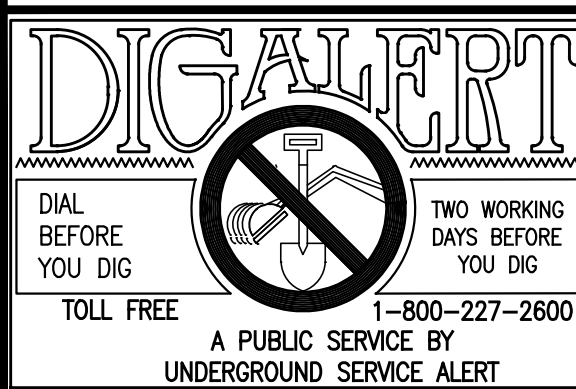

**NOTE:**  
WORK CONTAINED WITHIN THESE PLANS SHALL NOT COMMENCE UNTIL AN ENCROACHMENT PERMIT AND/OR A GRADING PERMIT HAS BEEN ISSUED.  
THE PRIVATE ENGINEER SIGNING THESE PLANS IS RESPONSIBLE FOR ASSURING THE ACCURACY AND ACCEPTABILITY OF THE DESIGN HEREON. IN THE EVENT OF DISCREPANCIES ARISING AFTER CITY APPROVAL OR DURING CONSTRUCTION, THE PRIVATE ENGINEER SHALL BE RESPONSIBLE FOR DETERMINING AN ACCEPTABLE SOLUTION AND REVISING THE PLANS FOR APPROVAL BY THE CITY.

MARK	BY	DATE	REVISIONS	APPR.	DATE
△	DJ	5/29/15	CATCH BASIN REVISED PER FIELD CONDITIONS		
△	DJ	3/5/15	ADDED CONSTRUCTION NOTE		

CITY OF PERRIS  
APPROVED BY: \_\_\_\_\_  
CITY ENGINEER  
DATE: \_\_\_\_\_

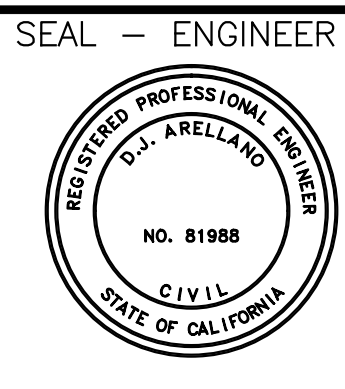


SEAL - ENGINEER  
**ALBERT A. WEBB ASSOCIATES**  
ENGINEERING CONSULTANTS  
3788 McCRAY STREET  
RIVERSIDE, CA. 92506  
PH. (951) 686-1070  
FAX (951) 788-1256  
UNDER THE SUPERVISION OF: \_\_\_\_\_  
D.J. ARELLANO R.C.E. #C81988 DATE 1/12/2015


BENCHMARK:  
SEE HEREON  
SCALE:  
H: AS SHOWN V: AS SHOWN

CITY OF PERRIS  
AMENDED DPR NO. 11-12-0004  
STRATFORD RANCH-PARCEL MAP 36469  
STREET IMPROVEMENT PLAN  
TITLE SHEET


SHEET NO. 1  
OF 23 SHEETS  
P8-1189

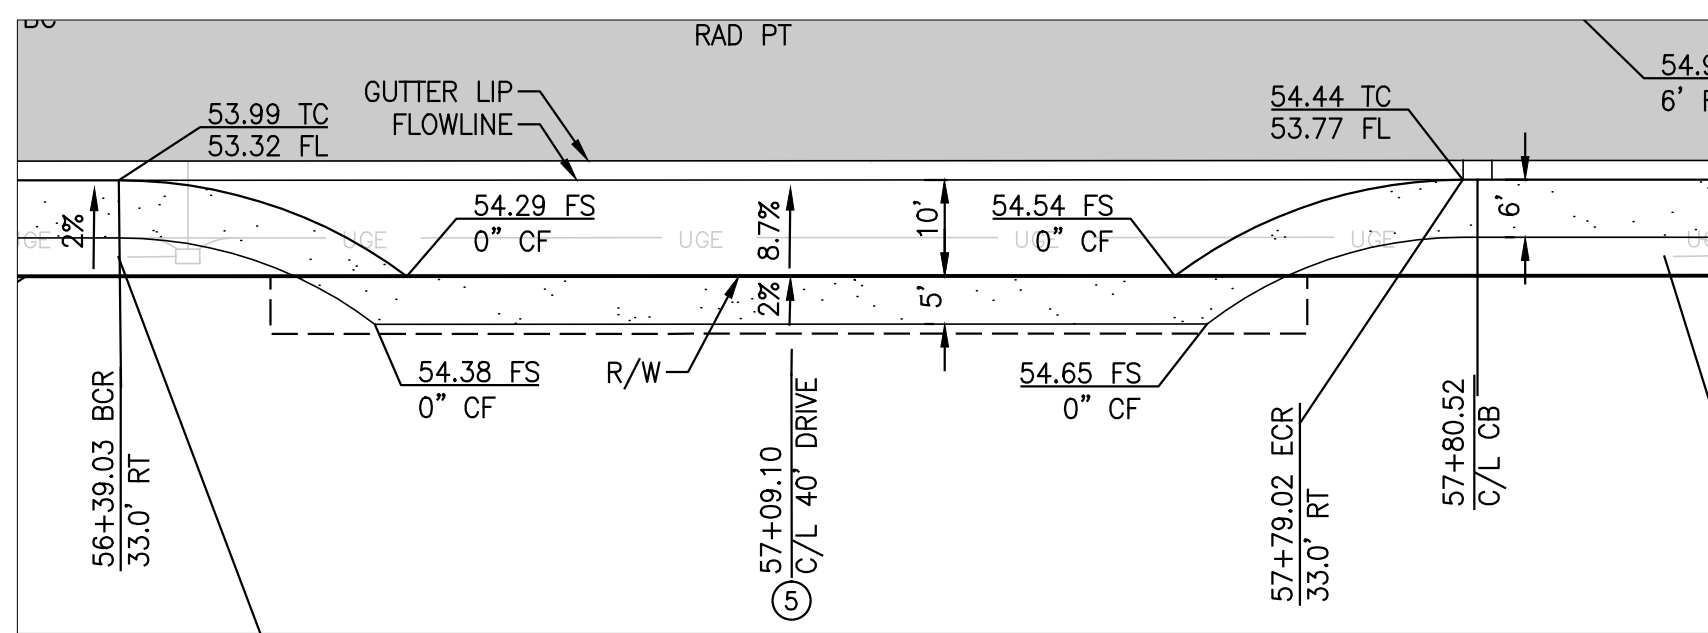


**DETAIL 1**  
NOT TO SCALE

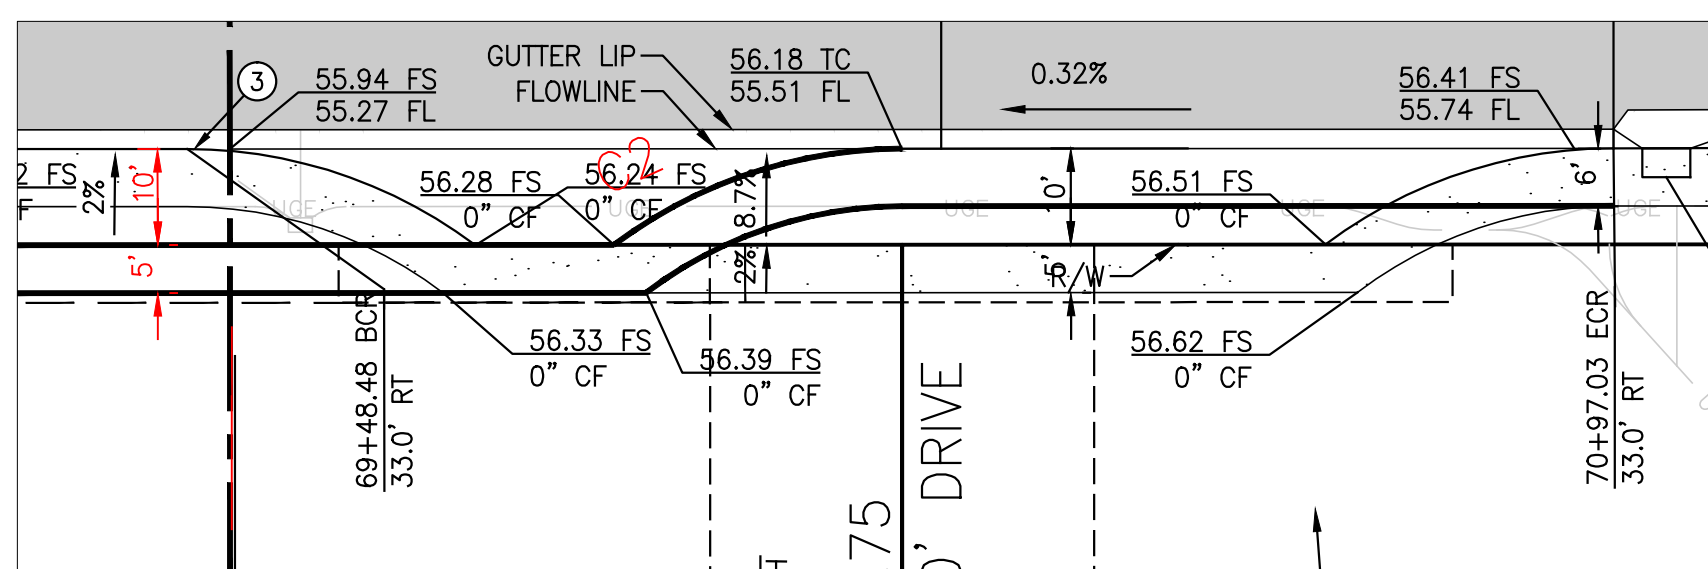


**DETAIL 2**  
NOT TO SCALE

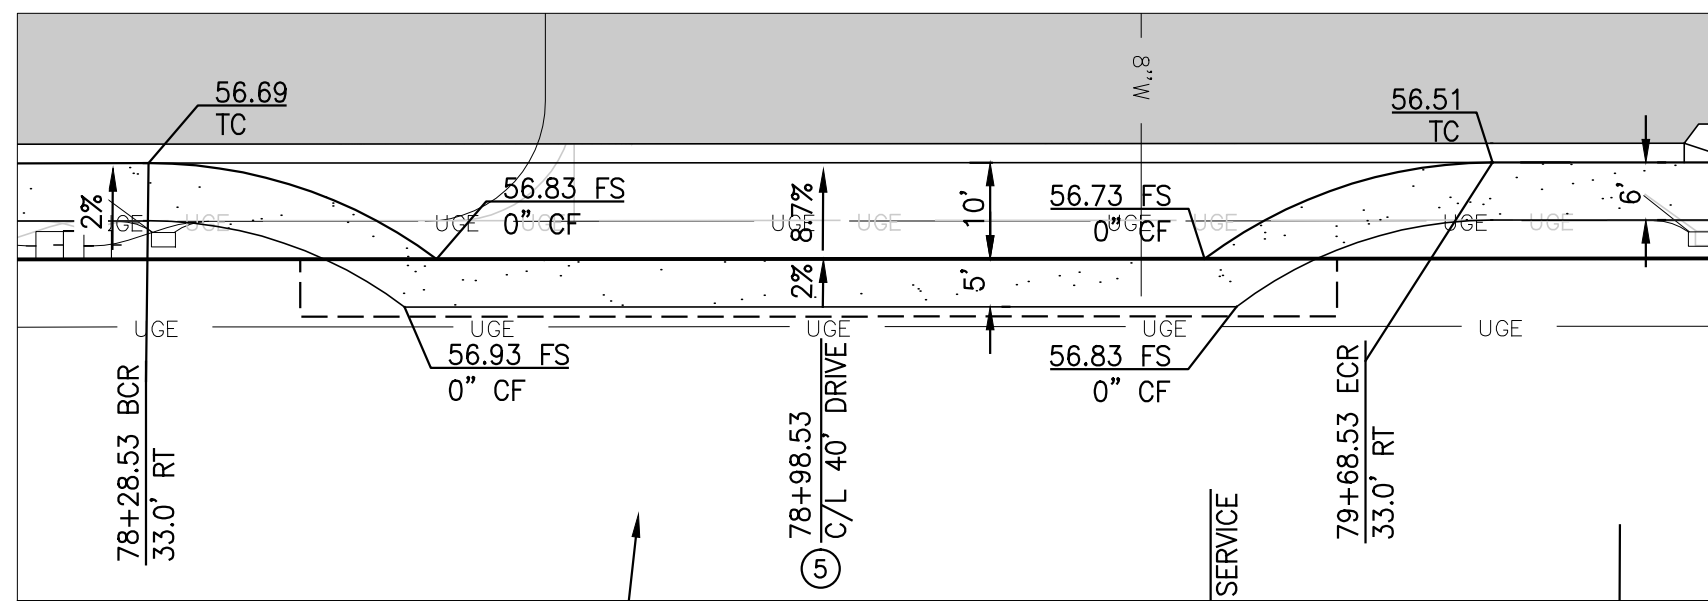


**DETAIL 3**  
NOT TO SCALE

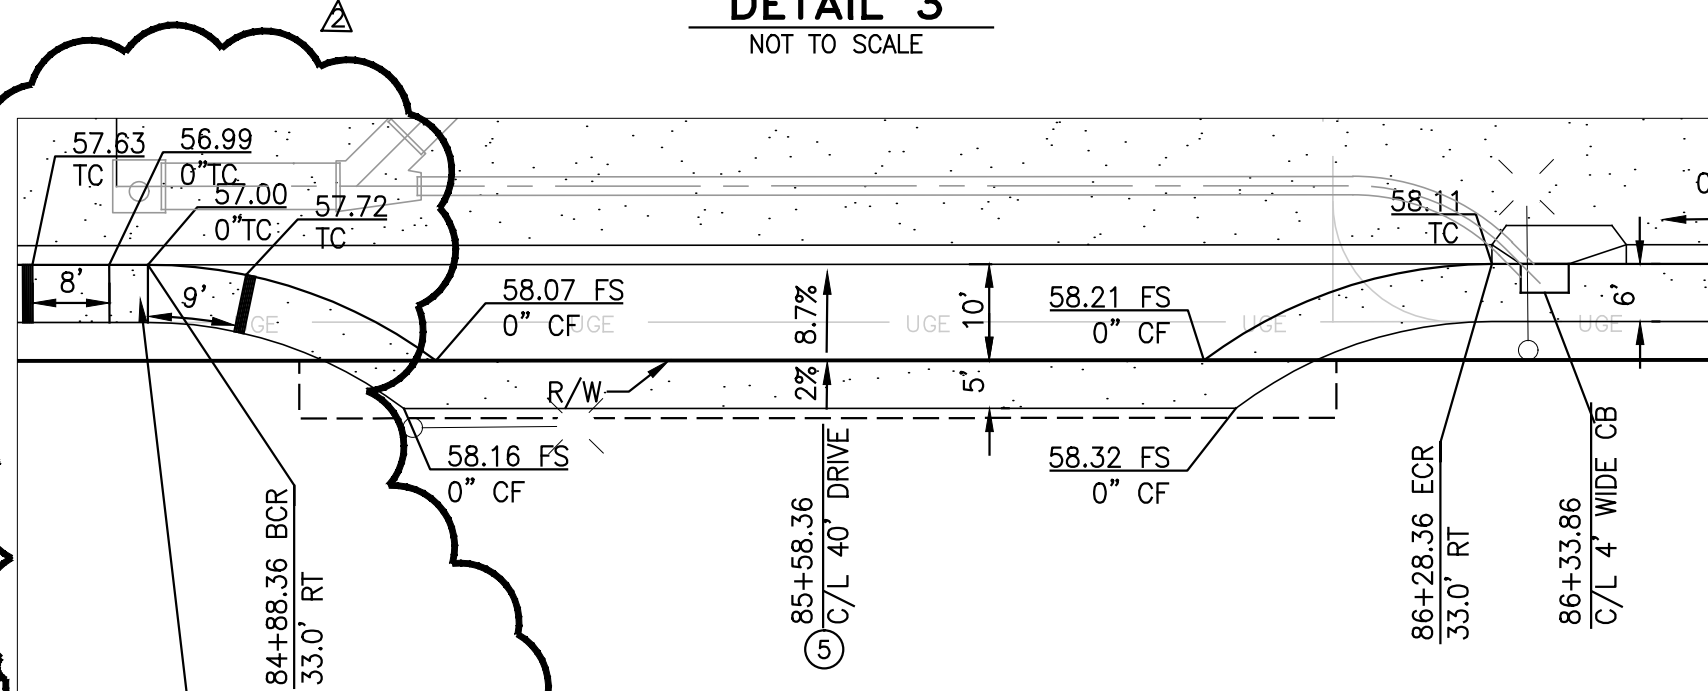


**DETAIL 4**  
NOT TO SCALE

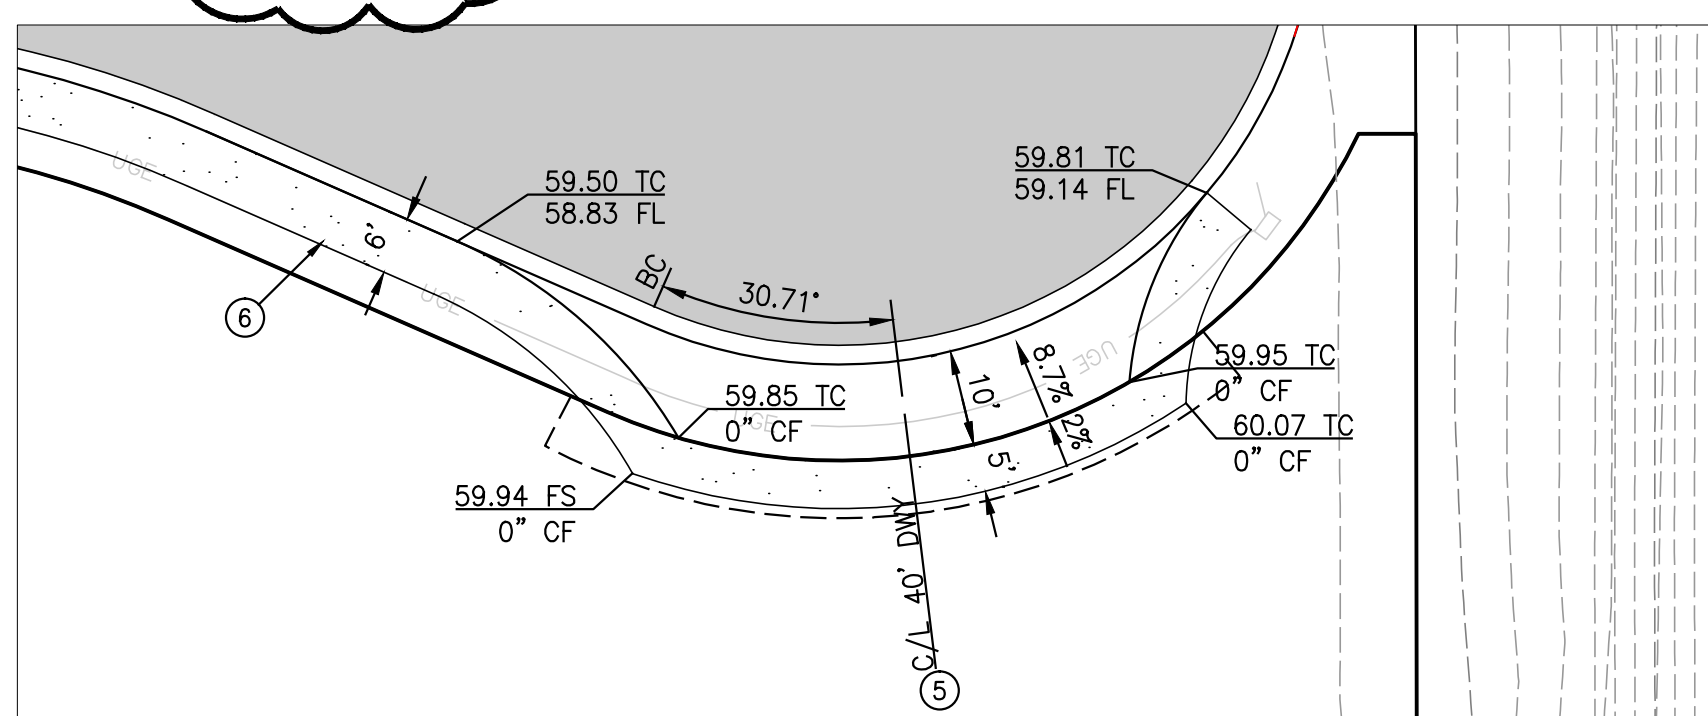


**DETAIL 5**  
NOT TO SCALE

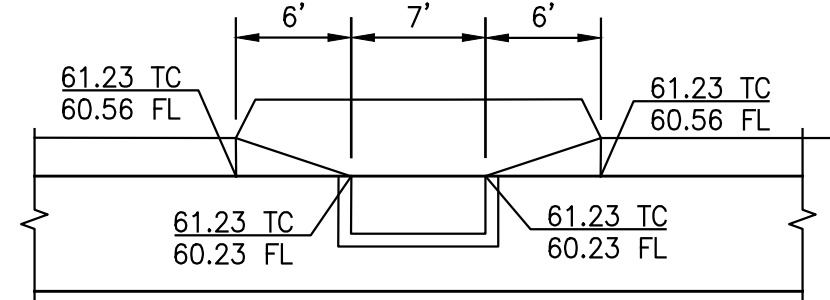


**LOCAL DEPRESSION DETAIL**  
AT STA 94+90 HARLEY KNOX BLVD  
NOT TO SCALE

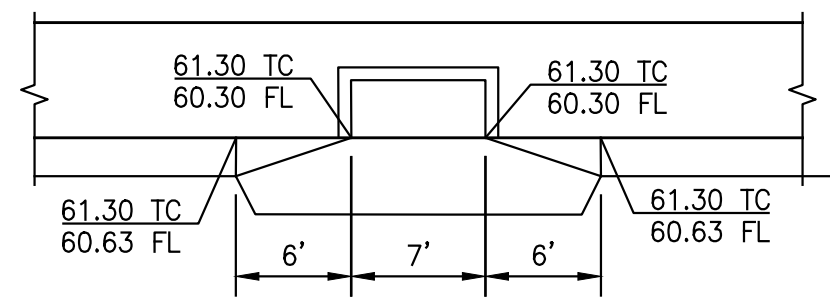


**LOCAL DEPRESSION DETAIL**  
AT STA 95+30 HARLEY KNOX BLVD  
NOT TO SCALE

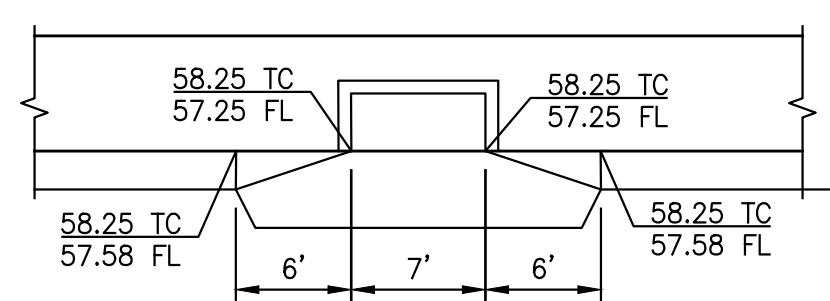


**LOCAL DEPRESSION DETAIL**  
AT STA 108+50 HARLEY KNOX BLVD  
NOT TO SCALE

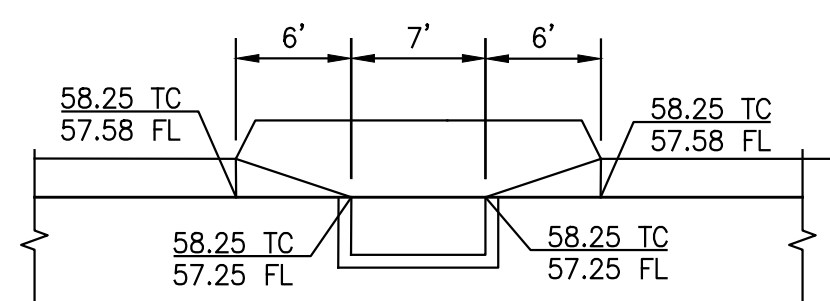


**LOCAL DEPRESSION DETAIL**  
AT STA 108+50 HARLEY KNOX BLVD  
NOT TO SCALE

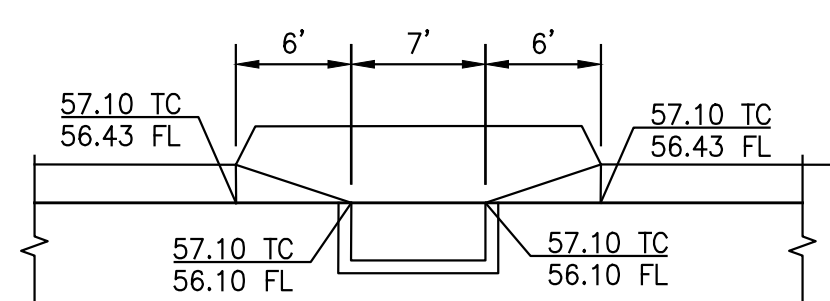


**LOCAL DEPRESSION DETAIL**  
AT STA 117+25 HARLEY KNOX BLVD  
NOT TO SCALE

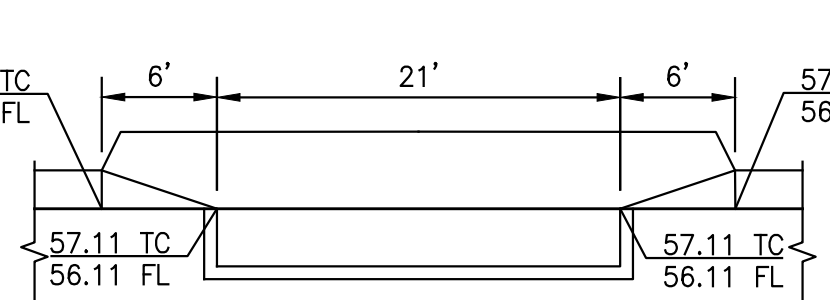


**LOCAL DEPRESSION DETAIL**  
AT STA 117+25 HARLEY KNOX BLVD  
NOT TO SCALE

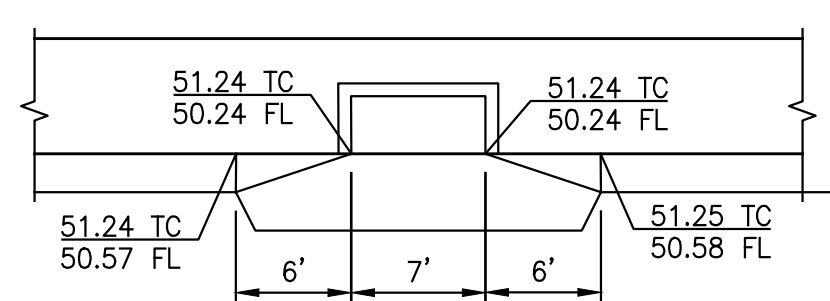


**LOCAL DEPRESSION DETAIL**  
AT STA 47+25 REDLANDS AVE  
NOT TO SCALE

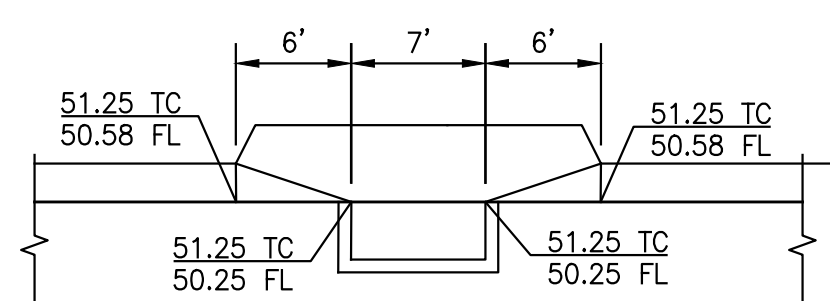


**LOCAL DEPRESSION DETAIL**  
AT STA 47+25 REDLANDS AVE  
NOT TO SCALE

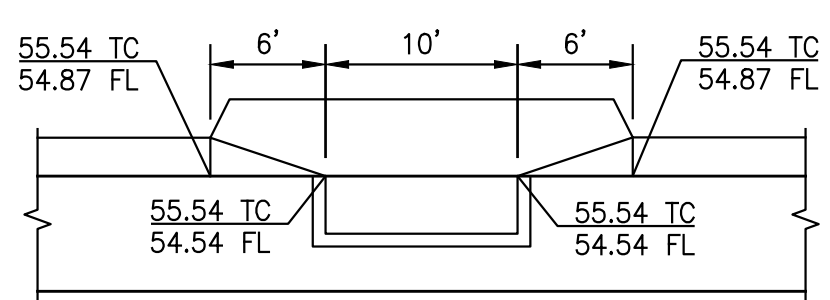


**LOCAL DEPRESSION DETAIL**  
AT STA 67+50 REDLANDS AVE  
NOT TO SCALE

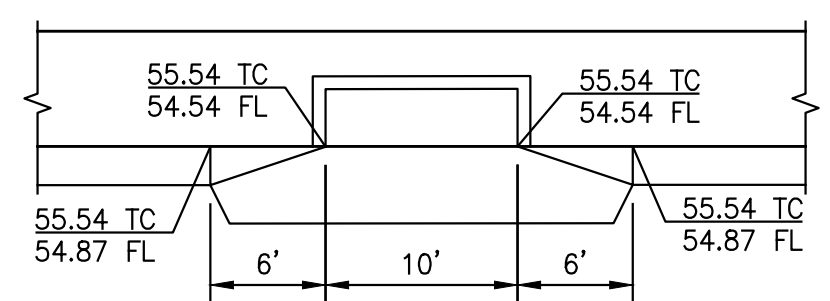


**LOCAL DEPRESSION DETAIL**  
AT STA 67+50 REDLANDS AVE  
NOT TO SCALE

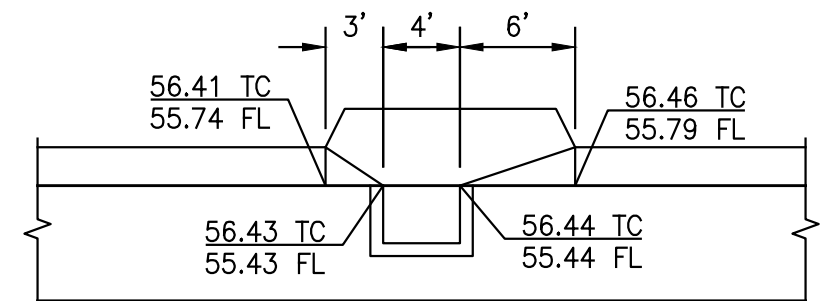


**LOCAL DEPRESSION DETAIL**  
AT STA 71+02.53 REDLANDS AVE  
NOT TO SCALE

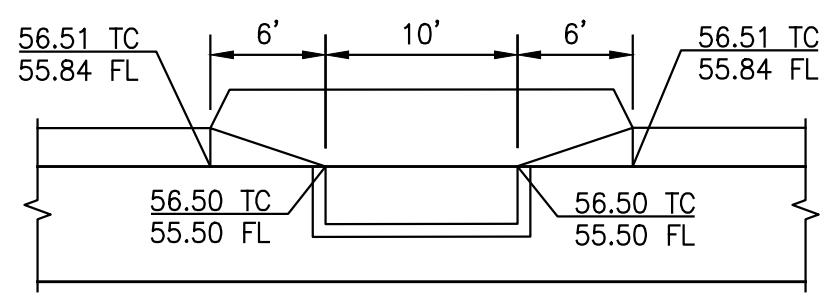


**LOCAL DEPRESSION DETAIL**  
AT STA 80+00 REDLANDS AVE  
NOT TO SCALE

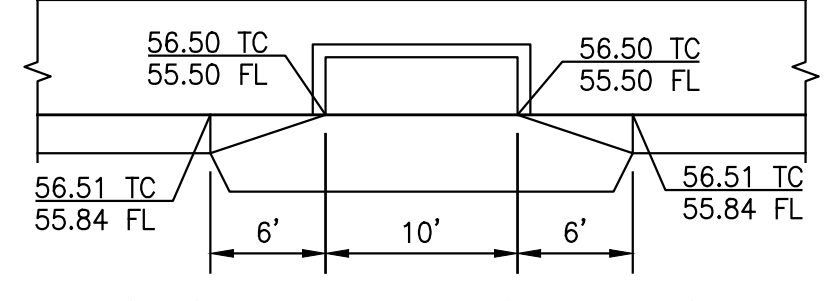


**LOCAL DEPRESSION DETAIL**  
AT STA 80+00 REDLANDS AVE  
NOT TO SCALE

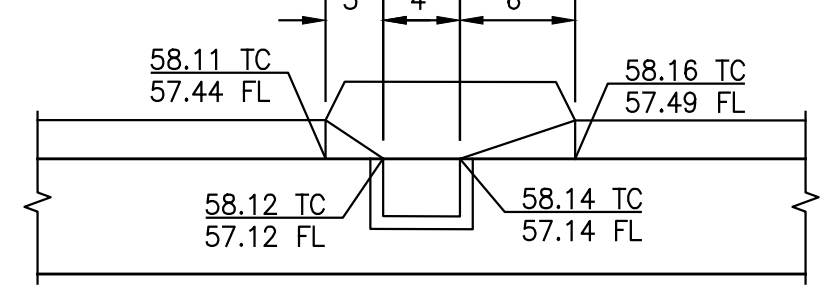


**LOCAL DEPRESSION DETAIL**  
AT STA 86+33.86 REDLANDS AVE  
NOT TO SCALE

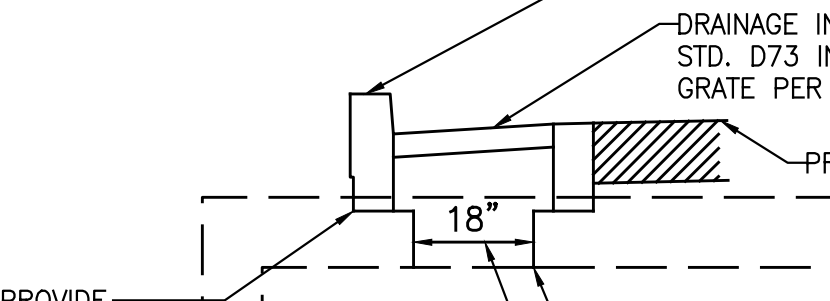


**LOCAL DEPRESSION DETAIL**  
AT STA 86+33.86 REDLANDS AVE  
NOT TO SCALE

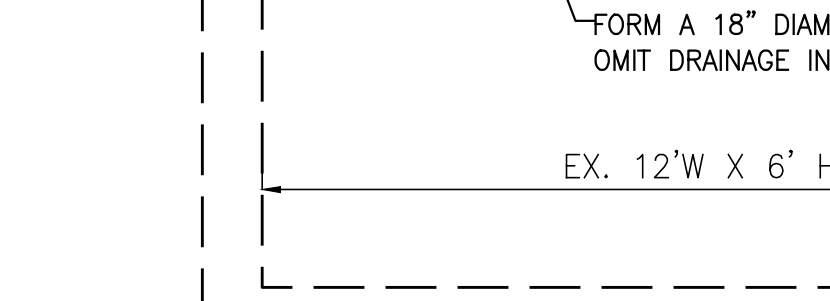


**LOCAL DEPRESSION DETAIL**  
AT STA 86+33.86 REDLANDS AVE  
NOT TO SCALE

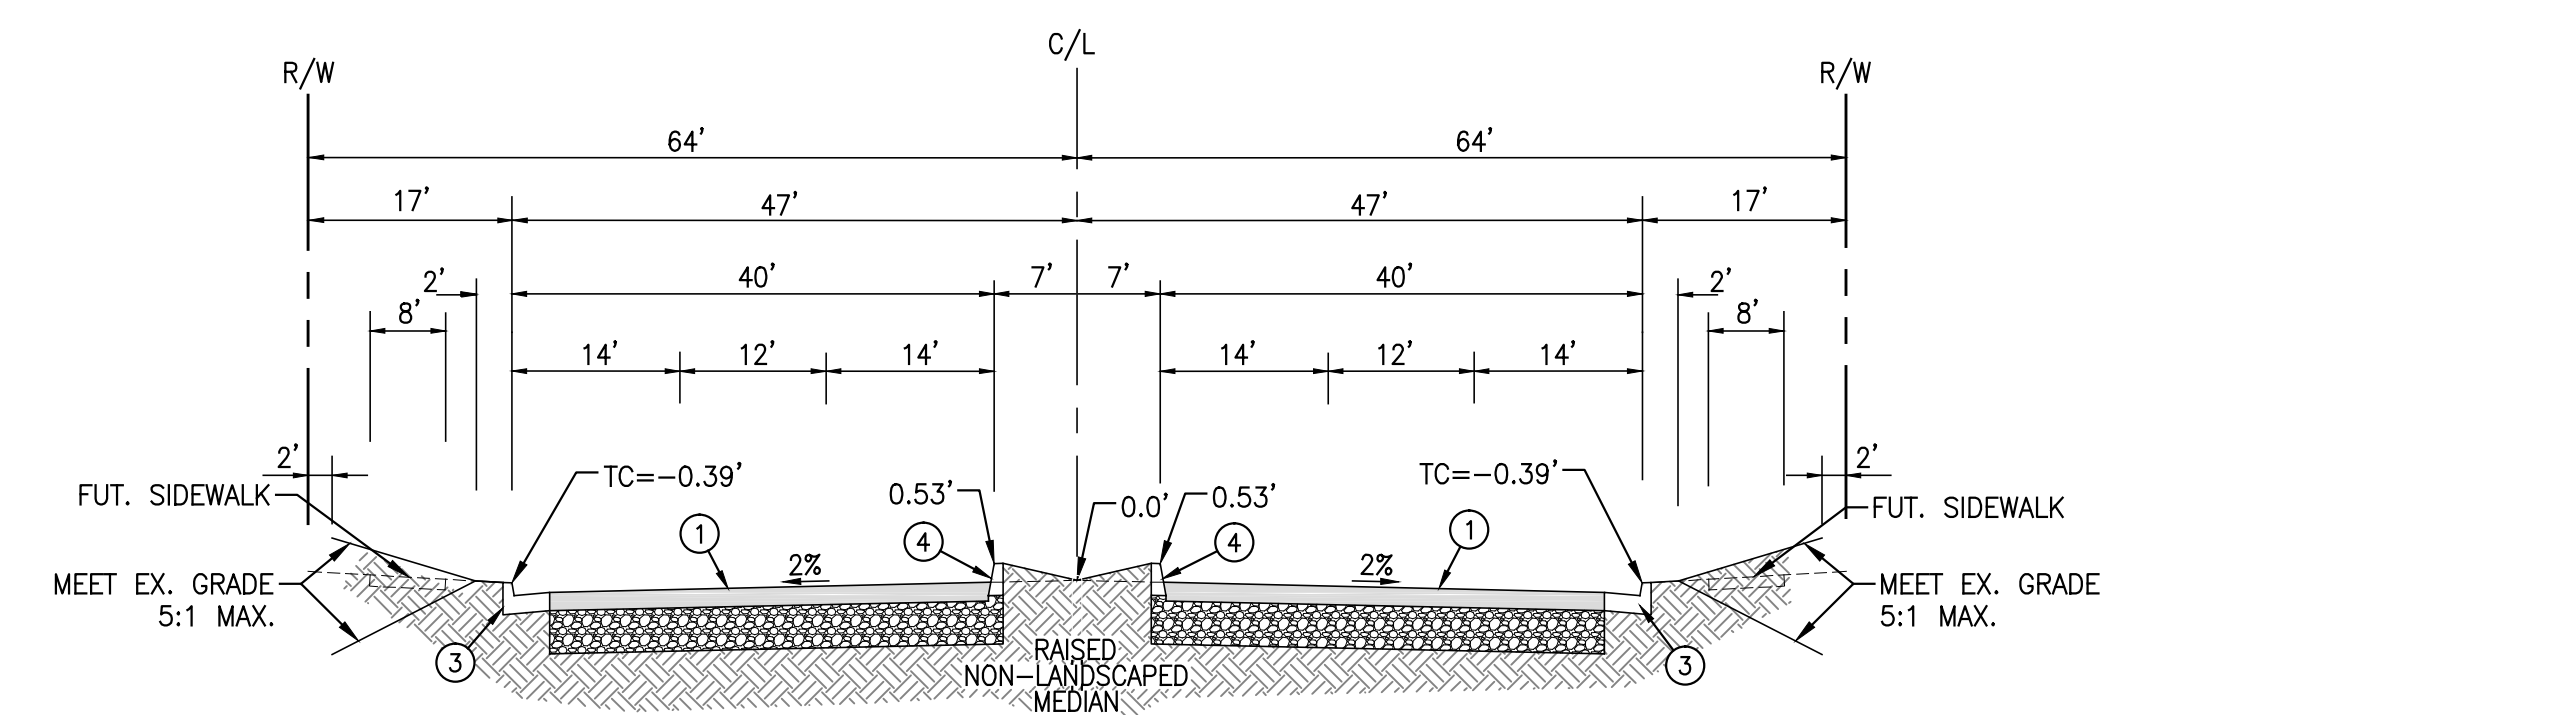


**TYPICAL SECTION HARLEY KNOX BLVD.**  
NOT TO SCALE  
T.I. = 11

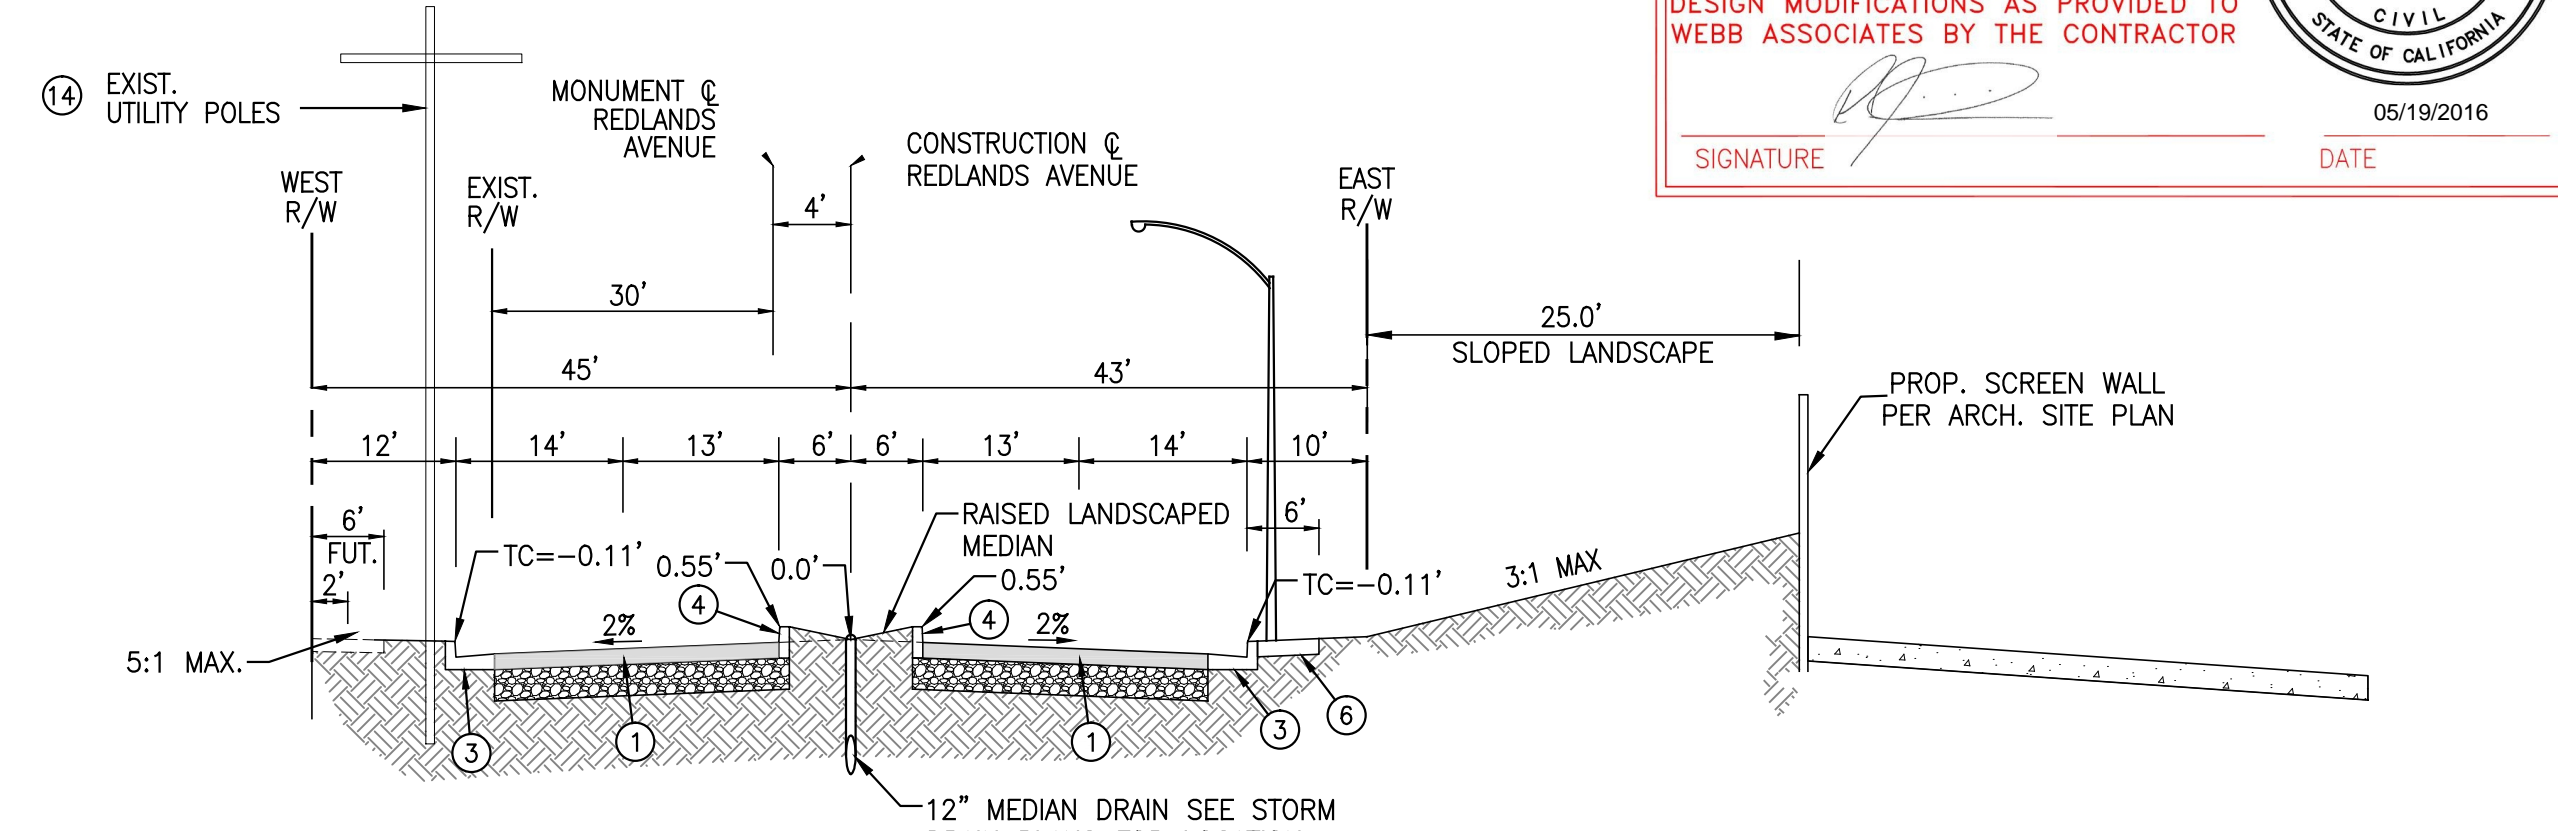


**TYPICAL SECTION REDLANDS AVENUE**  
NOT TO SCALE

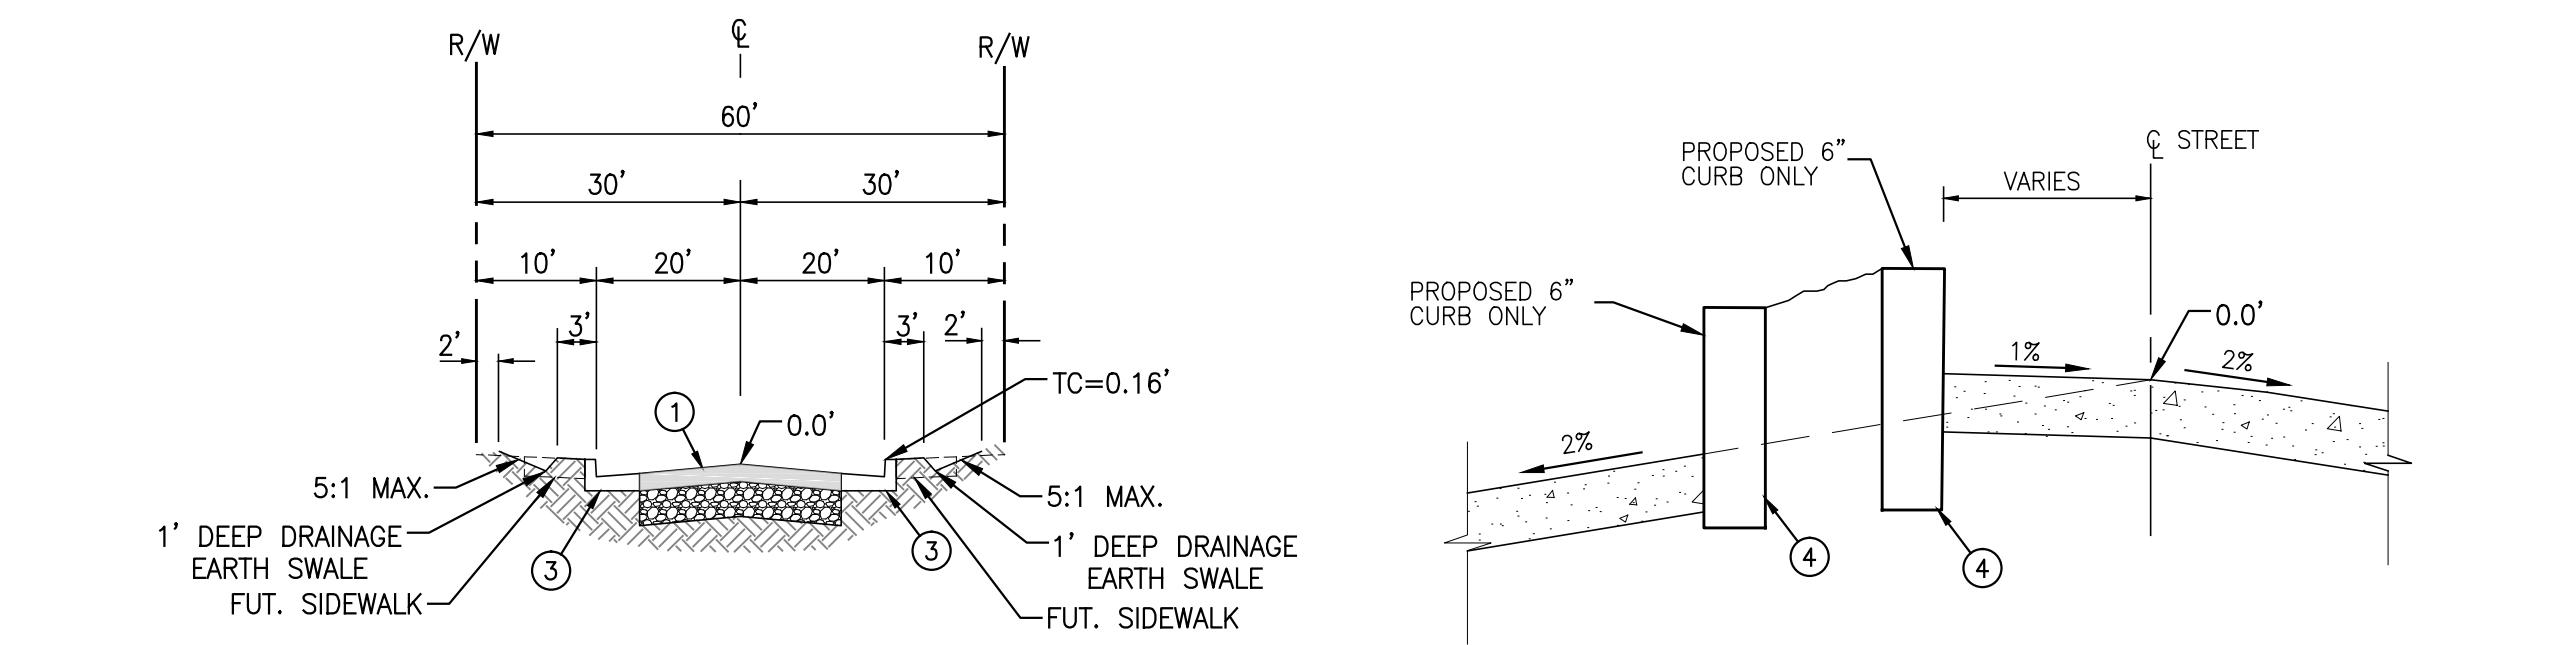


**TYPICAL SECTION NANCE STREET & PERRY STREET**  
NOT TO SCALE

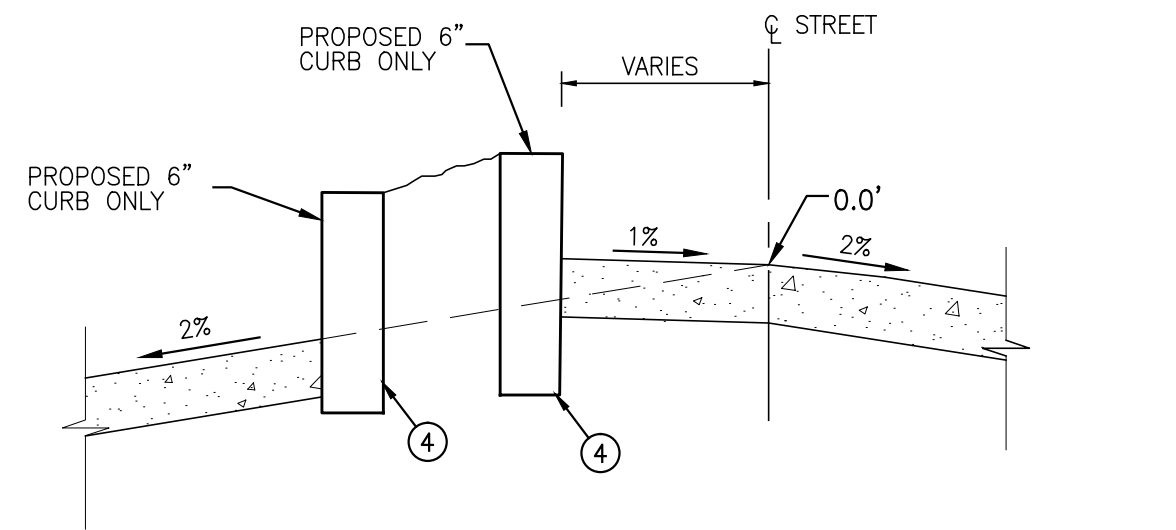

**LEFT TURN POCKET PAVING DETAIL**  
NOT TO SCALE

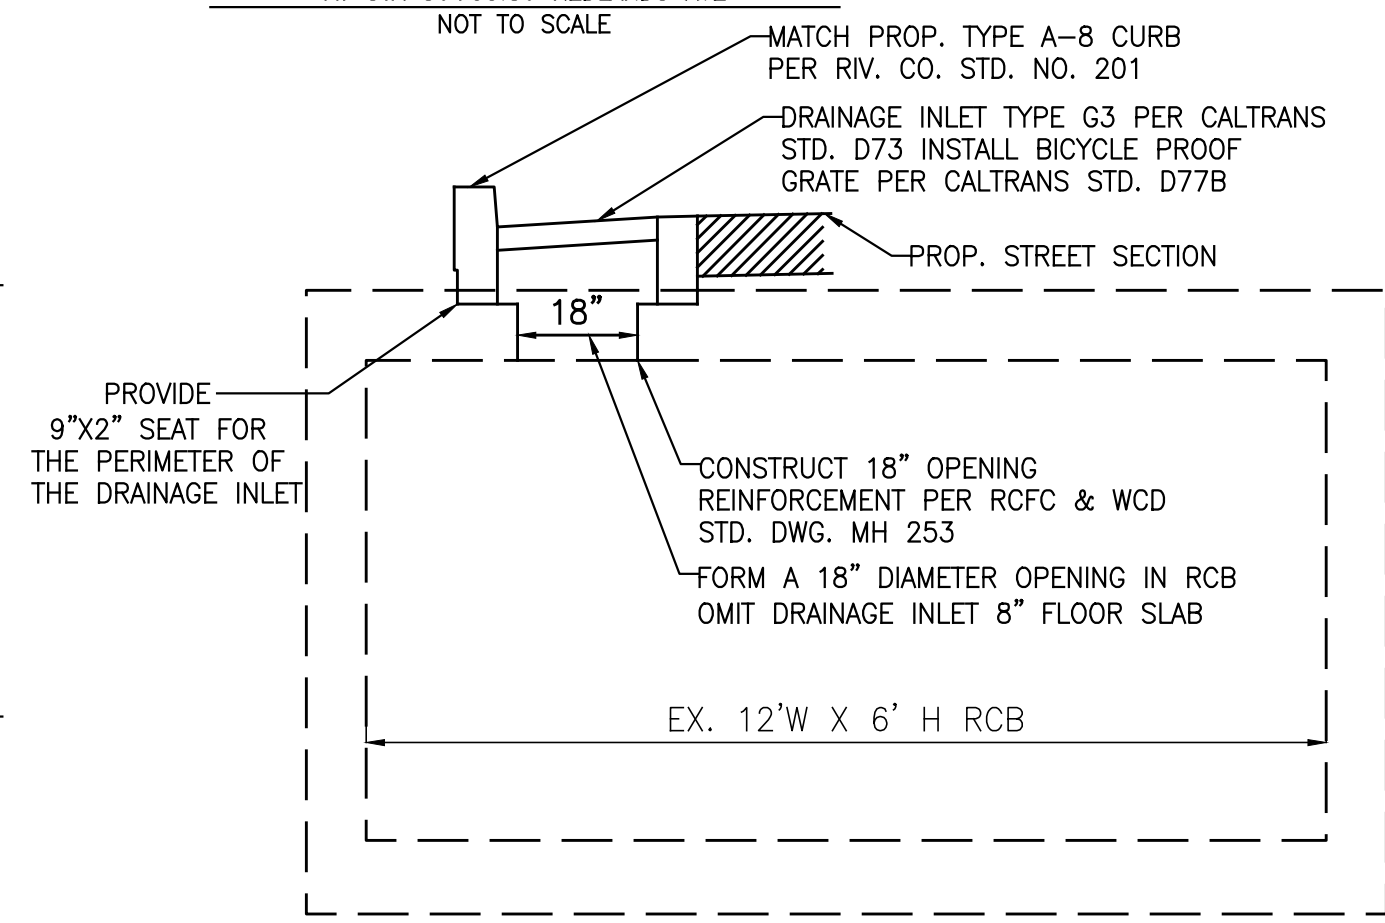

**32 DROP INLET DETAIL**  
NOT TO SCALE  
REDLANDS AVE. STA. 57+80.52

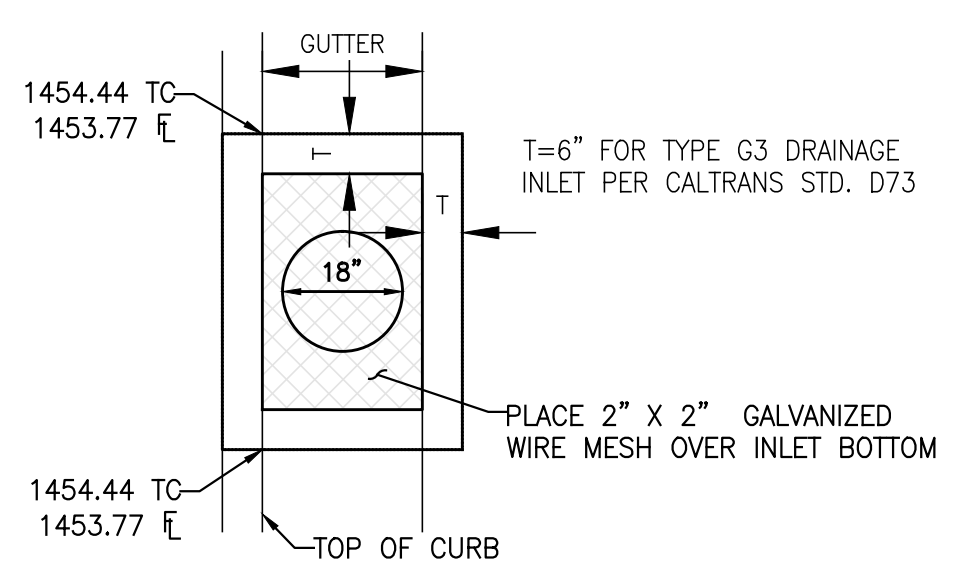

**11 SAWCUT & JOIN DETAIL**  
NOT TO SCALE

**AS BUILT**

THESE PLANS REFLECT ANY SUBSTANTIAL DESIGN MODIFICATIONS AS PROVIDED TO WEBB ASSOCIATES BY THE CONTRACTOR

SIGNATURE: *[Signature]* DATE: 05/19/2016

REGISTERED PROFESSIONAL ENGINEER  
D.J. ARELLANO  
NO. 81988  
CIVIL  
STATE OF CALIFORNIA

**DIG ALERT**

DIAL BEFORE YOU DIG

TWO WORKING DAYS BEFORE YOU DIG

TOLL FREE 1-800-227-2600

A PUBLIC SERVICE BY UNDERGROUND SERVICE ALERT

**NOTE:**

WORK CONTAINED WITHIN THESE PLANS SHALL NOT COMMENCE UNTIL AN ENCROACHMENT PERMIT AND/OR A GRADING PERMIT HAS BEEN ISSUED.

THE PRIVATE ENGINEER SIGNING THESE PLANS IS RESPONSIBLE FOR ASSURING THE ACCURACY AND ACCEPTABILITY OF THE DESIGN HEREON. IN THE EVENT OF DISCREPANCIES ARISING AFTER CITY APPROVAL OR DURING CONSTRUCTION, THE PRIVATE ENGINEER SHALL BE RESPONSIBLE FOR DETERMINING AN ACCEPTABLE SOLUTION AND REVISING THE PLANS FOR APPROVAL BY THE CITY.

MARK	BY	DATE	REVISIONS	APPR.	DATE
DJ	DJ	5/4/15	REVISE CURB RAMP TO CO STD. 403		

APPR.	DATE

SEAL - ENGINEER

REGISTERED PROFESSIONAL ENGINEER  
D.J. ARELLANO  
NO. 81988  
CIVIL  
STATE OF CALIFORNIA

**ALBERT A. WEBB ASSOCIATES**

ENGINEERING CONSULTANTS  
3788 McCRAIG STREET  
RIVERSIDE CA. 92506  
PH. (951) 686-1070  
FAX (951) 788-1256

UNDER THE SUPERVISION OF:

*[Signature]*

D.J. ARELLANO R.C.E. #C81988 DATE 1/12/2015

BENCHMARK: SEE SHEET 1

SCALE: H: AS SHOWN V: AS SHOWN

CITY OF PERRIS

AMENDED DPR NO. 11-12-0004

STRATFORD RANCH-PARCEL MAP 36469




SECTIONS AND DETAILS

FOR: IDI W.O. 2013-0239 CITY FILE NO. P8-1189

SHEET NO. 2

OF 23 SHEETS

G:\2013\13-0239\DRAWINGS\AS-BUILT\13-0239-C-ST-AS-BUILD.DWG 5/18/2016 8:28 AM

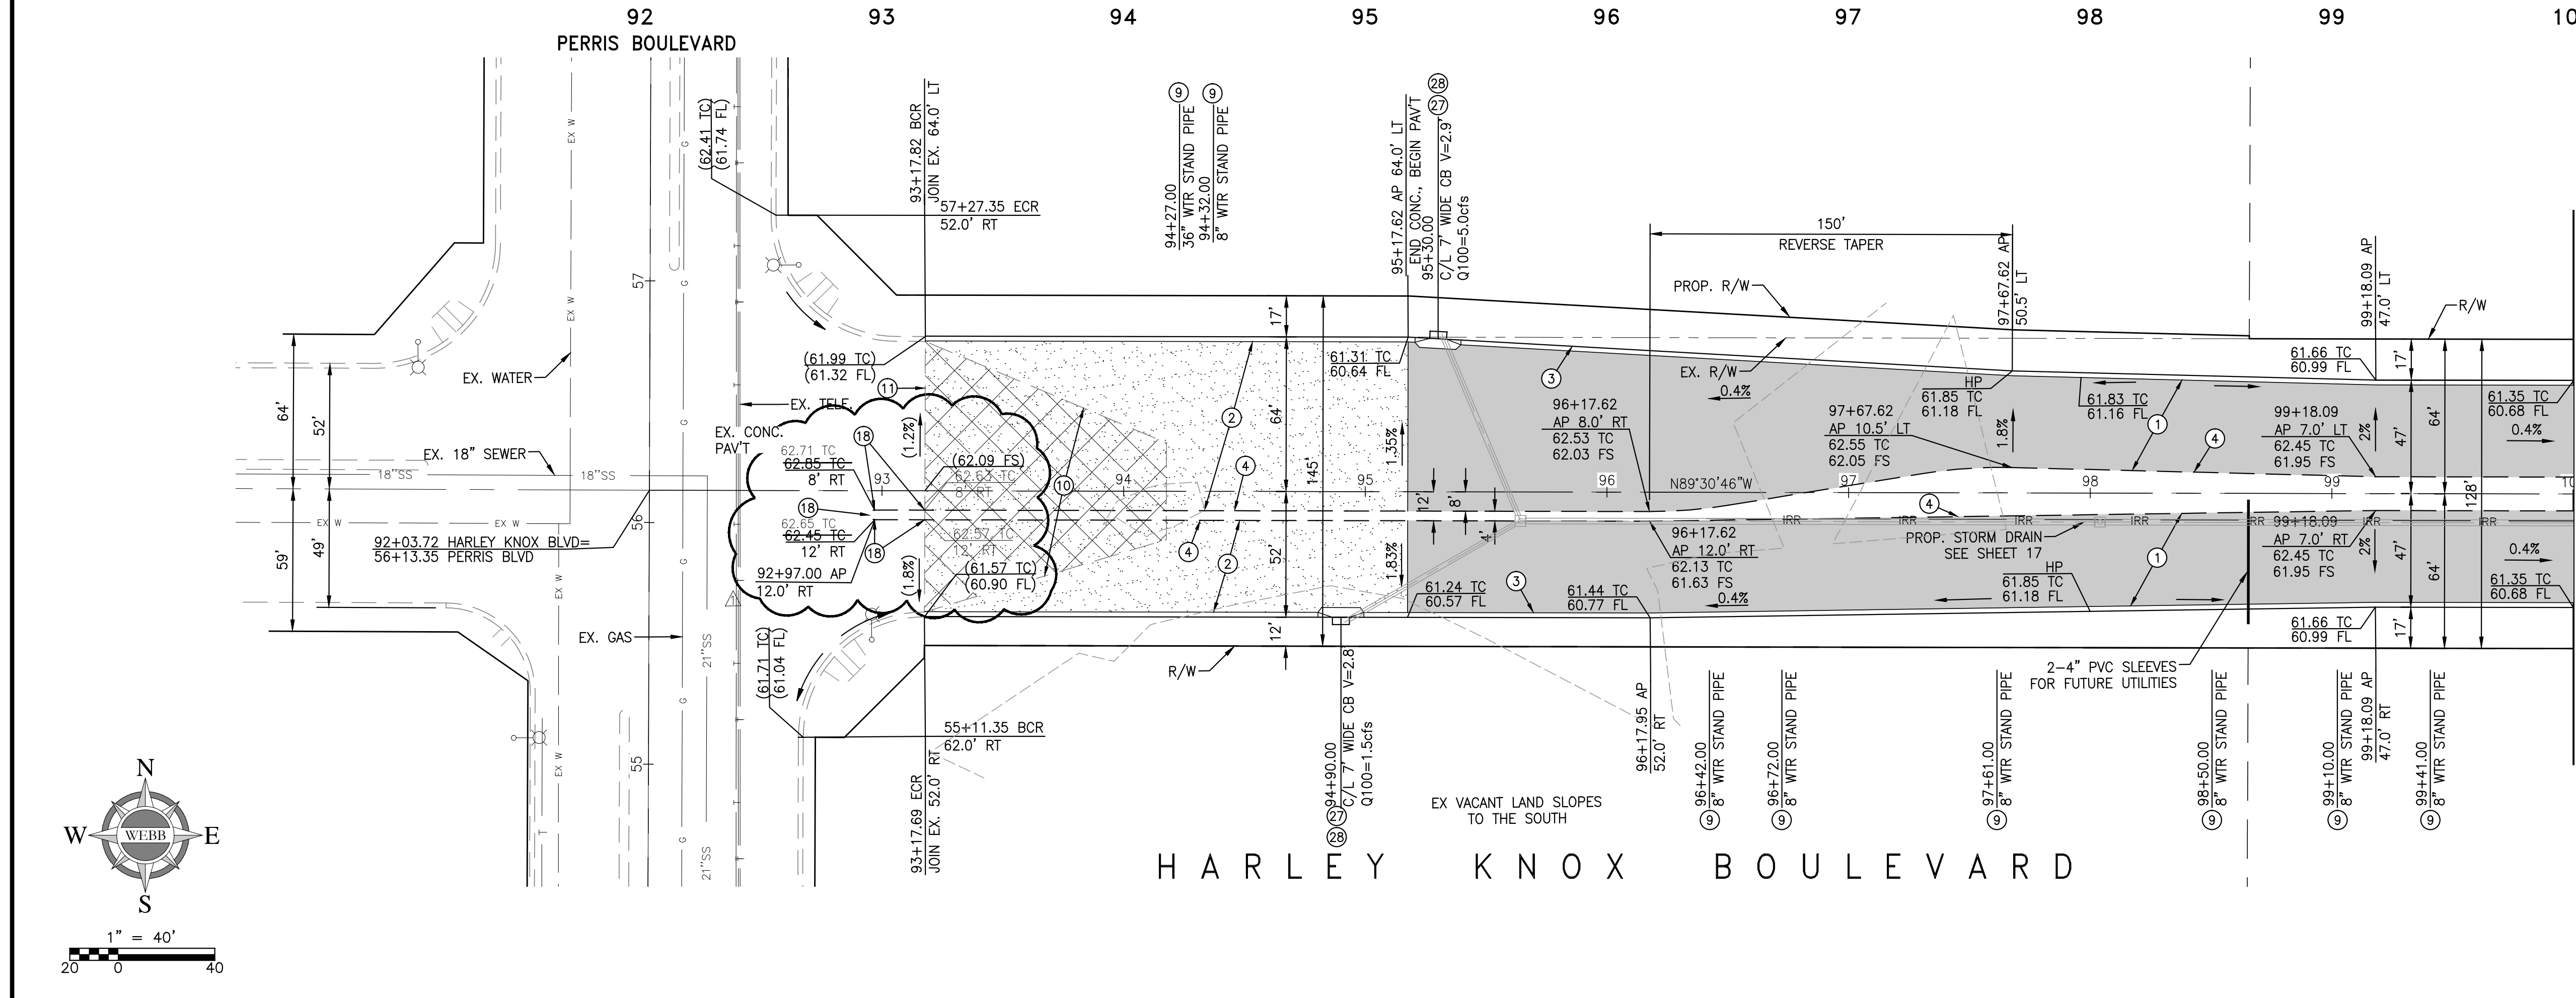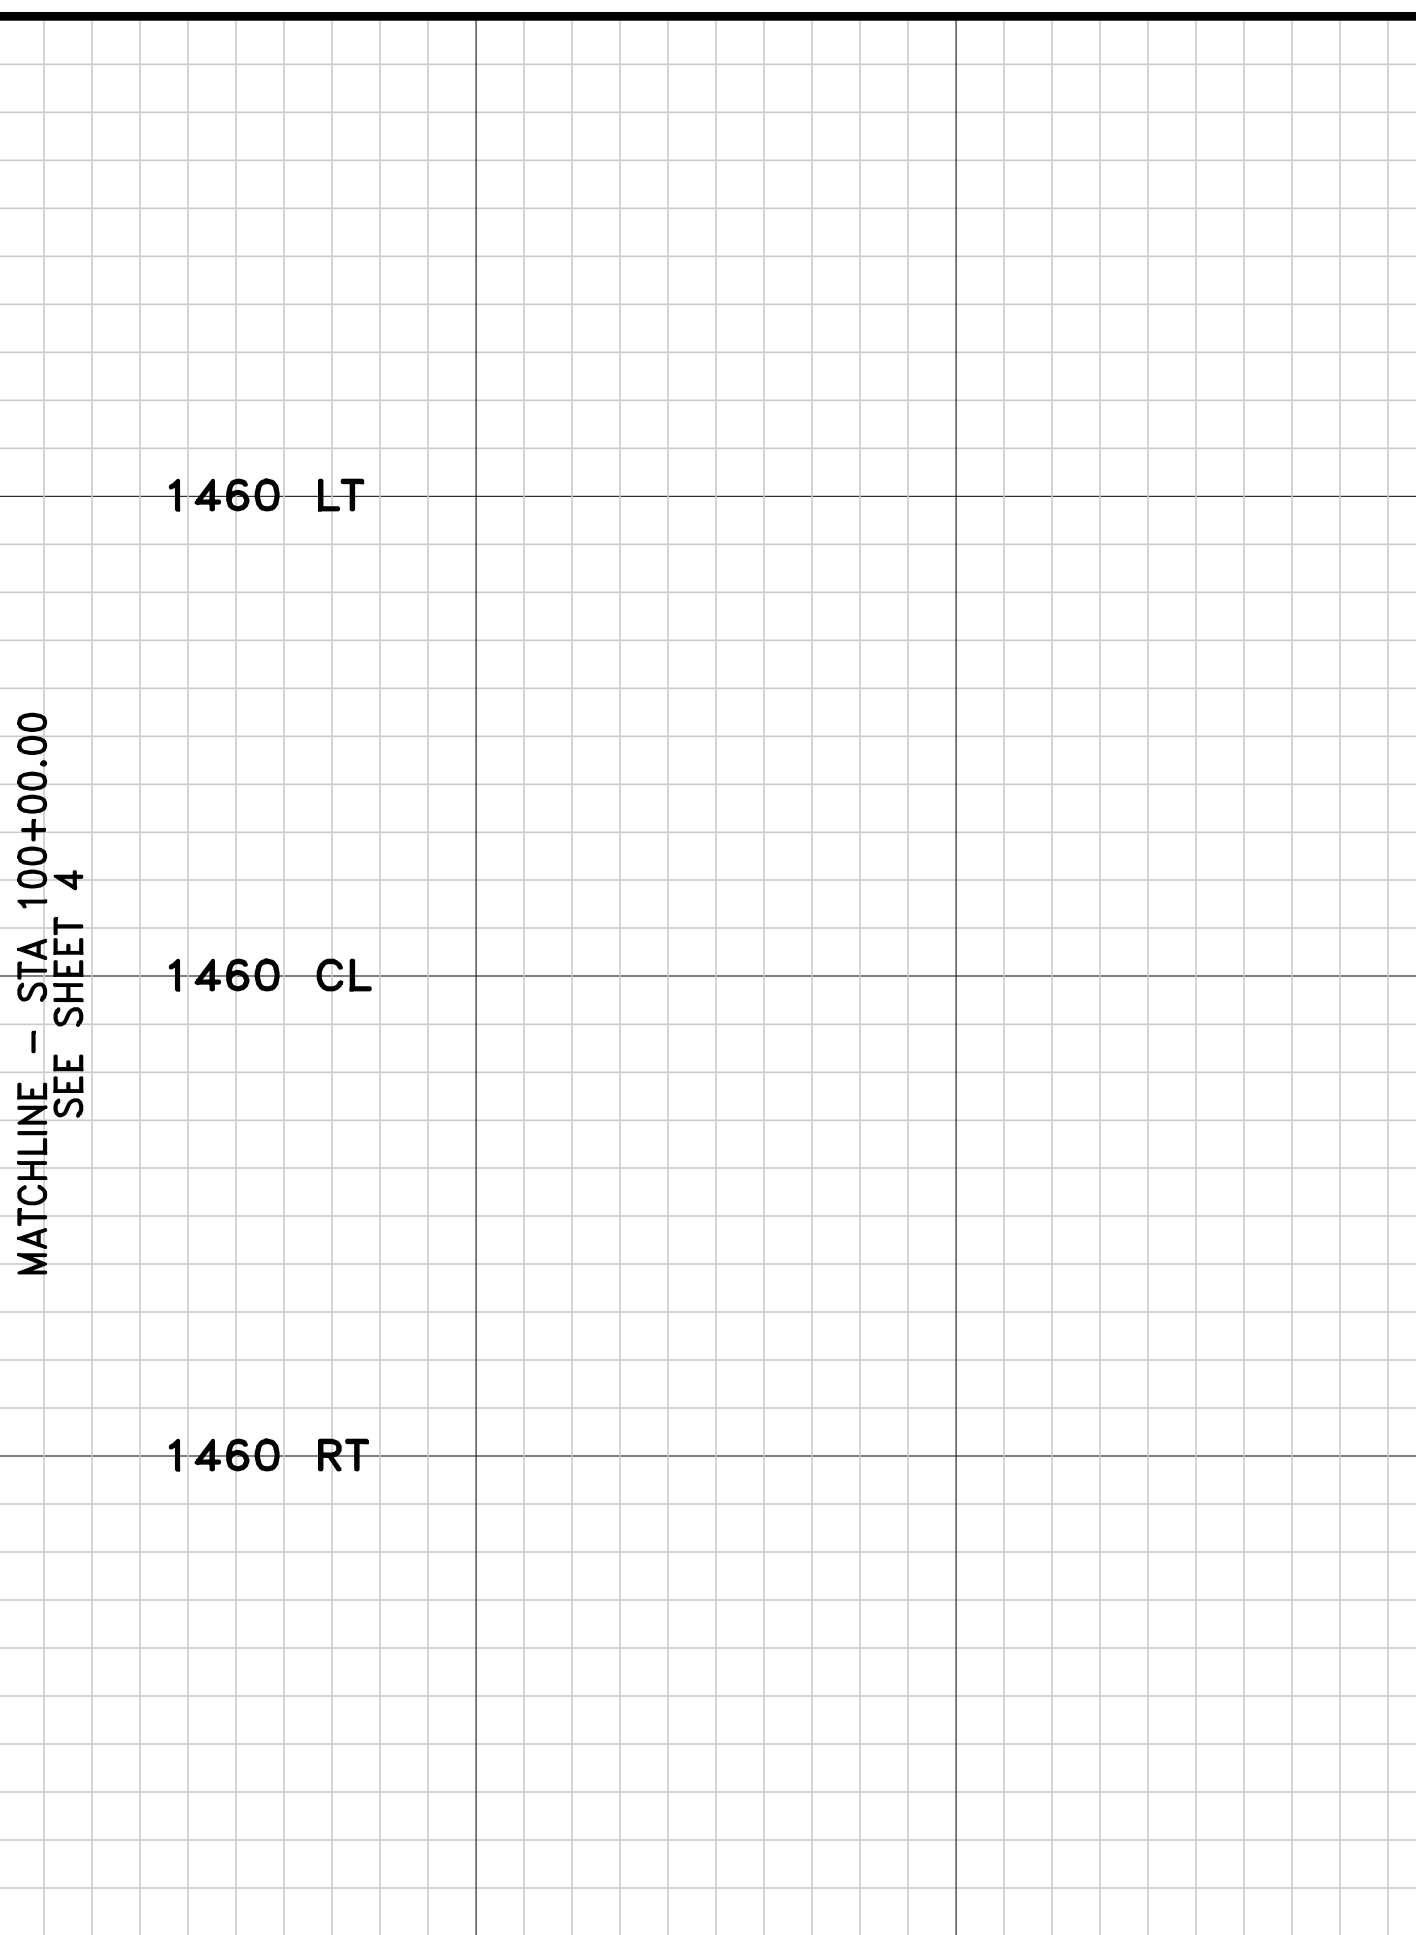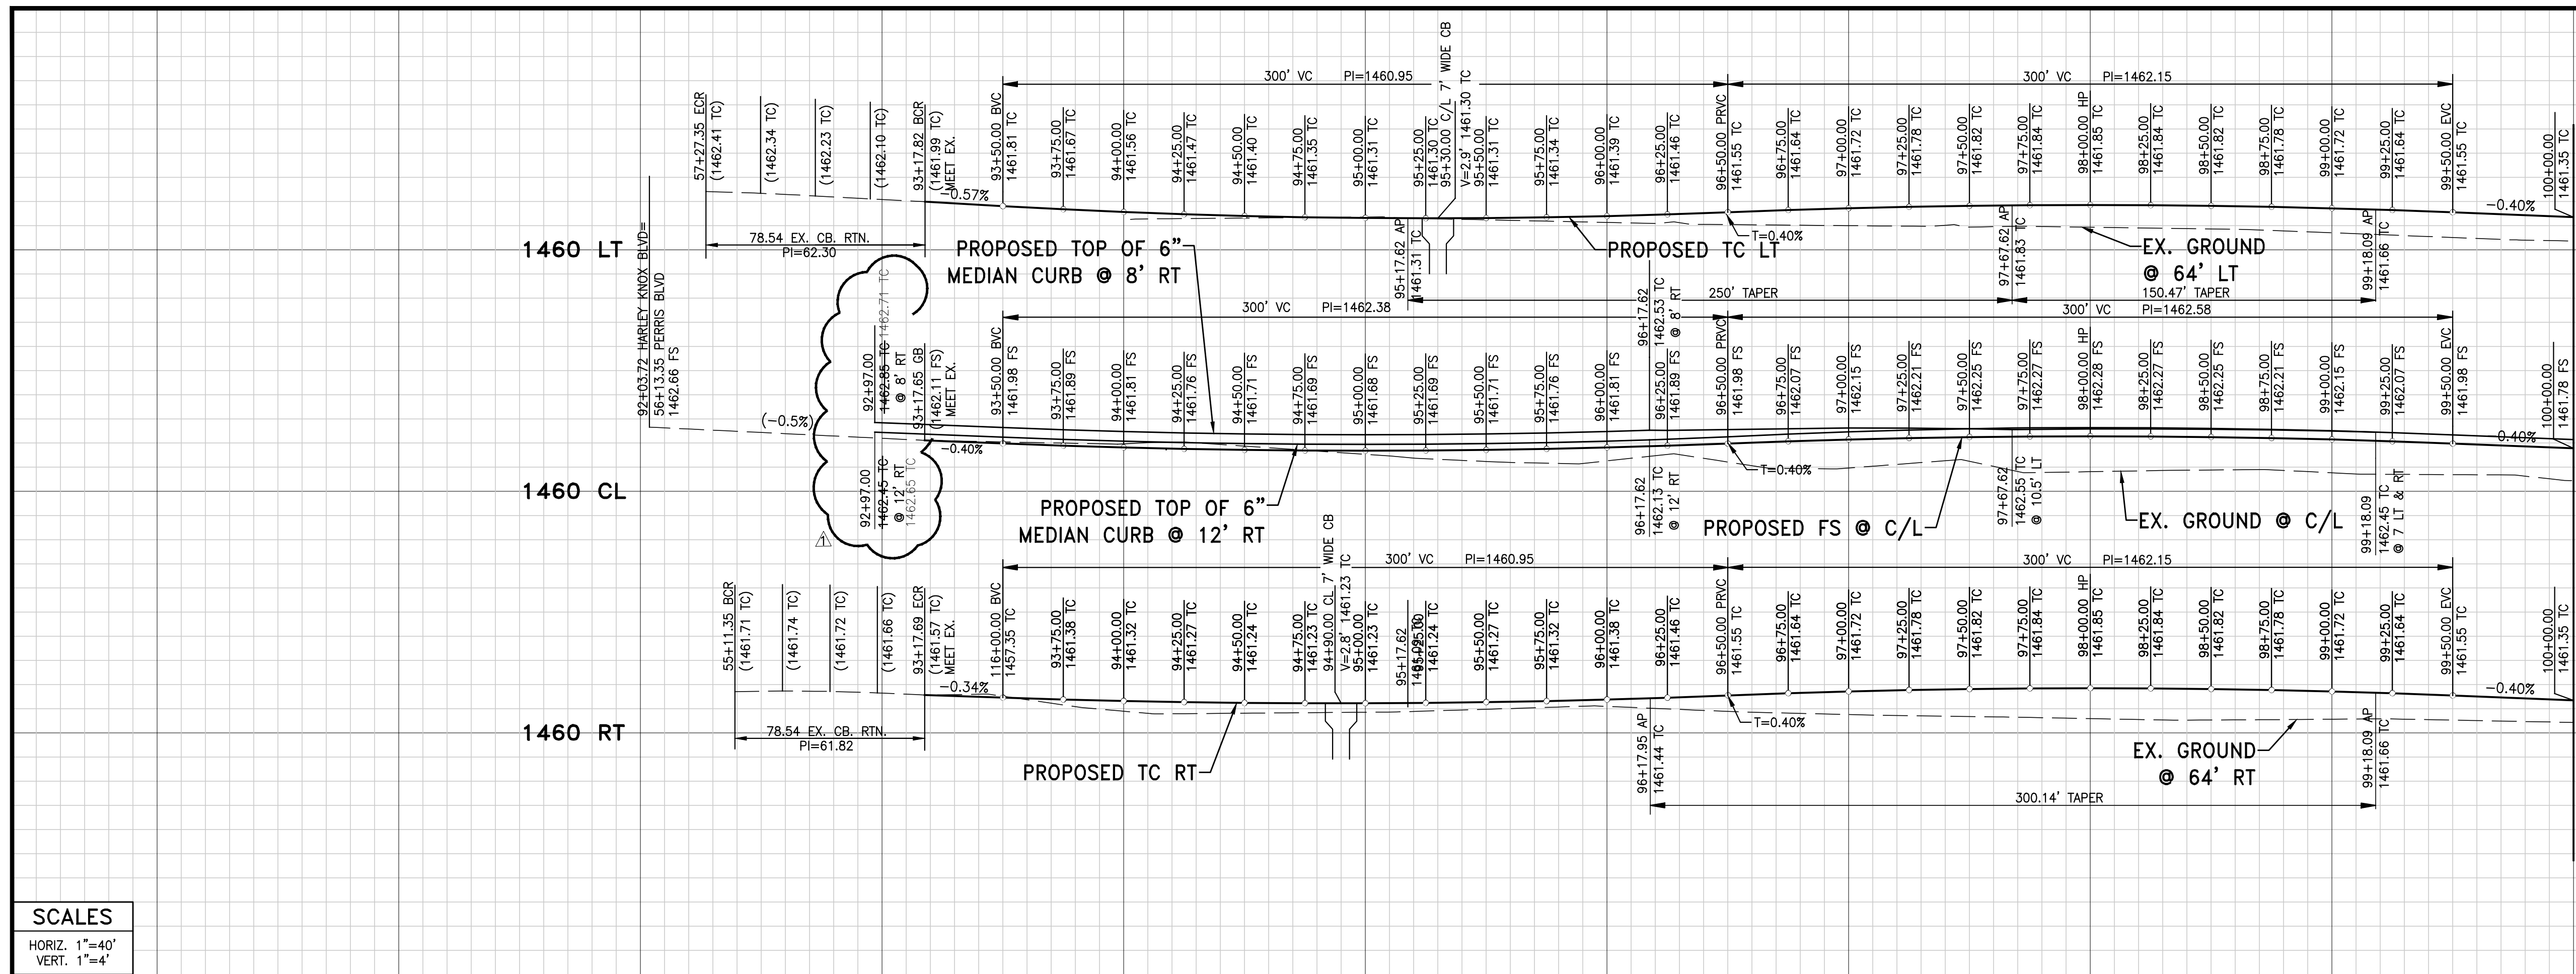

**CONSTRUCTION NOTES**

- CONSTRUCT MINIMUM 8" AC OVER 18" AB CLASS II
- CONSTRUCT MIN. 8" (4,000 PSI) PCC OVER 16" CLASS II AB (C.J. @ 20' O.C.)
- CONSTRUCT TYPE "A-8" CURB & GUTTER PER RIV. CO. STD. NO. 201
- CONSTRUCT 6" TYPE "D" CURB PER RIV. CO. STD. NO. 204
- RELOCATE EX. UTILITY RISER - BY UTILITY COMPANY
- REMOVE AC PAVEMENT AND DISPOSE OF LEGALLY
- SAWCUT & JOIN EX. A.C. PAVEMENT PER DETAIL ON SHEET 2
- CONSTRUCT 6" TYPE "D-1" CURB PER RIV. CO. STD. NO. 203
- CONSTRUCT CURB INLET CATCH BASIN PER RIV. CO. STD. NO. 300
- CONSTRUCT LOCAL DEPRESSION PER RIV. CO. STD. NO. 311

**AS BUILT**

THESE PLANS REFLECT ANY SUBSTANTIAL DESIGN MODIFICATIONS AS PROVIDED TO WEBB ASSOCIATES BY THE CONTRACTOR

SIGNATURE: [Signature] DATE: 05/19/2016

**LEGEND:**

- CONSTRUCT 8" AC OVER 18" AGGREGATE BASE
- REMOVE EXISTING AC PAVING
- INSTALL 8" PCC CONCRETE OVER 16" AGGREGATE BASE

**DIG ALERT**

CALL BEFORE YOU DIG

TWO WORKING DAYS BEFORE YOU DIG

1-800-227-2600

A PUBLIC SERVICE BY UNDERGROUND SERVICE ALERT

**NOTE:**

WORK CONTAINED WITHIN THESE PLANS SHALL NOT COMMENCE UNTIL AN ENCROACHMENT PERMIT AND/OR A GRADING PERMIT HAS BEEN ISSUED.

THE PRIVATE ENGINEER SIGNING THESE PLANS IS RESPONSIBLE FOR ASSURING THE ACCURACY AND ACCEPTABILITY OF THE DESIGN HEREON. IN THE EVENT OF DISCREPANCIES ARISING AFTER CITY APPROVAL OR DURING CONSTRUCTION, THE PRIVATE ENGINEER SHALL BE RESPONSIBLE FOR DETERMINING AN ACCEPTABLE SOLUTION AND REVISING THE PLANS FOR APPROVAL BY THE CITY.

MARK	BY	DATE	REVISIONS	APPR.	DATE
DJ	5/25/15		REVISE 8" D-1 CURB TO 6" D-1 CURB		
DJ	5/25/15		REVISE MEDIAN GRADES		

CITY OF PERRIS

APPROVED BY:

CITY ENGINEER

DATE

SEAL - ENGINEER

REGISTERED PROFESSIONAL ENGINEER

D.J. ARELLANO

No. 81988

CIVIL

STATE OF CALIFORNIA

ALBERT A. WEBB ASSOCIATES

ENGINEERING CONSULTANTS

3788 McCRAY STREET

RIVERSIDE CA. 92506

PH. (951) 686-1070

FAX (951) 788-1256

UNDER THE SUPERVISION OF:

D.J. ARELLANO R.C.E. #C81988 DATE 1/12/2015

BENCHMARK:

SEE SHEET 1

SCALE:

H: AS SHOWN V: AS SHOWN

CITY OF PERRIS

AMENDED DPR NO. 11-12-0004

STRATFORD RANCH-PARCEL MAP 36469

HARLEY KNOX BOULEVARD


STA 92+03.72 TO STA 100+00.00

SHEET NO. 3

OF 23 SHEETS


FOR: IDI W.O. 2013-0239 CITY FILE NO. P8-1189

6:\2013\13-0239\DRAWINGS\AS-BUILT\13-0239-C-ST-AE.DWG 5/18/2016 8:29 AM

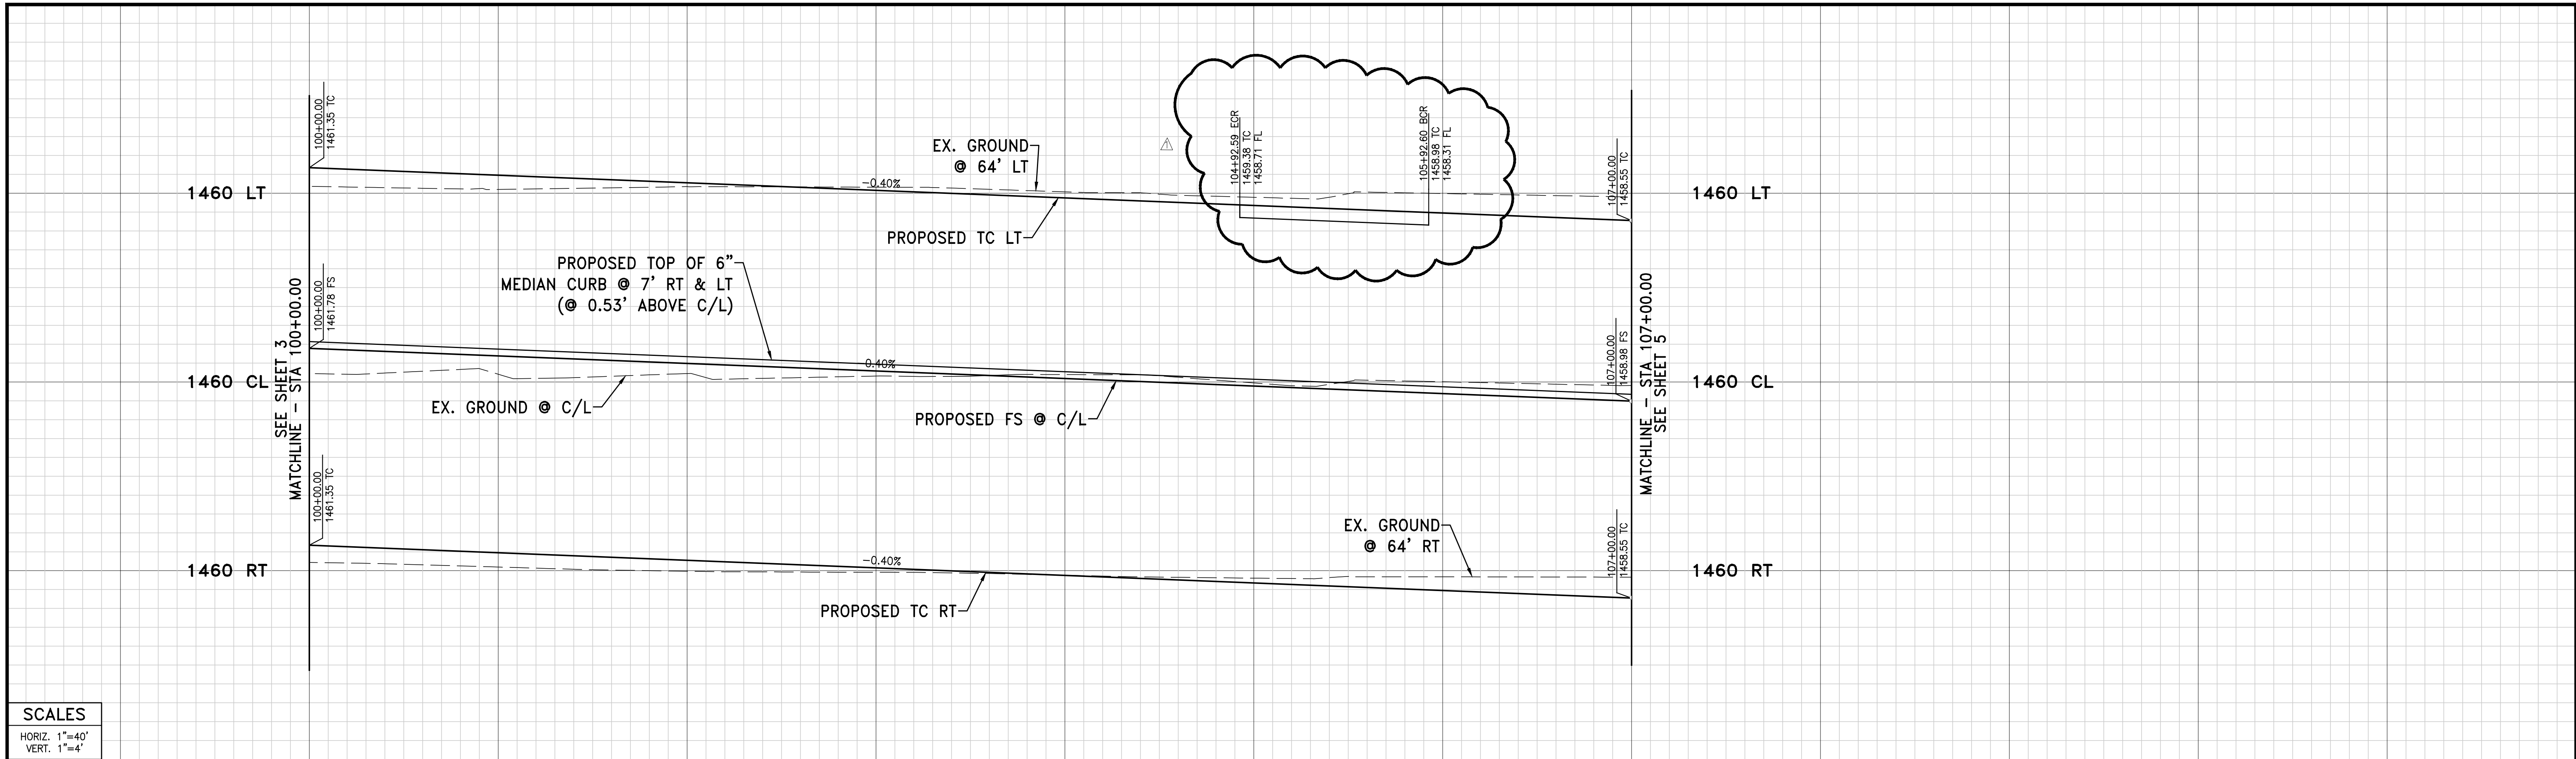

**SCALES**  
 HORIZ. 1"=40'  
 VERT. 1"=4'

100 101 102 103 104 105 106 107

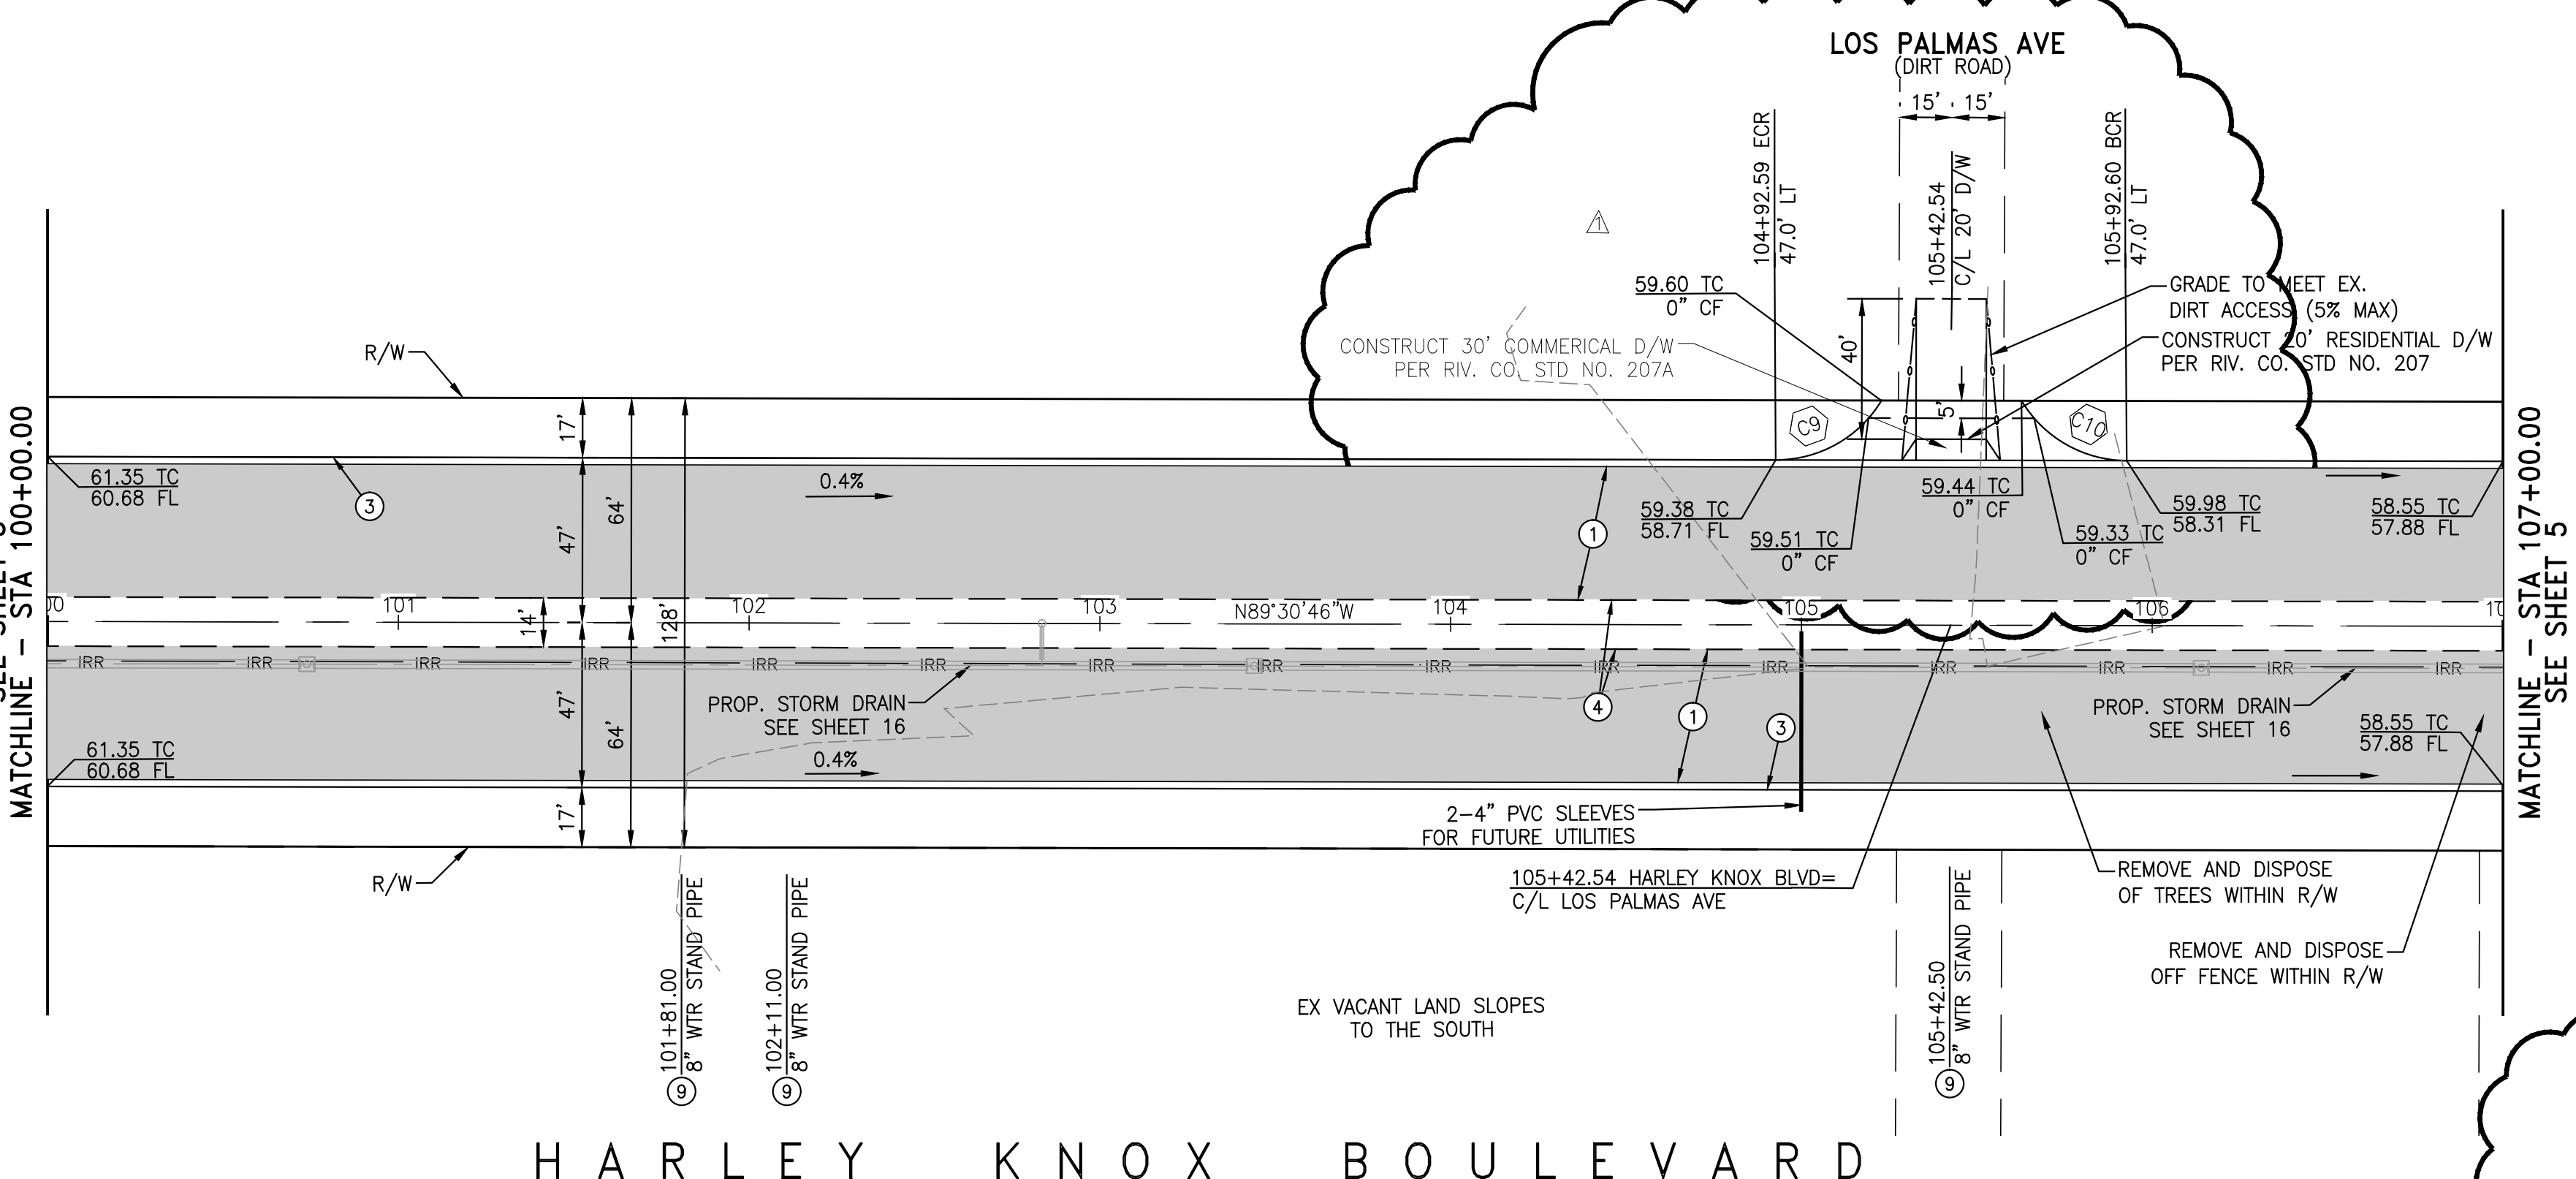

- CONSTRUCTION NOTES**
- 1 CONSTRUCT MINIMUM 8" AC OVER 18" AB CLASS II
  - 2 CONSTRUCT TYPE "A-8" CURB & GUTTER PER RIV. CO. STD. NO. 201
  - 3 CONSTRUCT 6" TYPE "D" CURB PER RIV. CO. STD. NO. 204
  - 4 RELOCATE EX. UTILITY RISER - BY UTILITY COMPANY

**AS BUILT**

THESE PLANS REFLECT ANY SUBSTANTIAL DESIGN MODIFICATIONS AS PROVIDED TO WEBB ASSOCIATES BY THE CONTRACTOR

SIGNATURE: *[Signature]* DATE: 05/19/2016


REGISTERED PROFESSIONAL ENGINEER  
 D.J. ARELLANO  
 NO. 81988  
 CIVIL  
 STATE OF CALIFORNIA

**LEGEND:**


	CONSTRUCT 8" AC OVER 18" AGGREGATE BASE
	REMOVE EXISTING AC PAVING
	INSTALL 8" PCC CONCRETE OVER 16" AGGREGATE BASE

**CURVE TABLE**

#	LENGTH	RADIUS	DELTA	TANGENT
C9	36.07	35.00	059°03'01"	19.82
C10	36.07	35.00	059°03'01"	19.82

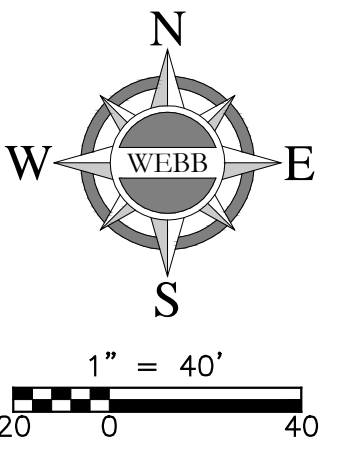


**NOTE:** CONTRACTOR TO BE FAMILIAR WITH SITE PRIOR TO CONSTRUCTION. ALL TREES, FENCES, BUILDINGS AND OTHER APPURTENANCES WITHIN THE PUBLIC RIGHT OF WAY TO BE REMOVED AND DISPOSED OF LEGALLY.

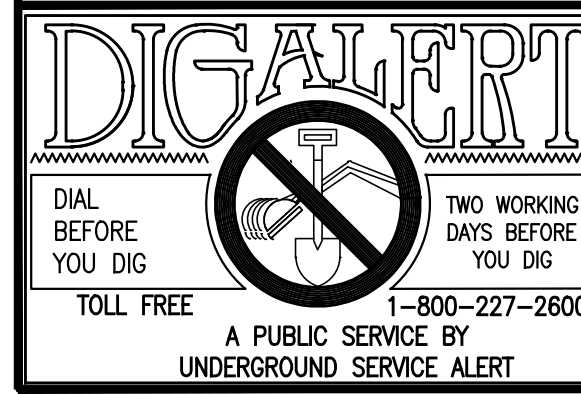

**NOTE:** WORK CONTAINED WITHIN THESE PLANS SHALL COMMENCE UNTIL AN ENCROACHMENT PERMIT AND/OR A GRADING PERMIT HAS BEEN ISSUED. THE PRIVATE ENGINEER SIGNING THESE PLANS IS RESPONSIBLE FOR ASSURING THE ACCURACY AND ACCEPTABILITY OF THE DESIGN HEREON. IN THE EVENT OF DISCREPANCIES ARISING AFTER CITY APPROVAL OR DURING CONSTRUCTION, THE PRIVATE ENGINEER SHALL BE RESPONSIBLE FOR DETERMINING AN ACCEPTABLE SOLUTION AND REVISING THE PLANS FOR APPROVAL BY THE CITY.

MARK	BY	DATE	REVISIONS	APPR.	DATE
Δ	DJM	5/19/16	REVISE DRIVEWAY FROM STD 207 TO STD 207A		

CITY OF PERRIS  
 APPROVED BY:  
 \_\_\_\_\_  
 CITY ENGINEER  
 DATE \_\_\_\_\_

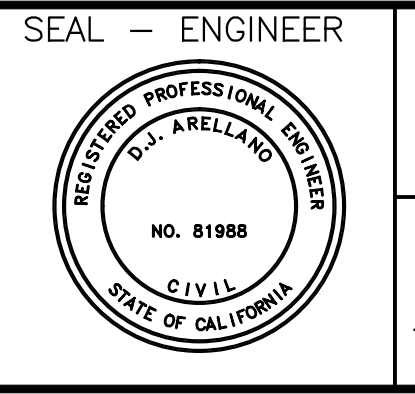


SEAL - ENGINEER  
**ALBERT A. WEBB ASSOCIATES**  
 ENGINEERING CONSULTANTS  
 3788 McCRAY STREET  
 RIVERSIDE, CA. 92506  
 PH. (951) 686-1070  
 FAX (951) 788-1256  
 UNDER THE SUPERVISION OF:  
 \_\_\_\_\_  
 D.J. ARELLANO R.C.E. #C81988 DATE 1/12/2015

BENCHMARK:  
 SEE SHEET 1  
 SCALE:  
 H: AS SHOWN V: AS SHOWN

CITY OF PERRIS  
 AMENDED DPR NO. 11-12-0004  
 STRATFORD RANCH-PARCEL MAP 36469  
 HARLEY KNOX BOULEVARD  
 STA 100+00.00 TO STA 107+00.00


SHEET NO.  
 4  
 OF 23 SHEETS  
 P8-1189

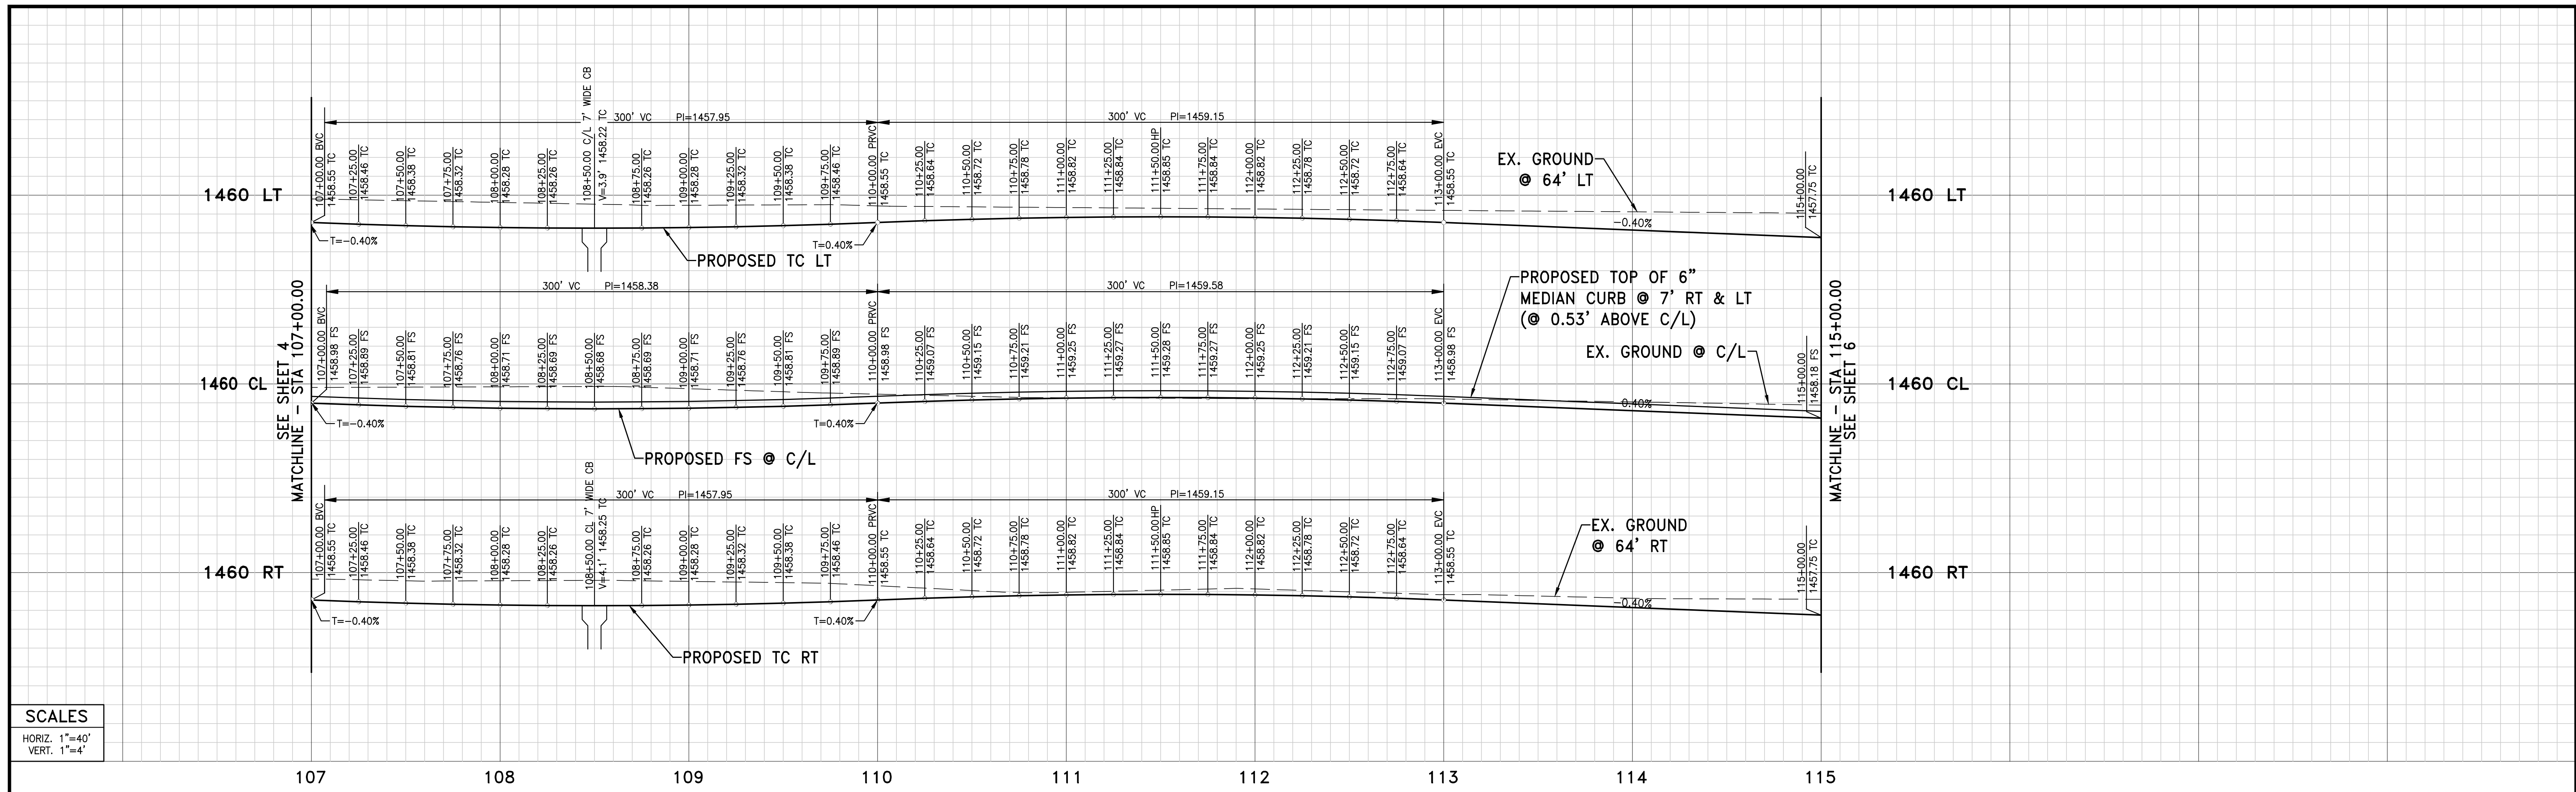

**SCALES**  
 HORIZ. 1"=40'  
 VERT. 1"=4'

**CONSTRUCTION NOTES**

- ① CONSTRUCT MINIMUM 8" AC OVER 18" AB CLASS II
- ③ CONSTRUCT TYPE "A-8" CURB & GUTTER PER RIV. CO. STD. NO. 201
- ④ CONSTRUCT 6" TYPE "D" CURB PER RIV. CO. STD. NO. 204
- ⑨ RELOCATE EX. UTILITY RISER - BY UTILITY COMPANY
- ⑳ CONSTRUCT CURB INLET CATCH BASIN PER RIV. CO. STD. NO. 300
- ㉔ CONSTRUCT LOCAL DEPRESSION PER RIV. CO. STD. NO. 311

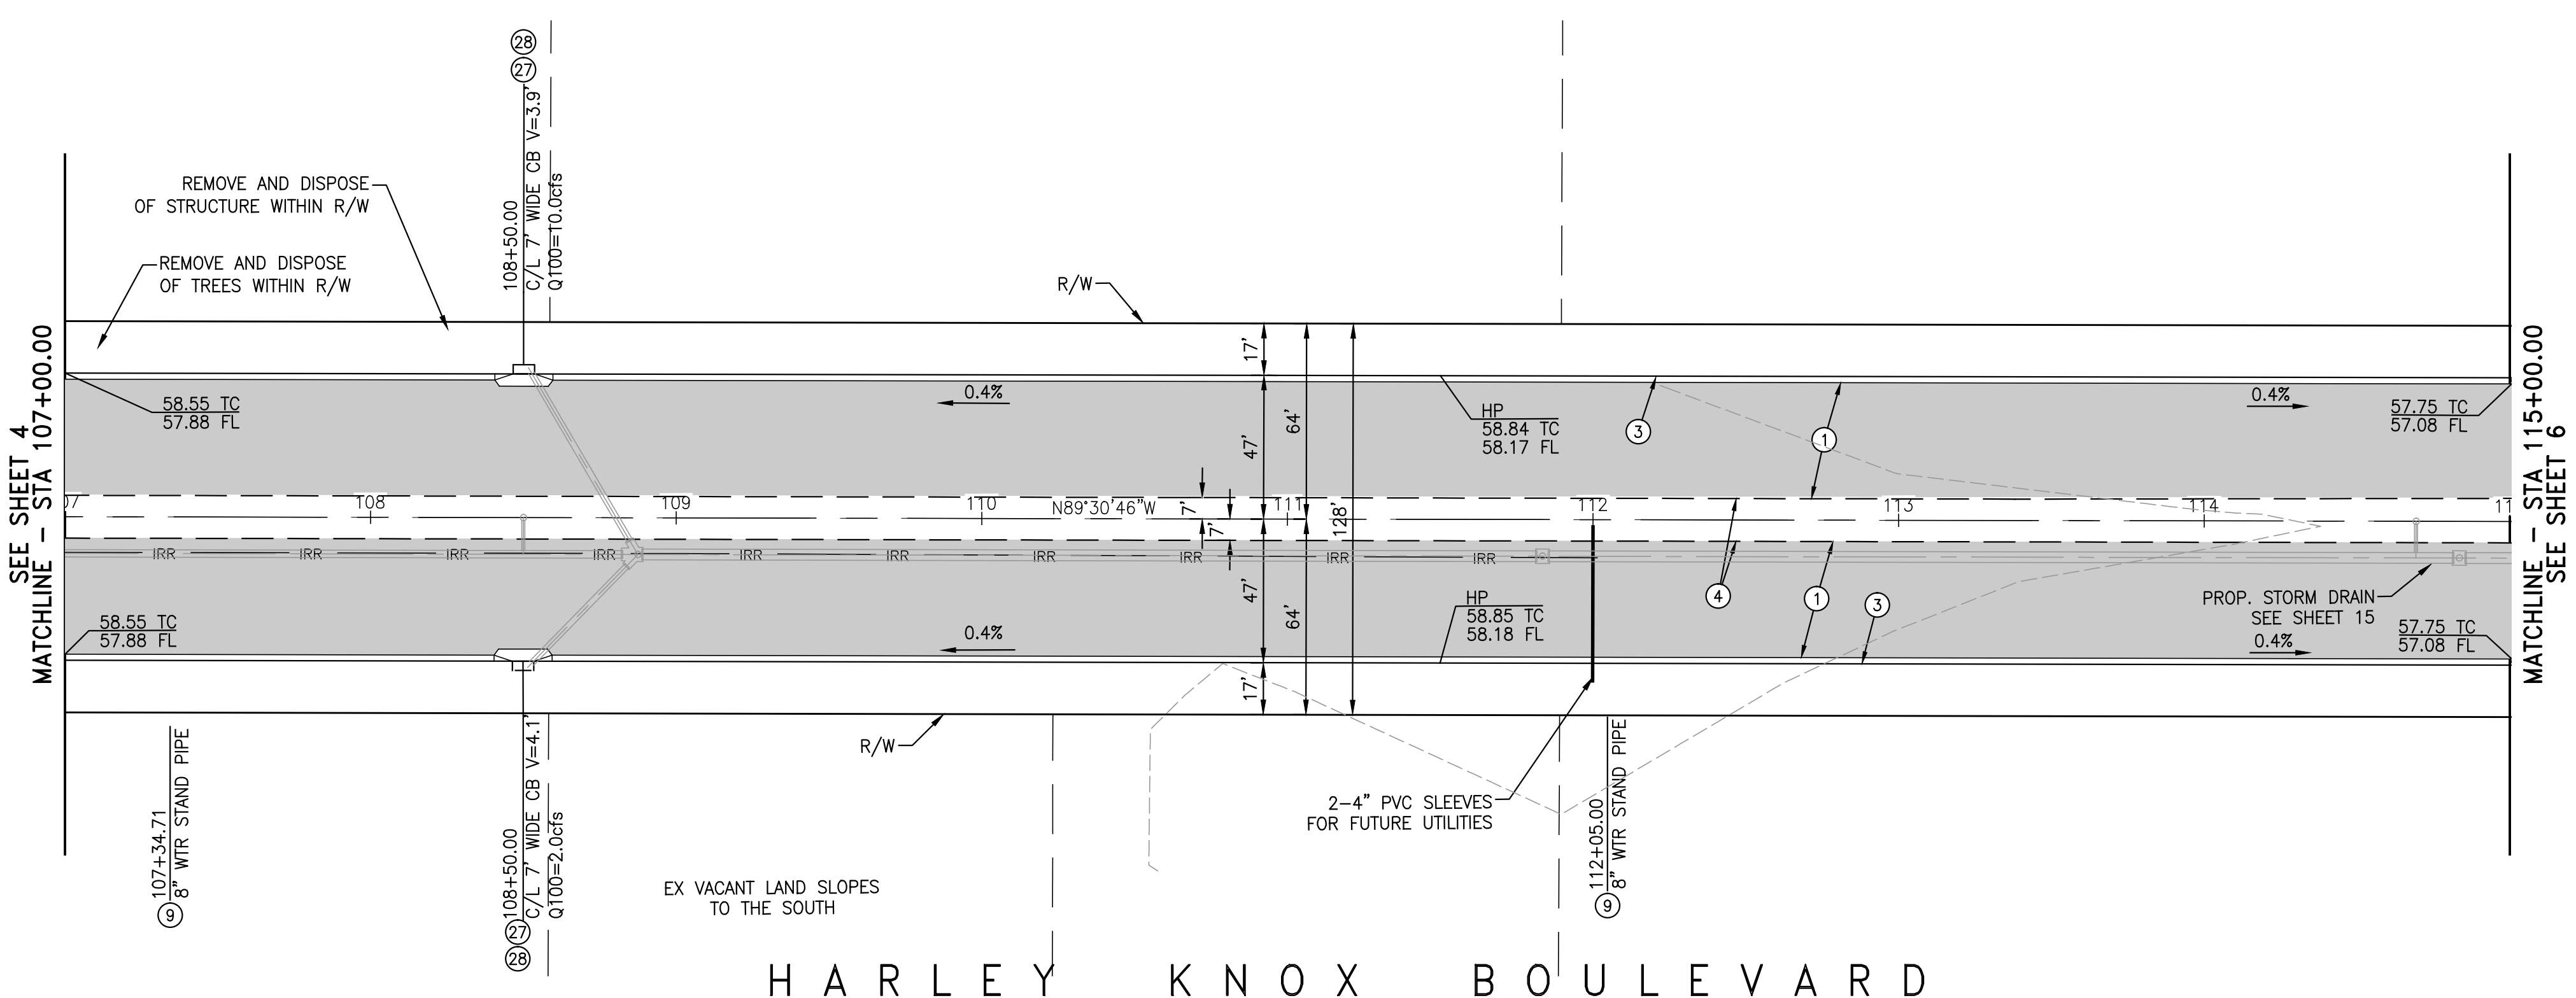


AS BUILT

THESE PLANS REFLECT ANY SUBSTANTIAL DESIGN MODIFICATIONS AS PROVIDED TO WEBB ASSOCIATES BY THE CONTRACTOR

SIGNATURE \_\_\_\_\_

DATE 05/19/2016

REGISTERED PROFESSIONAL ENGINEER  
 D.J. ARELLANO  
 No. 81988  
 CIVIL  
 STATE OF CALIFORNIA

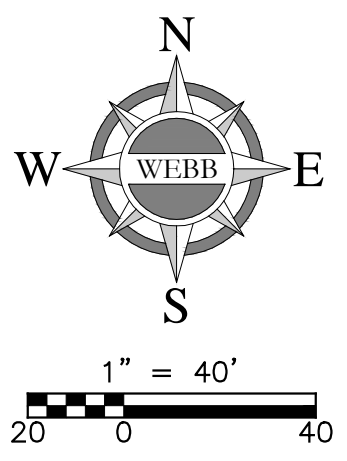

**DIG ALERT**

CALL BEFORE YOU DIG

1-800-227-2600

A PUBLIC SERVICE BY UNDERGROUND SERVICE ALERT

**NOTE:**  
 WORK CONTAINED WITHIN THESE PLANS SHALL NOT COMMENCE UNTIL AN ENCROACHMENT PERMIT AND/OR A GRADING PERMIT HAS BEEN ISSUED.

THE PRIVATE ENGINEER SIGNING THESE PLANS IS RESPONSIBLE FOR ASSURING THE ACCURACY AND ACCEPTABILITY OF THE DESIGN HEREON. IN THE EVENT OF DISCREPANCIES ARISING AFTER CITY APPROVAL OR DURING CONSTRUCTION, THE PRIVATE ENGINEER SHALL BE RESPONSIBLE FOR DETERMINING AN ACCEPTABLE SOLUTION AND REVISING THE PLANS FOR APPROVAL BY THE CITY.

MARK	BY	DATE	REVISIONS	APPR.	DATE

CITY OF PERRIS  
 APPROVED BY: \_\_\_\_\_  
 CITY ENGINEER  
 DATE \_\_\_\_\_

SEAL - ENGINEER

**ALBERT A. WEBB ASSOCIATES**  
 ENGINEERING CONSULTANTS  
 3788 McCRAY STREET  
 RIVERSIDE, CA. 92506  
 PH. (951) 686-1070  
 FAX (951) 788-1256


UNDER THE SUPERVISION OF: \_\_\_\_\_  
 D.J. ARELLANO R.C.E. #C81988 DATE 1/12/2015

BENCHMARK:  
 SEE SHEET 1


SCALE:  
 H: AS SHOWN V: AS SHOWN

CITY OF PERRIS  
 AMENDED DPR NO. 11-12-0004  
 STRATFORD RANCH-PARCEL MAP 36469  
 HARLEY KNOX BOULEVARD  
 STA 107+00.00 TO STA 115+00.00

SHEET NO. **5**  
 OF 23 SHEETS  
 P8-1189

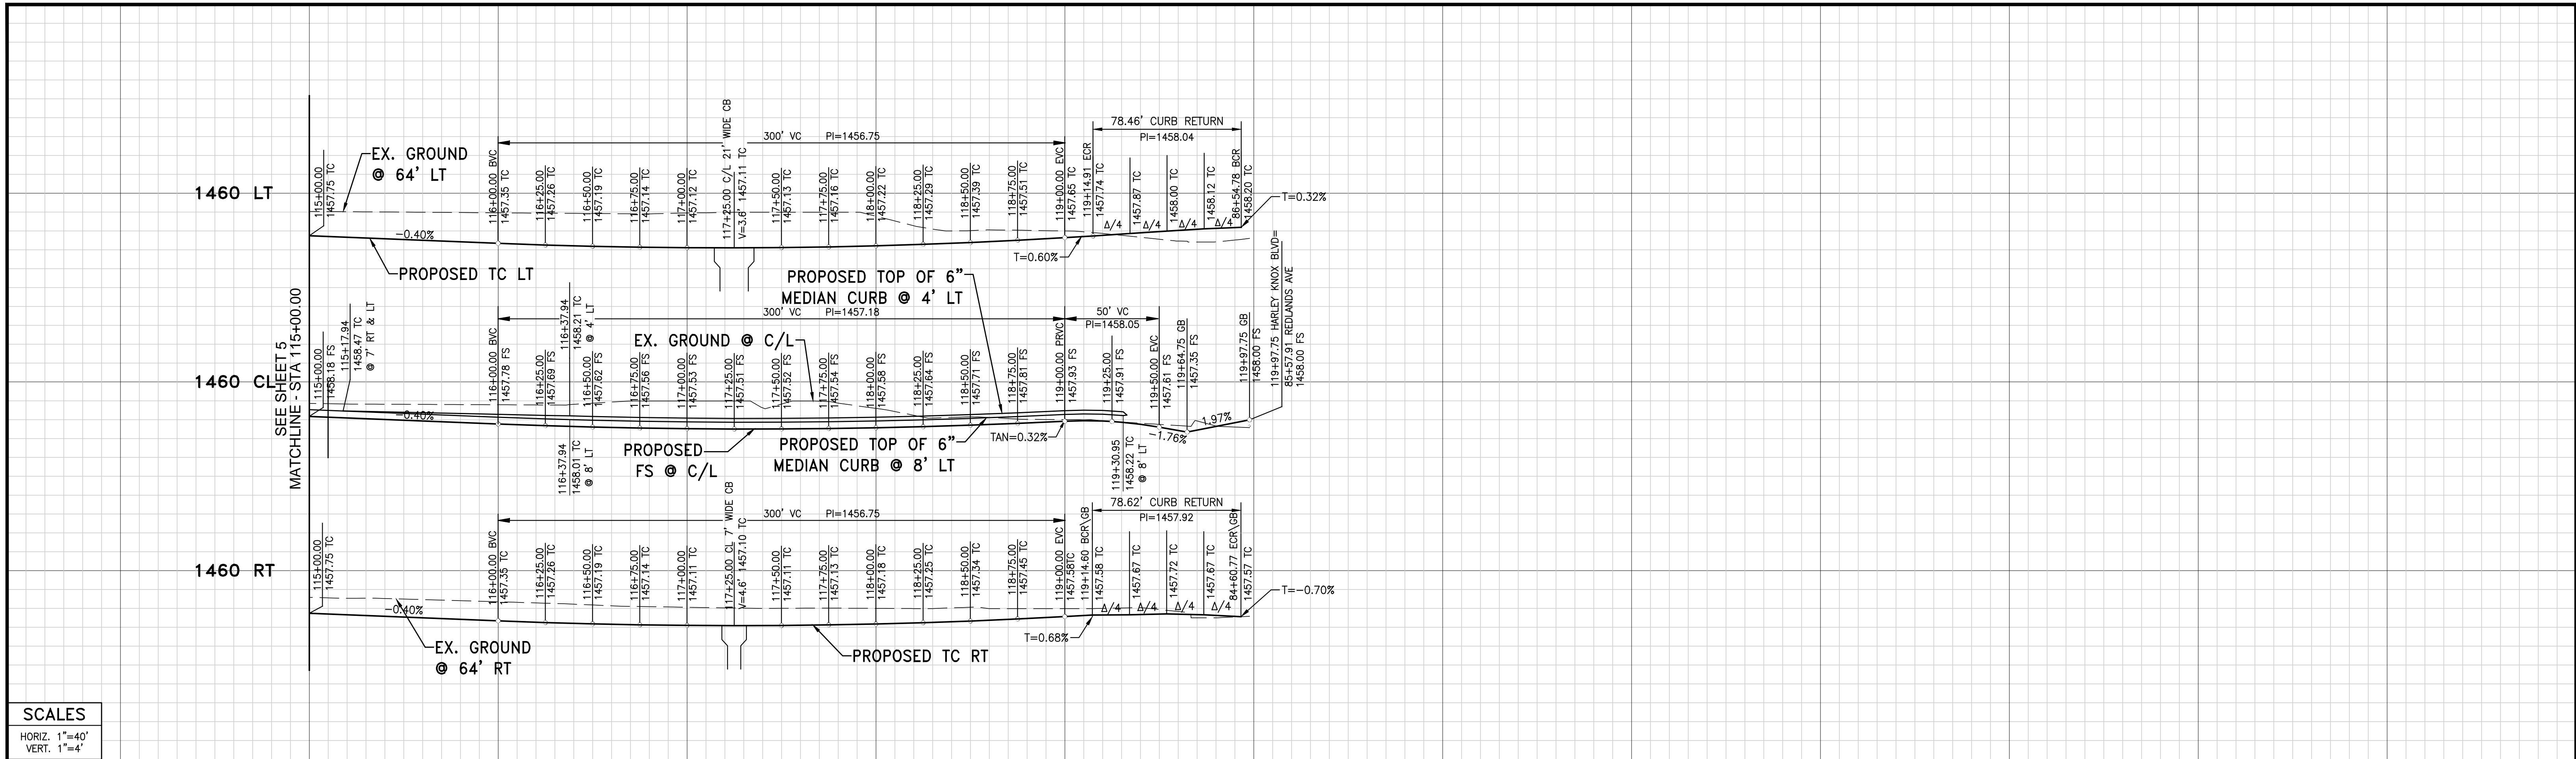

**SCALES**  
 HORIZ. 1"=40'  
 VERT. 1"=4'

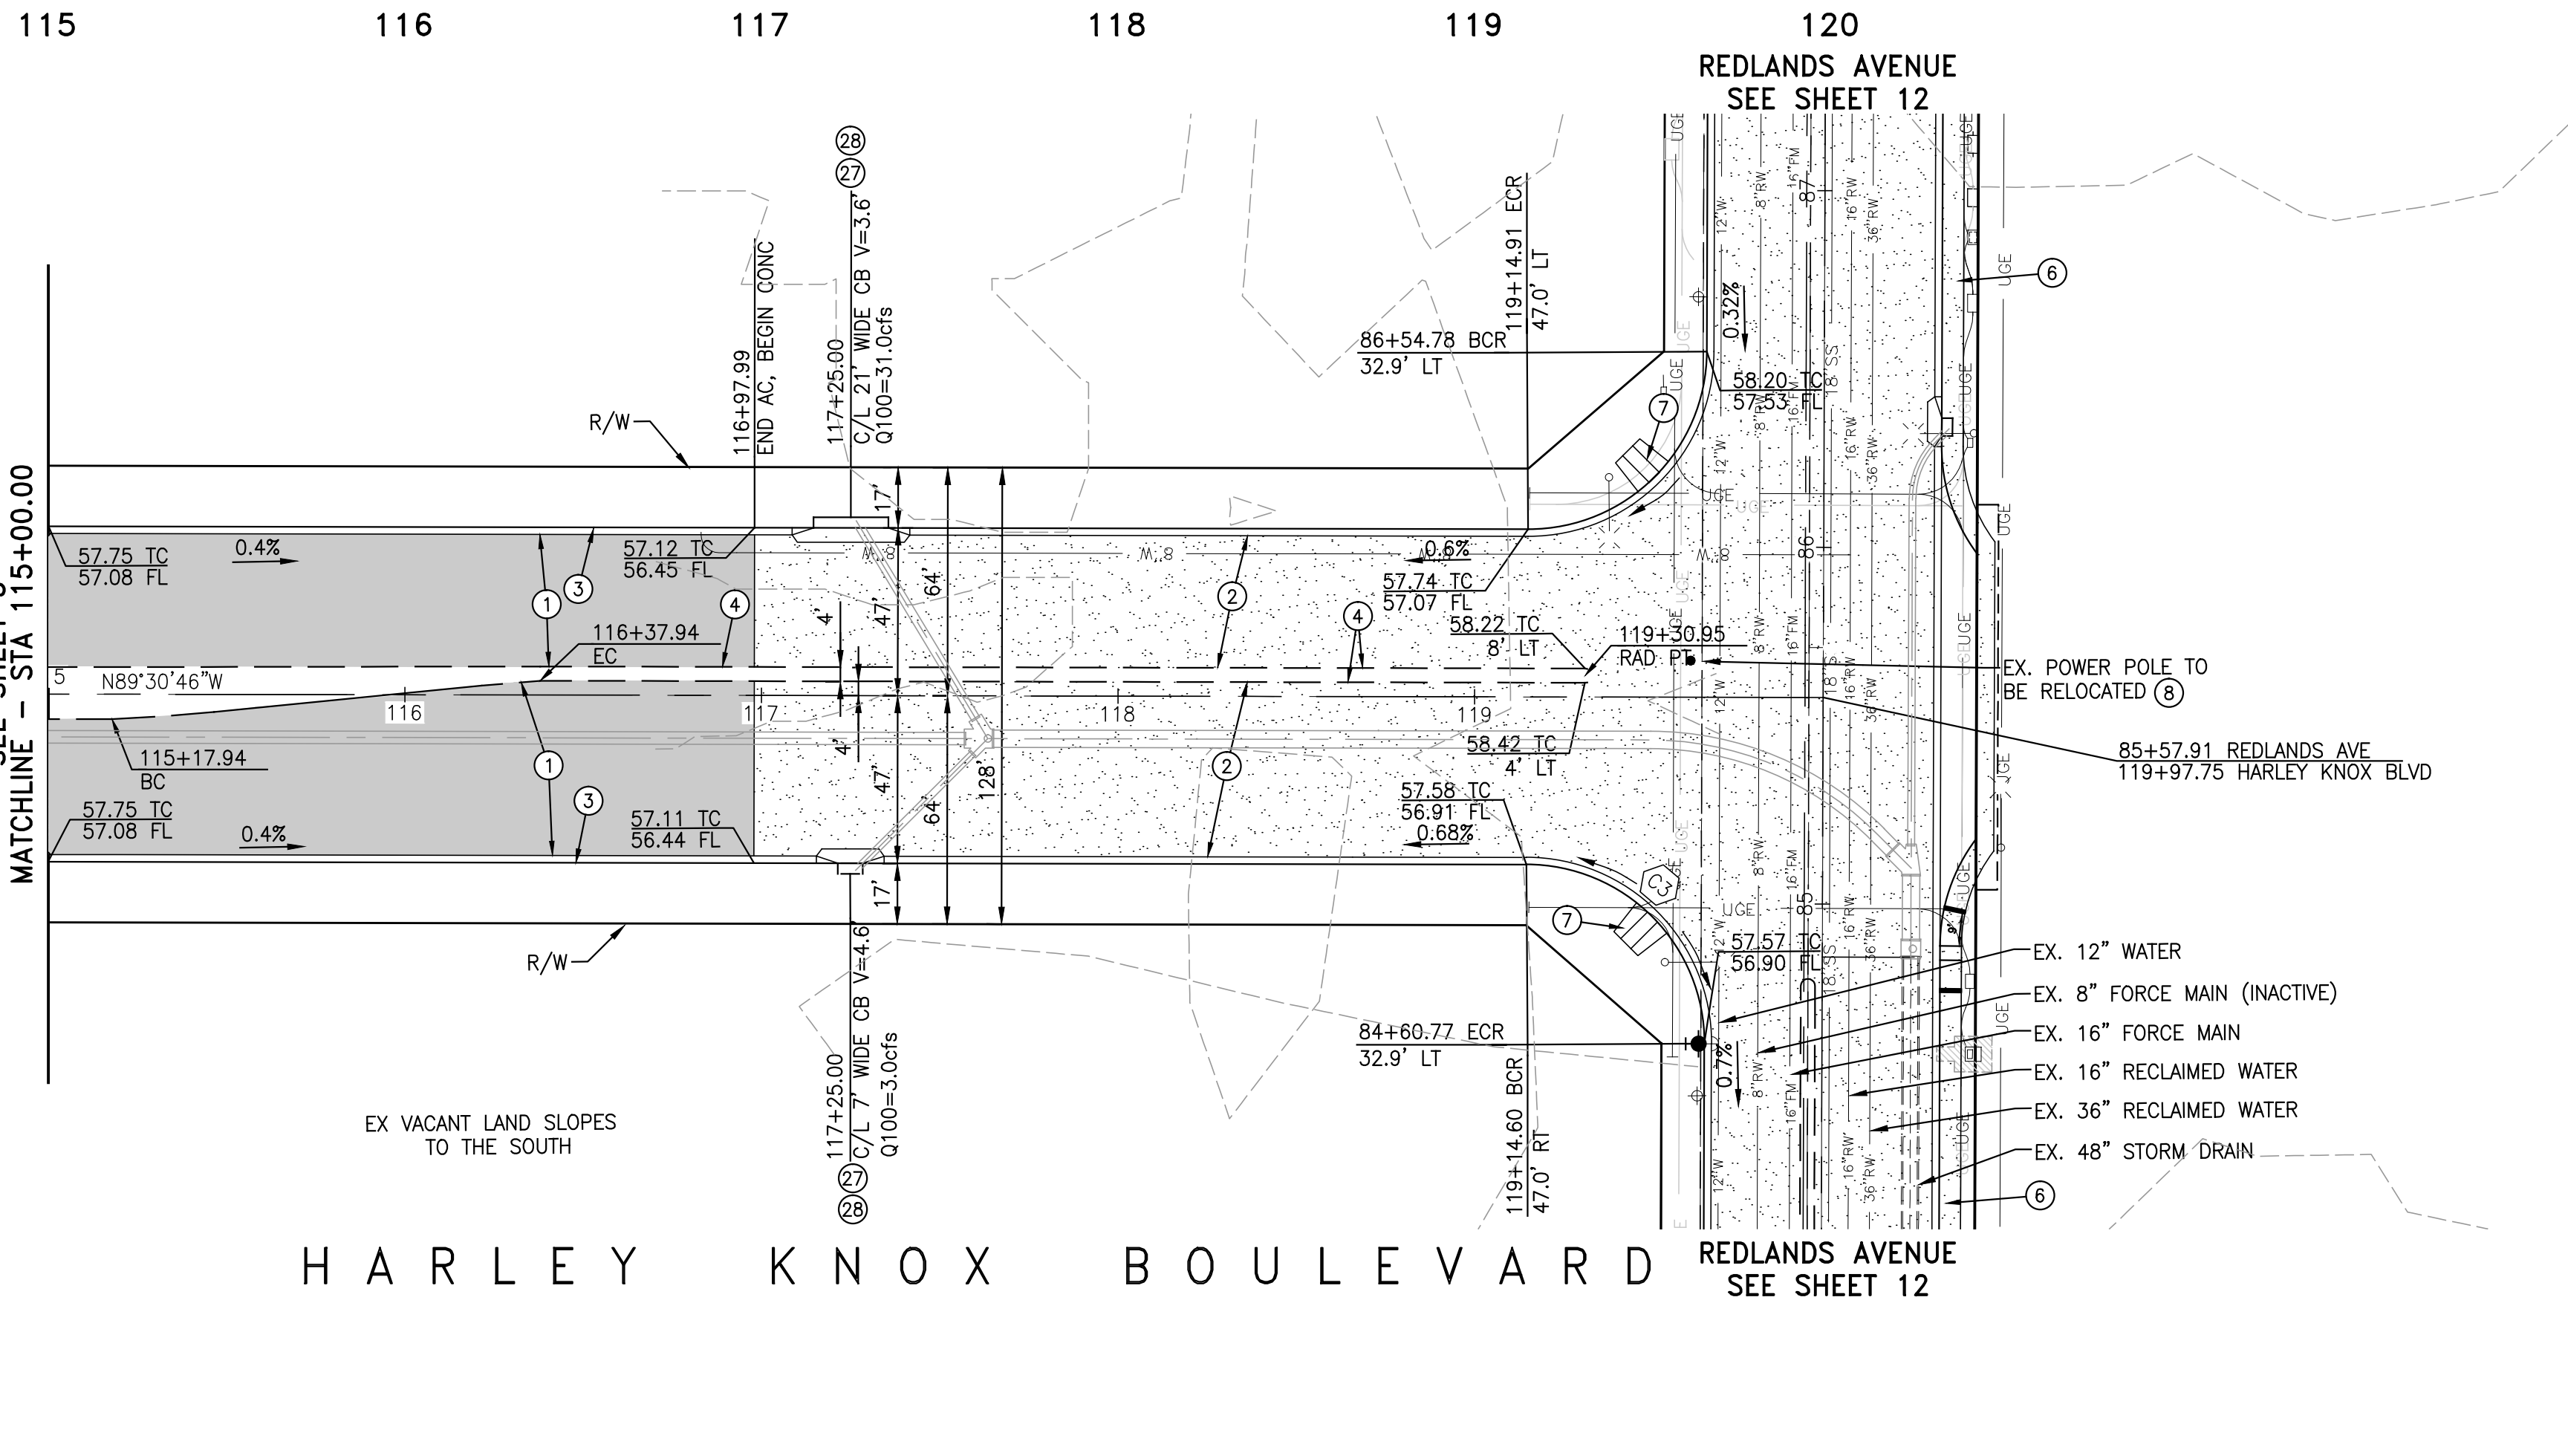

- CONSTRUCTION NOTES**
- CONSTRUCT MINIMUM 8" AC OVER 18" AB CLASS II
  - CONSTRUCT MIN. 8" (4,000 PSI) PCC OVER 16" CLASS II AB (C.J. @ 20' O.C.)
  - CONSTRUCT TYPE "A-8" CURB & GUTTER PER RIV. CO. STD. NO. 201
  - CONSTRUCT 6" TYPE "D" CURB PER RIV. CO. STD. NO. 204
  - CONSTRUCT 6' WIDE SIDEWALK PER RIV. CO. STD. 401
  - CONSTRUCT CURB RAMP PER RIV. CO. STD. NO. 403, CASE A
  - COORD UNDERGROUNDING/RELOCATION OF PP & GUY WIRE - BY UTILITY COMPANY
  - CONSTRUCT CURB INLET CATCH BASIN PER RIV. CO. STD. NO. 300
  - CONSTRUCT LOCAL DEPRESSION PER RIV. CO. STD. NO. 311

**AS BUILT**



THESE PLANS REFLECT ANY SUBSTANTIAL DESIGN MODIFICATIONS AS PROVIDED TO WEBB ASSOCIATES BY THE CONTRACTOR

SIGNATURE: *[Signature]* DATE: 05/19/2016

REGISTERED PROFESSIONAL ENGINEER  
 D.J. ARELLANO  
 NO. 81988  
 CIVIL  
 STATE OF CALIFORNIA

CURVE TABLE			
#	LENGTH	RADIUS	TANGENT
C1	78.62	50.00	090°05'38"
C2	78.46	50.00	089°54'22"
C3	78.62	50.00	090°05'24"


- LEGEND:**
- CONSTRUCT 8" AC OVER 18" AGGREGATE BASE
  - REMOVE EXISTING AC PAVING
  - INSTALL 8" PCC CONCRETE OVER 16" AGGREGATE BASE

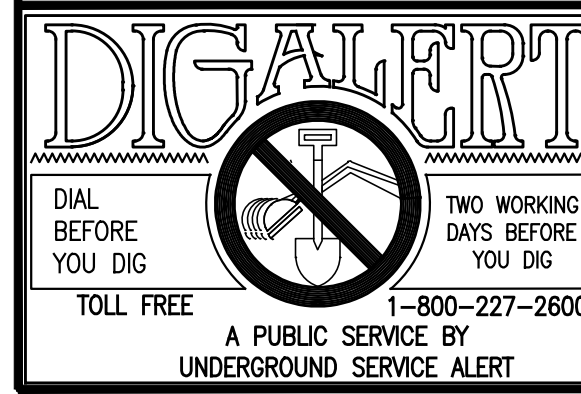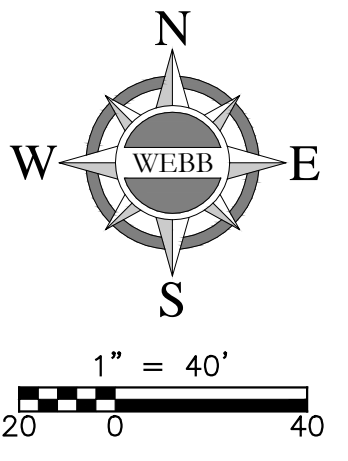

**NOTE:**  
 WORK CONTAINED WITHIN THESE PLANS SHALL NOT COMMENCE UNTIL AN ENCROACHMENT PERMIT AND/OR A GRADING PERMIT HAS BEEN ISSUED.  
 THE PRIVATE ENGINEER SIGNING THESE PLANS IS RESPONSIBLE FOR ASSURING THE ACCURACY AND ACCEPTABILITY OF THE DESIGN HEREON. IN THE EVENT OF DISCREPANCIES ARISING AFTER CITY APPROVAL OR DURING CONSTRUCTION, THE PRIVATE ENGINEER SHALL BE RESPONSIBLE FOR DETERMINING AN ACCEPTABLE SOLUTION AND REVISING THE PLANS FOR APPROVAL BY THE CITY.

MARK	BY	DATE	REVISIONS	APPR.	DATE

CITY OF PERRIS  
 APPROVED BY:  
 \_\_\_\_\_  
 CITY ENGINEER  
 DATE \_\_\_\_\_

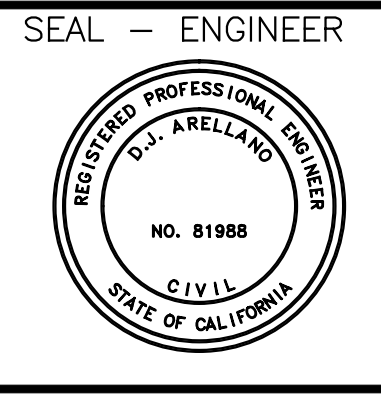


SEAL - ENGINEER  
**ALBERT A. WEBB ASSOCIATES**  
 ENGINEERING CONSULTANTS  
 3788 McCRAV STREET  
 RIVERSIDE CA. 92506  
 PH. (951) 686-1070  
 FAX (951) 788-1256  
 UNDER THE SUPERVISION OF:  
 \_\_\_\_\_  
 DATE 1/12/2015  
 R.C.E. #C81988

BENCHMARK:  
 SEE SHEET 1  
 SCALE:  
 H: AS SHOWN V: AS SHOWN

CITY OF PERRIS  
 AMENDED DPR NO. 11-12-0004  
 STRATFORD RANCH-PARCEL MAP 36469  
 HARLEY KNOX BOULEVARD  
 STA 115+00.00 TO STA 119+93.75

SHEET NO.  
**6**  
 OF 23 SHEETS  
 P8-1189



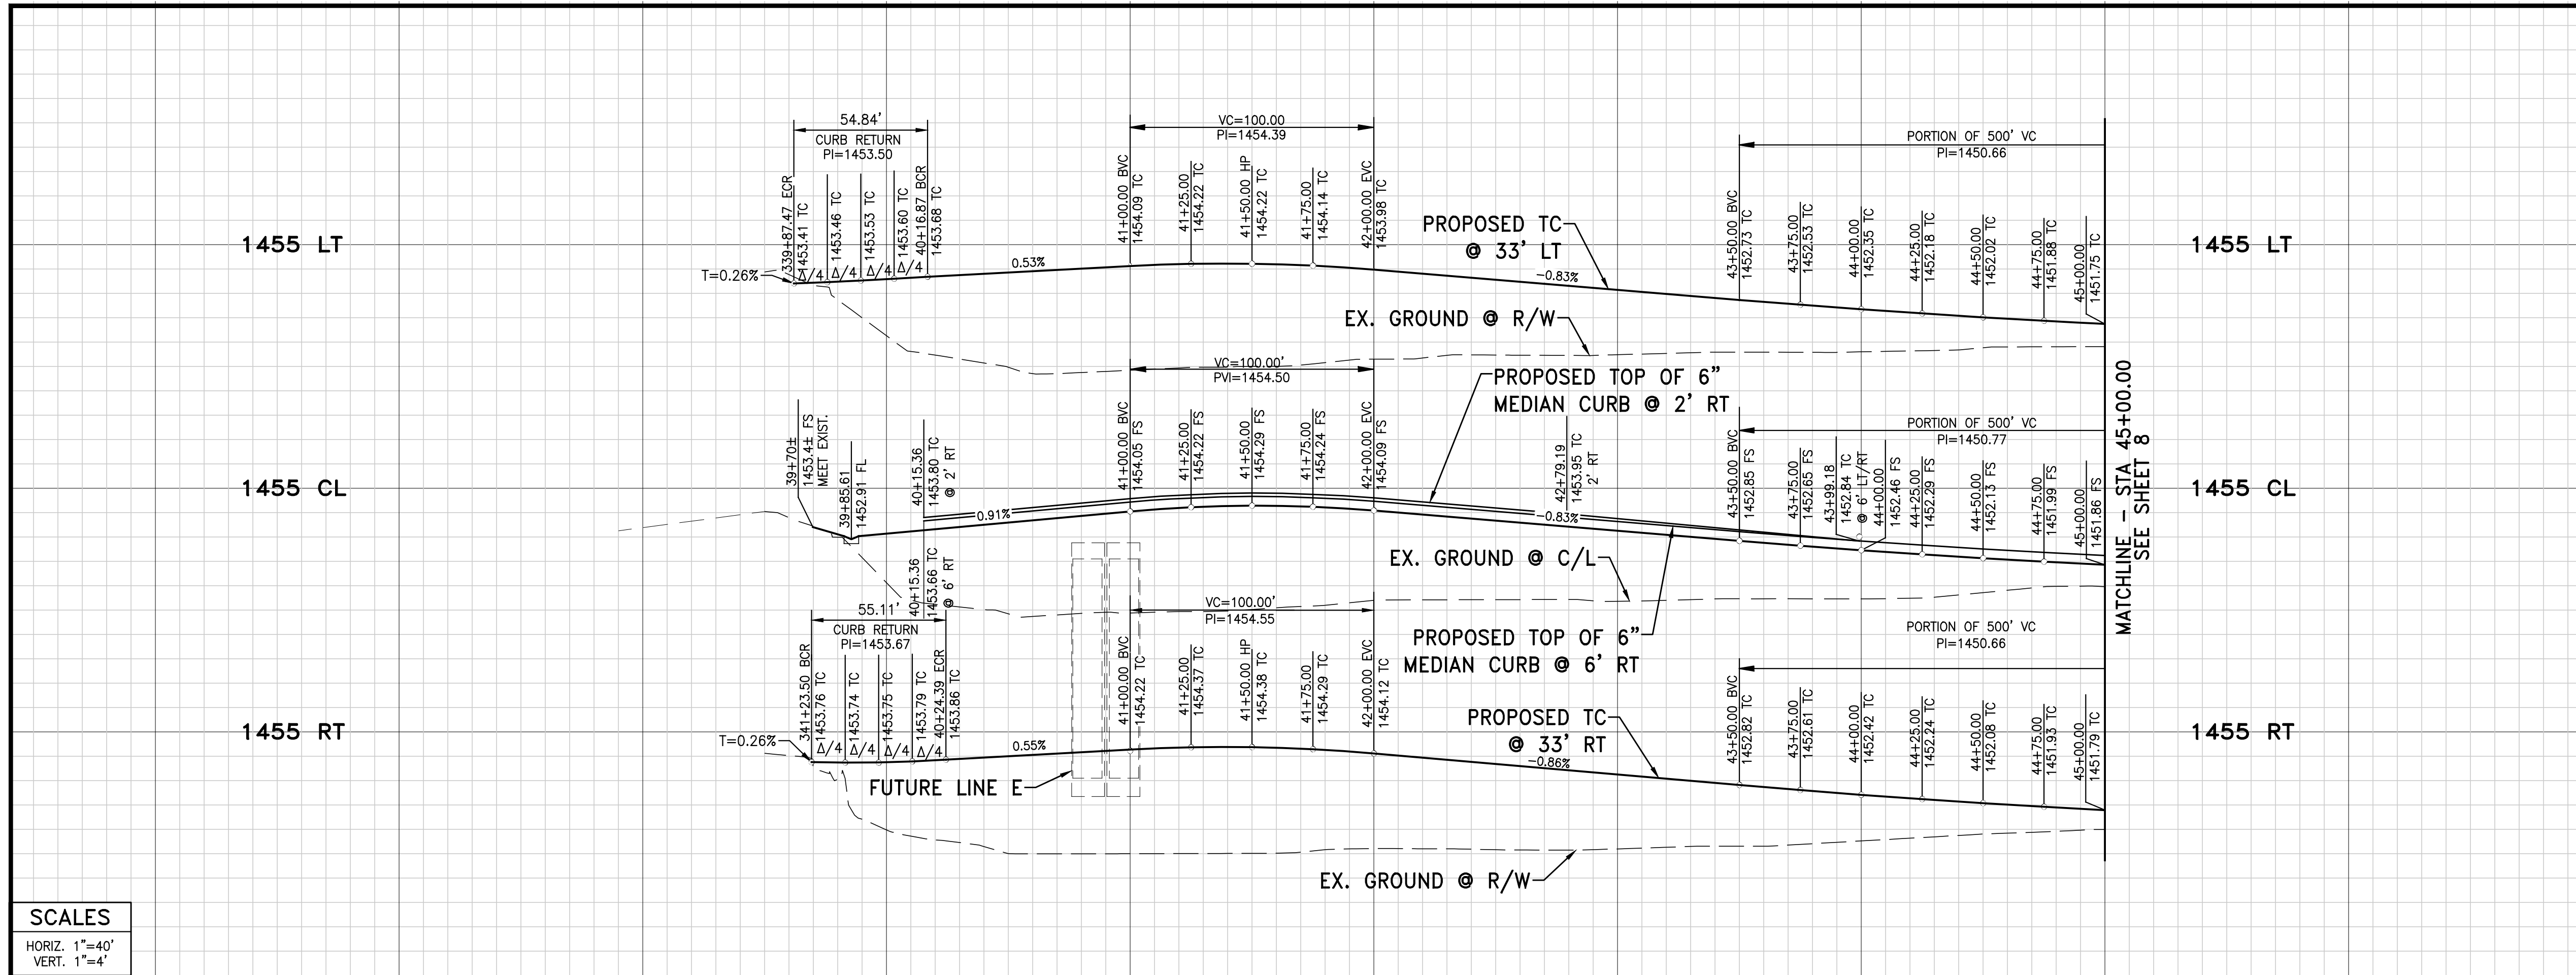


**SCALES**  
 HORIZ. 1"=40'  
 VERT. 1"=4'

**AS BUILT**


THESE PLANS REFLECT ANY SUBSTANTIAL DESIGN MODIFICATIONS AS PROVIDED TO WEBB ASSOCIATES BY THE CONTRACTOR

SIGNATURE: *[Signature]* DATE: 05/19/2016

REGISTERED PROFESSIONAL ENGINEER  
 D.J. ARELLANO  
 NO. 81988  
 CIVIL  
 STATE OF CALIFORNIA

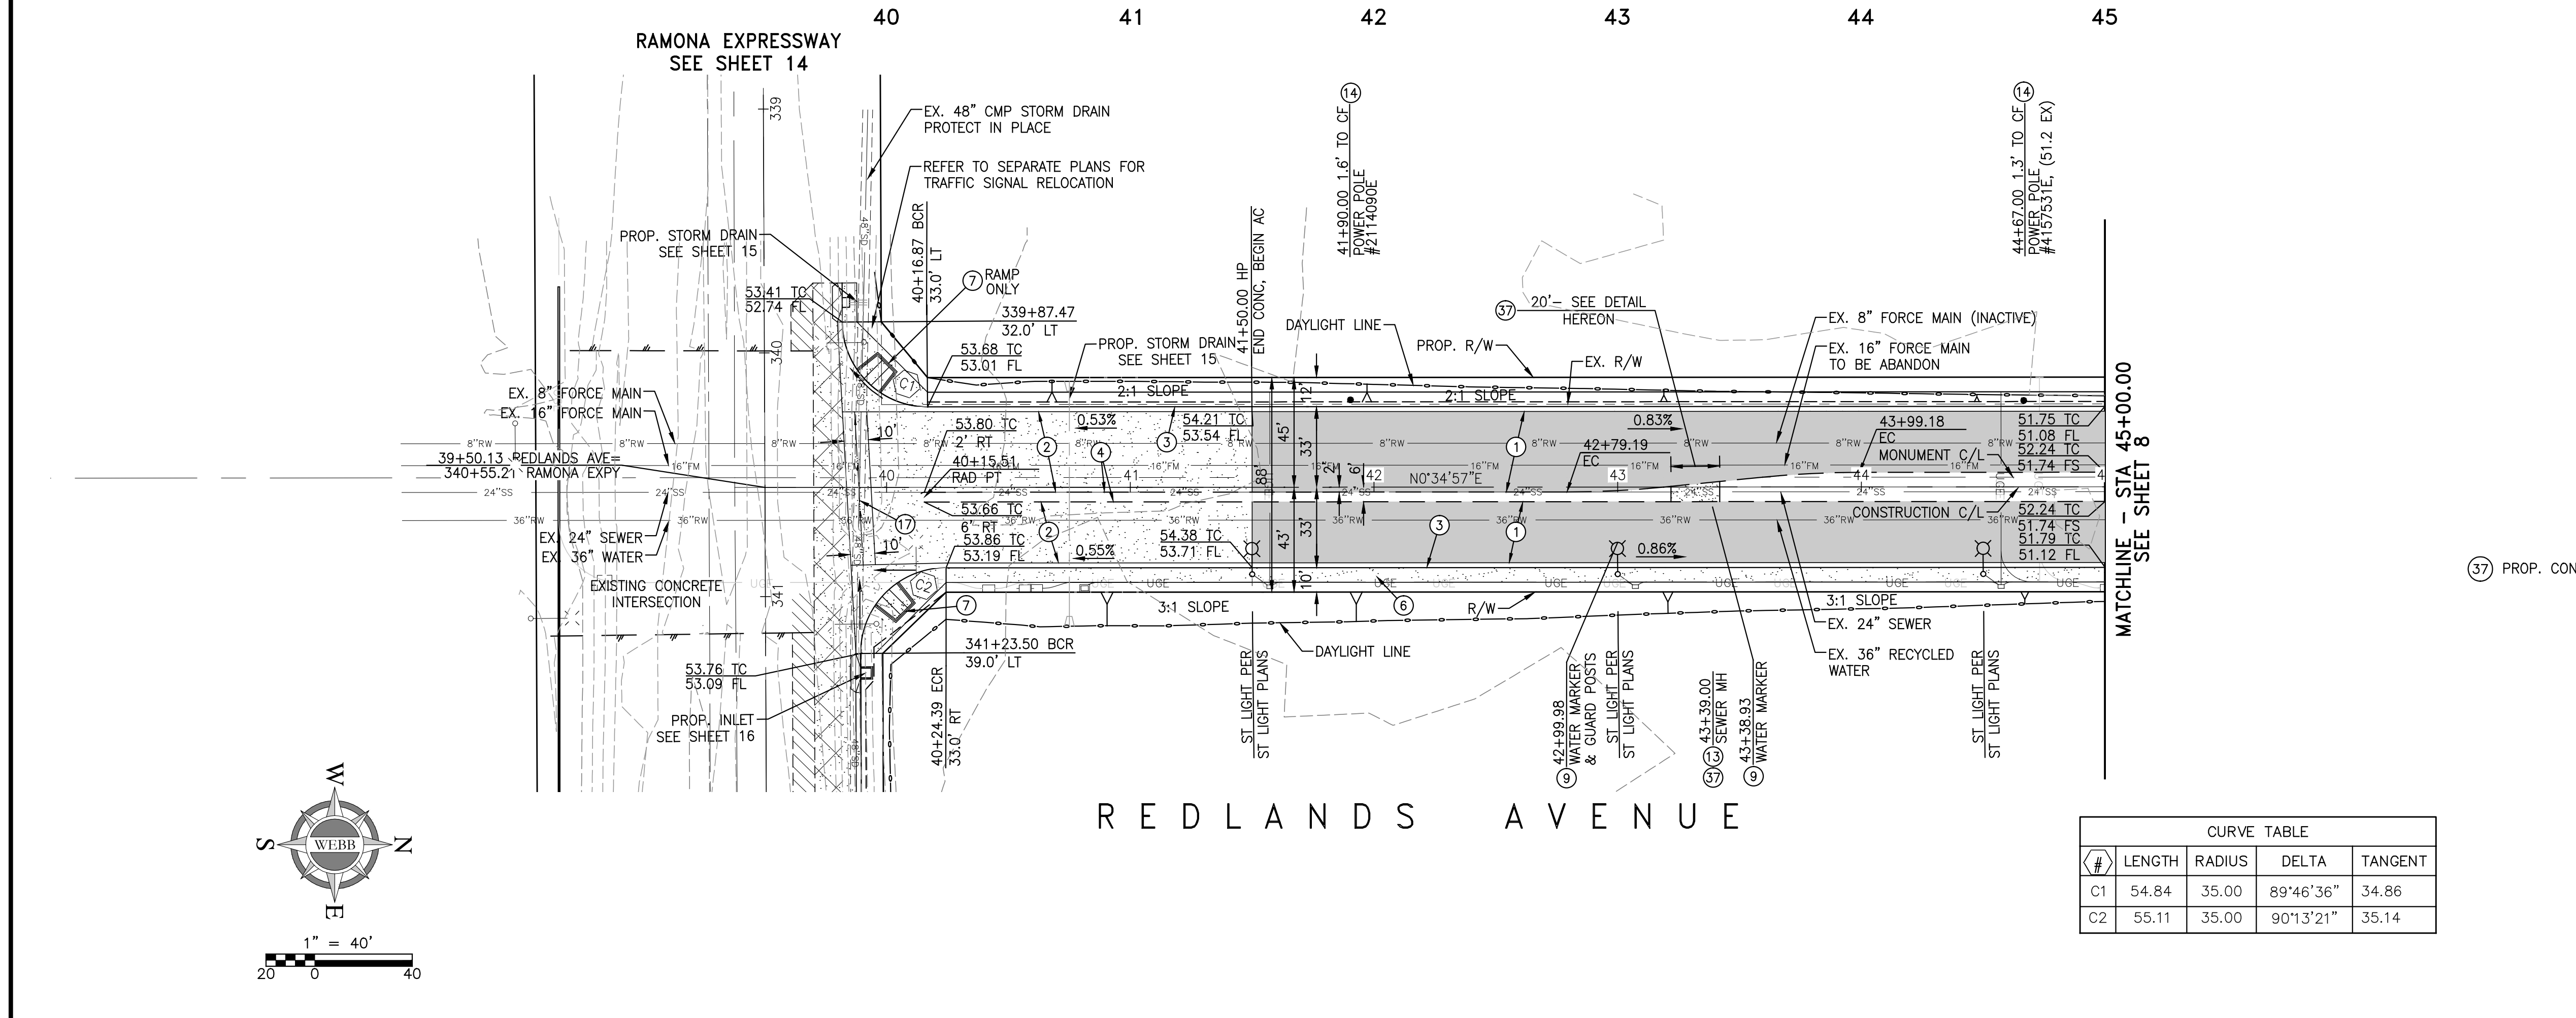

- CONSTRUCTION NOTES**
- CONSTRUCT MINIMUM 8" AC OVER 18" AB CLASS II
  - CONSTRUCT MIN. 8" (4,000 PSI) PCC OVER 16" CLASS II AB (C.J. @ 20' O.C.)
  - CONSTRUCT TYPE "A-8" CURB & GUTTER PER RIV. CO. STD. NO. 204
  - CONSTRUCT 6" TYPE "D" CURB PER RIV. CO. STD. NO. 204
  - CONSTRUCT 6' WIDE SIDEWALK PER RIV. CO. STD. 401
  - CONSTRUCT CURB RAMP PER RIV. CO. STD. NO. 403, CASE A
  - RELOCATE EX. UTILITY RISER -- BY UTILITY COMPANY
  - SAWCUT & JOIN EX. A.C. PAVEMENT PER DETAIL ON SHEET 2
  - ADJUST TO GRADE
  - PROTECT IN PLACE
  - CONSTRUCT CROSS GUTTER PER RIV. CO. STD. NO. 209
  - CONSTRUCT 8" THICK CONCRETE CLASS 560-C-3250; "B" AGGREGATE GRADATION

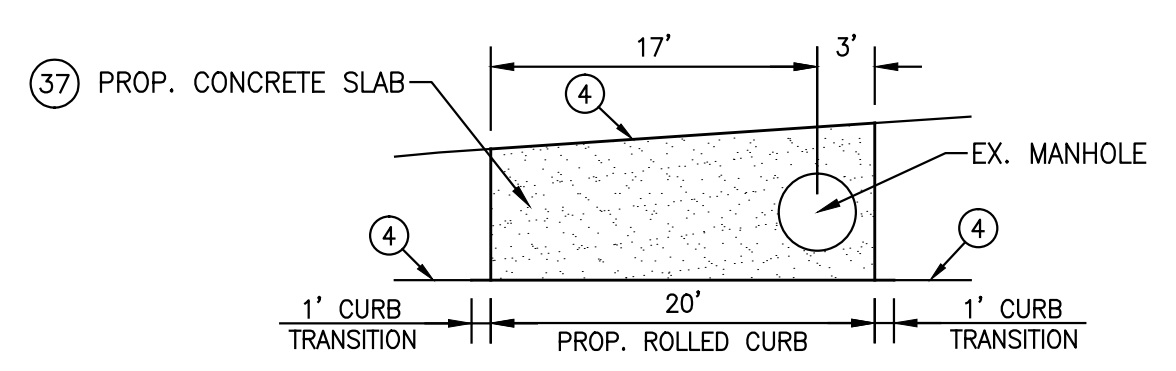

**CURVE TABLE**

#	LENGTH	RADIUS	DELTA	TANGENT
C1	54.84	35.00	89°46'36"	34.86
C2	55.11	35.00	90°13'21"	35.14

- LEGEND:**
- CONSTRUCT 8" AC OVER 18" AGGREGATE BASE
  - REMOVE EXISTING AC PAVING
  - INSTALL 8" PCC CONCRETE OVER 16" AGGREGATE BASE

**DIG ALERT**

CALL BEFORE YOU DIG

TWO WORKING DAYS BEFORE YOU DIG

TOLL FREE 1-800-227-2600

A PUBLIC SERVICE BY UNDERGROUND SERVICE ALERT

**NOTE:**  
 WORK CONTAINED WITHIN THESE PLANS SHALL NOT COMMENCE UNTIL AN ENCRoACHMENT PERMIT AND/OR A GRADING PERMIT HAS BEEN ISSUED.

THE PRIVATE ENGINEER SIGNING THESE PLANS IS RESPONSIBLE FOR ASSURING THE ACCURACY AND ACCEPTABILITY OF THE DESIGN HEREON. IN THE EVENT OF DISCREPANCIES ARISING AFTER CITY APPROVAL OR DURING CONSTRUCTION, THE PRIVATE ENGINEER SHALL BE RESPONSIBLE FOR DETERMINING AN ACCEPTABLE SOLUTION AND REVISING THE PLANS FOR APPROVAL BY THE CITY.

MARK	BY	DATE	REVISIONS	APPR.	DATE

CITY OF PERRIS  
 APPROVED BY: \_\_\_\_\_  
 CITY ENGINEER  
 DATE \_\_\_\_\_

SEAL - ENGINEER

REGISTERED PROFESSIONAL ENGINEER  
 D.J. ARELLANO  
 NO. 81988  
 CIVIL  
 STATE OF CALIFORNIA

ALBERT A. WEBB ASSOCIATES  
 ENGINEERING CONSULTANTS  
 3788 McCRAy STREET  
 RIVERSIDE, CA. 92506  
 PH. (951) 686-1070  
 FAX (951) 788-1256

UNDER THE SUPERVISION OF: \_\_\_\_\_  
 D.J. ARELLANO R.C.E. #081988 DATE 1/12/2015

BENCHMARK:  
 SEE SHEET 1



SCALE:  
 H: AS SHOWN V: AS SHOWN

CITY OF PERRIS  
 AMENDED DPR NO. 11-12-0004  
 STRATFORD RANCH-PARCEL MAP 36469  
 REDLANDS AVENUE  
 STA 39+50.13 TO STA 45+00.00

SHEET NO. 7  
 OF 23 SHEETS  
 P8-1189

C:\2013\13-0239\DRAWINGS\AS-BUILT\13-0239-C-ST-AB.DWG 5/18/2016 8:30 AM



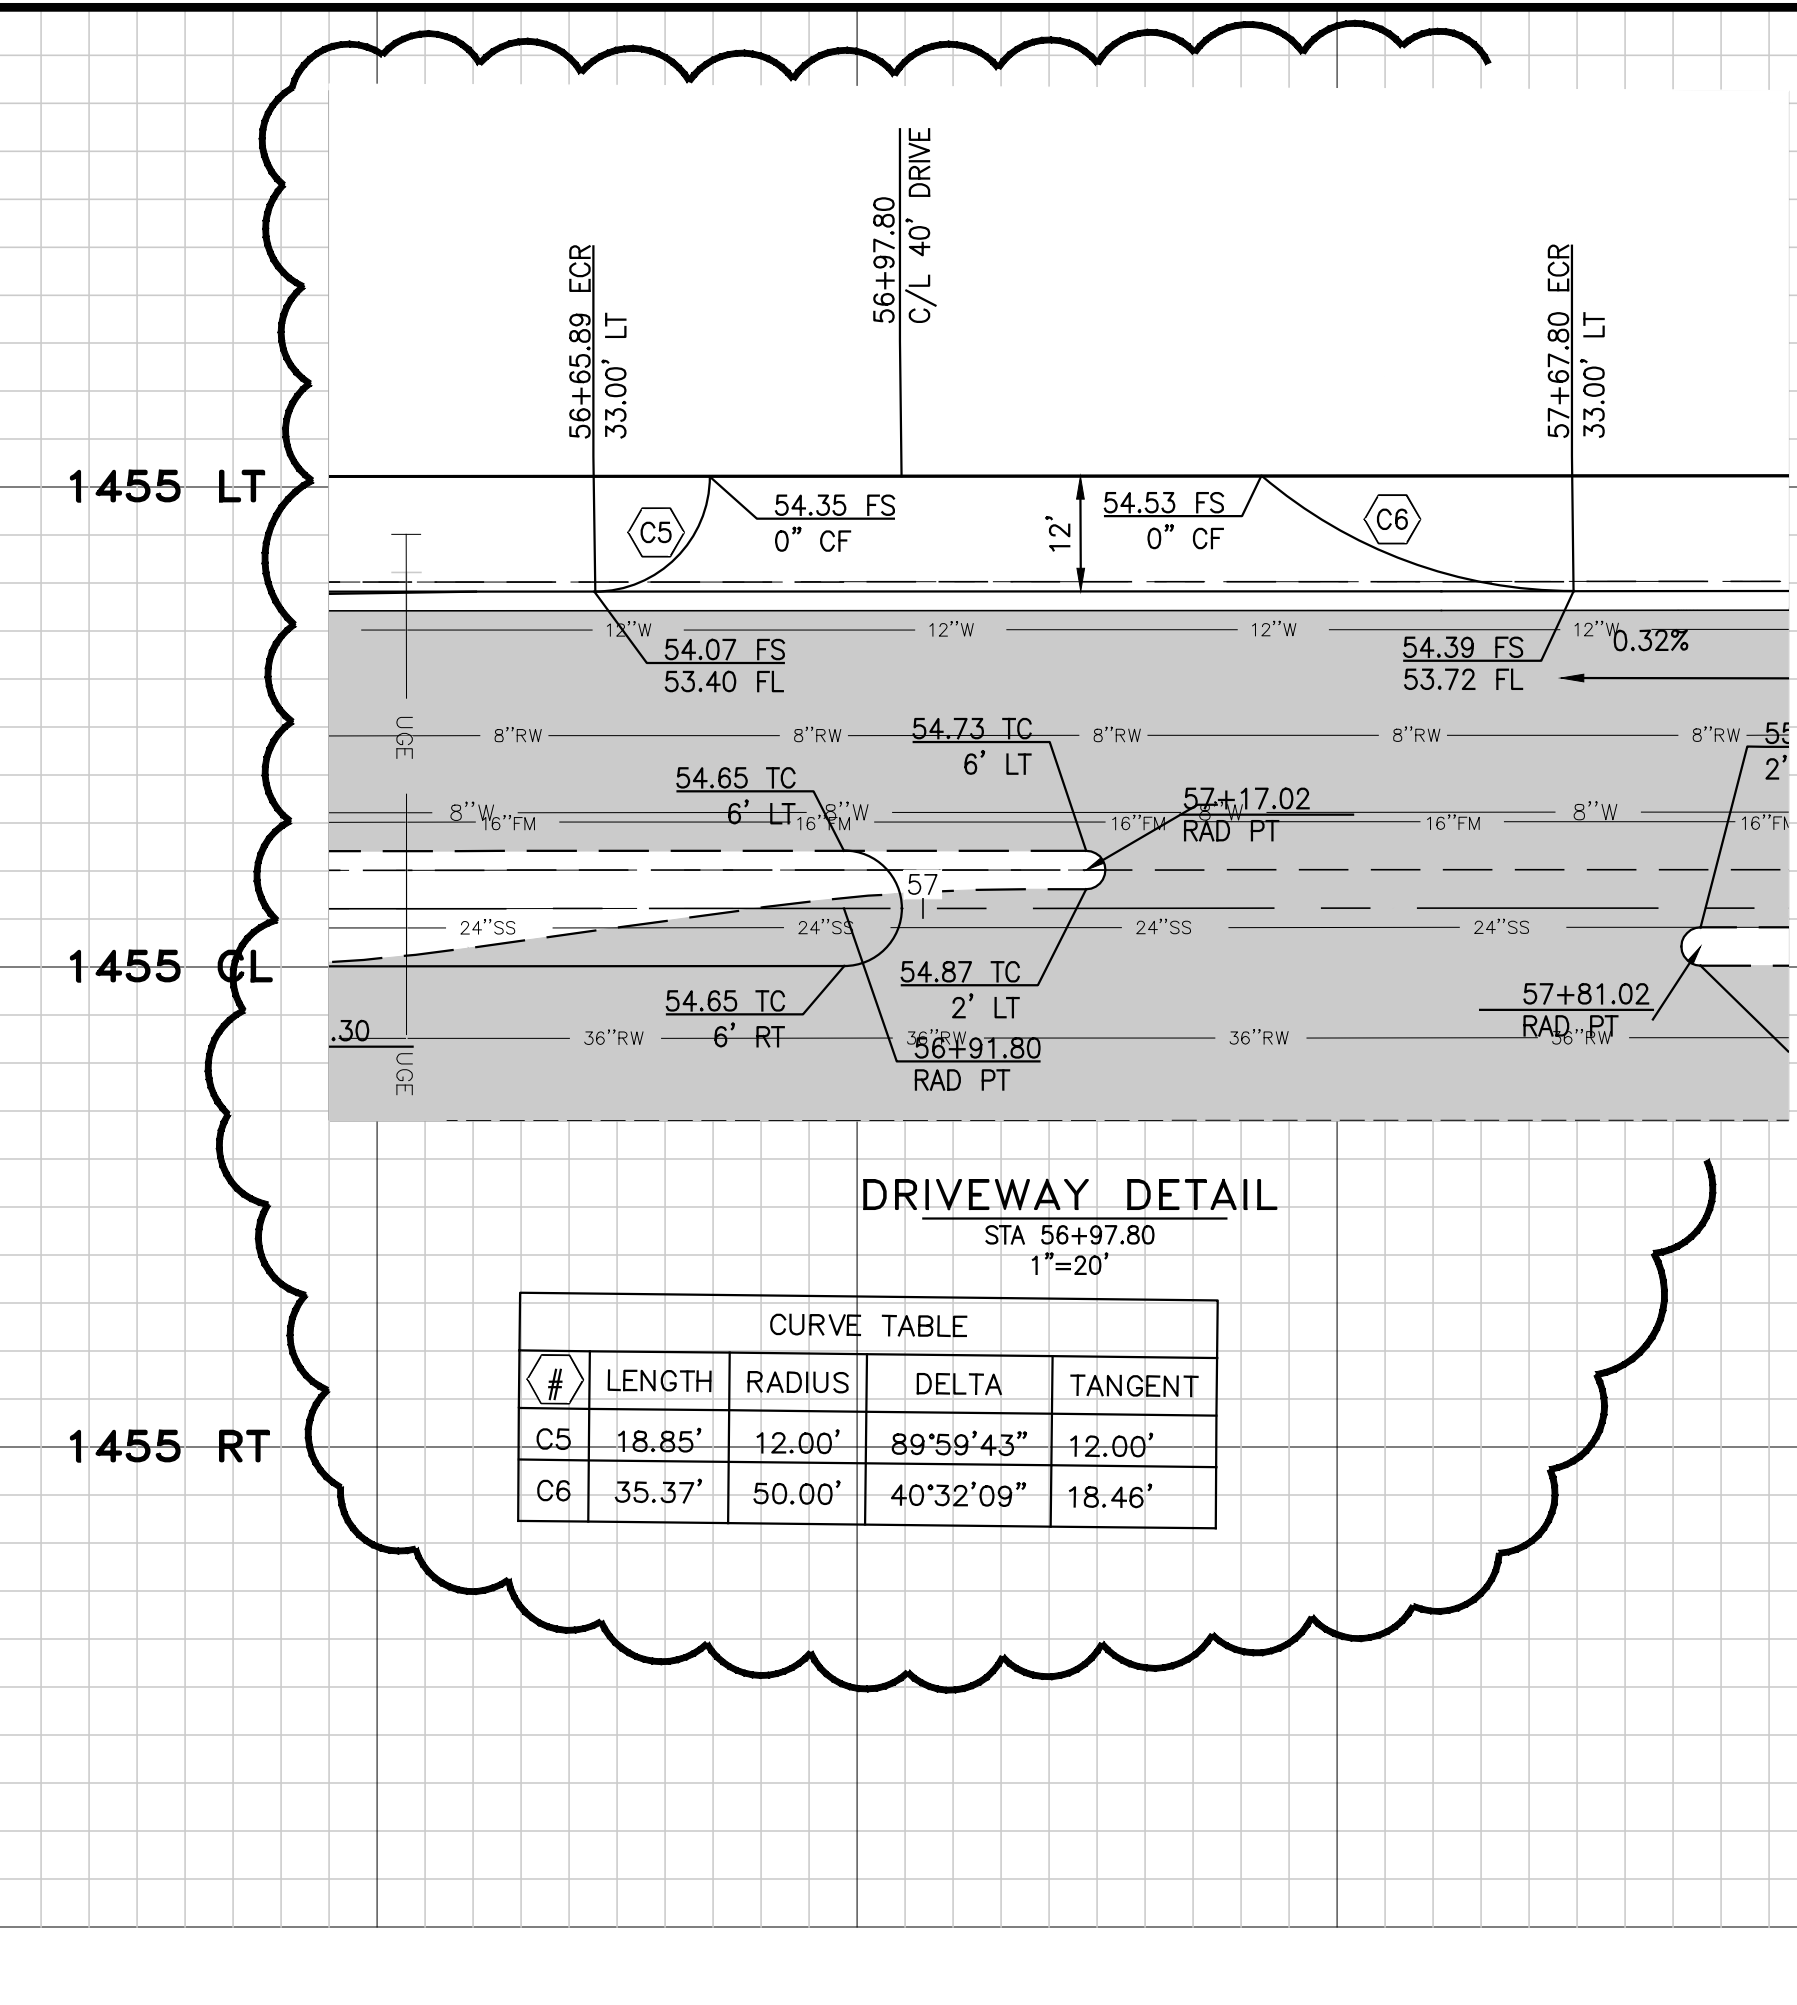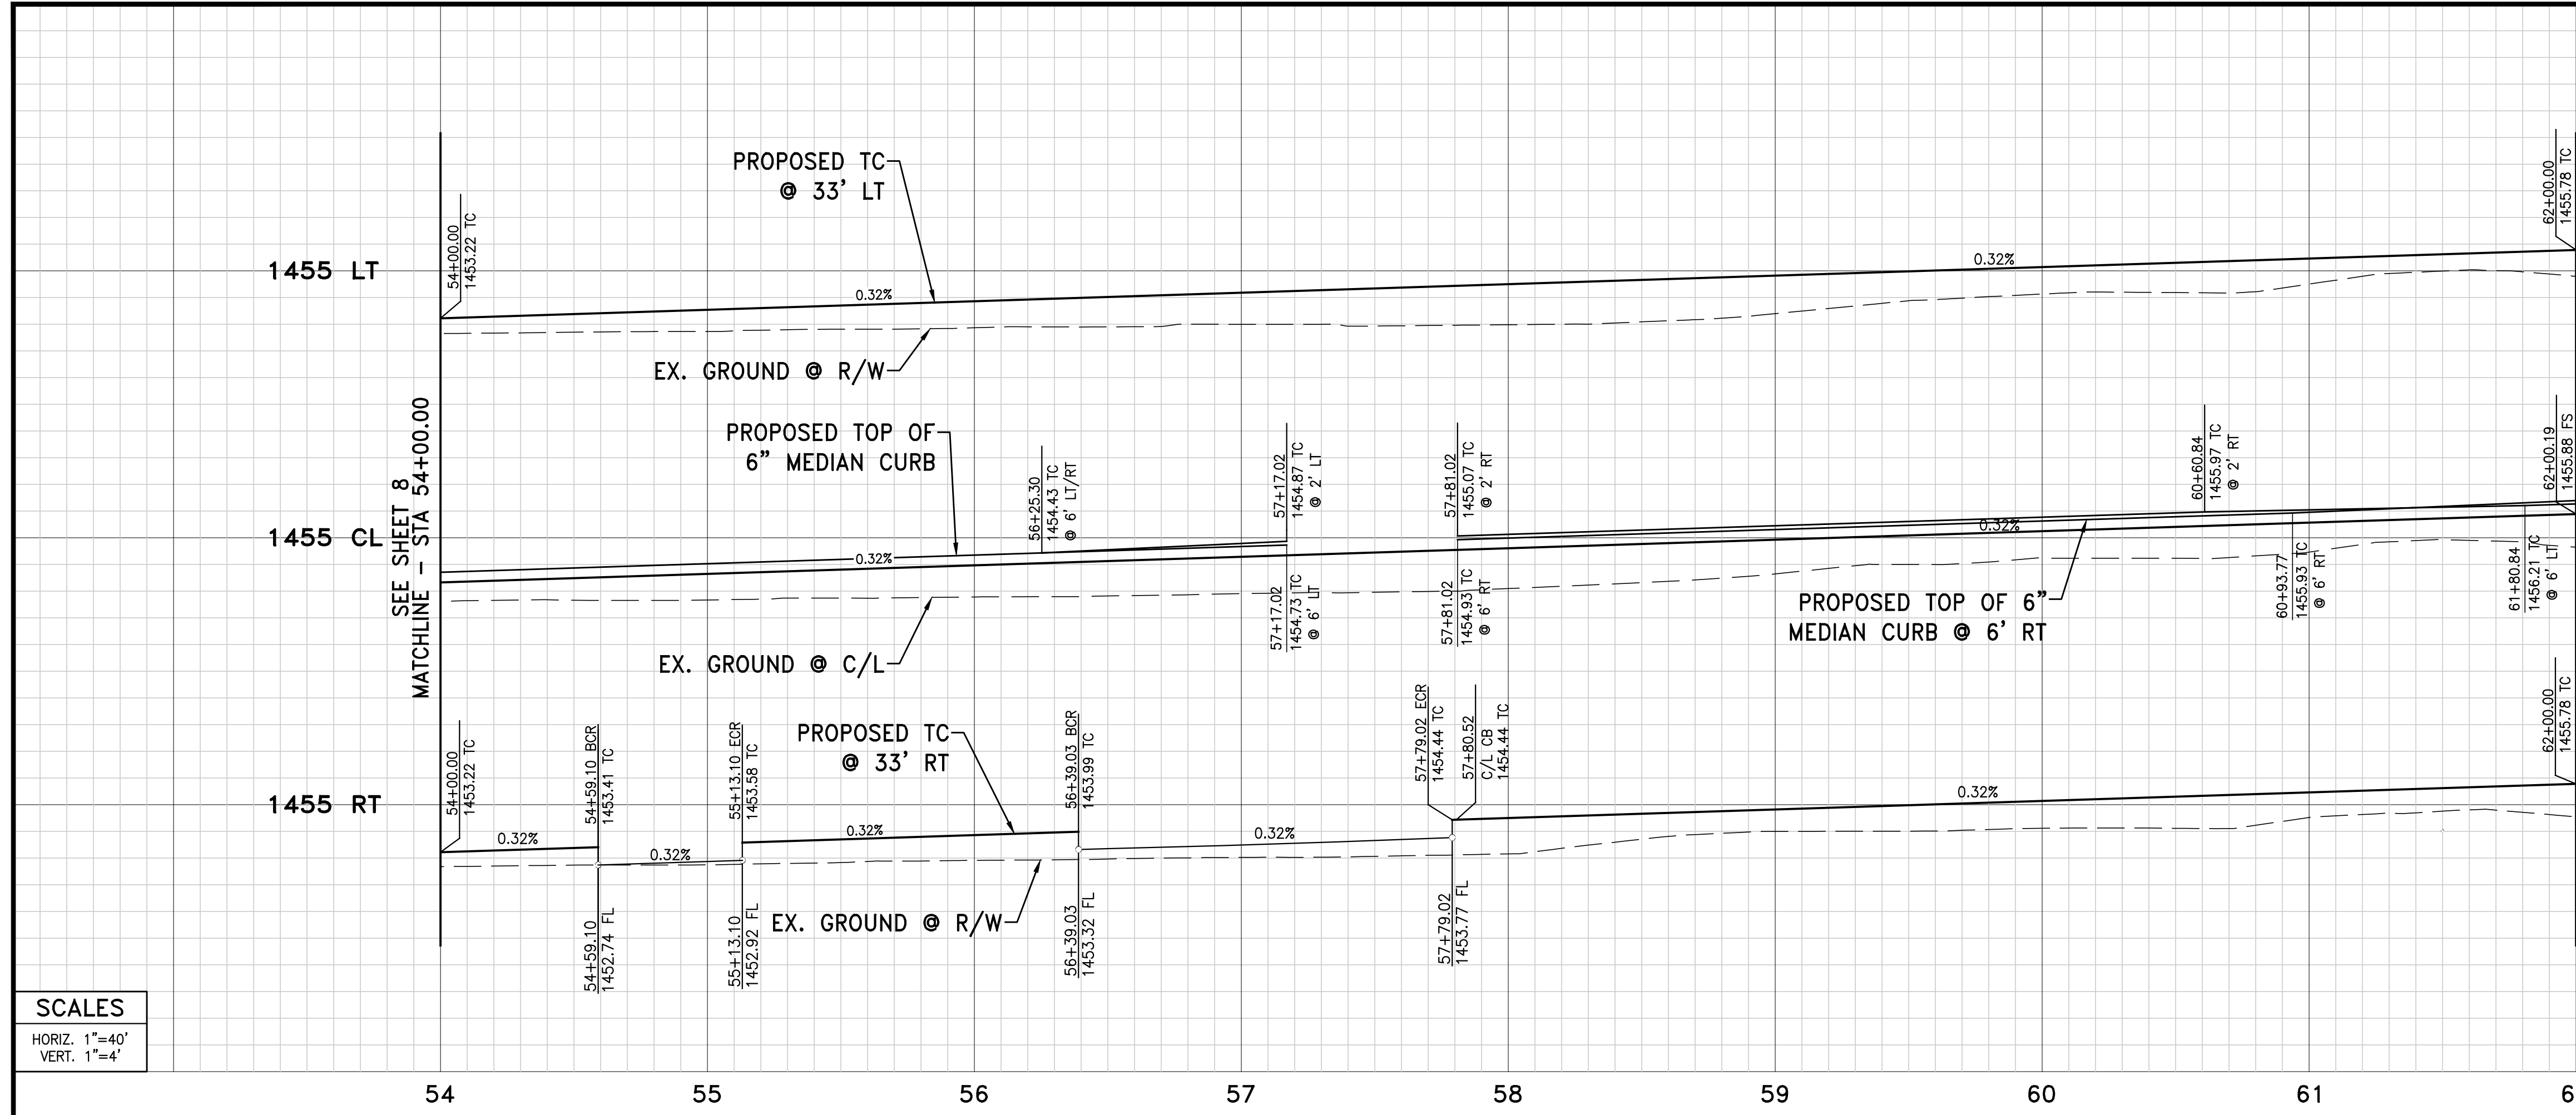

**SCALES**  
 HORIZ. 1"=40'  
 VERT. 1"=4'


**AS BUILT**

THESE PLANS REFLECT ANY SUBSTANTIAL DESIGN MODIFICATIONS AS PROVIDED TO WEBB ASSOCIATES BY THE CONTRACTOR

SIGNATURE: \_\_\_\_\_ DATE: 05/19/2016

REGISTERED PROFESSIONAL ENGINEER  
 D.J. ARELLANO  
 NO. 81988  
 CIVIL  
 STATE OF CALIFORNIA


- CONSTRUCTION NOTES**
- CONSTRUCT MINIMUM 8" AC OVER 18" AB CLASS II
  - CONSTRUCT MIN. 8" (4,000 PSI) PCC OVER 16" CLASS II AB (C.J. @ 20' O.C.)
  - CONSTRUCT TYPE "A-B" CURB & GUTTER PER RIV. CO. STD. NO. 201
  - CONSTRUCT 6" TYPE "D" CURB PER RIV. CO. STD. NO. 204
  - CONSTRUCT COMMERCIAL DRIVE PER RIV. CO. STD. NO. 207A
  - CONSTRUCT 6' WIDE SIDEWALK PER RIV. CO. STD. NO. 401
  - RELOCATE EX. UTILITY RISER - BY UTILITY COMPANY
  - ADJUST TO GRADE
  - PROTECT IN PLACE
  - CONSTRUCT DRAINAGE INLET TYPE G3 PER CALTRANS PLAN D73, AND DETAIL ON SHEET 2
  - CONSTRUCT 8" THICK CONCRETE CLASS 560-C-3250; "B" AGGREGATE GRADATION
  - CONSTRUCT BUS TURNOUT PER RIV. CO. STD. NO. 814

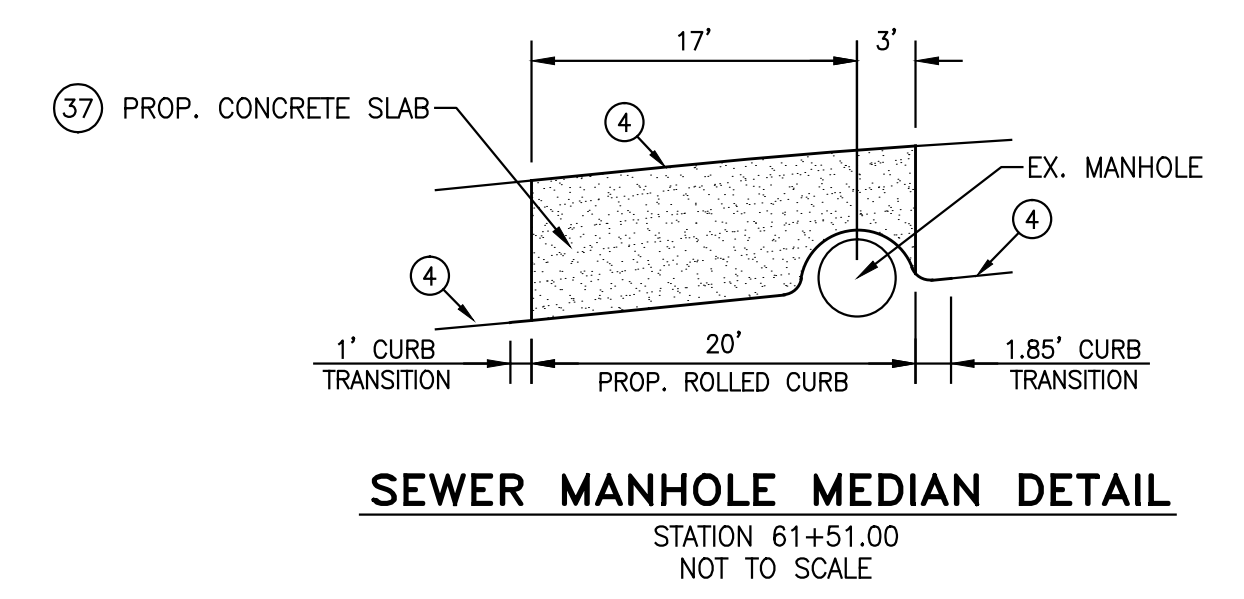

- LEGEND:**
- CONSTRUCT 8" AC OVER 18" AGGREGATE BASE
  - REMOVE EXISTING AC PAVING
  - INSTALL 8" PCC CONCRETE OVER 16" AGGREGATE BASE

#	LENGTH	RADIUS	DELTA	TANGENT
C1	23.56	15.00	090°00'00"	15.00
C2	32.18	50.00	036°52'12"	16.67
C3	1.32	1.00	075°31'21"	0.77
C4	7.91	3.00	151°02'42"	11.62

**REDLANDS AVENUE**

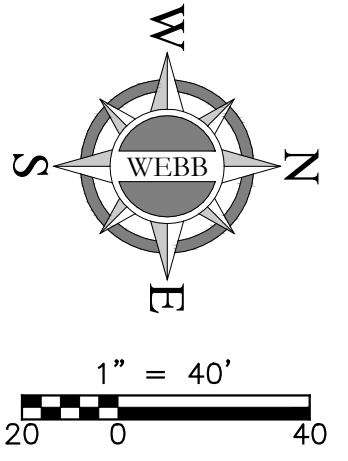

**DIG ALERT**

DIAL BEFORE YOU DIG

TWO WORKING DAYS BEFORE YOU DIG

TOLL FREE 1-800-227-2600

A PUBLIC SERVICE BY UNDERGROUND SERVICE ALERT

**NOTE:**  
 WORK CONTAINED WITHIN THESE PLANS SHALL NOT COMMENCE UNTIL AN ENCROACHMENT PERMIT AND/OR A GRADING PERMIT HAS BEEN ISSUED.

THE PRIVATE ENGINEER SIGNING THESE PLANS IS RESPONSIBLE FOR ASSURING THE ACCURACY AND ACCEPTABILITY OF THE DESIGN HEREON. IN THE EVENT OF DISCREPANCIES ARISING AFTER CITY APPROVAL OR DURING CONSTRUCTION, THE PRIVATE ENGINEER SHALL BE RESPONSIBLE FOR DETERMINING AN ACCEPTABLE SOLUTION AND REVISING THE PLANS FOR APPROVAL BY THE CITY.

MARK	BY	DATE	REVISIONS	APPR.	DATE
Δ	DJ	10/12/15	SHEET 9A SUPERCEDES SHEET 9		

CITY OF PERRIS  
 APPROVED BY:

CITY ENGINEER

DATE

SEAL - ENGINEER

REGISTERED PROFESSIONAL ENGINEER  
 D.J. ARELLANO  
 NO. 81988  
 CIVIL  
 STATE OF CALIFORNIA

**ALBERT A. WEBB ASSOCIATES**

ENGINEERING CONSULTANTS  
 3788 MCCRAY STREET  
 RIVERSIDE CA. 92506  
 PH. (951) 686-1070  
 FAX (951) 788-1256

UNDER THE SUPERVISION OF:




D.J. ARELLANO R.C.E. #C81988 DATE 1/12/2015

BENCHMARK:  
 SEE SHEET 1

SCALE:  
 H: AS SHOWN V: AS SHOWN

CITY OF PERRIS  
 AMENDED DPR NO. 11-12-0004  
 STRATFORD RANCH-PARCEL MAP 36469  
 REDLANDS AVENUE  
 STA 54+00.00 TO STA 62+00.00

SHEET NO.  
**9A**  
 OF 23 SHEETS  
 P8-1189

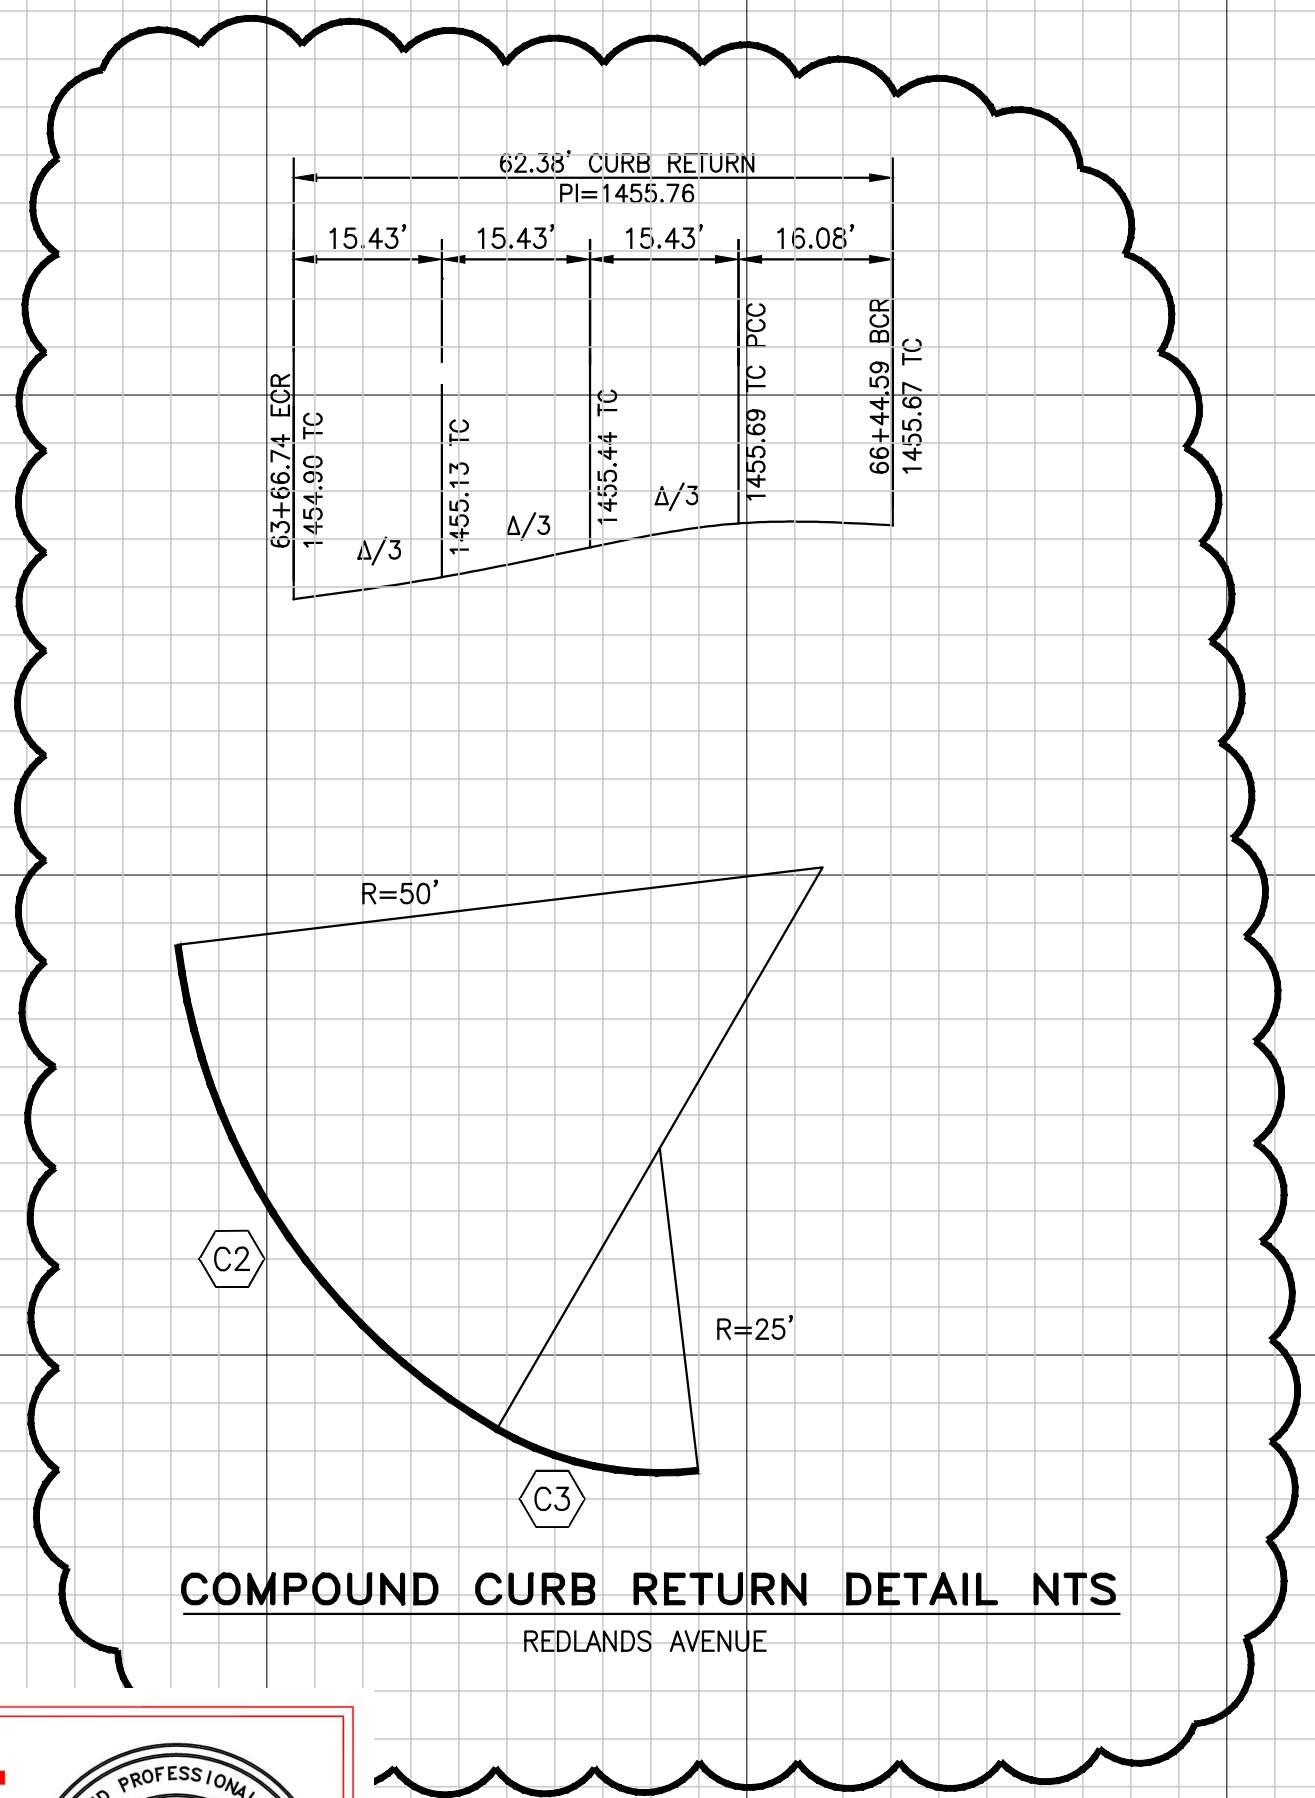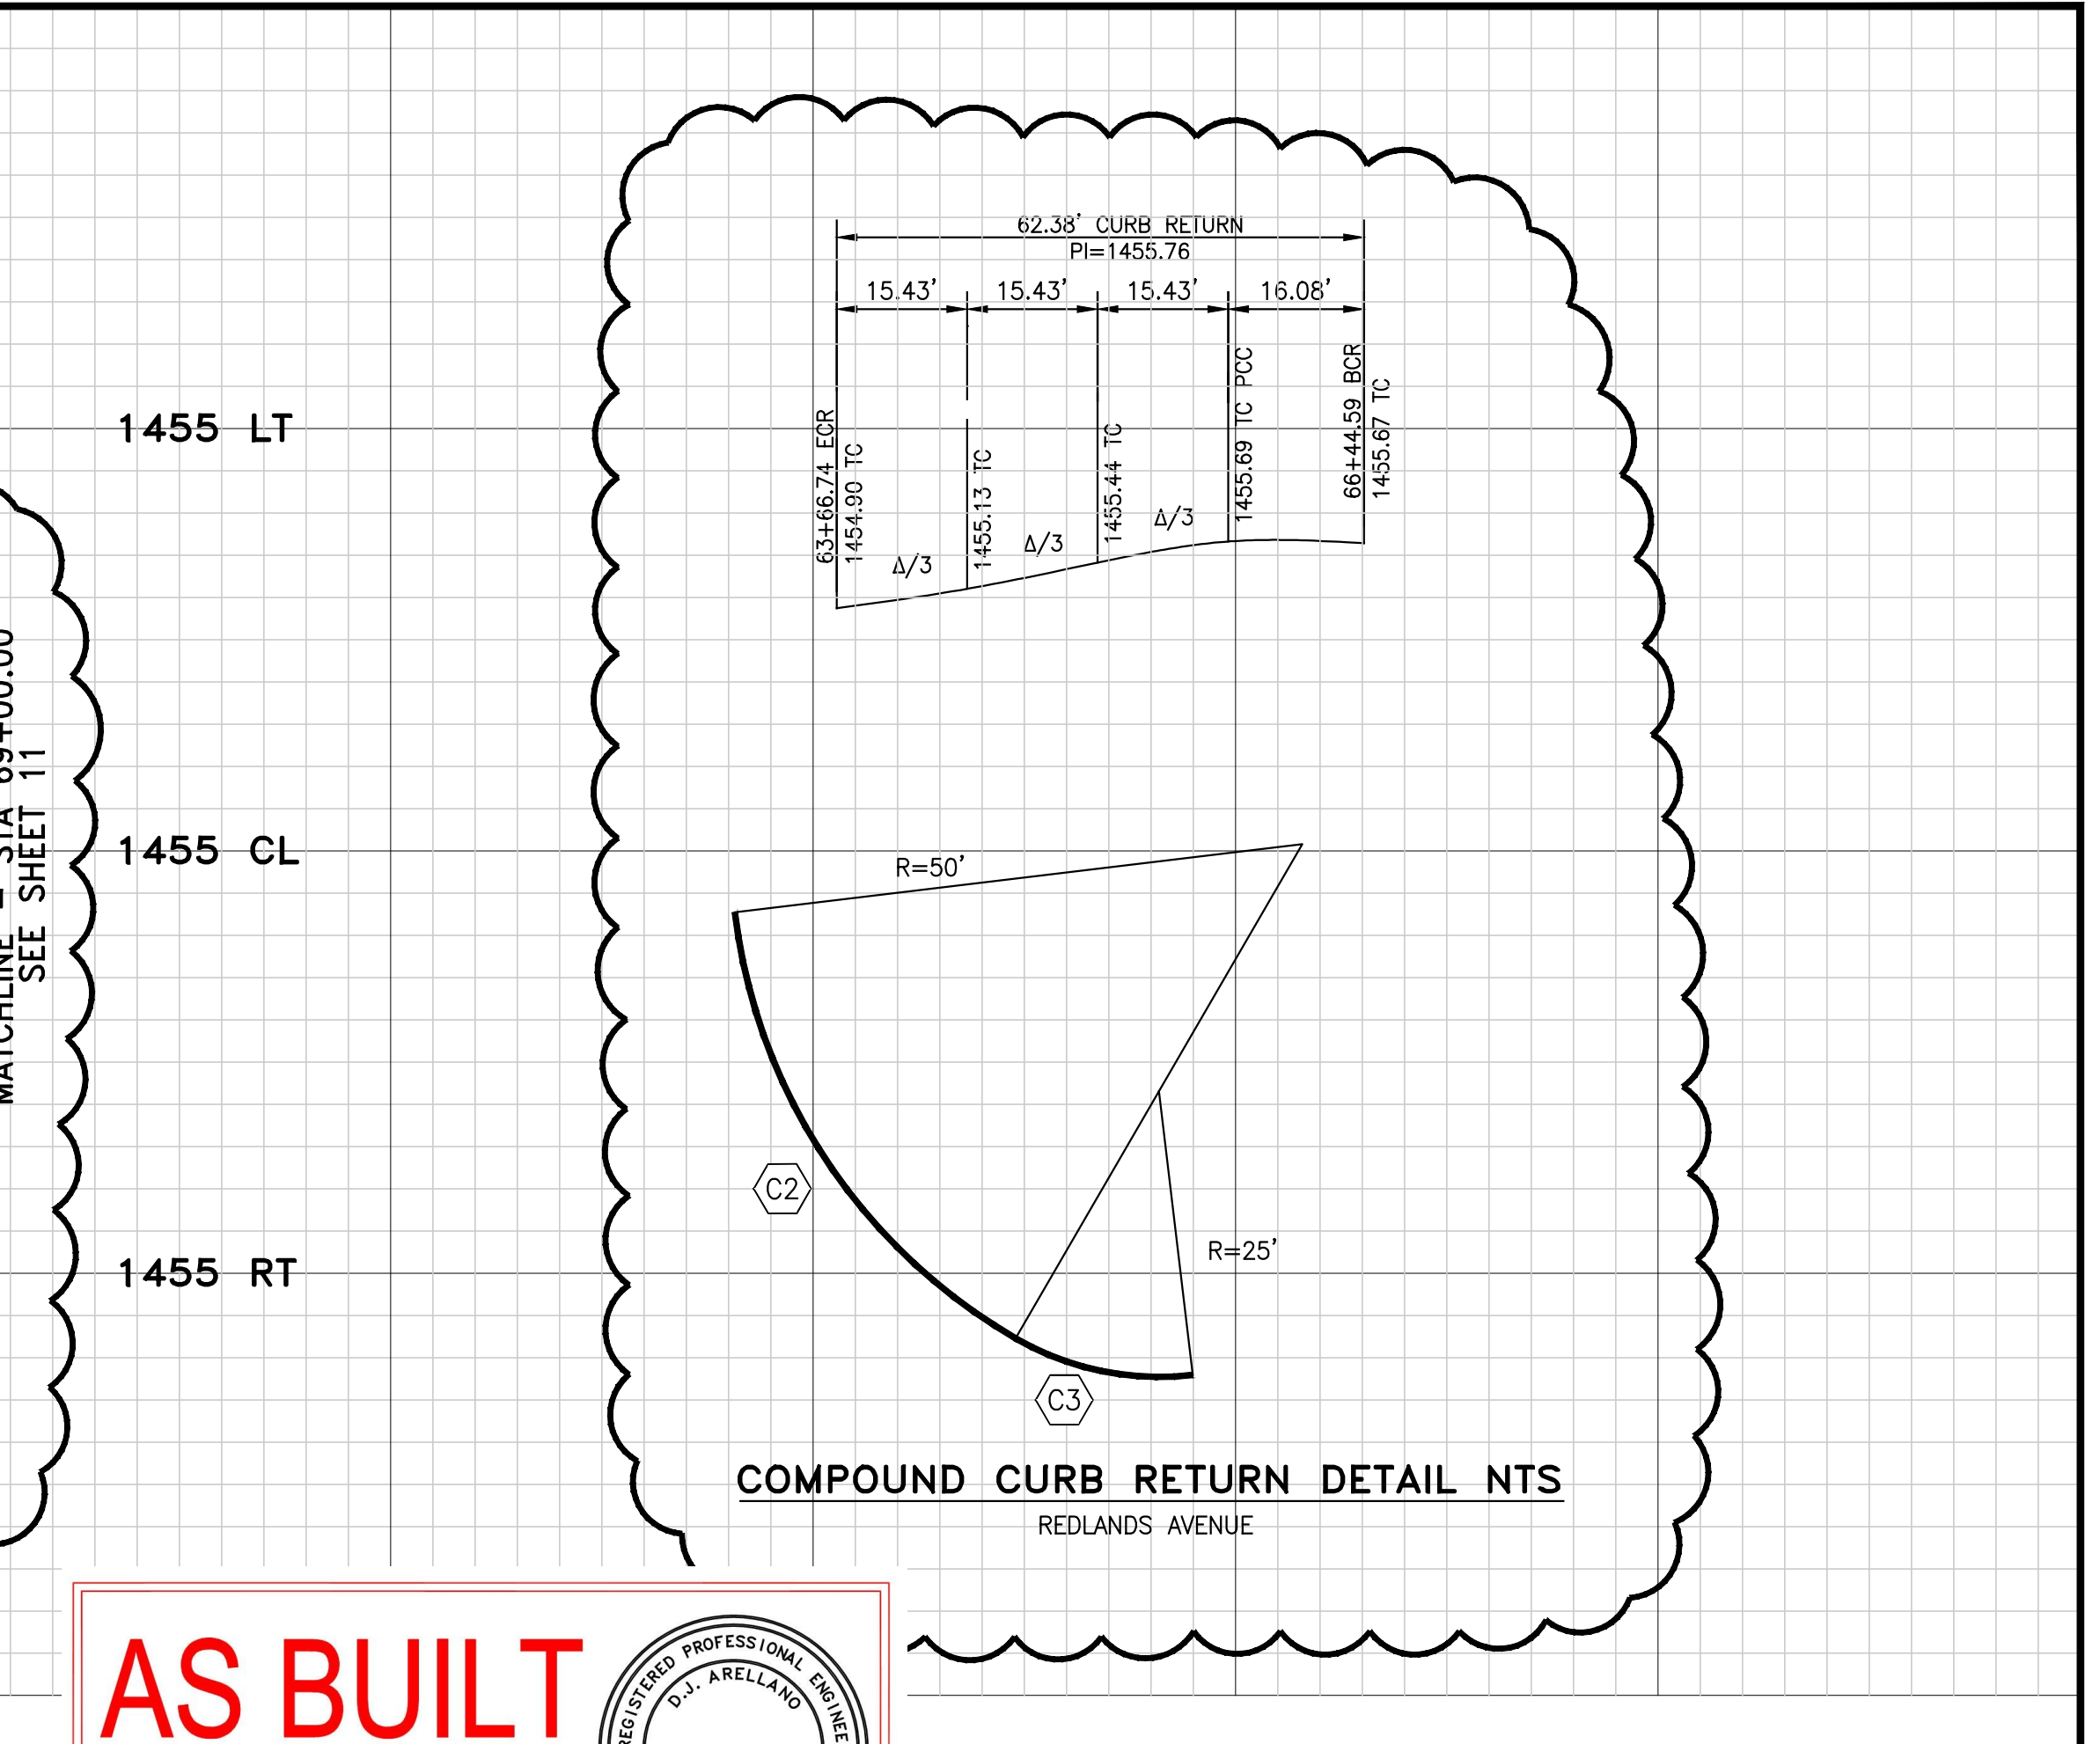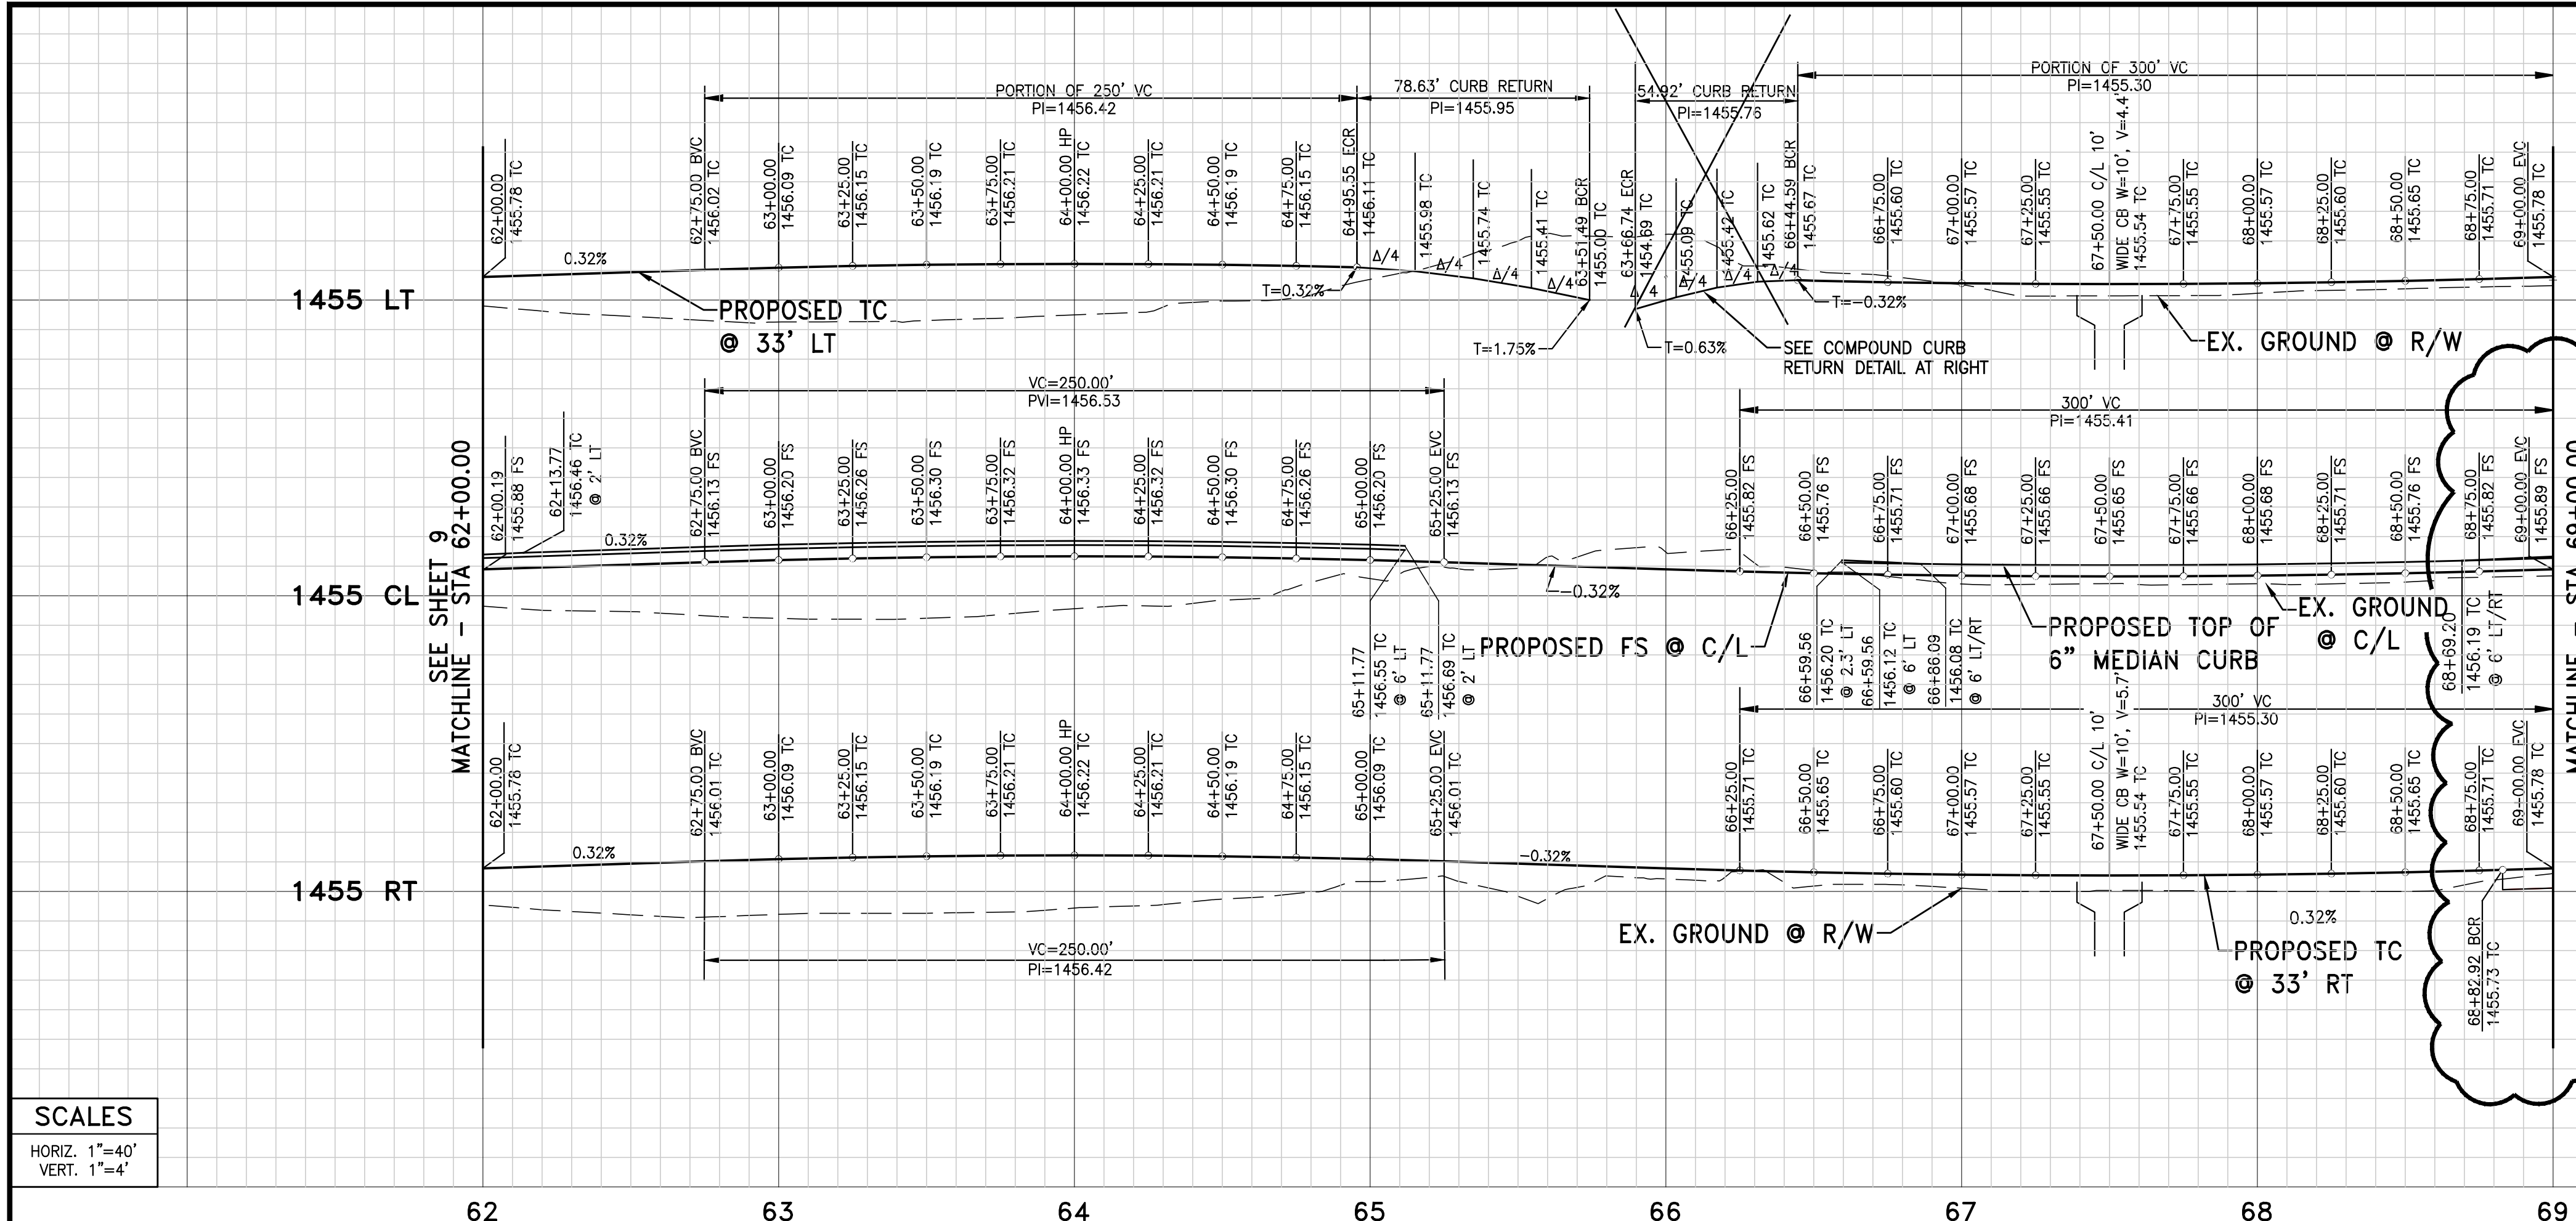

**SCALES**

HORIZ. 1"=40'

VERT. 1"=4'

**CURVE TABLE**

LENGTH	RADIUS	DELTA	TANGENT
C1 78.63	50.00	09°06'01"	50.09
C2 46.30	50.00	05°30'32"	24.96
C3 16.08	25.00	03°50'45"	8.33

**AS BUILT**

THESE PLANS REFLECT ANY SUBSTANTIAL DESIGN MODIFICATIONS AS PROVIDED TO WEBB ASSOCIATES BY THE CONTRACTOR




SIGNATURE: *[Signature]* DATE: 05/19/2016

REGISTERED PROFESSIONAL ENGINEER  
D.J. ARELLANO  
NO. 81988  
CIVIL  
STATE OF CALIFORNIA

- CONSTRUCTION NOTES**
- CONSTRUCT MINIMUM 8" AC OVER 18" AB CLASS II
  - CONSTRUCT MIN. 8" (4,000 PSI) PCC OVER 16" CLASS II AB (C.J. @ 20' O.C.)
  - CONSTRUCT TYPE "A-8" CURB & GUTTER PER RIV. CO. STD. NO. 201
  - CONSTRUCT 6" TYPE "D" CURB PER RIV. CO. STD. NO. 204
  - CONSTRUCT 6" WIDE SIDEWALK PER RIV. CO. STD. NO. 401
  - RELOCATE EX. UTILITY RISER - BY UTILITY COMPANY
  - ADJUST TO GRADE
  - PROTECT IN PLACE
  - CONSTRUCT CURB INLET CATCH BASIN PER RIV. CO. STD. NO. 300
  - CONSTRUCT LOCAL DEPRESSION PER RIV. CO. STD. NO. 311

**CURVE TABLE**

#	LENGTH	RADIUS	DELTA	TANGENT
C4	25.60'	12.00'	58°40'04"	14.05'
C5	35.37'	50.00'	40°32'09"	18.46'

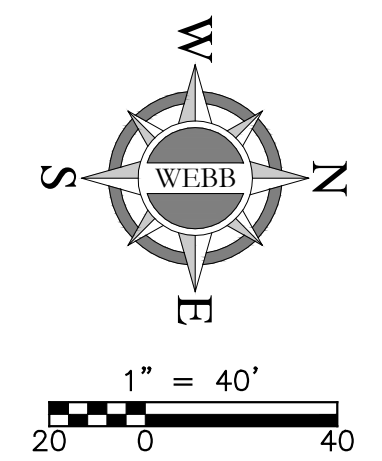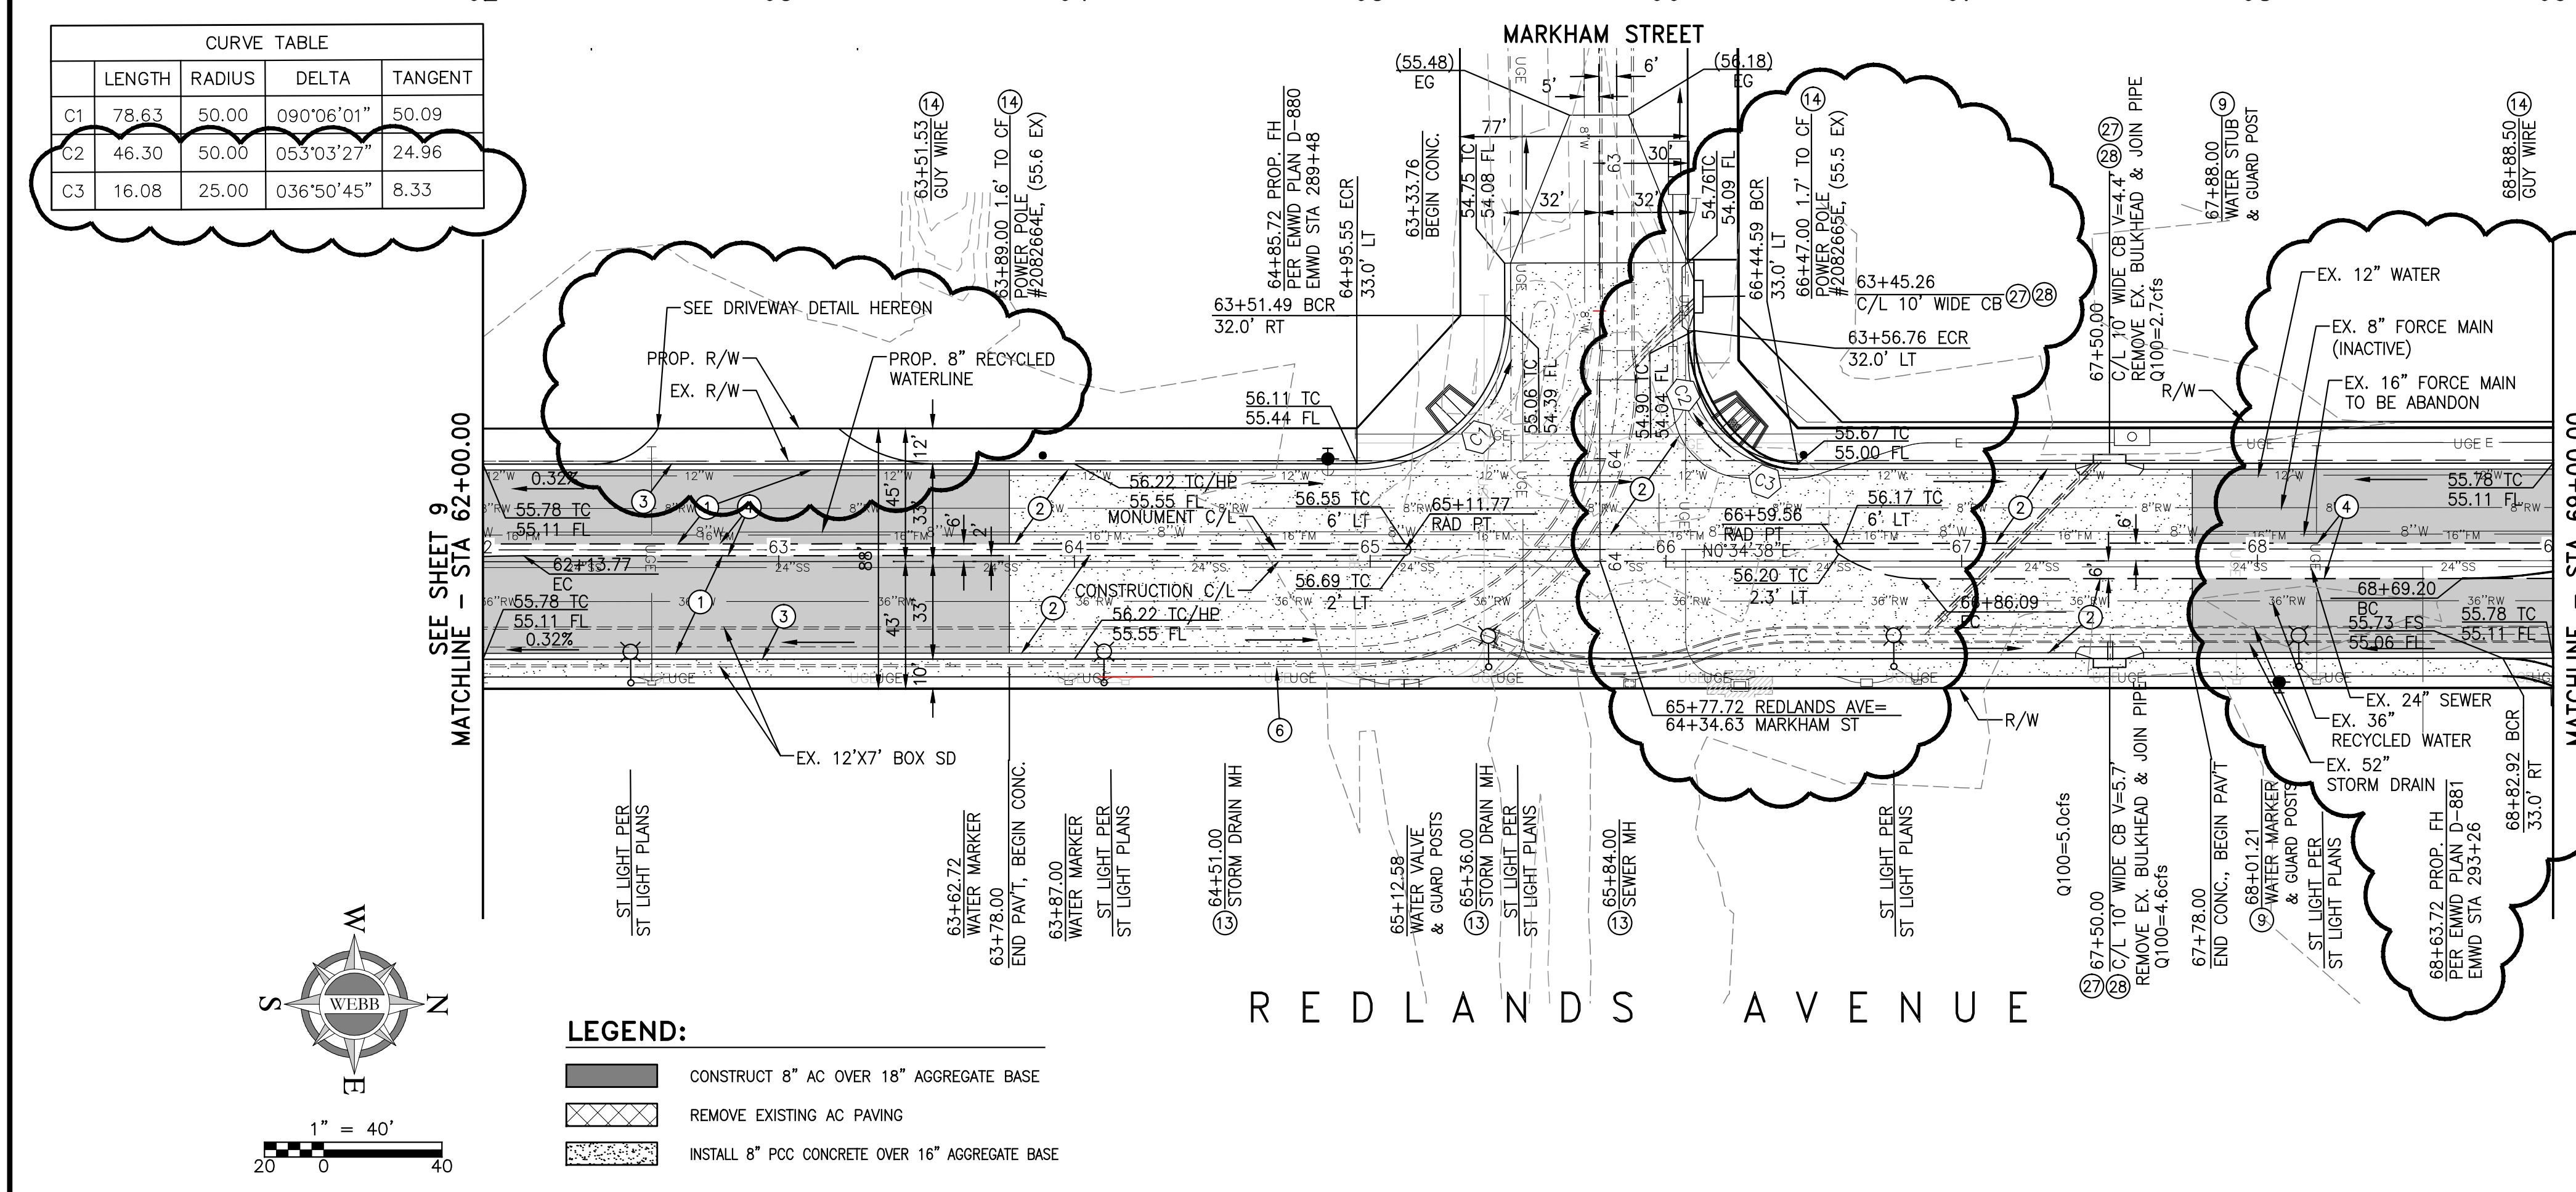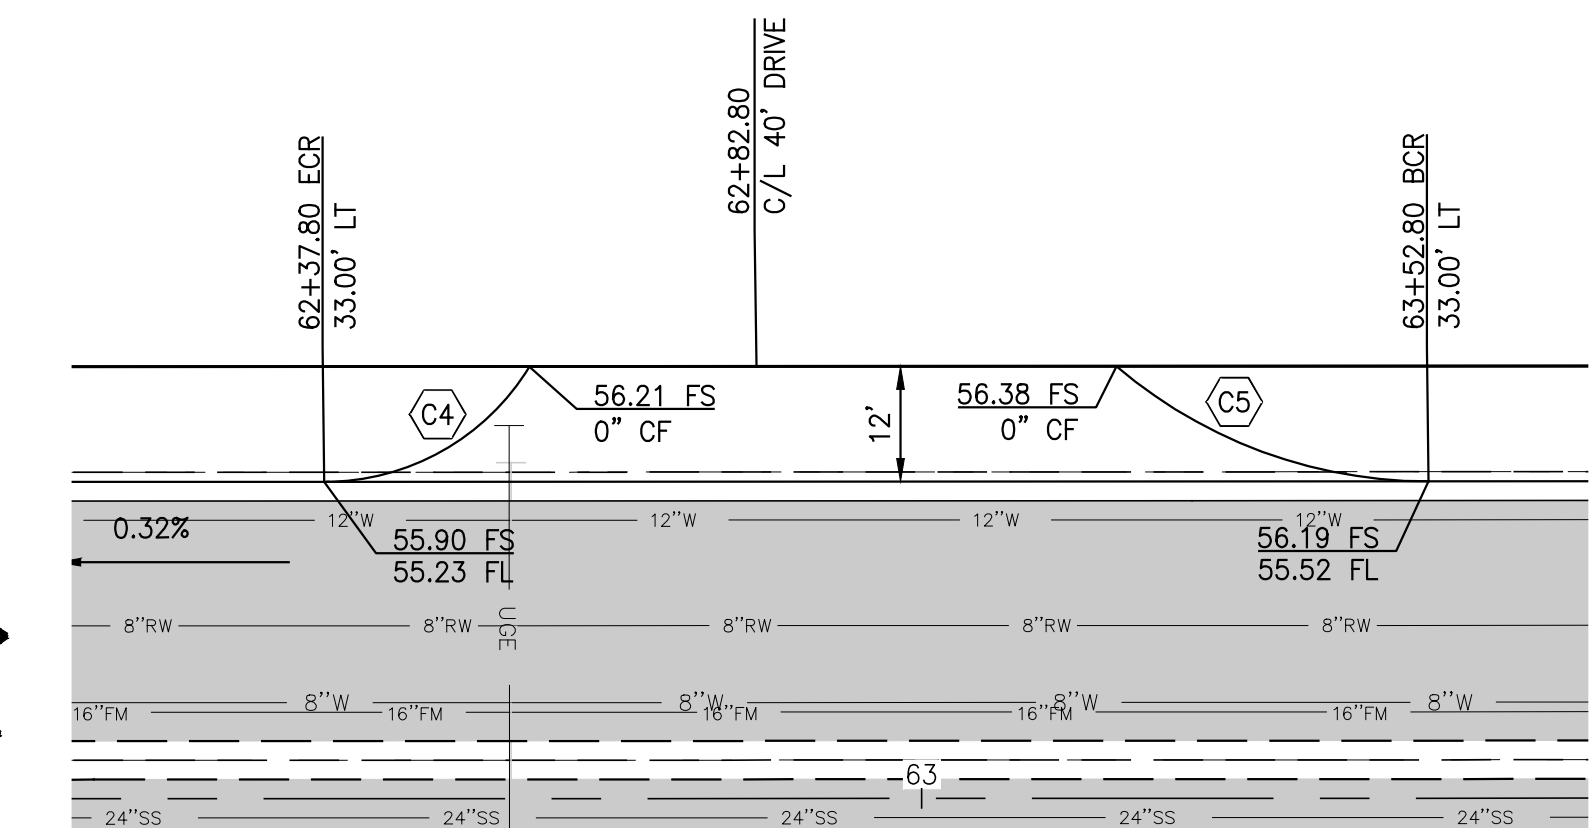

- LEGEND:**
- CONSTRUCT 8" AC OVER 18" AGGREGATE BASE
  - REMOVE EXISTING AC PAVING
  - INSTALL 8" PCC CONCRETE OVER 16" AGGREGATE BASE

**DIG ALERT**

NOTE: WORK CONTAINED WITHIN THESE PLANS SHALL NOT COMMENCE UNTIL AN ENCRoACHMENT PERMIT AND/OR A GRADING PERMIT HAS BEEN ISSUED.

THE PRIVATE ENGINEER SIGNING THESE PLANS IS RESPONSIBLE FOR ASSURING THE ACCURACY AND ACCEPTABILITY OF THE DESIGN HEREON. IN THE EVENT OF DISCREPANCIES ARISING AFTER CITY APPROVAL OR DURING CONSTRUCTION, THE PRIVATE ENGINEER SHALL BE RESPONSIBLE FOR DETERMINING AN ACCEPTABLE SOLUTION AND REVISING THE PLANS FOR APPROVAL BY THE CITY.

TWO WORKING DAYS BEFORE YOU DIG

1-800-227-2600

A PUBLIC SERVICE BY UNDERGROUND SERVICE ALERT

NOTE: WORK CONTAINED WITHIN THESE PLANS SHALL NOT COMMENCE UNTIL AN ENCRoACHMENT PERMIT AND/OR A GRADING PERMIT HAS BEEN ISSUED.

THE PRIVATE ENGINEER SIGNING THESE PLANS IS RESPONSIBLE FOR ASSURING THE ACCURACY AND ACCEPTABILITY OF THE DESIGN HEREON. IN THE EVENT OF DISCREPANCIES ARISING AFTER CITY APPROVAL OR DURING CONSTRUCTION, THE PRIVATE ENGINEER SHALL BE RESPONSIBLE FOR DETERMINING AN ACCEPTABLE SOLUTION AND REVISING THE PLANS FOR APPROVAL BY THE CITY.

REVISIONS

MARK	BY	DATE	REVISIONS
A	DJ	10/12/16	SHEET 10A SUPERCEDES SHEET 10

CITY OF PERRIS  
APPROVED BY: \_\_\_\_\_  
CITY ENGINEER

SEAL - ENGINEER

REGISTERED PROFESSIONAL ENGINEER  
D.J. ARELLANO  
NO. 81988  
CIVIL  
STATE OF CALIFORNIA

ALBERT A. WEBB ASSOCIATES  
ENGINEERING CONSULTANTS  
3788 McCRAY STREET  
RIVERSIDE CA. 92506  
PH. (951) 686-1070  
FAX (951) 788-1256

UNDER THE SUPERVISION OF: \_\_\_\_\_  
D.J. ARELLANO R.C.E. #C81988 DATE: 1/12/2015


BENCHMARK: SEE SHEET 1

CITY OF PERRIS  
AMENDED DPR NO. 11-12-0004  
STRATFORD RANCH-PARCEL MAP 36469  
REDLANDS AVENUE  
STA 62+00.00 TO STA 70+00.00

SHEET NO. 10A OF 23 SHEETS

FOR: H: AS SHOWN V: AS SHOWN

W.O. 2013-0239 CITY FILE NO. P8-1189

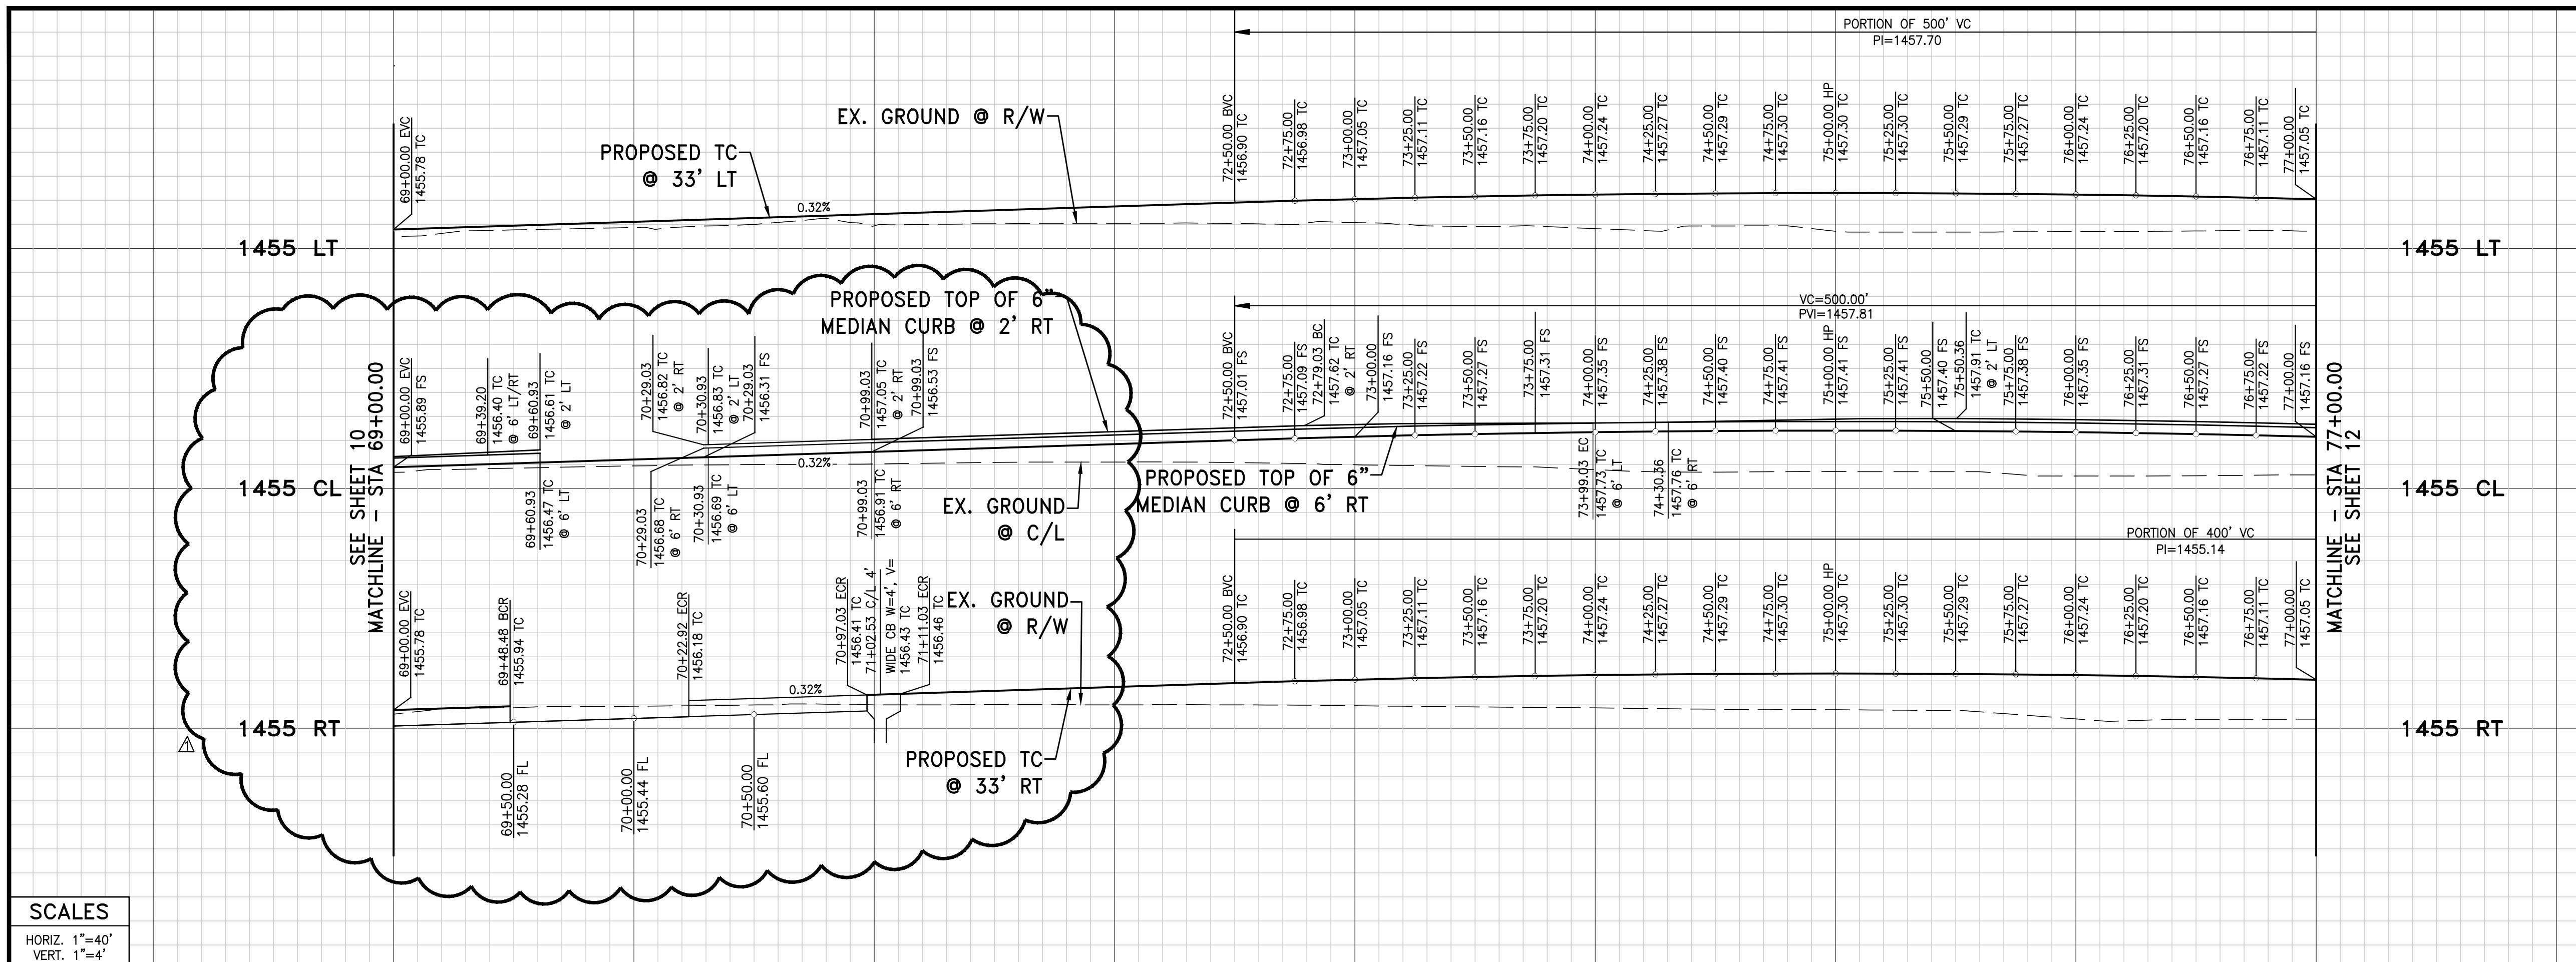

**SCALES**  
 HORIZ. 1"=40'  
 VERT. 1"=4'

**AS BUILT**


THESE PLANS REFLECT ANY SUBSTANTIAL DESIGN MODIFICATIONS AS PROVIDED TO WEBB ASSOCIATES BY THE CONTRACTOR

SIGNATURE: [Signature] DATE: 05/19/2016

REGISTERED PROFESSIONAL ENGINEER  
 D.J. ARELLANO  
 NO. 81988  
 CIVIL  
 STATE OF CALIFORNIA

69 70 71 72 73 74 75 76 77 78


- CONSTRUCTION NOTES**
- CONSTRUCT MINIMUM 8" AC OVER 18" AB CLASS II
  - CONSTRUCT TYPE "A-B" CURB & GUTTER PER RIV. CO. STD. NO. 201
  - CONSTRUCT COMMERCIAL DRIVE PER RIV. CO. STD. NO. 207A
  - CONSTRUCT 6' WIDE SIDEWALK PER RIV. CO. STD. 401
  - RELOCATE EX. UTILITY RISER - BY UTILITY COMPANY
  - ADJUST TO GRADE
  - PROTECT IN PLACE
  - CONSTRUCT CURB INLET CATCH BASIN PER RIV. CO. STD. NO. 300
  - CONSTRUCT LOCAL DEPRESSION PER RIV. CO. STD. NO. 311
  - CONSTRUCT 8" THICK CONCRETE CLASS 560-C-3250; "B" AGGREGATE GRADATION

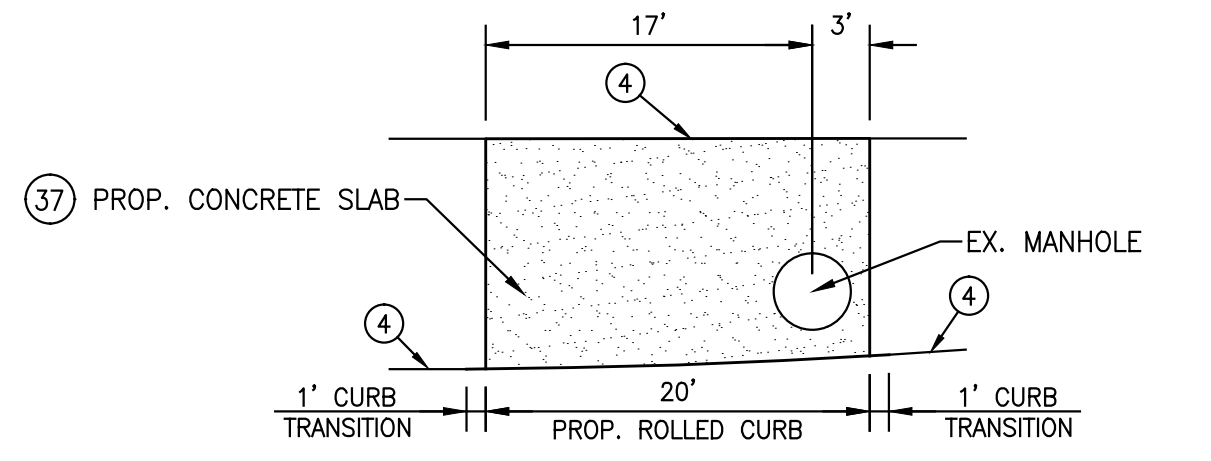

- LEGEND:**
- CONSTRUCT 8" AC OVER 18" AGGREGATE BASE
  - REMOVE EXISTING AC PAVING
  - INSTALL 8" PCC CONCRETE OVER 16" AGGREGATE BASE

**CURVE TABLE**

LENGTH	RADIUS	DELTA	TANGENT
C2	32.18	50.00	036°52'12"
			16.67

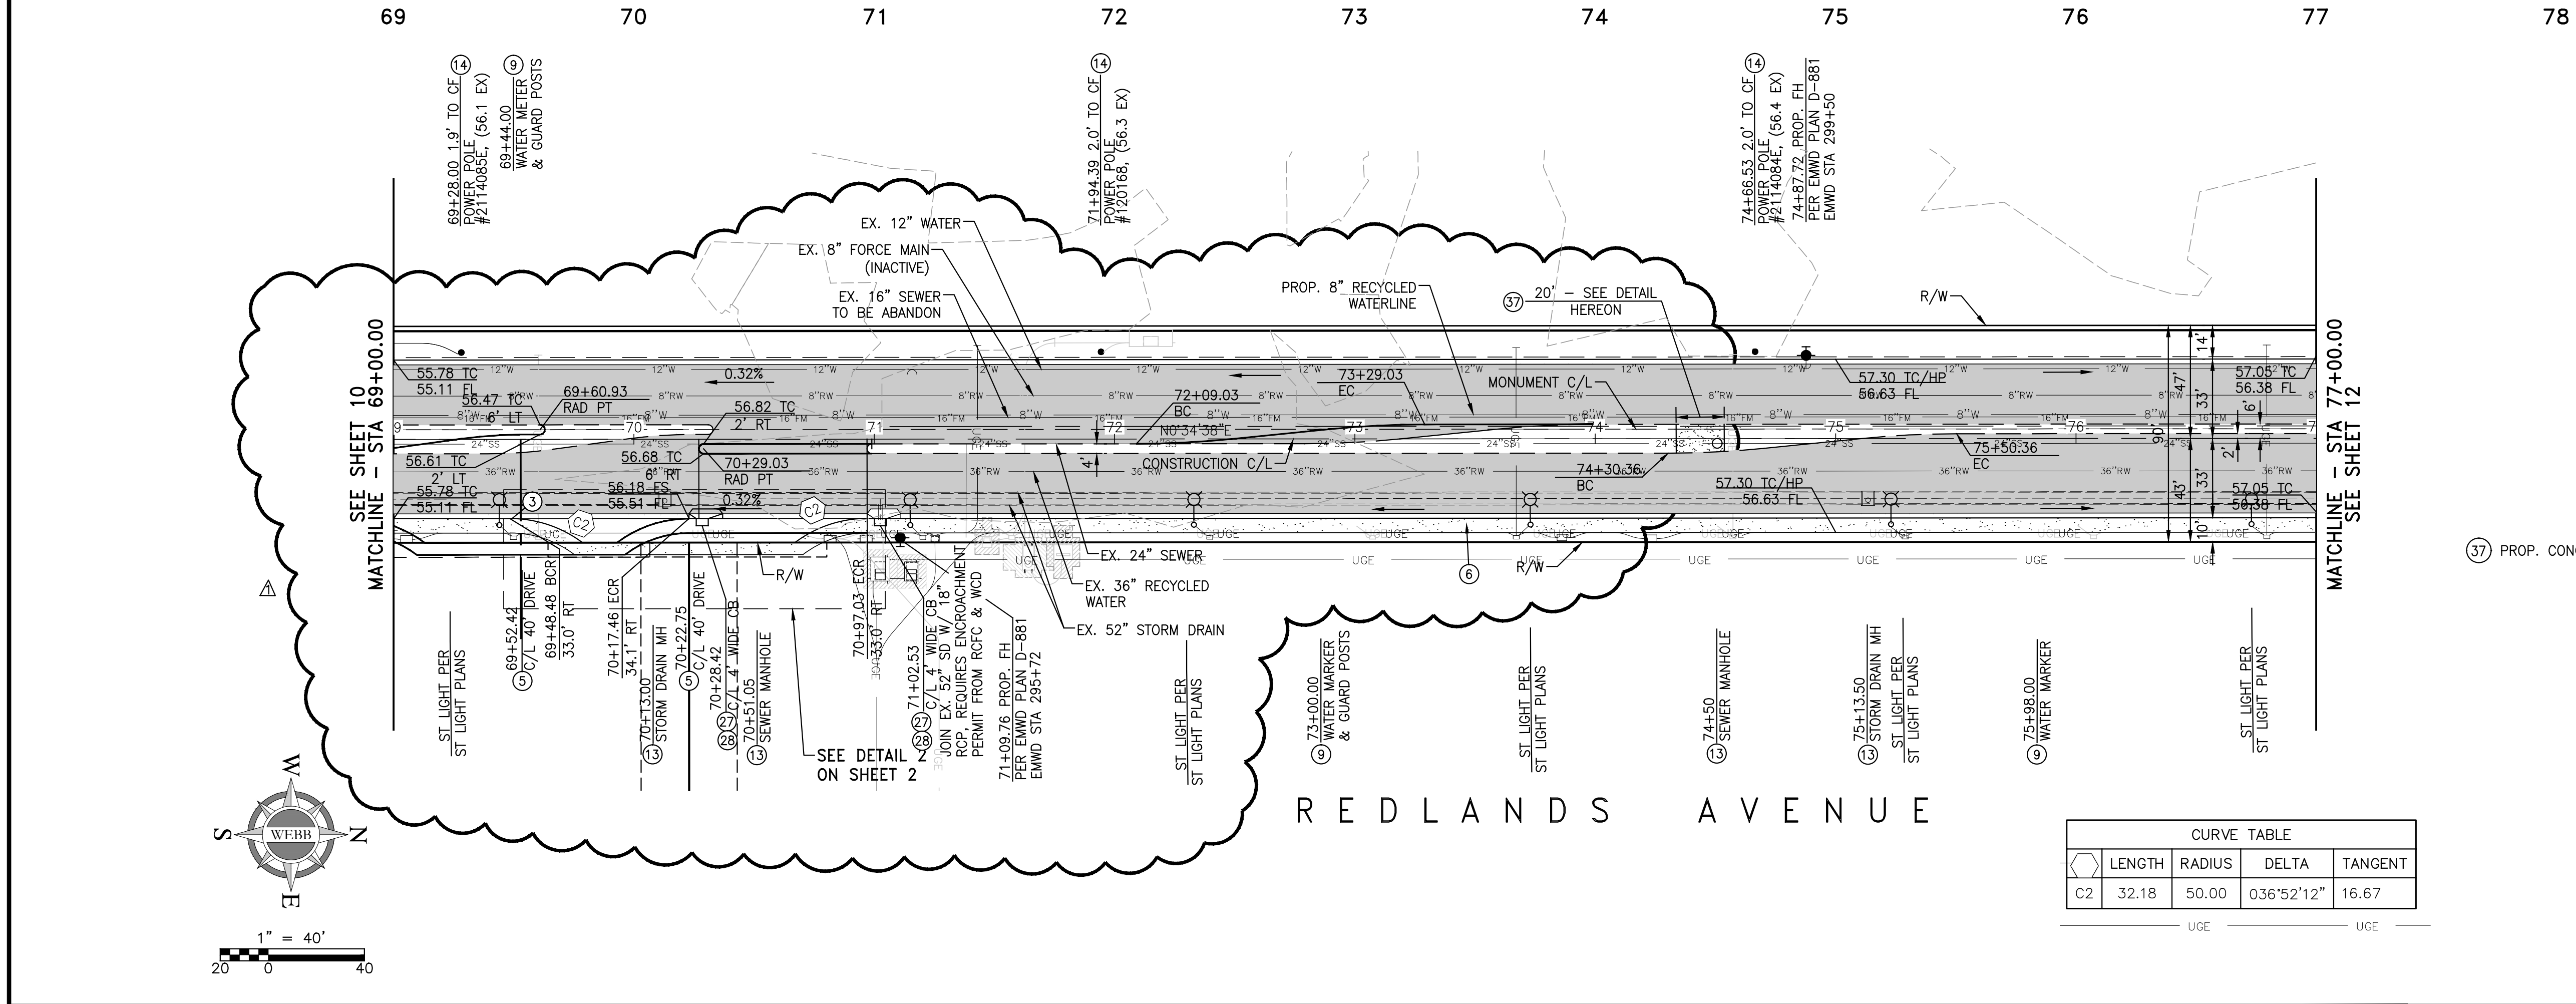

**DIG ALERT**

DIAL BEFORE YOU DIG

TWO WORKING DAYS BEFORE YOU DIG

1-800-227-2600

A PUBLIC SERVICE BY UNDERGROUND SERVICE ALERT

**NOTE:**  
 WORK CONTAINED WITHIN THESE PLANS SHALL NOT COMMENCE UNTIL AN ENCROACHMENT PERMIT AND/OR A GRADING PERMIT HAS BEEN ISSUED.

THE PRIVATE ENGINEER SIGNING THESE PLANS IS RESPONSIBLE FOR ASSURING THE ACCURACY AND ACCEPTABILITY OF THE DESIGN HEREON. IN THE EVENT OF DISCREPANCIES ARISING AFTER CITY APPROVAL OR DURING CONSTRUCTION, THE PRIVATE ENGINEER SHALL BE RESPONSIBLE FOR DETERMINING AN ACCEPTABLE SOLUTION AND REVISING THE PLANS FOR APPROVAL BY THE CITY.

MARK	BY	DATE	REVISIONS	APPR.	DATE
DJM		7/1/15	REVISE DRIVEWAY AND CATCH BASIN LOCATIONS		

CITY OF PERRIS  
 APPROVED BY:

CITY ENGINEER

DATE

SEAL - ENGINEER

REGISTERED PROFESSIONAL ENGINEER  
 D.J. ARELLANO  
 NO. 81988  
 CIVIL  
 STATE OF CALIFORNIA

**ALBERT A. WEBB ASSOCIATES**

ENGINEERING CONSULTANTS  
 3788 McCRAY STREET  
 RIVERSIDE, CA. 92506  
 PH. (951) 686-1070  
 FAX (951) 788-1256

UNDER THE SUPERVISION OF:

D.J. ARELLANO R.C.E. #C81988 DATE: 1/12/2015



BENCHMARK:  
 SEE SHEET 1

SCALE:  
 H: AS SHOWN V: AS SHOWN

CITY OF PERRIS  
 AMENDED DPR NO. 11-12-0004  
 STRATFORD RANCH-PARCEL MAP 36469  
 REDLANDS AVENUE  
 STA 70+00.00 TO STA 78+00.00

FOR: [Signature] W.O. 2013-0239 CITY FILE NO. P8-1189

SHEET NO. 11 OF 23 SHEETS

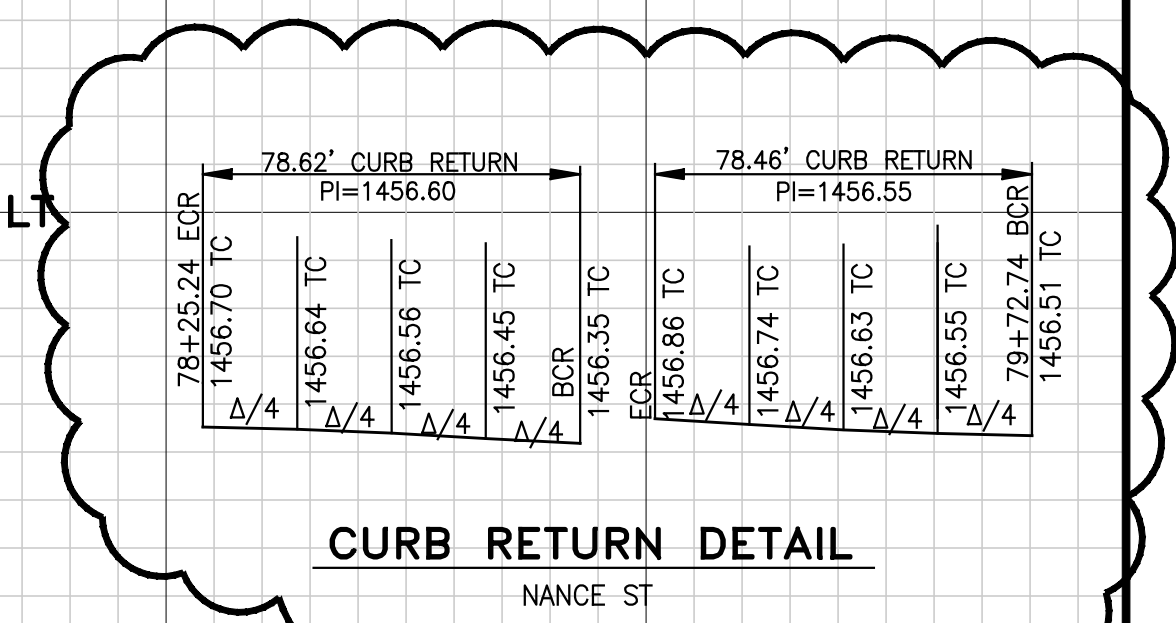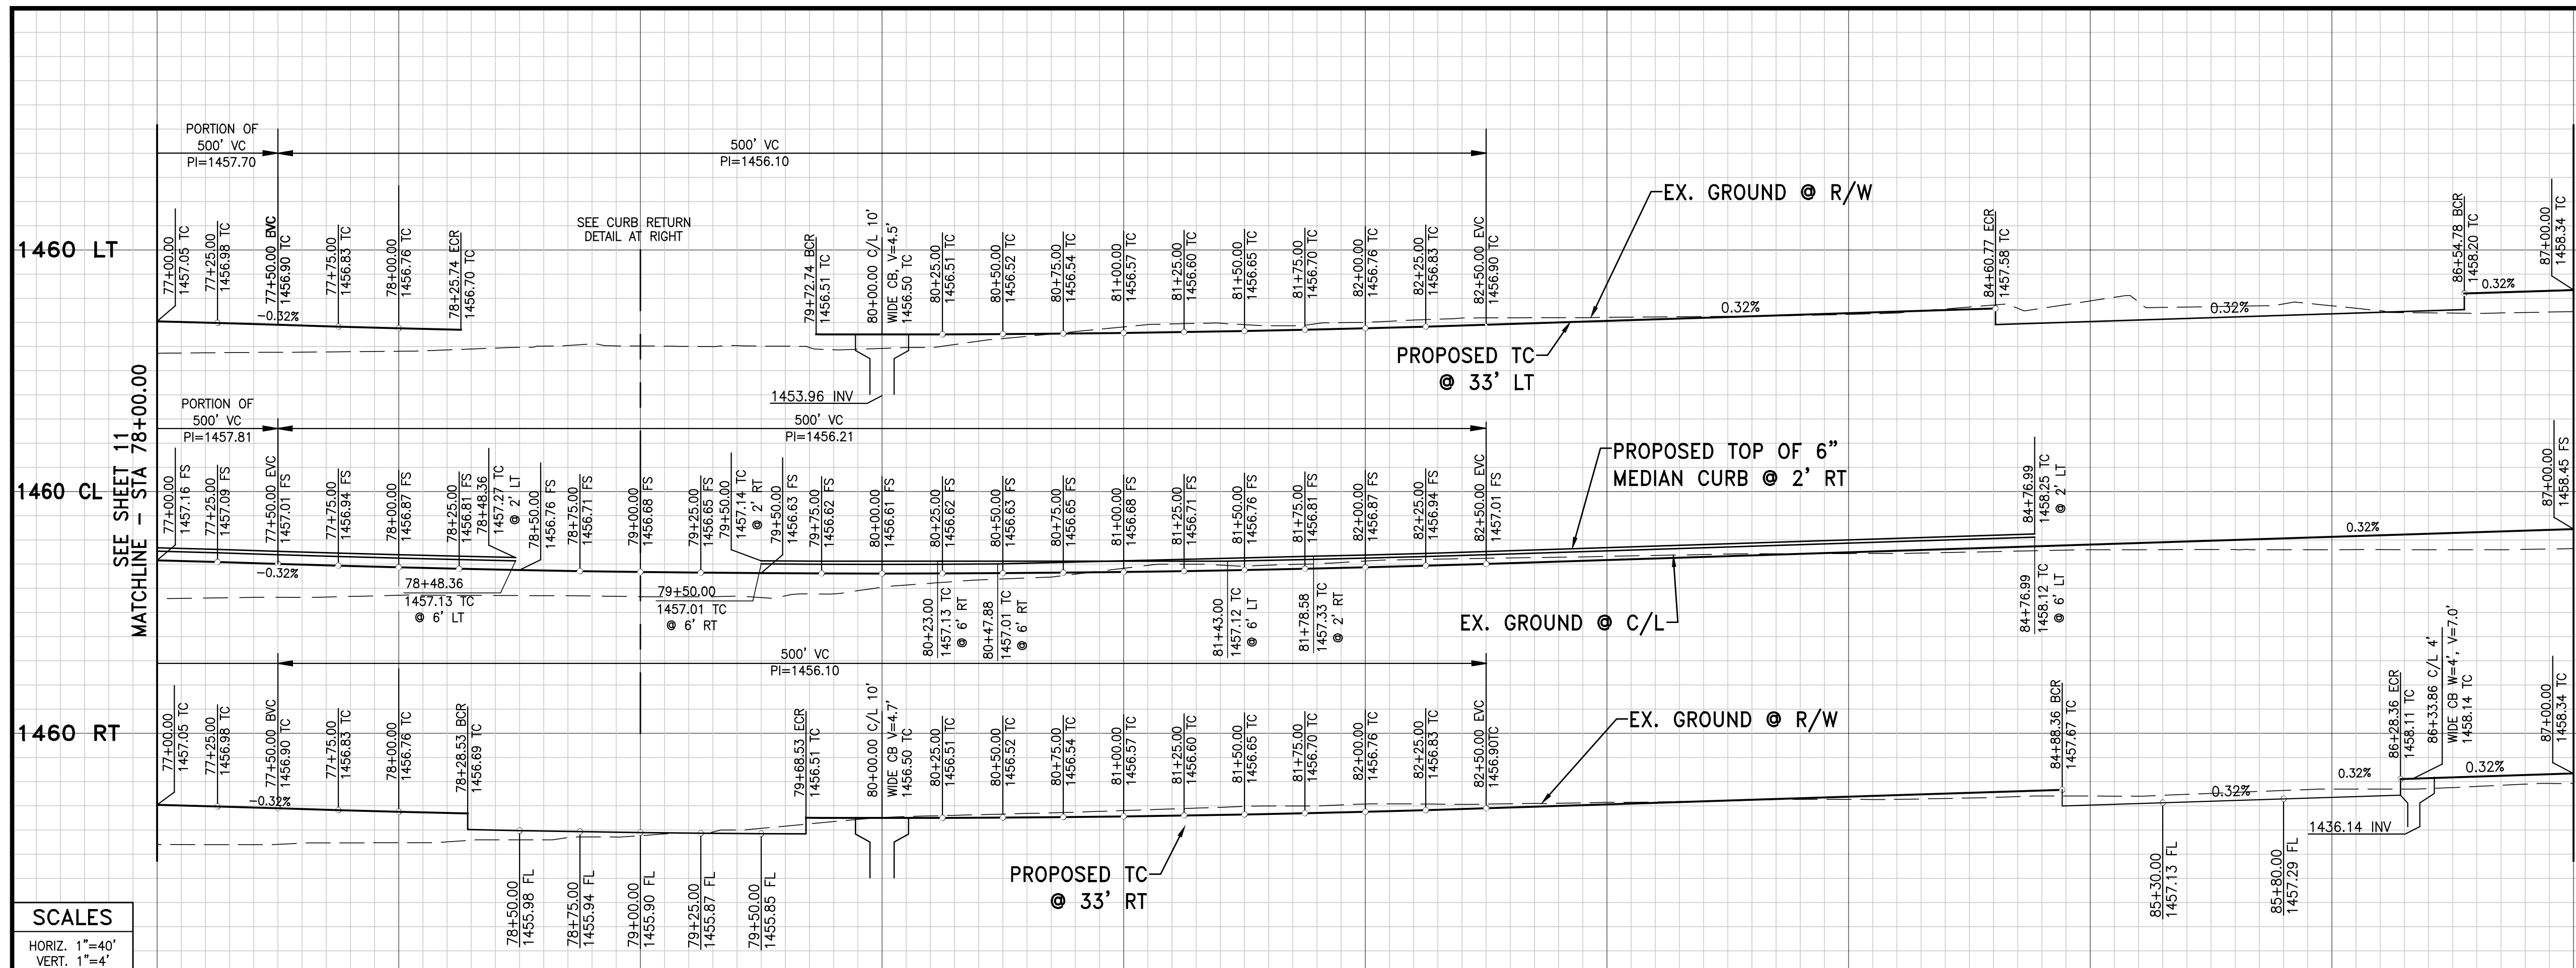


**AS BUILT**

THESE PLANS REFLECT ANY SUBSTANTIAL DESIGN MODIFICATIONS AS PROVIDED TO WEBB ASSOCIATES BY THE CONTRACTOR

SIGNATURE: *[Signature]* DATE: 05/19/2016

REGISTERED PROFESSIONAL ENGINEER  
D.J. ARELLANO  
No. 81988  
CIVIL  
STATE OF CALIFORNIA

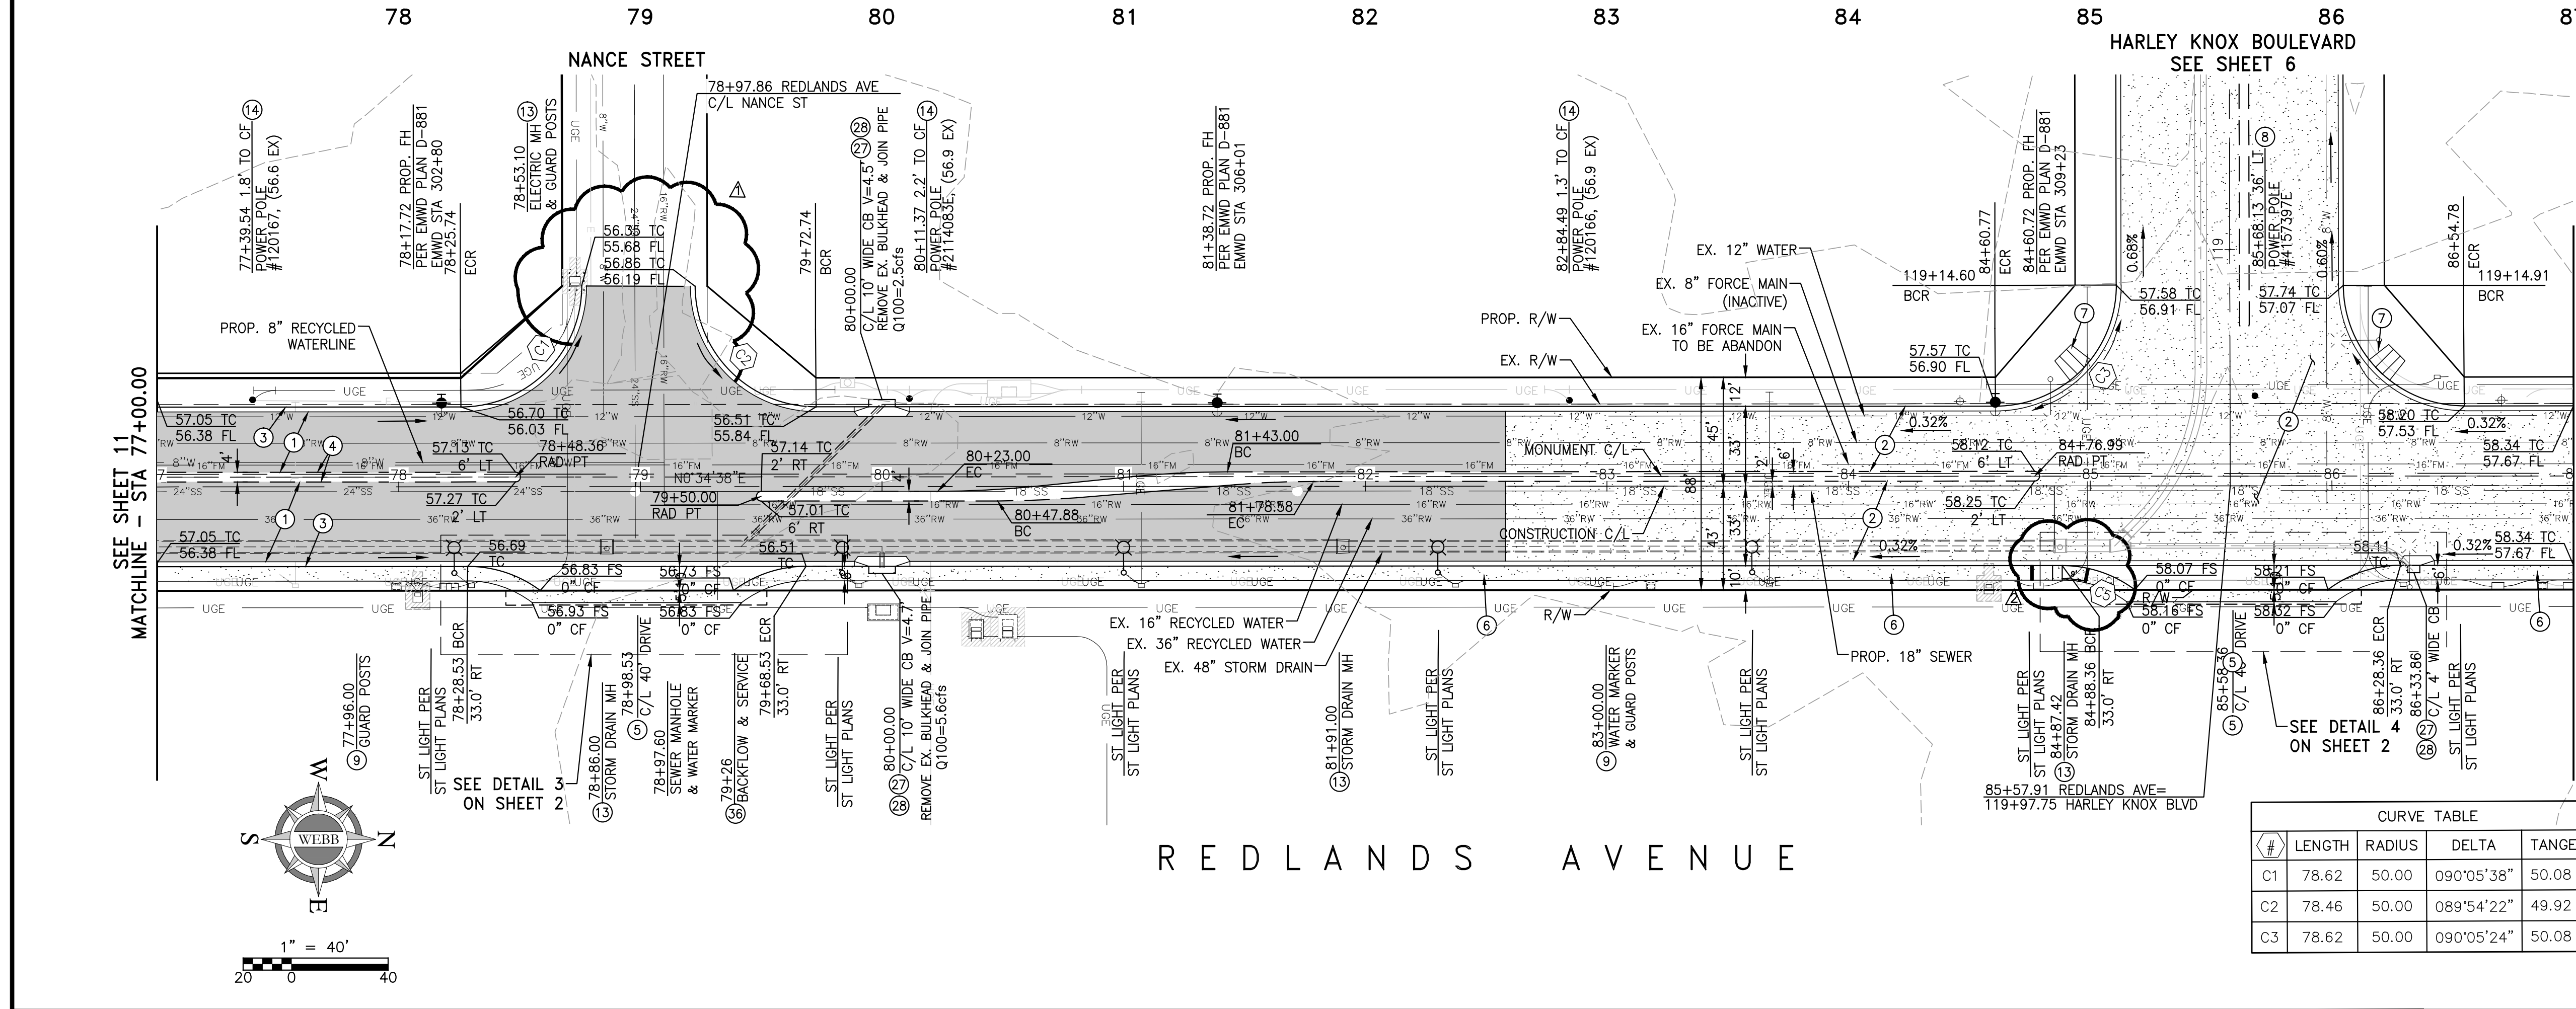

- CONSTRUCTION NOTES**
- CONSTRUCT MINIMUM 8" AC OVER 18" AB CLASS II
  - CONSTRUCT MIN. 8" (4,000 PSI) PCC OVER 16" CLASS II AB (C.J. @ 20' O.C.)
  - CONSTRUCT TYPE "A-8" CURB & GUTTER PER RIV. CO. STD. NO. 201
  - CONSTRUCT 6" TYPE "D" CURB PER RIV. CO. STD. NO. 204
  - CONSTRUCT COMMERCIAL DRIVE PER RIV. CO. STD. NO. 207A
  - CONSTRUCT 6' WIDE SIDEWALK PER RIV. CO. STD. NO. 401
  - CONSTRUCT CURB RAMP PER RIV. CO. STD. NO. 403, CASE A
  - COORD UNDERGROUNDING/RELOCATION OF PP & GUY WIRE -- BY UTILITY COMPANY
  - RELOCATE EX. UTILITY RISER -- BY UTILITY COMPANY
  - ADJUST TO GRADE
  - PROTECT IN PLACE
  - CONSTRUCT CURB INLET CATCH BASIN PER RIV. CO. STD. NO. 300
  - CONSTRUCT LOCAL DEPRESSION PER RIV. CO. STD. NO. 311
  - REMOVE BACKFLOW AND SERVICE. COORDINATE WITH EMWD

**CURVE TABLE**

#	LENGTH	RADIUS	DELTA	TANGENT
C1	78.62	50.00	090°05'38"	50.08
C2	78.46	50.00	089°54'22"	49.92
C3	78.62	50.00	090°05'24"	50.08

- LEGEND:**
- CONSTRUCT 8" AC OVER 18" AGGREGATE BASE
  - REMOVE EXISTING AC PAVING
  - INSTALL 8" PCC CONCRETE OVER 16" AGGREGATE BASE

**DIG ALERT**

TWO WORKING DAYS BEFORE YOU DIG

TOLL FREE 1-800-227-2600

A PUBLIC SERVICE BY UNDERGROUND SERVICE ALERT

**NOTE:**

WORK CONTAINED WITHIN THESE PLANS SHALL NOT COMMENCE UNTIL AN ENCROACHMENT PERMIT AND/OR A GRADING PERMIT HAS BEEN ISSUED.

THE PRIVATE ENGINEER SIGNING THESE PLANS IS RESPONSIBLE FOR ASSURING THE ACCURACY AND ACCEPTABILITY OF THE DESIGN INFORMATION IN THE EVENT OF DISCREPANCIES ARISING AFTER CITY APPROVAL OR DURING CONSTRUCTION, THE PRIVATE ENGINEER SHALL BE RESPONSIBLE FOR DETERMINING AN ACCEPTABLE SOLUTION AND REVISING THE PLANS FOR APPROVAL BY THE CITY.

MARK	BY	DATE	REVISIONS	APPR.	DATE
Δ	DJ	5/4/15	REVISE CURB RAMP TO CO STD. 403		
Δ	DJ	4/7/15	REVISE CURB RETURN GRADES		

CITY OF PERRIS

APPROVED BY:

CITY ENGINEER

DATE

SEAL - ENGINEER

REGISTERED PROFESSIONAL ENGINEER  
D.J. ARELLANO  
No. 81988  
CIVIL  
STATE OF CALIFORNIA

**ALBERT A. WEBB ASSOCIATES**

ENGINEERING CONSULTANTS  
3788 McCRAY STREET  
RIVERSIDE, CA 92506  
PH. (951) 686-1070  
FAX (951) 788-1256

UNDER THE SUPERVISION OF:

D.J. ARELLANO R.C.E. #C81988 DATE 1/12/2015

BENCHMARK:

SEE SHEET 1

SCALE: H: AS SHOWN V: AS SHOWN

CITY OF PERRIS

AMENDED DPR NO. 11-12-0004

STRATFORD RANCH-PARCEL MAP 36469

REDLANDS AVENUE


STA 78+00.00 TO STA 87+00.00

SHEET NO. 12

OF 23 SHEETS


P8-1189

6:\2013\13-0239\DRAWINGS\AS-BUILT\13-0239-C-ST-AEWDG 5/18/2016 10:13 AM

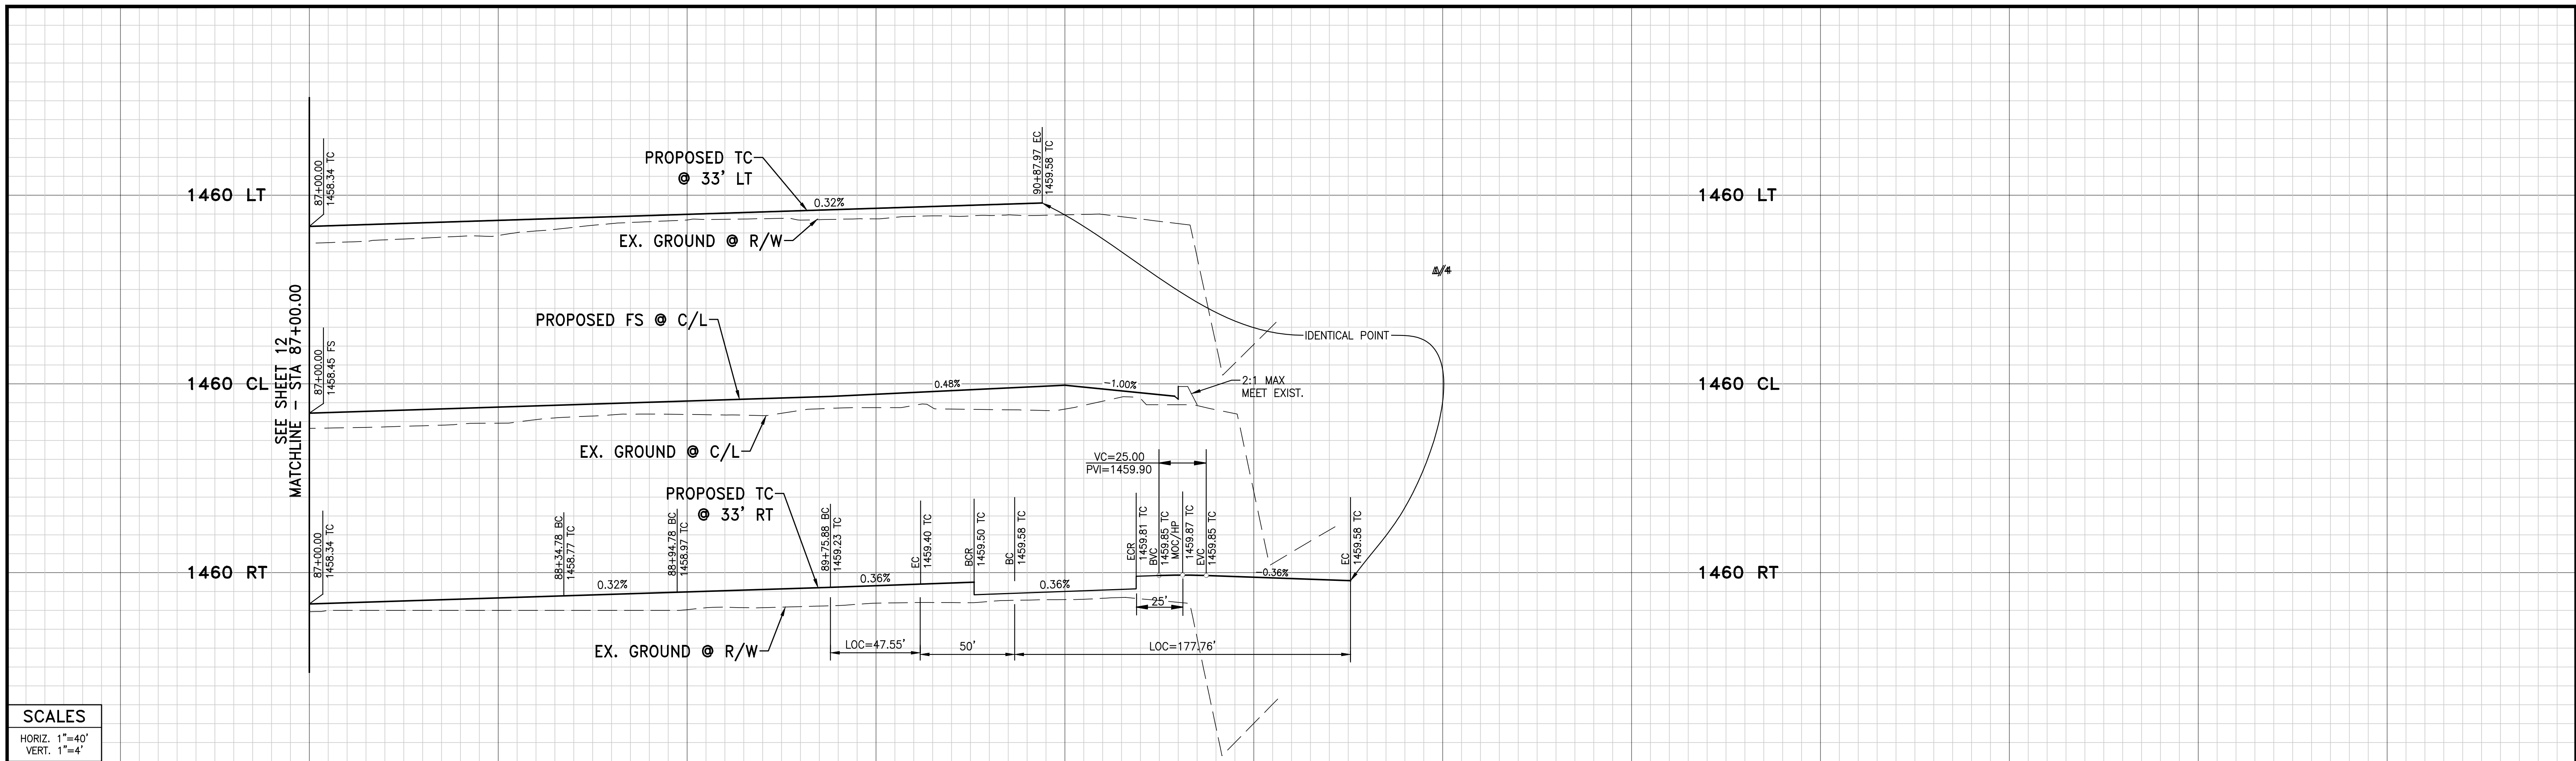

**SCALES**  
 HORIZ. 1"=40'  
 VERT. 1"=4'

87 88 89 90 91 92

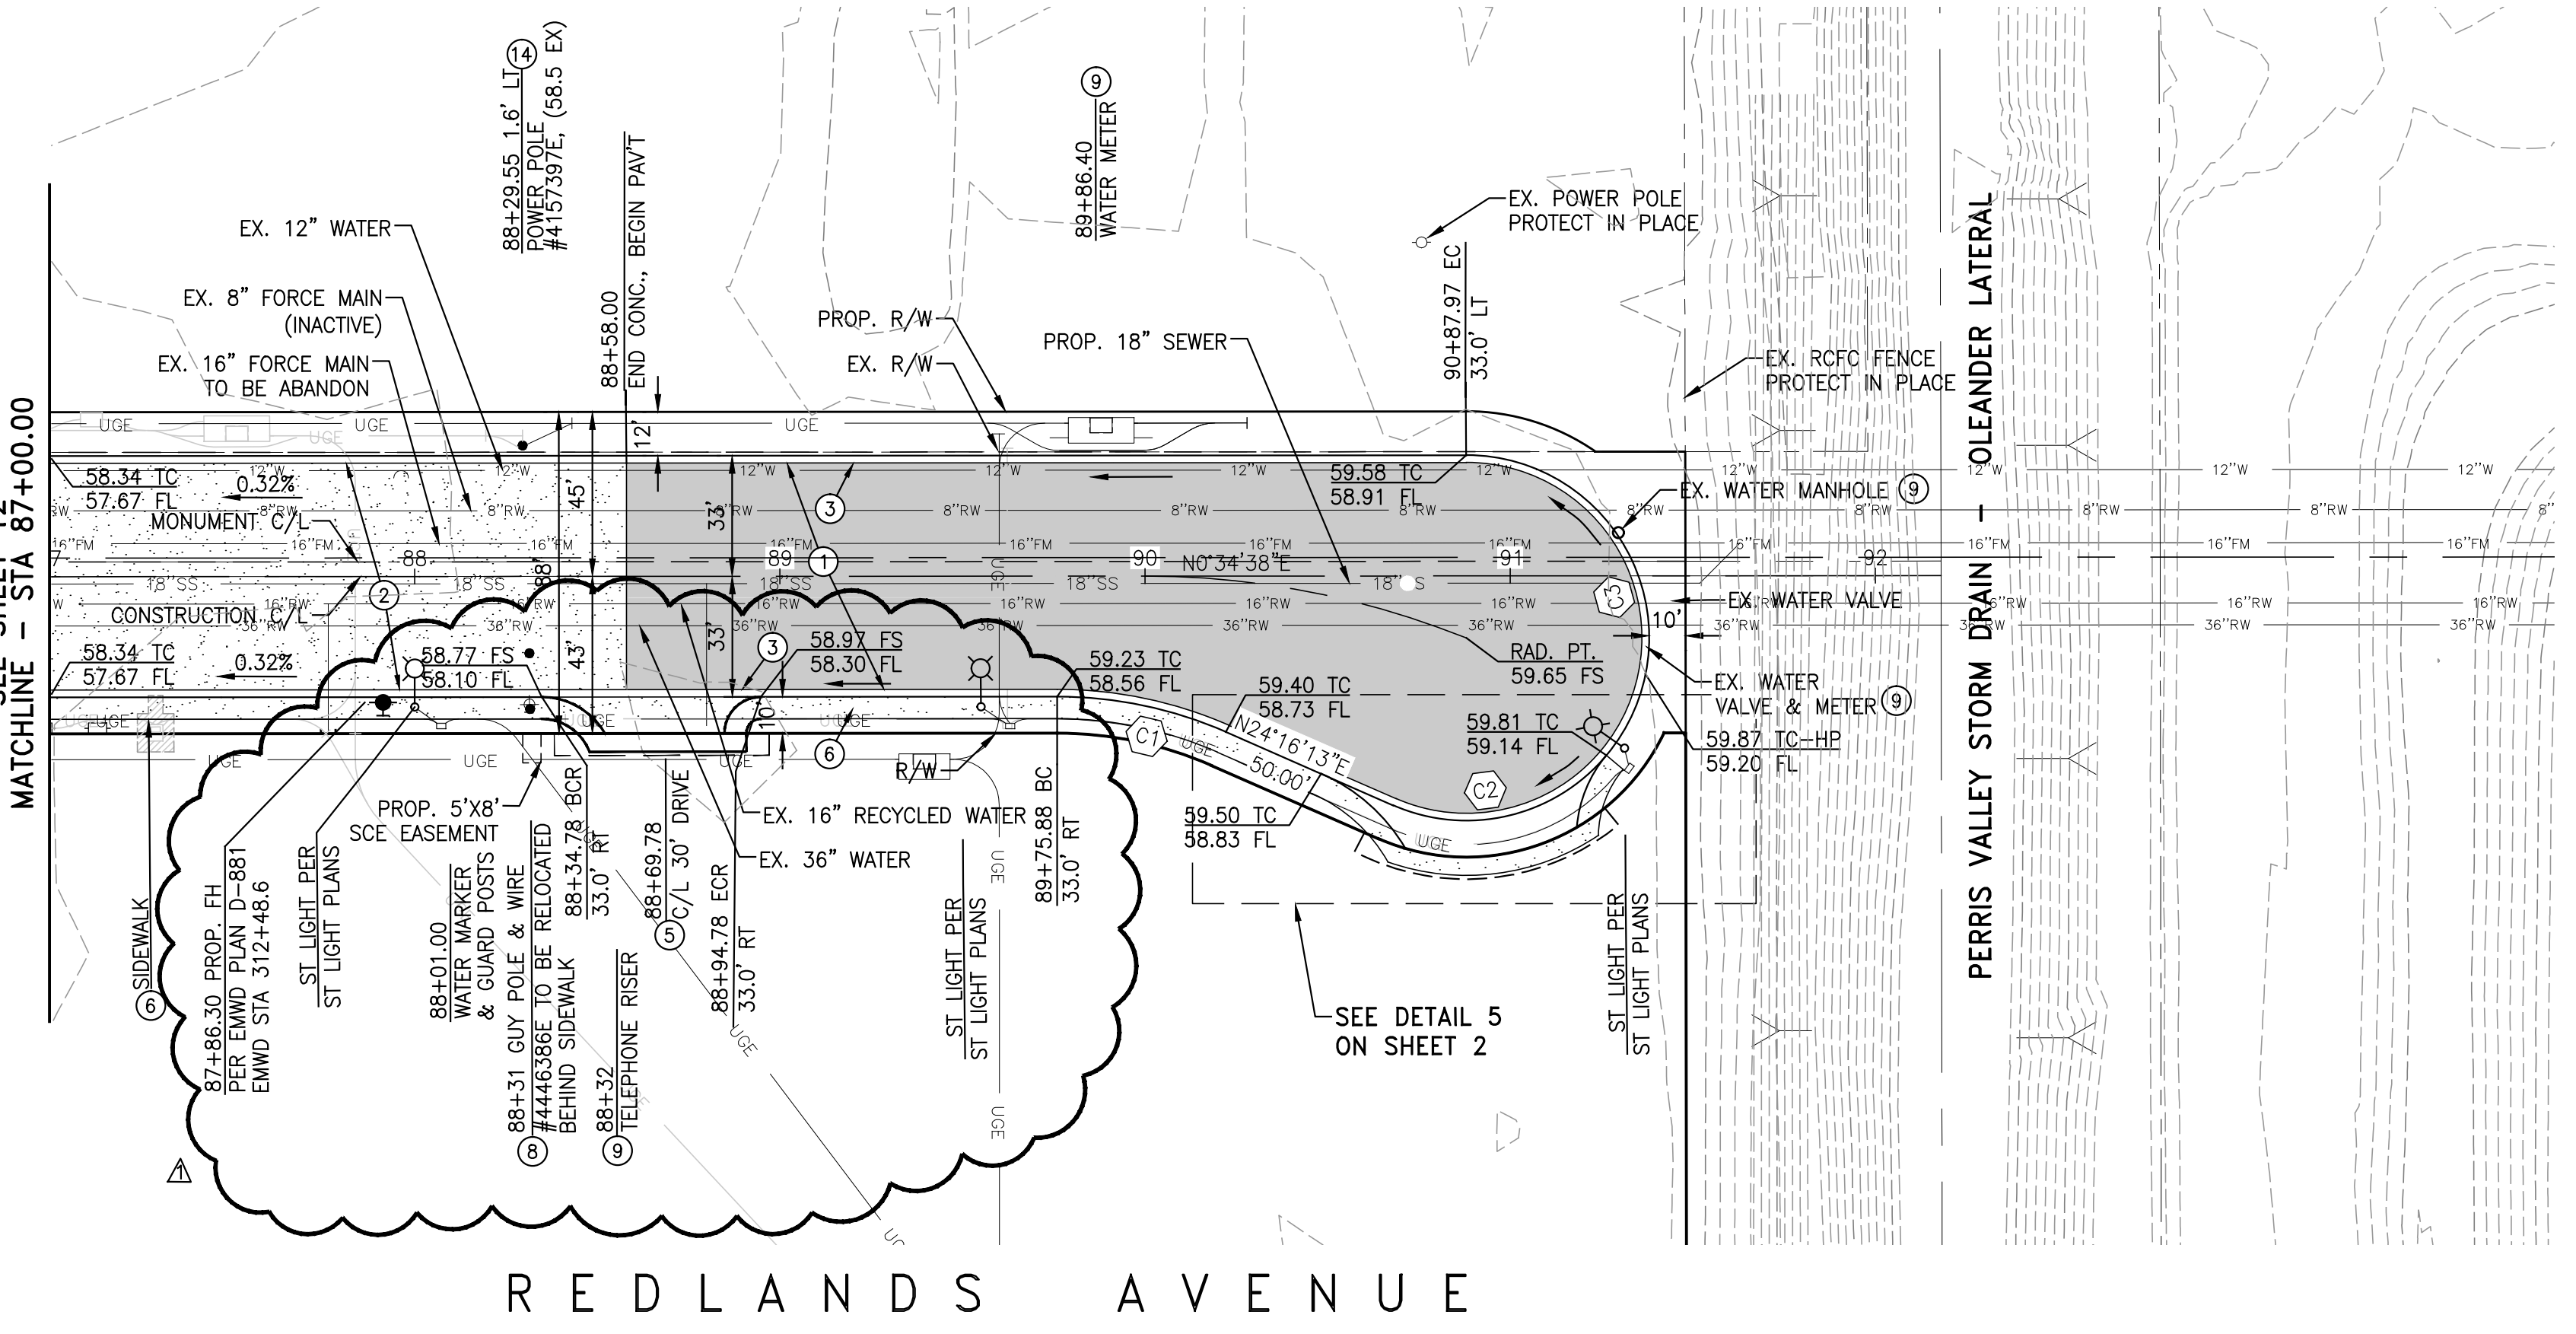


**AS BUILT**  
 THESE PLANS REFLECT ANY SUBSTANTIAL DESIGN MODIFICATIONS AS PROVIDED TO WEBB ASSOCIATES BY THE CONTRACTOR

SIGNATURE: [Signature]  
 DATE: 05/19/2016

REGISTERED PROFESSIONAL ENGINEER  
 D.J. ARELLANO  
 NO. 81988  
 CIVIL  
 STATE OF CALIFORNIA


- CONSTRUCTION NOTES**
- 1 CONSTRUCT MINIMUM 8" AC OVER 18" AB CLASS II
  - 2 CONSTRUCT MIN. 8" (4,000 PSI) PCC OVER 16" CLASS II AB (C.J. @ 20' O.C.)
  - 3 CONSTRUCT TYPE "A-B" CURB & GUTTER PER RIV. CO. STD. NO. 201
  - 6 CONSTRUCT 6' WIDE SIDEWALK PER RIV. CO. STD. 401
  - 8 COORD UNDERGROUNDING/RELOCATION OF PP & GUY WIRE - BY UTILITY COMPANY
  - 9 RELOCATE EX. UTILITY RISER - BY UTILITY COMPANY
  - 14 PROTECT IN PLACE

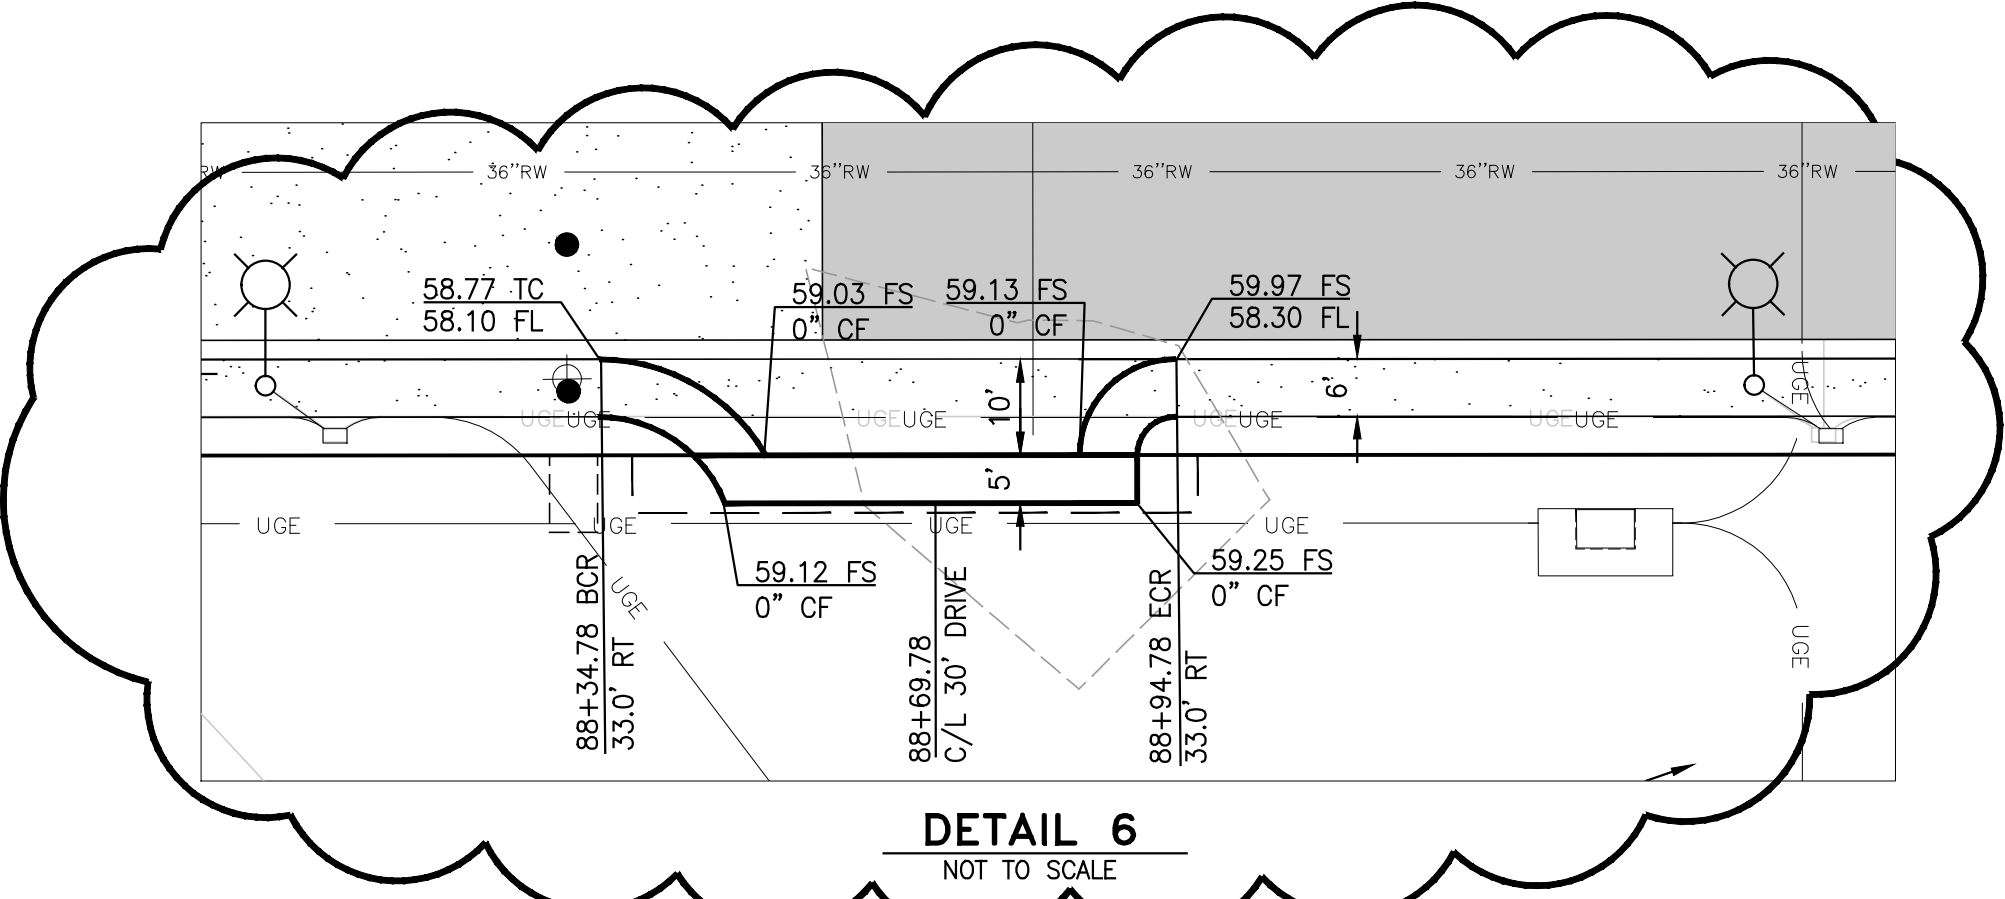

**CURVE TABLE**

LENGTH	RADIUS	DELTA	TANGENT	
C1	47.55	115.00	02°3'41"34"	24.12
C2	64.31	50.00	07°3'41"37"	37.47
C3	113.45	50.00	129°59'58"	107.22

- LEGEND:**
- CONSTRUCT 8" AC OVER 18" AGGREGATE BASE
  - REMOVE EXISTING AC PAVING
  - INSTALL 8" PCC CONCRETE OVER 16" AGGREGATE BASE

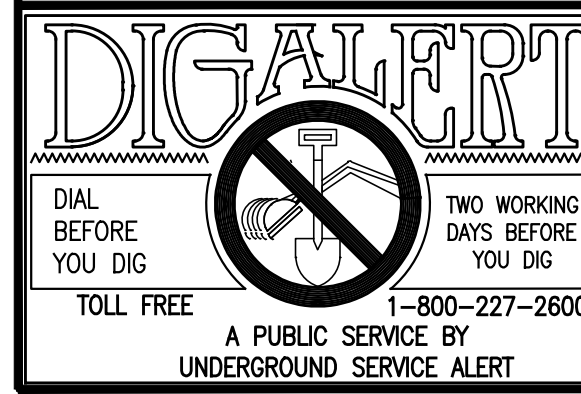

**NOTE:**  
 WORK CONTAINED WITHIN THESE PLANS SHALL NOT COMMENCE UNTIL AN ENCROACHMENT PERMIT AND/OR A GRADING PERMIT HAS BEEN ISSUED.

THE PRIVATE ENGINEER SIGNING THESE PLANS IS RESPONSIBLE FOR ASSURING THE ACCURACY AND ACCEPTABILITY OF THE DESIGN HEREON. IN THE EVENT OF DISCREPANCIES ARISING AFTER CITY APPROVAL OR DURING CONSTRUCTION, THE PRIVATE ENGINEER SHALL BE RESPONSIBLE FOR DETERMINING AN ACCEPTABLE SOLUTION AND REVISING THE PLANS FOR APPROVAL BY THE CITY.

CITY OF PERRIS  
 APPROVED BY:  
 \_\_\_\_\_  
 CITY ENGINEER  
 \_\_\_\_\_  
 DATE

SEAL - ENGINEER  
 REGISTERED PROFESSIONAL ENGINEER  
 D.J. ARELLANO  
 NO. 81988  
 CIVIL  
 STATE OF CALIFORNIA

ALBERT A. WEBB ASSOCIATES  
 ENGINEERING CONSULTANTS  
 3788 MCCRAY STREET  
 RIVERSIDE CA. 92506  
 PH. (951) 686-1070  
 FAX (951) 788-1256

UNDER THE SUPERVISION OF:  
 \_\_\_\_\_  
 D.J. ARELLANO R.C.E. #C81988 DATE 1/12/2015


BENCHMARK:  
 SEE SHEET 1

SCALE:  
 H: AS SHOWN V: AS SHOWN

CITY OF PERRIS  
 AMENDED DPR NO. 11-12-0004  
 STRATFORD RANCH-PARCEL MAP 36469  
 REDLANDS AVENUE  
 STA 87+00.00 TO STA 91+58.00



SHEET NO.  
 13  
 OF 23 SHEETS  
 P8-1189

G:\2013\13-0239\DRAWINGS\AS-BUILT\13-0239-C-ST-AE.DWG 5/18/2016 10:13 AM

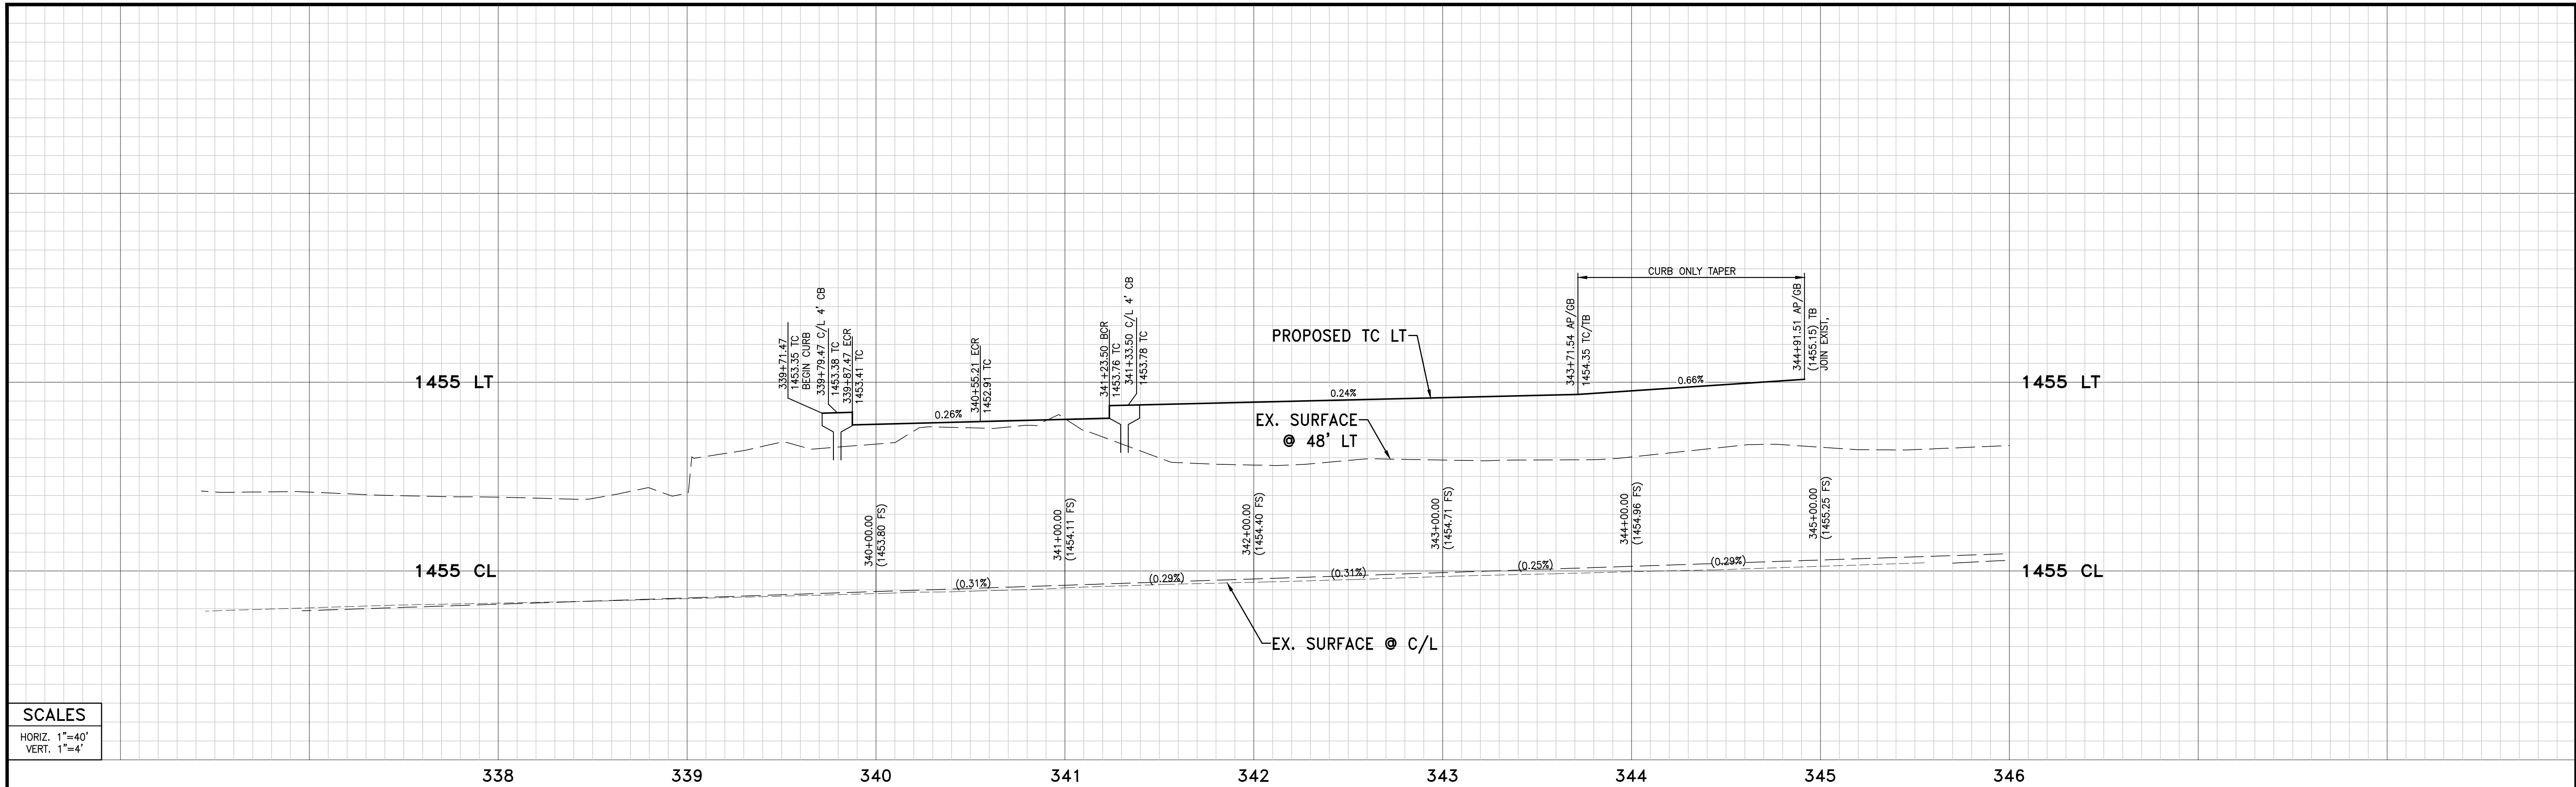

**SCALES**  
 HORIZ. 1"=40'  
 VERT. 1"=4'

338 339 340 341 342 343 344 345 346

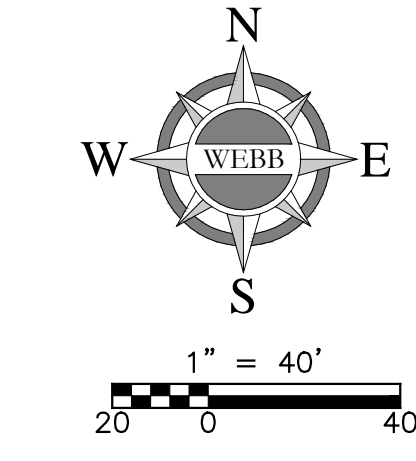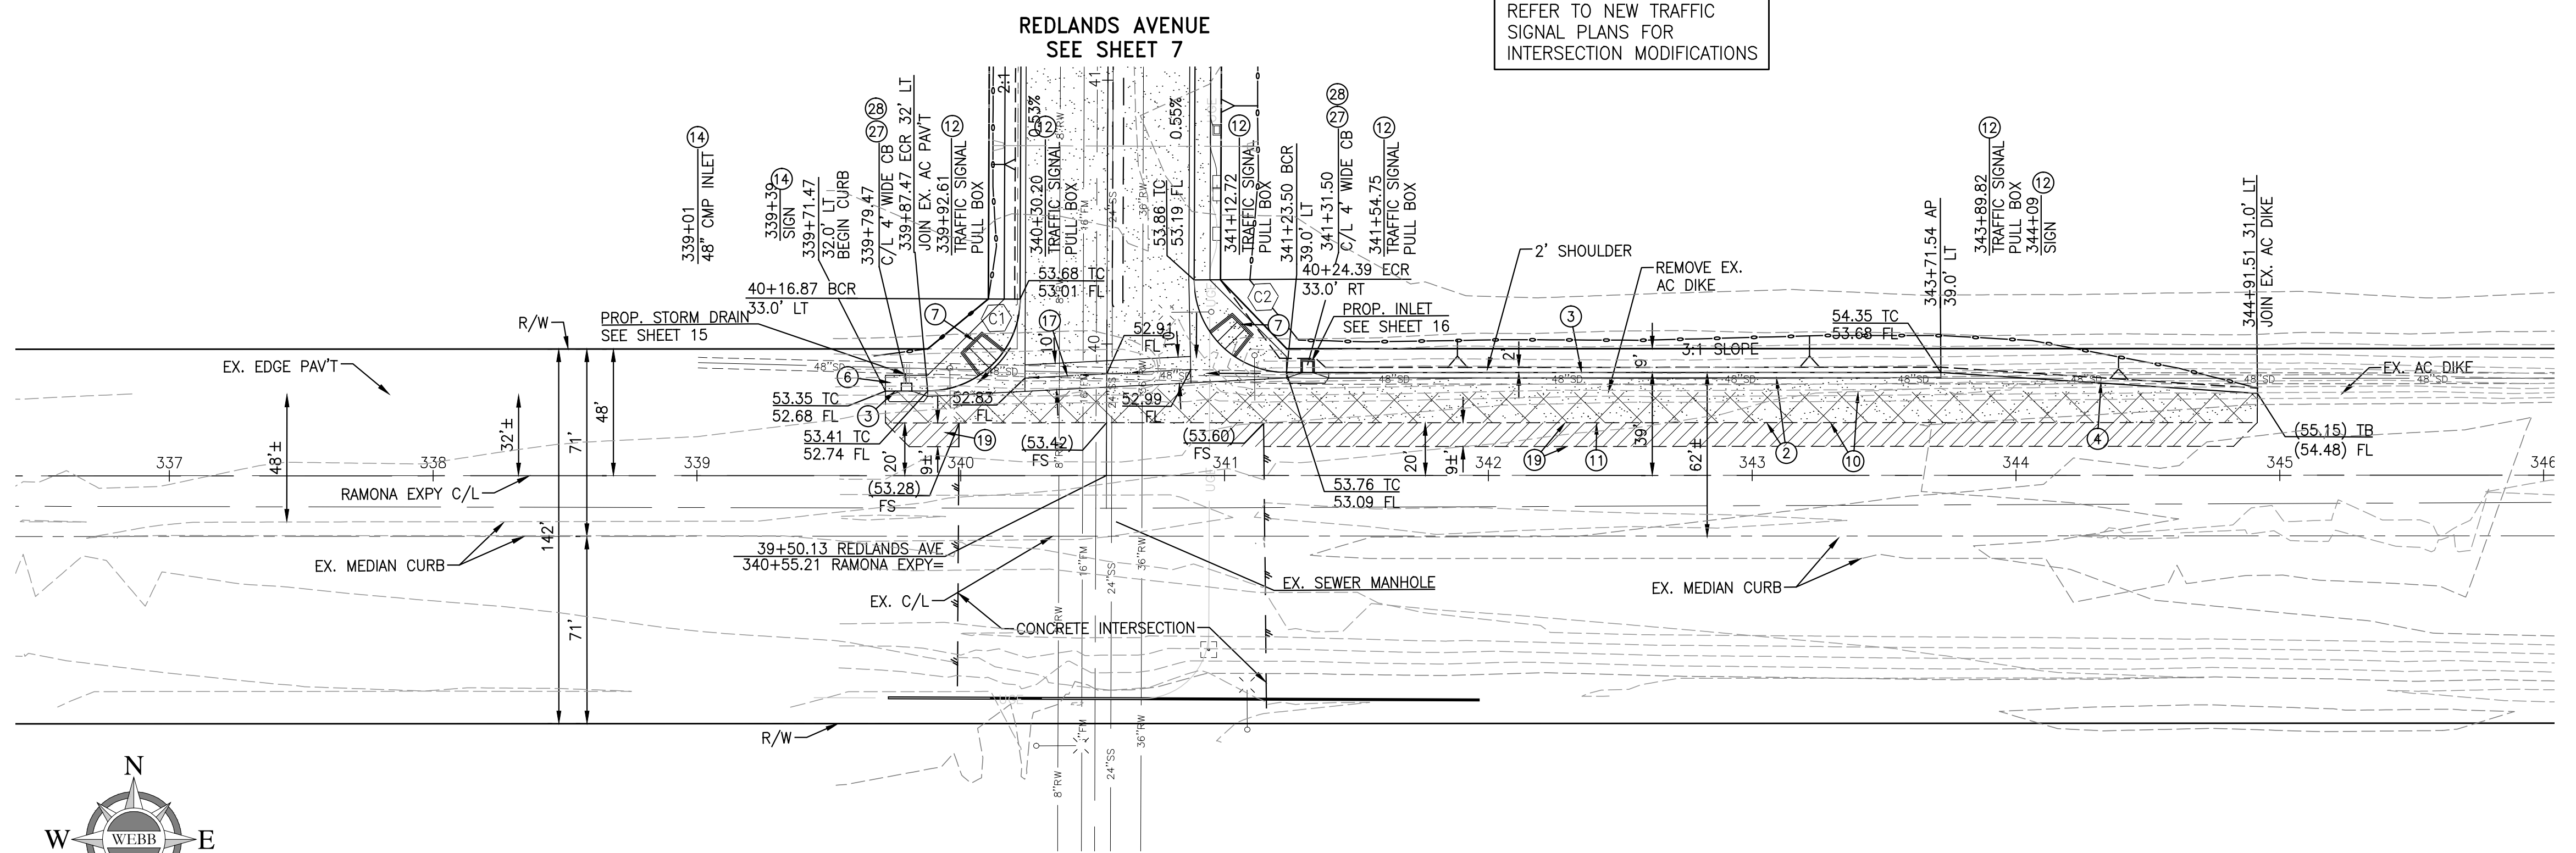

RAMONA EXPRESSWAY

CURVE TABLE			
#	LENGTH	RADIUS	TANGENT
C1	54.84	35.00	89°46'36"
C2	55.11	35.00	90°13'21"


- CONSTRUCTION NOTES**
- 2) CONSTRUCT MIN. 8" (4,000 PSI) PCC OVER 16" CLASS II AB (C.J. @ 20' O.C.)
  - 3) CONSTRUCT TYPE "A-8" CURB & GUTTER PER RIV. CO. STD. NO. 201
  - 4) CONSTRUCT 6" TYPE "D" CURB PER RIV. CO. STD. NO. 204
  - 6) CONSTRUCT 6' WIDE SIDEWALK PER RIV. CO. STD. 401
  - 7) CONSTRUCT CURB RAMP PER RIV. CO. STD. NO. 403, CASE A
  - 10) REMOVE AC PAVEMENT AND DISPOSE OF LEGALLY
  - 11) SAWCUT & JOIN EX. A.C. PAVEMENT PER DETAIL ON SHEET 2
  - 12) RELOCATE
  - 14) PROTECT IN PLACE
  - 17) CONSTRUCT CROSS GUTTER PER RIV. CO. STD. NO. 209
  - 19) 0.15' GRIND AND OVERLAY
  - 27) CONSTRUCT CURB INLET CATCH BASIN PER RIV. CO. STD. NO. 300
  - 28) CONSTRUCT LOCAL DEPRESSION PER RIV. CO. STD. NO. 311

**AS BUILT**

THESE PLANS REFLECT ANY SUBSTANTIAL DESIGN MODIFICATIONS AS PROVIDED TO WEBB ASSOCIATES BY THE CONTRACTOR

SIGNATURE: *[Signature]* DATE: 05/19/2016


- LEGEND:**
- CONSTRUCT 8" AC OVER 18" AGGREGATE BASE
  - REMOVE EXISTING AC PAVING
  - INSTALL 8" PCC CONCRETE OVER 16" AGGREGATE BASE

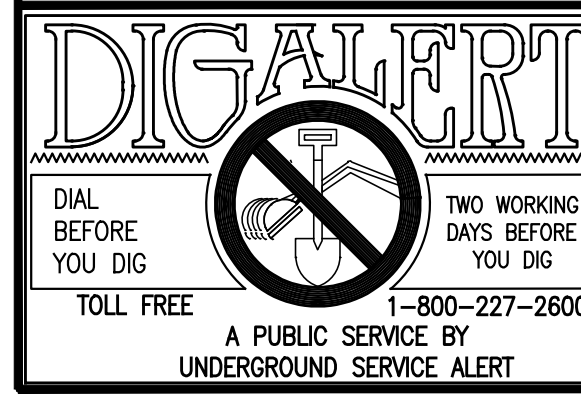

**NOTE:**  
 WORK CONTAINED WITHIN THESE PLANS SHALL NOT COMMENCE UNTIL AN ENCROACHMENT PERMIT AND/OR A GRADING PERMIT HAS BEEN ISSUED.  
 THE PRIVATE ENGINEER SIGNING THESE PLANS IS RESPONSIBLE FOR ASSURING THE ACCURACY AND ACCEPTABILITY OF THE DESIGN HEREON. IN THE EVENT OF DISCREPANCIES ARISING AFTER CITY APPROVAL OR DURING CONSTRUCTION, THE PRIVATE ENGINEER SHALL BE RESPONSIBLE FOR DETERMINING AN ACCEPTABLE SOLUTION AND REVISING THE PLANS FOR APPROVAL BY THE CITY.

MARK	BY	DATE	REVISIONS	APPR.	DATE

CITY OF PERRIS  
 APPROVED BY:  
 \_\_\_\_\_  
 CITY ENGINEER  
 DATE \_\_\_\_\_

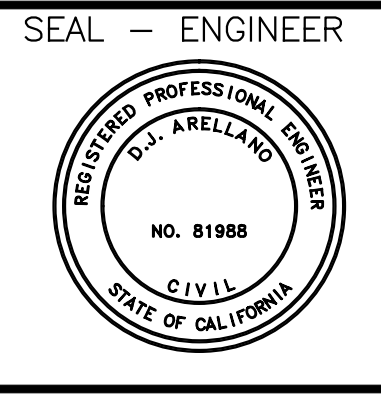

SEAL - ENGINEER  
**ALBERT A. WEBB ASSOCIATES**  
 ENGINEERING CONSULTANTS  
 3788 McCRAY STREET  
 RIVERSIDE, CA. 92506  
 PH. (951) 686-1070  
 FAX (951) 788-1256  
 UNDER THE SUPERVISION OF:  
 \_\_\_\_\_  
 D.J. ARELLANO R.C.E. #CB1988 DATE 1/12/2015

BENCHMARK:  
 SEE SHEET 1  
 SCALE:  
 H: AS SHOWN V: AS SHOWN

CITY OF PERRIS  
 AMENDED DPR NO. 11-12-0004  
 STRATFORD RANCH-PARCEL MAP 36469  
 RAMONA EXPRESSWAY  
 STA 114+00.00 TO STA 119+93.75  
 FOR: \_\_\_\_\_ W.O. 2013-0239 CITY FILE NO. \_\_\_\_\_

SHEET NO. 14  
 OF 23 SHEETS  
 P8-1189



**NOTE TO CONTRACTOR**

1. CONTRACTOR TO VERIFY LOCATIONS AND ELEVATIONS OF ALL EXISTING UTILITIES PRIOR TO CONSTRUCTION

1460

1450

1440

1460 1460

1450 1450

1440 1440

1460

1450

1440

L A T E R A L D 3 A

L A T E R A L D 3

**SCALES**

HORIZ. 1"=40'

VERT. 1"=4'

**AS BUILT**

THESE PLANS REFLECT ANY SUBSTANTIAL DESIGN MODIFICATIONS AS PROVIDED TO WEBB ASSOCIATES BY THE CONTRACTOR

SIGNATURE: *[Signature]* DATE: 05/19/2016

REGISTERED PROFESSIONAL ENGINEER  
D.J. ARELLANO  
NO. 81988  
CIVIL  
STATE OF CALIFORNIA

**CURVE DATA**


(A) Δ=45°05'24"  
R=90.0'  
L=70.83'  
T=37.36'

(B) Δ=45°00'00"  
R=22.5'  
L=17.67'  
T=9.32'

REDLANDS AVE

**NOTE TO CONTRACTOR**


1. CONTRACTOR TO VERIFY LOCATIONS AND ELEVATIONS OF ALL EXISTING UTILITIES PRIOR TO CONSTRUCTION

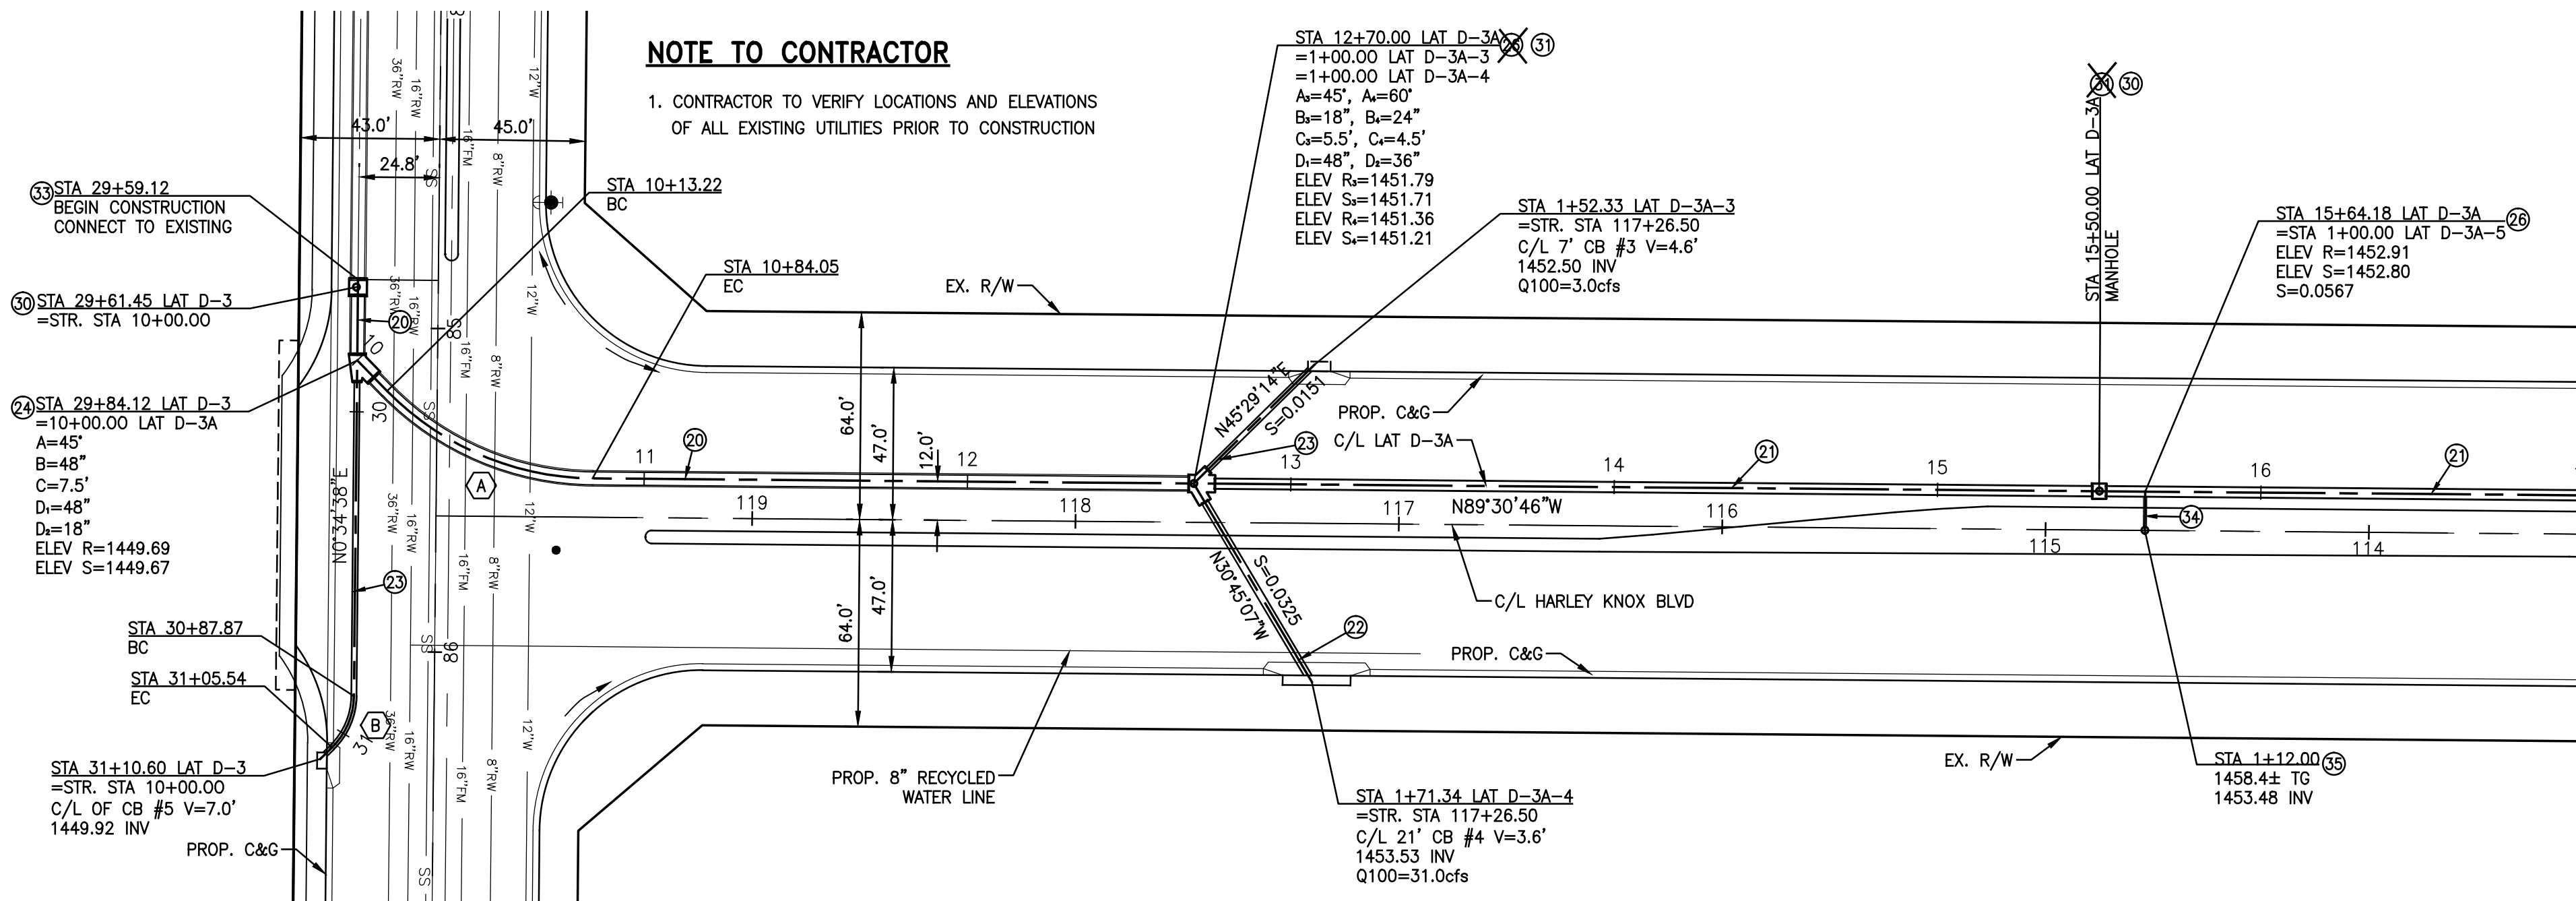

**NOTE TO CONTRACTOR**

1. CONTRACTOR TO VERIFY LOCATIONS AND ELEVATIONS OF ALL EXISTING UTILITIES PRIOR TO CONSTRUCTION

REDLANDS AVE

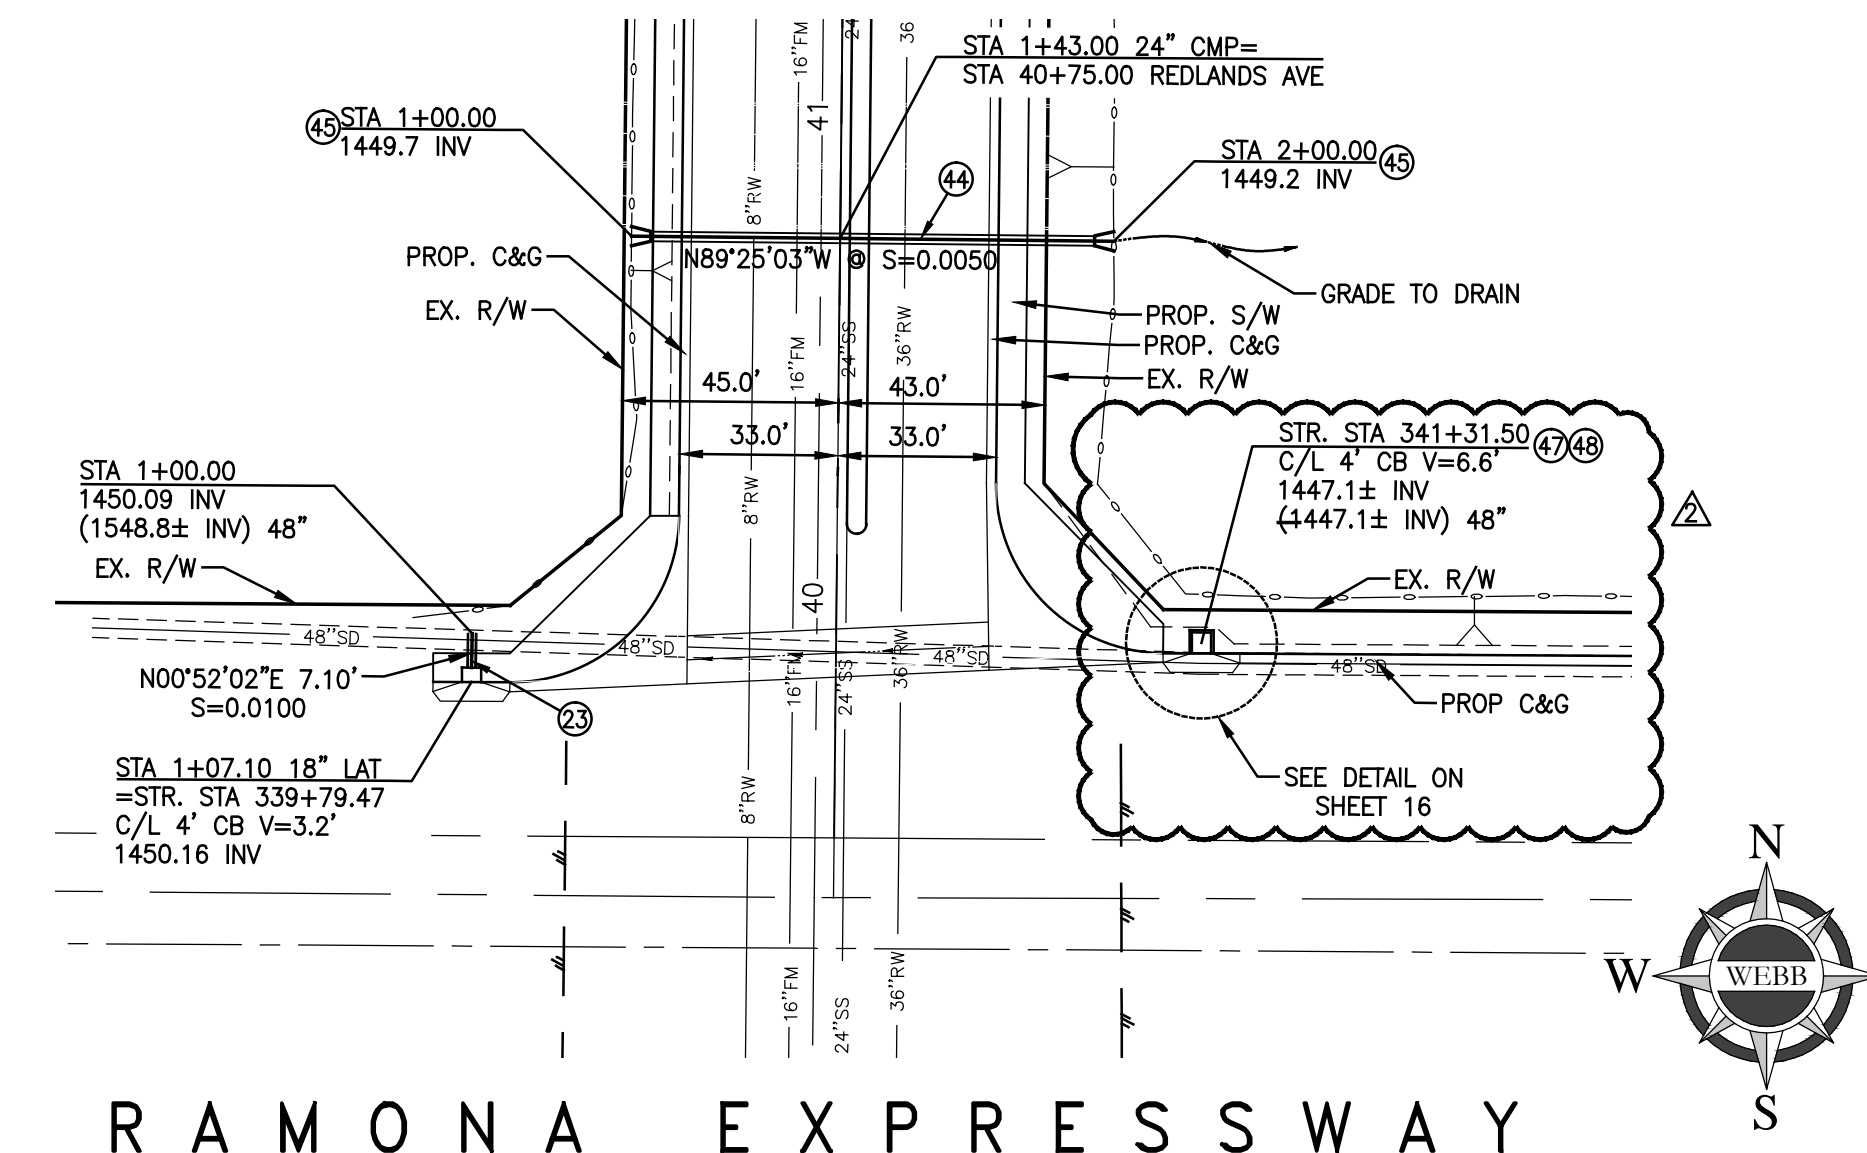

**CONSTRUCTION NOTES**

- (20) INSTALL 48" RCP (D-LOAD PER PLAN)
- (21) INSTALL 36" RCP (D-LOAD PER PLAN)
- (22) INSTALL 24" RCP (D-LOAD PER PLAN)
- (23) INSTALL 18" RCP (D-LOAD PER PLAN)
- (24) CONSTRUCT JUNCTION STRUCTURE NO. 2 PER RCF&WCD STD. JS227
- (25) CONSTRUCT JUNCTION STRUCTURE NO. 4 PER RCF&WCD STD. JS229
- (26) CONSTRUCT MANHOLE NO. 2 PER RCF&WCD STD. MH252
- (31) CONSTRUCT MANHOLE NO. 4 PER RCF&WCD STD. MH254
- (32) REMOVE CONCRETE BULKHEAD
- (33) INSTALL 12" DIA. HDPE N-12 STORM DRAIN PIPE ("ADS" OR APPROVED EQUAL)
- (34) INSTALL 18" DRAIN BASIN ("NYLOPLAST" OR EQUAL) WITH DOME GRATE
- (35) INSTALL 24" CMP HEL-COR PIPE ("CONTECH" OR APPROVED EQUAL)
- (36) INSTALL 24" FLARED END SECTION ("CONTECH" OR APPROVED EQUAL)
- (37) CONSTRUCT MODIFIED GRATING CATCH BASIN PER SPPWC STD 303-3 AND DETAIL ON SHEET 16
- (38) CONSTRUCT LOCAL DEPRESSION PER SPPWC STD 313-3 CASE C

**DIG ALERT**

DIAL BEFORE YOU DIG

TWO WORKING DAYS BEFORE YOU DIG

TOLL FREE 1-800-227-2600

A PUBLIC SERVICE BY UNDERGROUND SERVICE ALERT

**NOTE:**

WORK CONTAINED WITHIN THESE PLANS SHALL NOT COMMENCE UNTIL AN ENCROACHMENT PERMIT AND/OR A GRADING PERMIT HAS BEEN ISSUED.

THE PRIVATE ENGINEER SIGNING THESE PLANS IS RESPONSIBLE FOR ASSURING THE ACCURACY AND ACCEPTABILITY OF THE DESIGN HEREON. IN THE EVENT OF DISCREPANCIES ARISING AFTER CITY APPROVAL OR DURING CONSTRUCTION, THE PRIVATE ENGINEER SHALL BE RESPONSIBLE FOR DETERMINING AN ACCEPTABLE SOLUTION AND REVISING THE PLANS FOR APPROVAL BY THE CITY.

MARK	DJ	DATE	REVISIONS	APPR.	DATE
Δ	DJ	5/29/15	CATCH BASIN REVISED PER FIELD CONDITIONS		

CITY OF PERRIS  
APPROVED BY:

CITY ENGINEER

DATE

SEAL - ENGINEER

REGISTERED PROFESSIONAL ENGINEER  
D.J. ARELLANO  
NO. 81988  
CIVIL  
STATE OF CALIFORNIA

ALBERT A. WEBB ASSOCIATES

ENGINEERING CONSULTANTS  
3788 McCRAY STREET  
RIVERSIDE CA. 92506  
PH. (951) 686-1070  
FAX (951) 788-1256

UNDER THE SUPERVISION OF:

D.J. ARELLANO R.C.E. #C81988 DATE 1/12/2015

BENCHMARK: SEE SHEET 1

SCALE: H: AS SHOWN V: N/A

CITY OF PERRIS

AMENDED DPR NO. 11-12-0004

STORM DRAIN IMPROVEMENT PLANS

LATERAL D-3, D-3A

STA 29+84.12-STA 31+10.60/STA 10+00-STA 17+00



FOR: 2013-0239

W.O. CITY FILE NO. P8-1189

SHEET NO. 15


OF 23 SHEETS

G:\2013\13-0239\DRAWINGS\DESIGN\13-0239-C-SD.DWG 5/17/2016 2:42 PM

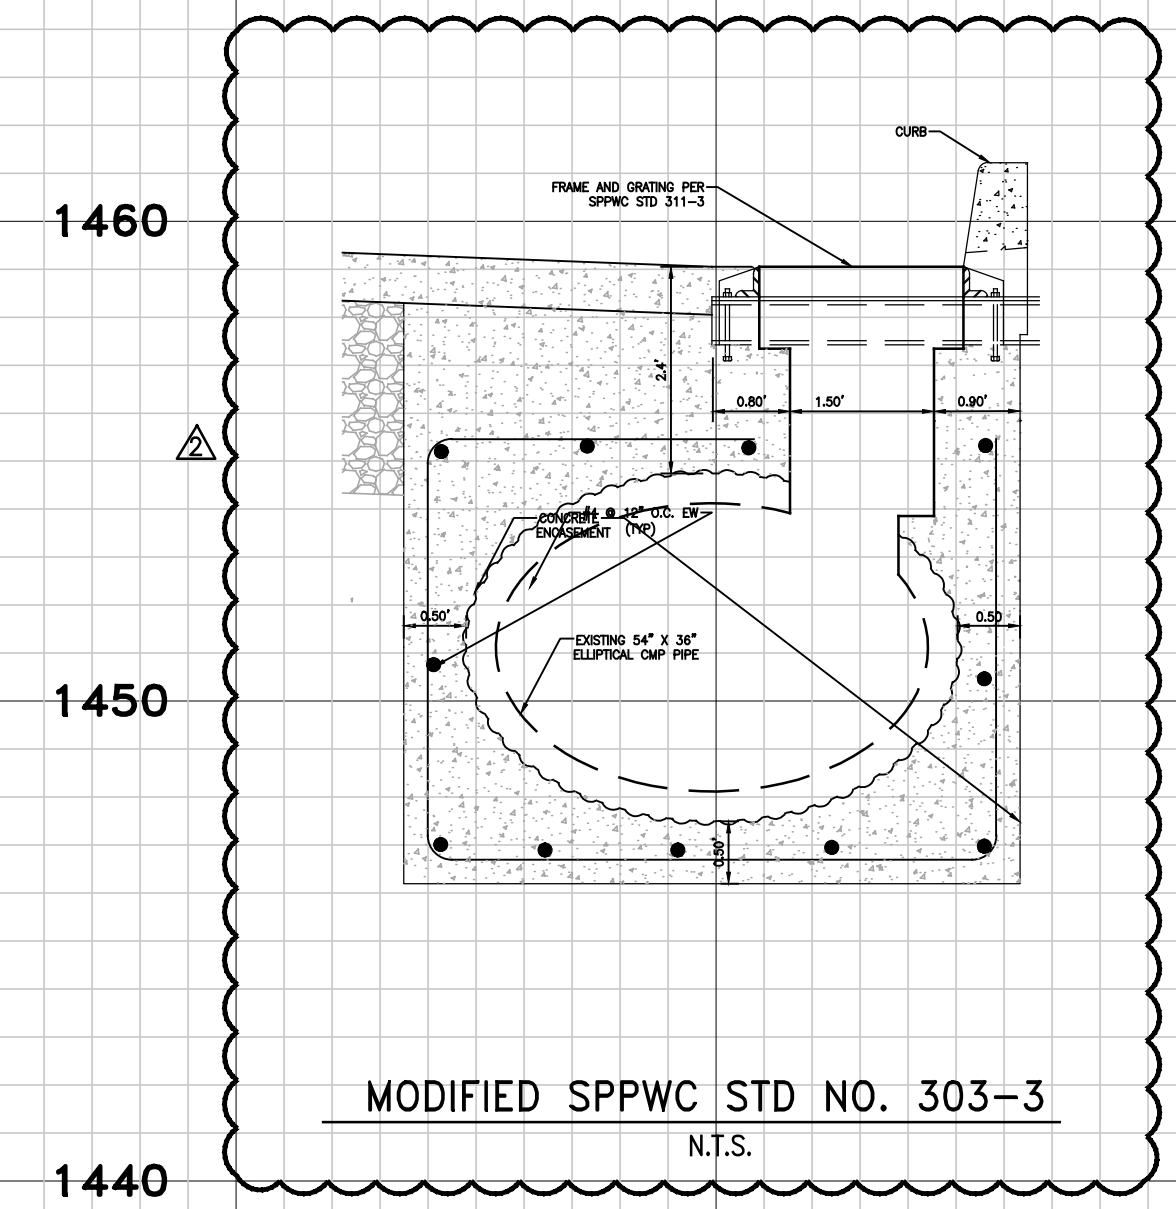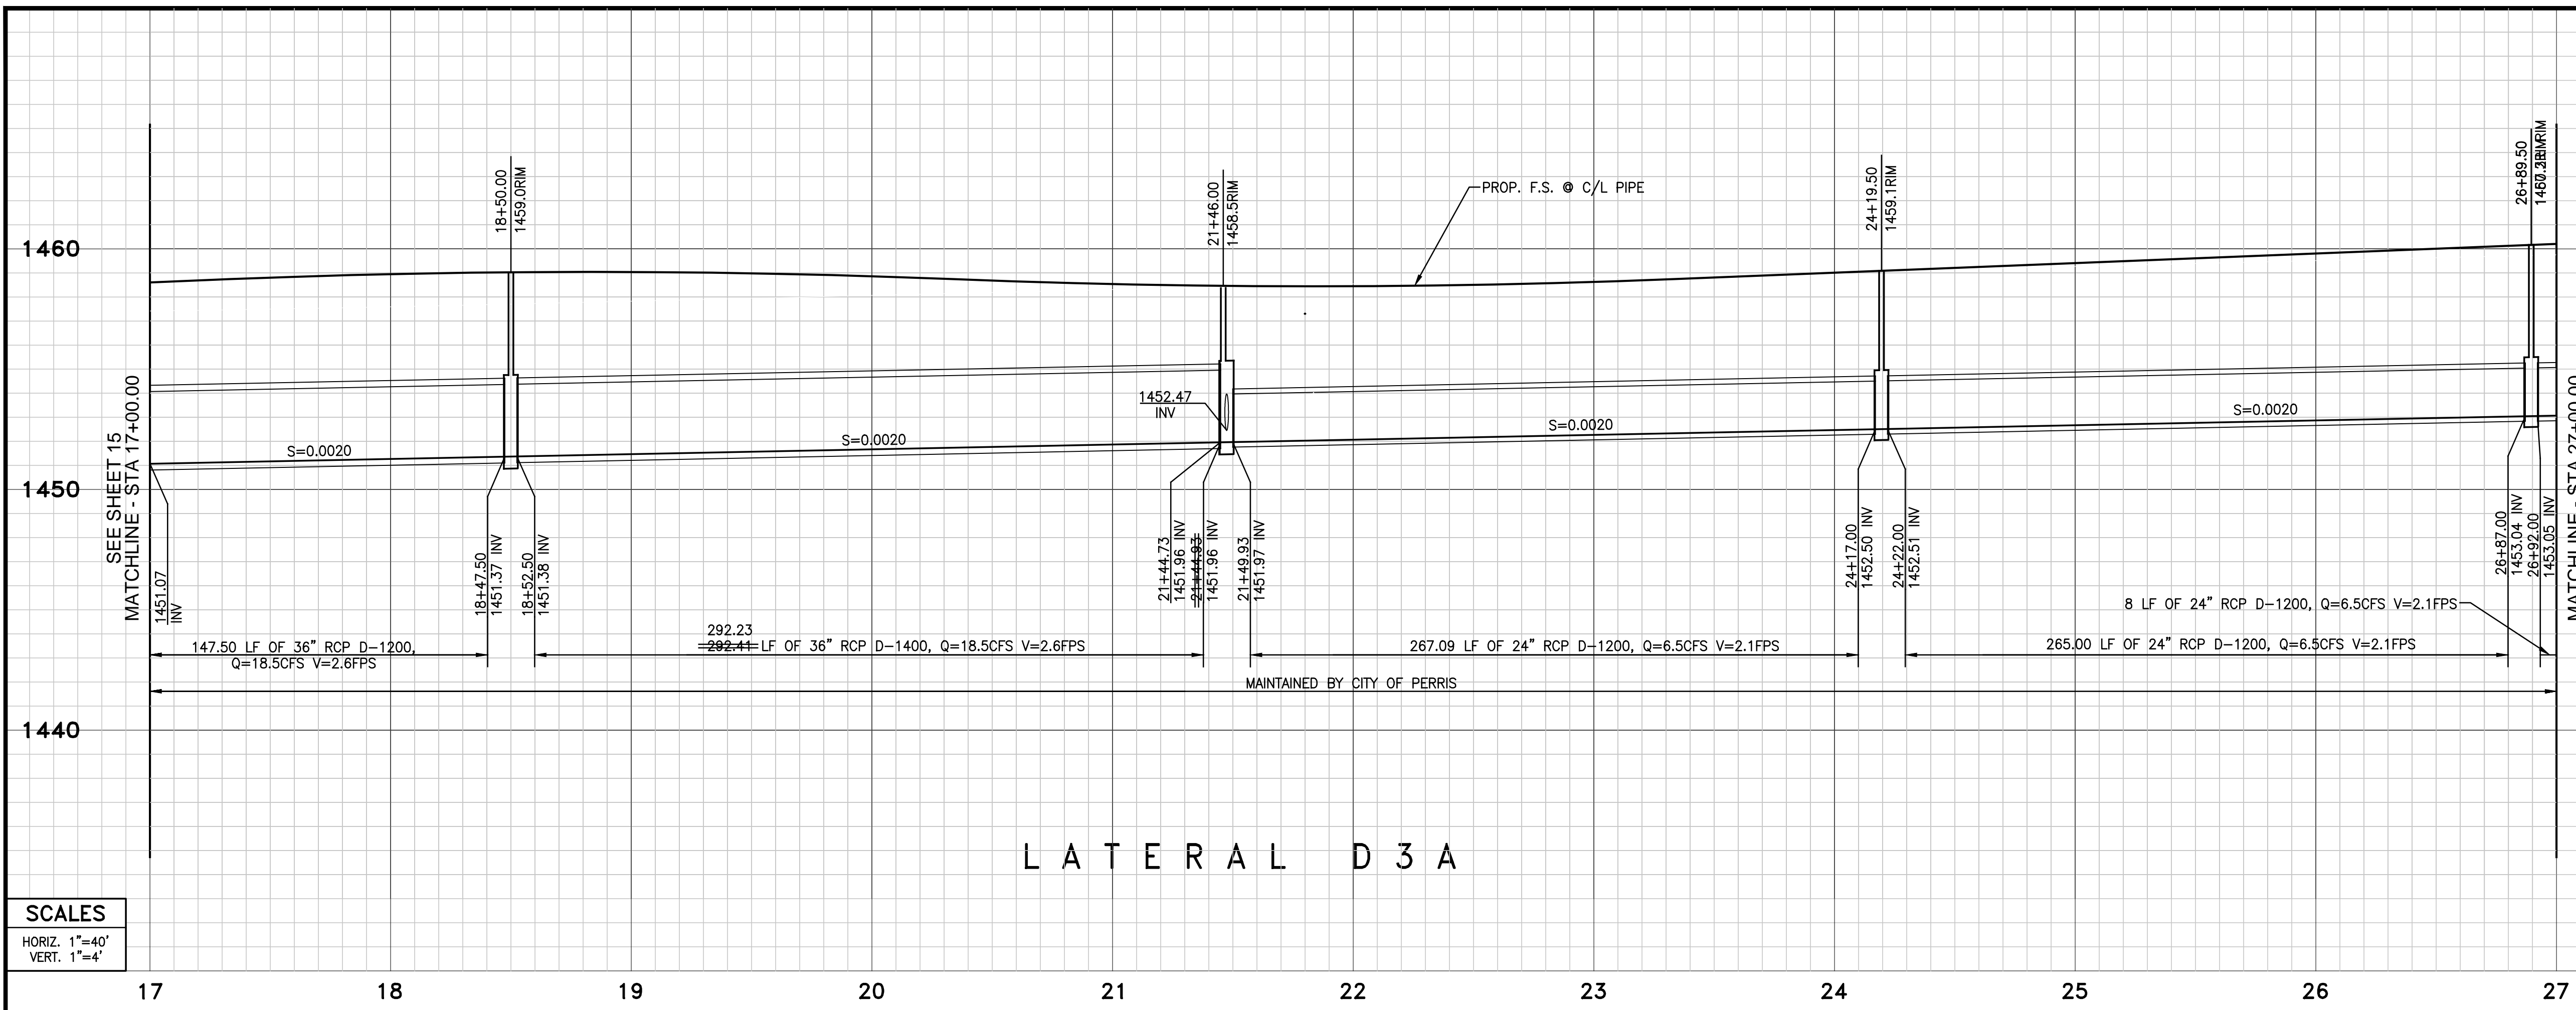


**SCALES**  
HORIZ. 1"=40'  
VERT. 1"=4'

17 18 19 20 21 22 23 24 25 26 27

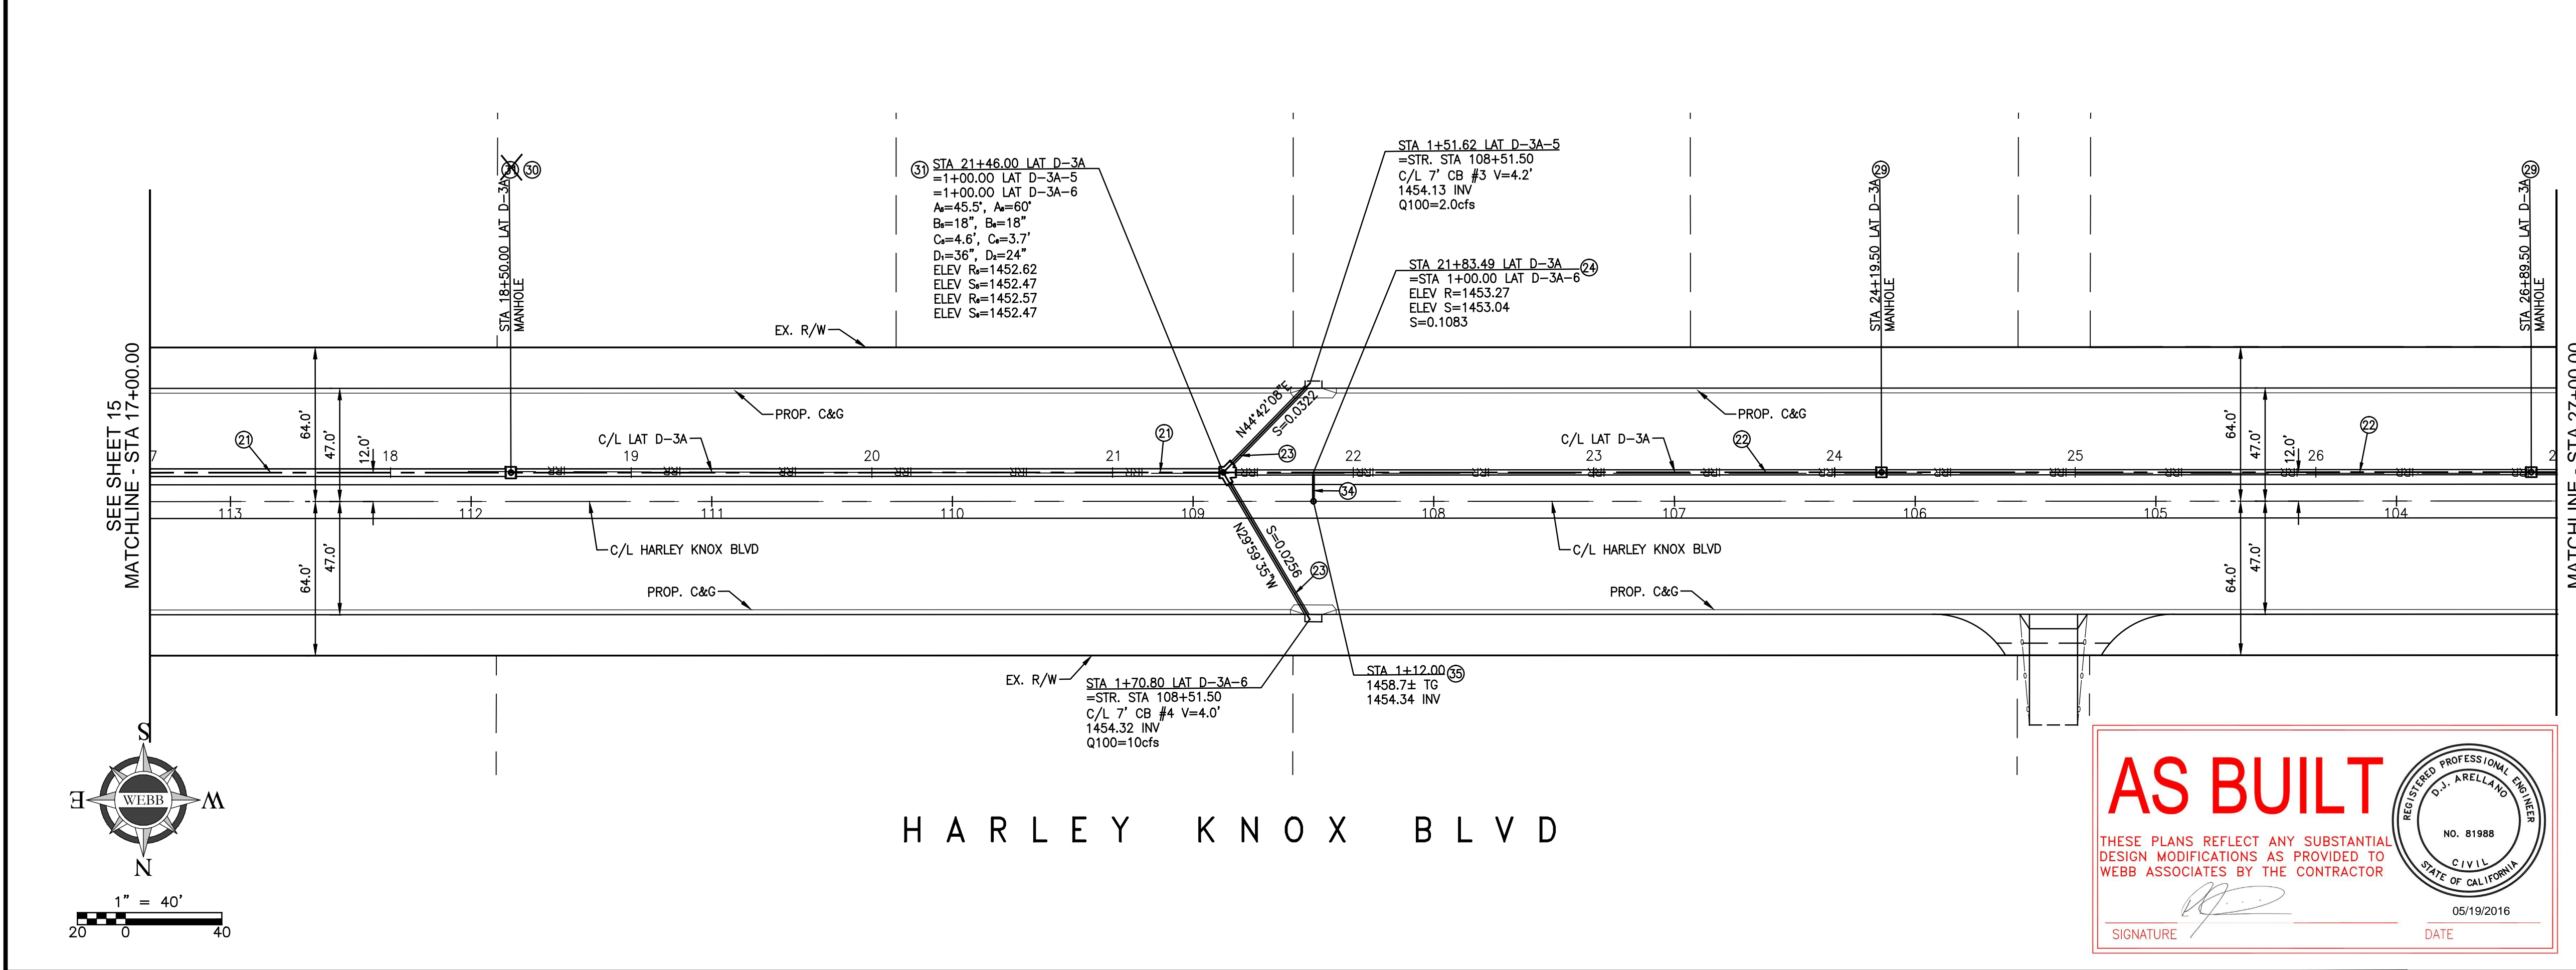


- CONSTRUCTION NOTES**
- 21 INSTALL 36" RCP (D-LOAD PER PLAN)
  - 22 INSTALL 24" RCP (D-LOAD PER PLAN)
  - 23 INSTALL 18" RCP (D-LOAD PER PLAN)
  - 24 CONSTRUCT JUNCTION STRUCTURE NO 2 PER RCFC&WCD STD. JS227
  - 25 CONSTRUCT MANHOLE NO. 1 PER RCFC&WCD STD. MH251
  - 26 CONSTRUCT MANHOLE NO. 4 PER RCFC&WCD STD. MH254
  - 27 INSTALL 12" DIA. HDPE N-12 STORM DRAIN PIPE ("ADS" OR APPROVED EQUAL)
  - 28 INSTALL 18" DRAIN BASIN ("NYLOPLAST" OR EQUAL) WITH DOME GRATE

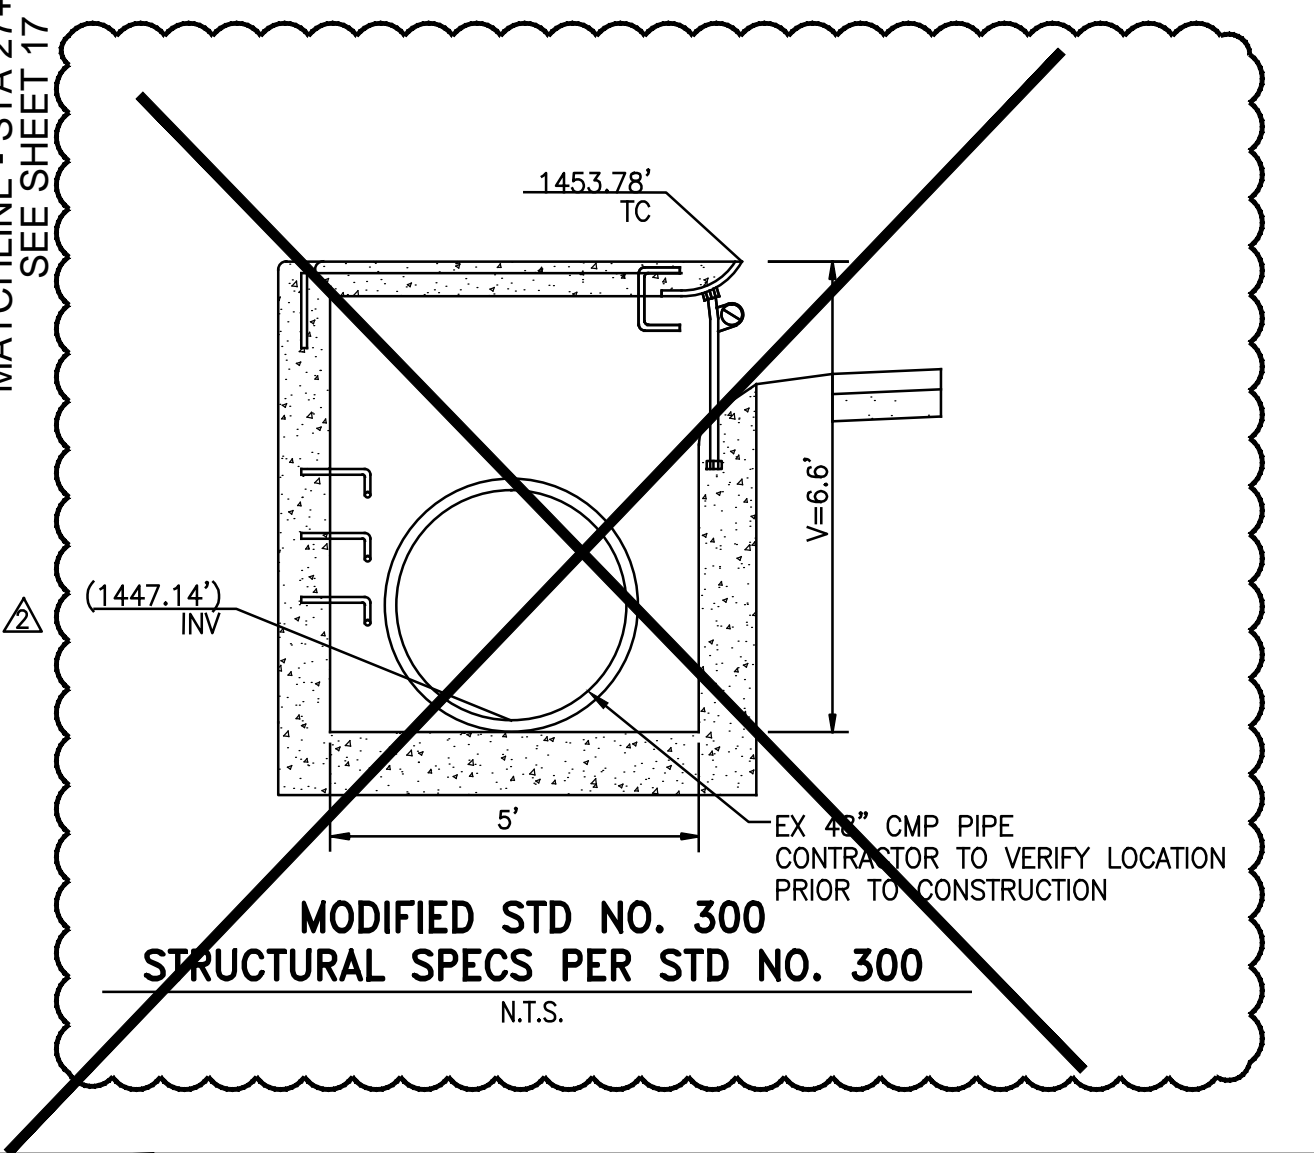

**AS BUILT**  
THESE PLANS REFLECT ANY SUBSTANTIAL DESIGN MODIFICATIONS AS PROVIDED TO WEBB ASSOCIATES BY THE CONTRACTOR

SIGNATURE: [Signature] DATE: 05/19/2016

REGISTERED PROFESSIONAL ENGINEER  
D.J. ARELLANO  
NO. 81988  
CIVIL  
STATE OF CALIFORNIA

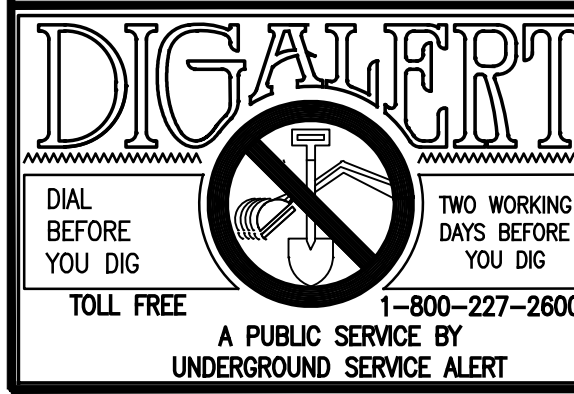

**NOTE:**  
WORK CONTAINED WITHIN THESE PLANS SHALL COMMENCE UNTIL AN ENCROACHMENT PERMIT AND/OR A GRADING PERMIT HAS BEEN ISSUED.

THE PRIVATE ENGINEER SIGNING THESE PLANS IS RESPONSIBLE FOR ASSURING THE ACCURACY AND ACCEPTABILITY OF THE DESIGN HEREON. IN THE EVENT OF DISCREPANCIES ARISING AFTER CITY APPROVAL OR DURING CONSTRUCTION, THE PRIVATE ENGINEER SHALL BE RESPONSIBLE FOR DETERMINING AN ACCEPTABLE SOLUTION AND REVISING THE PLANS FOR APPROVAL BY THE CITY.

MARK	DJ	DATE	REVISIONS	APPR.	DATE
Δ	DJ	5/29/15	CATCH BASIN REVISED PER FIELD CONDITIONS		

CITY OF PERRIS  
APPROVED BY:  
CITY ENGINEER  
DATE

SEAL - ENGINEER  
REGISTERED PROFESSIONAL ENGINEER  
D.J. ARELLANO  
NO. 81988  
CIVIL  
STATE OF CALIFORNIA

**ALBERT A. WEBB ASSOCIATES**  
ENGINEERING CONSULTANTS  
3788 MCCRAY STREET  
RIVERSIDE, CA 92506  
PH. (951) 686-1070  
FAX (951) 788-1256


UNDER THE SUPERVISION OF:  
D.J. ARELLANO R.C.E. #C81988 DATE 1/12/2015

BENCHMARK:  
SEE SHEET 1  
SCALE:  
H: AS SHOWN V: N/A


CITY OF PERRIS  
AMENDED DPR NO. 11-12-0004  
STORM DRAIN IMPROVEMENT PLANS  
LATERAL D-3A  
STA 17+00-STA 27+00

SHEET NO. 16  
OF 23 SHEETS  
CITY FILE NO. P8-1189

6:\2013\13-0239\DRAWINGS\DESIGN\13-0239-C-SD.DWG 5/19/2016 6:37 AM

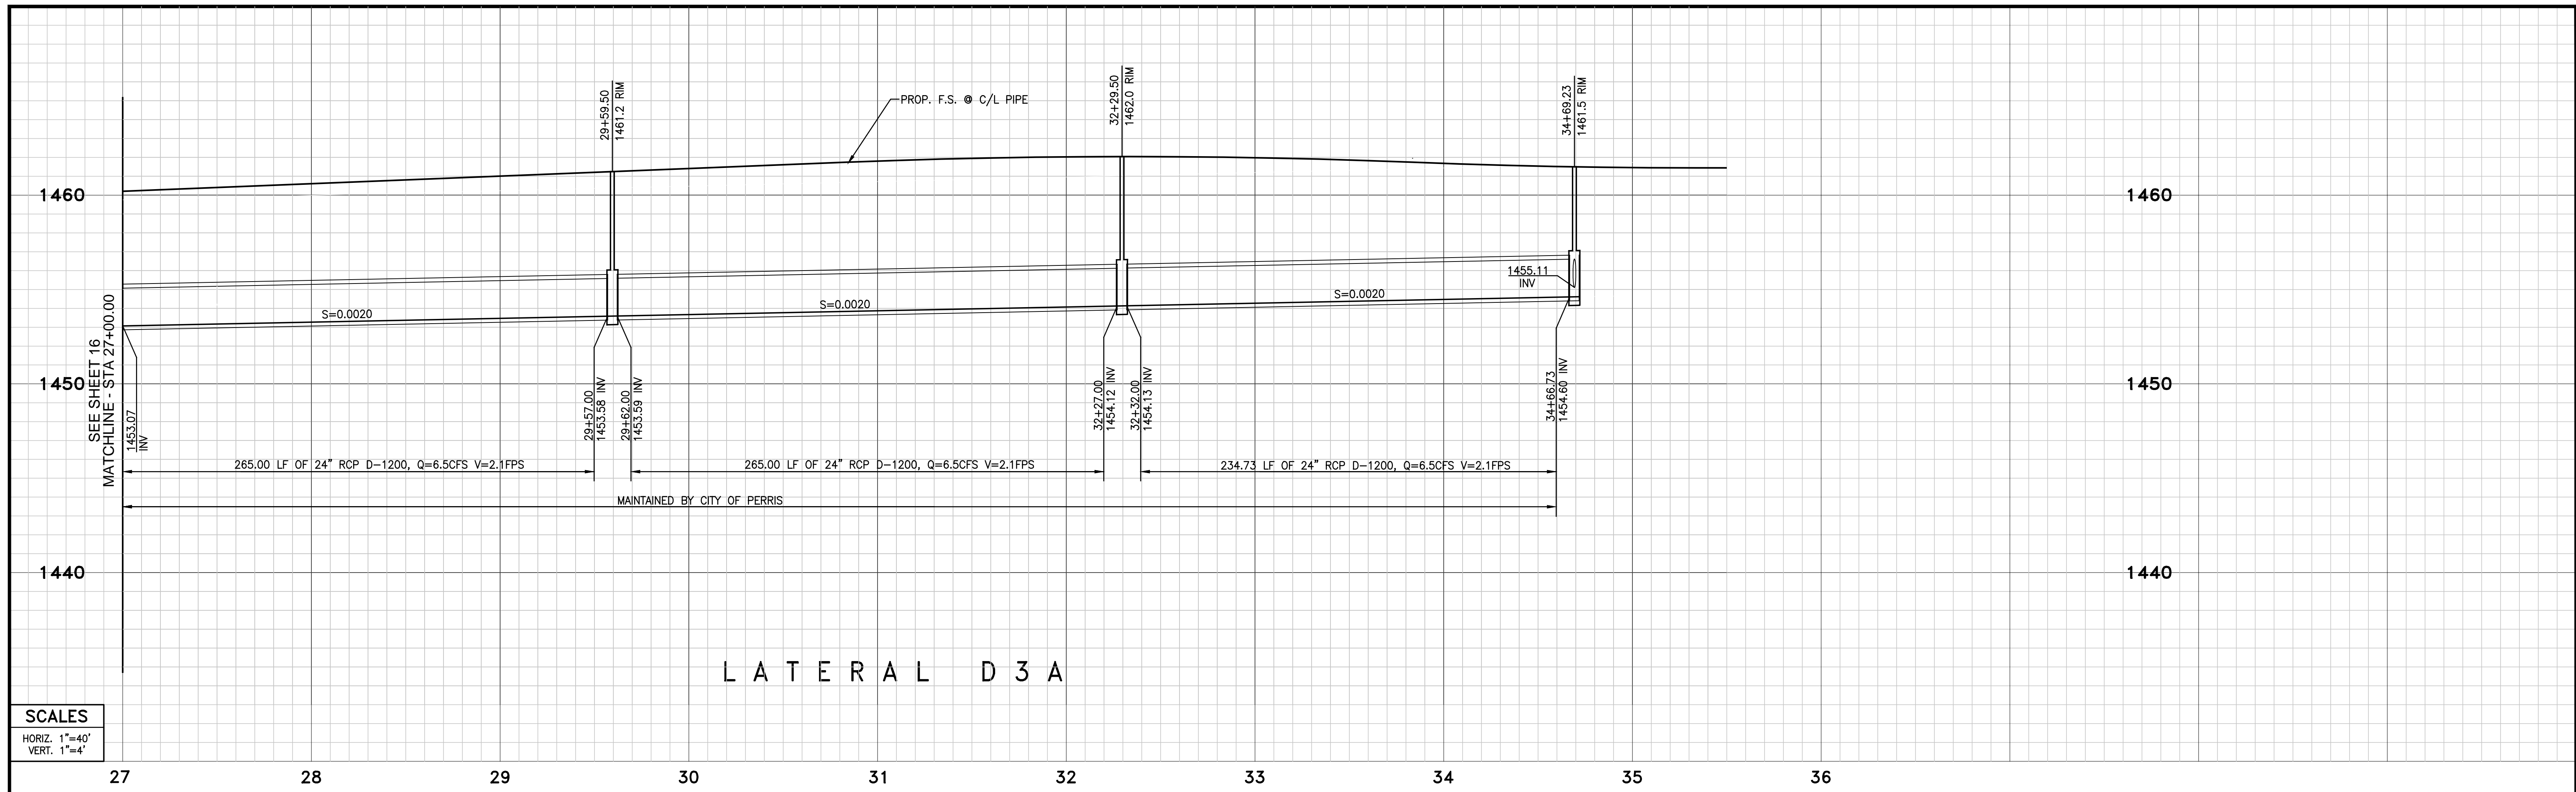

SCALES	
HORIZ.	1"=40'
VERT.	1"=4'

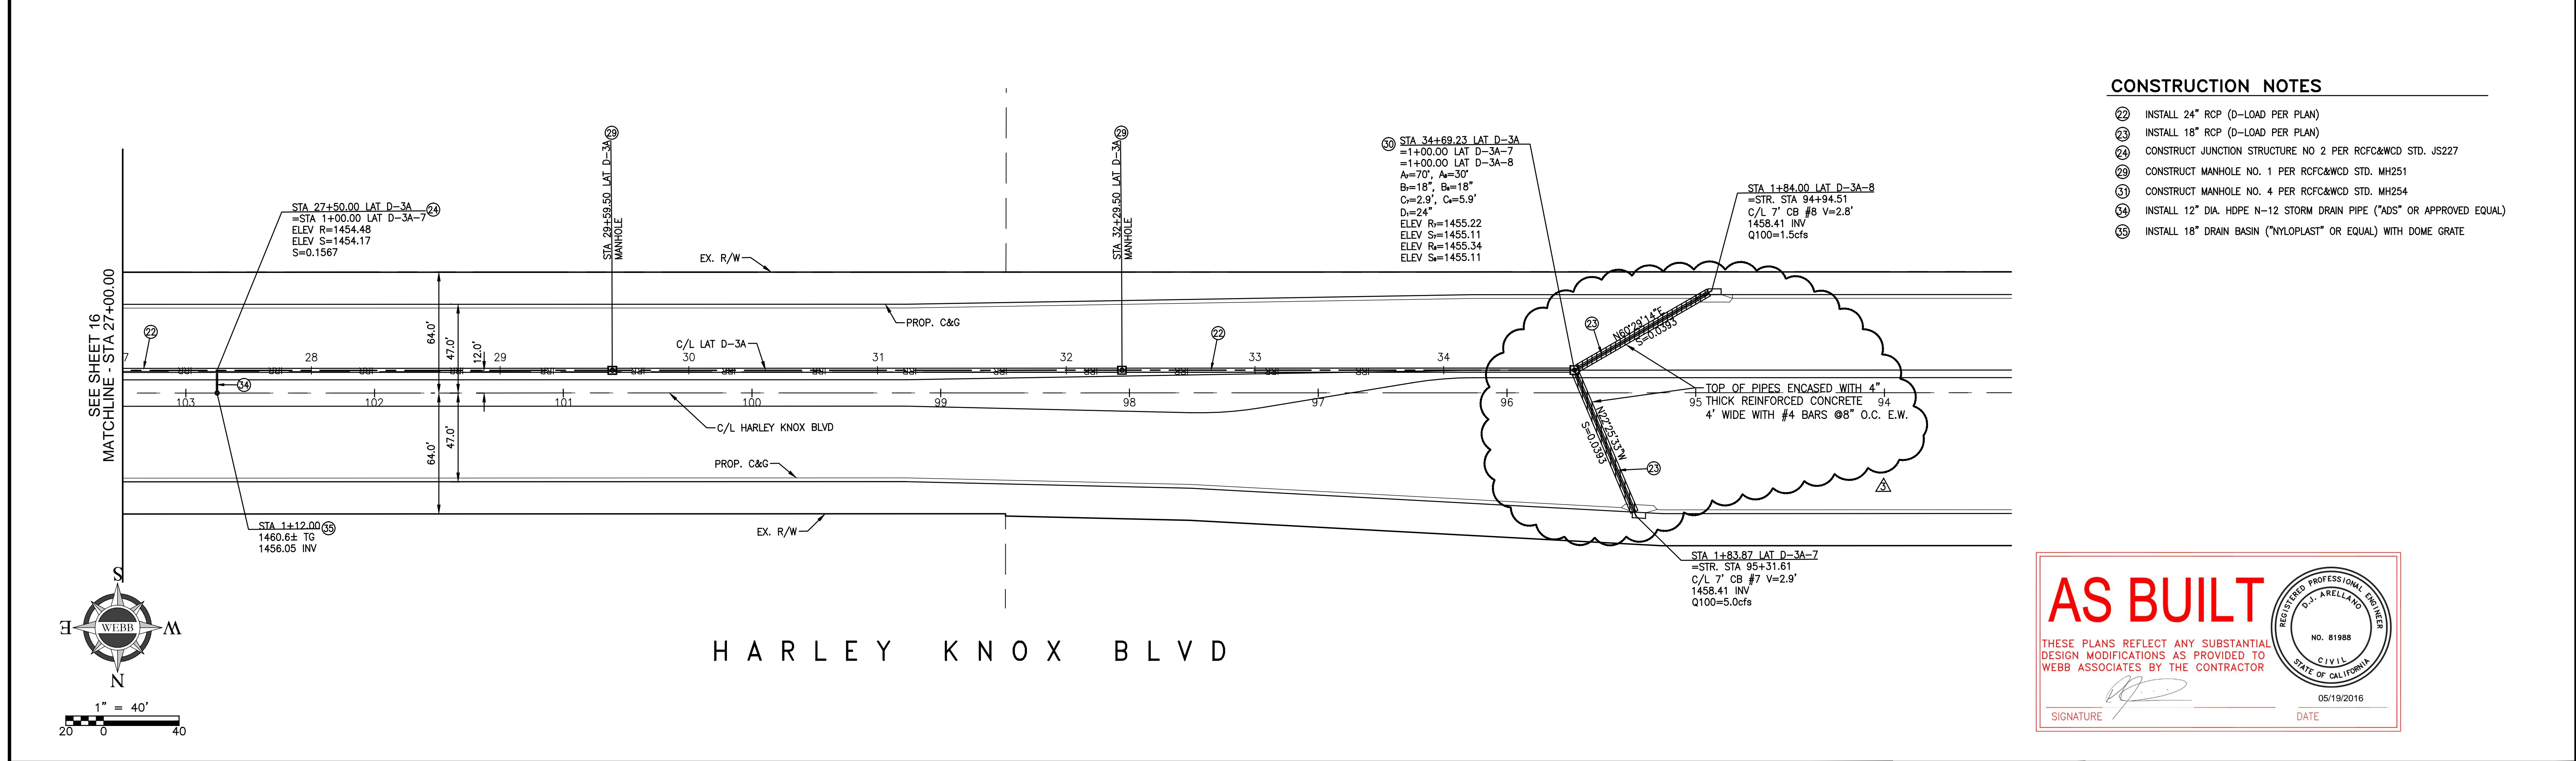

- CONSTRUCTION NOTES**
- 22 INSTALL 24" RCP (D-LOAD PER PLAN)
  - 23 INSTALL 18" RCP (D-LOAD PER PLAN)
  - 24 CONSTRUCT JUNCTION STRUCTURE NO 2 PER RCF&WCD STD. JS227
  - 29 CONSTRUCT MANHOLE NO. 1 PER RCF&WCD STD. MH251
  - 31 CONSTRUCT MANHOLE NO. 4 PER RCF&WCD STD. MH254
  - 34 INSTALL 12" DIA. HDPE N-12 STORM DRAIN PIPE ("ADS" OR APPROVED EQUAL)
  - 35 INSTALL 18" DRAIN BASIN ("NYLOPLAST" OR EQUAL) WITH DOME GRATE

**AS BUILT**

THESE PLANS REFLECT ANY SUBSTANTIAL DESIGN MODIFICATIONS AS PROVIDED TO WEBB ASSOCIATES BY THE CONTRACTOR

SIGNATURE: *[Signature]* DATE: 05/19/2016

REGISTERED PROFESSIONAL ENGINEER  
D.J. ARELLANO  
NO. 81988  
CIVIL  
STATE OF CALIFORNIA

**DIAL BEFORE YOU DIG**

TWO WORKING DAYS BEFORE YOU DIG

TOLL FREE 1-800-227-2600

A PUBLIC SERVICE BY UNDERGROUND SERVICE ALERT

**NOTE:**  
WORK CONTAINED WITHIN THESE PLANS SHALL COMMENCE UNTIL AN ENCROACHMENT PERMIT AND/OR A GRADING PERMIT HAS BEEN ISSUED.

THE PRIVATE ENGINEER SIGNING THESE PLANS IS RESPONSIBLE FOR ASSURING THE ACCURACY AND ACCEPTABILITY OF THE DESIGN HEREON. IN THE EVENT OF DISCREPANCIES ARISING AFTER CITY APPROVAL OR DURING CONSTRUCTION, THE PRIVATE ENGINEER SHALL BE RESPONSIBLE FOR DETERMINING AN ACCEPTABLE SOLUTION AND REVISING THE PLANS FOR APPROVAL BY THE CITY.

MARK	BY	DATE	REVISIONS	APPR.	DATE
Δ	DJ	5/29/15	CONCRETE ENCASUREMENT OF SD PIPES		

CITY OF PERRIS  
APPROVED BY:

CITY ENGINEER

DATE

SEAL - ENGINEER

REGISTERED PROFESSIONAL ENGINEER  
D.J. ARELLANO  
NO. 81988  
CIVIL  
STATE OF CALIFORNIA

**ALBERT A. WEBB ASSOCIATES**

ENGINEERING CONSULTANTS  
3788 McCRAY STREET  
RIVERSIDE, CA. 92506  
PH. (951) 686-1070  
FAX (951) 788-1256

UNDER THE SUPERVISION OF:

D.J. ARELLANO R.C.E. #C81988 DATE 1/12/2015


BENCHMARK:  
SEE SHEET 1

SCALE:  
H: AS SHOWN V: N/A

CITY OF PERRIS  
AMENDED DPR NO. 11-12-0004  
STORM DRAIN IMPROVEMENT PLANS  
LATERAL D-3A  
STA 27+00-STA 34+69.23



FOR: W.O. 2013-0239 CITY FILE NO. P8-1189

SHEET NO. 17 OF 23 SHEETS

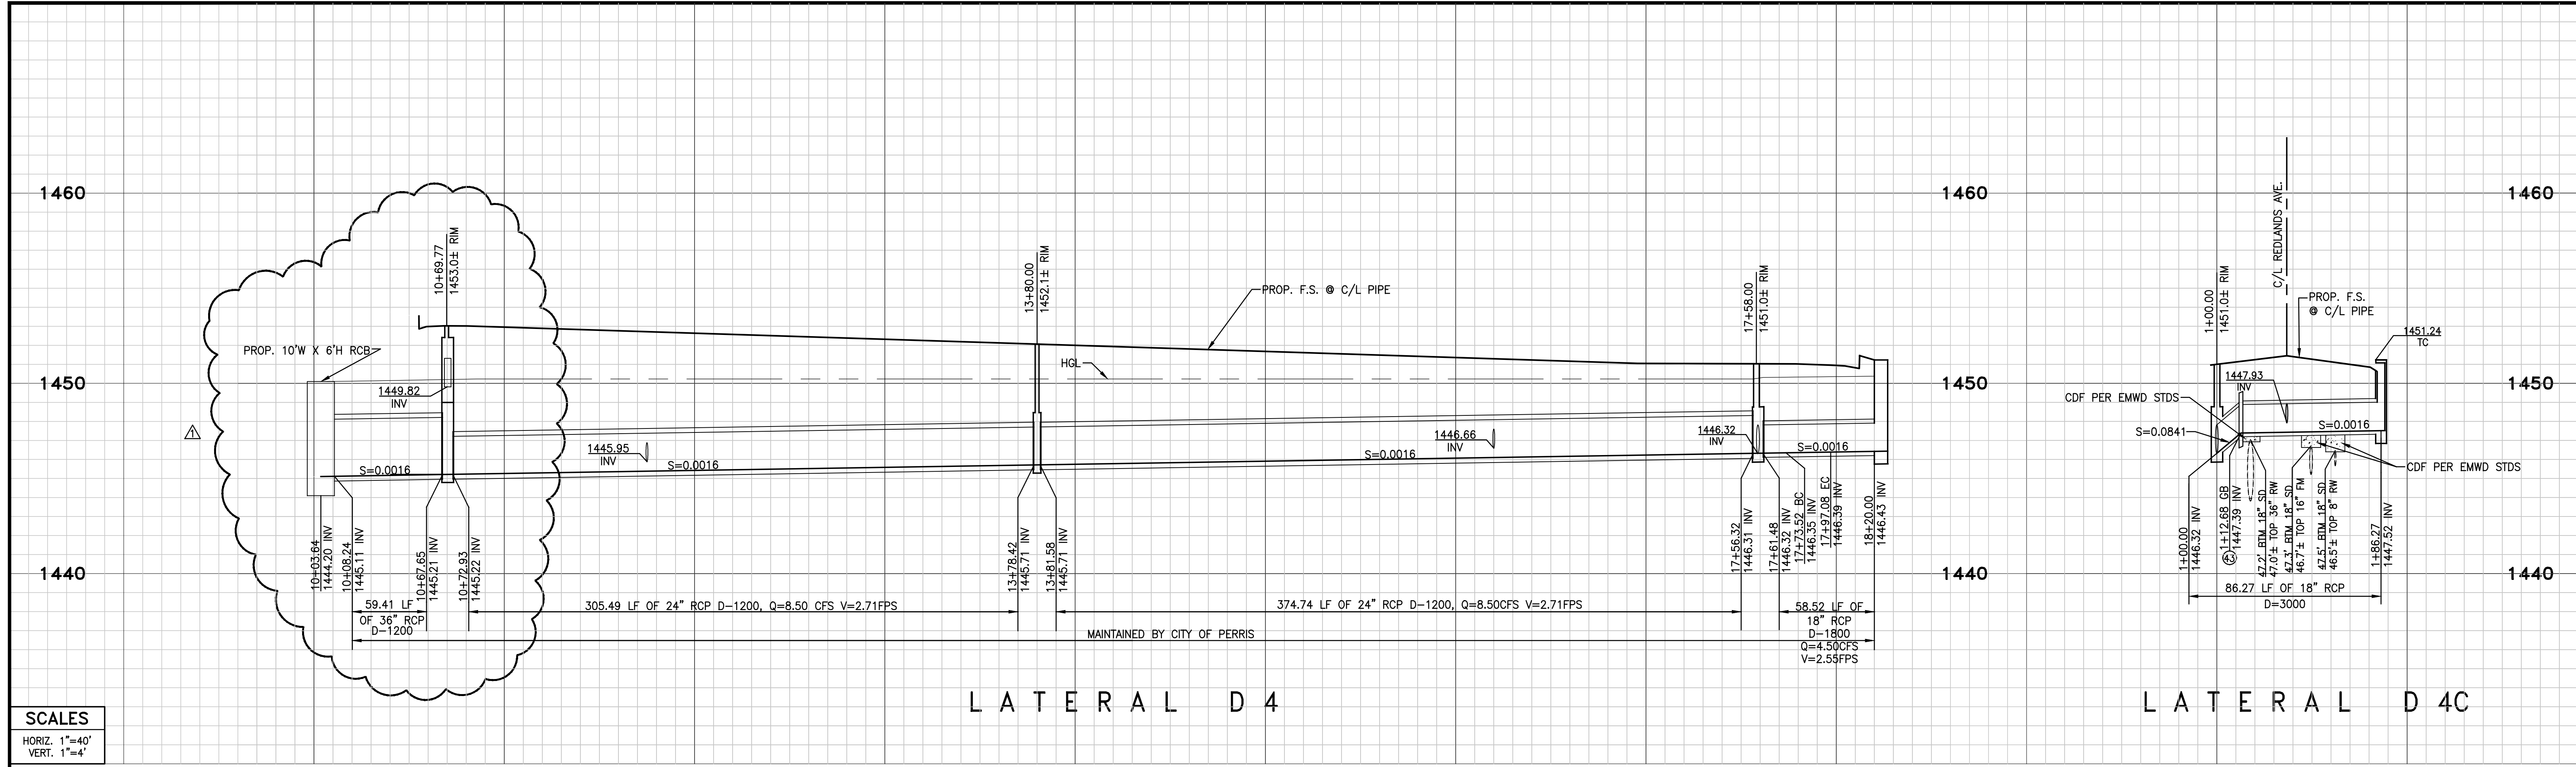



**SCALES**  
 HORIZ. 1"=40'  
 VERT. 1"=4'

**CURVE DATA**  
 A=15'00"00"  
 R=90.0'  
 L=23.56'  
 T=11.85'

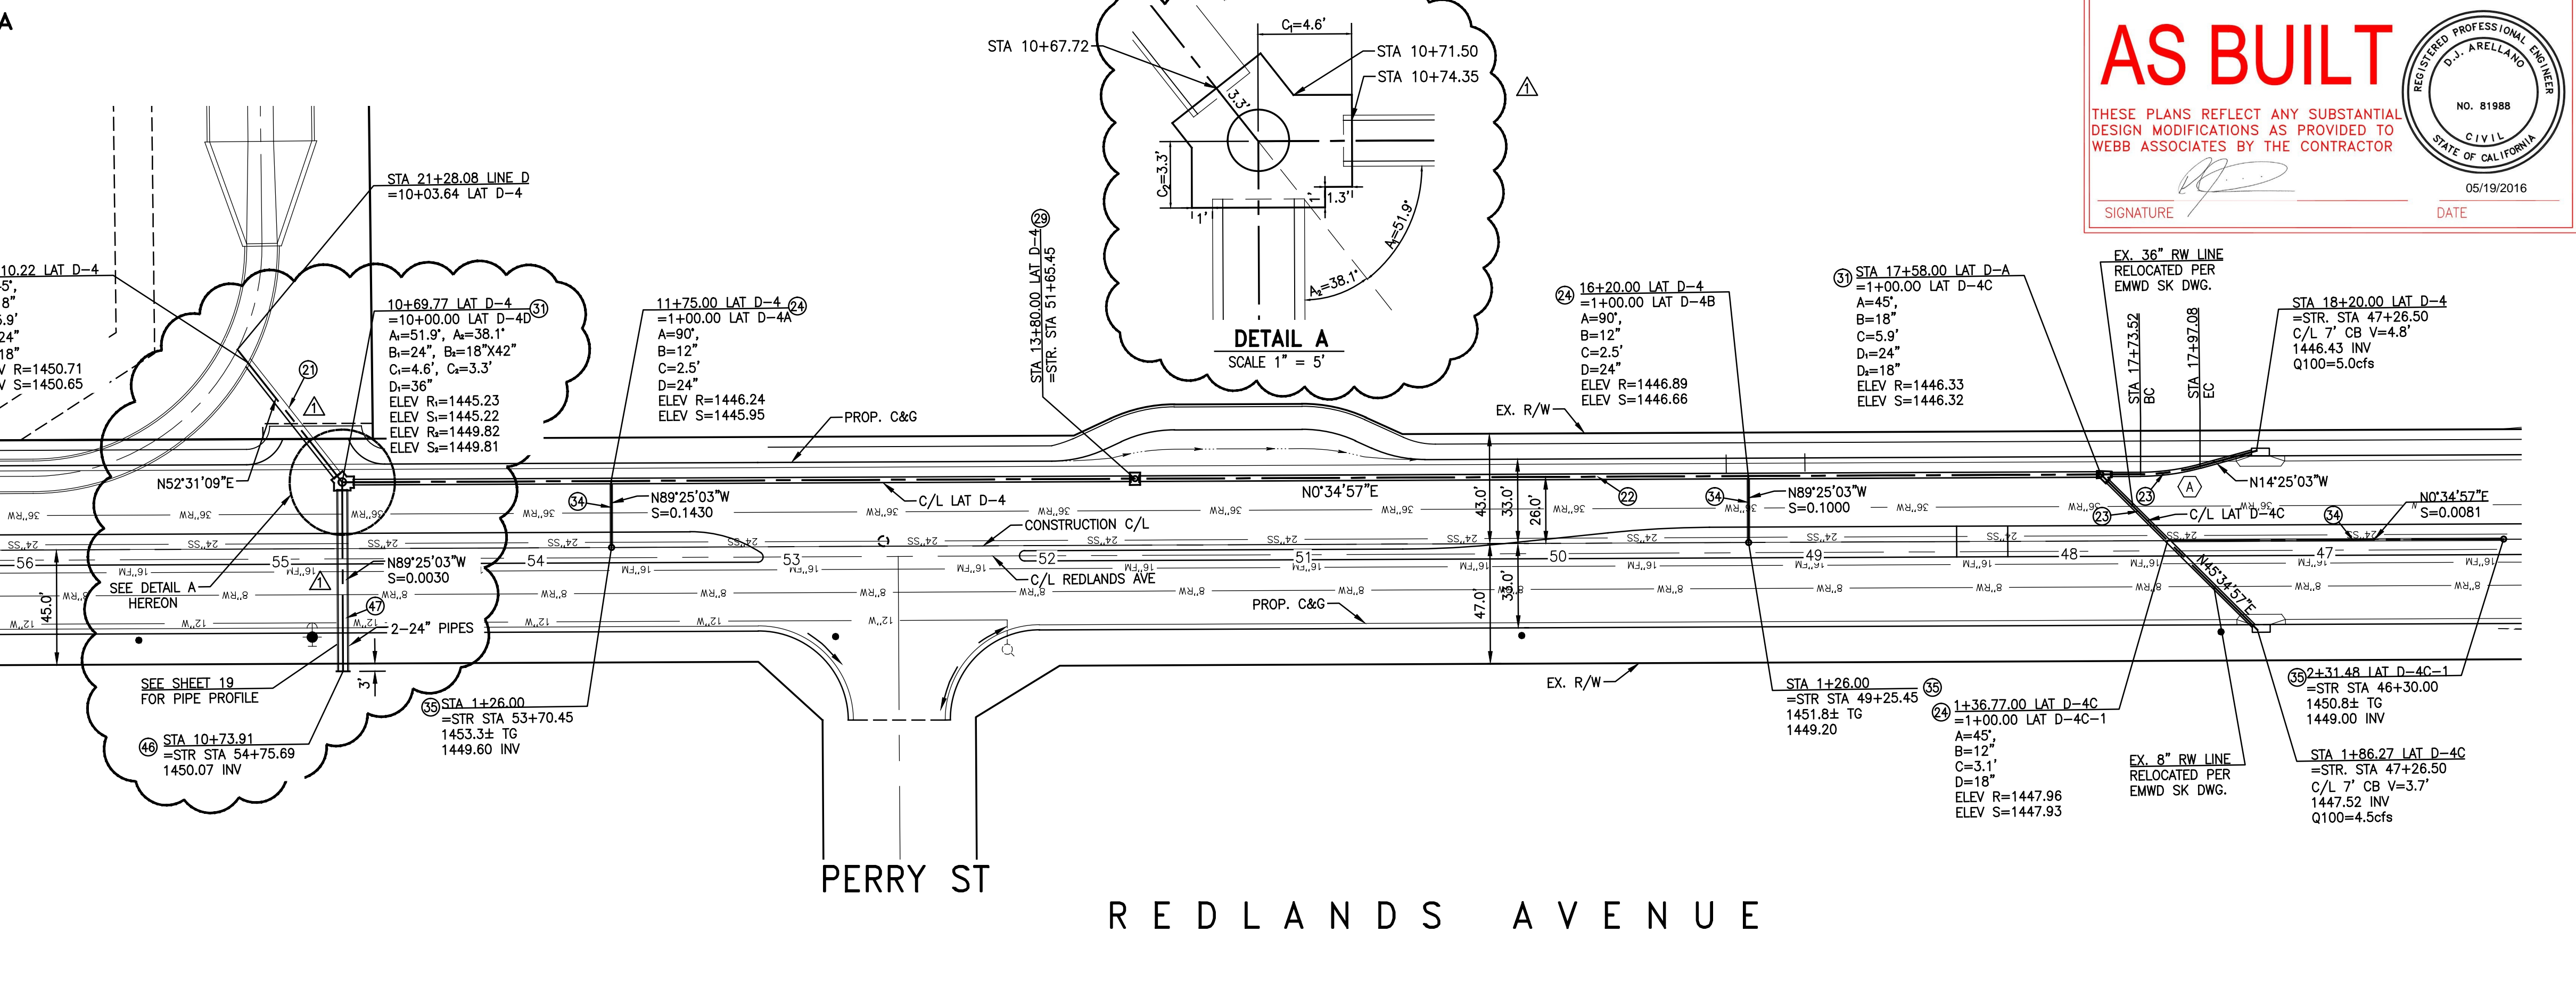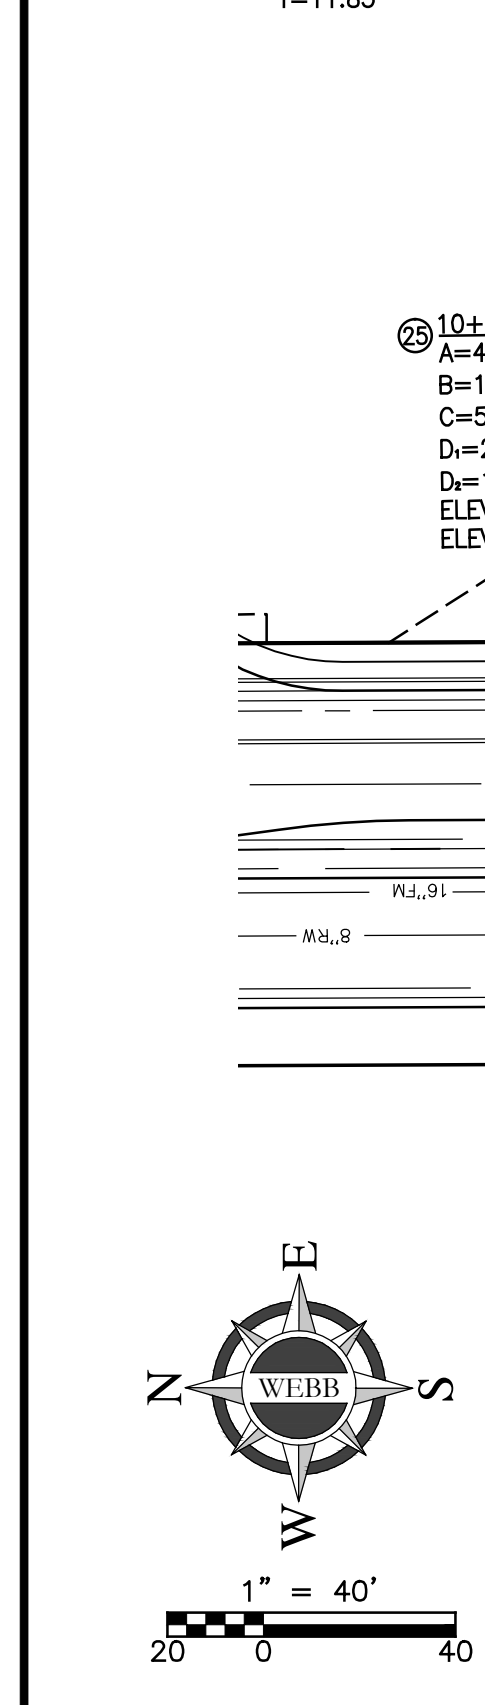

**AS BUILT**  
 THESE PLANS REFLECT ANY SUBSTANTIAL DESIGN MODIFICATIONS AS PROVIDED TO WEBB ASSOCIATES BY THE CONTRACTOR  
 SIGNATURE: [Signature]  
 DATE: 05/19/2016  
 REGISTERED PROFESSIONAL ENGINEER  
 D.J. ARELLANO  
 NO. 81988  
 CIVIL  
 STATE OF CALIFORNIA

- CONSTRUCTION NOTES**
1. INSTALL 36" RCP (D-LOAD PER PLAN)
  2. INSTALL 24" RCP (D-LOAD PER PLAN)
  3. INSTALL 18" RCP (D-LOAD PER PLAN)
  4. CONSTRUCT JUNCTION STRUCTURE NO 2 PER RCF&WCD STD. JS227
  5. CONSTRUCT JUNCTION STRUCTURE NO 3 PER RCF&WCD STD. JS228
  6. CONSTRUCT MANHOLE NO. 1 PER RCF&WCD STD. MH251
  7. CONSTRUCT MANHOLE NO. 4 PER RCF&WCD STD. MH254
  8. INSTALL 12" DIA. HDPE N-12 STORM DRAIN PIPE ("ADS" OR APPROVED EQUAL)
  9. INSTALL 18" DRAIN BASIN ("NYLOPLAST" OR EQUAL) WITH DOME GRATE
  10. INSTALL CONCRETE COLLAR PER RCF&WCD STD. M803
  11. CONSTRUCT CONCRETE BULKHEAD
  12. CONSTRUCT 18"x42" RCB PER CALTRANS STD. D80

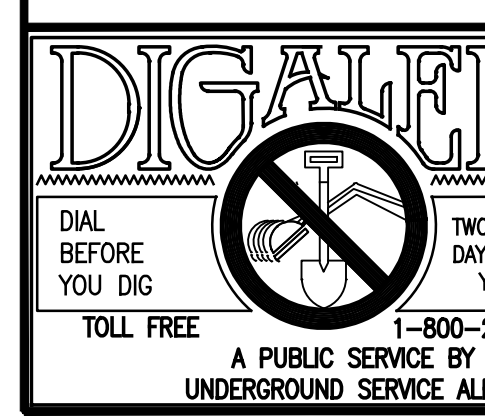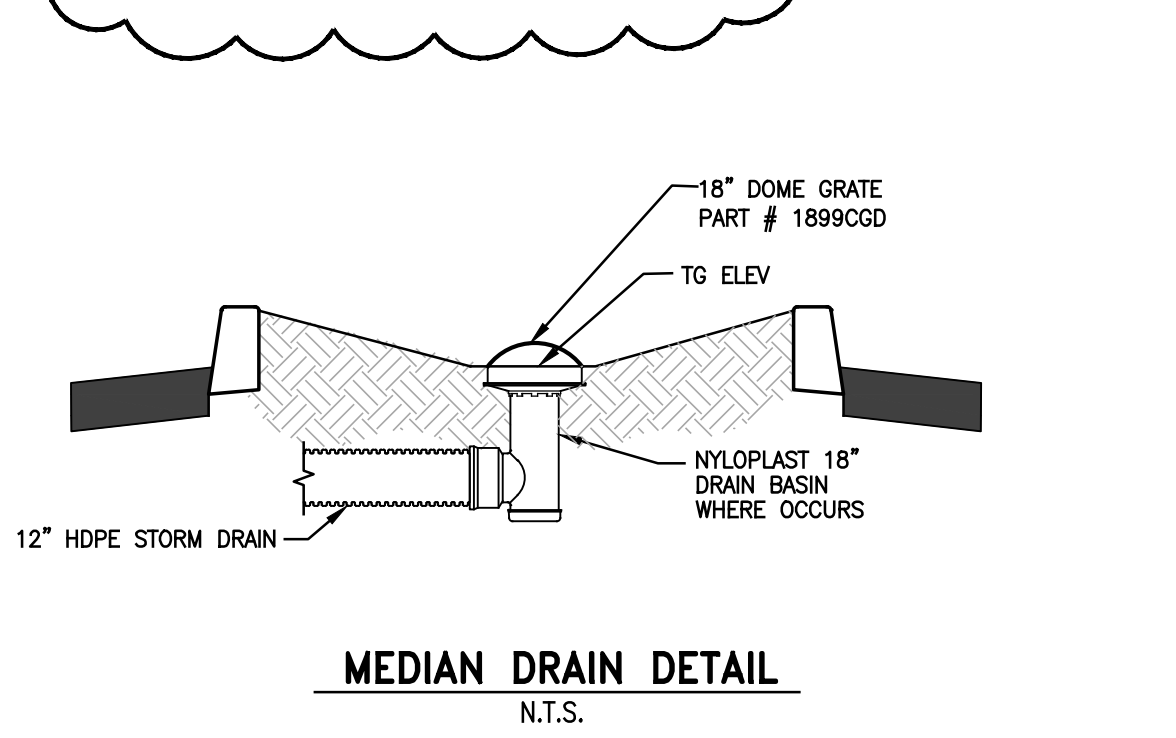

**NOTE:**  
 WORK CONTAINED WITHIN THESE PLANS SHALL NOT COMMENCE UNTIL AN ENCROACHMENT PERMIT AND/OR A GRADING PERMIT HAS BEEN ISSUED.  
 THE PRIVATE ENGINEER SIGNING THESE PLANS IS RESPONSIBLE FOR ASSURING THE ACCURACY AND ACCEPTABILITY OF THE DESIGN HEREON. IN THE EVENT OF DISCREPANCIES ARISING AFTER CITY APPROVAL OR DURING CONSTRUCTION, THE PRIVATE ENGINEER SHALL BE RESPONSIBLE FOR DETERMINING AN ACCEPTABLE SOLUTION AND REVISING THE PLANS FOR APPROVAL BY THE CITY.

MARK	BY	DATE	REVISIONS	APPR.	DATE
Δ	DJM	3/5/15	ADDED 18"x42" RCB LATERAL, 36" PIPE, AND JUNCTION STRUCTURE		

CITY OF PERRIS  
 APPROVED BY:  
 CITY ENGINEER  
 DATE

SEAL - ENGINEER  
 REGISTERED PROFESSIONAL ENGINEER  
 D.J. ARELLANO  
 NO. 81988  
 CIVIL  
 STATE OF CALIFORNIA

ALBERT A. WEBB ASSOCIATES  
 ENGINEERING CONSULTANTS  
 3788 McCGRAY STREET  
 RIVERSIDE CA. 92506  
 PH. (951) 686-1070  
 FAX (951) 788-1256  
 UNDER THE SUPERVISION OF:  
 D.J. ARELLANO R.C.E. #C81988 DATE 1/12/2015

BENCHMARK:  
 SEE SHEET 1  
 SCALE:  
 H: AS SHOWN V: N/A


CITY OF PERRIS  
 AMENDED DPR NO. 11-12-0004  
 STORM DRAIN IMPROVEMENT PLANS  
 LATERAL D-4, D-4A

SHEET NO.  
 18  
 OF 23 SHEETS  
 FOR: W.O. 2013-0239 CITY FILE NO. P8-1189

6:\2013\13-0239\DRAWINGS\DESIGN\13-0239-C-SD.DWG 5/19/2016 6:37 AM

**NOTE TO CONTRACTOR**

1. CONTRACTOR TO VERIFY LOCATIONS AND ELEVATIONS OF ALL EXISTING UTILITIES PRIOR TO CONSTRUCTION

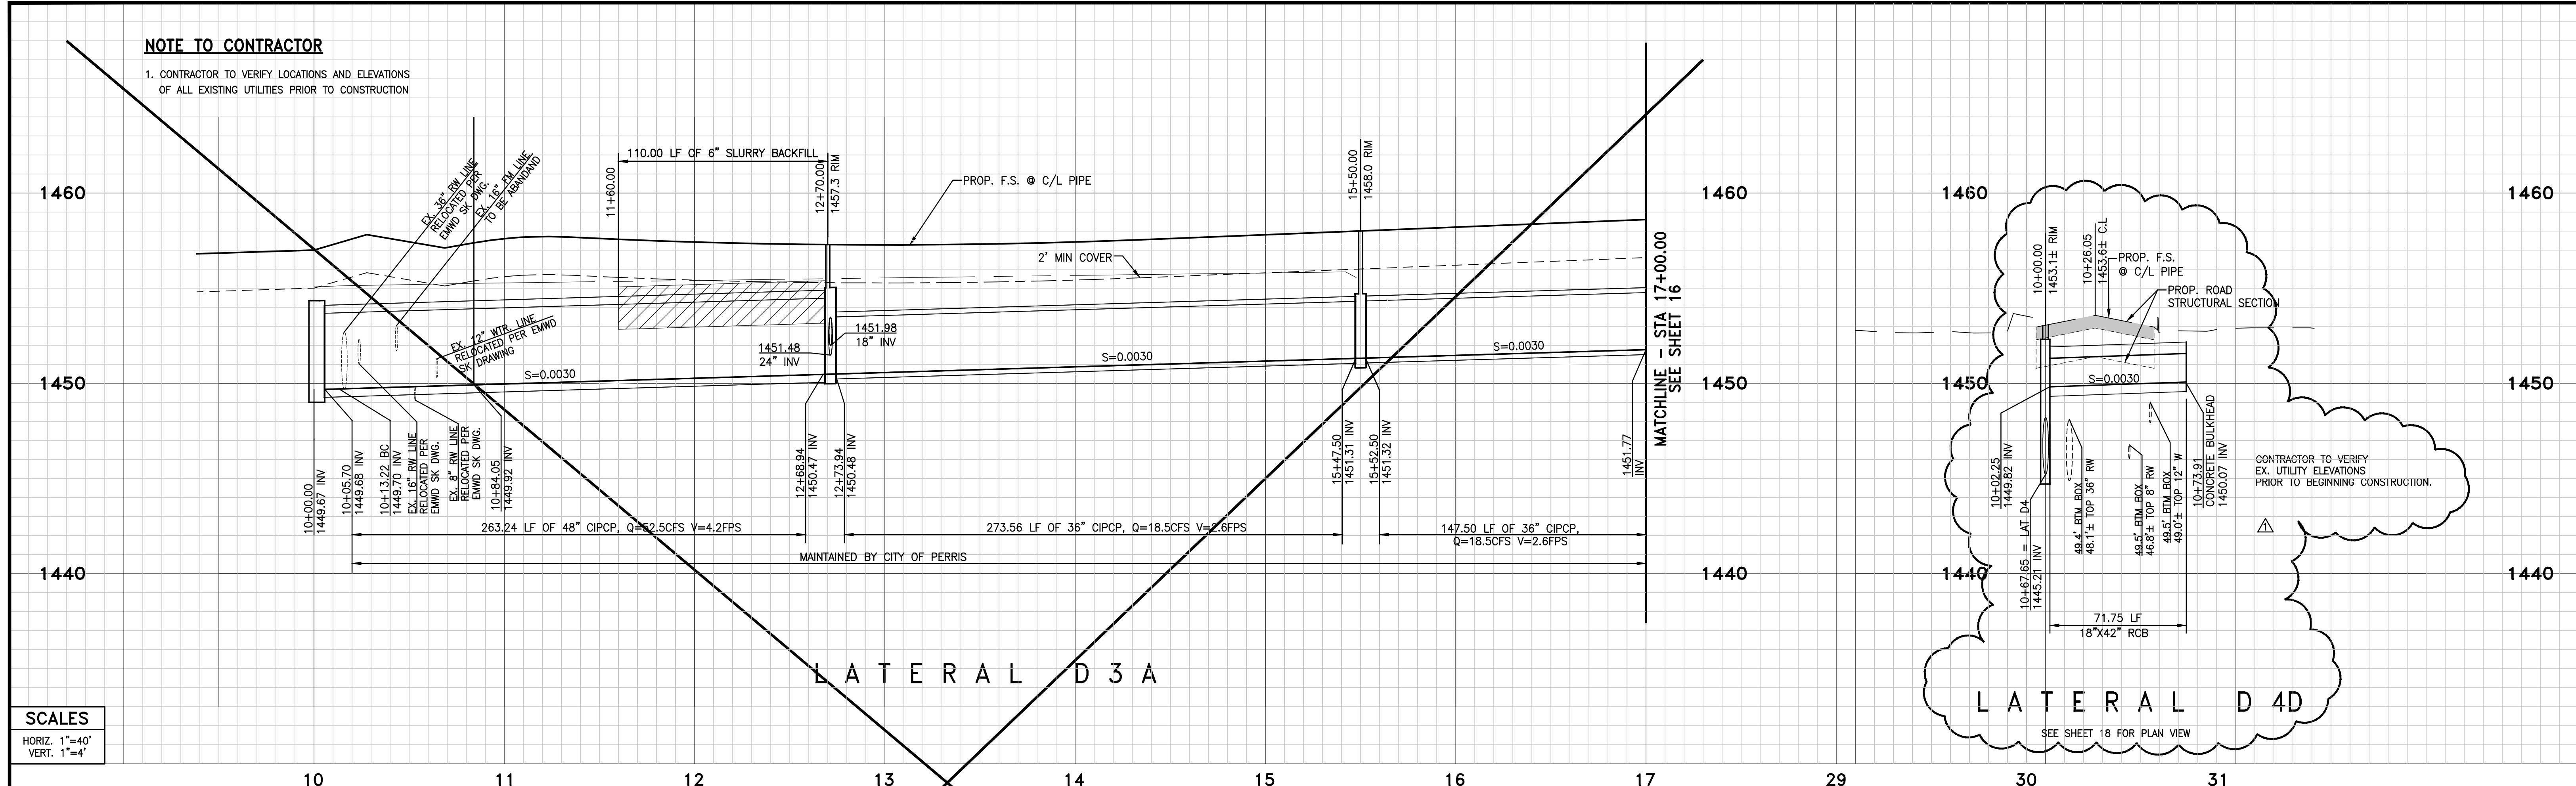

**SCALES**  
HORIZ. 1"=40'  
VERT. 1"=4'

**CURVE DATA**


(A) Δ=45°05'24"  
R=90.0'  
L=70.83'  
T=37.36'

(B) Δ=45°00'00"  
R=22.5'  
L=17.67'  
T=9.32'

**REDLANDS AVE**


**NOTE TO CONTRACTOR**

1. CONTRACTOR TO VERIFY LOCATIONS AND ELEVATIONS OF ALL EXISTING UTILITIES PRIOR TO CONSTRUCTION

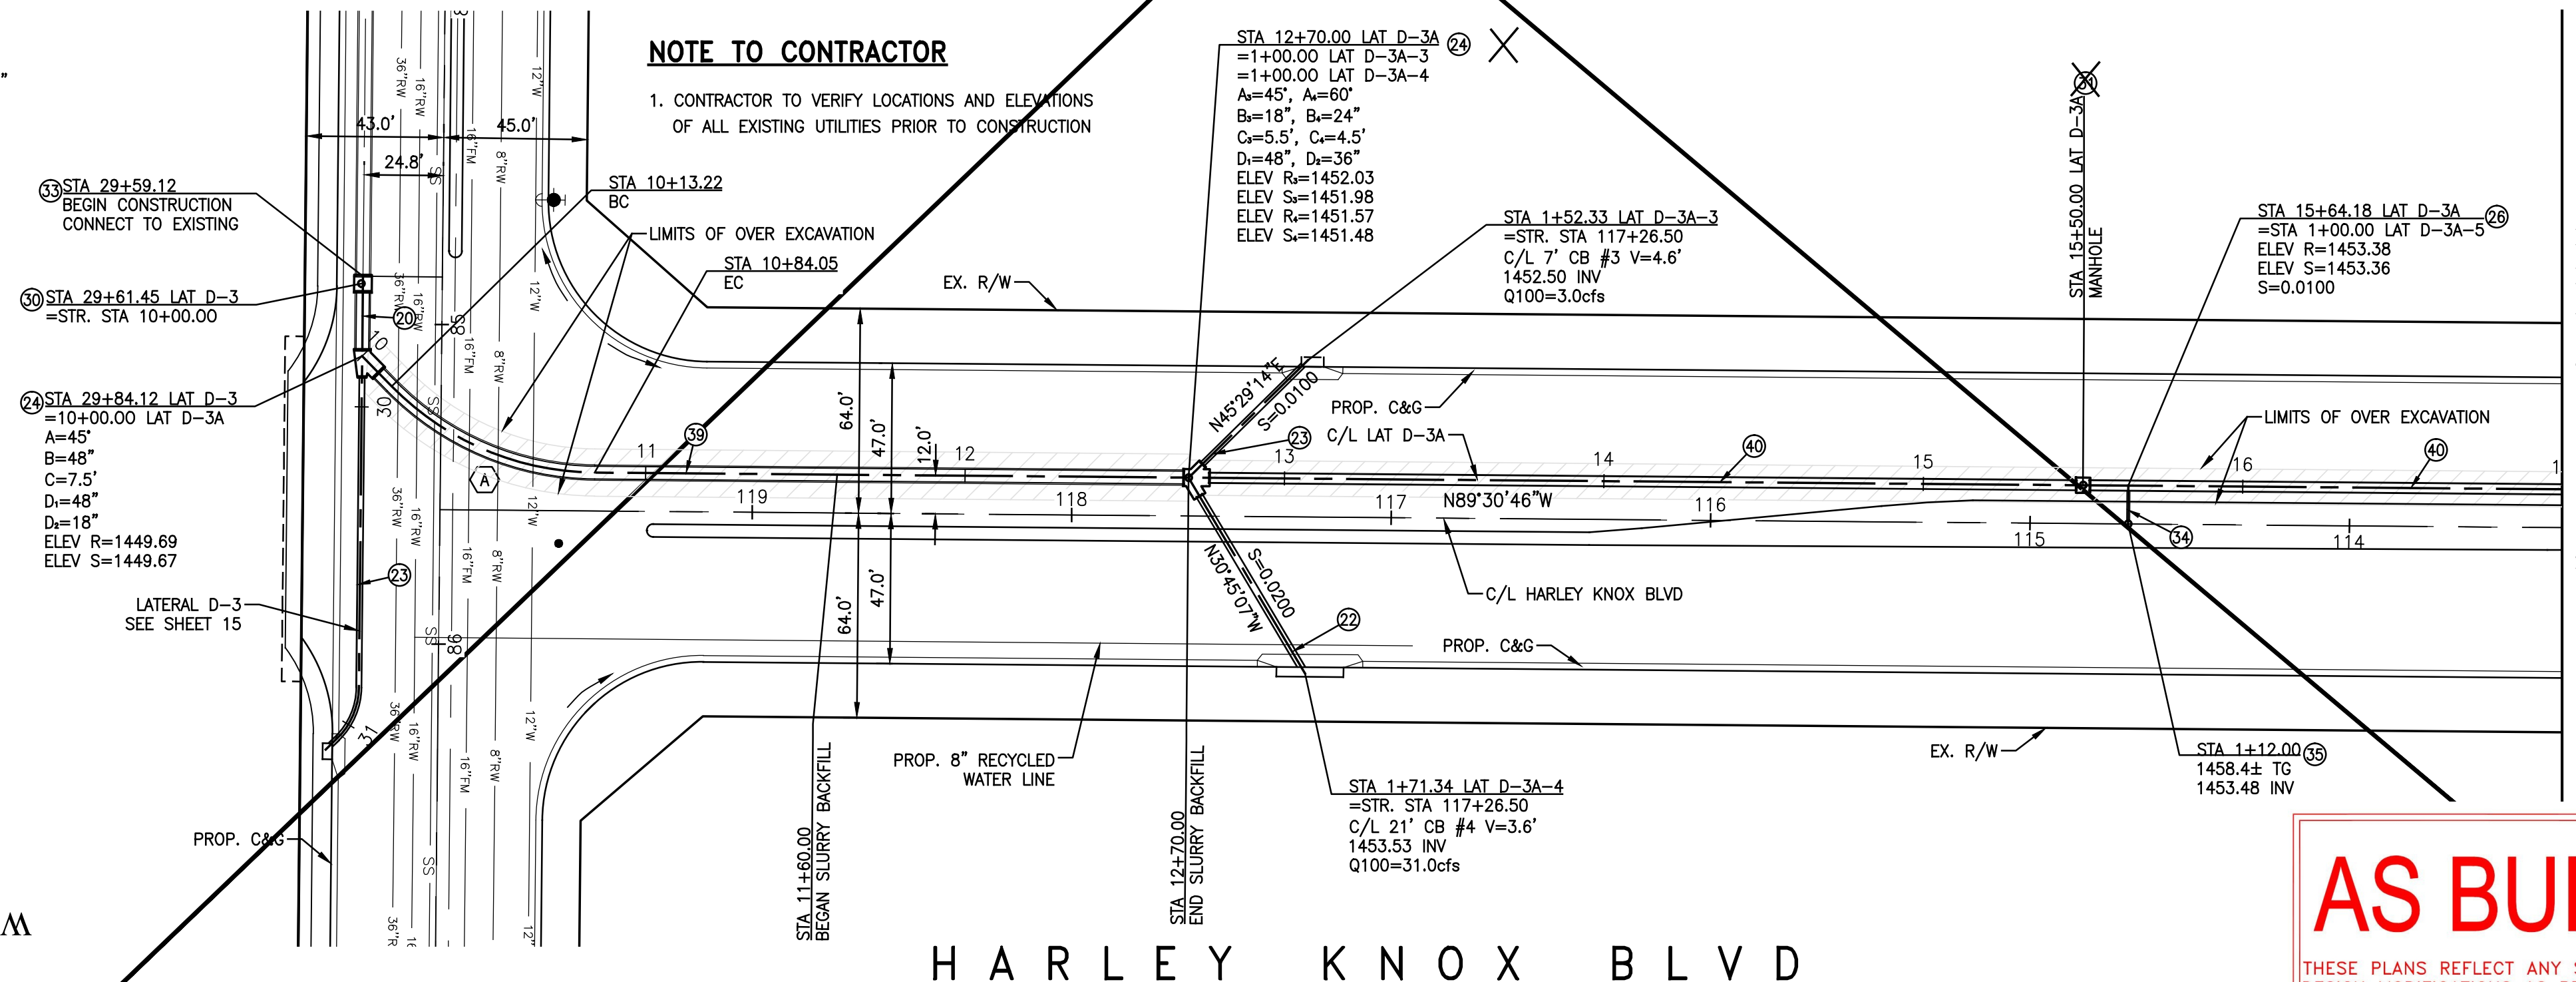

**CONSTRUCTION NOTES**

- 22 INSTALL 24" RCP (D-LOAD PER PLAN)
- 23 INSTALL 18" RCP (D-LOAD PER PLAN)
- 24 CONSTRUCT JUNCTION STRUCTURE NO. 2 PER RCF&WCD STD. JS227
- 25 CONSTRUCT JUNCTION STRUCTURE NO. 4 PER RCF&WCD STD JS2229
- 26 CONSTRUCT MANHOLE NO. 2 PER RCF&WCD STD. MH252
- 27 CONSTRUCT MANHOLE NO. 4 PER RCF&WCD STD. MH254
- 28 REMOVE CONCRETE BULKHEAD
- 29 INSTALL 12" DIA. HDPE N-12 STORM DRAIN PIPE ("ADS" OR APPROVED EQUAL)
- 30 INSTALL 18" DRAIN BASIN ("NYLOPLAST" OR EQUAL) WITH DOME GRATE
- 31 INSTALL 48" CIPCP PER MANUFACTURES SPECS
- 32 INSTALL 36" CIPCP PER MANUFACTURES SPECS
- 33 INSTALL 6" SLURRY BACKFILL (2 SACK)

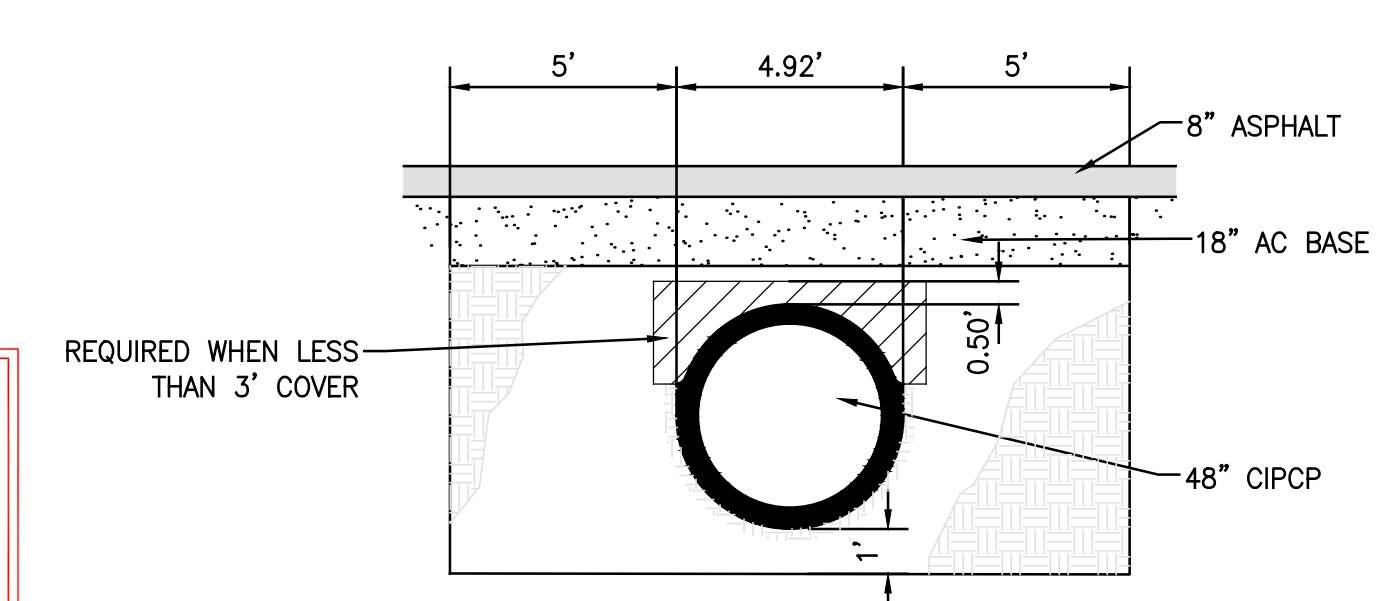

**CAST-IN-PLACE DETAIL**  
N.T.S.

**AS BUILT**

THESE PLANS REFLECT ANY SUBSTANTIAL DESIGN MODIFICATIONS AS PROVIDED TO WEBB ASSOCIATES BY THE CONTRACTOR

SIGNATURE: [Signature] DATE: 05/19/2016

REGISTERED PROFESSIONAL ENGINEER  
D.J. ARELLANO  
NO. 81988  
CIVIL  
STATE OF CALIFORNIA

**DIG ALERT**

DIAL BEFORE YOU DIG

TWO WORKING DAYS BEFORE YOU DIG

TOLL FREE 1-800-227-2600

A PUBLIC SERVICE BY UNDERGROUND SERVICE ALERT

**NOTE:**  
WORK CONTAINED WITHIN THESE PLANS SHALL NOT COMMENCE UNTIL AN ENCROACHMENT PERMIT AND/OR A GRADING PERMIT HAS BEEN ISSUED.

THE PRIVATE ENGINEER SIGNING THESE PLANS IS RESPONSIBLE FOR ASSURING THE ACCURACY AND ACCEPTABILITY OF THE DESIGN HEREON. IN THE EVENT OF DISCREPANCIES ARISING AFTER CITY APPROVAL OR DURING CONSTRUCTION, THE PRIVATE ENGINEER SHALL BE RESPONSIBLE FOR DETERMINING AN ACCEPTABLE SOLUTION AND REVISING THE PLANS FOR APPROVAL BY THE CITY.

MARK	BY	DATE	REVISIONS	APPR.	DATE
▲	DJM	5/17/16	RCP USED IN LIEU OF CIP SD PIPES		
▲	DJM	5/5/15	ADDED PROFILE FOR 18"x42" RCB		

CITY OF PERRIS  
APPROVED BY:

CITY ENGINEER

DATE

SEAL - ENGINEER

REGISTERED PROFESSIONAL ENGINEER  
D.J. ARELLANO  
NO. 81988  
CIVIL  
STATE OF CALIFORNIA

**ALBERT A. WEBB ASSOCIATES**

ENGINEERING CONSULTANTS  
3788 McCRAY STREET  
RIVERSIDE CA. 92506  
PH. (951) 686-1070  
FAX (951) 788-1256

UNDER THE SUPERVISION OF:

D.J. ARELLANO R.C.E. #C81988 DATE 1/12/2015

BENCHMARK:  
SEE SHEET 1

SCALE:  
H: AS SHOWN V: N/A

CITY OF PERRIS

AMENDED DPR NO. 11-12-0004

STORM DRAIN IMPROVEMENT PLANS

CIPCP - ALTERNATE BID ITEM LATERAL D-3A


STA 10+00-STA 17+00

FOR: W.O. 2013-0239 CITY FILE NO. P8-1189


SHEET NO. 19

OF 23 SHEETS

6:\2013\13-0239\DRAWINGS\DESIGN\13-0239-C-SD.DWG 5/19/2016 6:37 AM

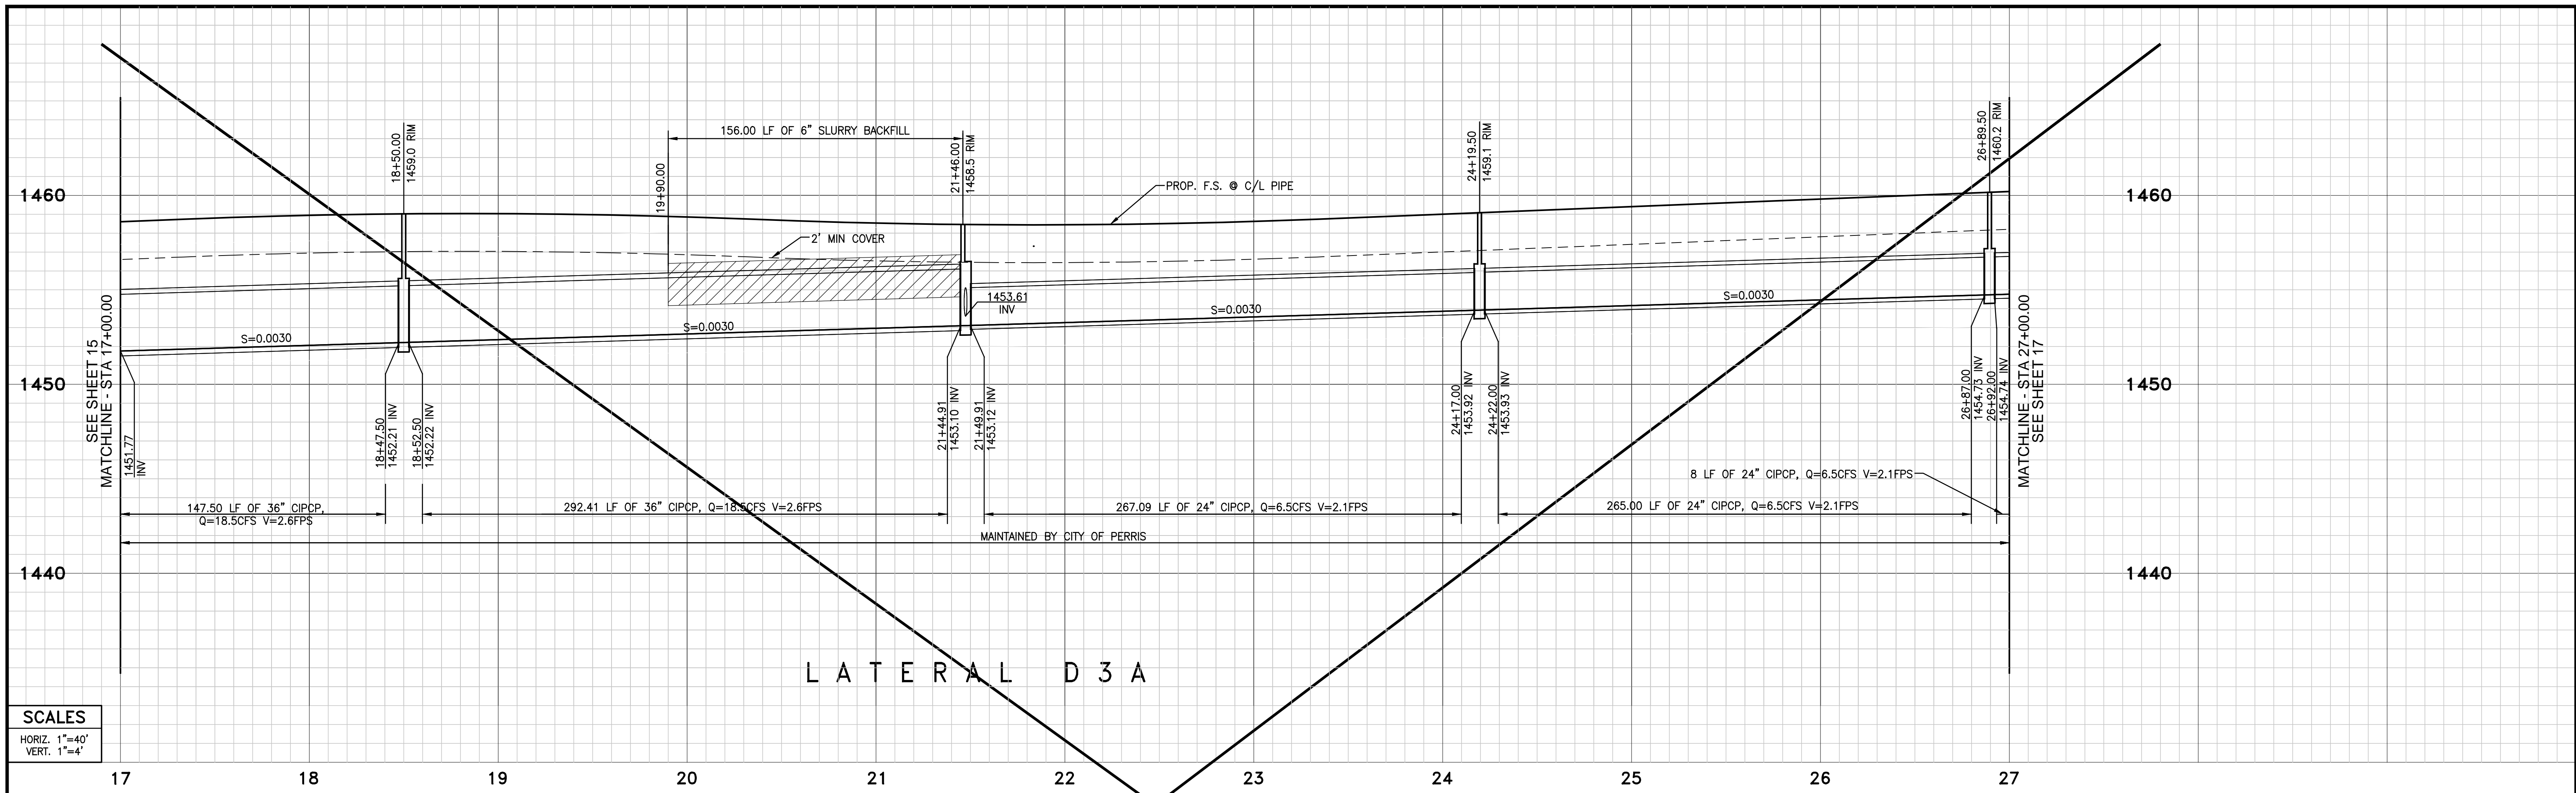


**SCALES**  
 HORIZ. 1"=40'  
 VERT. 1"=4'

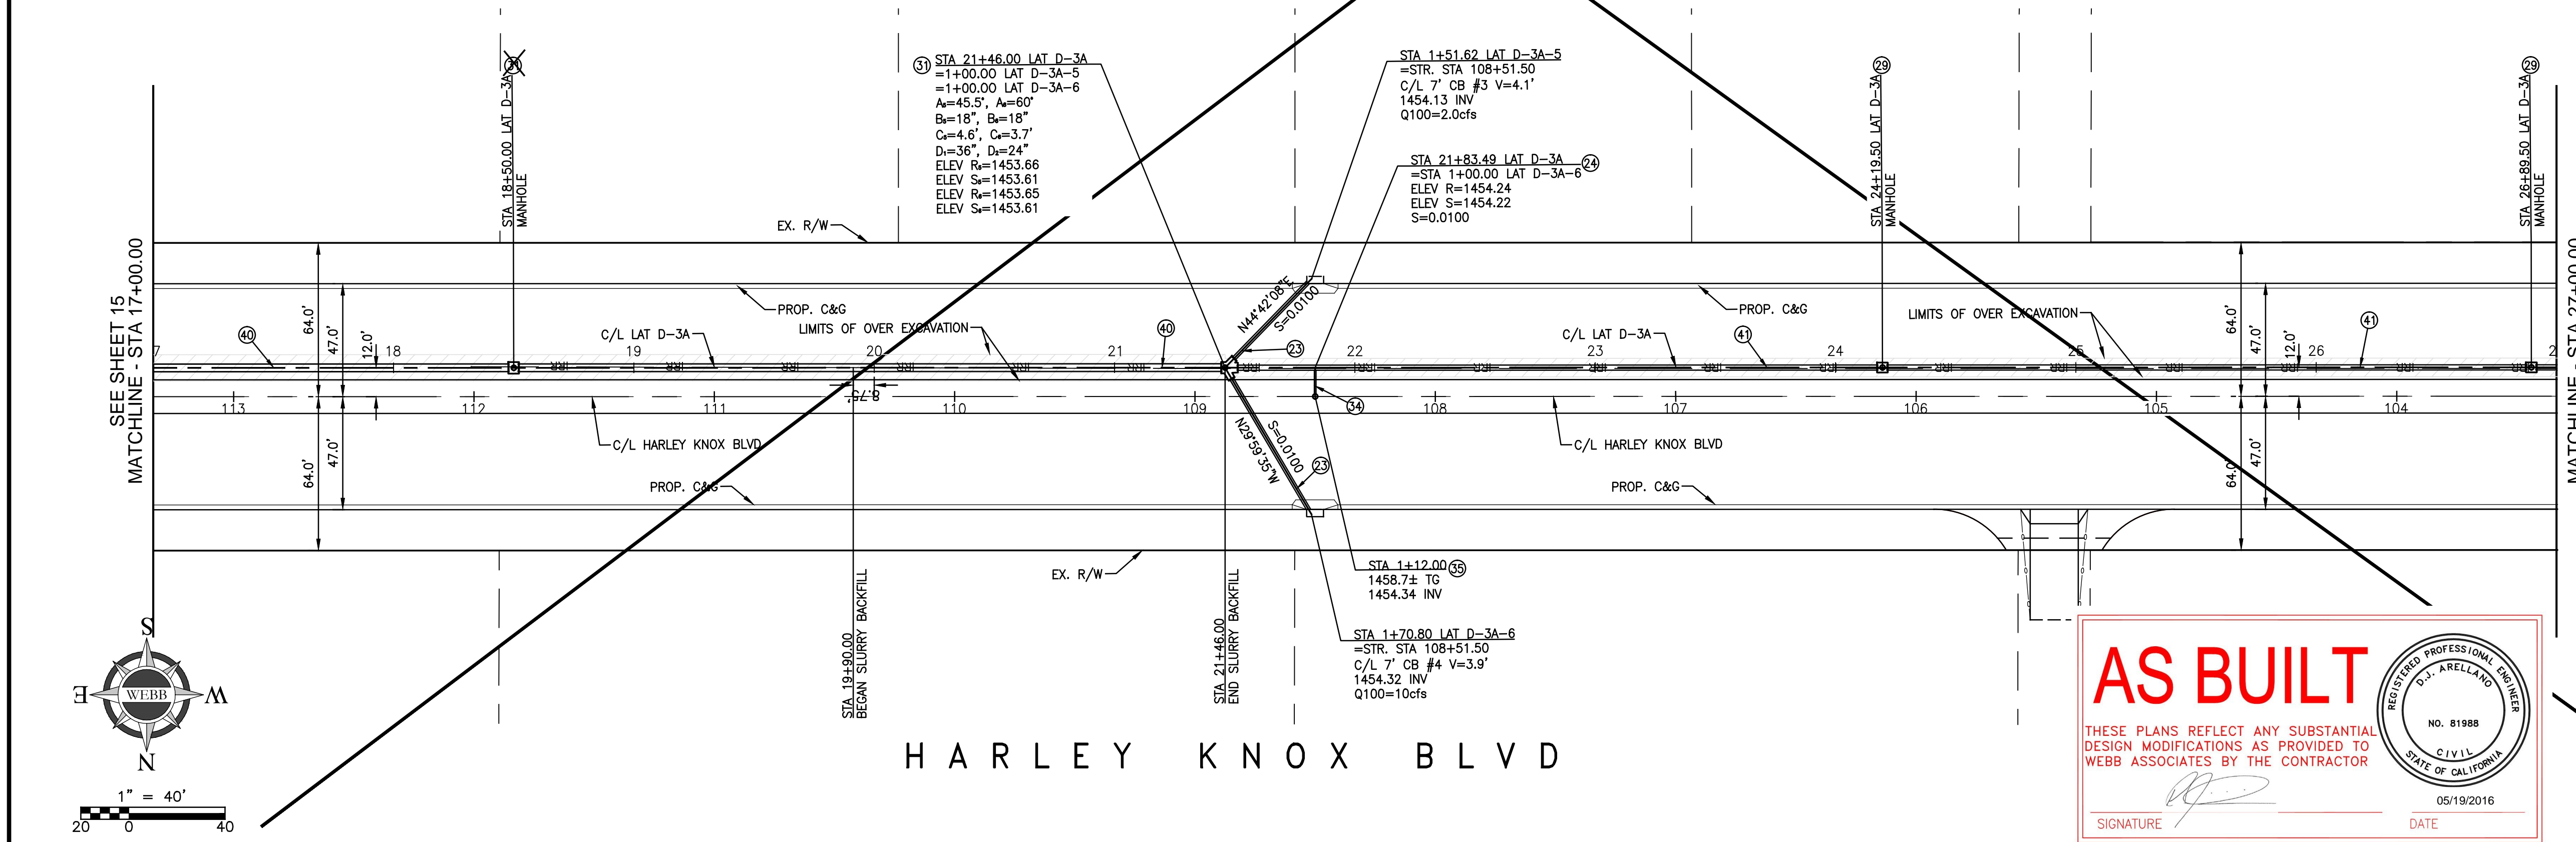

**CONSTRUCTION NOTES**

- ① INSTALL 36" RCP (D-LOAD PER PLAN)
- ② INSTALL 24" RCP (D-LOAD PER PLAN)
- ③ INSTALL 18" RCP (D-LOAD PER PLAN)
- ④ CONSTRUCT JUNCTION STRUCTURE NO 2 PER RCFC&WCD STD. JS227
- ⑤ CONSTRUCT MANHOLE NO. 1 PER RCFC&WCD STD. MH251
- ⑥ CONSTRUCT MANHOLE NO. 4 PER RCFC&WCD STD. MH254
- ⑦ INSTALL 12" DIA. HDPE N-12 STORM DRAIN PIPE ("ADS" OR APPROVED EQUAL)
- ⑧ INSTALL 18" DRAIN BASIN ("NYLOPLAST" OR EQUAL) WITH DOME GRATE
- ⑨ INSTALL 48" CIPCP PER MANUFACTURES SPECS
- ⑩ INSTALL 36" CIPCP PER MANUFACTURES SPECS
- ⑪ INSTALL 24" CIPCP PER MANUFACTURES SPECS
- ⑫ INSTALL 6" SLURRY BACKFILL (2 SACK)

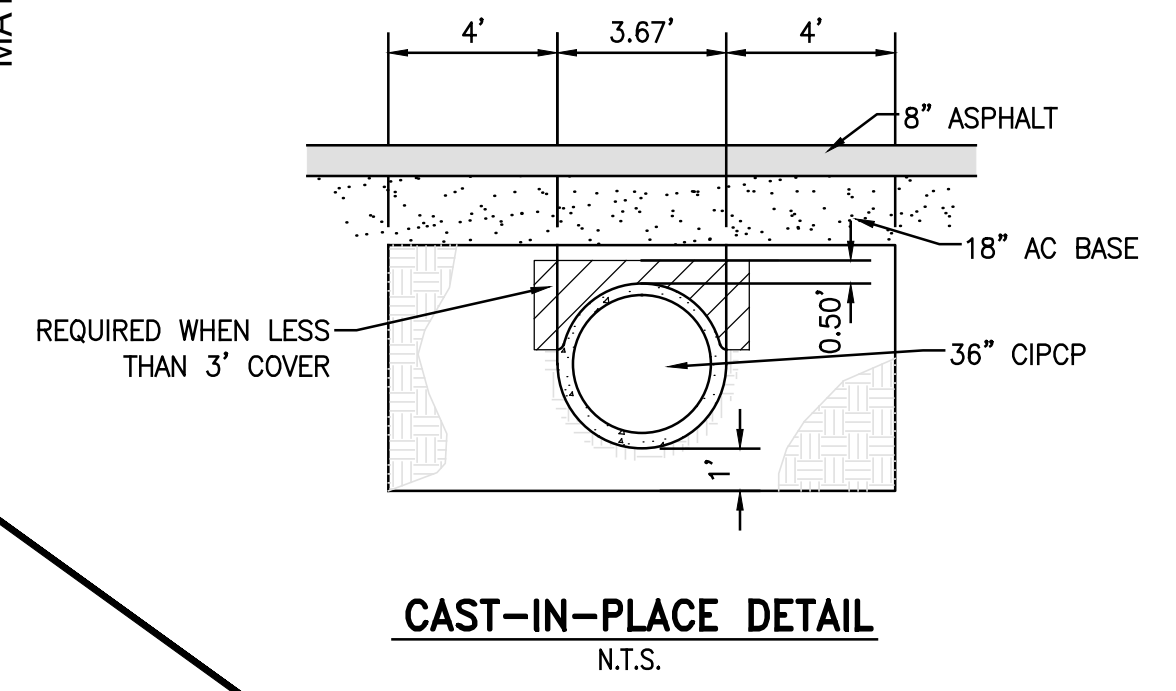

**AS BUILT**

THESE PLANS REFLECT ANY SUBSTANTIAL DESIGN MODIFICATIONS AS PROVIDED TO WEBB ASSOCIATES BY THE CONTRACTOR

SIGNATURE: *[Signature]* DATE: 05/19/2016

REGISTERED PROFESSIONAL ENGINEER  
 D.J. ARELLANO  
 NO. 81988  
 CIVIL  
 STATE OF CALIFORNIA

**DIG ALERT**

CALL BEFORE YOU DIG

TWO WORKING DAYS BEFORE YOU DIG

TOLL FREE 1-800-227-2600

A PUBLIC SERVICE BY UNDERGROUND SERVICE ALERT

**NOTE:**  
 WORK CONTAINED WITHIN THESE PLANS SHALL COMMENCE UNTIL AN ENCROACHMENT PERMIT AND/OR A GRADING PERMIT HAS BEEN ISSUED.

THE PRIVATE ENGINEER SIGNING THESE PLANS IS RESPONSIBLE FOR ASSURING THE ACCURACY AND ACCEPTABILITY OF THE DESIGN HEREON. IN THE EVENT OF DISCREPANCIES ARISING AFTER CITY APPROVAL OR DURING CONSTRUCTION, THE PRIVATE ENGINEER SHALL BE RESPONSIBLE FOR DETERMINING AN ACCEPTABLE SOLUTION AND REVISING THE PLANS FOR APPROVAL BY THE CITY.

MARK	BY	DATE	REVISIONS	APPR.	DATE
Δ	DJM	5/17/16	RCP USED IN LIEU OF CIP SD PIPES		

CITY OF PERRIS  
 APPROVED BY: \_\_\_\_\_  
 CITY ENGINEER

SEAL - ENGINEER

REGISTERED PROFESSIONAL ENGINEER  
 D.J. ARELLANO  
 NO. 81988  
 CIVIL  
 STATE OF CALIFORNIA

**ALBERT A. WEBB ASSOCIATES**

ENGINEERING CONSULTANTS  
 3788 McCRAY STREET  
 RIVERSIDE, CA. 92506  
 PH. (951) 686-1070  
 FAX (951) 788-1256

UNDER THE SUPERVISION OF:  
 D.J. ARELLANO R.C.E. #C81988 DATE 1/12/2015


BENCHMARK:  
 SEE SHEET 1

SCALE:  
 H: AS SHOWN V: N/A



CITY OF PERRIS  
 AMENDED DPR NO. 11-12-0004  
 STORM DRAIN IMPROVEMENT PLANS  
 CIPCP - ALTERNATE BID ITEM LATERAL D-3A  
 STA 17+00-STA 27+00

FOR: \_\_\_\_\_ W.O. 2013-0239 CITY FILE NO. \_\_\_\_\_

SHEET NO. **20**  
 OF 23 SHEETS  
 P8-1189

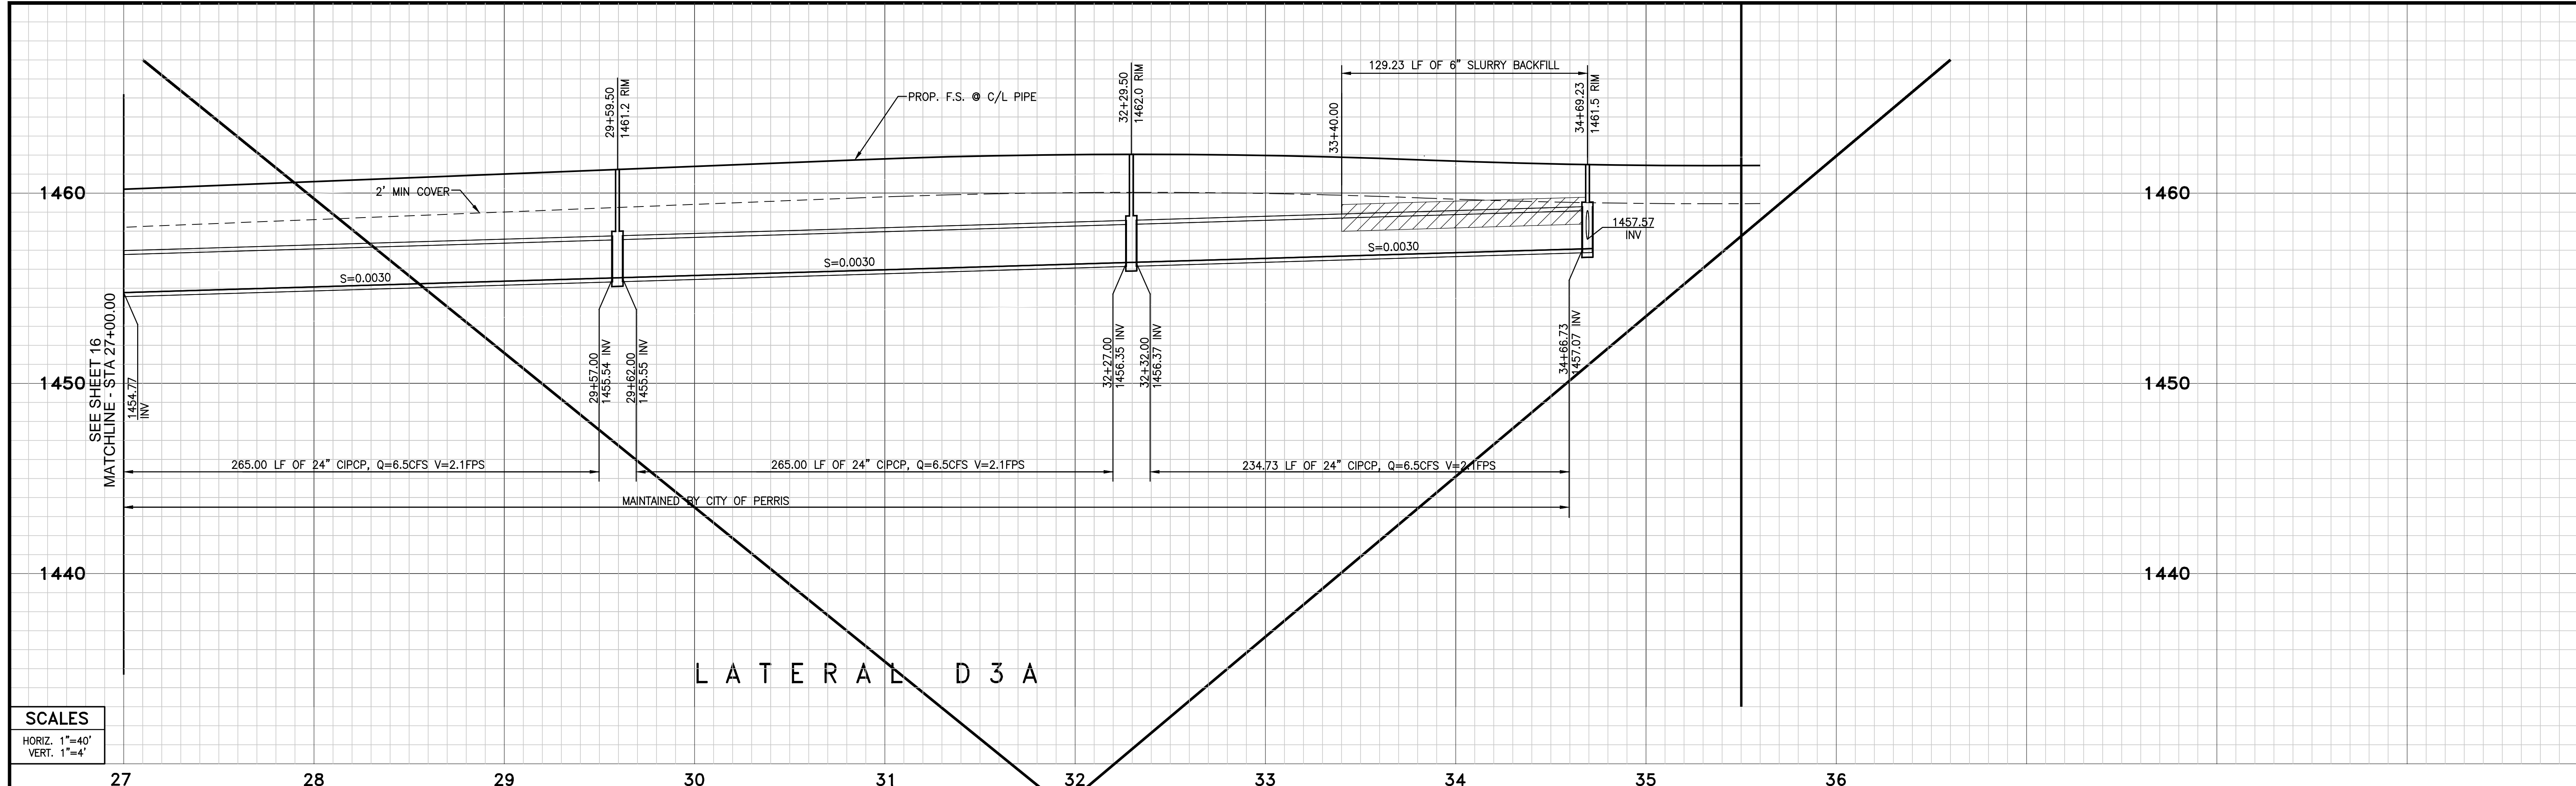


**SCALES**  
 HORIZ. 1"=40'  
 VERT. 1"=4'

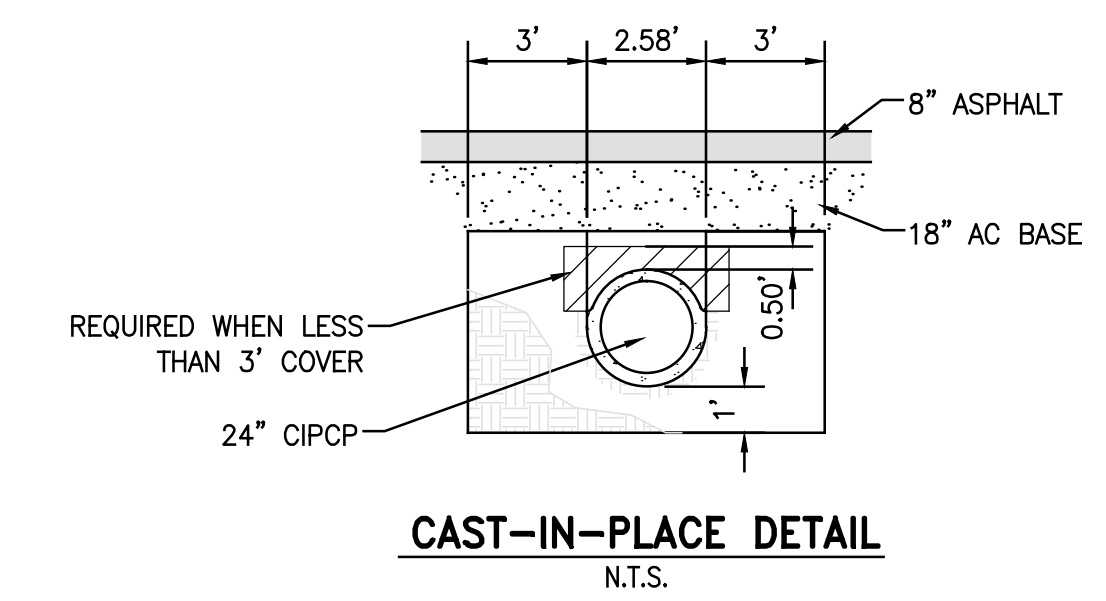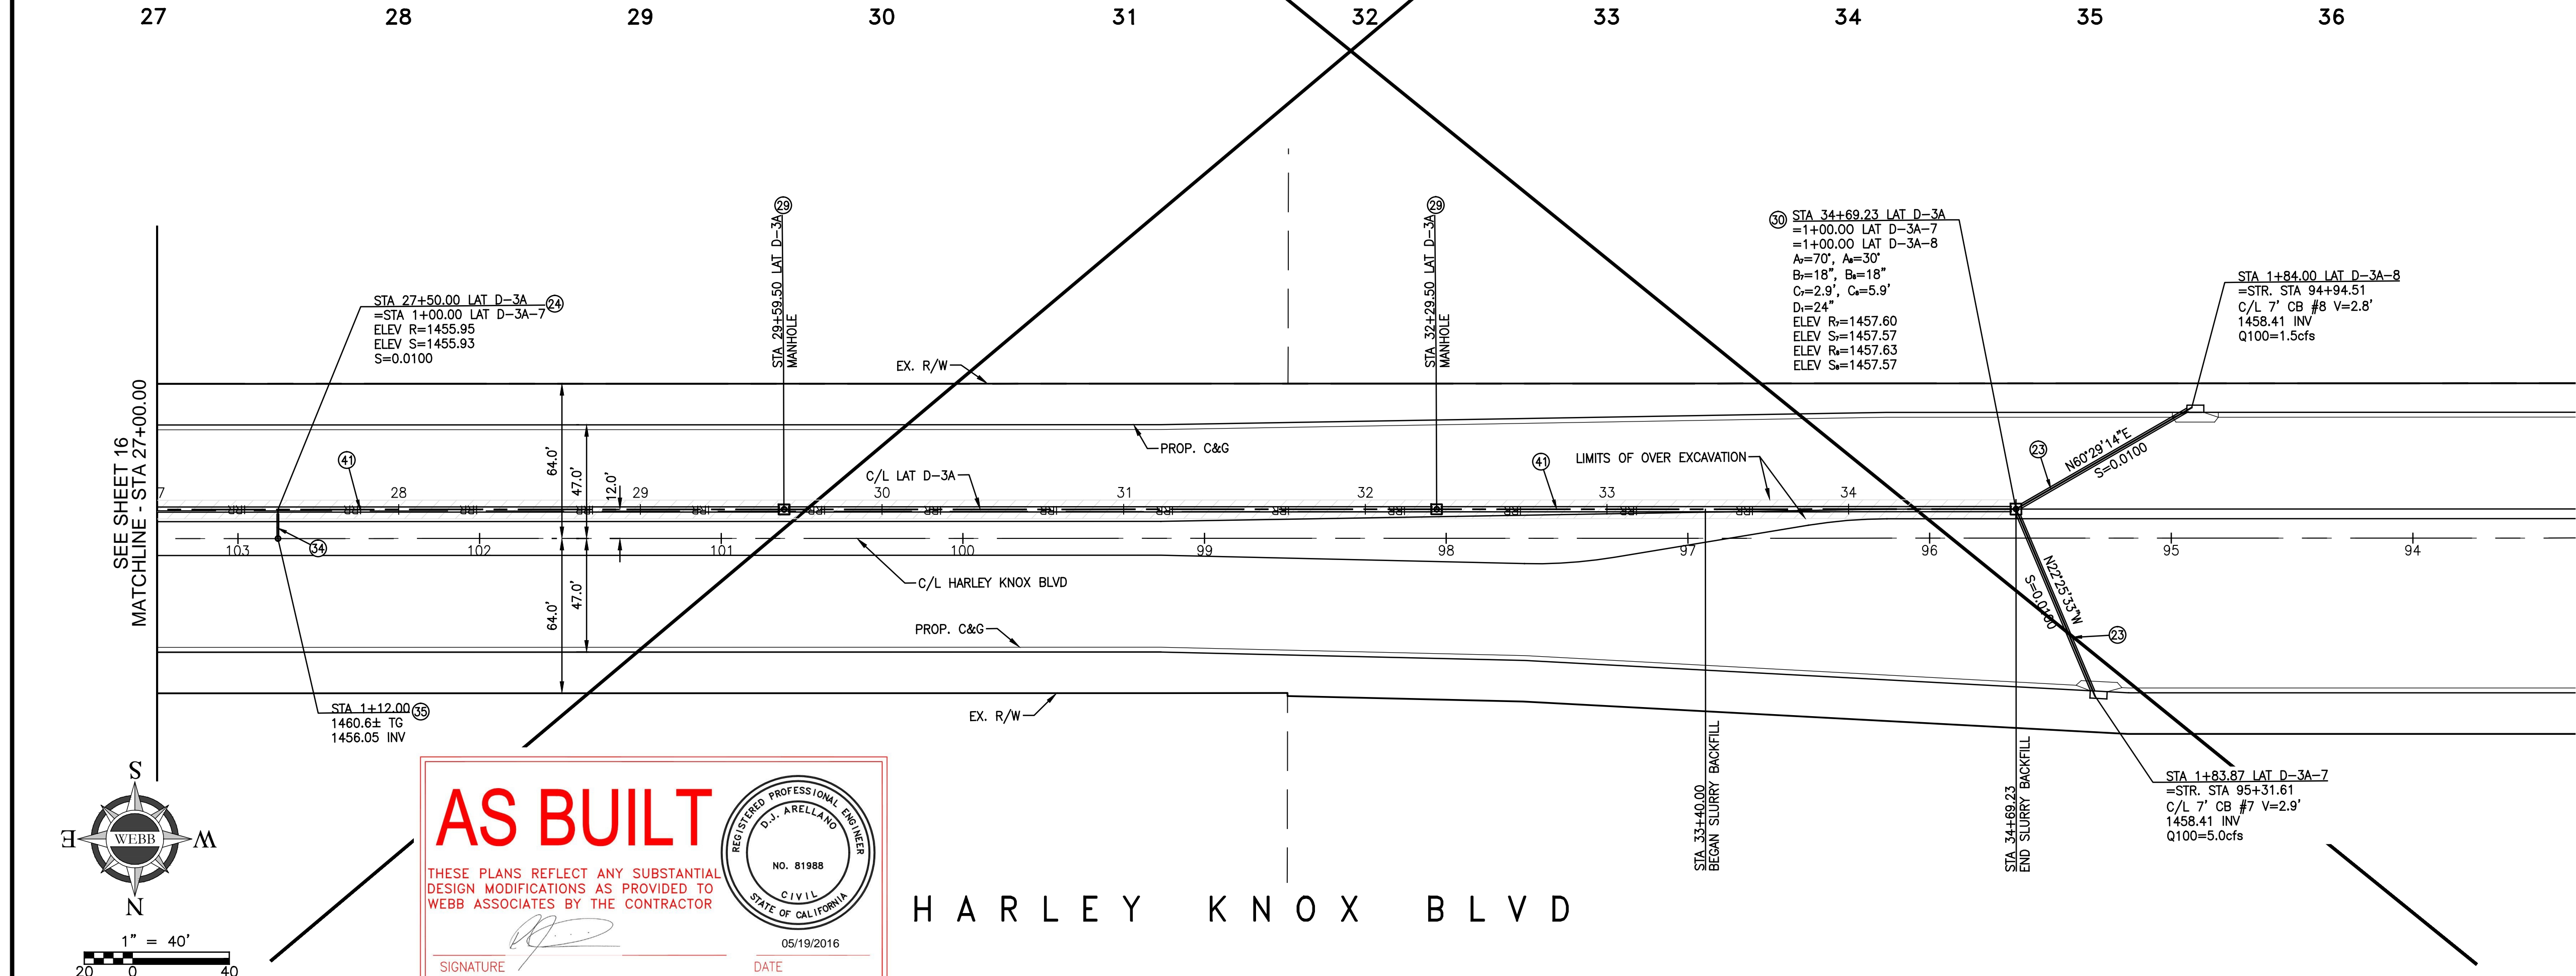

**AS BUILT**  
 THESE PLANS REFLECT ANY SUBSTANTIAL DESIGN MODIFICATIONS AS PROVIDED TO WEBB ASSOCIATES BY THE CONTRACTOR

SIGNATURE: [Signature]  
 DATE: 05/19/2016

HARLEY KNOX BLVD

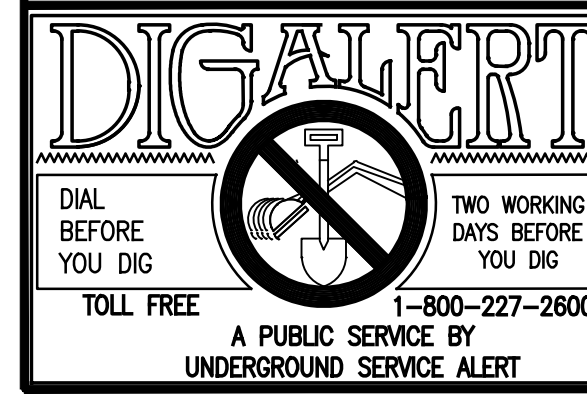

**NOTE:**  
 WORK CONTAINED WITHIN THESE PLANS SHALL COMMENCE UNTIL AN ENCROACHMENT PERMIT AND/OR A GRADING PERMIT HAS BEEN ISSUED.

THE PRIVATE ENGINEER SIGNING THESE PLANS IS RESPONSIBLE FOR ASSURING THE ACCURACY AND ACCEPTABILITY OF THE DESIGN HEREON. IN THE EVENT OF DISCREPANCIES ARISING AFTER CITY APPROVAL OR DURING CONSTRUCTION, THE PRIVATE ENGINEER SHALL BE RESPONSIBLE FOR DETERMINING AN ACCEPTABLE SOLUTION AND REVISING THE PLANS FOR APPROVAL BY THE CITY.

MARK	BY	DATE	REVISIONS	APPR.	DATE
Δ	DJM	5/17/16	RCP USED IN LIEU OF CIP SD PIPES		

CITY OF PERRIS  
 APPROVED BY:

CITY ENGINEER

DATE

SEAL - ENGINEER

D.J. ARELLANO  
 NO. 81988  
 CIVIL  
 STATE OF CALIFORNIA

ALBERT A. WEBB ASSOCIATES  
 ENGINEERING CONSULTANTS  
 3788 McCRAV STREET  
 RIVERSIDE CA. 92506  
 PH. (951) 686-1070  
 FAX (951) 788-1256

UNDER THE SUPERVISION OF:

D.J. ARELLANO R.C.E. #C81988 DATE 1/12/2015

BENCHMARK:  
 SEE SHEET 1


SCALE:  
 H: AS SHOWN V: N/A

CITY OF PERRIS  
 AMENDED DPR NO. 11-12-0004  
 STORM DRAIN IMPROVEMENT PLANS  
 CIPCP - ALTERNATE BID ITEM LATERAL D-3A  
 STA 27+00-STA 34+69.23

FOR: W.O. 2013-0239 CITY FILE NO. P8-1189

SHEET NO. 21 OF 23 SHEETS

6:\2013\13-0239\DRAWINGS\DESIGN\13-0239-C-SD.DWG 5/19/2016 6:37 AM












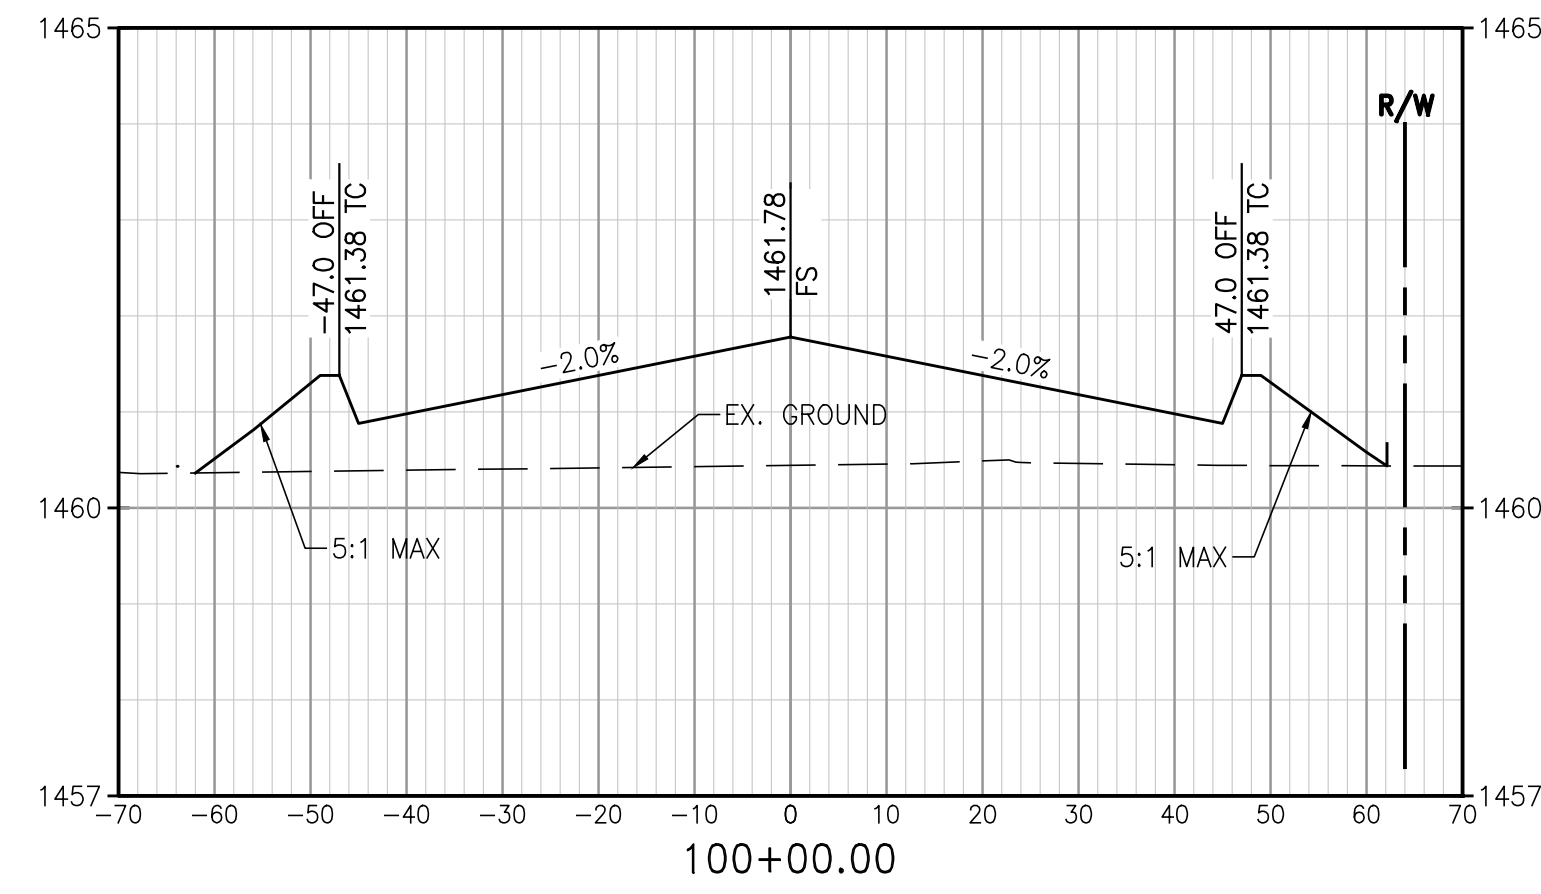


**AS BUILT**

THESE PLANS REFLECT ANY SUBSTANTIAL DESIGN MODIFICATIONS AS PROVIDED TO WEBB ASSOCIATES BY THE CONTRACTOR


REGISTERED PROFESSIONAL ENGINEER  
D.J. ARELLANO  
NO. 81988  
CIVIL  
STATE OF CALIFORNIA

SIGNATURE: *[Signature]* DATE: 05/19/2016

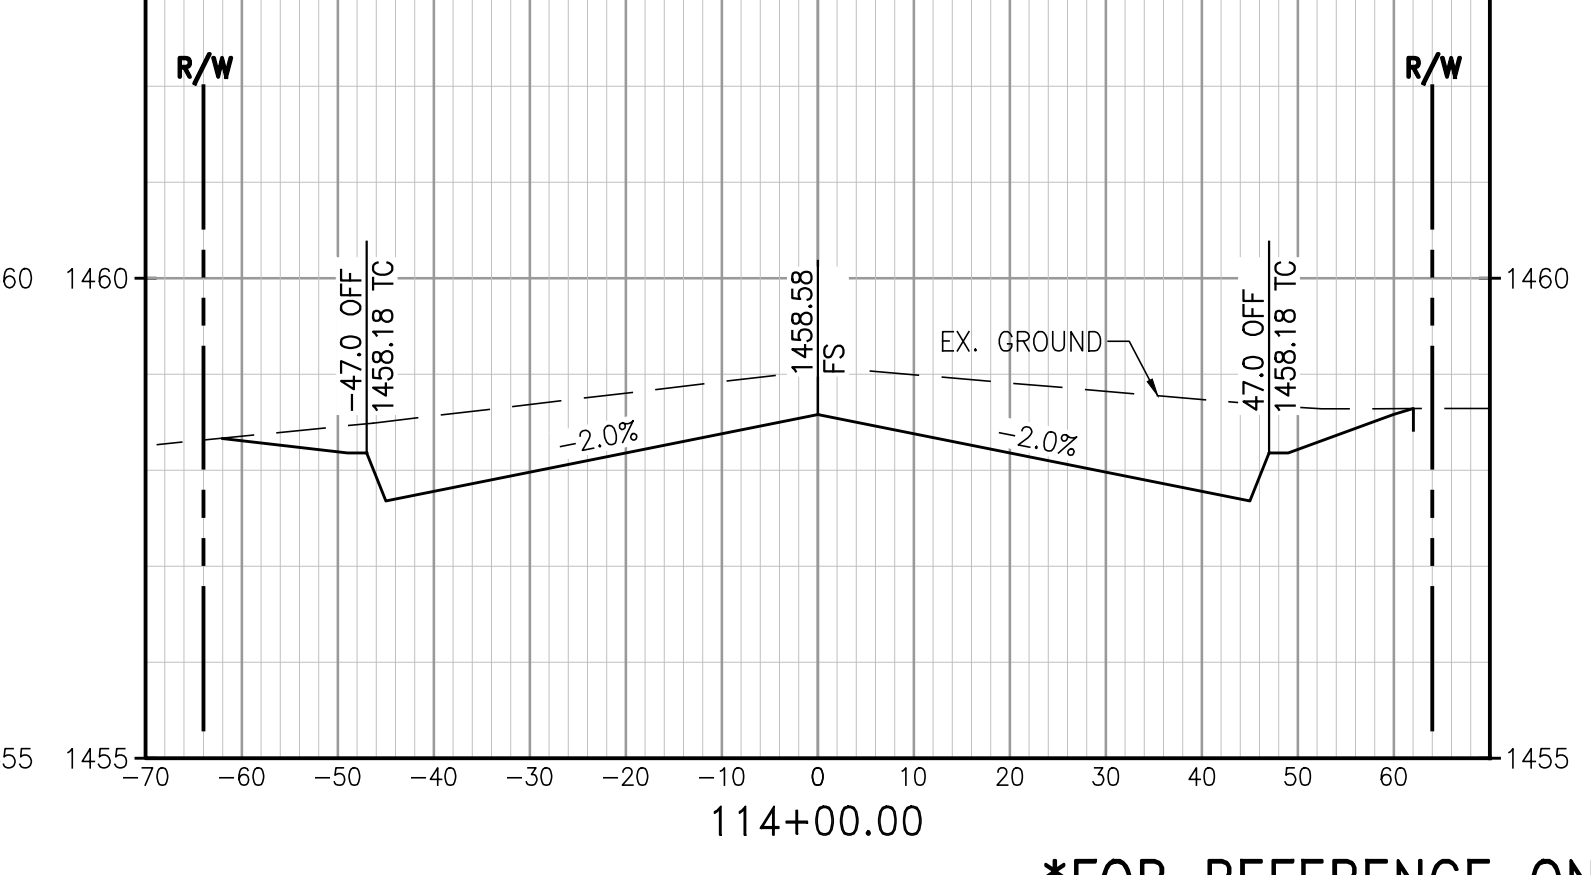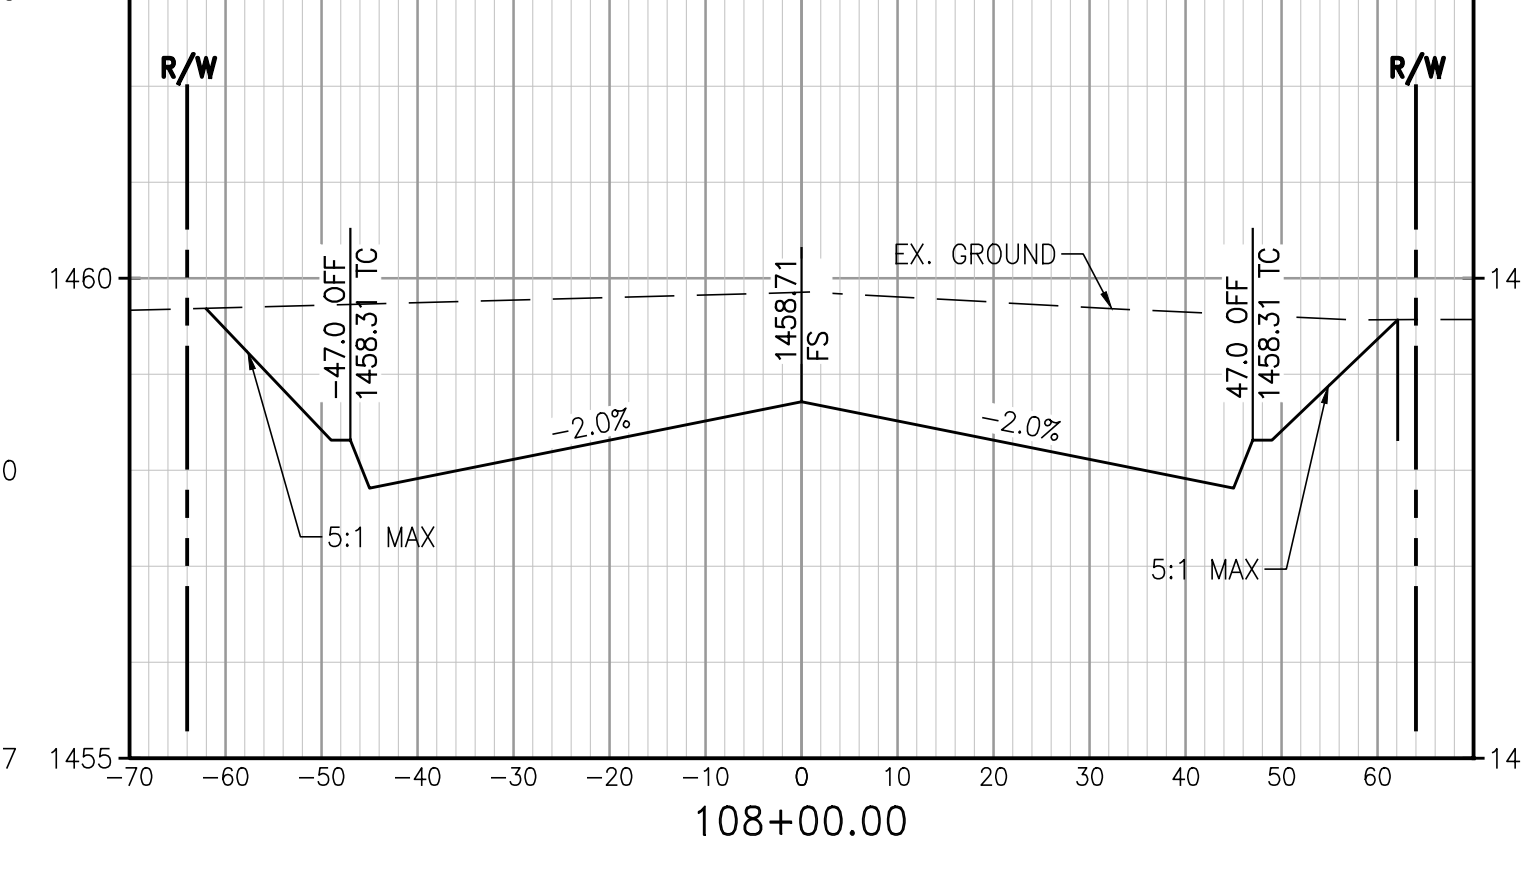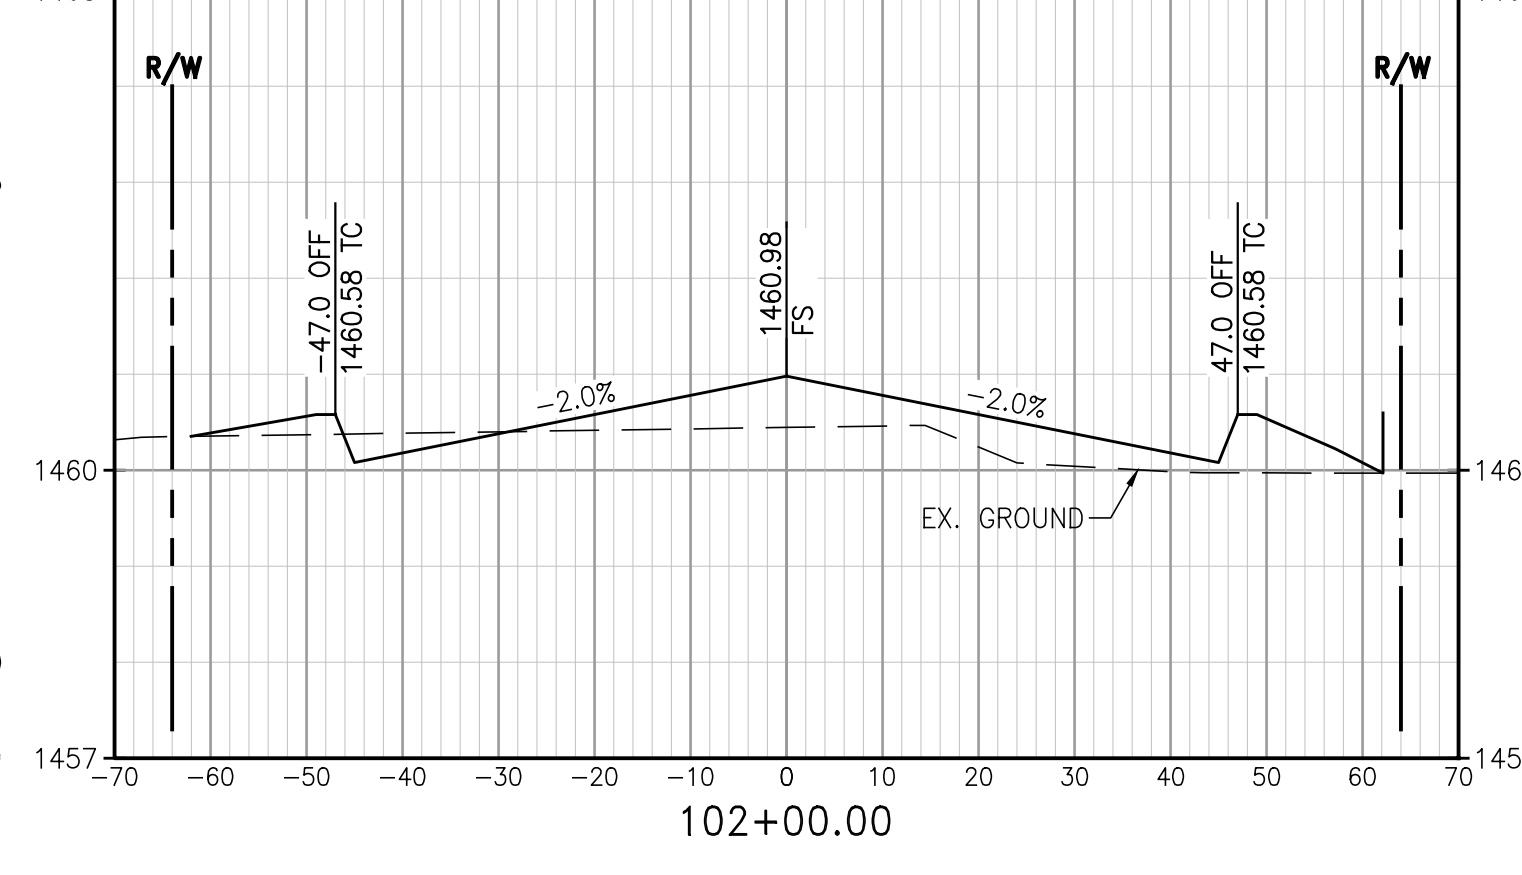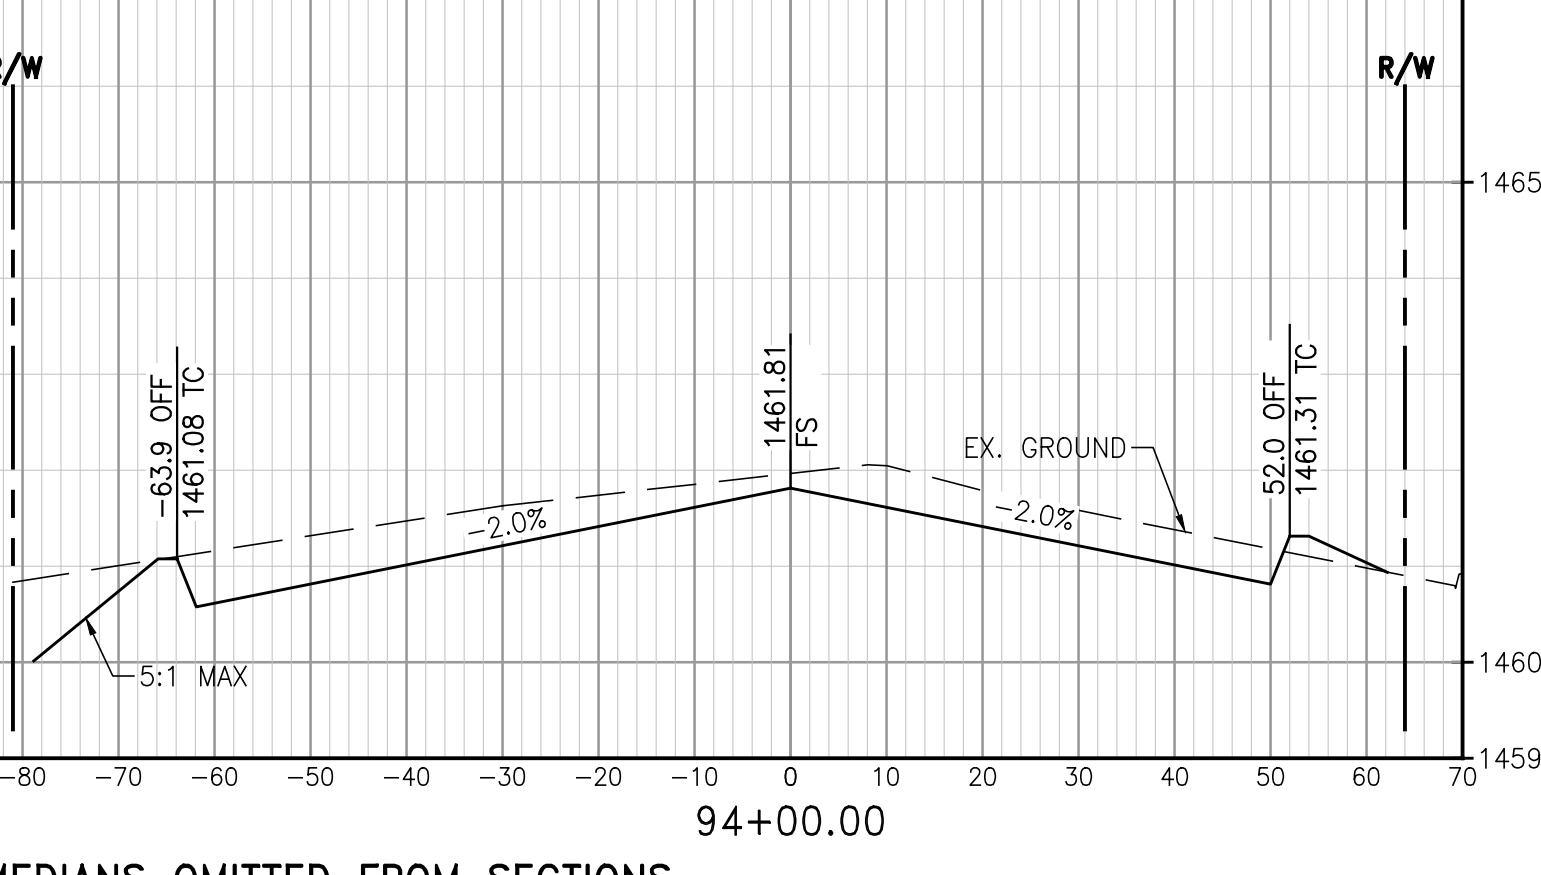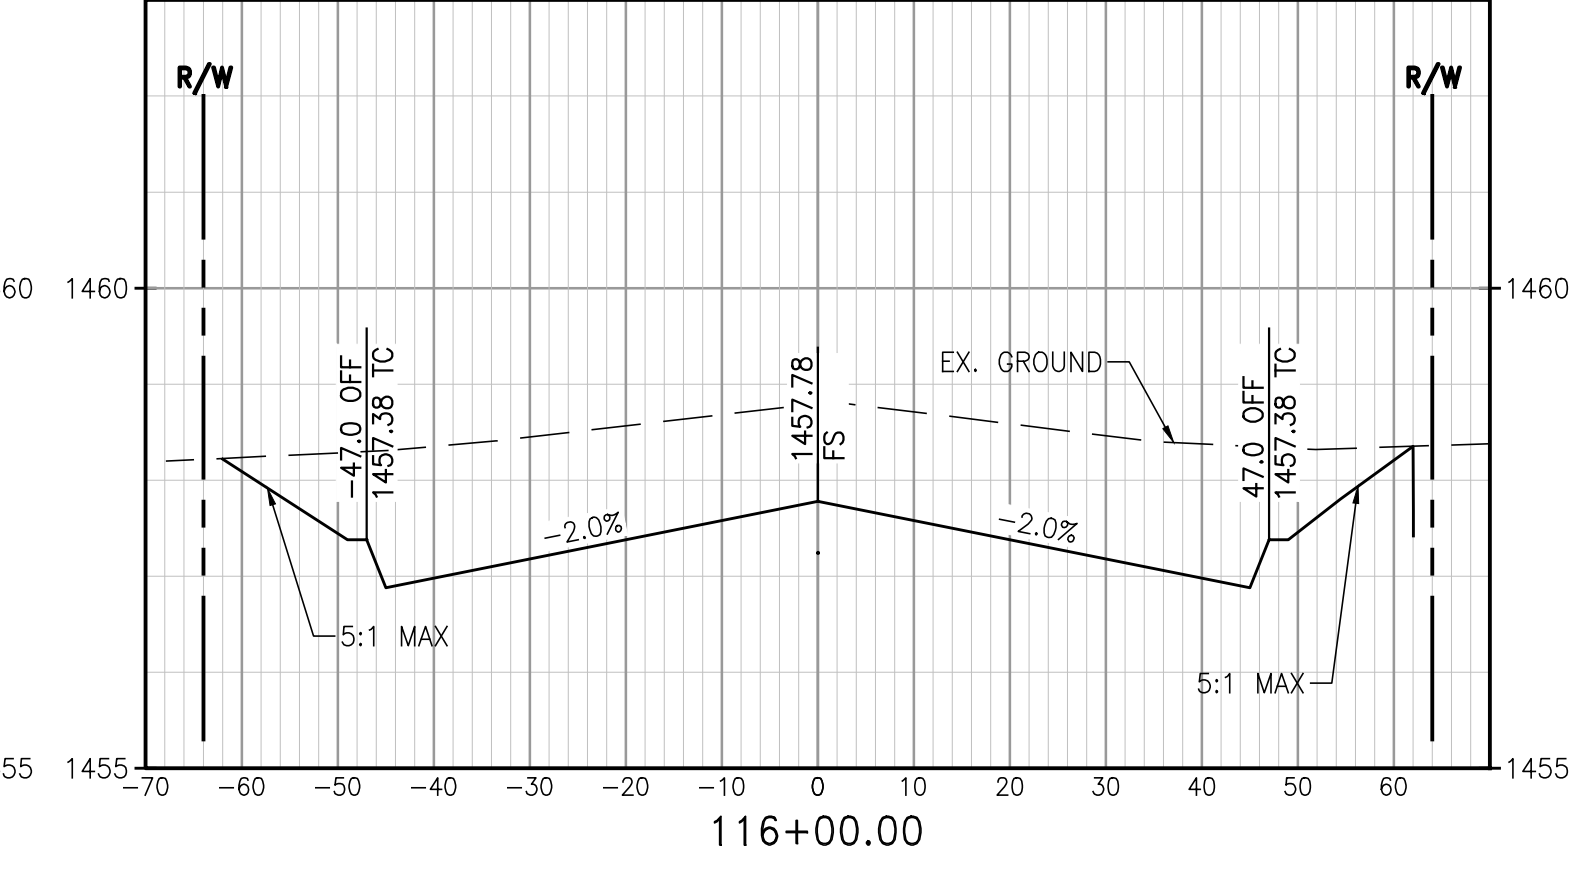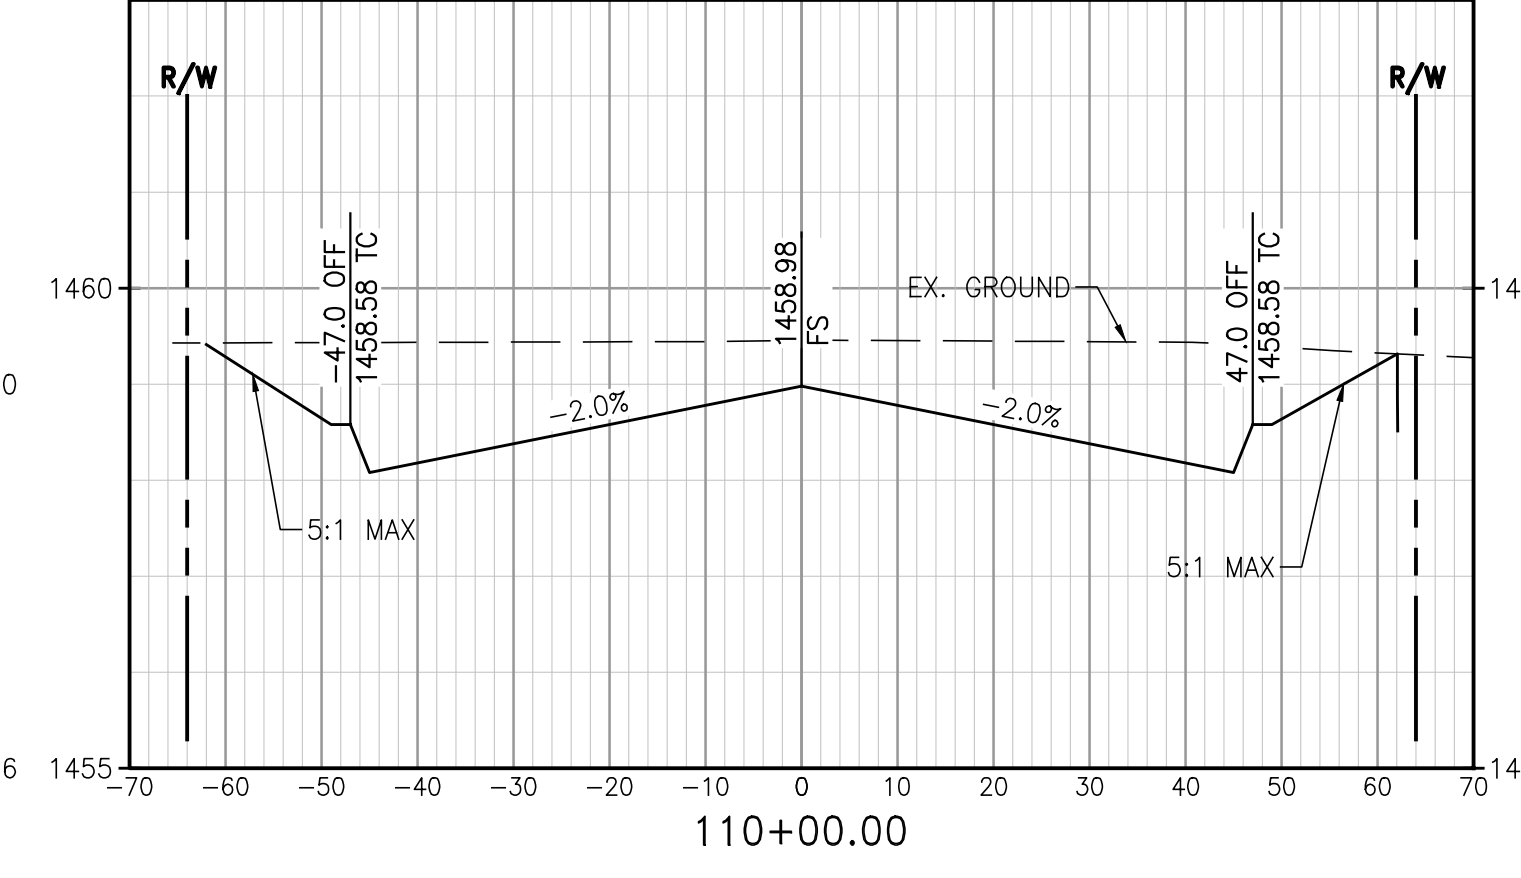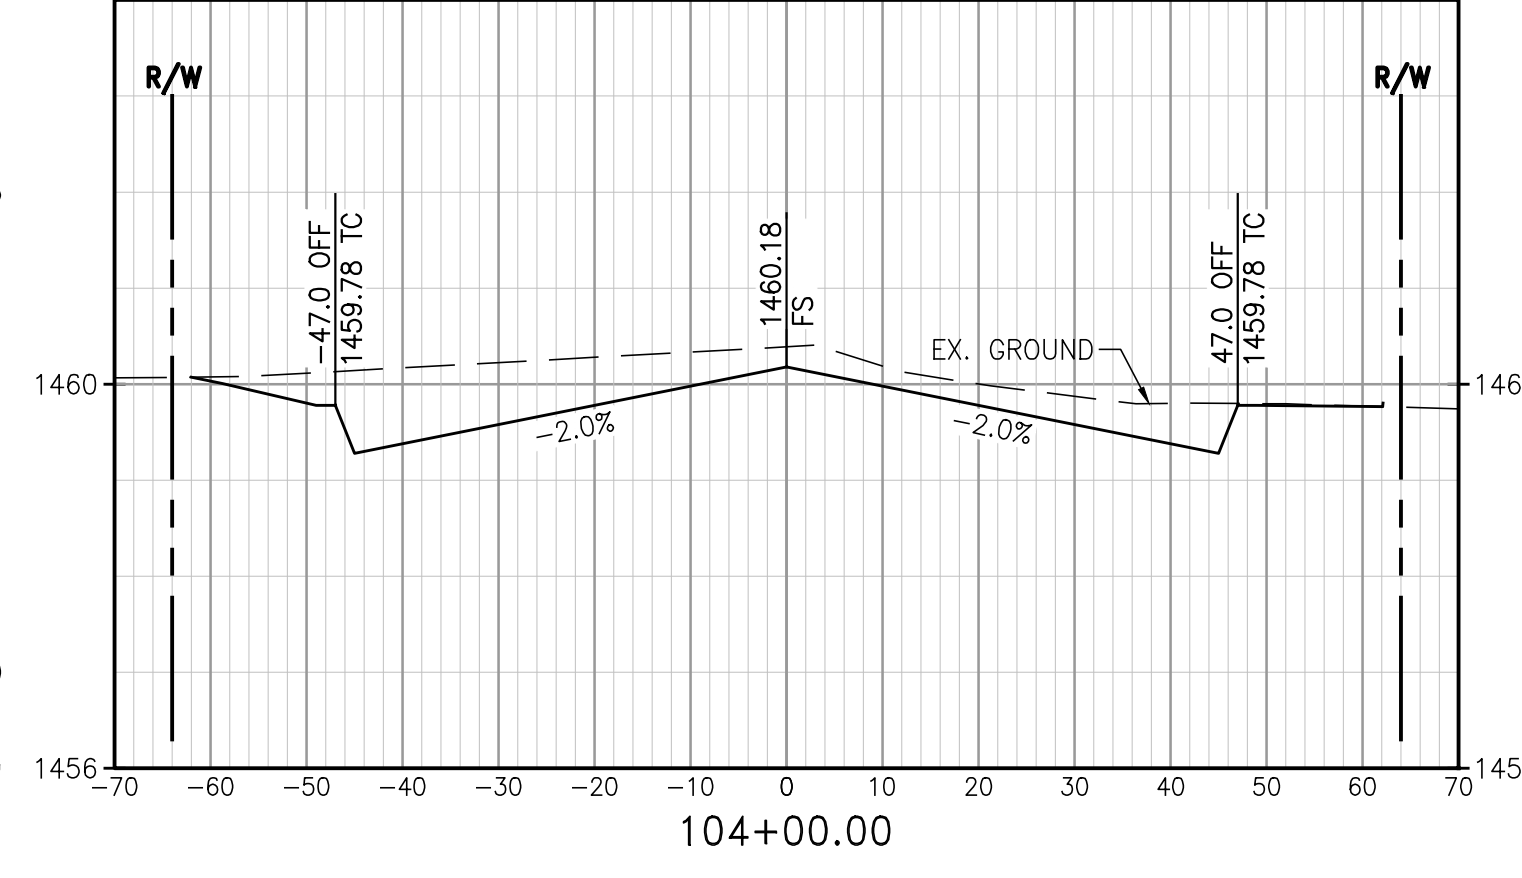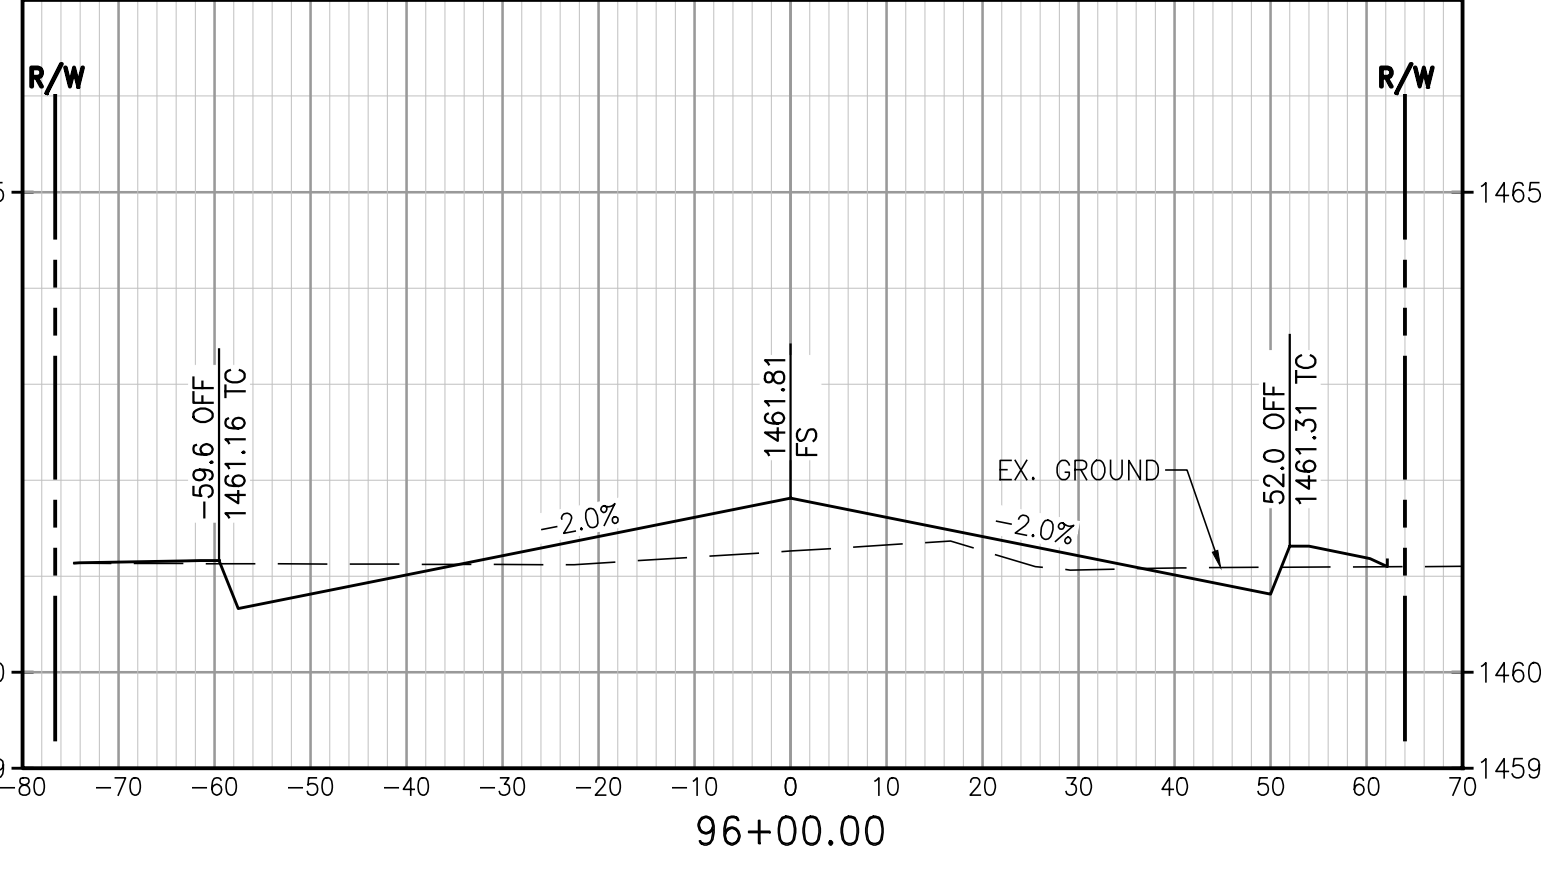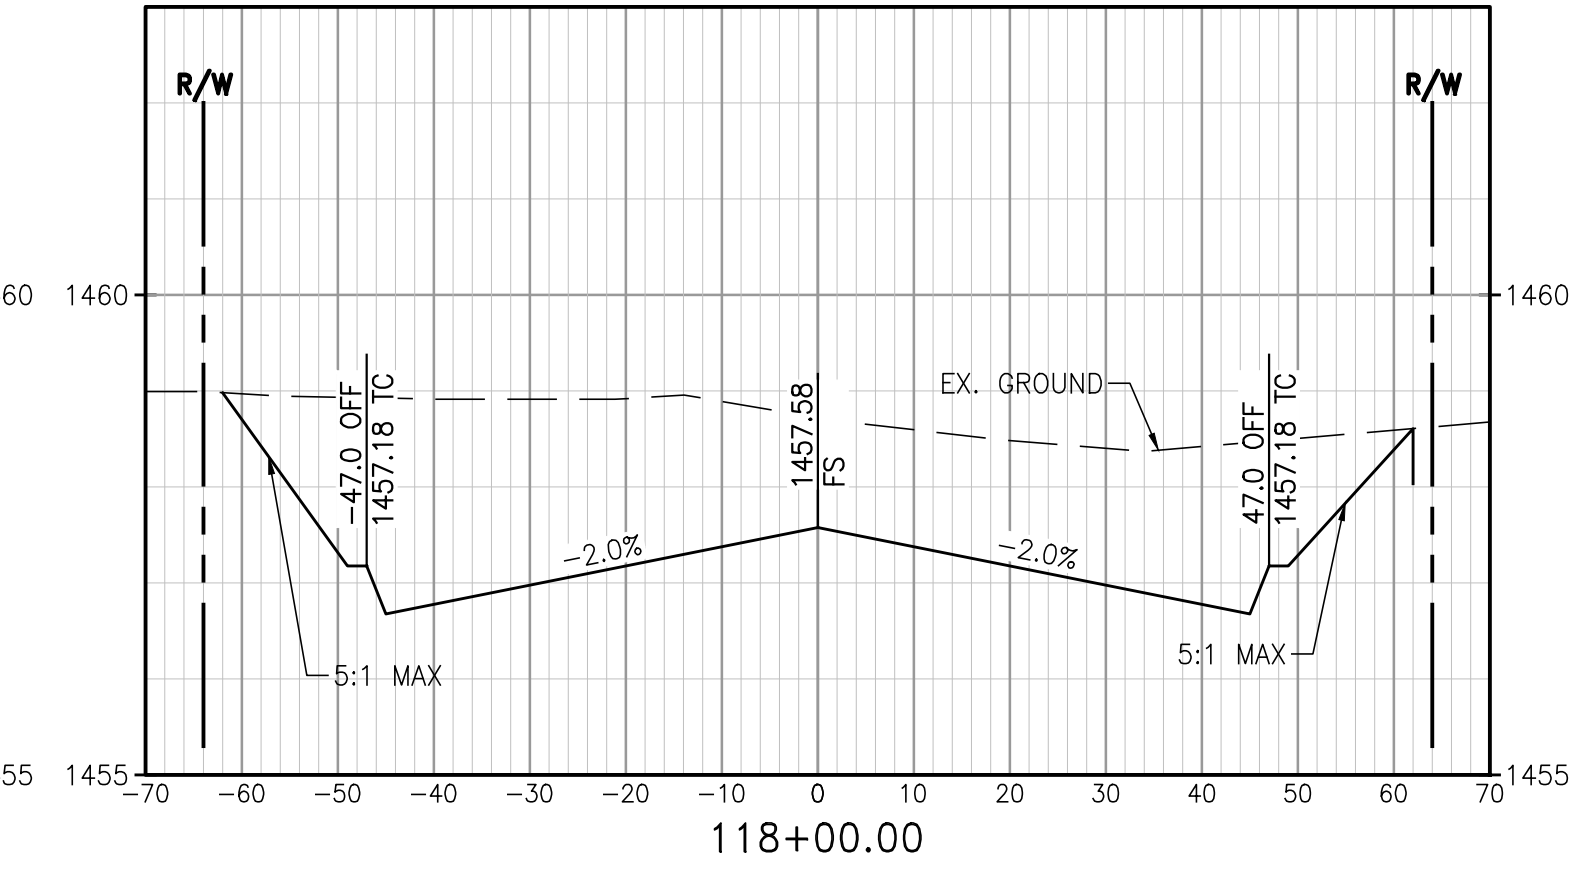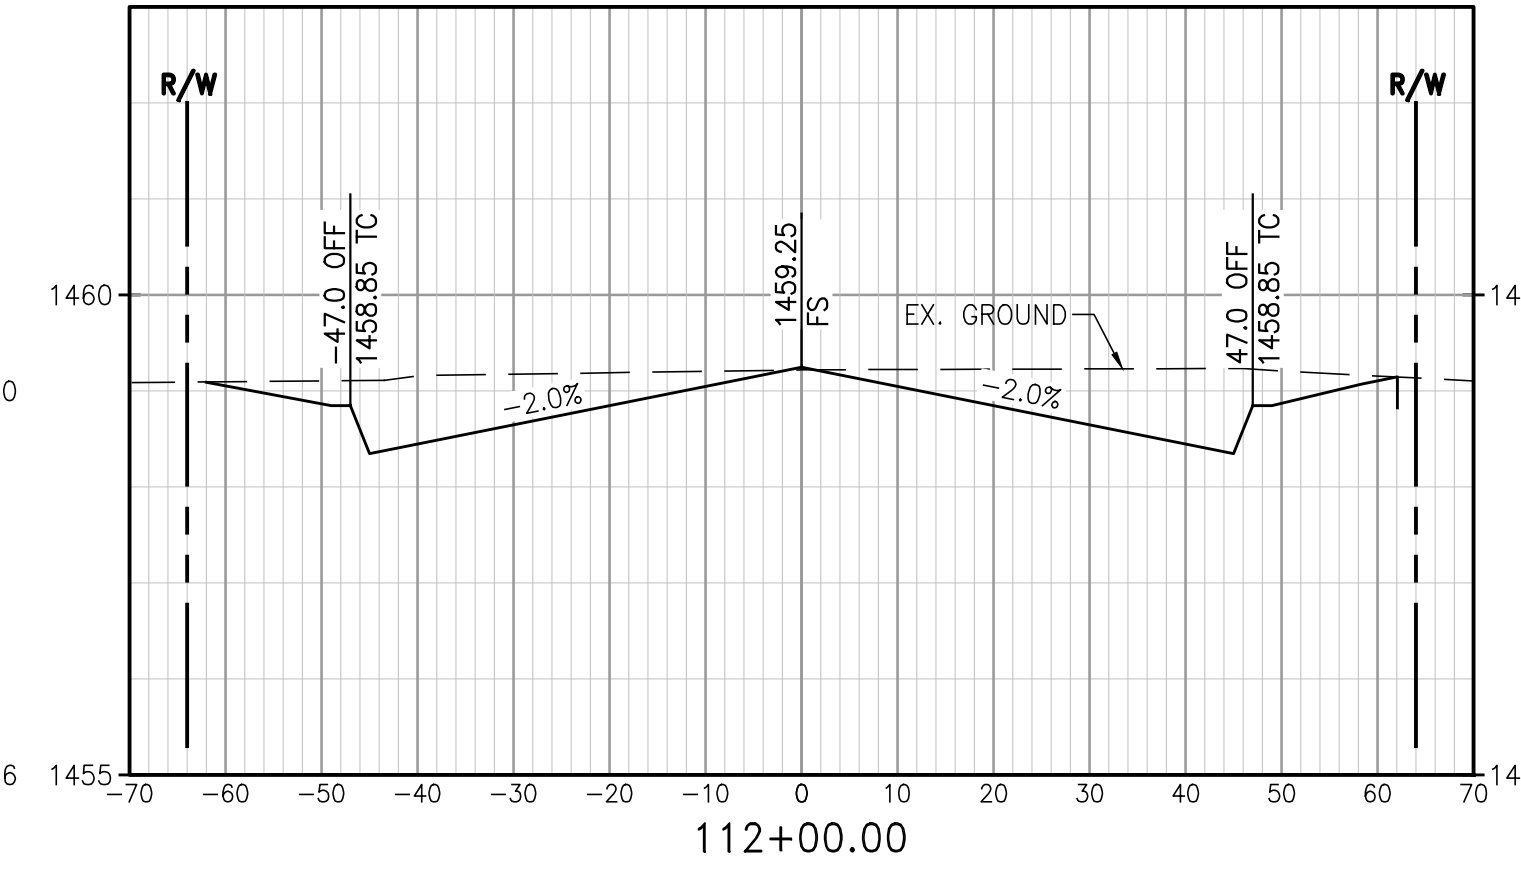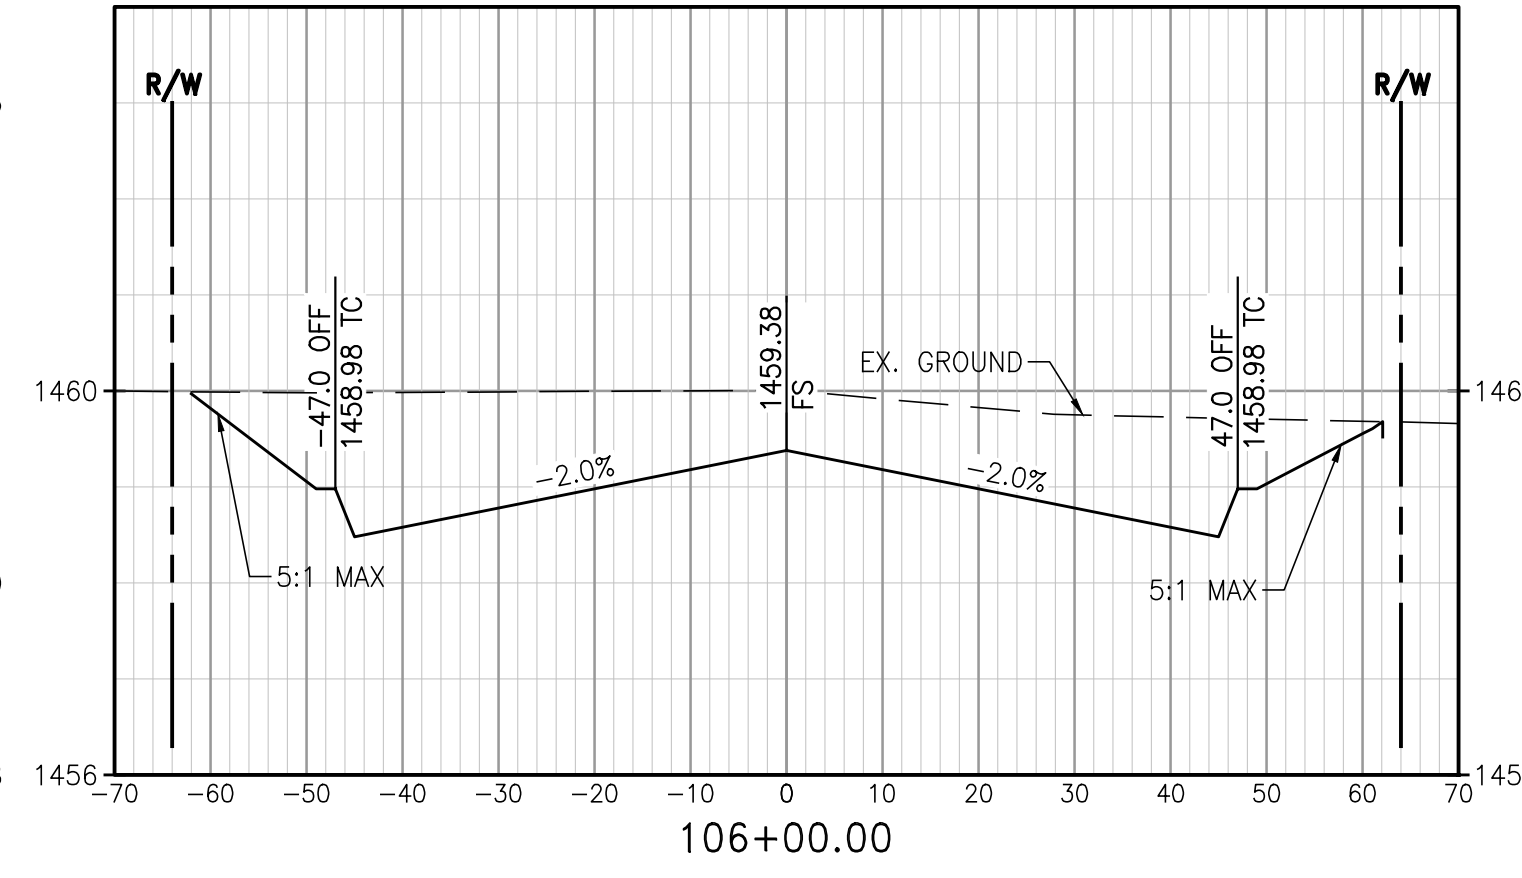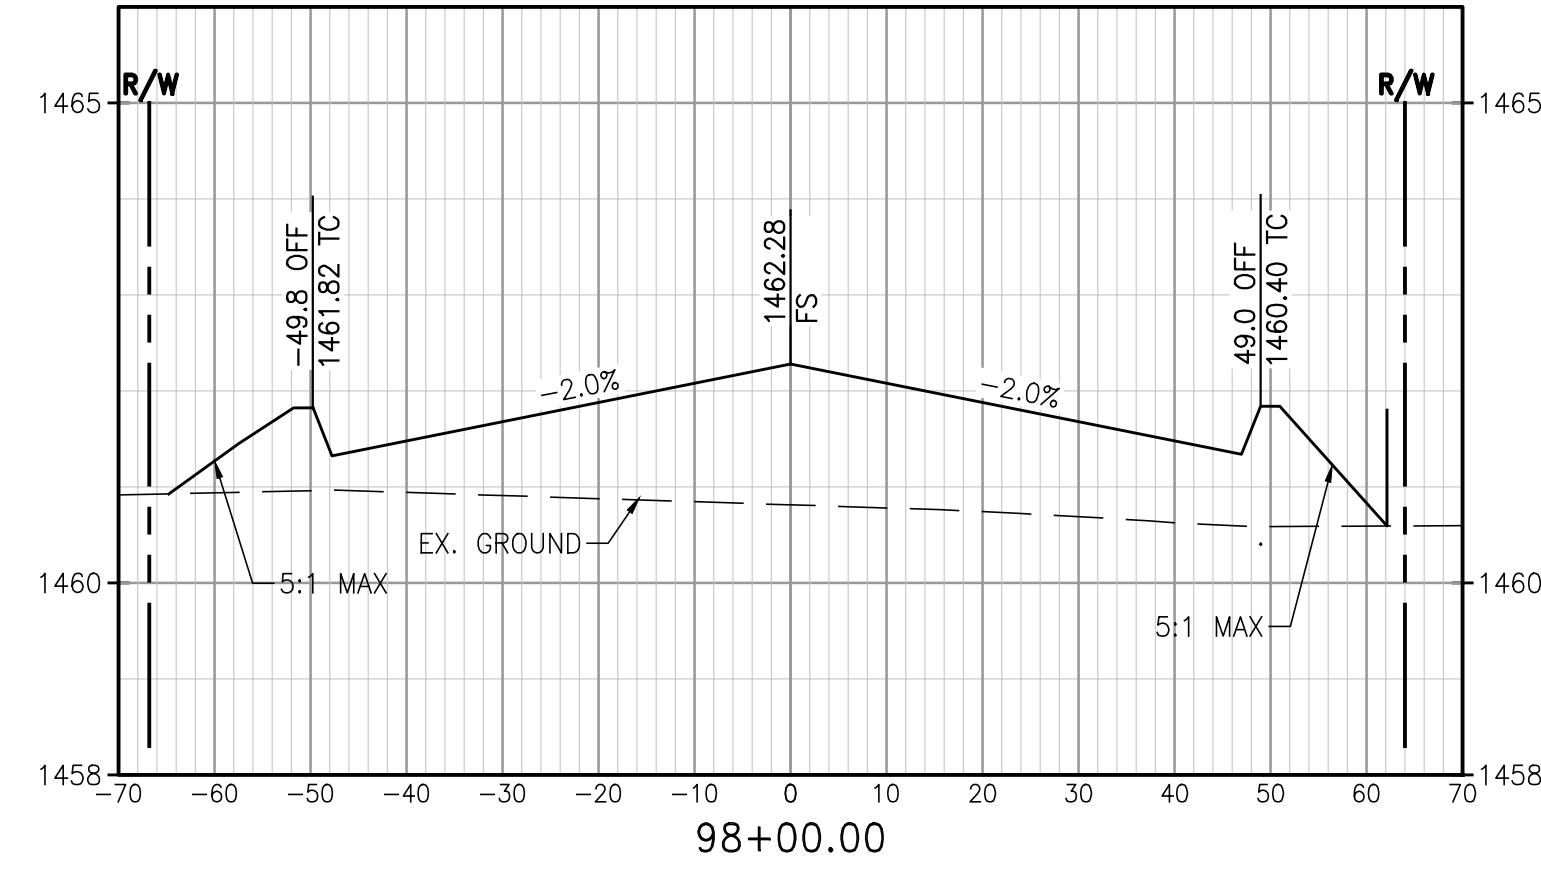

NOTE: MEDIANS OMITTED FROM SECTIONS


\*FOR REFERENCE ONLY\*

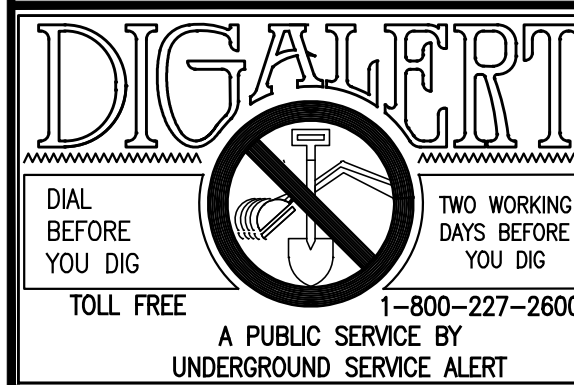

NOTE:  
WORK CONTAINED WITHIN THESE PLANS SHALL NOT COMMENCE UNTIL AN ENCROACHMENT PERMIT AND/OR A GRADING PERMIT HAS BEEN ISSUED.

THE PRIVATE ENGINEER SIGNING THESE PLANS IS RESPONSIBLE FOR ASSURING THE ACCURACY AND ACCEPTABILITY OF THE DESIGN HEREON. IN THE EVENT OF DISCREPANCIES ARISING AFTER CITY APPROVAL OR DURING CONSTRUCTION, THE PRIVATE ENGINEER SHALL BE RESPONSIBLE FOR DETERMINING AN ACCEPTABLE SOLUTION AND REVISING THE PLANS FOR APPROVAL BY THE CITY.

MARK	BY	DATE	REVISIONS	APPR.	DATE

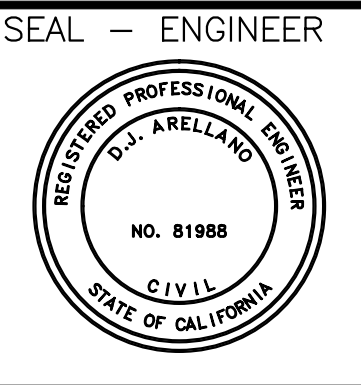

**ALBERT A. WEBB ASSOCIATES**  
ENGINEERING CONSULTANTS  
3788 MCCRAY STREET  
RIVERSIDE, CA. 92506  
PH. (951) 686-1070  
FAX (951) 788-1256

UNDER THE SUPERVISION OF:  
*[Signature]*  
D.J. ARELLANO R.C.E. #C81988 DATE: 1/12/2015

BENCHMARK: SEE HEREON












SCALE: H: 1"=20' V: 1"=2'

CITY OF PERRIS  
AMENDED DPR NO. 11-12-0004  
STRATFORD RANCH-PARCEL MAP 36469  
STREET IMPROVEMENT PLAN  
HARLEY KNOX BLVD CROSS SECTIONS

SHEET NO. 22 OF 23 SHEETS  
PA-1189

G:\2013\13-0239\DRAWINGS\DESIGN\13-0239-C-ST-SECTIONS.DWG 5/18/2016 8:38 AM



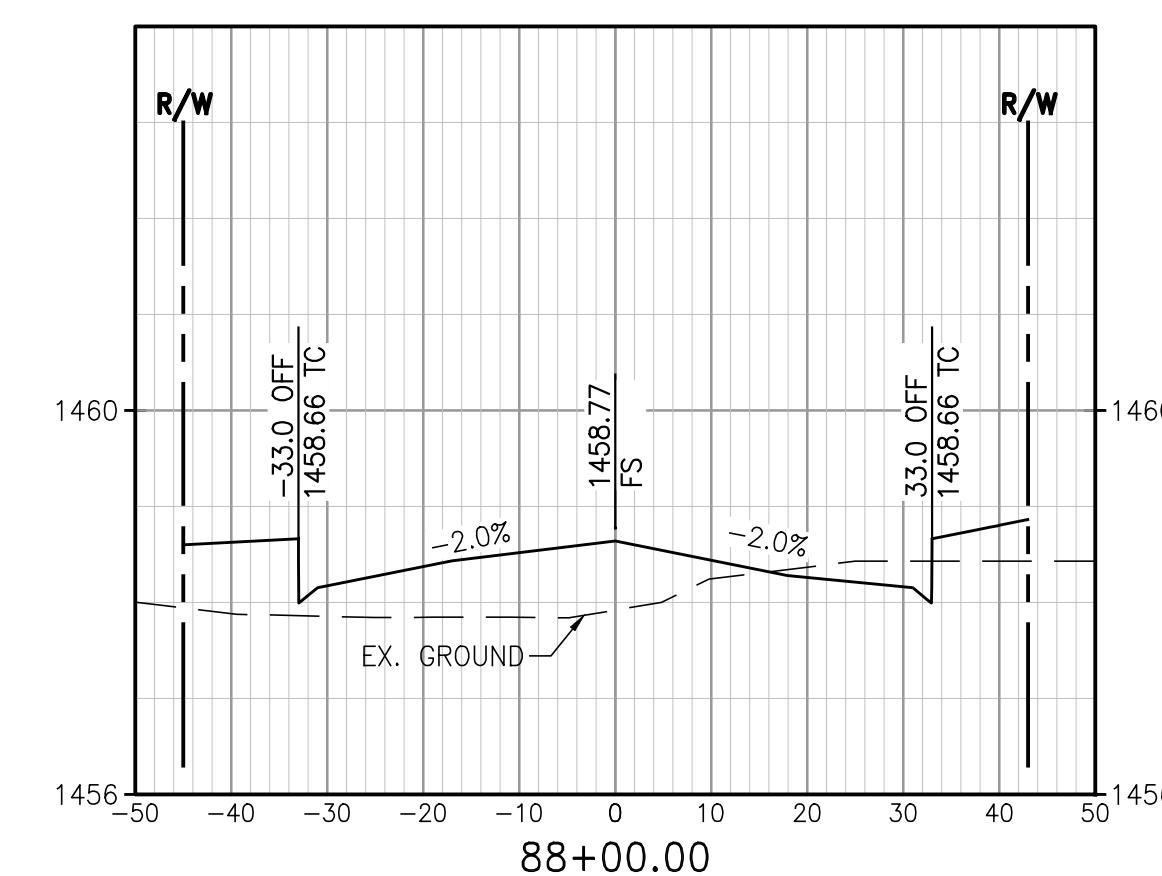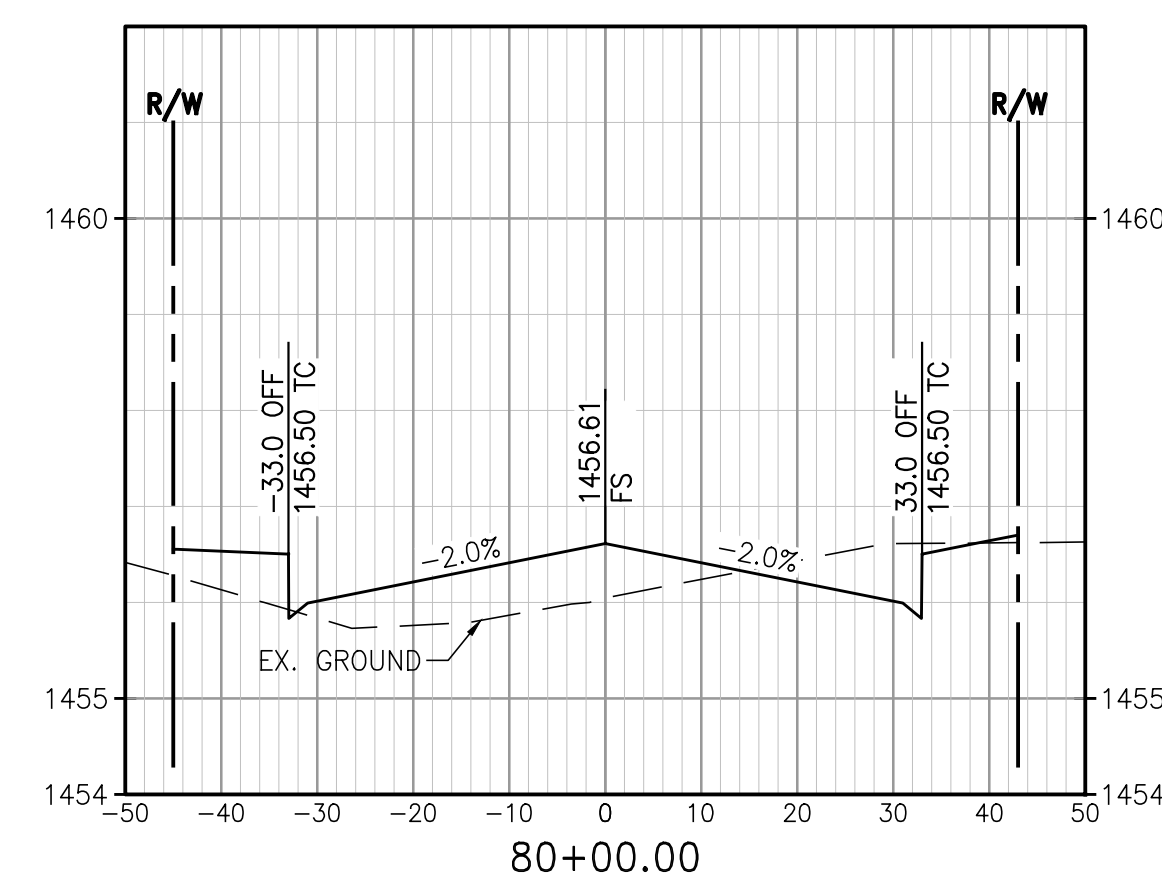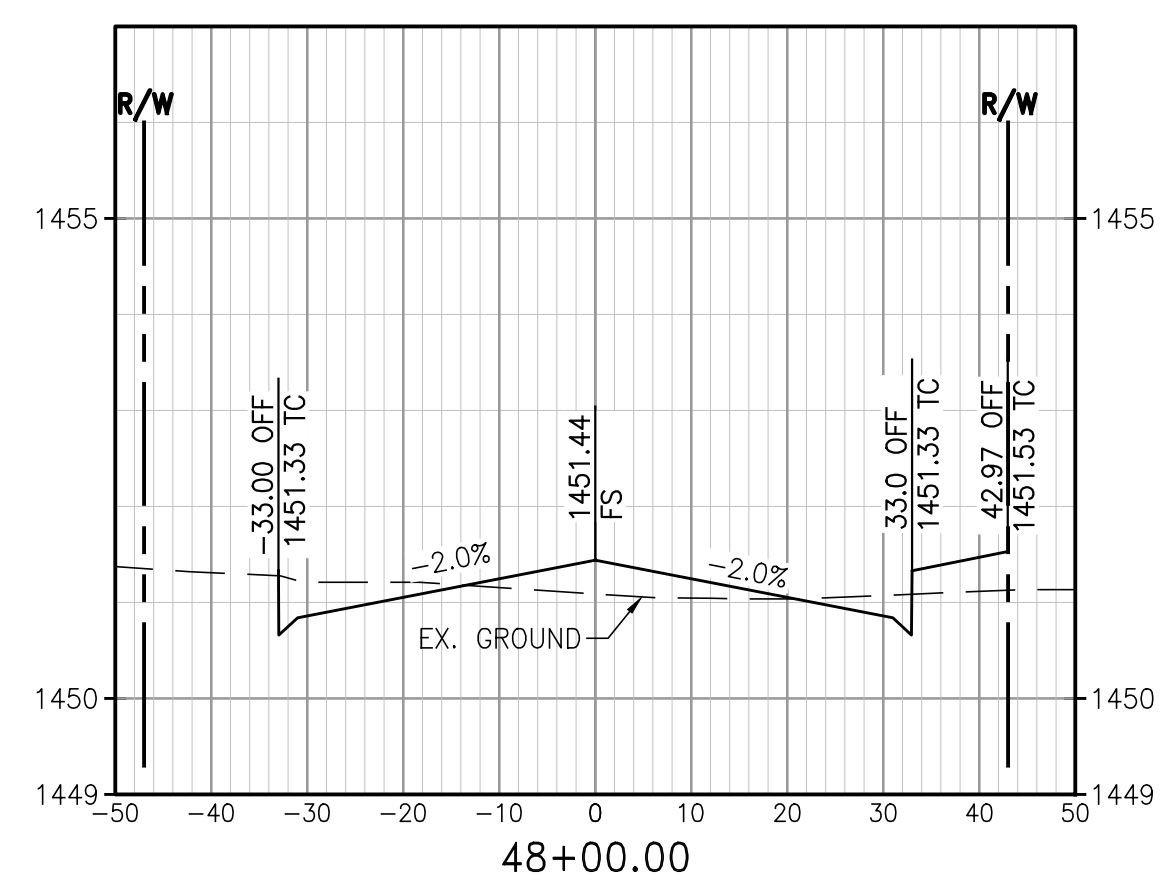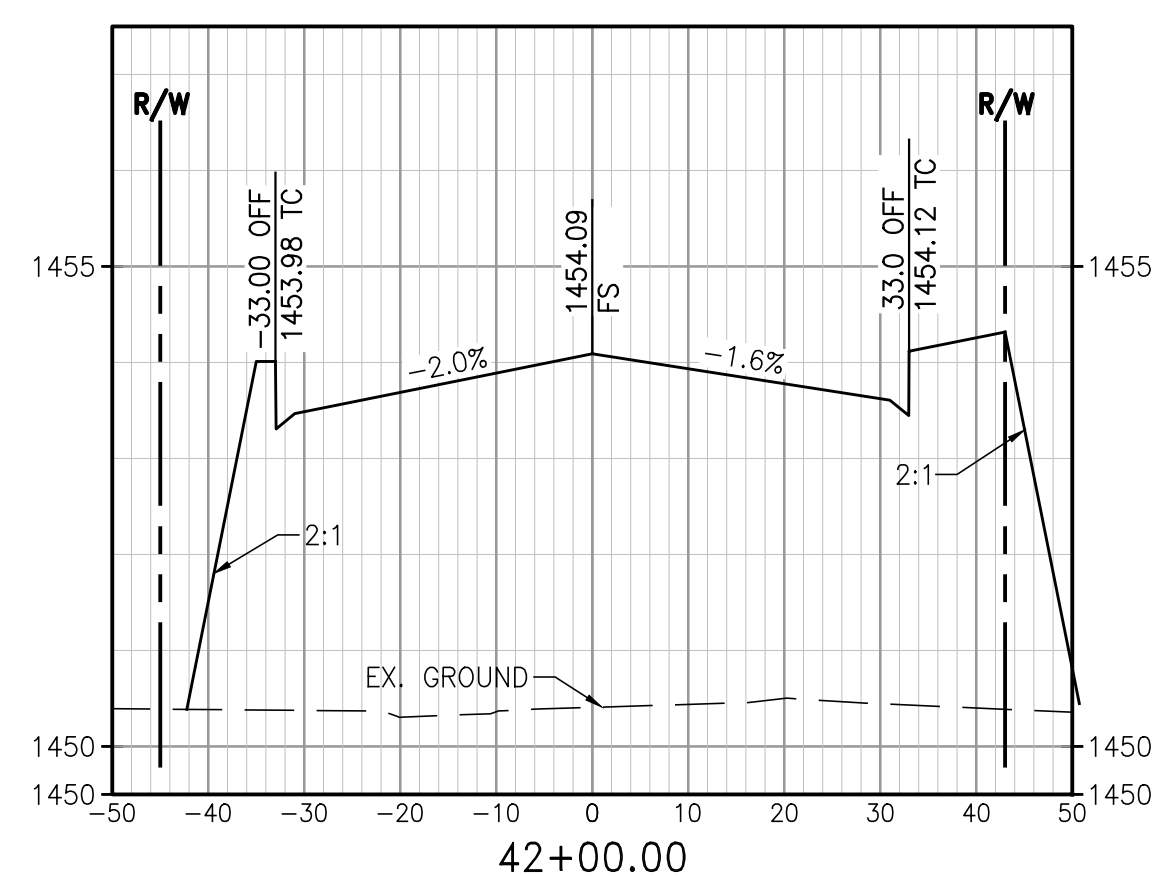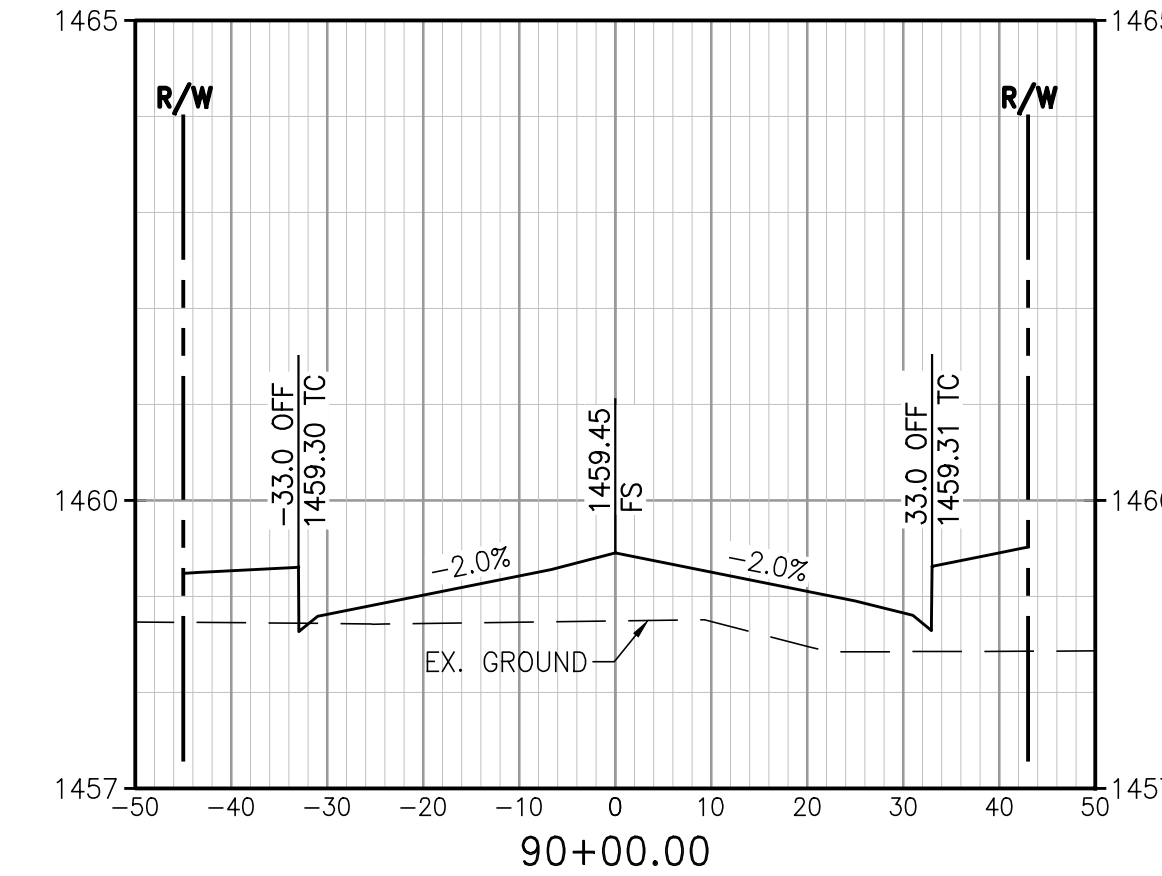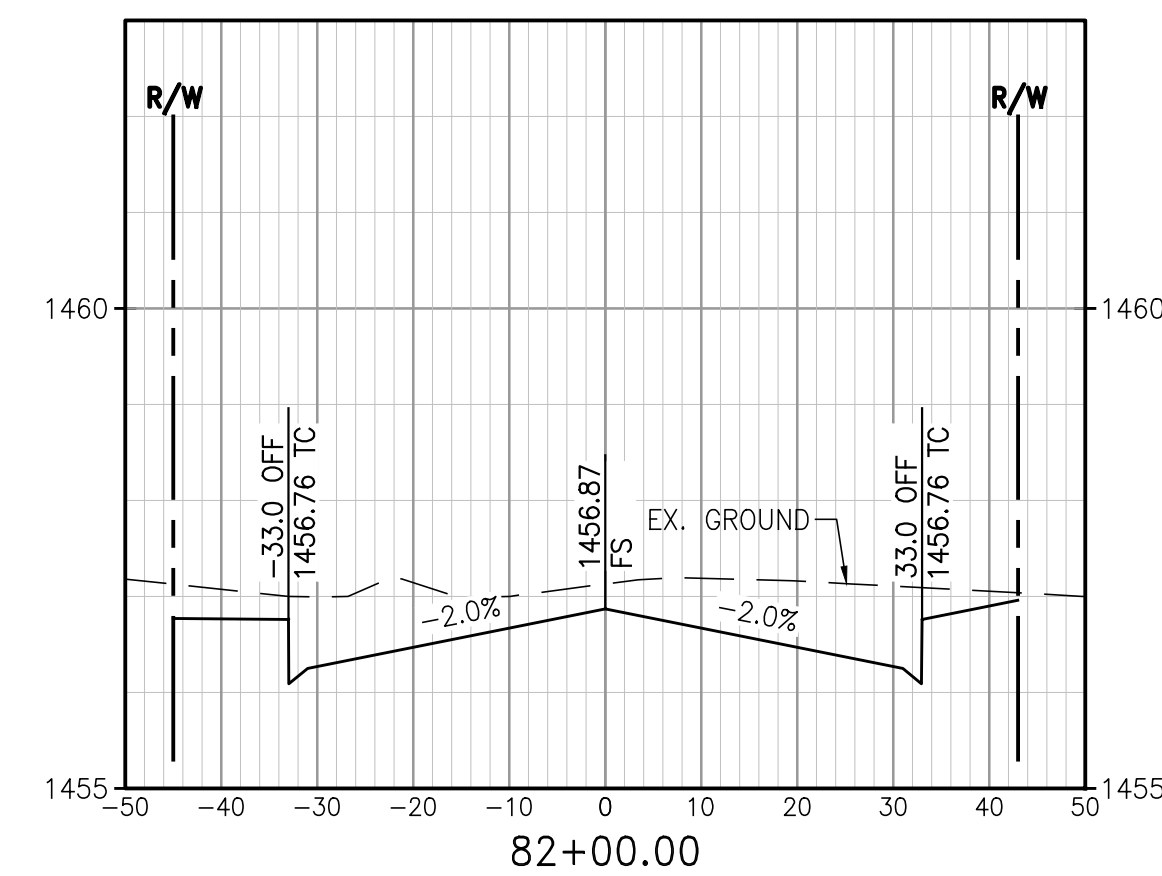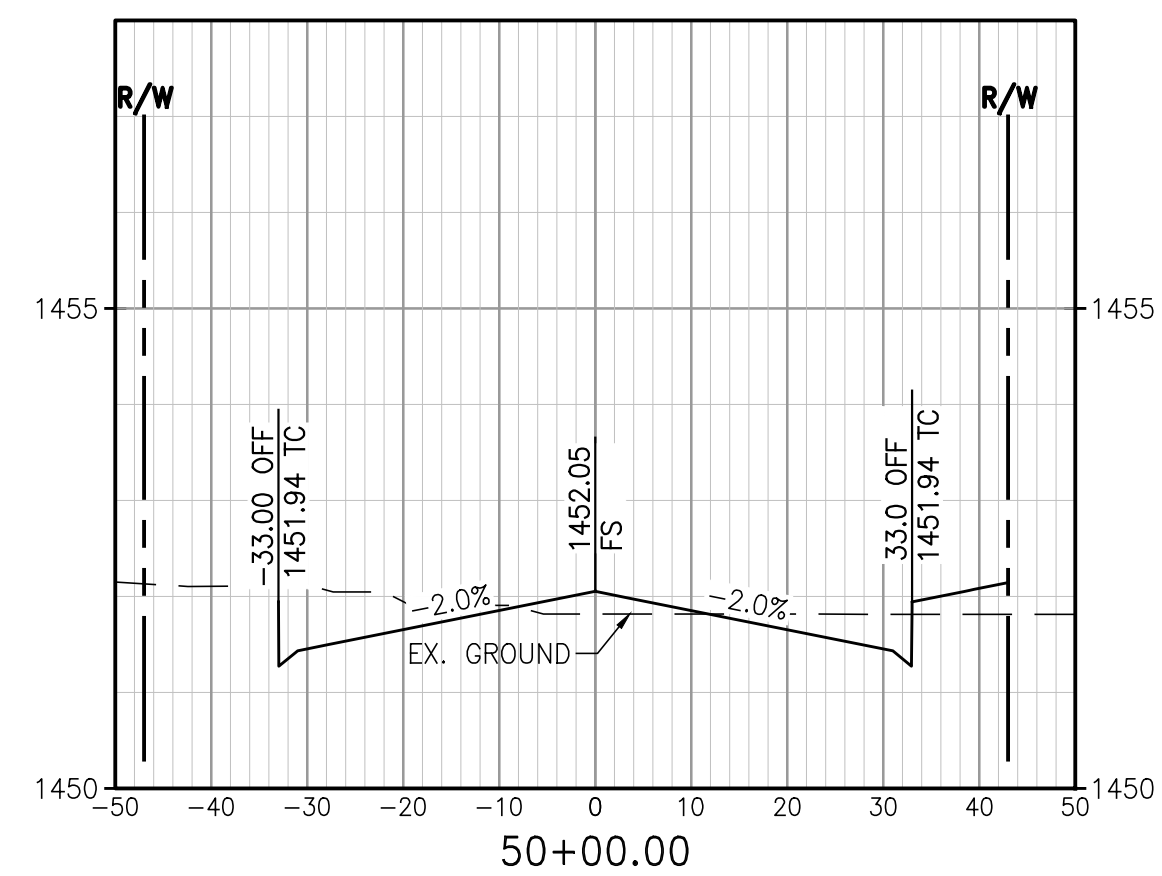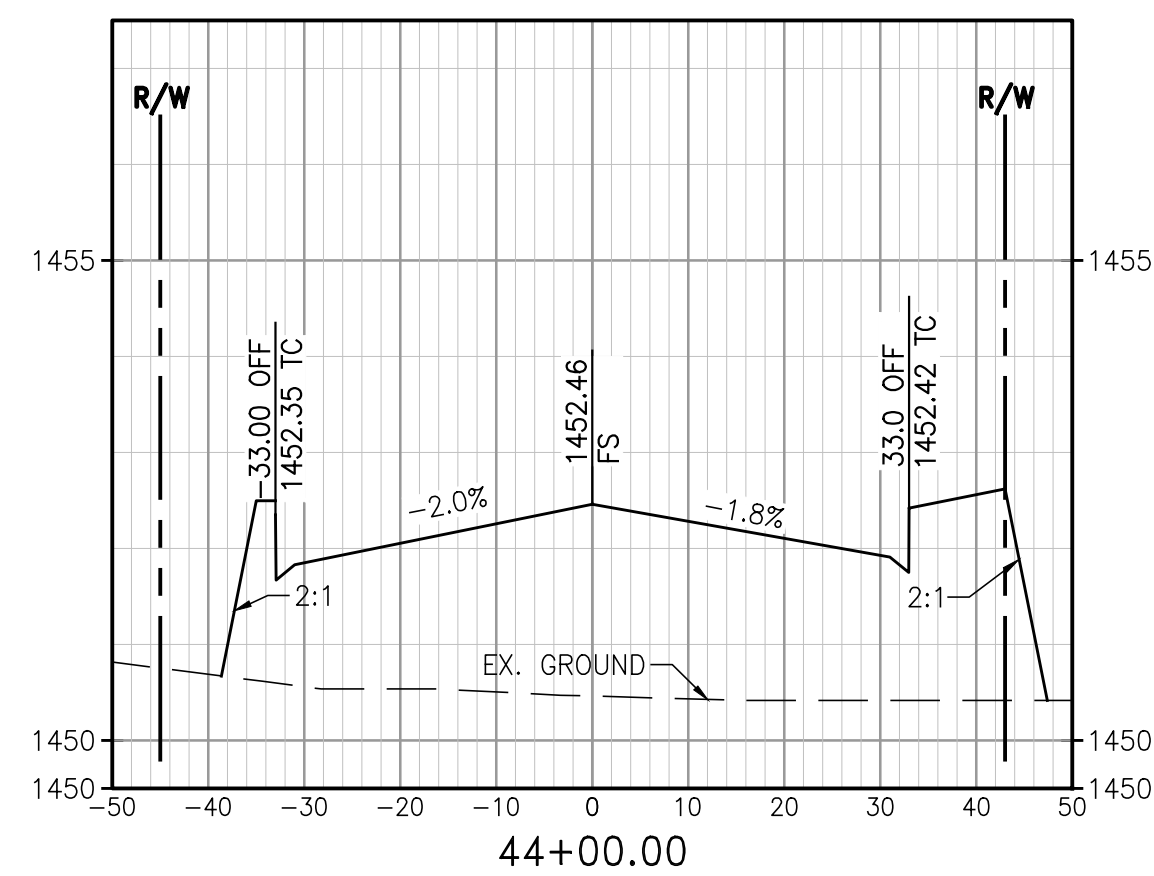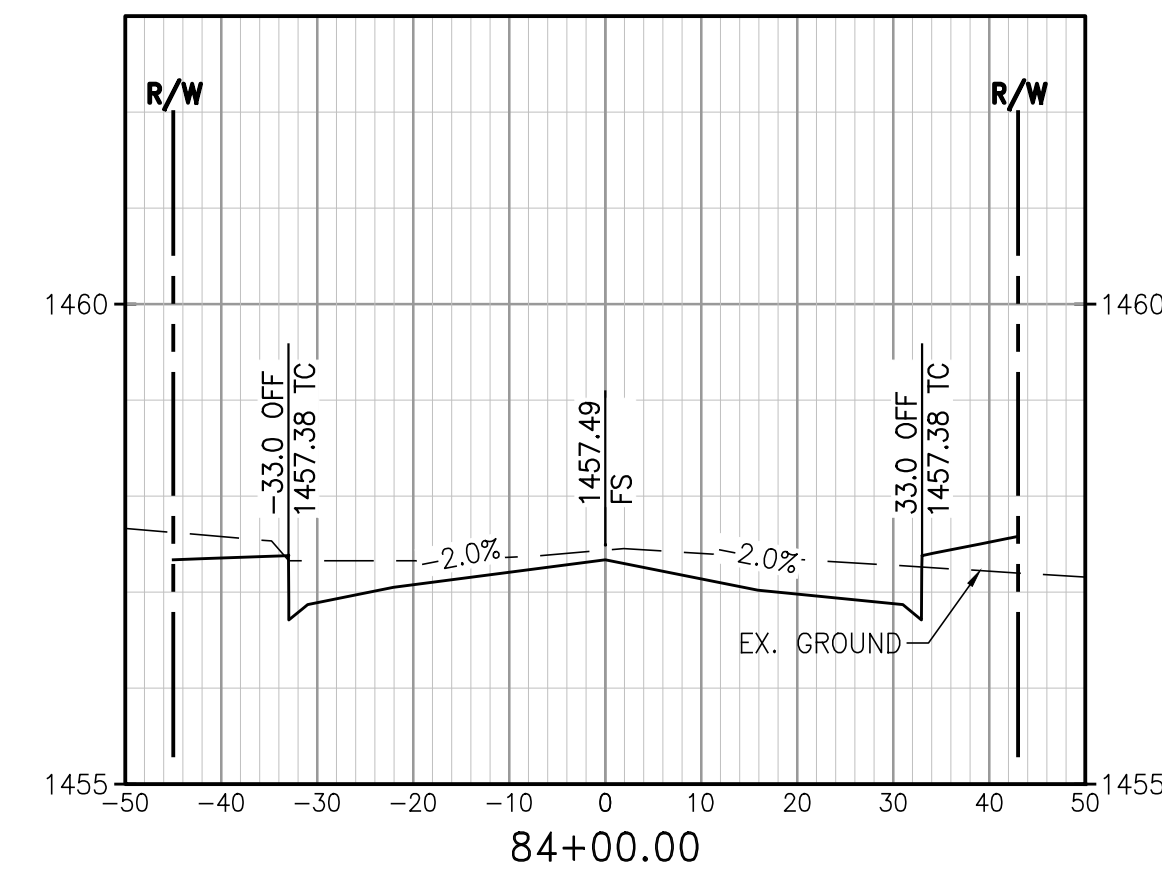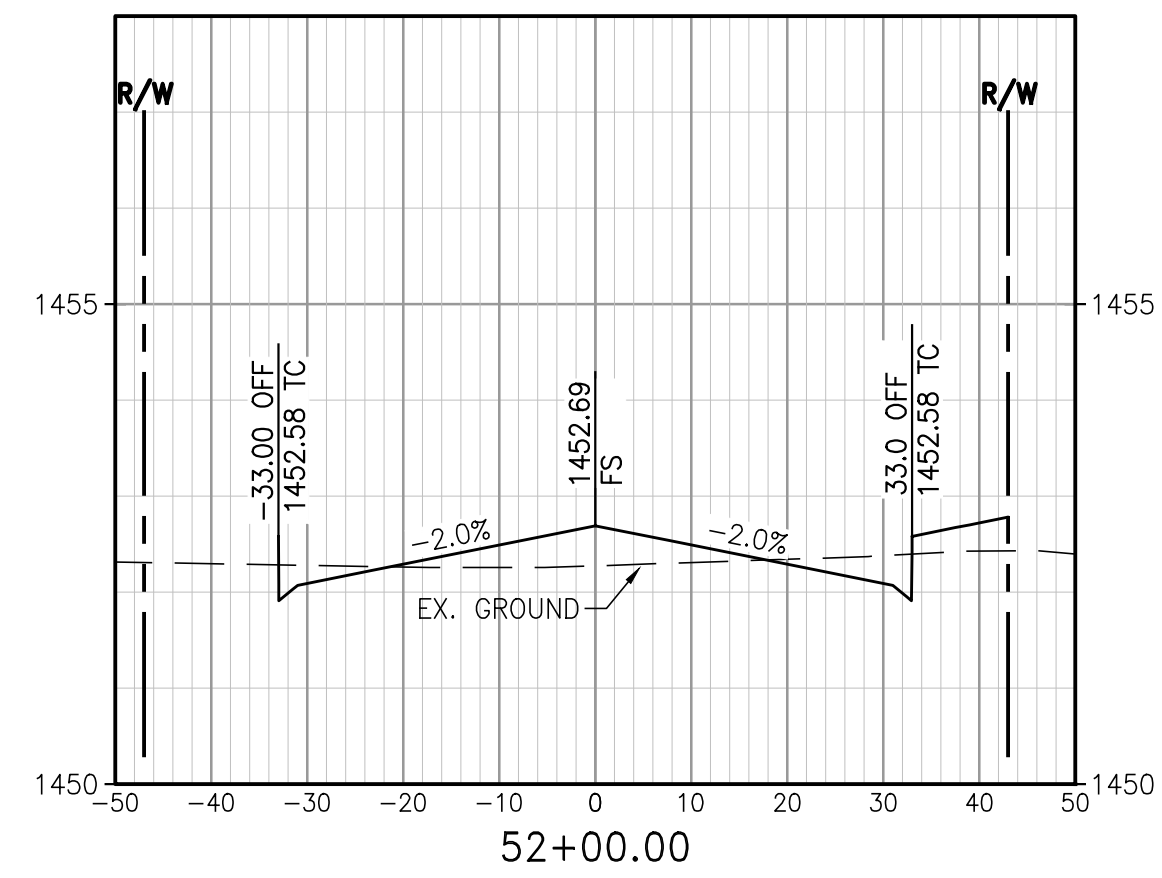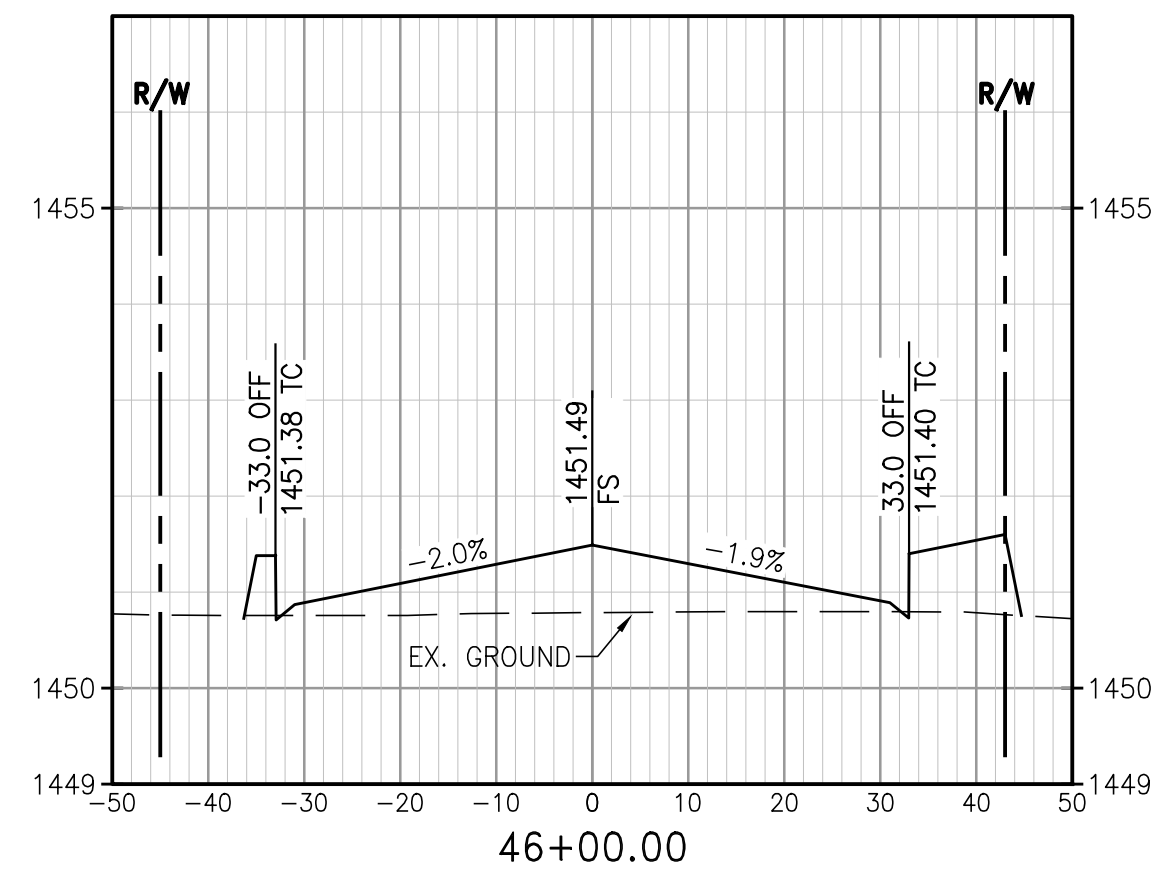

**AS BUILT**


THESE PLANS REFLECT ANY SUBSTANTIAL DESIGN MODIFICATIONS AS PROVIDED TO WEBB ASSOCIATES BY THE CONTRACTOR

*[Signature]*

NO. 81988  
D.J. ARELLANO  
REGISTERED PROFESSIONAL ENGINEER  
CIVIL  
STATE OF CALIFORNIA  
05/19/2016

NOTE: MEDIANS OMITTED FROM SECTIONS


\*FOR REFERENCE ONLY\*

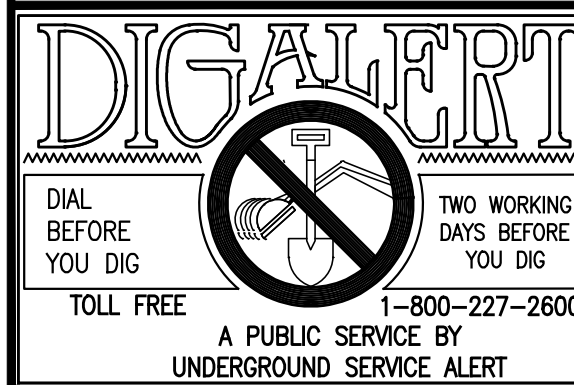

NOTE:  
WORK CONTAINED WITHIN THESE PLANS SHALL NOT COMMENCE UNTIL AN ENCROACHMENT PERMIT AND/OR A GRADING PERMIT HAS BEEN ISSUED.

THE PRIVATE ENGINEER SIGNING THESE PLANS IS RESPONSIBLE FOR ASSURING THE ACCURACY AND ACCEPTABILITY OF THE DESIGN HEREON. IN THE EVENT OF DISCREPANCIES ARISING AFTER CITY APPROVAL OR DURING CONSTRUCTION, THE PRIVATE ENGINEER SHALL BE RESPONSIBLE FOR DETERMINING AN ACCEPTABLE SOLUTION AND REVISING THE PLANS FOR APPROVAL BY THE CITY.

MARK	BY	DATE	REVISIONS	APPR.	DATE

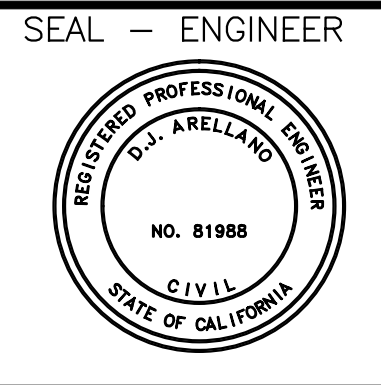

SEAL - ENGINEER

**ALBERT A. WEBB ASSOCIATES**

ENGINEERING CONSULTANTS  
3788 McCRAY STREET  
RIVERSIDE CA. 92506  
PH. (951) 686-1070  
FAX (951) 788-1256

UNDER THE SUPERVISION OF:  
*[Signature]*  
D.J. ARELLANO R.C.E. #C81988 DATE 1/12/2015

BENCHMARK:  
SEE SHEET 1

SCALE:  
H: 1"=20' V: 1"=2'

CITY OF PERRIS  
AMENDED DPR NO. 11-12-0004  
STRATFORD RANCH-PARCEL MAP 36469  
SECTIONS AND DETAILS  
REDLANDS AVE CROSS SECTIONS

FOR: IDI W.O. 2013-0239 CITY FILE NO. 2013-0239

SHEET NO. 23 OF 23 SHEETS  
P8-1189