

Figure 1: Location Map

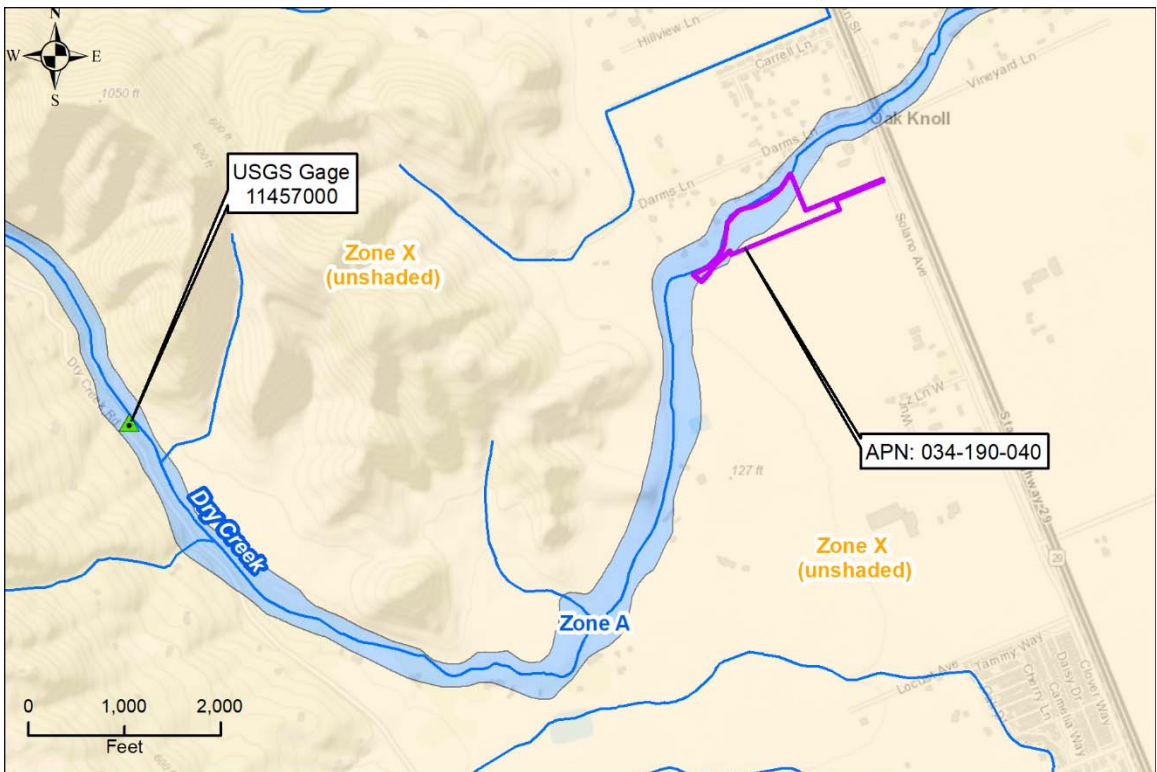


Figure 2: FEMA Effective Special Flood Hazard Areas

## Hydrology

The United States Geological Survey (USGS) stream gage 11457000 (Figure 2) collected flowrate information along Dry Creek, which is upstream of the project site. The USGS Stream Statistics (StreamStats) program used this gage data to calculate a 100-year flowrate of 4,170 cfs. We used this flowrate in the hydraulic model to calculate 100-year BFEs along the subject property.

The StreamStats gage information is included as an attachment to this memorandum.

As-built plans from the California Department of Transportation (CalTrans) indicate a 100-year flowrate of 4,000 cfs at the Highway 29 bridges. While the flowrates are similar, we used the USGS gage data for this analysis because it is more conservative.

## Hydraulics

We created a HEC-RAS model for Dry Creek to calculate 100-year water surface elevations. The model extends along Dry Creek from just downstream of Washington Street to approximately 800 linear feet upstream of the subject property. We developed cross sections geometry using the 2014 digital elevation model (DEM) for Napa County. We also used an onsite survey performed in 2014 to supplement the LiDAR data. The survey is included as an attachment.

We used as-built bridge plans provided by CalTrans to model the Solano Avenue, Highway 29, and Washington Street Bridges, which are attached to this memorandum.

We estimated the railroad bridge height and pier information based on available data in the CalTrans plans and the available topographic information. We used a conversion of +2.66 feet to translate the elevations (NGVD 29) in the bridge plans in order to reference the NAVD 88 vertical datum.

The elevation conversion is based on the Napa County benchmarks 723-C and 724-C along Solano Avenue near the project site. The vertical datum conversion from NGVD 29 to NAVD 88 was not available for Dry Creek in the FEMA Flood Insurance Study (FIS).

We used a normal depth of 0.7 percent slope as the downstream boundary condition measured using the DEM. There are no available, effective base flood elevations along Dry Creek. We assigned Manning's roughness values based on aerial imagery and Google Street View photos.

Figure 4 shows an image of Dry Creek looking upstream from Solano Avenue. We used a roughness value of 0.04 for the channel, and 0.08 was used for the overbanks to represent the trees, development, and vineyards in the overbanks. We reduced channel roughness to 0.035 beneath the bridges since vegetation is minimal.

Ineffective flow areas represent the expansion and contraction of the floodplain through the bridges at a 1:1 ratio upstream and 4:1 downstream. We adjusted the contraction and expansion coefficients to 0.3 and 0.5, respectively, at the cross sections upstream and downstream of the bridges.




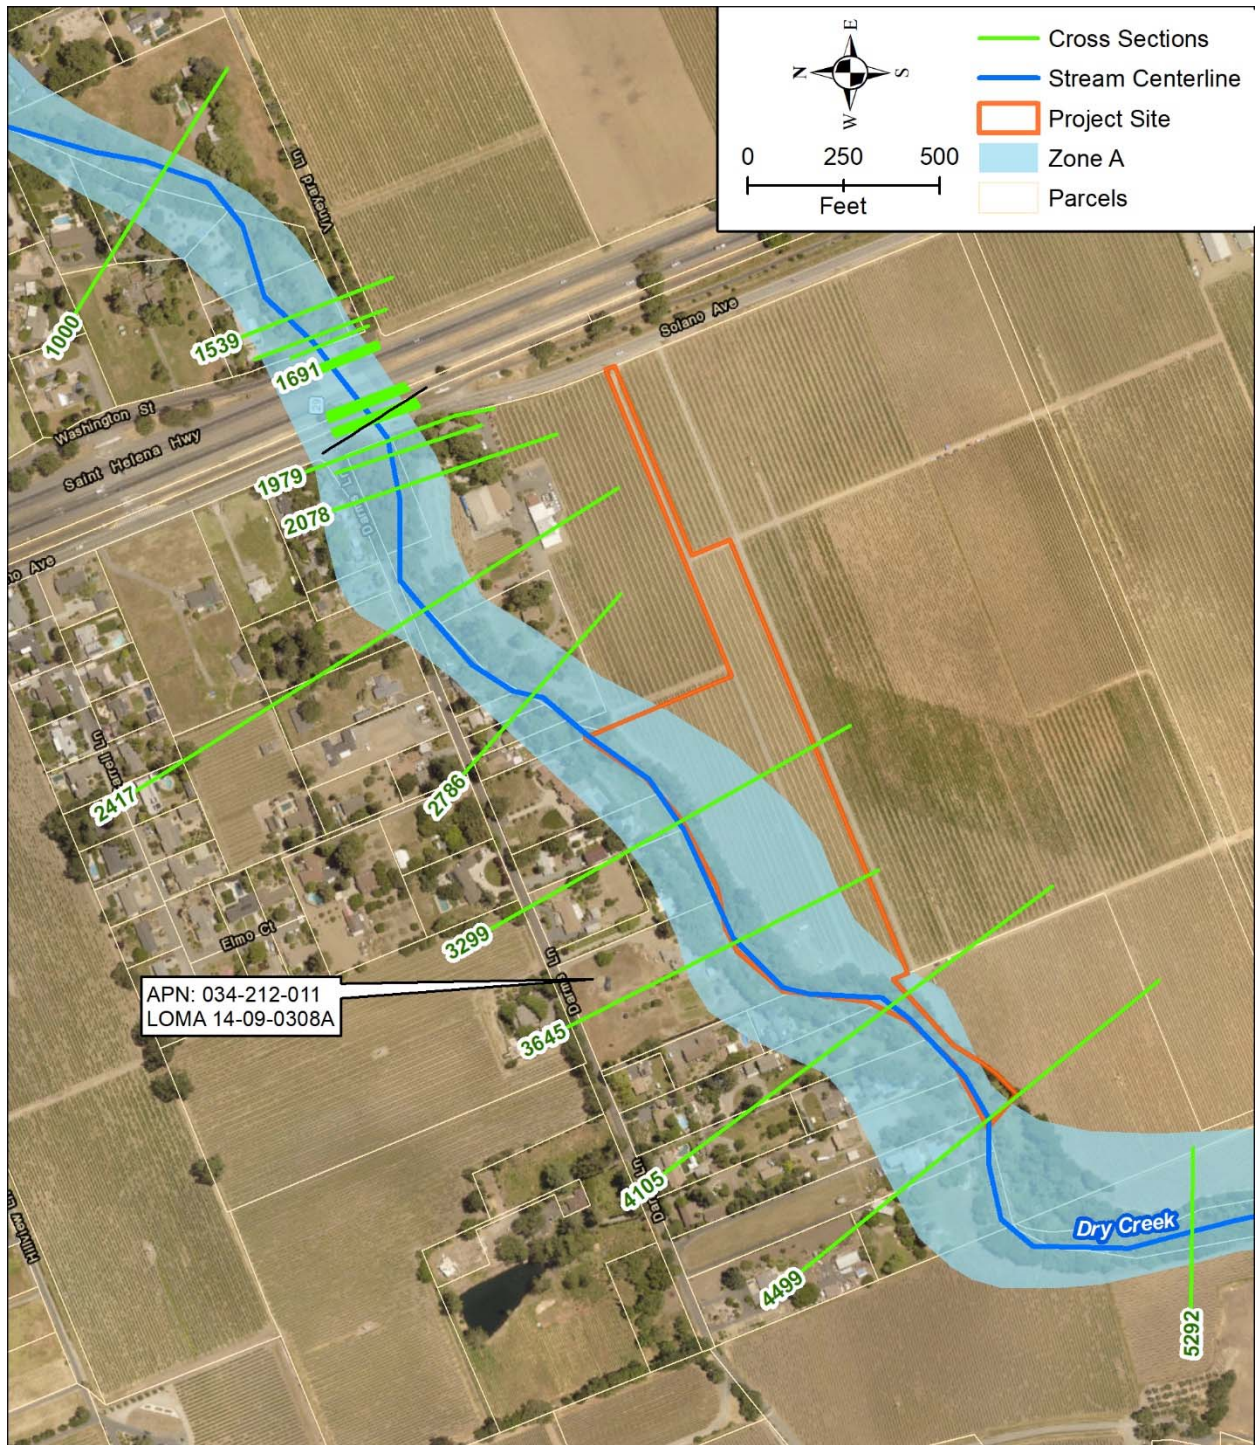


Figure 3: Hydraulic Work Map Dry Creek



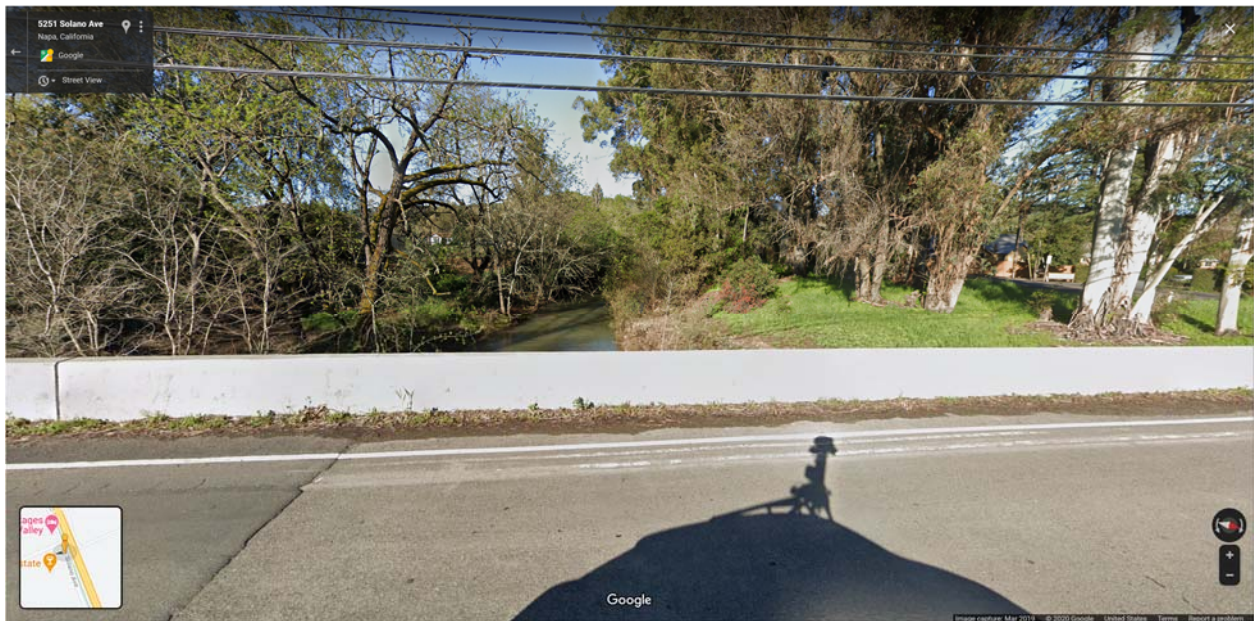

**Figure 4: Google Street View on Solano Avenue Looking West (Upstream) at Dry Creek**

**Results**

The results of the analysis indicate a 100-year base flood elevation of 109.51 feet, NAVD 88 at the upstream end of the property and 105.3 feet, NAVD 88, at the downstream end of the property.


The sections through the property site are highlighted in green in Table 1. Note that the calculated 100-year water surface elevation of 106.2 feet, NAVD 88, matches the base flood elevation determined as part of the LOMA for property APN 034-212-111.

The 100-year water surface elevation is generally contained within the channel banks of Dry Creek near the project site, as shown in Figure 5.

**Table 1: Dry Creek 100-year Water Surface Elevations (ft, NAVD 88)**

River Station	WSE (ft, NAV D88)	River Station	WSE (ft, NAV D88)	River Station	WSE (ft, NAV D88)
5292	114.89	1886	100.08	1703	97.18
4499	110.21	1881	100.09	1700	97.28
4105	109.51	1876	100.09	1697	97.40
3645	106.17	1870	100.10	1691	97.6
3299	105.30	1857	Railroad		Washington Street
2786	103.52	1844	99.82	1674	97.64
2417	101.68	1840	99.80	1645	97.22
2078	100.77	1836	99.73	1615	96.67
2017	100.36	1832	99.66	1539	92.98
1979	100.42	1827	99.53	1000	
1928	Solano Ave	1765	HWY 29		
1892	100.07	1709	96.94		

*\*Highlighted areas represent the project site*

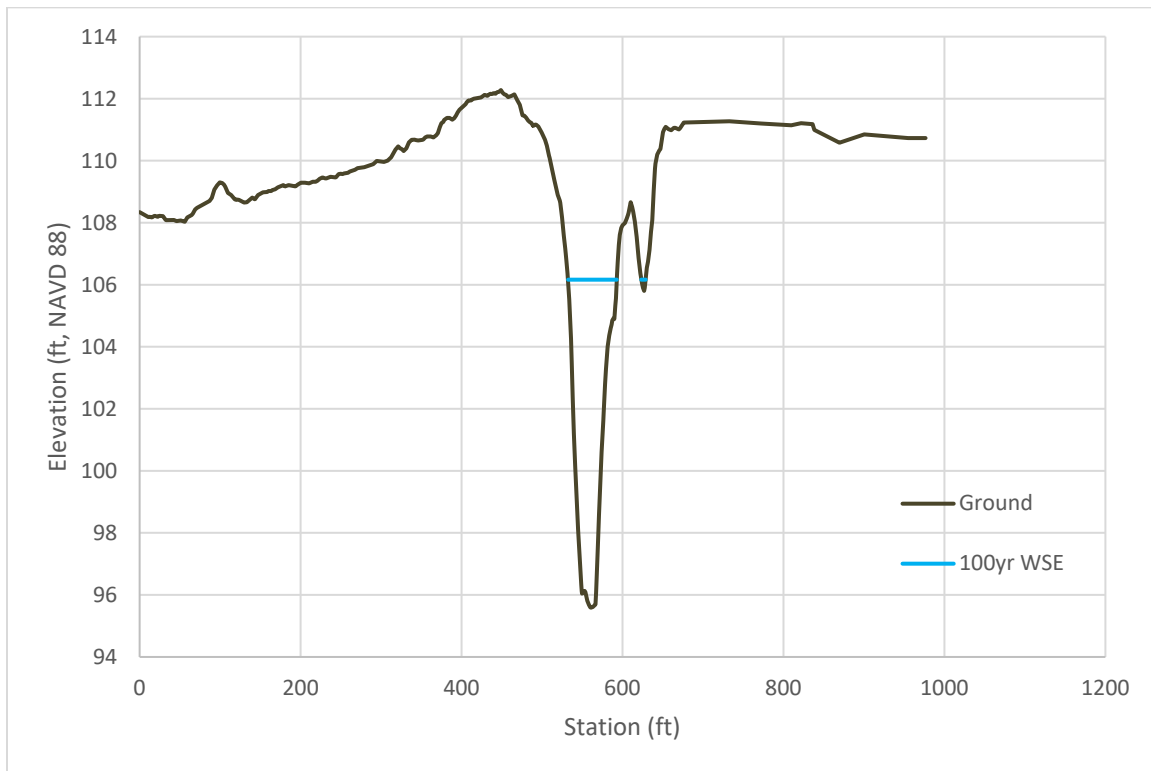

**Figure 5: Cross Section 3645 100-year Water Surface Elevations**

## Recommendations and Conclusions

The results indicate that the 100-year flowrate calculated at the USGS gage on Dry Creek is contained within the channel banks where the floodplain is located within the subject property. The water surface elevation varies across the property site.

Note that the LiDAR data used for the channel geometry may not fully capture the channel flowline due to standing water and vegetation. A survey of the channel would provide additional detail and may change the calculations.

Structures constructed within the Zone A floodplain are required to elevate the finished floor elevation 1 foot above the base flood elevation to meet County NFIP regulations. Flood insurance rates may still apply. A LOMA or Letter of Map Revision Based on Fill (LOMR-F) would need to be submitted to FEMA to remove any structures or portions of property from the Zone A floodplain.

The lowest adjacent grade to any structure or lowest elevation within a defined portion of land must be at or above the BFE to remove the structure or area from the Zone A designation. Flood insurance requirements are subject to the lender and NFIP regulations.

**Attachments:**

1. USGS StreamStats Results
2. CalTrans As-built Bridge Plans
3. 2014 Onsite Survey
4. LOMA 14-09-0308A-06025
5. HEC-RAS Cross Sections
6. HEC-RAS Stream Profile

**Attachment 1: USGS StreamStats Gage Data**





## StreamStats Data-Collection Station Report

USGS Station Number      11457000  
 Station Name                DRY C NR NAPA CA

[Click here to link to available data on NWIS-Web for this site.](#)

### Descriptive Information

Station Type                Streamgauge, continuous record  
 Location  
 Gage  
 Regulation and Diversions  
 Regulated?                False  
 Period of Record  
 Remarks  
 Latitude (degrees NAD83)    38.35630164  
 Longitude (degrees NAD83)   -122.36497702  
 Hydrologic unit code        18050002  
 County                      -  
 HCDN2009                  No

### Physical Characteristics

Characteristic Name	Value	Units	Citation Number
<b>Descriptive Information</b>			
High_Flow_Region_Code	1	dimensionless	<a href="#">230</a>
High_Flow_Regression_Equation	Y	Yes or No	<a href="#">230</a>
Datum_of_Latitude_Longitude	NAD83	dimensionless	<a href="#">30</a>
District_Code	06	dimensionless	<a href="#">30</a>
Begin_date_of_record	4/1/1951	days	<a href="#">41</a>
End_date_of_record	9/30/1966	days	<a href="#">41</a>
Number_of_days_of_record	5662	days	<a href="#">41</a>
Number_of_days_GT_0	4465	days	<a href="#">41</a>
<b>Precipitation Statistics</b>			
24_Hour_2_Year_Precipitation	3.3000	inches	<a href="#">31</a>
Mean_Annual_Precipitation	40.72	inches	<a href="#">230</a>
<b>Climate Characteristics</b>			
Mean_Annual_Lake_Evaporation	49.000	inches	<a href="#">31</a>
<b>Temperature Statistics</b>			
Mean_Min_January_Temperature	36.000	degrees F	<a href="#">31</a>
<b>Topographical Characteristics</b>			
Elevation_of_10_and_85_points	1200.00	feet	<a href="#">31</a>
Percent_above_5000_ft	0.0000	percent	<a href="#">31</a>
Mean_Basin_Elevation	1139	feet	<a href="#">230</a>
<b>Land Cover Characteristics</b>			
Percent_Forest	29.000	percent	<a href="#">31</a>
Percent_Storage	0.0000	percent	<a href="#">31</a>
<b>Stream Channel Properties</b>			
Main_Channel_Length	10.800	miles	<a href="#">31</a>
Stream_Slope_10_and_85_Method	72.000	feet per mi	<a href="#">31</a>
<b>Basin Dimensional Characteristics</b>			
Contributing_Drainage_Area	17.400	square miles	<a href="#">31</a>

Drainage\_Area 17.3 square miles [230](#)

### Streamflow Statistics

Statistic Name	Value	Units	Citation Number	Years of Preferred? Record	Standard Error, percent	Variance log- 10	Lower 95% Confidence Interval	Upper 95% Confidenc Interval
<b>Peak-Flow Statistics</b>								
Mean_Annual_Flood	617.000	cubic feet per second	<a href="#">31</a>	Y				
2_Year_Peak_Flood	1580	cubic feet per second	<a href="#">230</a>	Y	15	13.31	0.00331149995	
5_Year_Peak_Flood	2350	cubic feet per second	<a href="#">230</a>	Y	15	13.43	0.00337069994	
10_Year_Peak_Flood	2830	cubic feet per second	<a href="#">230</a>	Y	15	14.88	0.00412950013	
25_Year_Peak_Flood	3400	cubic feet per second	<a href="#">230</a>	Y	15	17.42	0.00564080011	
50_Year_Peak_Flood	3800	cubic feet per second	<a href="#">230</a>	Y	15	19.62	0.00712289987	
100_Year_Peak_Flood	4170	cubic feet per second	<a href="#">230</a>	Y	15	21.96	0.00888239965	

200_Year_Peak_Flood	4530	cubic feet per second	<a href="#">230</a>	Y	15	24.4	0.0109099997
500_Year_Peak_Flood	4980	cubic feet per second	<a href="#">230</a>	Y	15	27.75	0.0139880003
Regression_2_Year_Peak_Flood	917	cubic feet per second	<a href="#">230</a>	Y		58.14	0.0549179986
Regression_5_Year_Peak_Flood	1780	cubic feet per second	<a href="#">230</a>	Y		47.03	0.0376829989
Regression_10_Year_Peak_Flood	2400	cubic feet per second	<a href="#">230</a>	Y		44.01	0.0333979987
Regression_25_Year_Peak_Flood	3230	cubic feet per second	<a href="#">230</a>	Y		42.29	0.0310299993
Regression_50_Year_Peak_Flood	3850	cubic feet per second	<a href="#">230</a>	Y		42.37	0.0311450008
Regression_100_Year_Peak_Flood	4510	cubic feet per second	<a href="#">230</a>	Y		43.88	0.0332069993
Regression_200_Year_Peak_Flood	5120	cubic feet per second	<a href="#">230</a>	Y		44.07	0.0334799998
Regression_500_Year_Peak_Flood	5950	cubic feet per second	<a href="#">230</a>	Y		45.63	0.0356810018
Weighted_5_Year_Peak_Flood	2300	cubic feet per second	<a href="#">230</a>	Y		12.86	0.00309389993
Weighted_10_Year_Peak_Flood	2780	cubic feet per second	<a href="#">230</a>	Y		14.03	0.00367509993
Weighted_25_Year_Peak_Flood	3370	cubic feet per second	<a href="#">230</a>	Y		16.01	0.00477309991
Weighted_50_Year_Peak_Flood	3810	cubic feet per second	<a href="#">230</a>	Y		17.67	0.00579709979
Weighted_100_Year_Peak_Flood	4240	cubic feet per second	<a href="#">230</a>	Y		19.46	0.00700790016
Weighted_200_Year_Peak_Flood	4670	cubic feet per second	<a href="#">230</a>	Y		21.1171658289881	0.00822880026
Weighted_500_Year_Peak_Flood	5230	cubic feet per second	<a href="#">230</a>	Y		23.39	0.0100490004
Peak_years_with_historic_adjustment	15	years	<a href="#">230</a>	N			
Weighted_2_Year_Peak_Flood	1530	cubic feet per second	<a href="#">230</a>	Y		12.92	0.00312320003
<b>Flood-Volume Statistics</b>							
1_Day_2_Year_Maximum	596.000	cubic feet per second	<a href="#">31</a>	Y			
1_Day_50_Year_Maximum	1683.00	cubic feet per second	<a href="#">31</a>	Y			
3_Day_2_Year_Maximum	394.000	cubic feet per second	<a href="#">31</a>	Y			

3_Day_50_Year_Maximum	1108.00	cubic feet per second	<a href="#">31</a>	Y	
7_Day_2_Year_Maximum	234.000	cubic feet per second	<a href="#">31</a>	Y	
7_Day_50_Year_Maximum	809.000	cubic feet per second	<a href="#">31</a>	Y	
15_Day_2_Year_Maximum	149.000	cubic feet per second	<a href="#">31</a>	Y	
15_Day_50_Year_Maximum	526.000	cubic feet per second	<a href="#">31</a>	Y	

**Flow-Duration Statistics**

1_Percent_Duration	316	cubic feet per second	<a href="#">325</a>	Y	15
2_Percent_Duration	199	cubic feet per second	<a href="#">325</a>	Y	15
3_Percent_Duration	144	cubic feet per second	<a href="#">325</a>	Y	15
5_Percent_Duration	89	cubic feet per second	<a href="#">325</a>	Y	15
10_Percent_Duration	42	cubic feet per second	<a href="#">325</a>	Y	15
15_Percent_Duration	24	cubic feet per second	<a href="#">325</a>	Y	15
20_Percent_Duration	14	cubic feet per second	<a href="#">325</a>	Y	15
25_Percent_Duration	9.9	cubic feet per second	<a href="#">325</a>	Y	15
30_Percent_Duration	7.3	cubic feet per second	<a href="#">325</a>	Y	15
35_Percent_Duration	5.3	cubic feet per second	<a href="#">325</a>	Y	15
40_Percent_Duration	4	cubic feet per second	<a href="#">325</a>	Y	15
45_Percent_Duration	2.7	cubic feet per second	<a href="#">325</a>	Y	15
50_Percent_Duration	1.9	cubic feet per second	<a href="#">325</a>	Y	15
55_Percent_Duration	1.4	cubic feet per second	<a href="#">325</a>	Y	15
60_Percent_Duration	0.9	cubic feet per second	<a href="#">325</a>	Y	15
65_Percent_Duration	0.5	cubic feet per second	<a href="#">325</a>	Y	15
70_Percent_Duration	0.2	cubic feet per second	<a href="#">325</a>	Y	15
75_Percent_Duration	0.1	cubic feet per second	<a href="#">325</a>	Y	15
80_Percent_Duration	0	cubic feet per second	<a href="#">325</a>	Y	15
85_Percent_Duration	0	cubic feet per second	<a href="#">325</a>	Y	15
90_Percent_Duration	0	cubic feet per second	<a href="#">325</a>	Y	15
95_Percent_Duration	0	cubic feet per second	<a href="#">325</a>	Y	15
97_Percent_Duration	0	cubic feet per second	<a href="#">325</a>	Y	15
98_Percent_Duration	0	cubic feet per second	<a href="#">325</a>	Y	15
99_Percent_Duration	0	cubic feet per second	<a href="#">325</a>	Y	15

**Annual Flow Statistics**

Mean_Annual_Flow	20	cubic feet per second	<a href="#">325</a>	Y	15
------------------	----	-----------------------	---------------------	---	----



Stand_Dev_of_Mean_Annual_Flow	14	cubic feet per second	<a href="#">325</a>	Y	15
Maximum_Annual_Mean_Flow	48	cubic feet per second	<a href="#">325</a>	Y	15
Minimum_Annual_Mean_Flow	5.4	cubic feet per second	<a href="#">325</a>	Y	15

**Monthly Flow Statistics**

January_Mean_Flow	59.950	cubic feet per second	<a href="#">31</a>	Y	
January_STD	56.320	cubic feet per second	<a href="#">31</a>	Y	
February_Mean_Flow	67.600	cubic feet per second	<a href="#">31</a>	Y	
February_STD	62.210	cubic feet per second	<a href="#">31</a>	Y	
March_Mean_Flow	35.510	cubic feet per second	<a href="#">31</a>	Y	
March_STD	29.130	cubic feet per second	<a href="#">31</a>	Y	
April_Mean_Flow	26.460	cubic feet per second	<a href="#">31</a>	Y	
April_STD	39.280	cubic feet per second	<a href="#">31</a>	Y	
May_Mean_Flow	5.8300	cubic feet per second	<a href="#">31</a>	Y	
May_STD	4.0000	cubic feet per second	<a href="#">31</a>	Y	
June_Mean_Flow	1.7800	cubic feet per second	<a href="#">31</a>	Y	
June_STD	1.4800	cubic feet per second	<a href="#">31</a>	Y	
October_Mean_Flow	3.0600	cubic feet per second	<a href="#">31</a>	Y	
October_STD	9.9600	cubic feet per second	<a href="#">31</a>	Y	
November_Mean_Flow	3.1100	cubic feet per second	<a href="#">31</a>	Y	
November_STD	3.2300	cubic feet per second	<a href="#">31</a>	Y	
December_Mean_Flow	35.640	cubic feet per second	<a href="#">31</a>	Y	
December_STD	57.720	cubic feet per second	<a href="#">31</a>	Y	

**General Flow Statistics**

Minimum_daily_flow	0	cubic feet per second	<a href="#">325</a>	Y	15
Maximum_daily_flow	1490	cubic feet per second	<a href="#">325</a>	Y	15
Std_Dev_of_daily_flows	70	cubic feet per second	<a href="#">325</a>	Y	15
Average_daily_streamflow	19.117	cubic feet per second	<a href="#">41</a>	Y	15
Harmonic_Mean_Streamflow	0.54	cubic feet per second	<a href="#">325</a>	Y	15
Mean_of_Logs_of_Daily_Values	0.569818	Log base 10	<a href="#">325</a>	Y	15
Std_Dev_of_Logs_of_Daily_Values	0.889695	Log base 10	<a href="#">325</a>	Y	15
Skew_of_Logs_of_Daily_Values	0.045182	Log base 10	<a href="#">325</a>	Y	15
Non_Zero_Adjusted_Harmonic_Mean_Flow	0.68	cubic feet per second	<a href="#">325</a>	Y	15

**Base Flow Statistics**

Number_of_years_to_compute_BFI	15	years	<a href="#">42</a>	Y	15
Average_BFI_value	0.301	dimensionless	<a href="#">42</a>	Y	15
Std_dev_of_annual_BFI_values	0.096	dimensionless	<a href="#">42</a>	Y	15

**Probability Statistics**Probability\_flow\_durations\_are\_zero 0.20752 dimensionless [325](#) Y 15

---

**Citations**

---

<b>Citation Number</b>	<b>Citation Name and URL</b>
31	Imported from Basin Characteristics file
41	<a href="#">Wolock, D.M., 2003, Flow characteristics at U.S. Geological Survey streamgages in the conterminous United States: U.S. Geological Survey Open-File Report 03-146, digital data set</a>
42	<a href="#">Wolock, D.M., 2003, Base-flow index grid for the conterminous United States: U.S. Geological Survey Open-File Report 03-263, digital data set</a>
230	<a href="#">Gotvald, A.J., Barth, N.A., Veilleux, A.G., and Parrett, Charles, 2012, Methods for determining magnitude and frequency of floods in California, based on data through water year 2006: U.S. Geological Survey Scientific Investigations Report 2012-5113, 38 p., 1 pl.</a>
325	<a href="#">Granato G.E., Ries, K.G., III, and Steeves, P.A., 2017, Compilation of streamflow statistics calculated from daily mean streamflow data collected during water years 1901-2015 for selected U.S. Geological Survey streamgages: U.S. Geological Survey Open-File Report 2017-1108, 17 p.</a>

---

**Attachment 2: CalTrans As-Built Bridge Plans**

*California Department of Transportation  
Division of Maintenance*

*Structure Maintenance and Investigations*

---

**B**<sub>RIDGE</sub>

**I**<sub>NSPECTION</sub>

**R**<sub>ECORDS</sub>

**I**<sub>NFORMATION</sub>

**S**<sub>YSTEM</sub>




---

The requested documents have been generated by BIRIS.

These documents are the property of the California Department of Transportation and should be handled in accordance with Deputy Directive 55 and the State Administrative Manual.

Records for “Confidential” bridges may only be released outside the Department of Transportation upon execution of a confidentiality agreement.




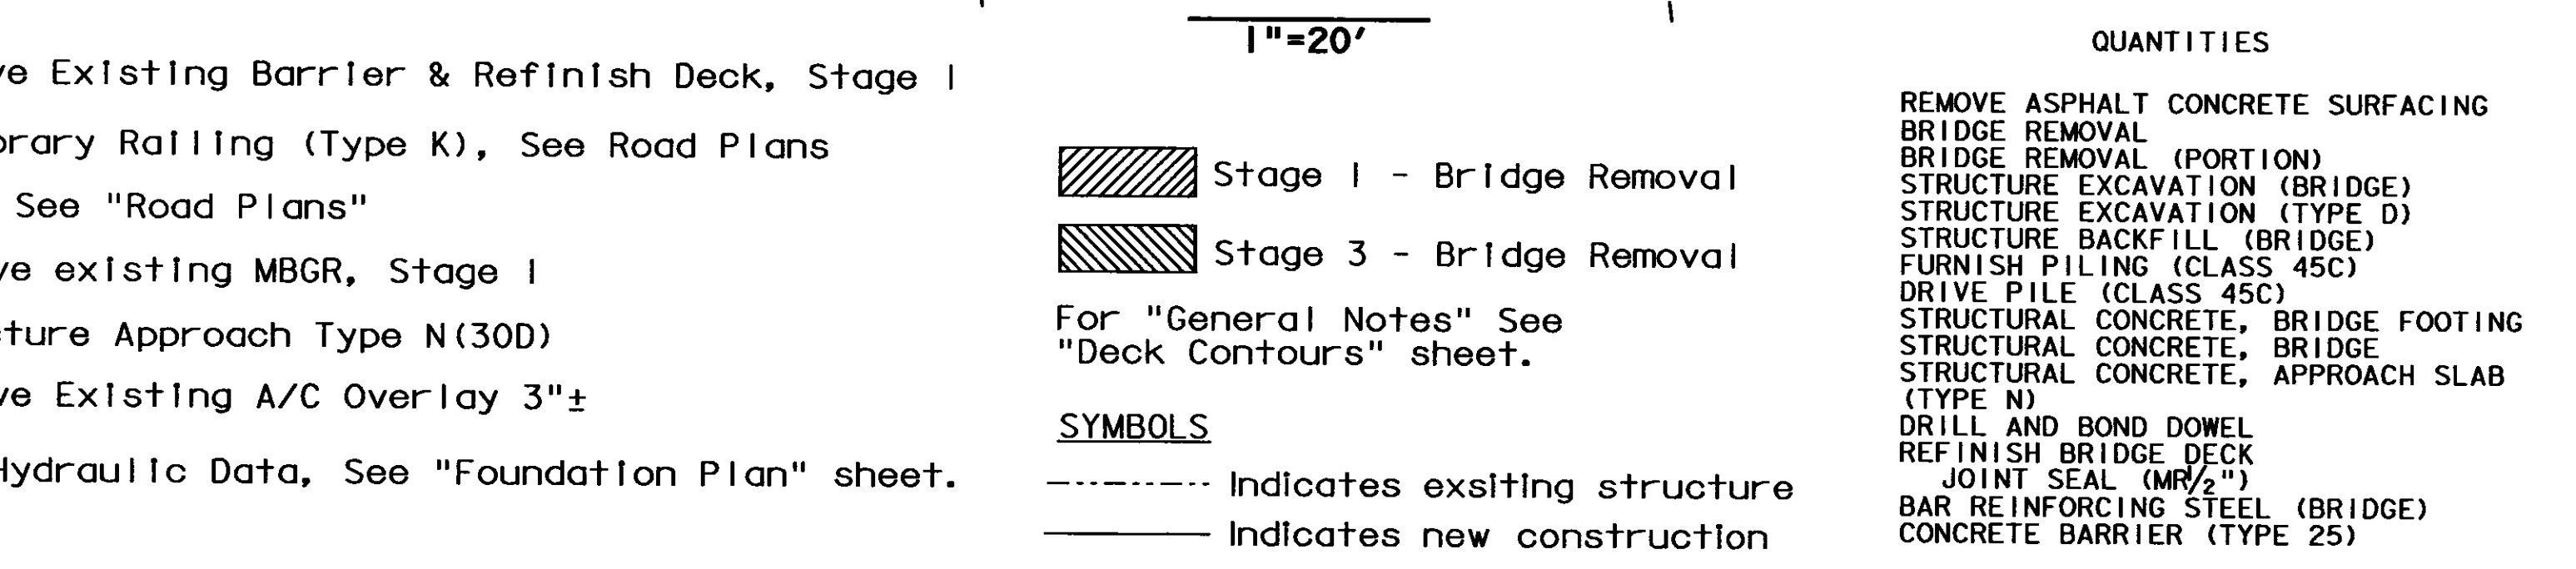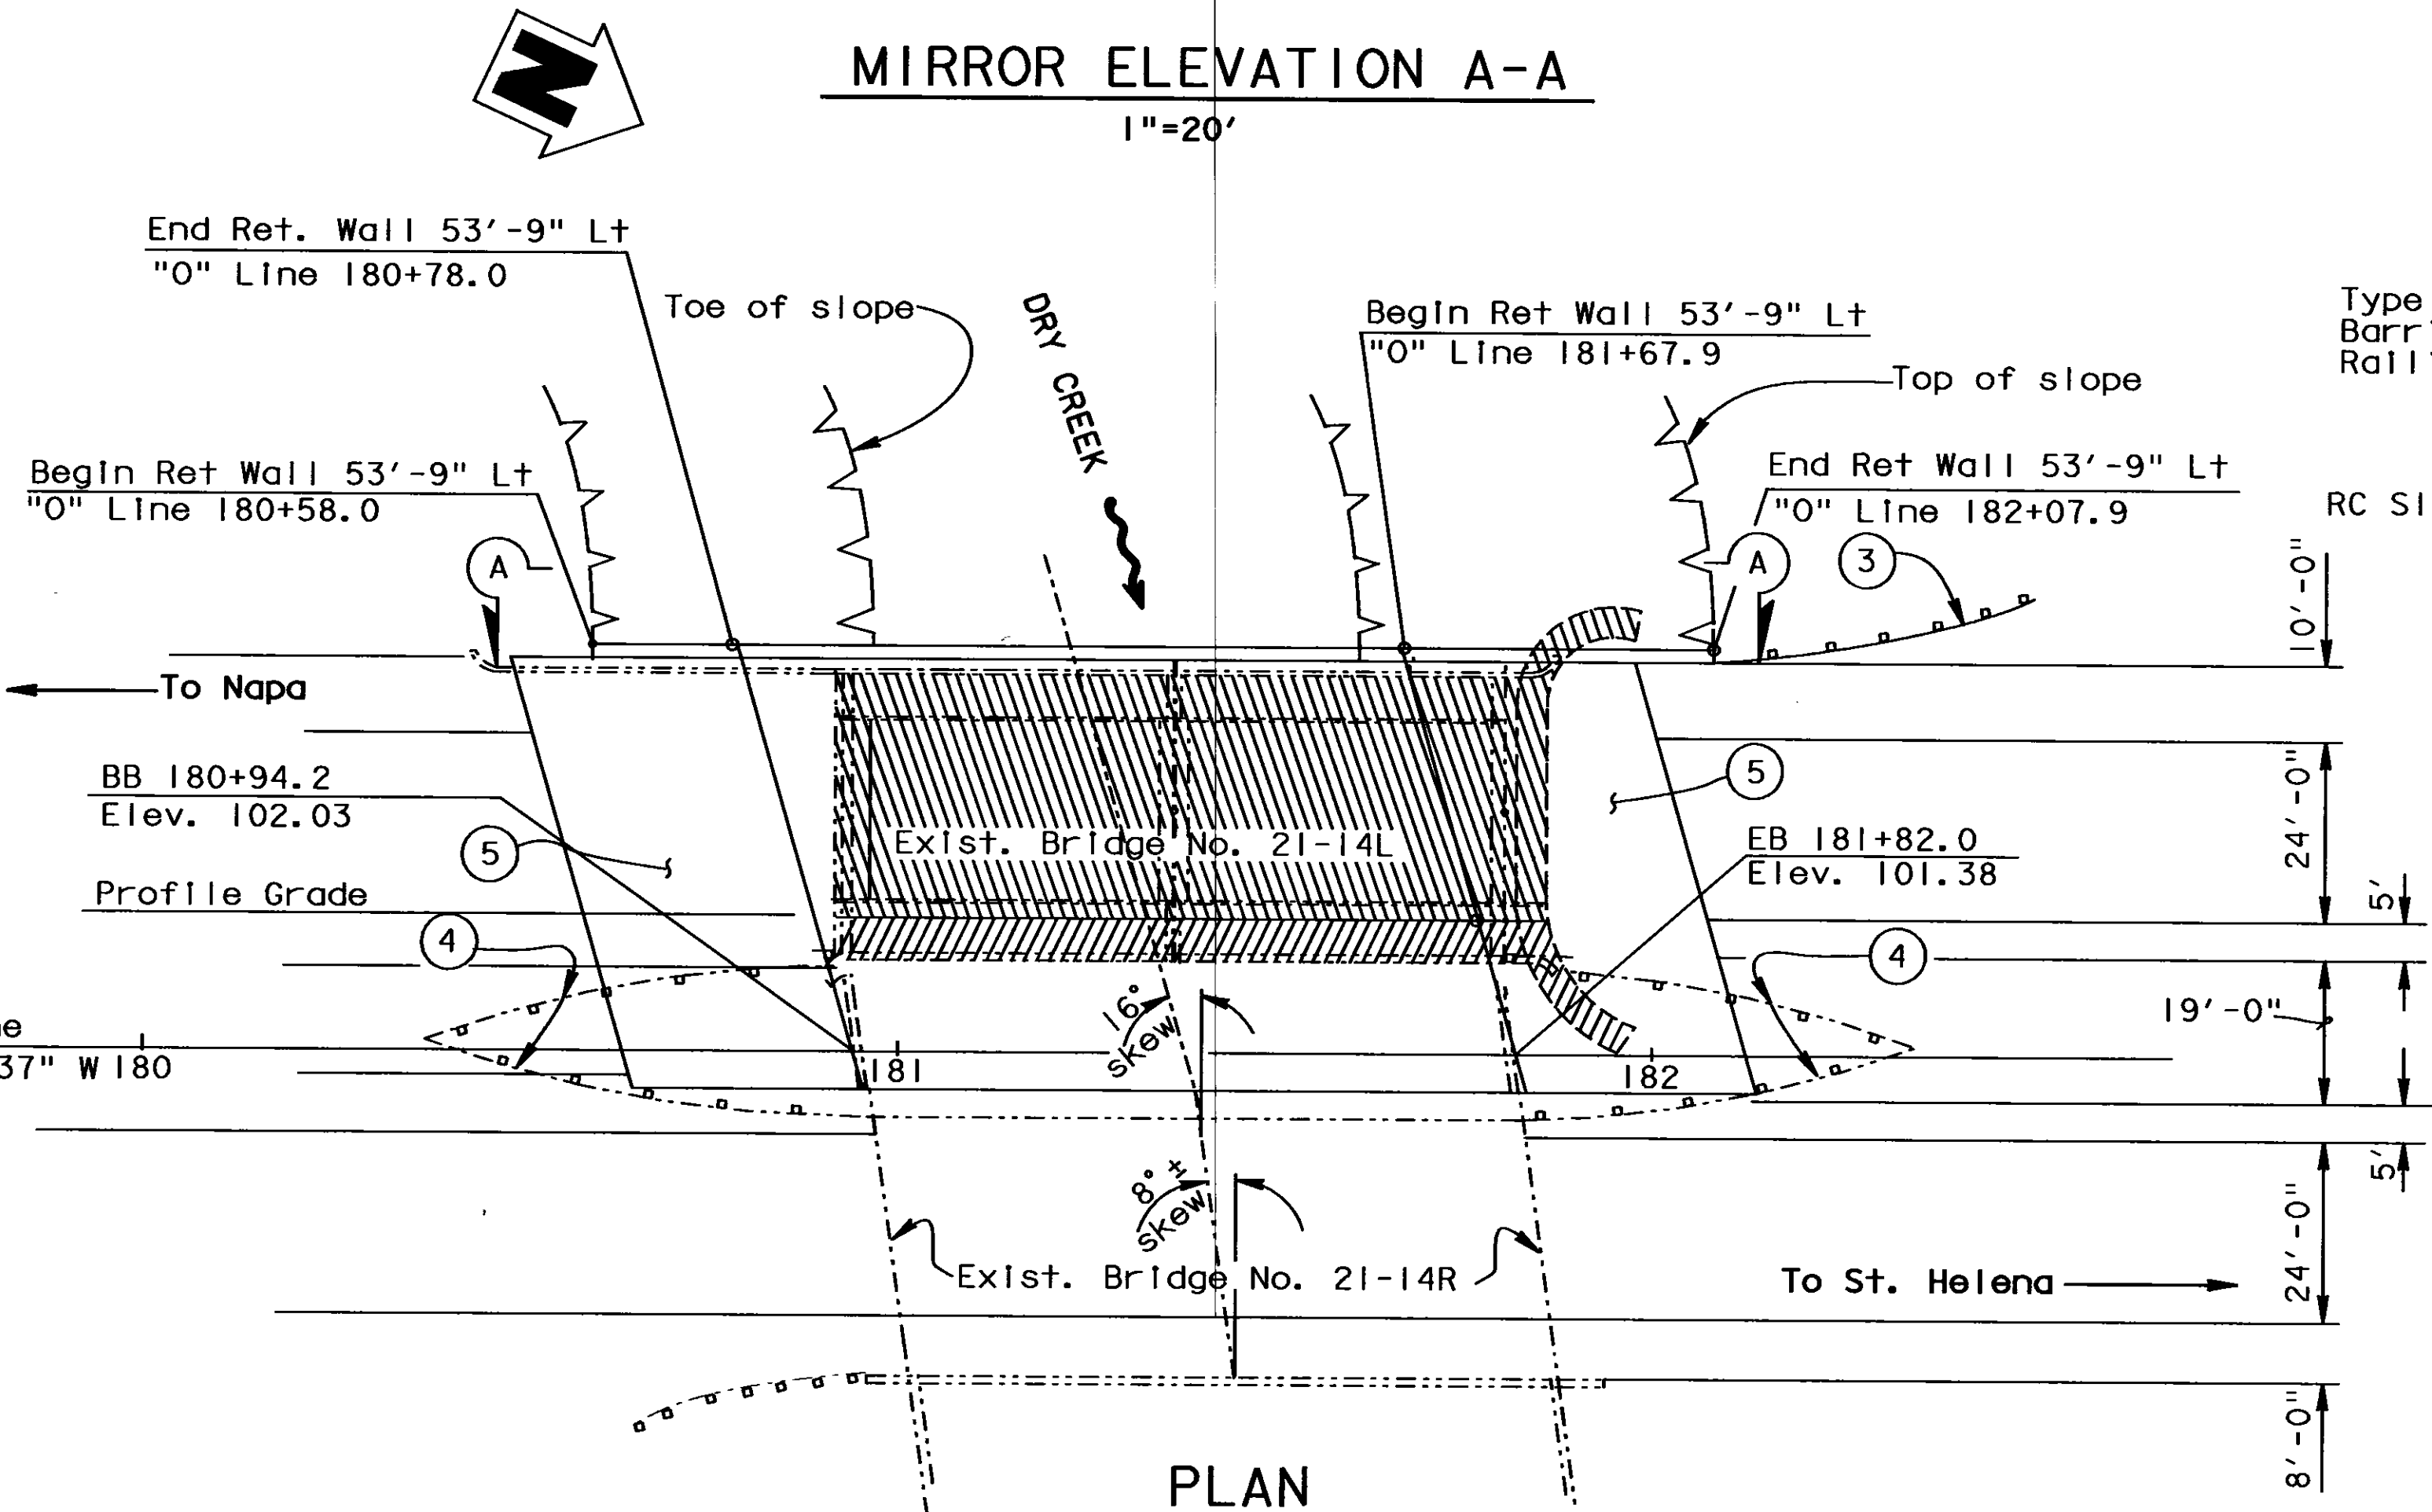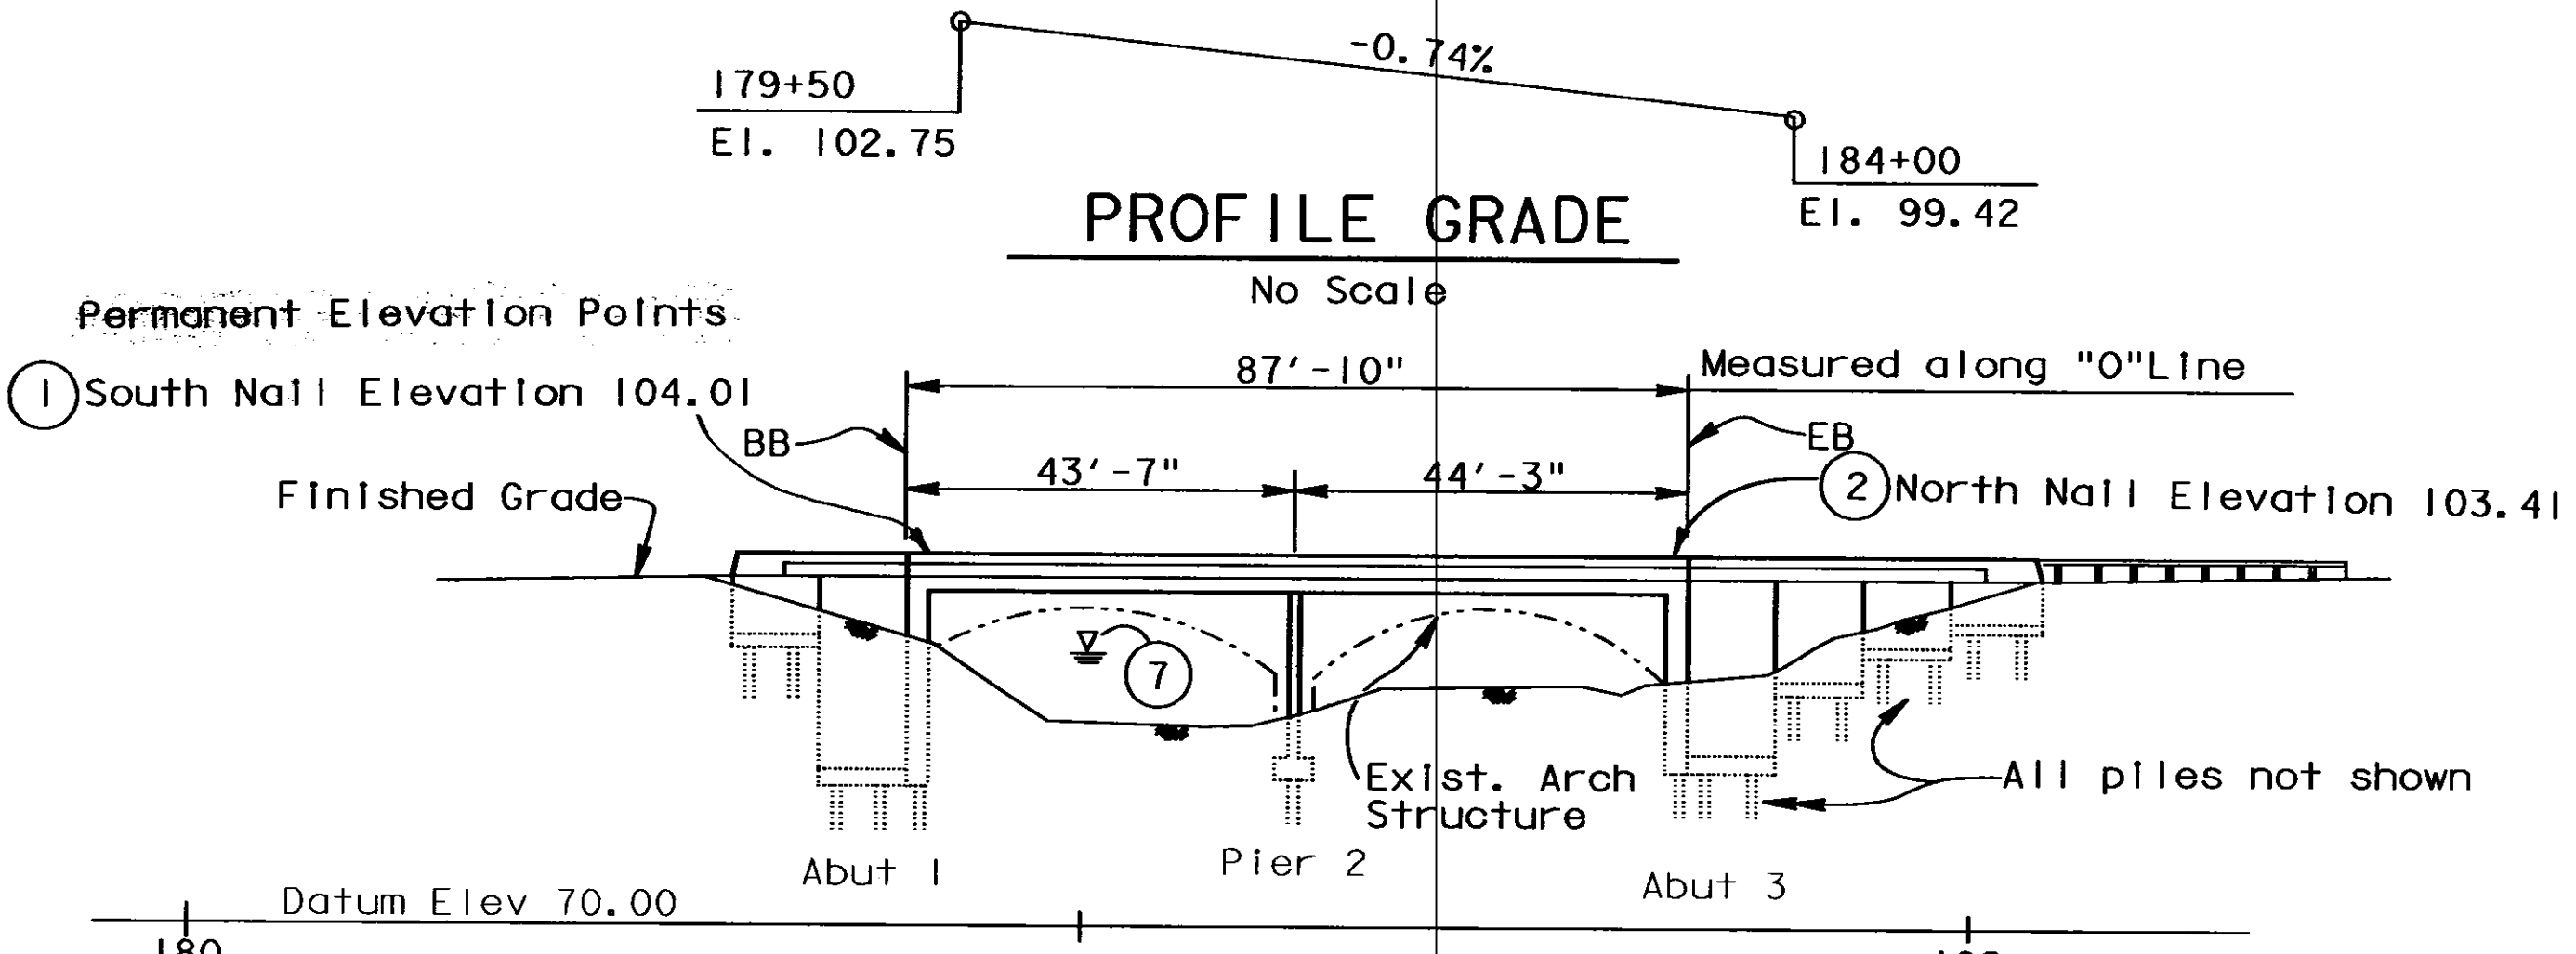

### PILE DATA

LOCATION	DESIGN LOADING (SERVICE)	NOMINAL RESISTANCE		DESIGN TIP ELEVATION (a), (c)&(d)	SPECIFIED TIP ELEVATION
		COMPRESSION	TENSION		
Abut 1	45 tons	180 kips	0 kips	40.0	40.0
Pier 2	45 tons	180 kips	90 kips	40.0	40.0
Abut 3	45 tons	180 kips	0 kips	40.0	40.0
Retaining Wall	45 tons	180 kips	0 kips	40.0	40.0

Design tip elevation is controlled by the following demands:  
 (a) Compression; (c) Lateral Loads; (d) Scour potential to Elevation 78.0

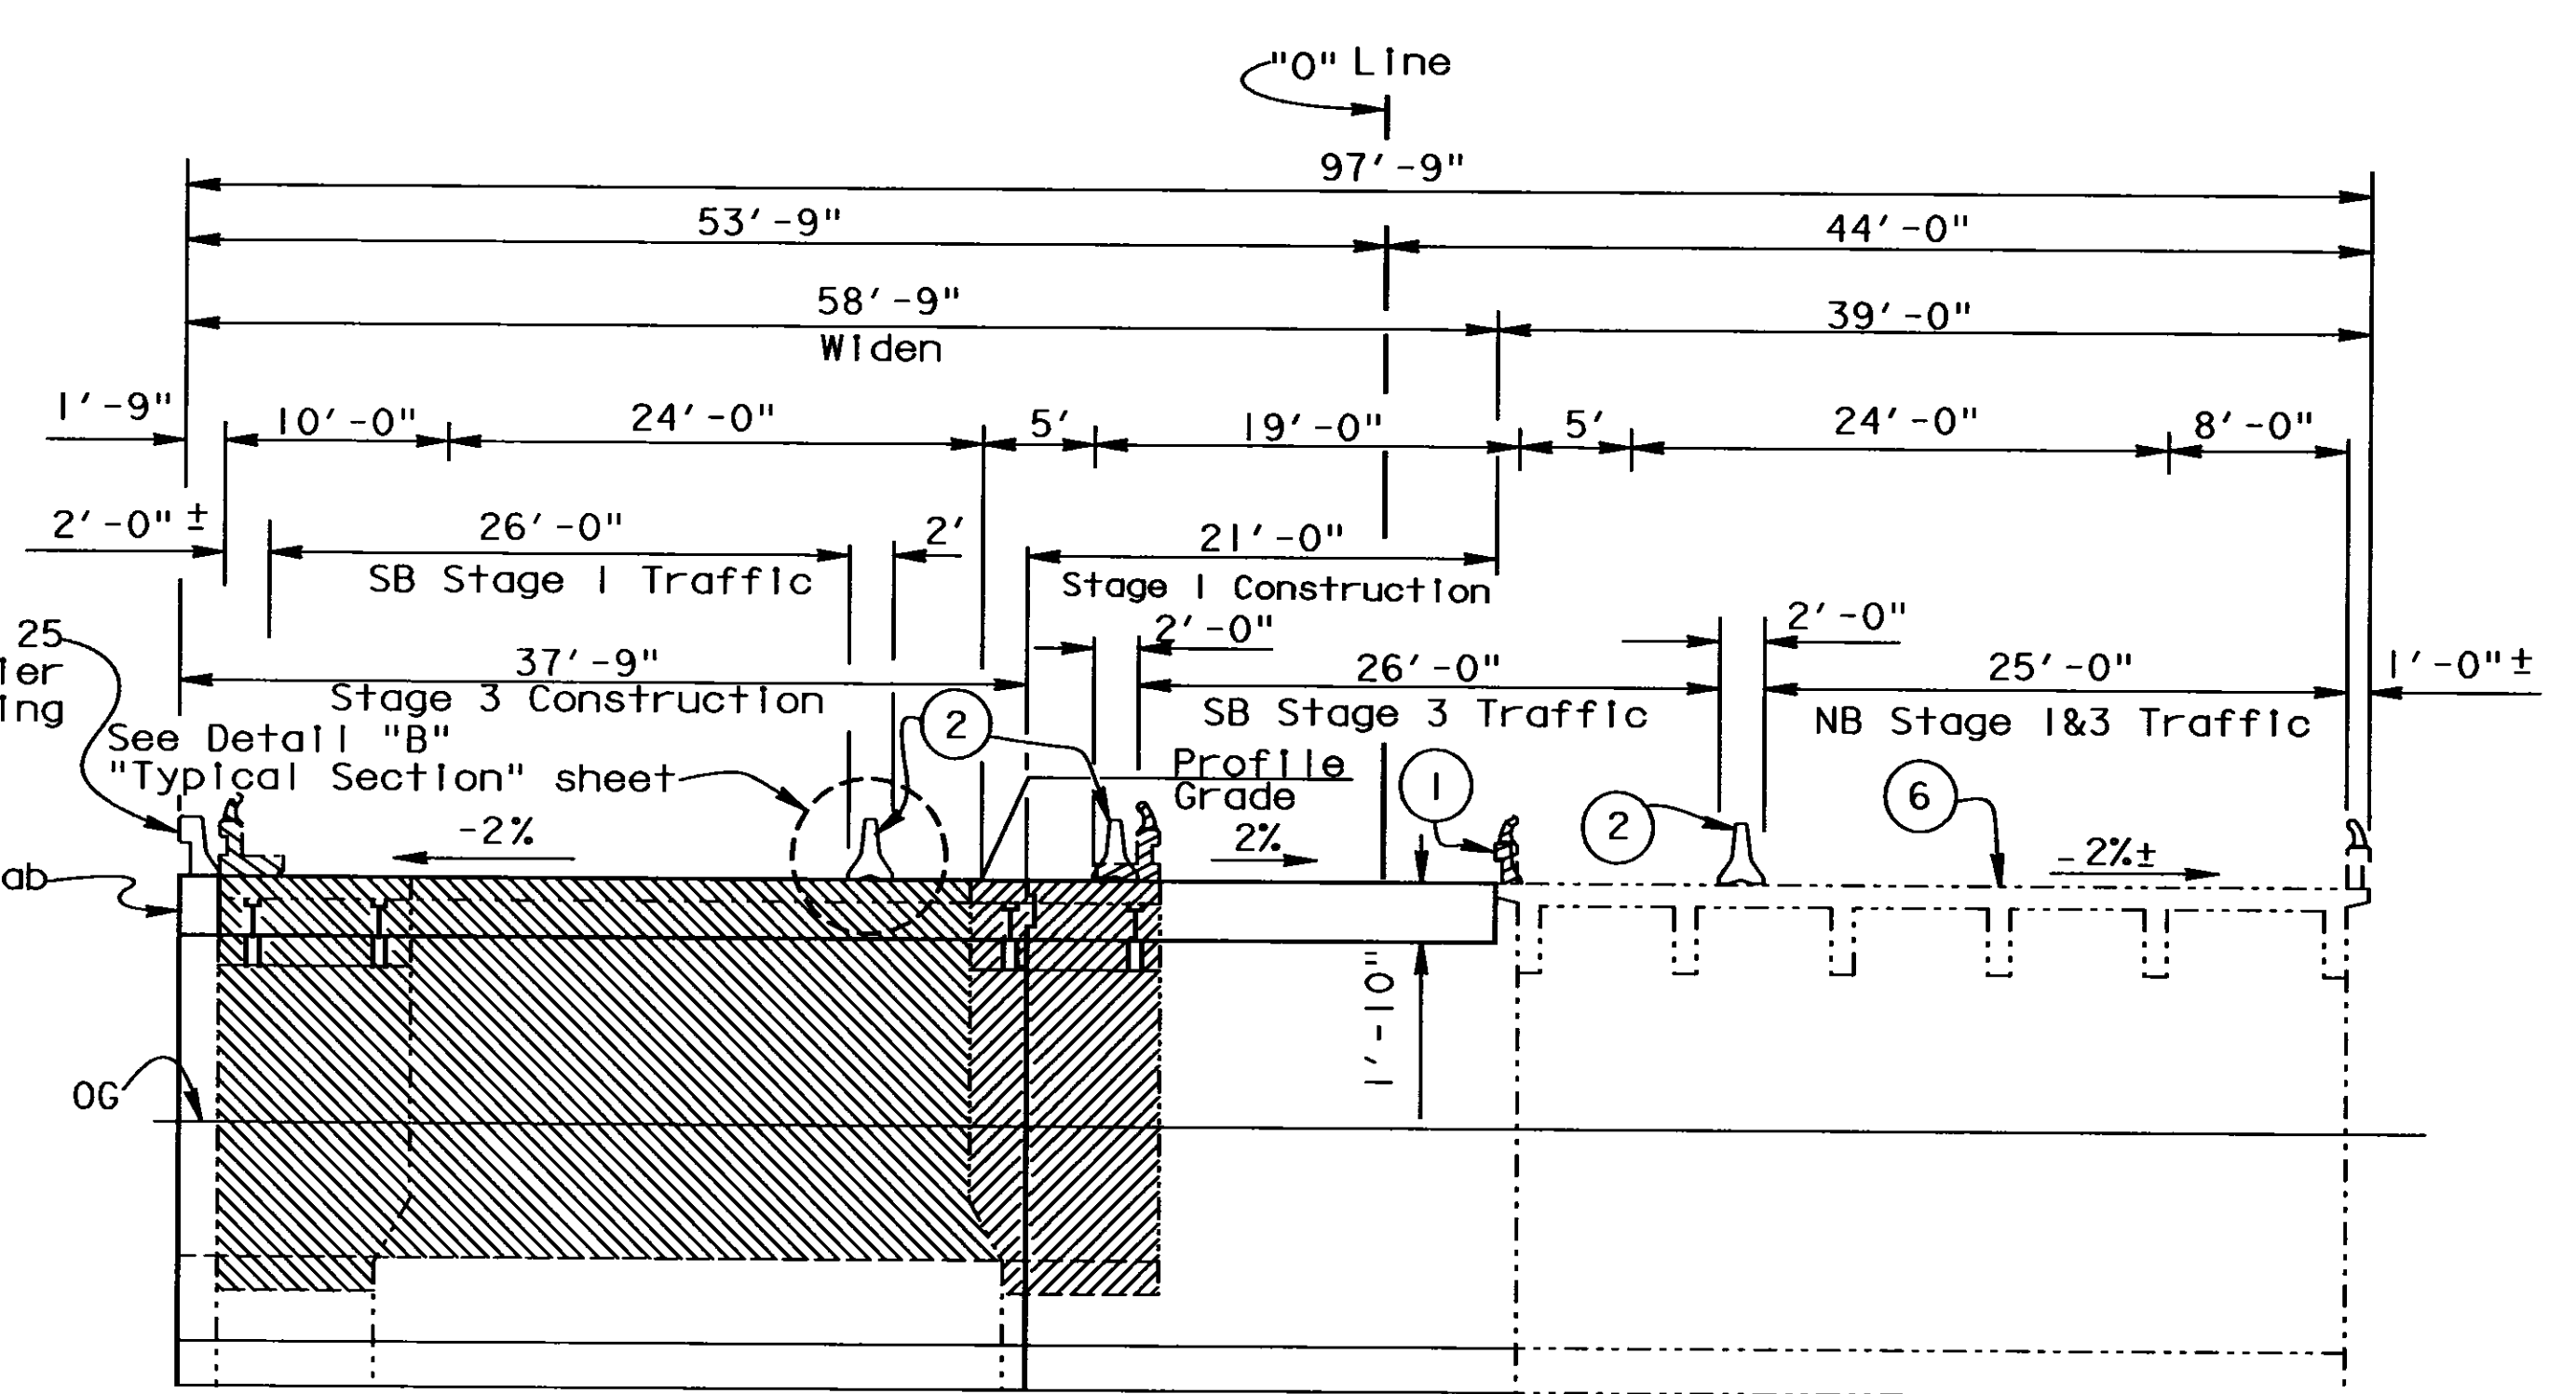

**TYPICAL SECTION**  
 1/8" = 1'-0"

INDEX TO PLANS		STANDARD PLANS DATED JULY 1992	
SHEET NO.	TITLE	Code	Description
1.	GENERAL PLAN	A10A	ABBREVIATIONS
2.	DECK CONTOURS	A10B	SYMBOLS
3.	FOUNDATION PLAN	A62C	LIMITS OF PAYMENT FOR EXCAVATION AND BACKFILL-BRIDGE
4.	ABUTMENT LAYOUT		
5.	ABUTMENT DETAILS	B0-1	BRIDGE DETAILS
6.	PIER DETAILS	B0-3	BRIDGE DETAILS
7.	TYPICAL SECTION	B0-5	BRIDGE DETAILS
8.	SLAB REINFORCEMENT	B2-8	PILE DETAILS CLASS 45C AND CLASS 70C
9.	SLAB REINFORCEMENT DETAILS	B3-1	RETAINING WALL TYPE 1 H=4" 30"
10.	RETAINING WALLS DETAILS	B3-8	RETAINING WALL DETAILS NO. 1
11.	MISCELLANEOUS DETAILS	B6-21	JOINT SEALS (MAX. MOVEMENT RATING=2"
12.	BRIDGE REMOVAL DETAILS NO. 1	B11-53	CONCRETE BARRIER TYPE 25
13.	BRIDGE REMOVAL DETAILS NO. 2		
14.	STRUCTURE APPROACH TYPE N (30D)		
15.	DRAINAGE DETAILS		
16.	LOG OF TEST BORINGS		

**AS BUILT**

CORRECTIONS BY *Michael Aswad / G. Sarik*  
 CONTRACT NO. *0-4-149304*  
 DATE *12-08-97* *3-2-98*

Notes:  
 The contractor shall verify all controlling field dimensions before ordering or fabricating any material

- NOTES:
- Remove Existing Barrier & Refinish Deck, Stage 1
  - Temporary Railing (Type K), See Road Plans
  - MBGR See "Road Plans"
  - Remove existing MBGR, Stage 1
  - Structure Approach Type N(30D)
  - Remove Existing A/C Overlay 3"±
  - For Hydraulic Data, See "Foundation Plan" sheet.

- Stage 1 - Bridge Removal
- Stage 3 - Bridge Removal

For "General Notes" See "Deck Contours" sheet.

SYMBOLS

--- Indicates existing structure

— Indicates new construction

QUANTITIES

REMOVE ASPHALT CONCRETE SURFACING	353	SOYD
BRIDGE REMOVAL	LUMP	SUM
BRIDGE REMOVAL (PORTION)	LUMP	SUM
STRUCTURE EXCAVATION (BRIDGE)	128	CY
STRUCTURE EXCAVATION (TYPE D)	664	CY
STRUCTURE BACKFILL (BRIDGE)	395	CY
FURNISH PILING (CLASS 45C)	2,933	LF
DRIVE PILE (CLASS 45C)	68	EA
STRUCTURAL CONCRETE, BRIDGE FOOTING	80	CY
STRUCTURAL CONCRETE, BRIDGE	582	CY
STRUCTURAL CONCRETE, APPROACH SLAB (TYPE N)	127	CY
DRILL AND BOND DOWEL	94	LF
REFINISH BRIDGE DECK	172	SQFT
JOINT SEAL (MR2")	118	LF
BAR REINFORCING STEEL (BRIDGE)	128,200	LB
CONCRETE BARRIER (TYPE 25)	148	LF


DESIGN ENGINEER <i>Garry L. Tolen</i>	DESIGNS BY Garry L. Tolen 3-96 CHECKED Mike Whiteside 5-96 DETAILS BY Janice Sam 3-96 CHECKED Mike Whiteside 5-96 QUANTITIES BY Garry L. Tolen 6-96 CHECKED Kristi Westoby 6-96	LOAD FACTOR DESIGN LIVE LOADING HS 20-44 AND ALTERNATIVE AND PERMIT DESIGN LOAD LAYOUT BY Garry L. Tolen CHECKED Mike Whiteside 5-96 SPECIFICATIONS BY CHECKED Kristi Westoby 6-96 PLANS AND SPECS COMPARED	STATE OF CALIFORNIA DEPARTMENT OF TRANSPORTATION	DISTRICT 2 SEISMIC DESIGN	BRIDGE NO. 21-0014 POST MILE 16.5	<b>EARTHQUAKE RETROFIT PROJECT NO. 412</b> <b>DRY CREEK BRIDGE</b> <b>GENERAL PLAN</b>	
FOR REDUCED PLANS ORIGINAL SCALE IS IN INCHES			CU 04 EA 149301	DISREGARD PRINTS BEARING EARLIER REVISION DATES			SHEET 1 OF 16

DATE PLOTTED => 18-Nov-1998 TIME PLOTTED => 06:59



DIST.	COUNTY	ROUTE	POST MILES TOTAL PROJECT	SHEET NO.	TOTAL SHEETS
04	Nap	29	16.3/16.7	54	68

*Garry Tolen*  
REGISTERED ENGINEER - CIVIL

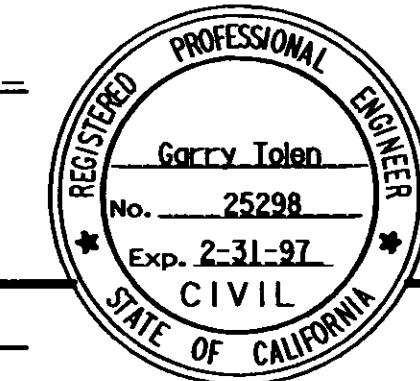

11-18-96  
PLANS APPROVAL DATE

The State of California or its officers or agents shall not be responsible for the accuracy or completeness of electronic copies of this plan sheet.

### GENERAL NOTES LOAD FACTOR DESIGN

DESIGN: BRIDGE DESIGN SPECIFICATIONS  
(1983 AASHTO with Interims and Revisions by CALTRANS)

DEAD LOAD: Includes 35 psf for future wearing surface.


LIVE LOADING: HS20-44 and alternative and permit design load.

SEISMIC LOADING: Peak Rock Acceleration = 0.6 g  
Depth of Alluvium = 80-150 ft.

REINFORCED CONCRETE:  $f_y = 60,000$  psi  
 $f'_c = 4,000$  psi  
 $n = 9$

NOTES:

- Indicates Even Foot Contours
  - X 10' Intervals along Station Line  
Contours do not include Camber  
Barrier Rail and Deck Drains not shown.
- RWLOL= Retaining Wall Layout Line

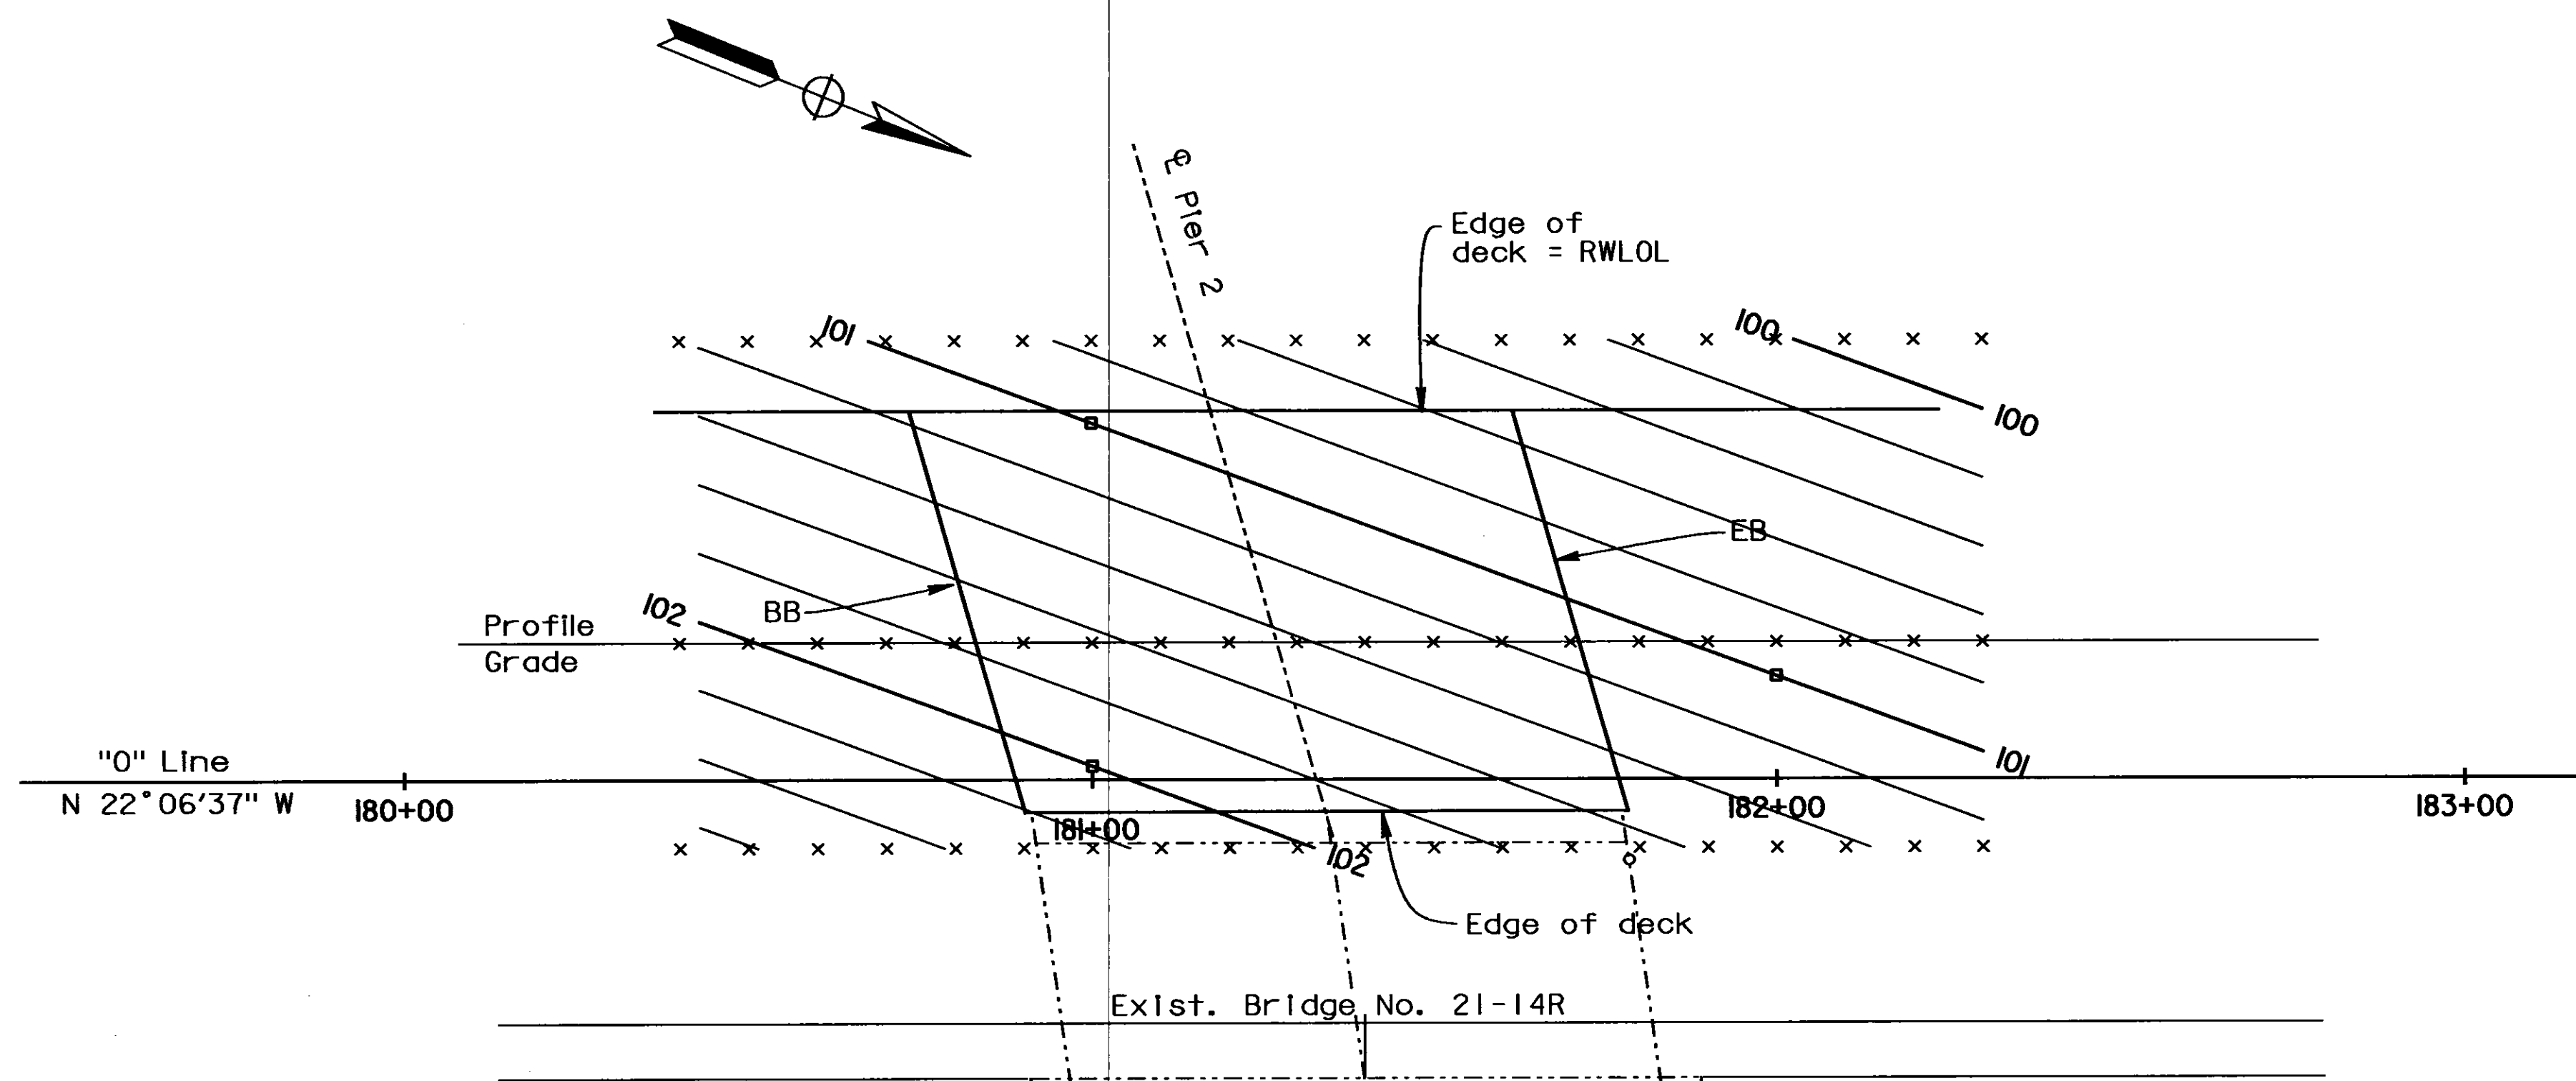

**PLAN**  
1" = 20'

*No Changes*  
**AS BUILT**  
CORRECTIONS BY *Michael Assad*  
CONTRACT NO. *04-149304*  
DATE *12-08-97* *3-2-98*

**EARTHQUAKE RETROFIT PROJECT NO. 412**

DESIGN	BY Garry Tolen	3-96	CHECKED Mike Whiteside	5-96
DETAILS	BY JF Casarino	3-96	CHECKED Mike Whiteside	5-96
QUANTITIES	BY Garry Tolen	3-96	CHECKED Kristi Westoby	5-96

**STATE OF CALIFORNIA**  
DEPARTMENT OF TRANSPORTATION

**DISTRIC 2**  
**SEISMIC DESIGN**

BRIDGE NO.	21-0014
POST MILE	16.5

**DRY CREEK BRIDGE**  
**DECK CONTOURS**


DIST	COUNTY	ROUTE	POST MILES TOTAL PROJECT	SHEET NO.	TOTAL SHEETS
04	Nap	29	16.3/16.7	55	68

*Garry L. Tolen*  
 REGISTERED ENGINEER-CIVIL

Garry Tolen  
 No. 25298  
 Exp. 12-31-97  
 CIVIL  
 STATE OF CALIFORNIA

11-18-96  
 PLANS APPROVAL DATE

The State of California or its officers or agents shall not be responsible for the accuracy or completeness of electronic copies of this plan sheet.

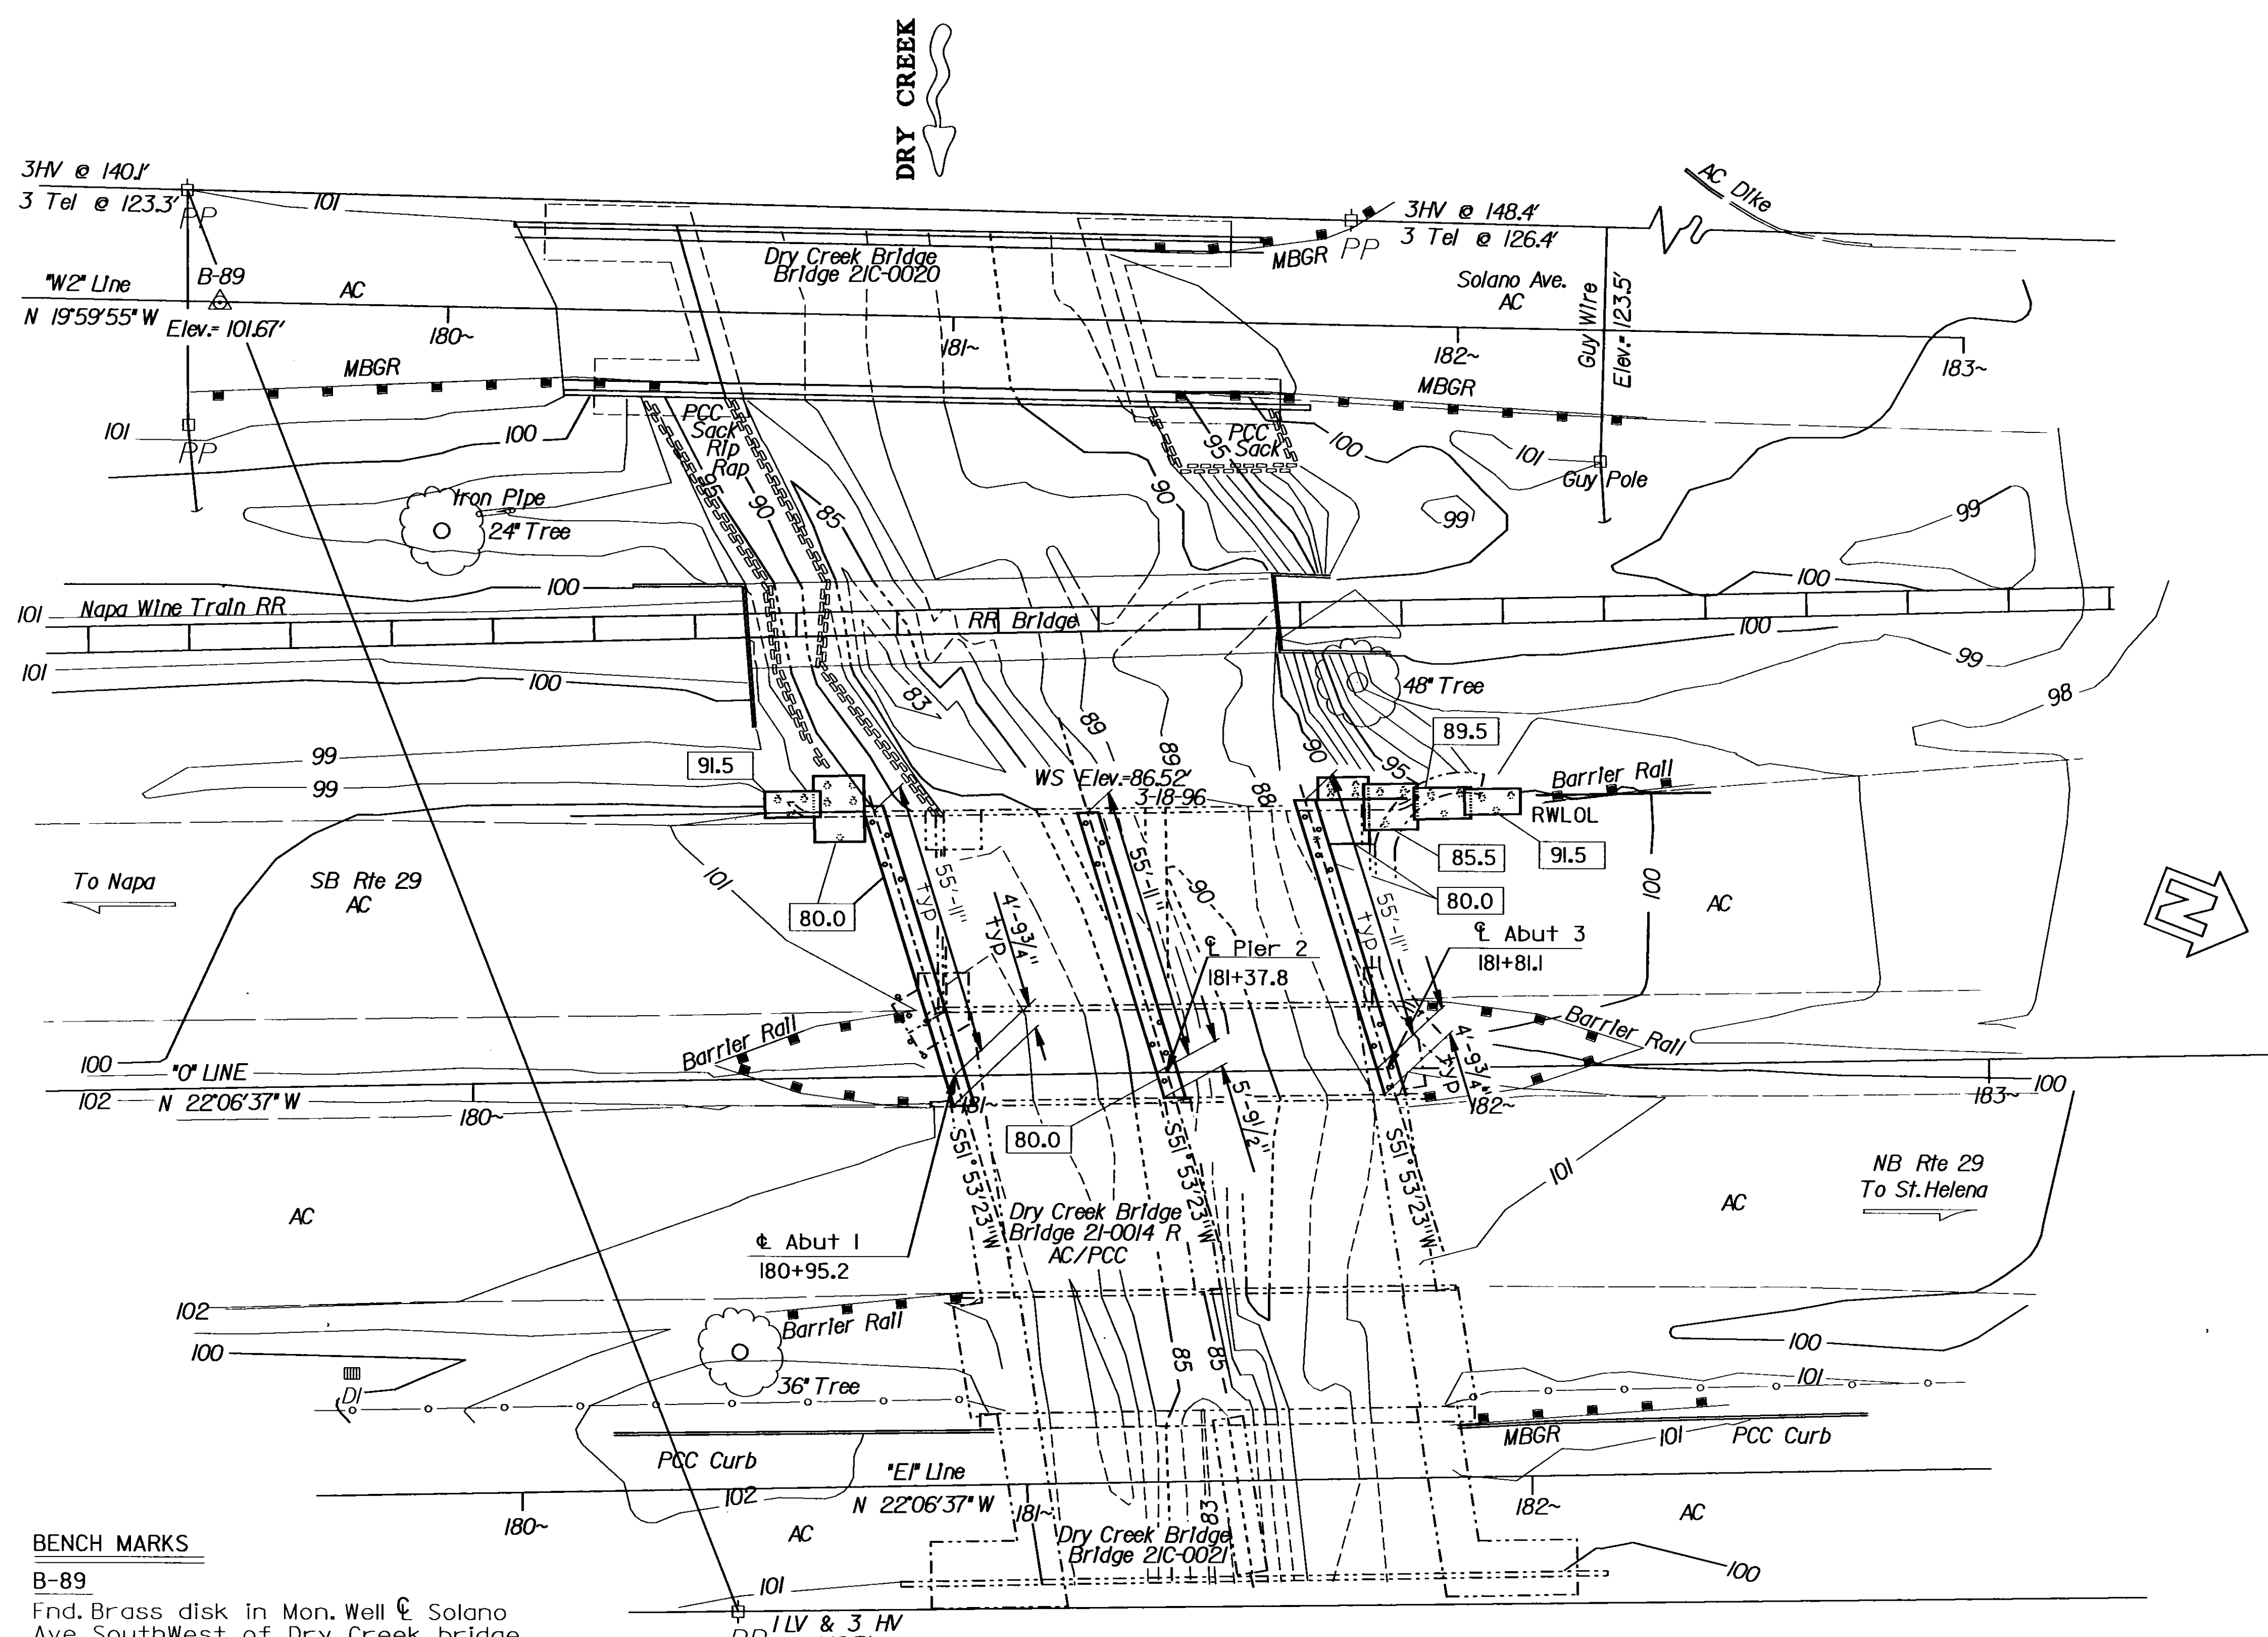

The Streambed Elevation on 11-26-97 was 86.76' Considering the Dry Bench Mark

**AS BUILT** *G. Sam*  
 CORRECTIONS BY *Michael Assad*  
 CONTRACT NO. *04-149304*  
 DATE *12-08-97* *3-2-98*

**HYDROLOGIC SUMMARY**

DRAINAGE AREA: 18.8 SQUARE MILES

FREQUENCY (YEARS)	DESIGN FLOOD	BASE FLOOD	OVERTOPPING FLOOD
50	3600	4000	5400 Est.
DISCHARGE (CUBIC FEET PER SECOND)	3600	4000	5400 ±
WATER SURFACE (ELEVATION AT BRIDGE)	96.0	97.0	99.0 ±

FLOOD PLAIN DATA ARE BASED UPON INFORMATION AVAILABLE WHEN THE PLANS WERE PREPARED AND ARE SHOWN TO MEET FEDERAL REQUIREMENTS. THE ACCURACY OF SAID INFORMATION IS NOT WARRANTED BY THE STATE AND INTERESTED OR AFFECTED PARTIES SHOULD MAKE THEIR OWN INVESTIGATION.

**BENCH MARKS**

B-89  
 Fnd. Brass disk in Mon. Well @ Solano Ave. SouthWest of Dry Creek bridge. 155.59' Lt. "0" Line 179+52.63  
 El.=101.67'

DRY  
 Fnd. Bronze disk 41.6' SW of @ Rte. 29 19.0' NE of @ Solano Ave. 11.6' NE of the NE rail of the Napa Wine Train RR tracks.  
 El.=100.13'

**PLAN**  
 1" = 20'

NOTE:  
 [Symbol] Indicates bottom of footing elevation.

PRELIMINARY INVESTIGATION SECTION				DESIGN BY Garry L. Tolen 3-96	CHECKED Mike Whiteside 5-96	STATE OF CALIFORNIA DEPARTMENT OF TRANSPORTATION	DISTRICT 2 SEISMIC DESIGN	BRIDGE NO. 21-0014	EARTHQUAKE RETROFIT PROJECT NO. 412 DRY CREEK BRIDGE FOUNDATION PLAN
SCALE 1" = 20'	DATUM NGVD 1929 (Ad J 1951)	PHOTOGRAMMETRY AS OF: SURVEYED BY EWL 3/96	DRAWN BY EWL 3/96	DETAILS BY JFCasario 6-96	CHECKED Mike Whiteside 5-96			POST MILE 16.5	
ALIGNMENT TIES As Built	FIELD CHECKED BY	TRACED BY EWL 4/96	CHECKED BY PJC 4/96	QUANTITIES BY Garry L. Tolen 6-96	CHECKED Kristi Westoby 6-96	CU 04 EA 149301	REVISION DATES (PRELIMINARY STAGE ONLY)	SHEET 3 OF 16	

ORIGINAL SCALE IN INCHES FOR REDUCED PLANS 0 1 2 3

DISREGARD PRINTS BEARING EARLIER REVISION DATES

USERNAME => trpauld  
 DGN FILE => [ESC-OE]Jaafnd.psf

DATE PLOTTED => 18-NOV-1998  
 TIME PLOTTED => 07:00





DIST.	COUNTY	ROUTE	POST MILES TOTAL PROJECT	SHEET NO.	TOTAL SHEETS
04	Nap	29	16.3/16.7	56	68

*Garry Tolen*  
REGISTERED ENGINEER - CIVIL


**PROFESSIONAL ENGINEER**  
Garry Tolen  
No. 25298  
Exp. 12-31-97  
CIVIL  
STATE OF CALIFORNIA

11-18-96  
PLANS APPROVAL DATE

The State of California or its officers or agents shall not be responsible for the accuracy or completeness of electronic copies of this plan sheet.

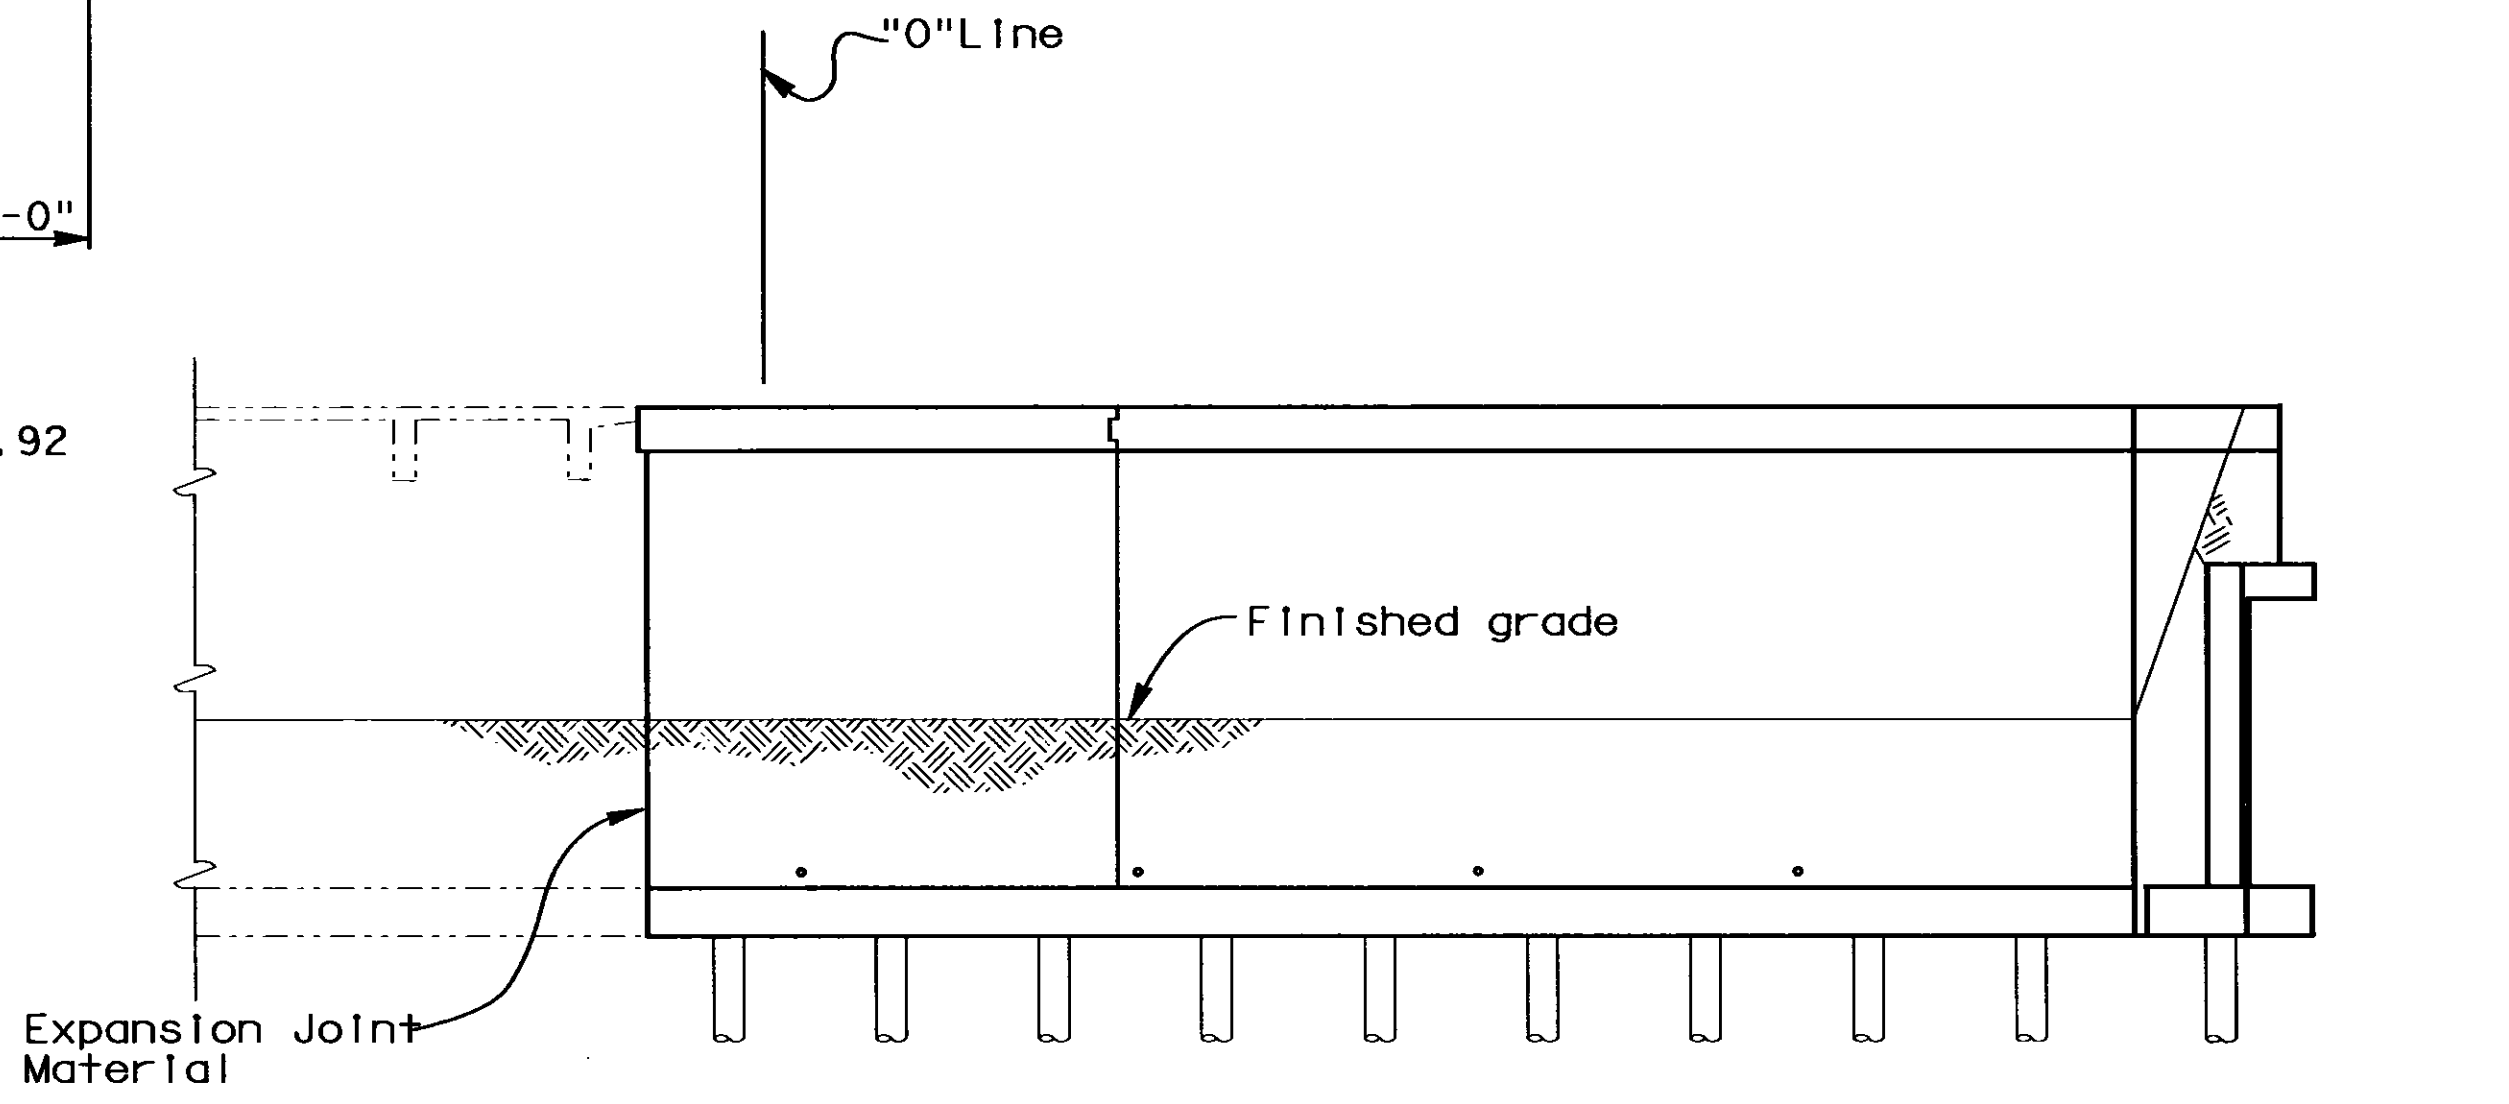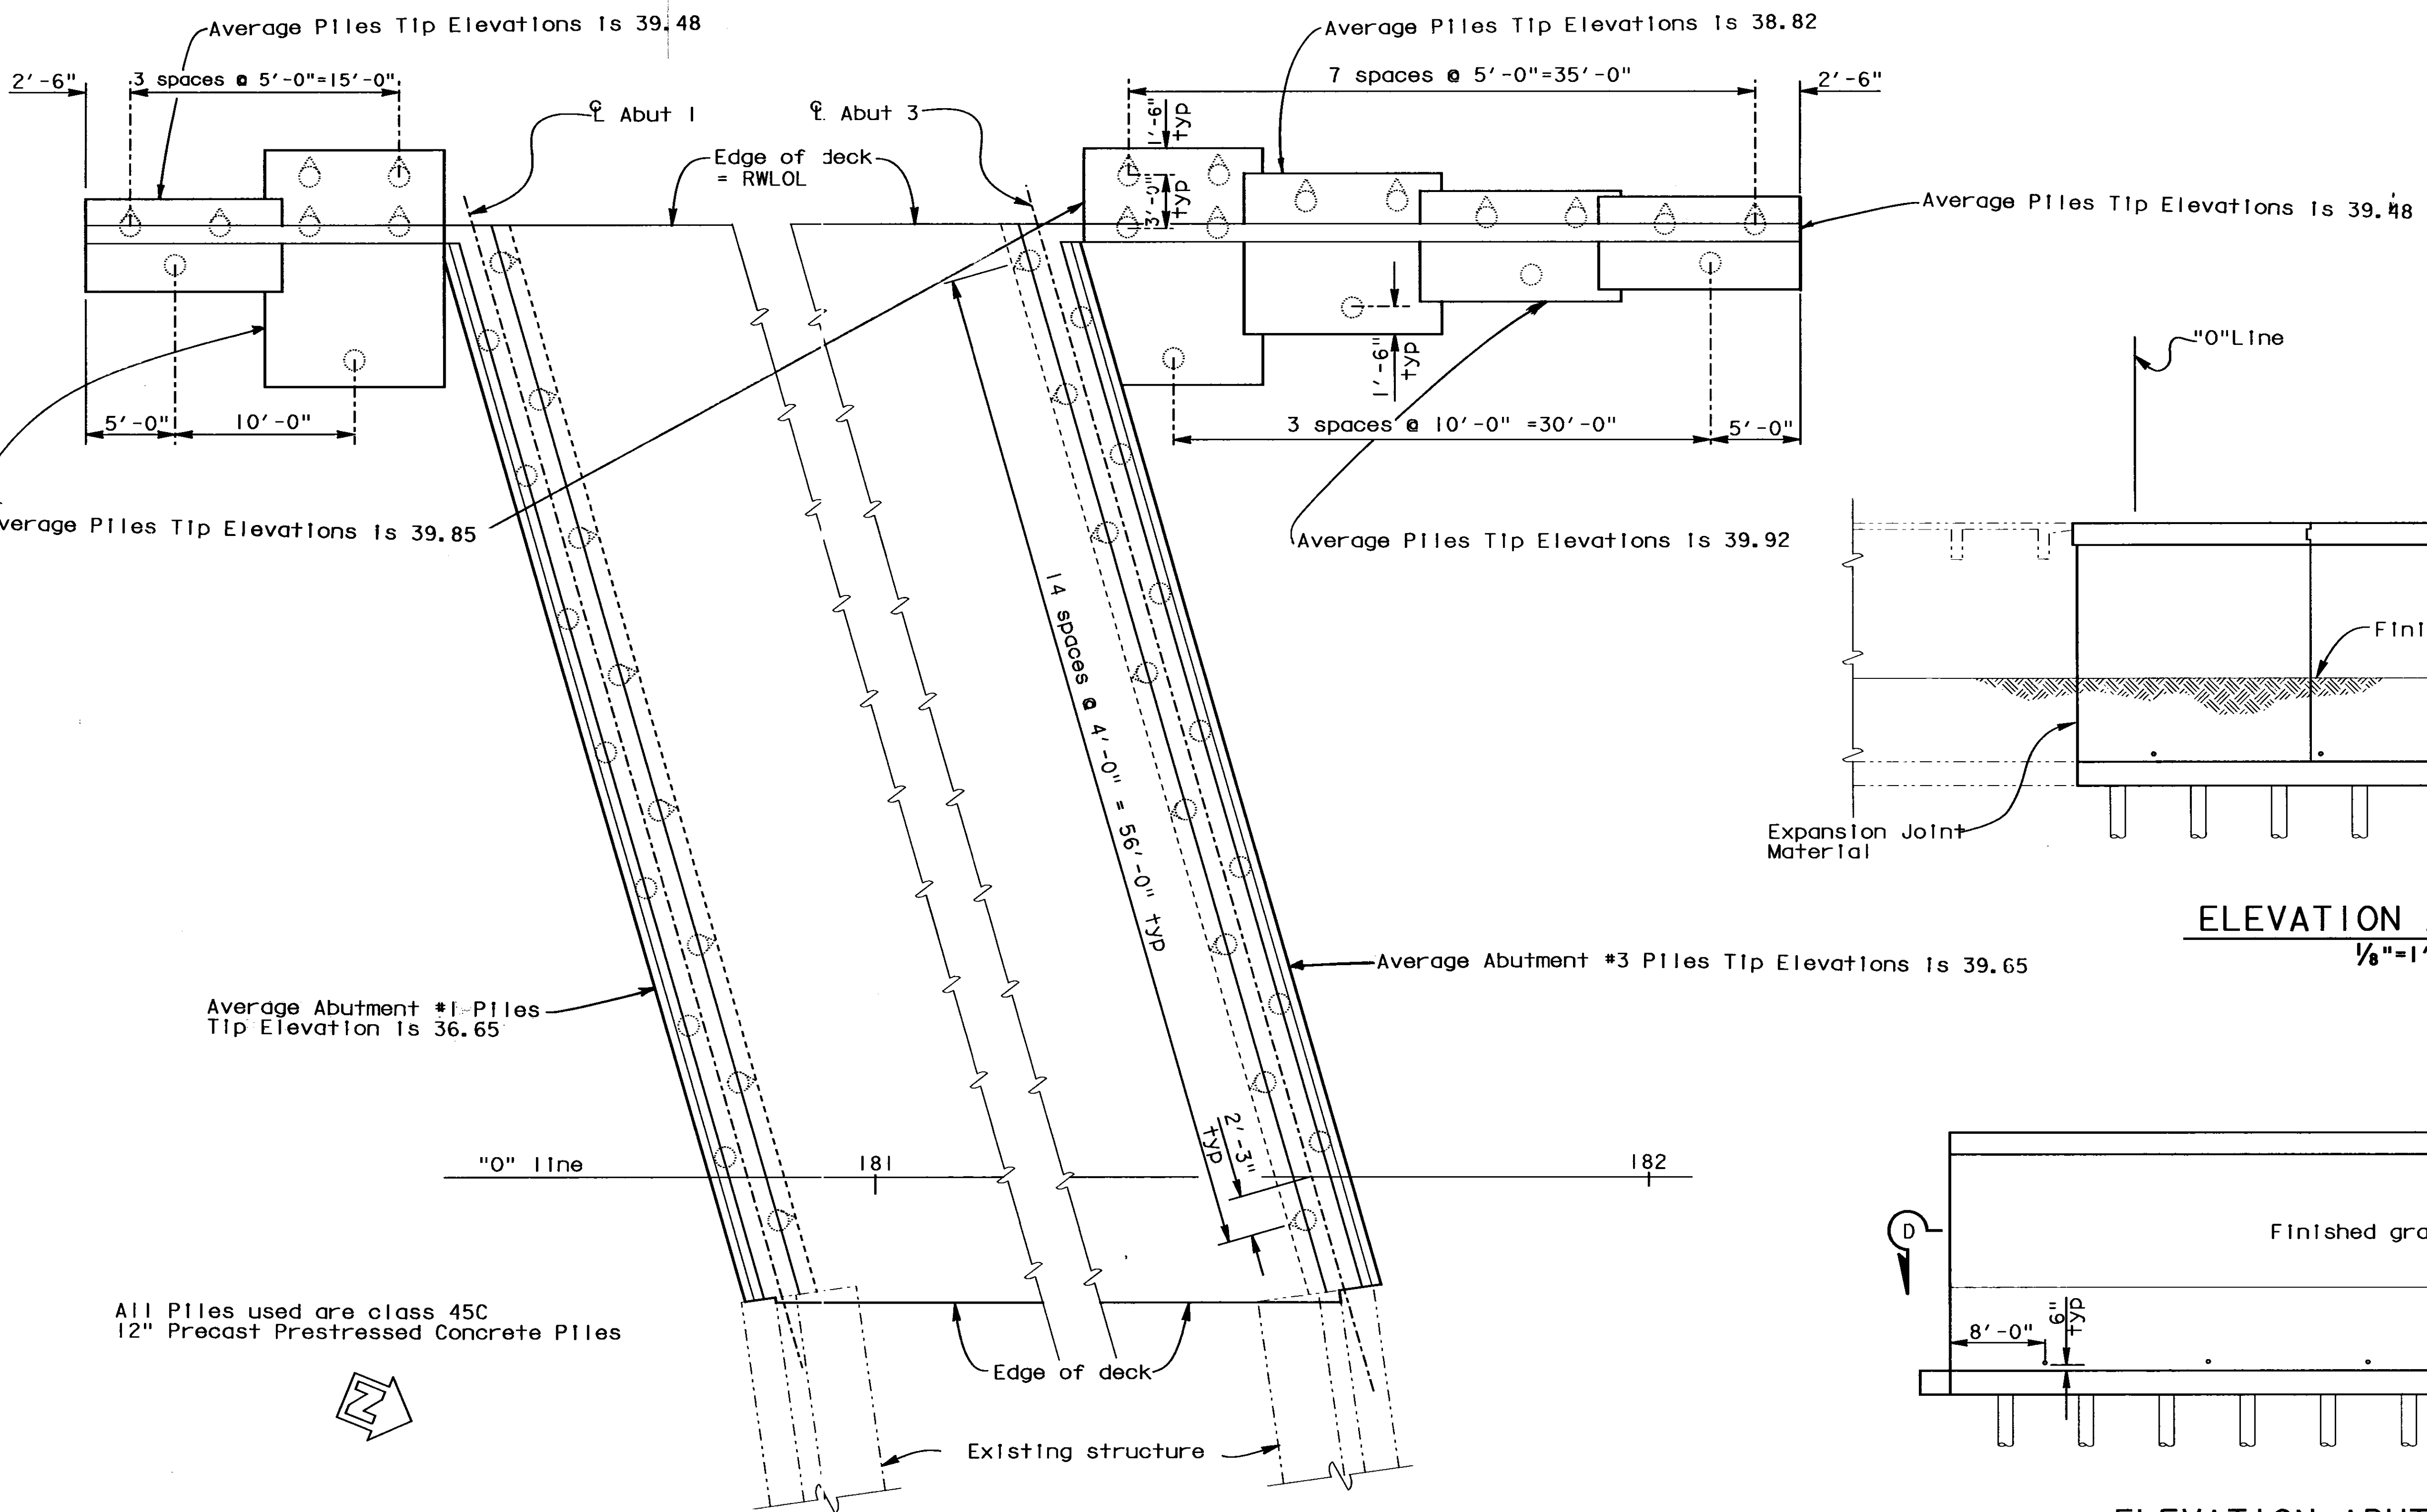

**ELEVATION ABUTMENT 1**  
1/8" = 1'-0"

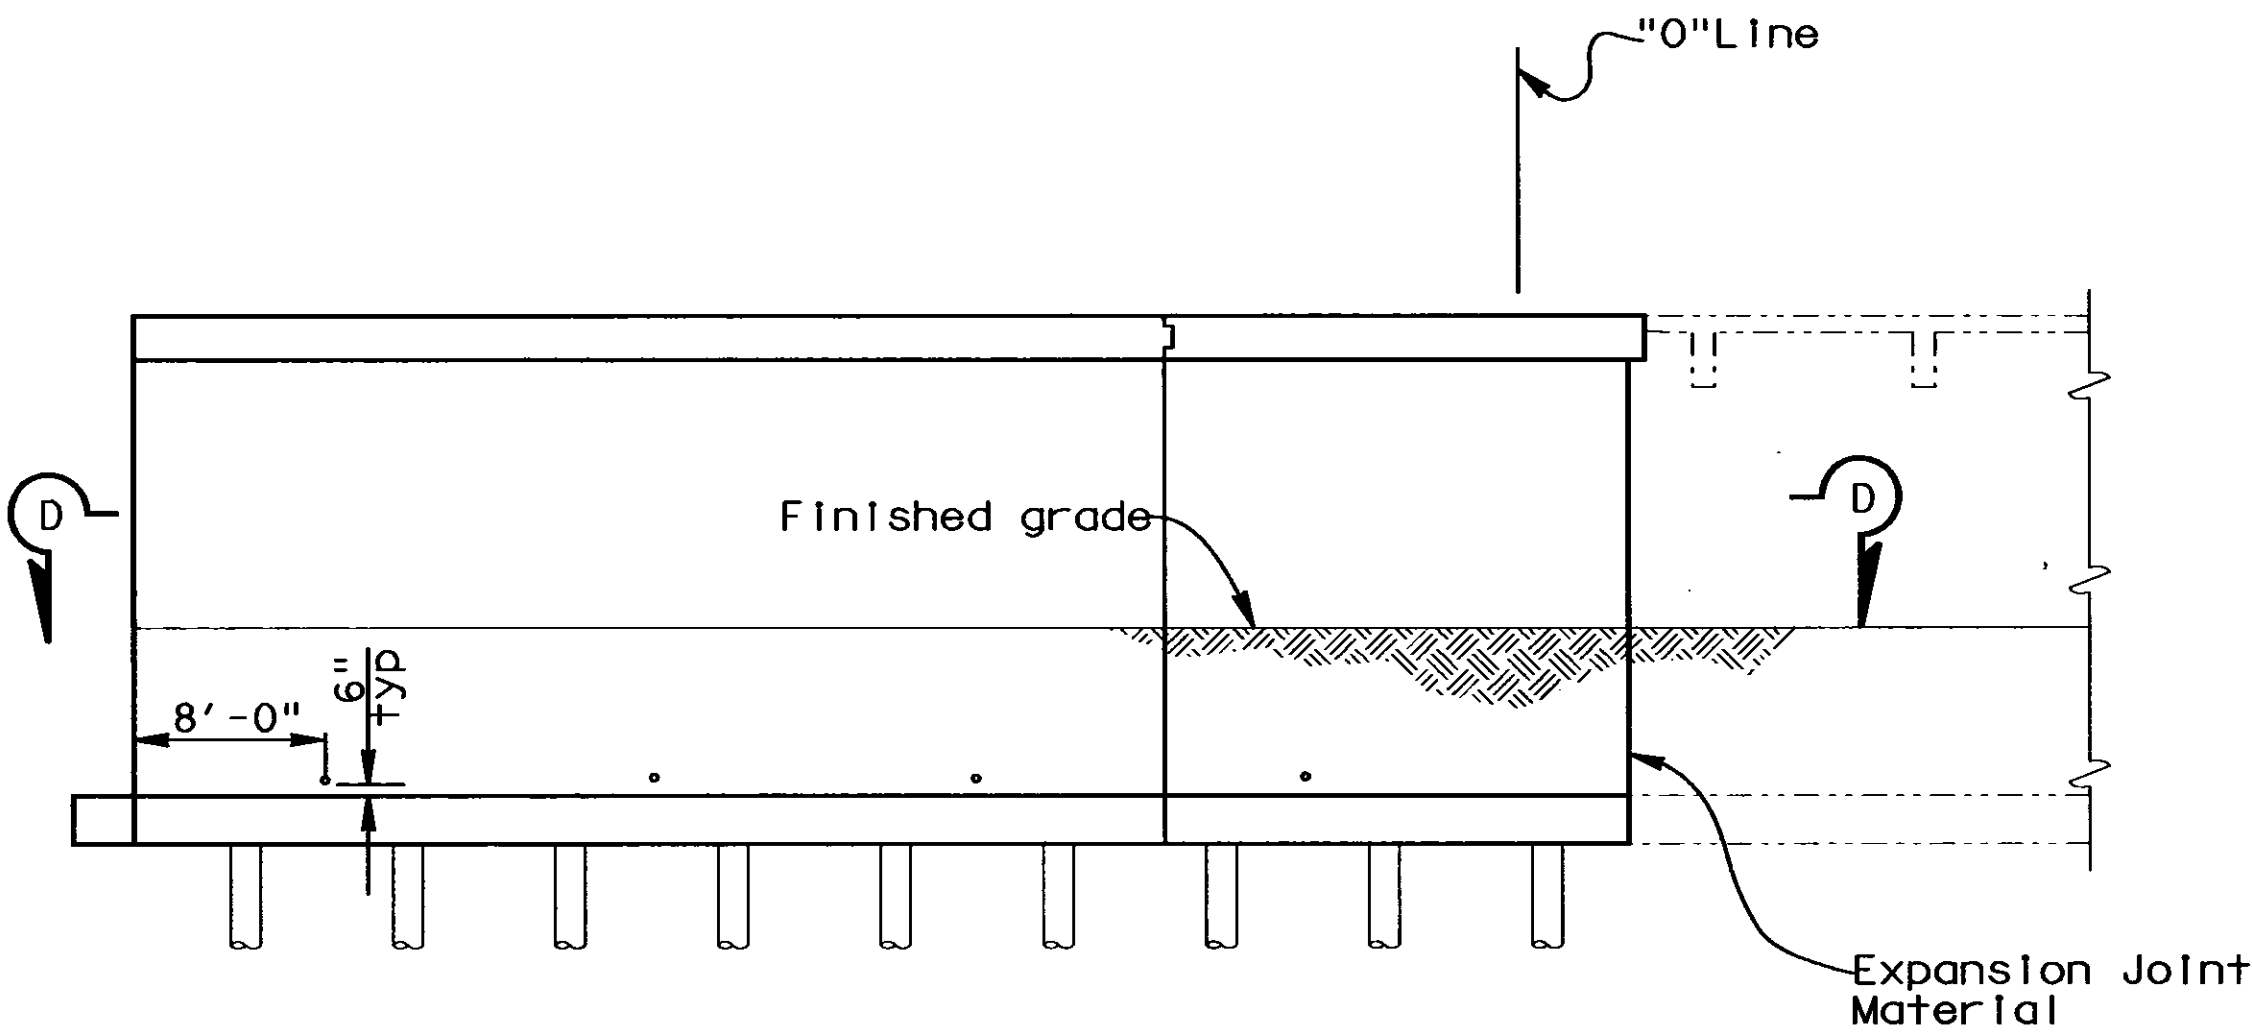

**ELEVATION ABUTMENT 3**  
1/8" = 1'-0"

**ABUTMENT PLAN**  
3/8" = 1'-0"

NOTE:  
THE CONTRACTOR SHALL VERIFY ALL CONTROLLING FIELD DIMENSIONS BEFORE ORDERING OR FABRICATING ANY MATERIAL.

**AS BUILT**

CORRECTIONS BY *Michael Assad*  
CONTRACT NO. *04-149304*  
DATE *12-08-97* *3-2-98*

- Notes:
- For "Section D-D" See "Abutment Details" sheet.
  - Indicates 3"Ø formed hole total 4 spaced @ 14'-0"
  - Indicates vertical pile
  - ⊙ Indicates battered pile

**EARTHQUAKE RETROFIT PROJECT NO. 412**

DESIGN	BY Garry Tolen	3-96	CHECKED Mike Whiteside	5-96
DETAILS	BY Andy Onodera	3-96	CHECKED Mike Whiteside	5-96
QUANTITIES	BY Garry Tolen	6-96	CHECKED Kristi Westoby	6-96

STATE OF CALIFORNIA  
DEPARTMENT OF TRANSPORTATION

DISTRICT 2  
SEISMIC DESIGN  
BRIDGE NO. 21-0014  
POST MILE 16.5

**DRY CREEK BRIDGE  
ABUTMENT LAYOUT**

DS OSD 2139 (CADD 10/95)	ORIGINAL SCALE IN INCHES FOR REDUCED PLANS	0 1 2 3	CU 04 EA 149301	DISREGARD PRINTS BEARING EARLIER REVISION DATES	REVISION DATES (PRELIMINARY STAGE ONLY)	SHEET 4 OF 16
--------------------------	--	---------	--------------------	---	---	---------------

USERNAME => trpauid  
DGN FILE => [ESC-OE]aabtlay.psf

DATE PLOTTED => 18-Nov-1996  
TIME PLOTTED => 07:00






DIST.	COUNTY	ROUTE	POST MILES TOTAL PROJECT	SHEET NO.	TOTAL SHEETS
04	Nap	29	16.3/16.7	57	68

*Garry E. Tolen*  
 REGISTERED ENGINEER - CIVIL  
 No. 25298  
 Exp. 12-31-97  
 CIVIL  
 STATE OF CALIFORNIA

11-18-96  
 PLANS APPROVAL DATE

*The State of California or its officers or agents shall not be responsible for the accuracy or completeness of electronic copies of this plan sheet.*

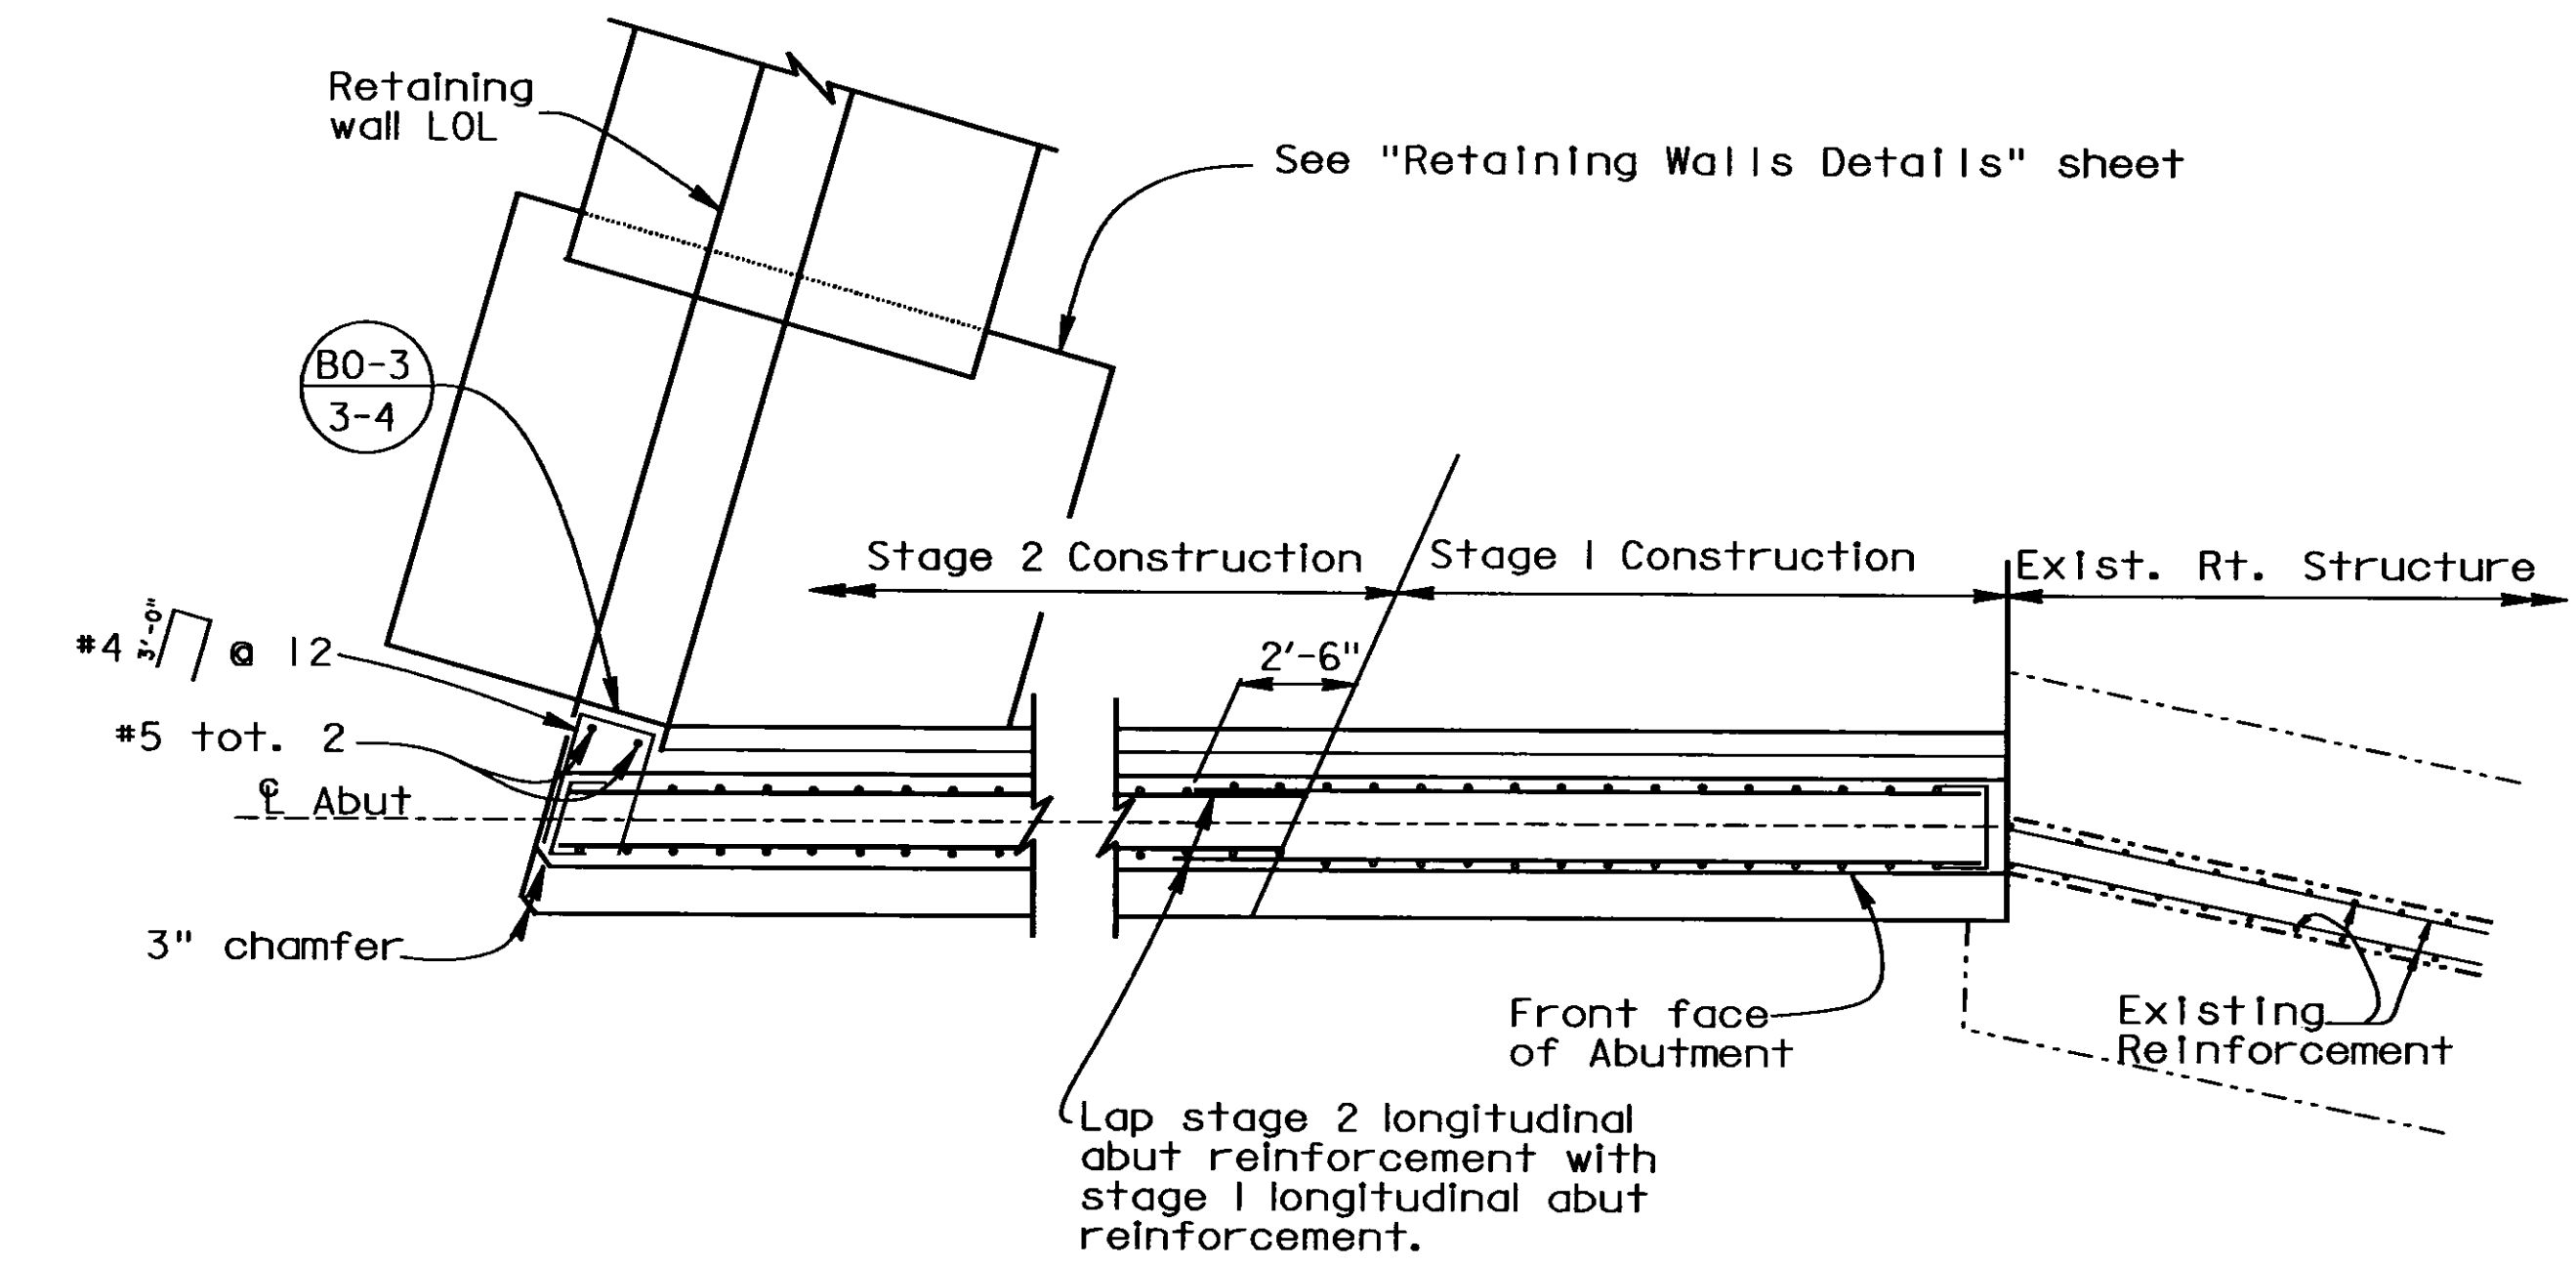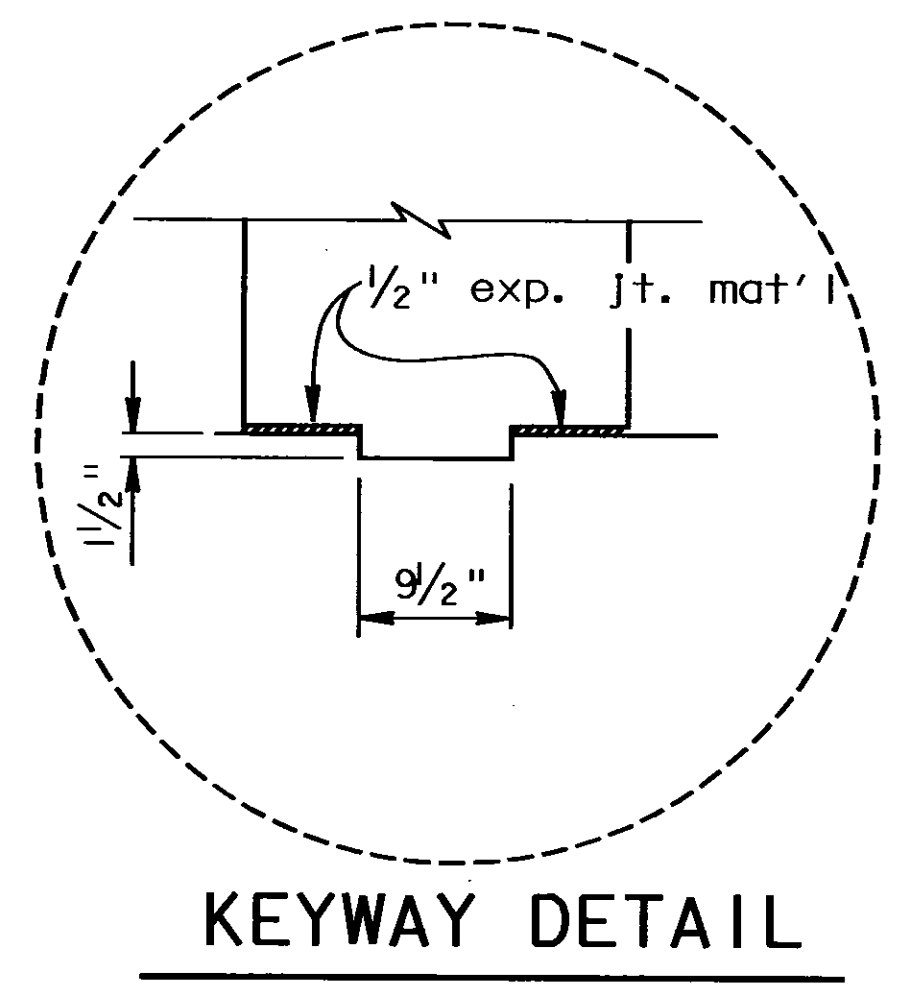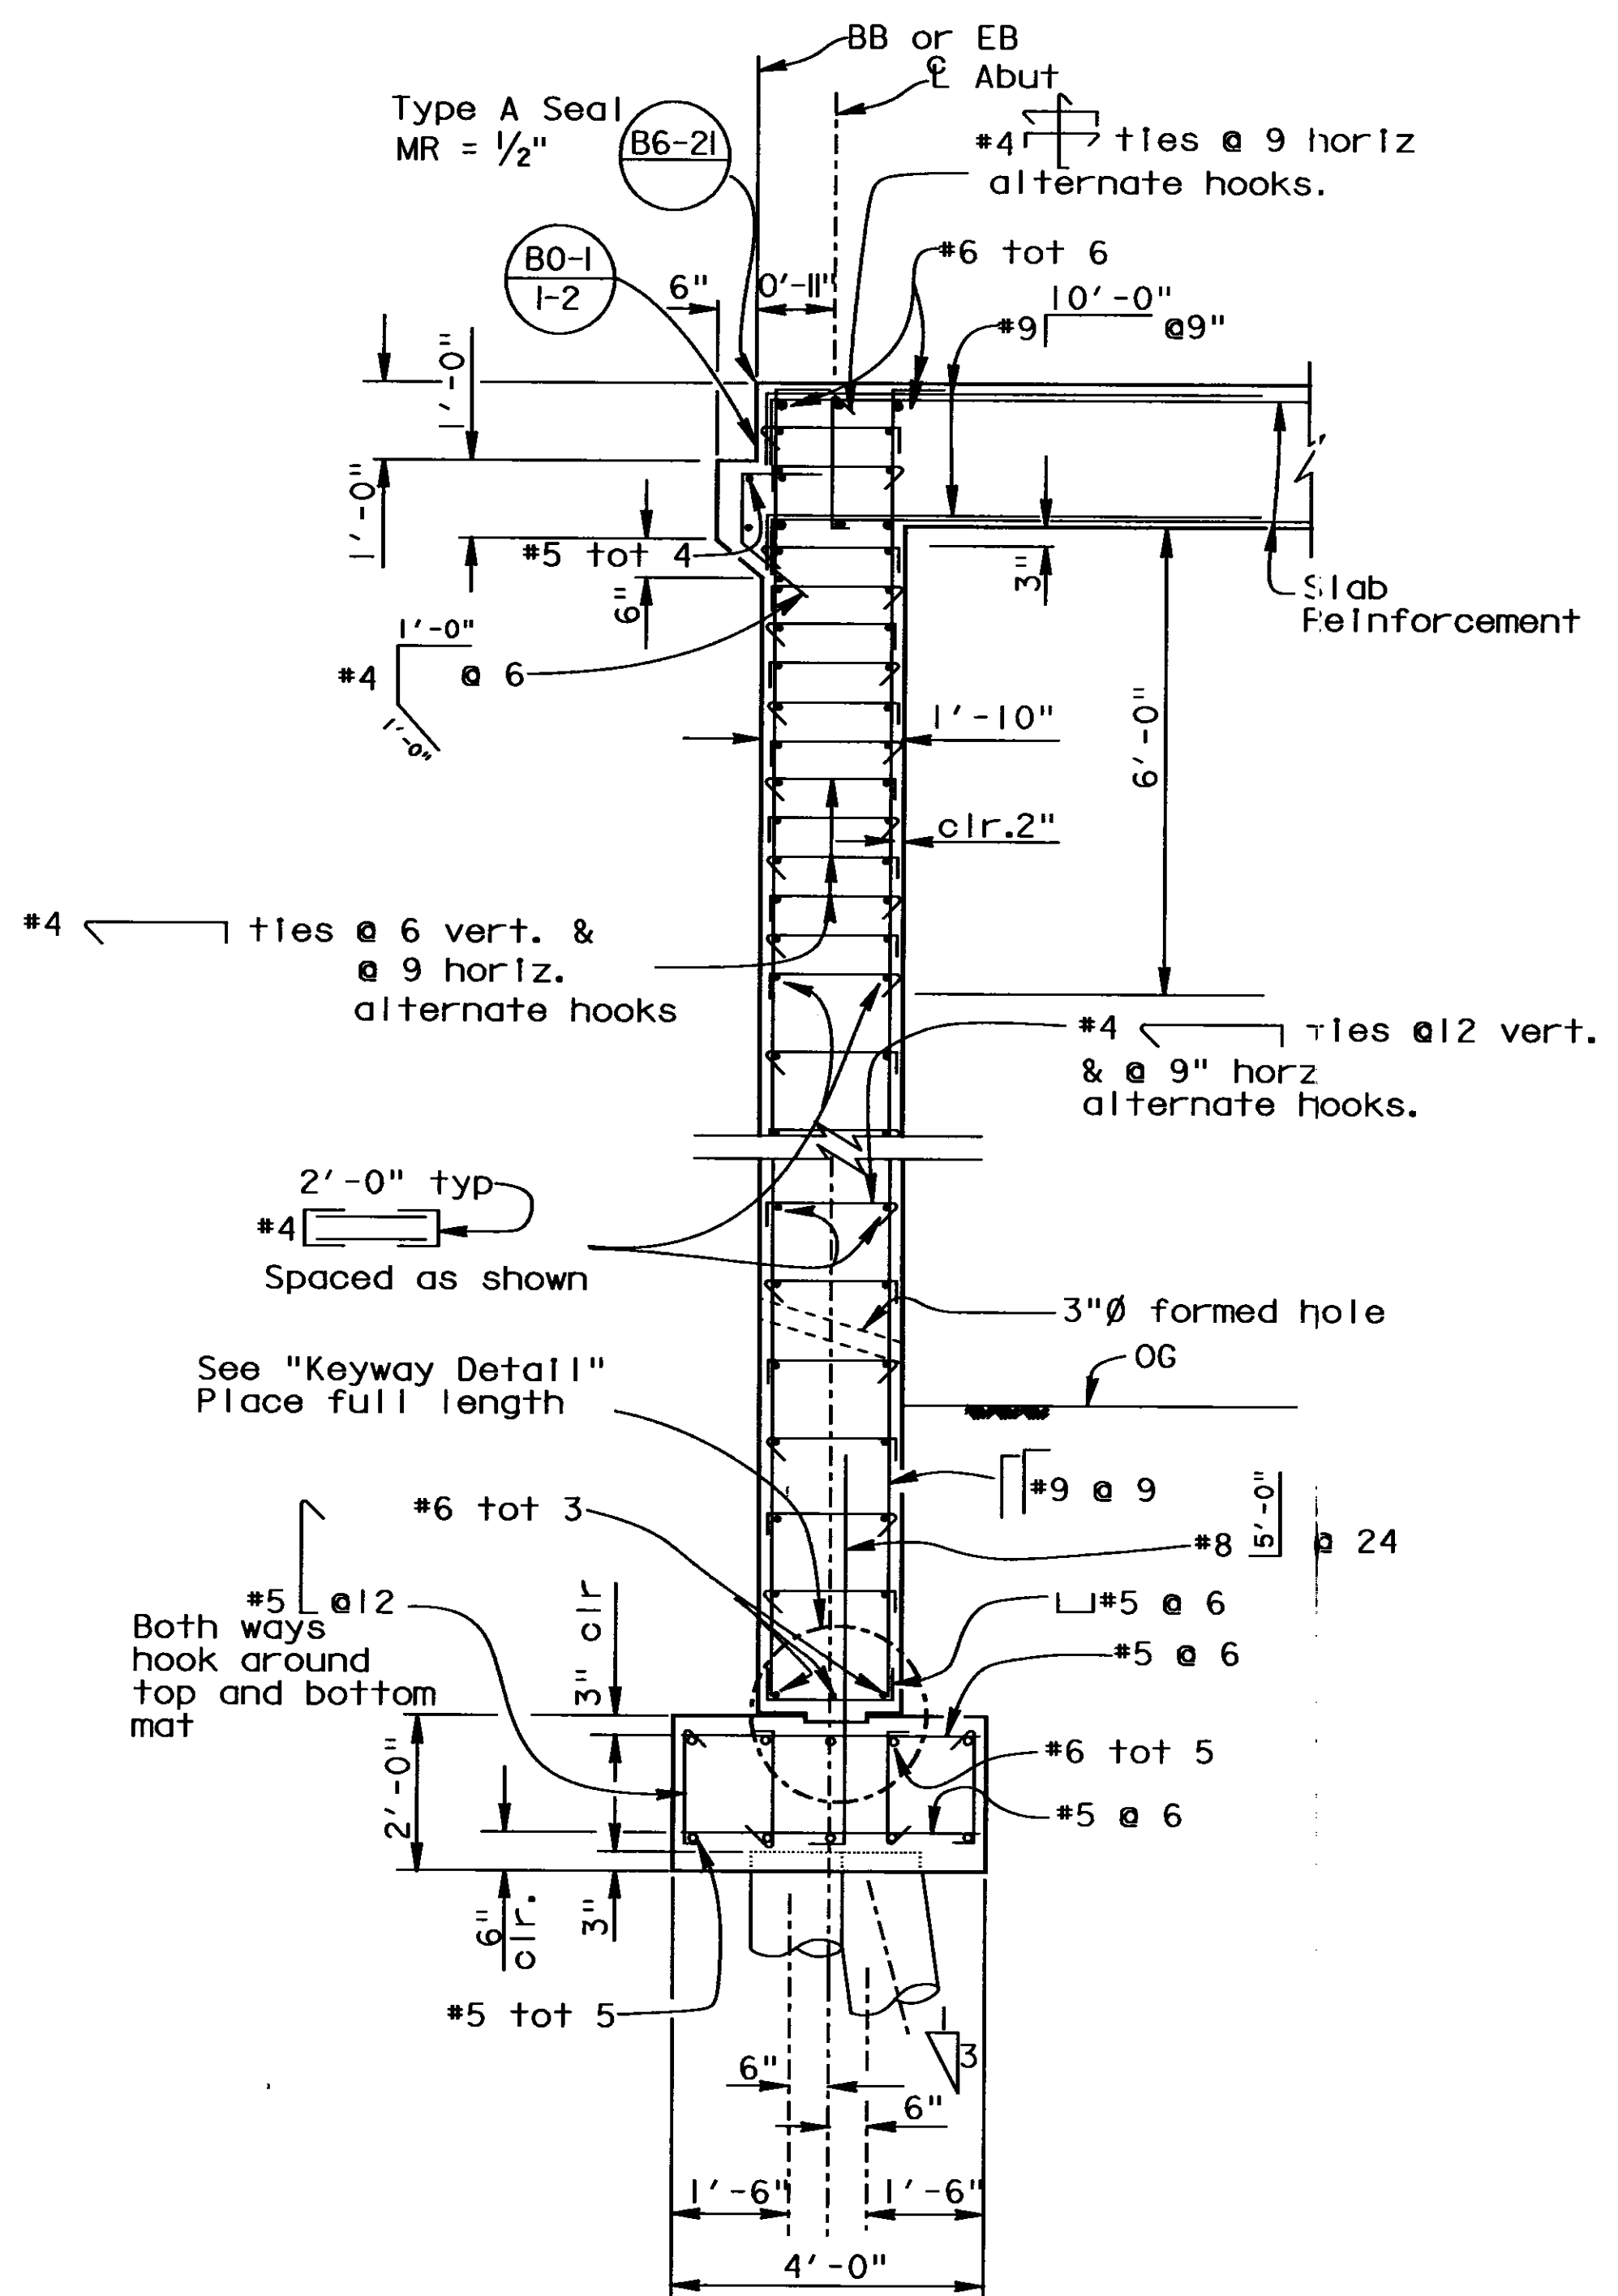

**SECTION D-D**  
1/4" = 1'-0"

**TYPICAL ABUTMENT SECTION**  
1/2" = 1'-0"

- Notes:
1. For location of Section D-D, See "Abutment Layout" sheet.
  2. Abutment 3 shown, Abutment 1 Similar.
  3. Once deck is completed, backfill shall be placed simultaneously at both Abutments.

*No Changes*  
**AS BUILT**  
*of Sam*  
 CORRECTIONS BY *Michael David*  
 CONTRACT NO. *04-149304*  
 DATE *12-08-97* 3-2-98

DESIGN BY Garry Tolen 3-96		CHECKED Mike Whiteside 5-96	<b>STATE OF CALIFORNIA</b> DEPARTMENT OF TRANSPORTATION	DISTRICT 2 <b>SEISMIC DESIGN</b>	BRIDGE NO. 21-0014	EARTHQUAKE RETROFIT PROJECT NO. 412	
DETAILS BY Janice Sam 3-96		CHECKED Mike Whiteside 5-96			POST MILE 16.5	<b>DRY CREEK BRIDGE</b> <b>ABUTMENT DETAILS</b>	
QUANTITIES BY Garry Tolen 6-96		CHECKED Kristi Westoby 6-96			REVISION DATES (PRELIMINARY STAGE ONLY) 1-2-96 5-2-96 5-15-96 7-2-96 1-2-97 1-2-97 10-21-96 10-28-96	SHEET 5 OF 16	

ORIGINAL SCALE IN INCHES FOR REDUCED PLANS: 0 1 2 3  
 USERNAME => trpauid  
 DGN FILE => [ESC-OE]aaab+det.ps

DATE PLOTTED => 18-NOV-1996  
 TIME PLOTTED => 07:01






DIST.	COUNTY	ROUTE	POST MILES TOTAL PROJECT	SHEET NO.	TOTAL SHEETS
04	Nap	29	16.3/16.7	59	68

*Garry L. Tolen*  
REGISTERED ENGINEER - CIVIL



11-18-96  
PLANS APPROVAL DATE


The State of California or its officers or agents shall not be responsible for the accuracy or completeness of electronic copies of this plan sheet.

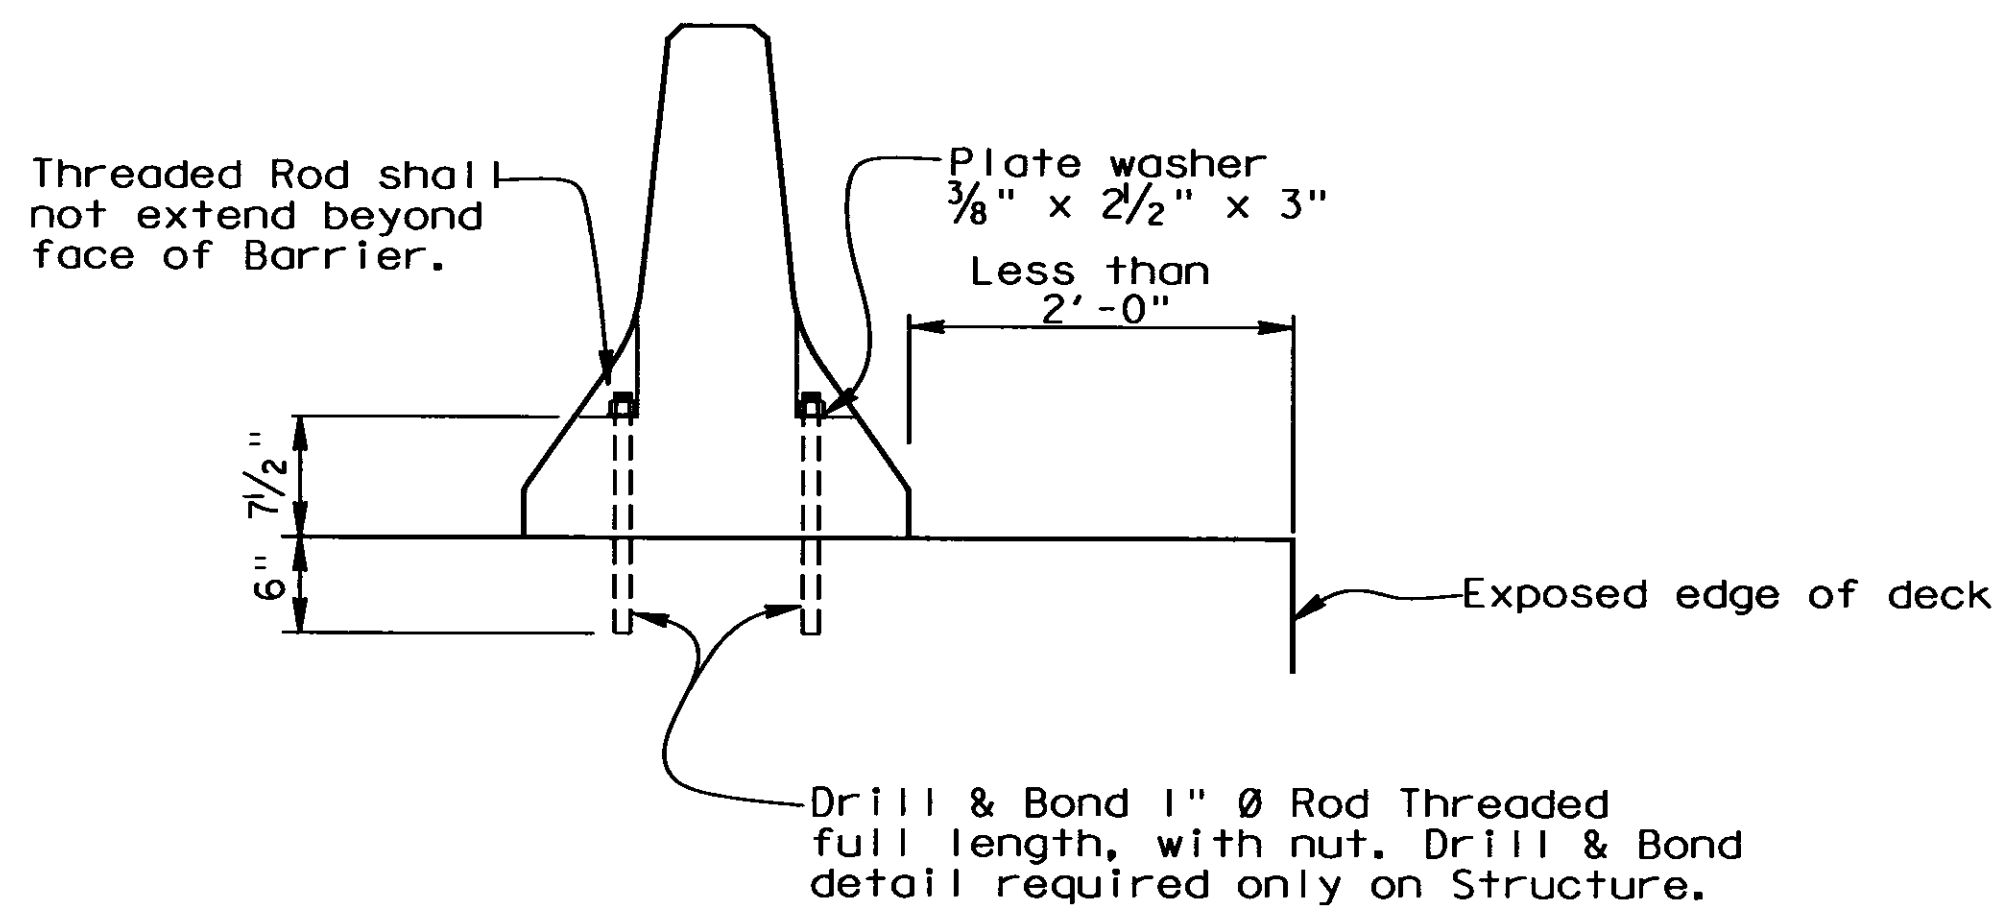

**DETAIL B**

1" = 1'-0"

See (T3) for details not shown

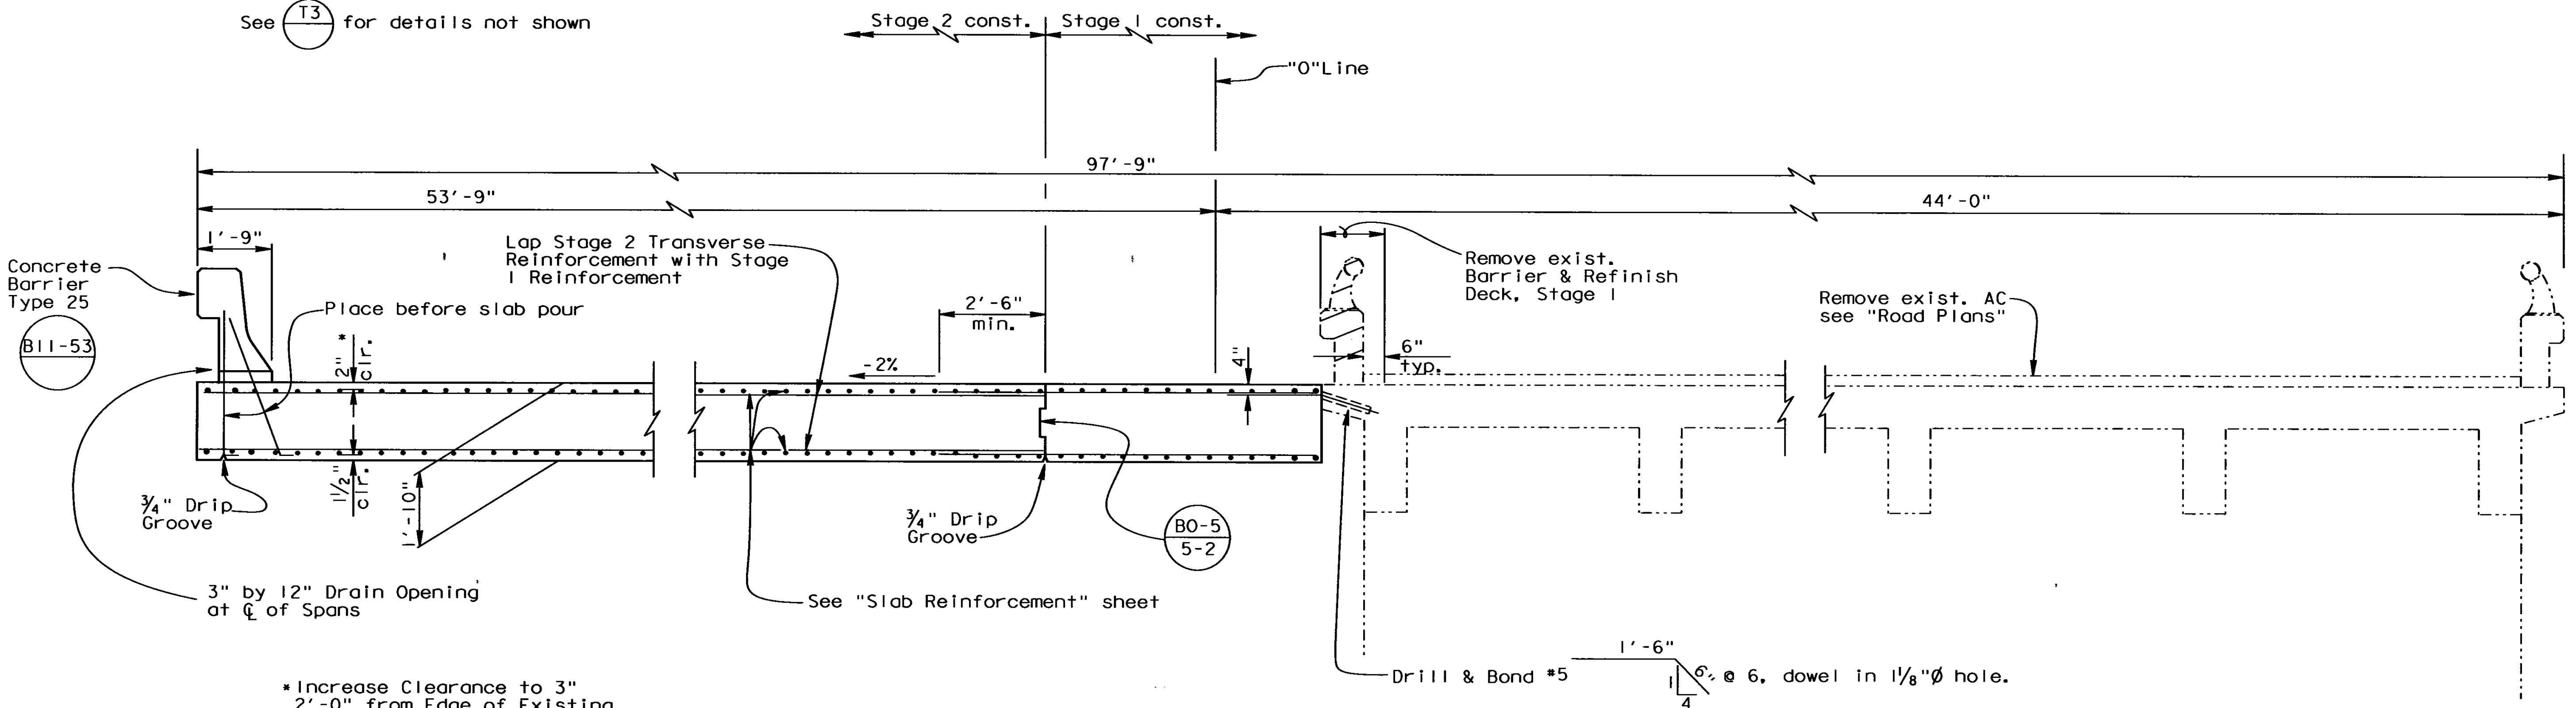

**TYPICAL SECTION**

1/2" = 1'-0"

\*Increase Clearance to 3" 2'-0" from Edge of Existing Structure

*No Changes*  
**AS BUILT** *J. Sam*  
CORRECTIONS BY *Michael Assad*  
CONTRACT NO. *04-149304*  
DATE *12-08-97* *3-2-98*

**EARTHQUAKE RETROFIT PROJECT NO. 412**

DESIGN	BY Garry Tolen	3-96	CHECKED Mike Whiteside	5-96
DETAILS	BY Janice Sam	3-96	CHECKED Mike Whiteside	5-96
QUANTITIES	BY Garry Tolen	6-96	CHECKED Kristi Westoby	6-96

**STATE OF CALIFORNIA**  
**DEPARTMENT OF TRANSPORTATION**

**DISTRICT 2**  
**SEISMIC DESIGN**

BRIDGE NO. 21-0014  
POST MILE 16.5  
**DRY CREEK BRIDGE**  
**TYPICAL SECTION**

DS OSD 2139 (CADD 9/95)	ORIGINAL SCALE IN INCHES FOR REDUCED PLANS	0 1 2 3	CU 04 EA 149301	DISREGARD PRINTS BEARING EARLIER REVISION DATES	REVISION DATES (PRELIMINARY STAGE ONLY)	SHEET 7 OF 16
-------------------------	--	---------	--------------------	---	---	---------------


USERNAME => trlenord  
aatyp18063945

aatyp

DATE PLOTTED => 18-Nov-1996  
TIME PLOTTED => 06:39





DIST.	COUNTY	ROUTE	POST MILES TOTAL PROJECT	SHEET NO.	TOTAL SHEETS
04	Nap	29	16.3/16.7	60	68

*Garry L. Tolen*  
REGISTERED ENGINEER - CIVIL

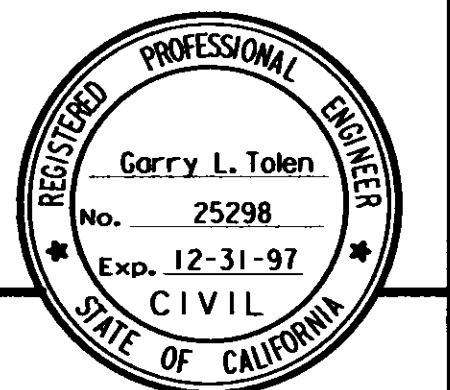

11-18-96  
PLANS APPROVAL DATE

The State of California or its officers or agents shall not be responsible for the accuracy or completeness of electronic copies of this plan sheet.

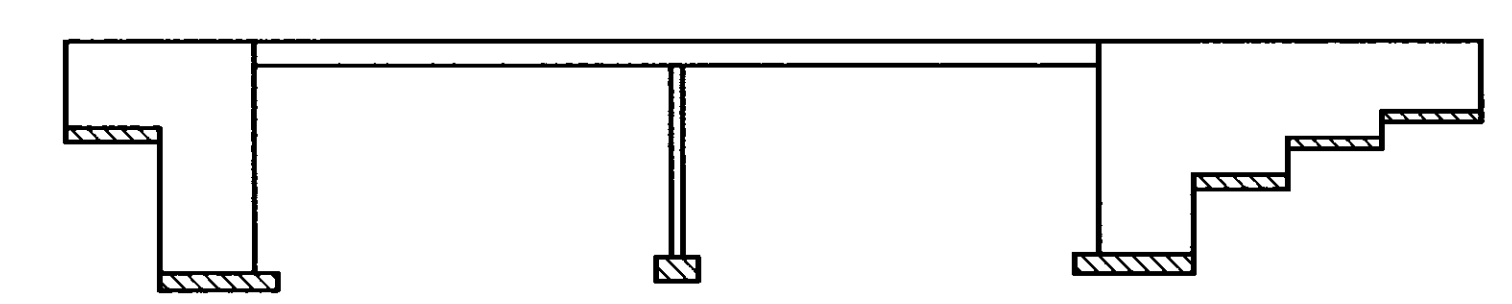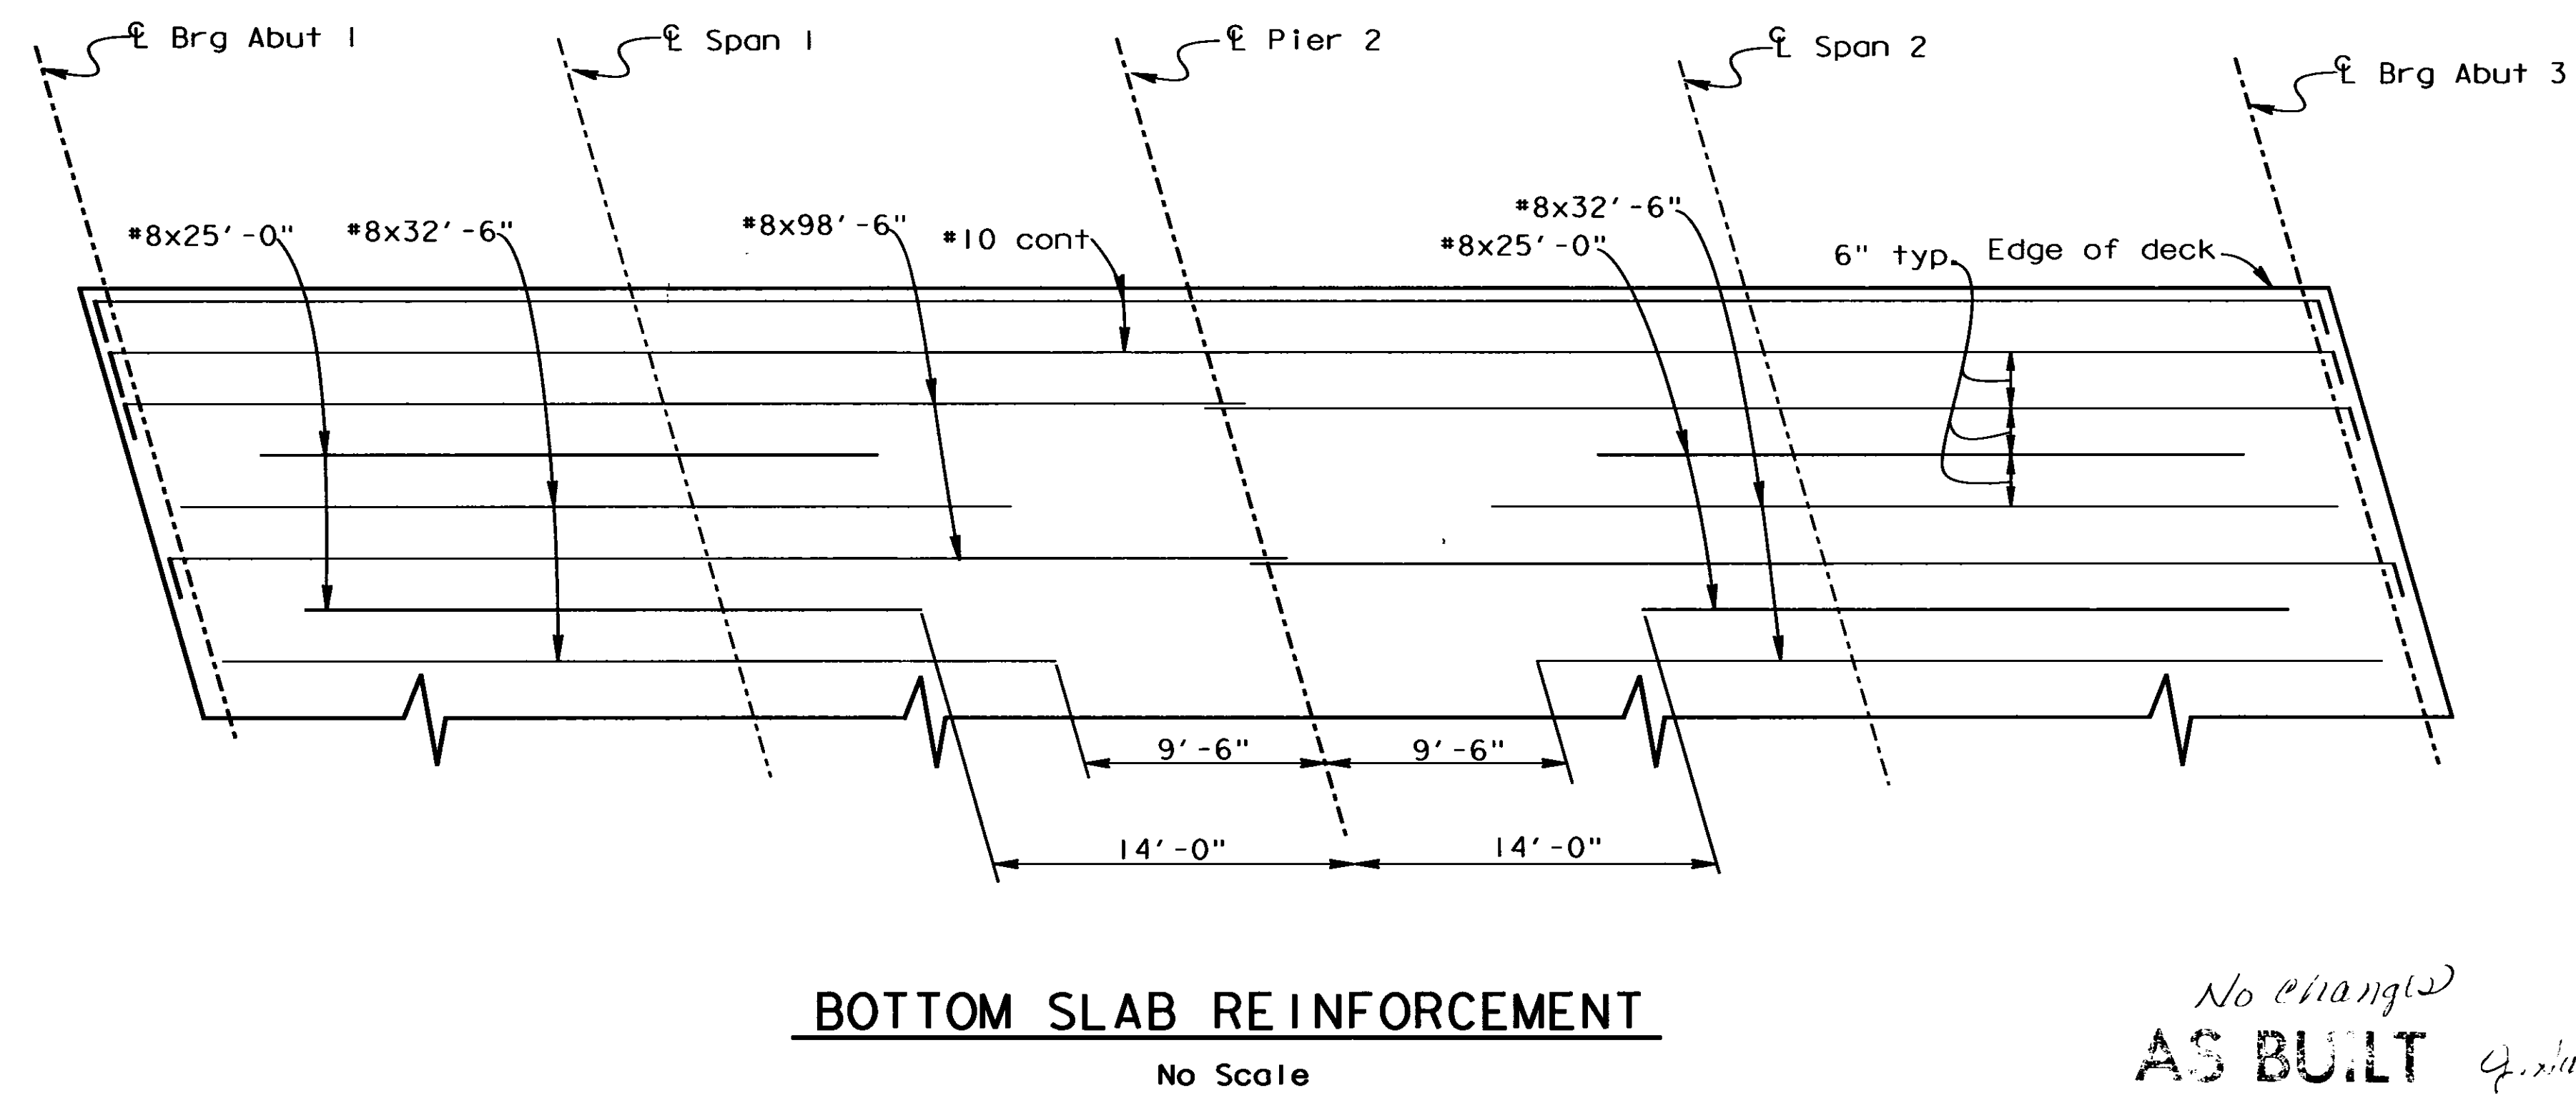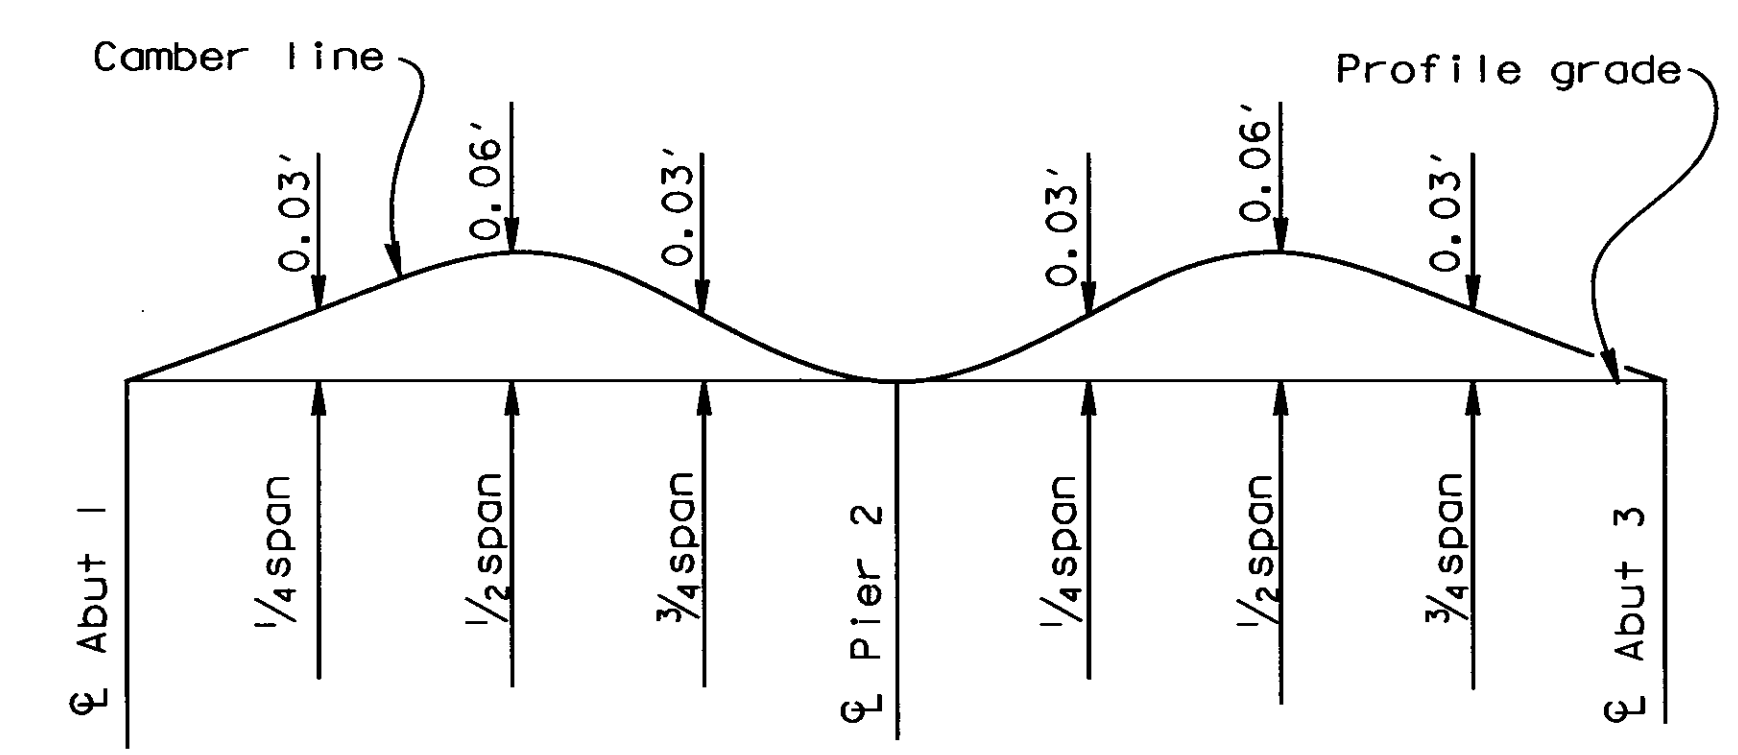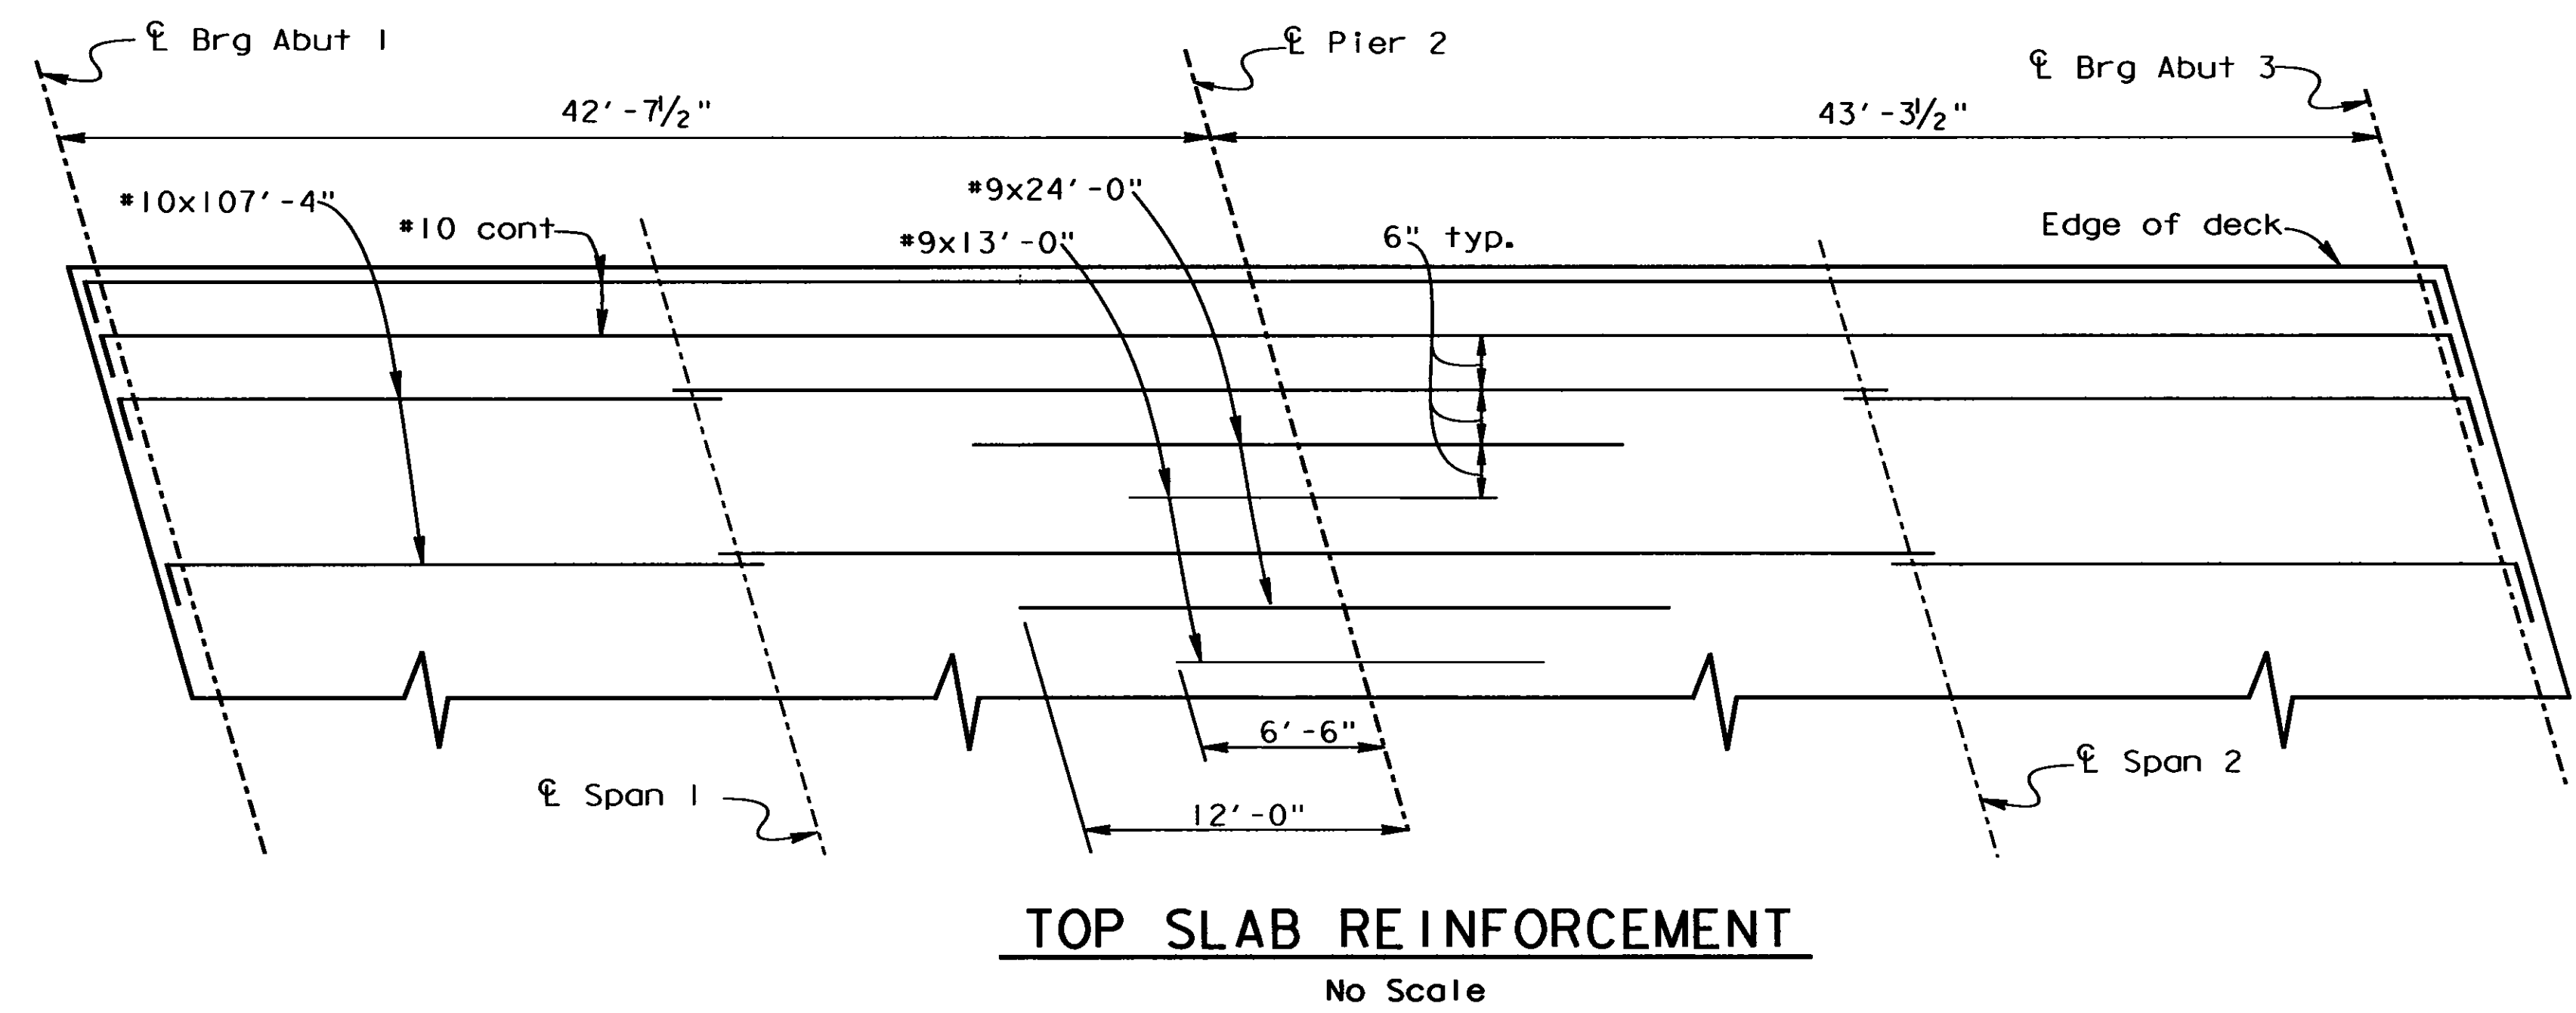

Structural Concrete, Bridge  
Structural Concrete, Bridge Footing

**CONCRETE STRENGTH AND TYPE LIMITS**  
No Scale

- Notes:
- Falsework shall not be released less than 28 days after the last Concrete has been placed.
  - All bars spaced at 6" max. across entire width of bridge.

*No change*  
**AS BUILT**  
CORRECTIONS BY *Michael Assad*  
CONTRACT NO. *04-149304*  
DATE *12-08-97* *3-2-98*

DESIGN	BY Garry Tolen	3-96	CHECKED Mike Whiteside	5-96
DETAILS	BY Janice Sam	3-96	CHECKED Mike Whiteside	5-96
QUANTITIES	BY Garry Tolen	6-96	CHECKED Kristi Westoby	6-96

STATE OF CALIFORNIA  
DEPARTMENT OF TRANSPORTATION

DISTRICT 2  
SEISMIC DESIGNS

BRIDGE NO.	21-0014
POST MILE	16.5

**EARTHQUAKE RETROFIT PROJECT NO. 412**  
**DRY CREEK BRIDGE**  
**SLAB REINFORCEMENT**

DATE PLOTTED => 18-NOV-1996  
TIME PLOTTED => 06:41




DIST.	COUNTY	ROUTE	POST MILES TOTAL PROJECT	SHEET NO.	TOTAL SHEETS
04	Nap	29	16.3/16.7	61	68

*Garry Tolen*  
REGISTERED ENGINEER - CIVIL


REGISTERED PROFESSIONAL ENGINEER  
Garry Tolen  
No. 25298  
Exp. 12-31-97  
CIVIL  
STATE OF CALIFORNIA

11-18-96  
PLANS APPROVAL DATE


The State of California or its officers or agents shall not be responsible for the accuracy or completeness of electronic copies of this plan sheet.

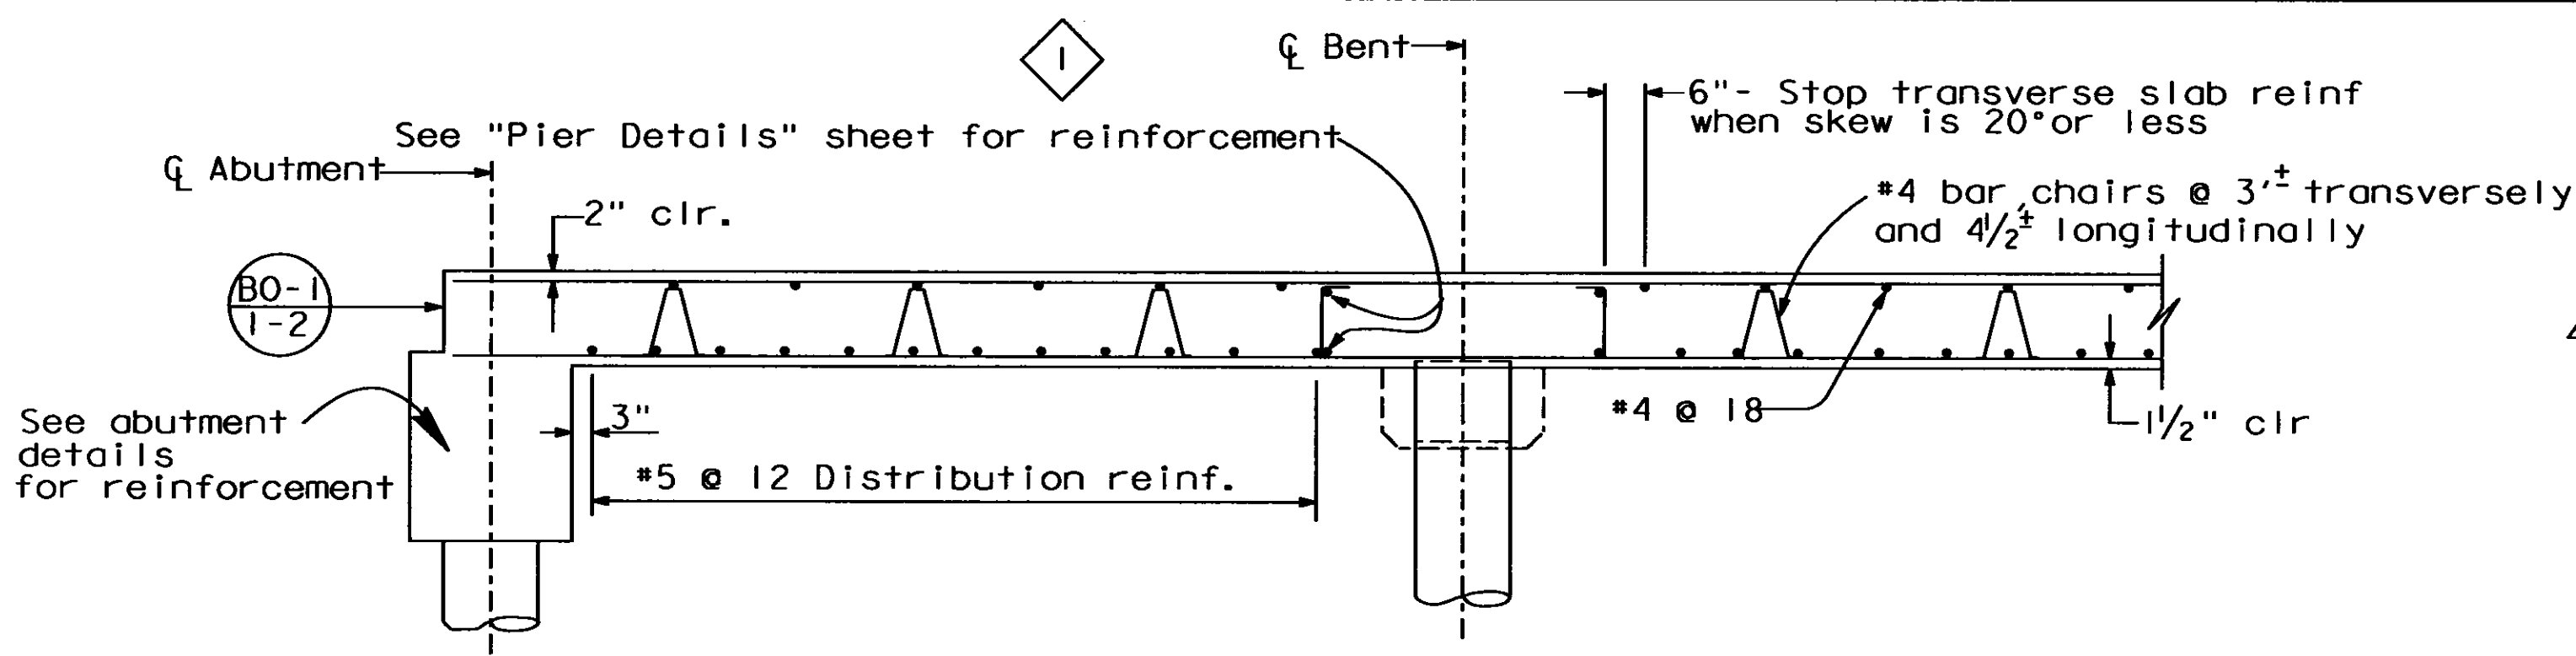

**LONGITUDINAL SECTION**

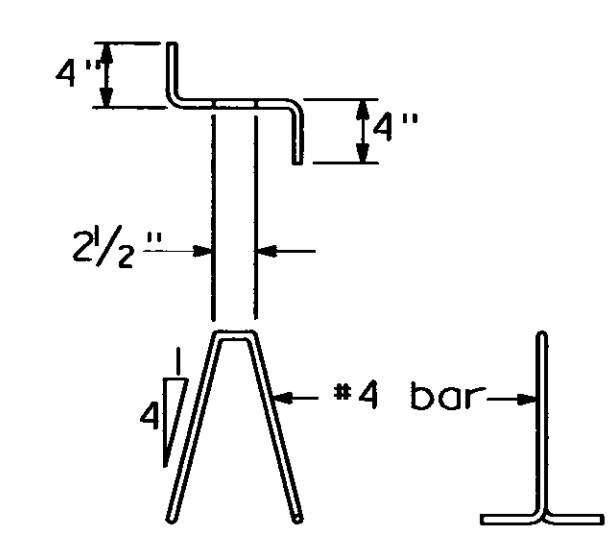

**BAR CHAIR DETAIL**

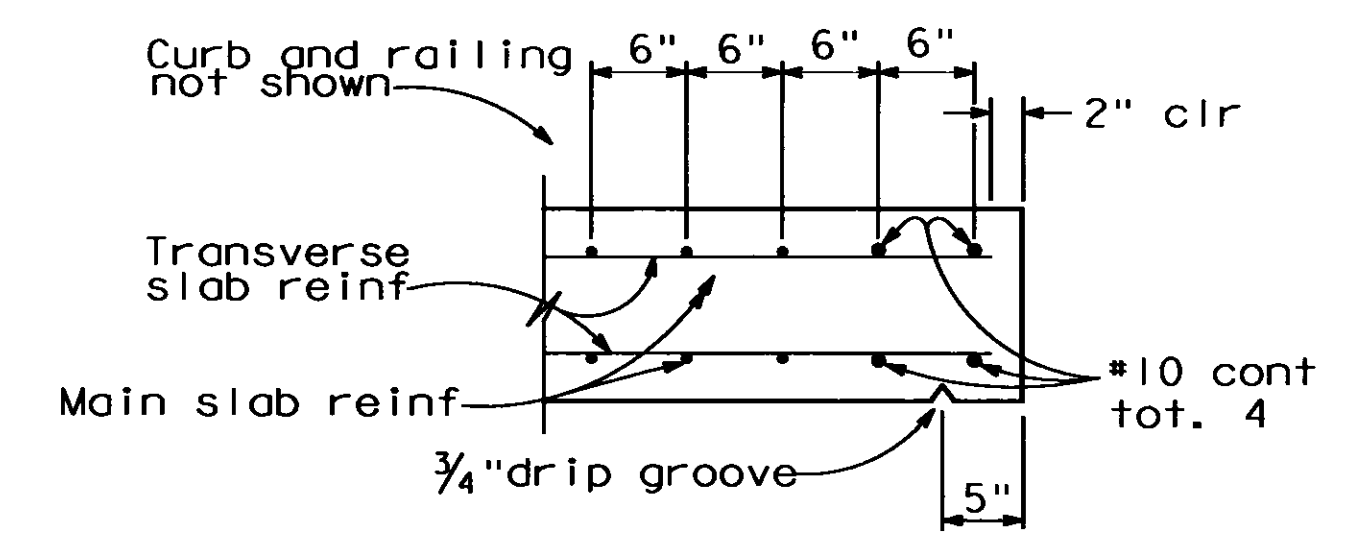


**EDGE OF SLAB DETAILS**

BAR SPLICE LENGTH								
Bar size	#4	#5	#6	#7	#8	#9	#10	#11
All bars, except top bars in spans over 24'	23"	28"	34"	39"	45"	68"	76"	85"
Top bars in spans over 24'	23"	28"	34"	53"	60"	77"	97"	120"


**REINFORCEMENT NOTES:**

Splice in top bars to be located near center of span.  
Splice in bottom main bars to be located near bent.  
Spacing of all transverse bars is measured along  $\phi$  roadway.  
Skew 0° to 20°: Place all transverse bars parallel to bent.  
Skew over 20°: Place transverse slab bars perpendicular to  $\phi$  bridge. See details at right and below.

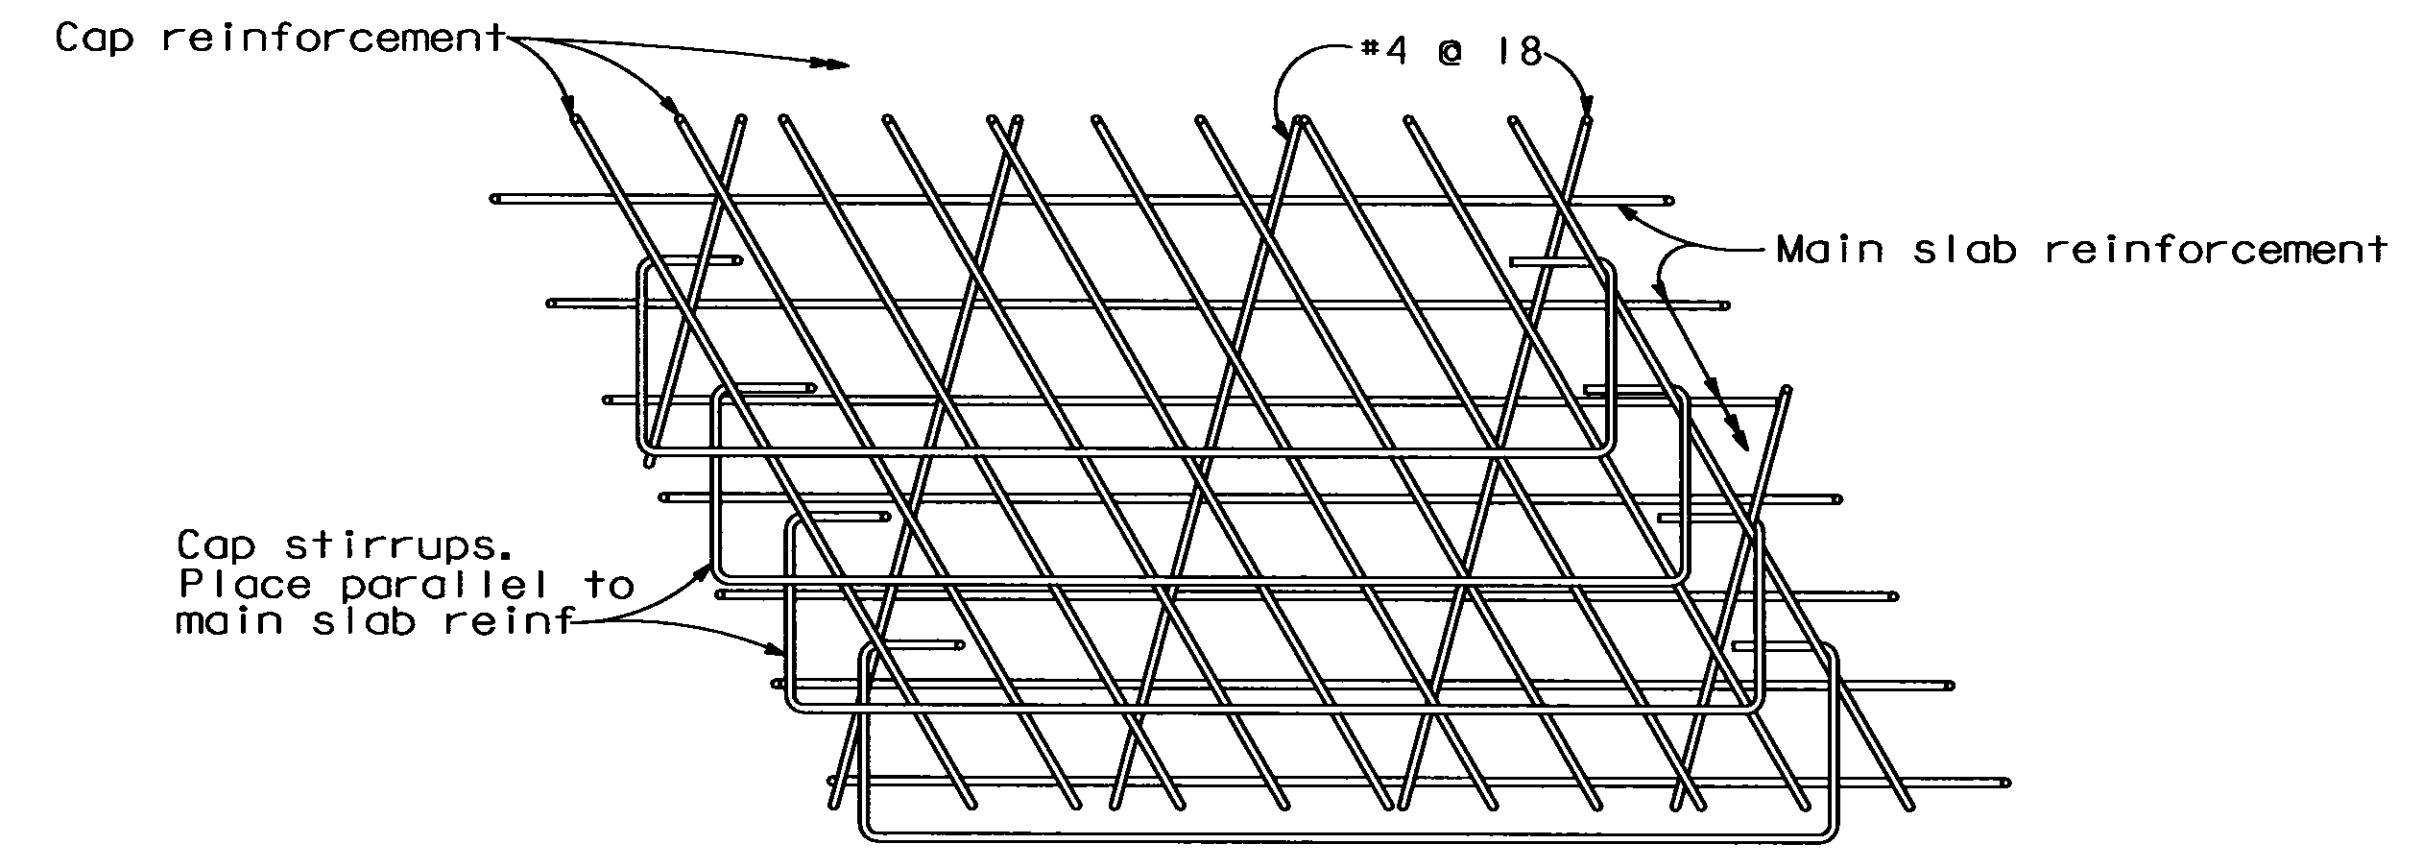


**TOP SLAB REINFORCEMENT AT BENT**

Note: View for main span over 24'.  
Bar placement similar for spans under 24'

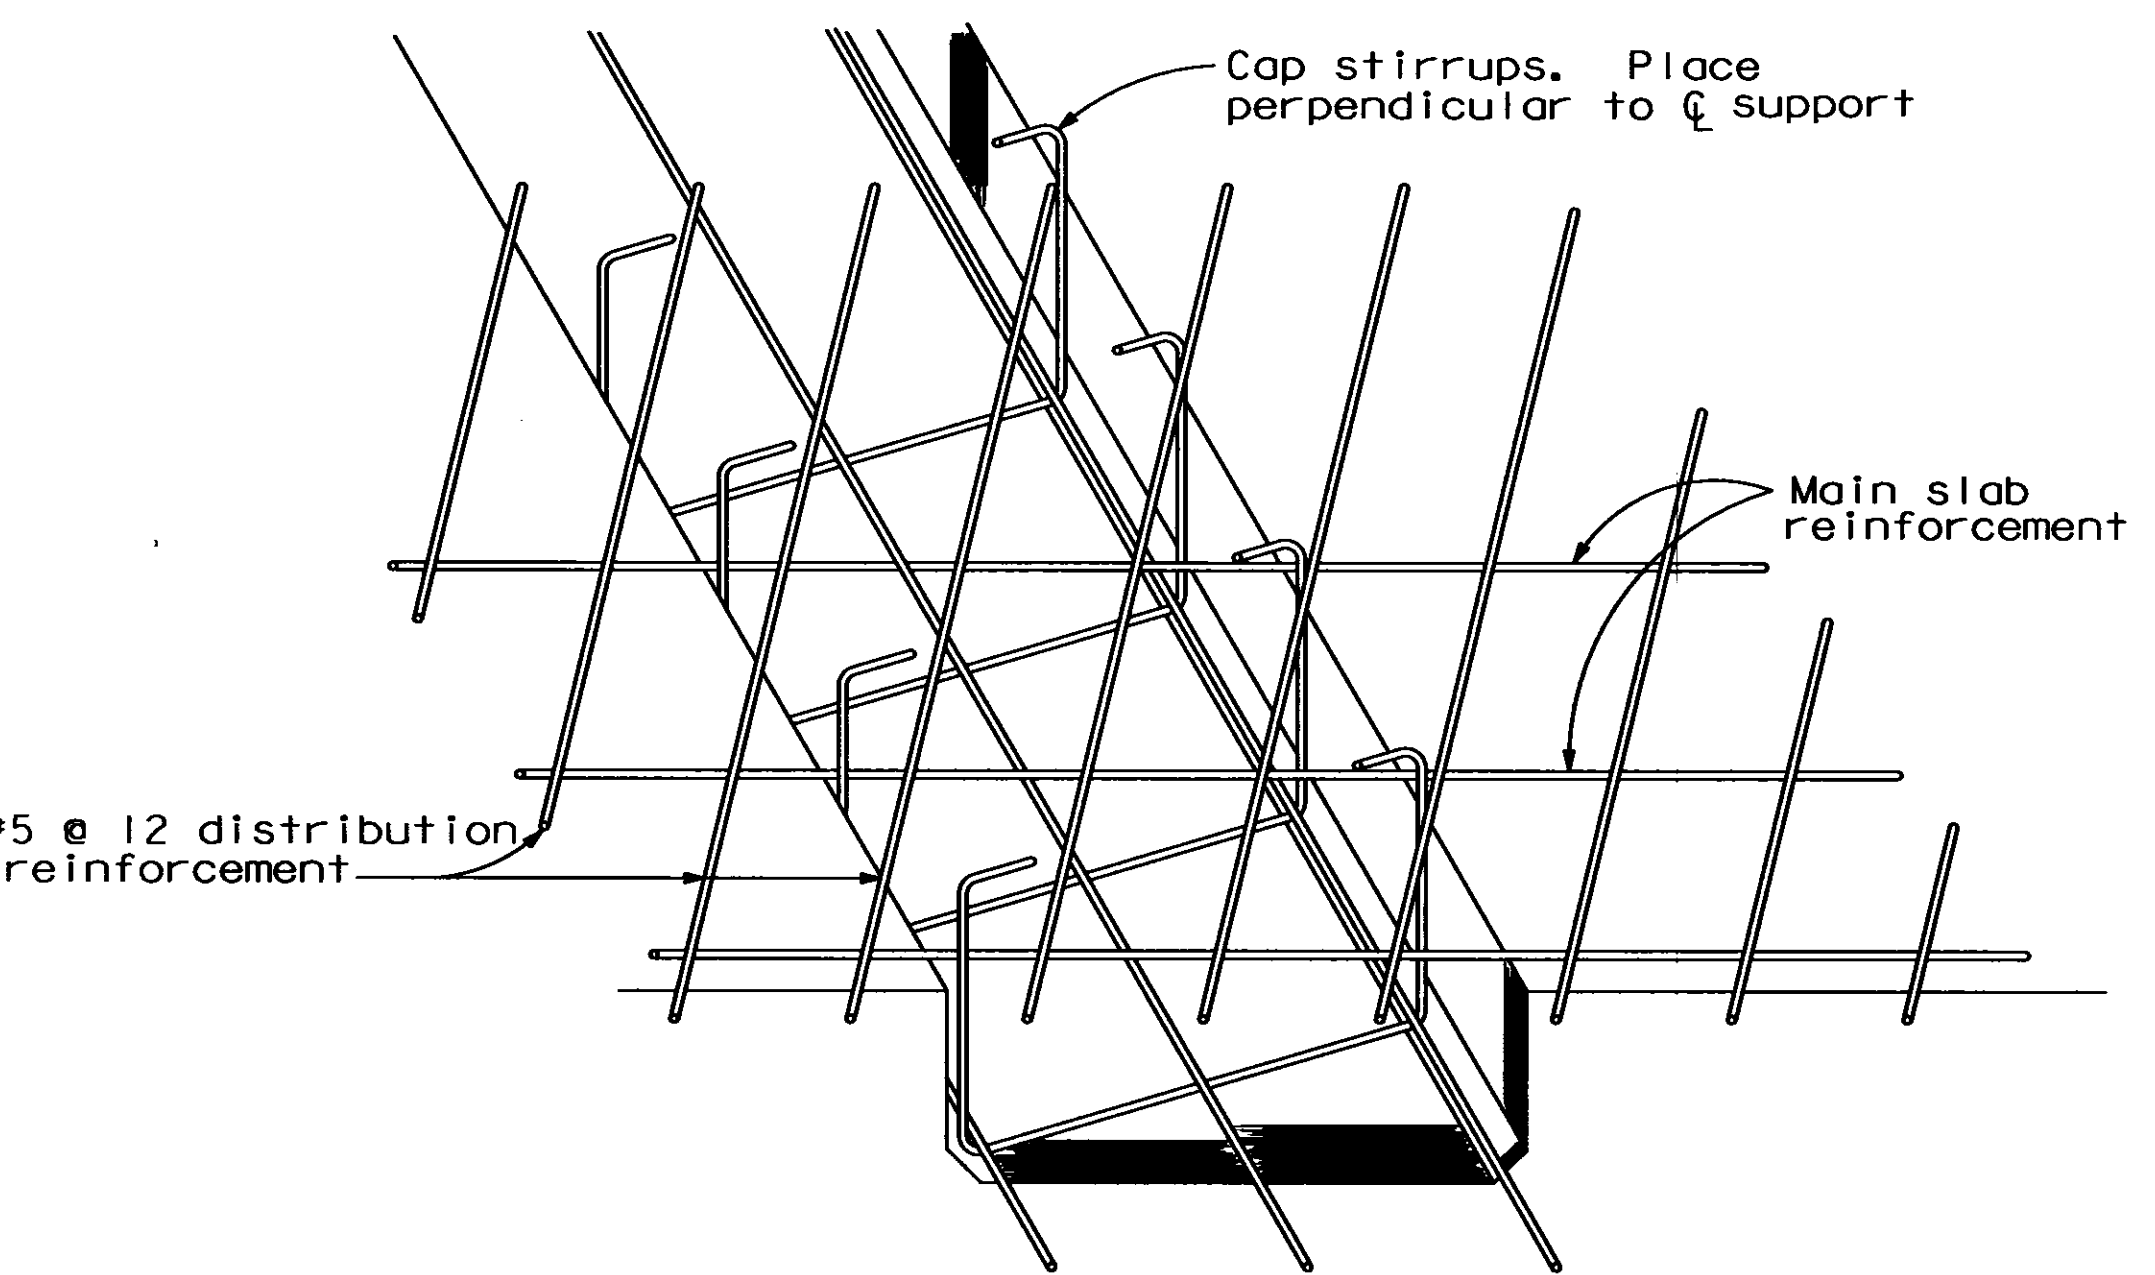

**DROPPED CAP**

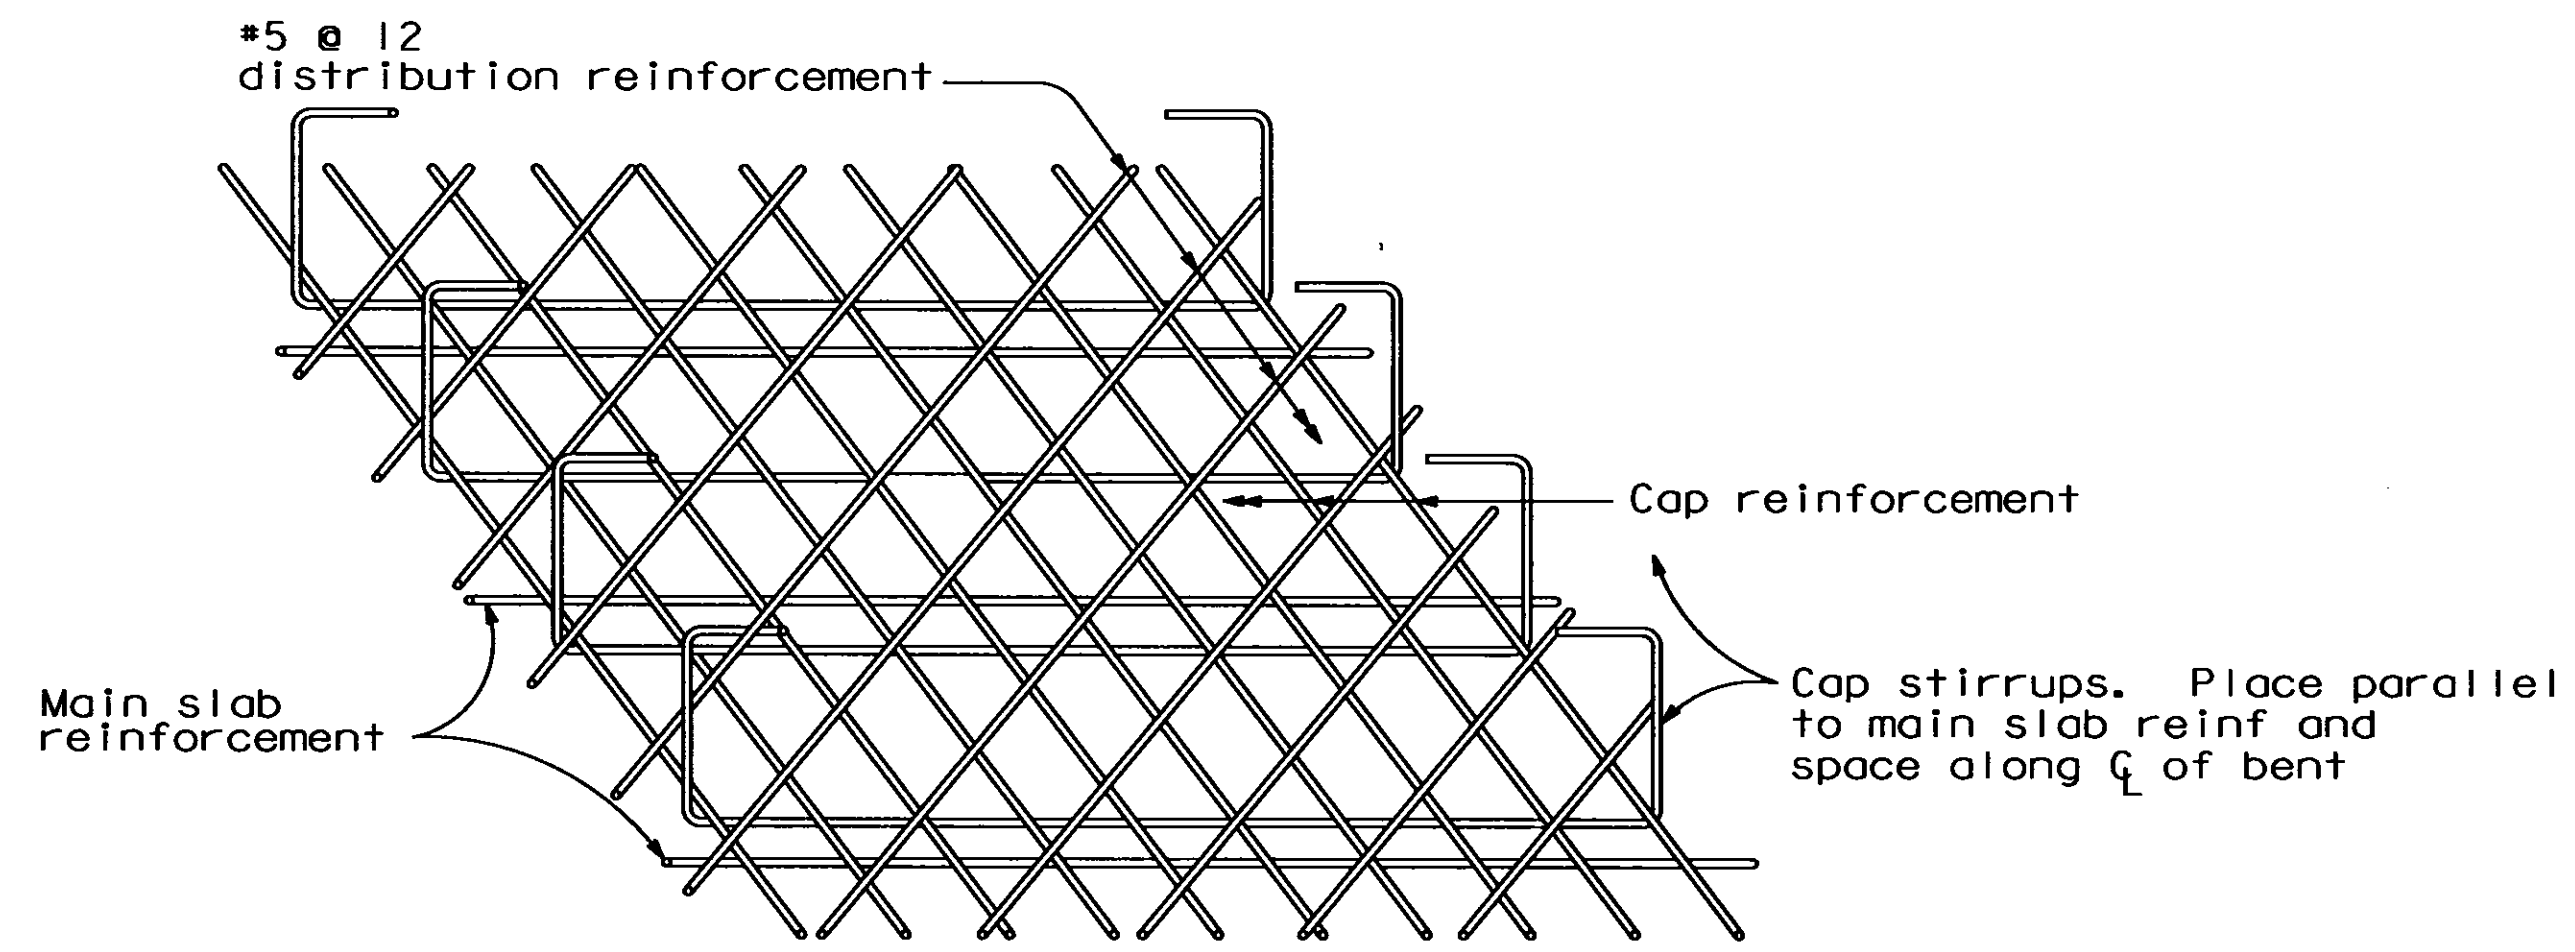

**FLUSH CAP**

**BOTTOM SLAB REINFORCEMENT AT BENT**

*No Change*  
**AS BUILT** *g.s.ian*  
CORRECTIONS BY *Michael Assad*  
CONTRACT NO. *04-149304*  
DATE *12-08-97* *3-2-98*

**EARTHQUAKE RETROFIT PROJECT NO. 412**

STANDARD DRAWING			
FILE NO. <b>XS 12-55</b>	DESIGN BY <i>L.Y. Lee</i>	CHECKED <i>T. Farnan</i>	APPROVAL RECOMMENDED BY <i>Richard D. Ford</i>
DESIGN DATE <b>8/86</b>	DETAILS BY <i>R. YEE</i>	CHECKED <i>T. Farnan</i>	DESIGN SUPERVISOR
SUBMITTED BY <i>R.S. Watanabe</i>			

STATE OF CALIFORNIA  
DEPARTMENT OF TRANSPORTATION

DISTRICT 2  
SEISMIC DESIGN

BRIDGE NO. 21-0014  
POST MILE 16.5

Changed notes

DRY CREEK BRIDGE	
SLAB REINFORCEMENT DETAILS	
DISREGARD PRINTS BEARING EARLIER REVISION DATES	REVISION DATES (PRELIMINARY STAGE ONLY)
6-5-96 7-30-96	
SHEET 9	OF 16

ORIGINAL SCALE IN INCHES FOR REDUCED PLANS


CU 04  
EA 149301

DIST.	COUNTY	ROUTE	POST MILES TOTAL PROJECT	SHEET NO.	TOTAL SHEETS
04	Nap	29	16.3/16.7	62	68

*Garry Tolen*  
REGISTERED ENGINEER - CIVIL  
No. 25298  
Exp. 12-31-97  
CIVIL  
STATE OF CALIFORNIA


11-18-96  
PLANS APPROVAL DATE

The State of California or its officers or agents shall not be responsible for the accuracy or completeness of electronic copies of this plan sheet.

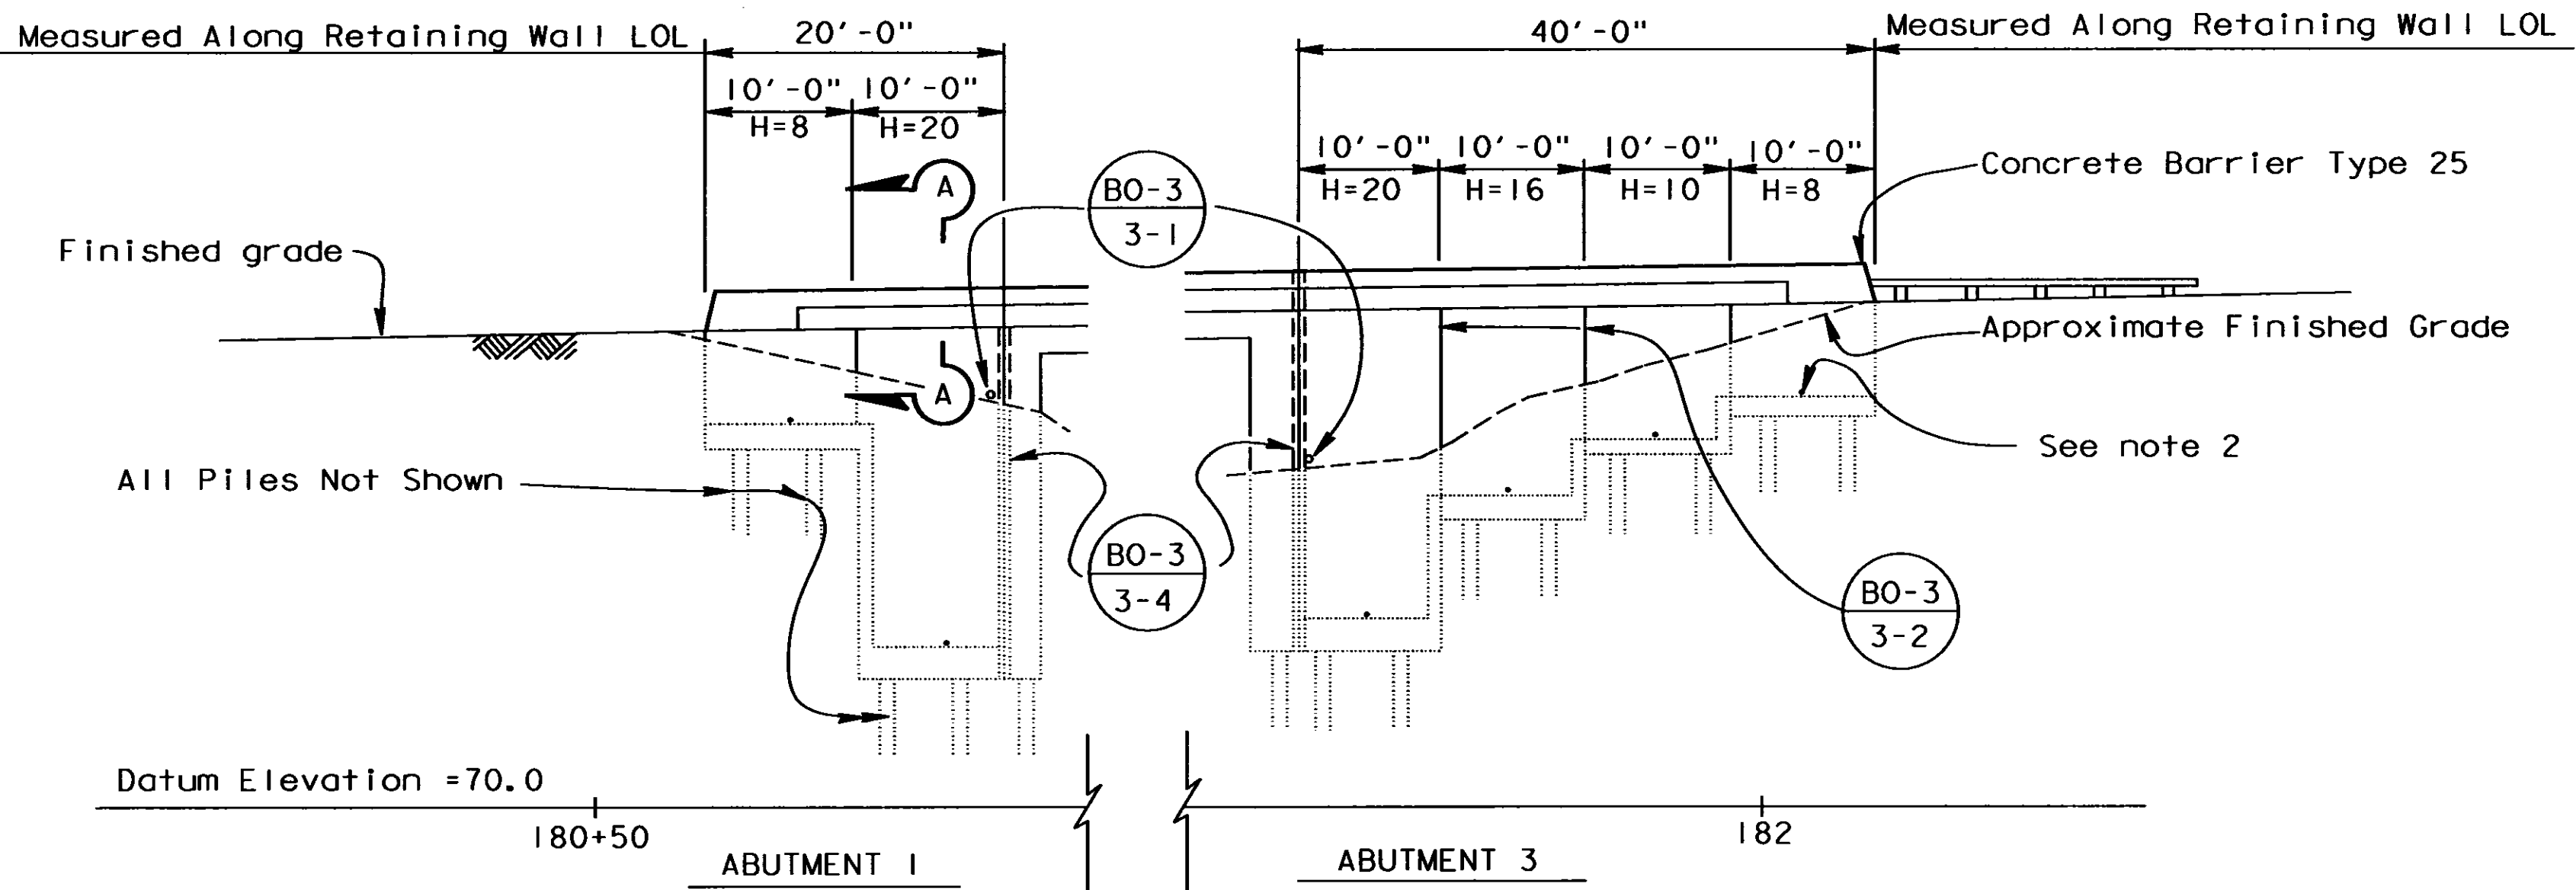


**RETAINING WALL MIRROR ELEVATION**  
1" = 10'-0"

(B0-3) (B3-1) (B3-8)

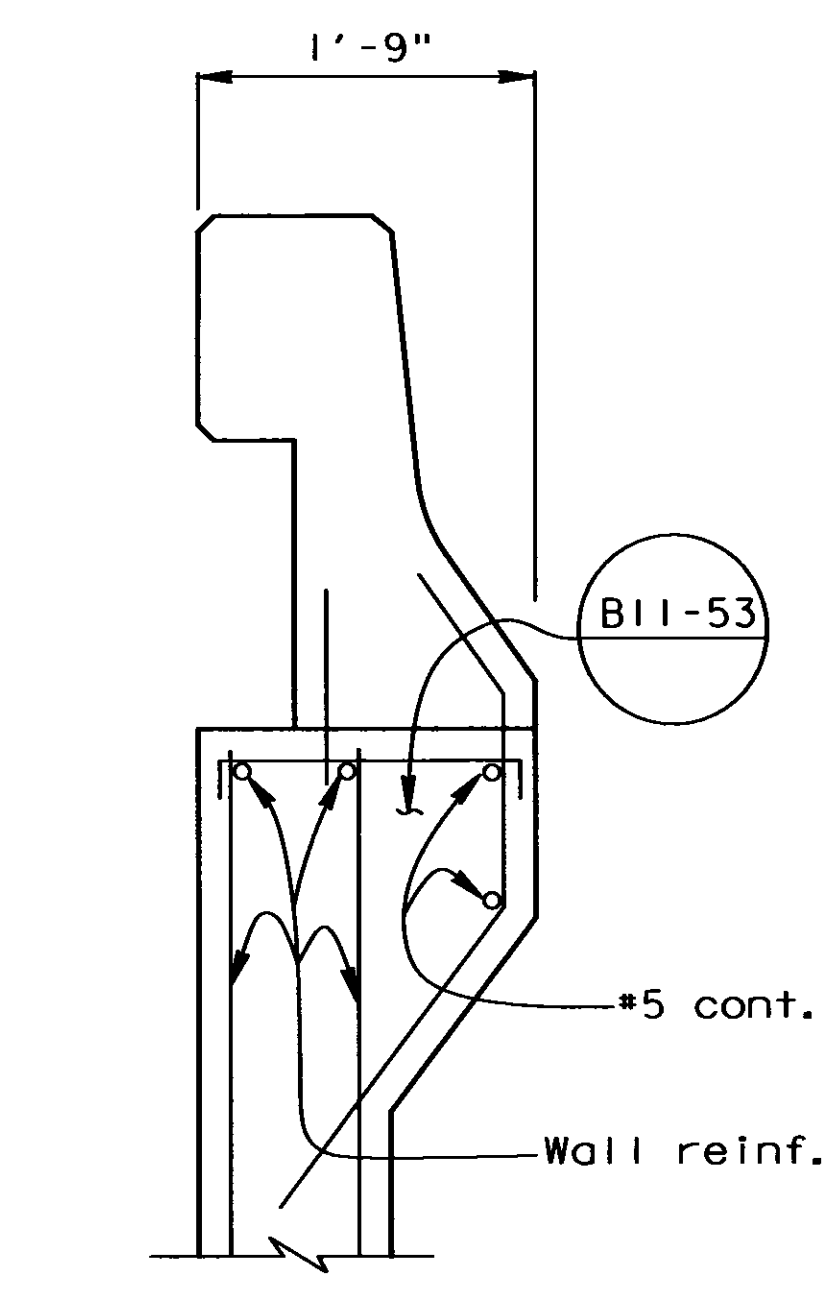

**SECTION A-A**  
1" = 10'-0"

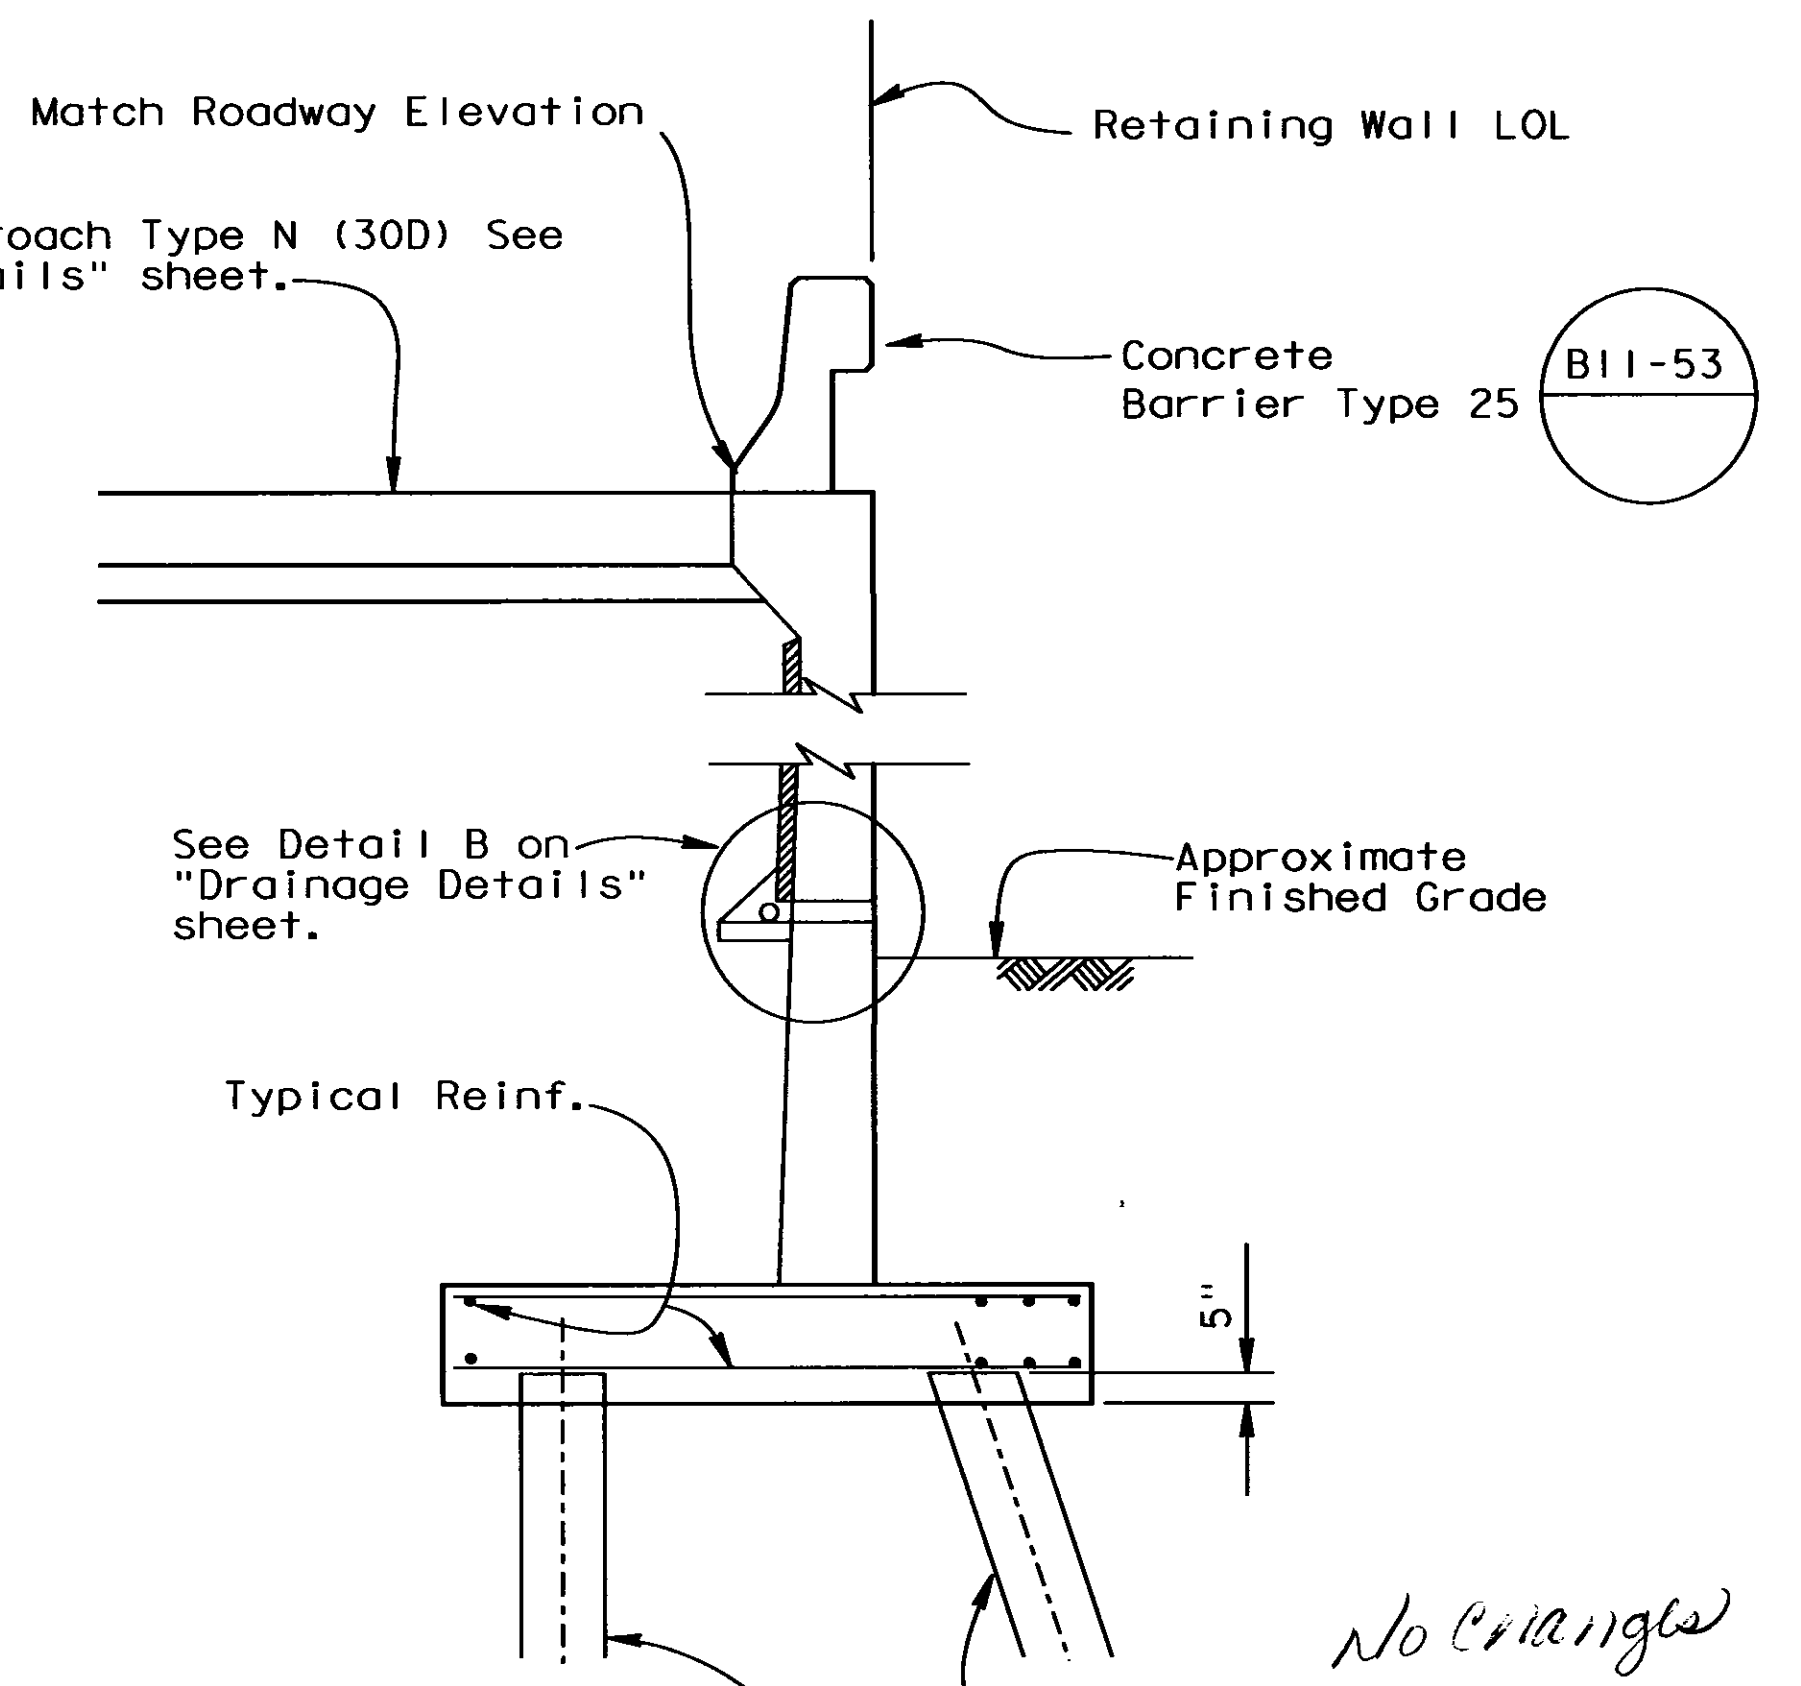

**TYPICAL SECTION**  
3/8" = 1'-0"


*No Changes*

**AS BUILT** *of Jan*

CORRECTIONS BY *Michael Aswad*

CONTRACT NO. *04-149304*

DATE *12-08-97* *3-2-98*

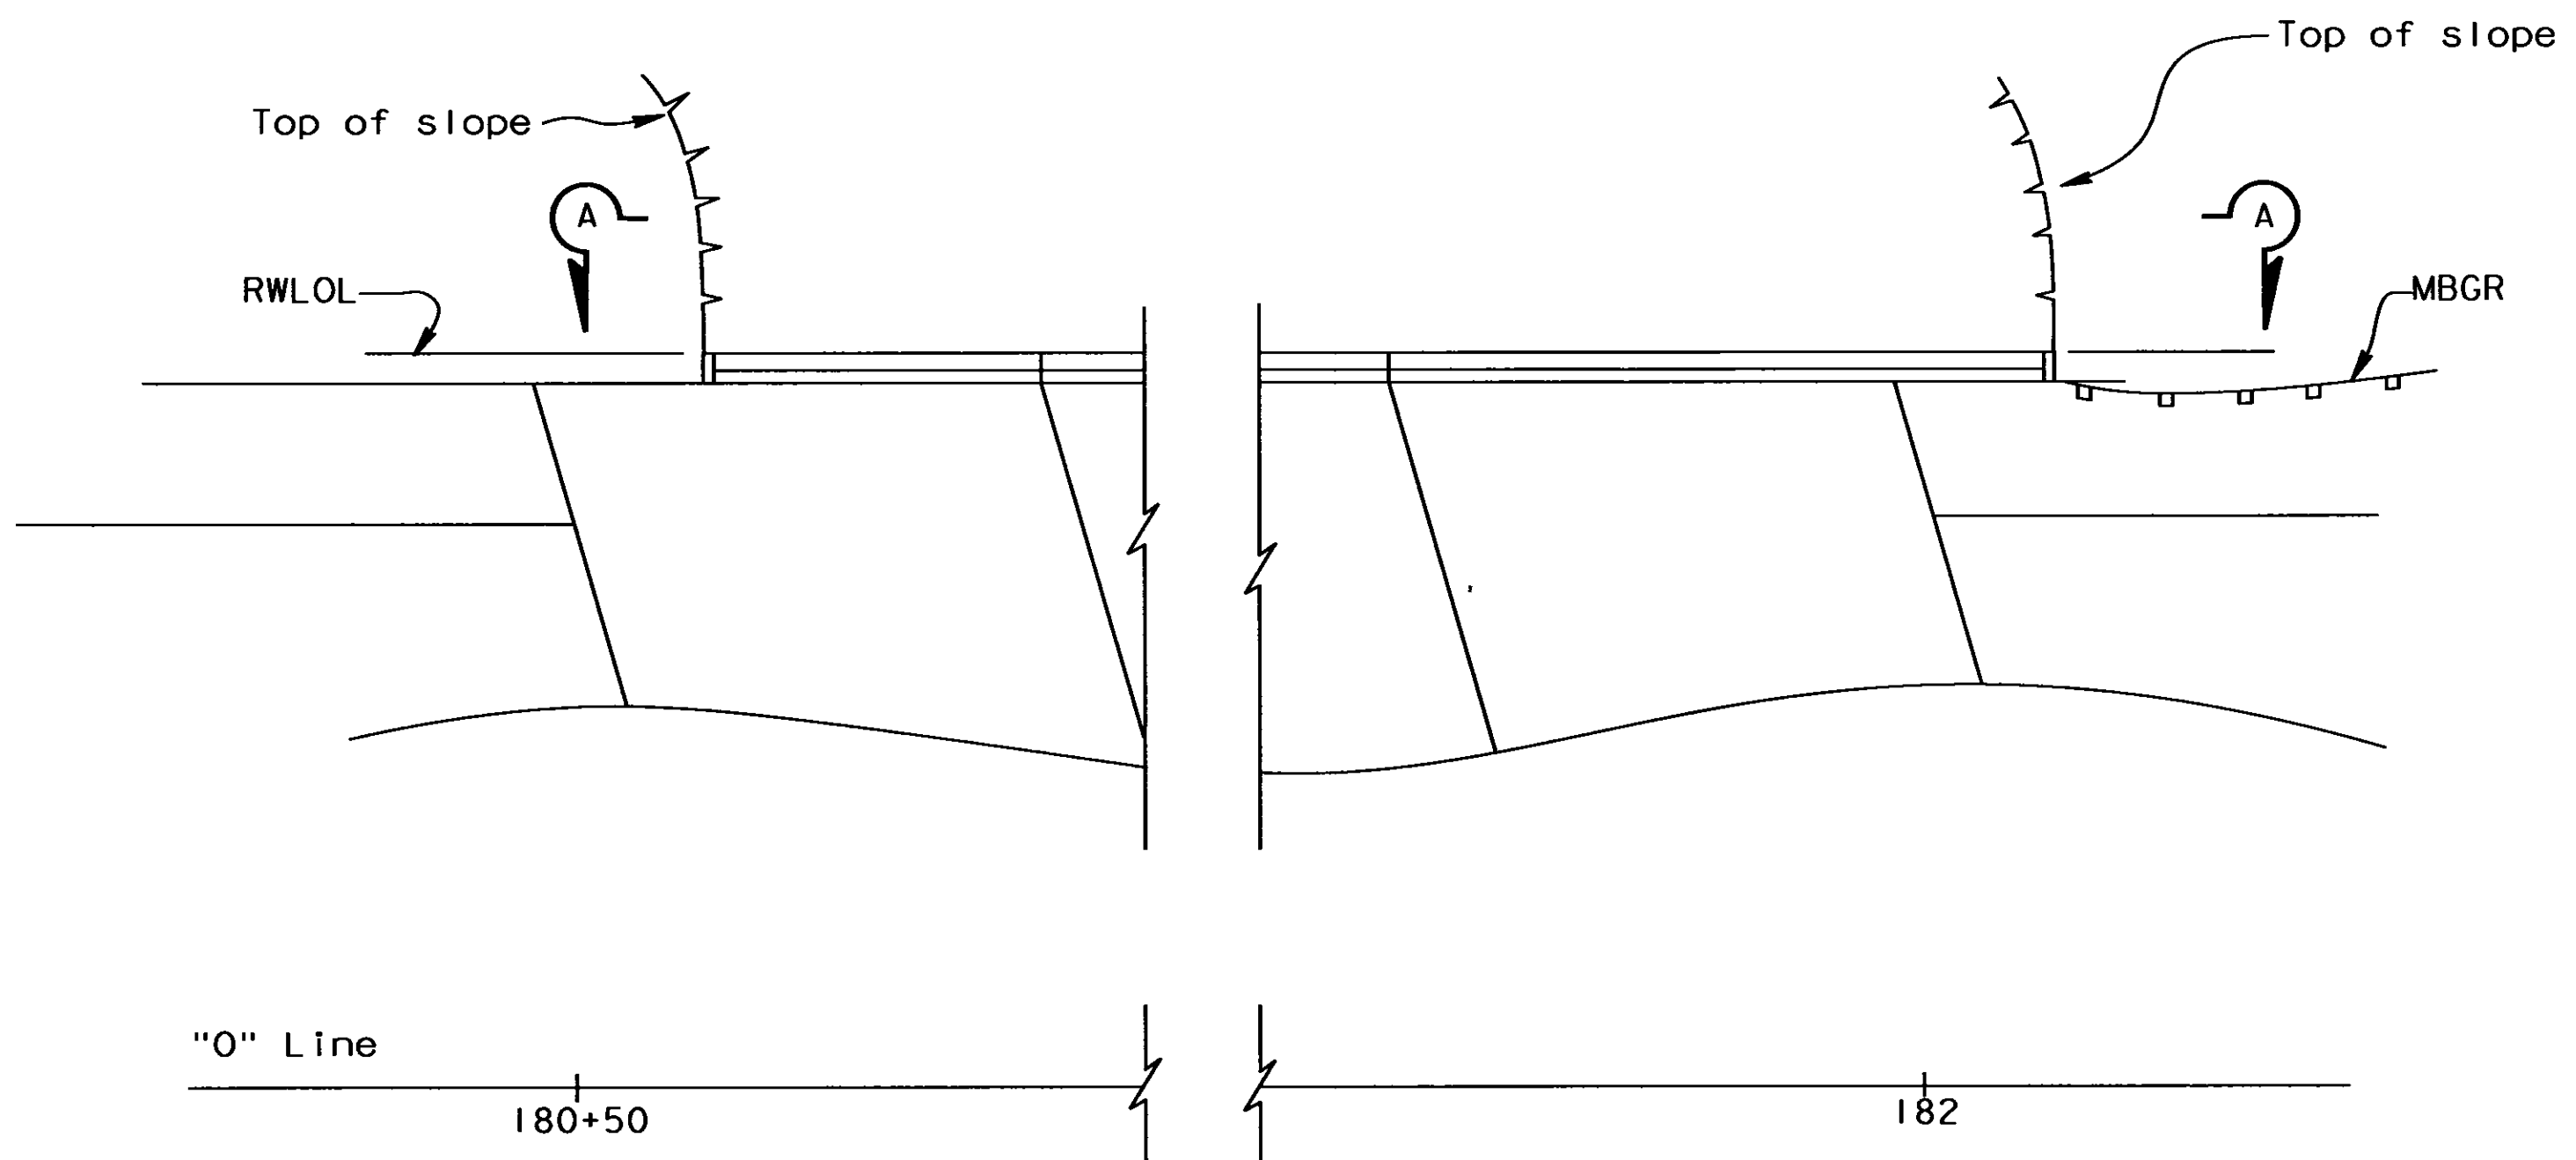

**PLAN**  
1" = 10'-0"

- Notes:
- H = Design Height
  - \* = 3" diam. formed hole

<b>EARTHQUAKE RETROFIT PROJECT NO. 412</b>	
<b>DRY CREEK BRIDGE</b>	
<b>RETAINING WALLS DETAILS</b>	
BRIDGE NO. 21-0014	POST MILE 16.5

DESIGN BY Mike Whiteside 5-96	CHECKED Mike Whiteside 5-96
DETAILS BY Janice Sam 5-96	CHECKED Mike Whiteside 5-96
QUANTITIES BY Garry Tolen 6-96	CHECKED Kristi Westoby 6-96

**STATE OF CALIFORNIA**  
DEPARTMENT OF TRANSPORTATION

**DISTRICT 2**  
**SEISMIC DESIGN**

CU 04  
EA 149301

DISREGARD PRINTS BEARING EARLIER REVISION DATES	REVISION DATES (PRELIMINARY STAGE ONLY)	SHEET	OF
	5-30-96 6-2-96 1-10-96	10	16


USERNAME => trlenard  
aartw18065728

DATE PLOTTED => 18-Nov-1996  
TIME PLOTTED => 08:57





DIST.	COUNTY	ROUTE	POST MILES TOTAL PROJECT	SHEET NO.	TOTAL SHEETS
04	Nap	29	16.3/16.7	63	68

*Garry L. Tolen*  
REGISTERED ENGINEER - CIVIL

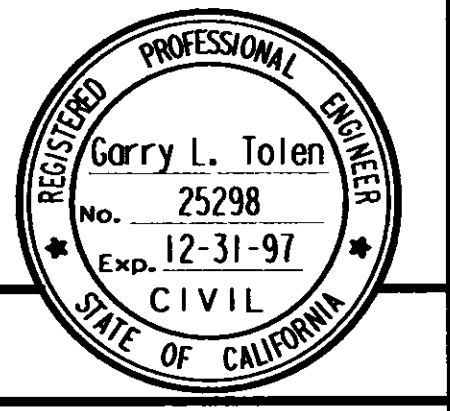

11-18-96  
PLANS APPROVAL DATE

The State of California or its officers or agents shall not be responsible for the accuracy or completeness of electronic copies of this plan sheet.

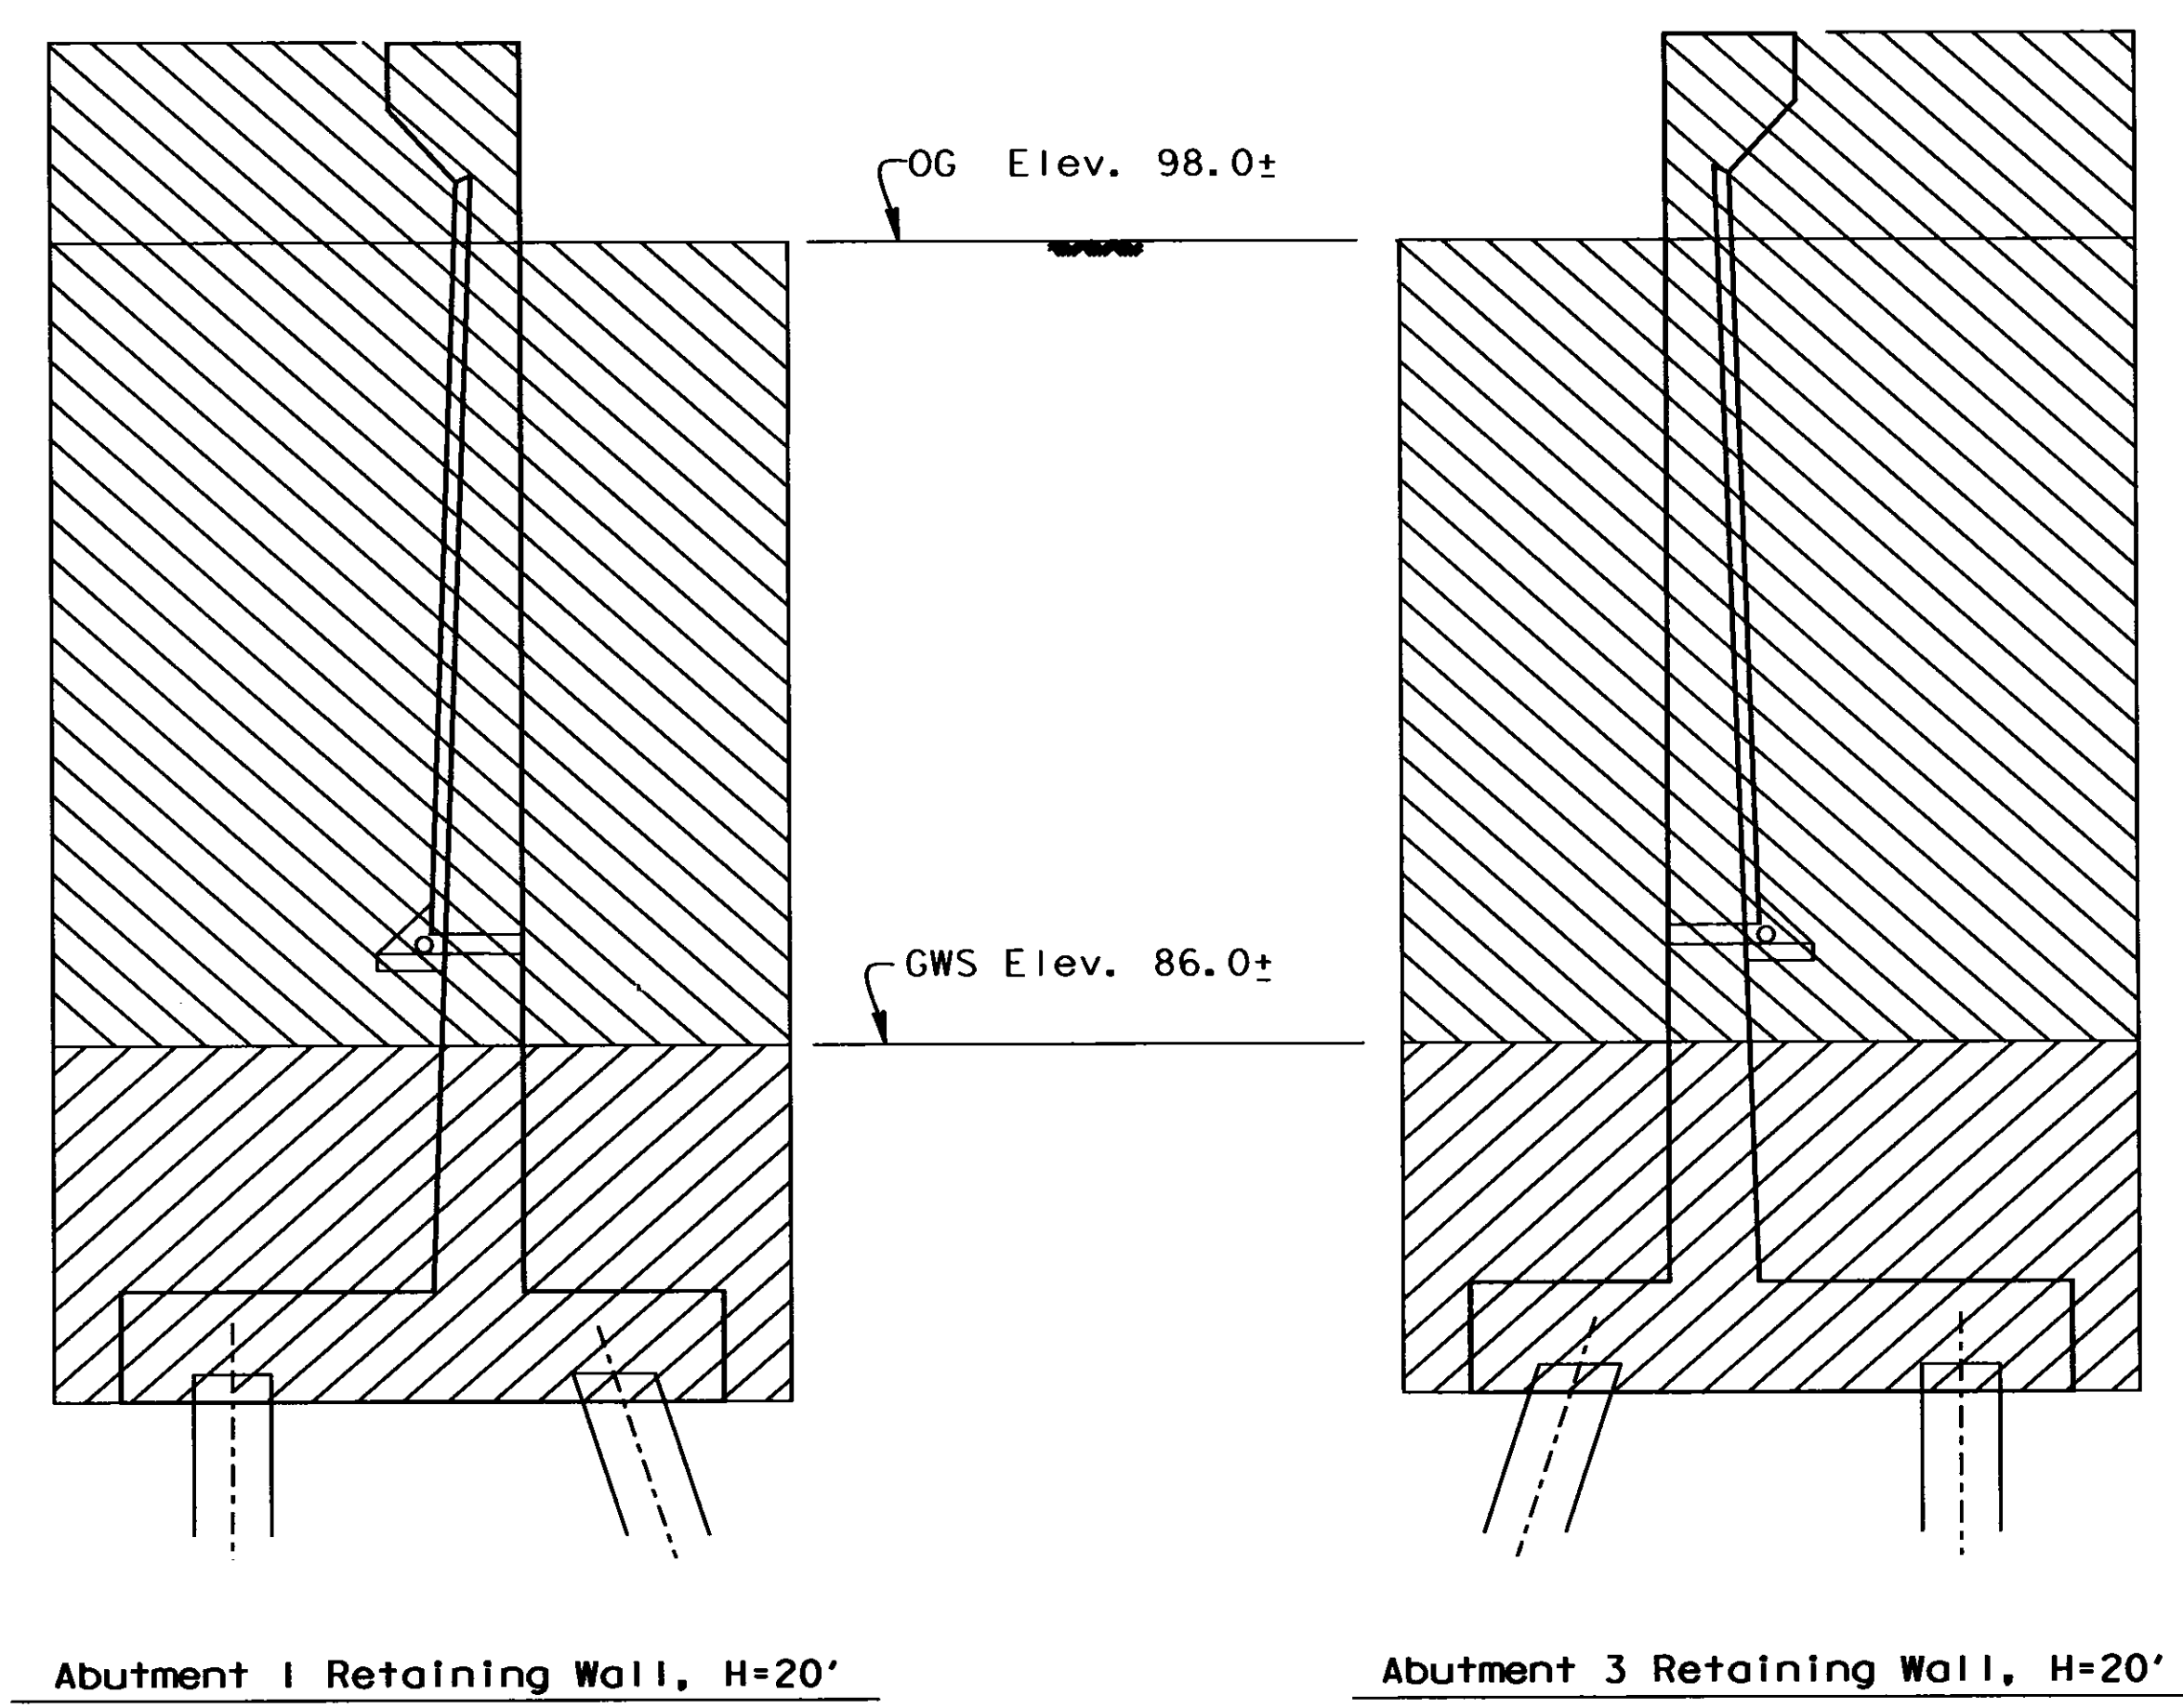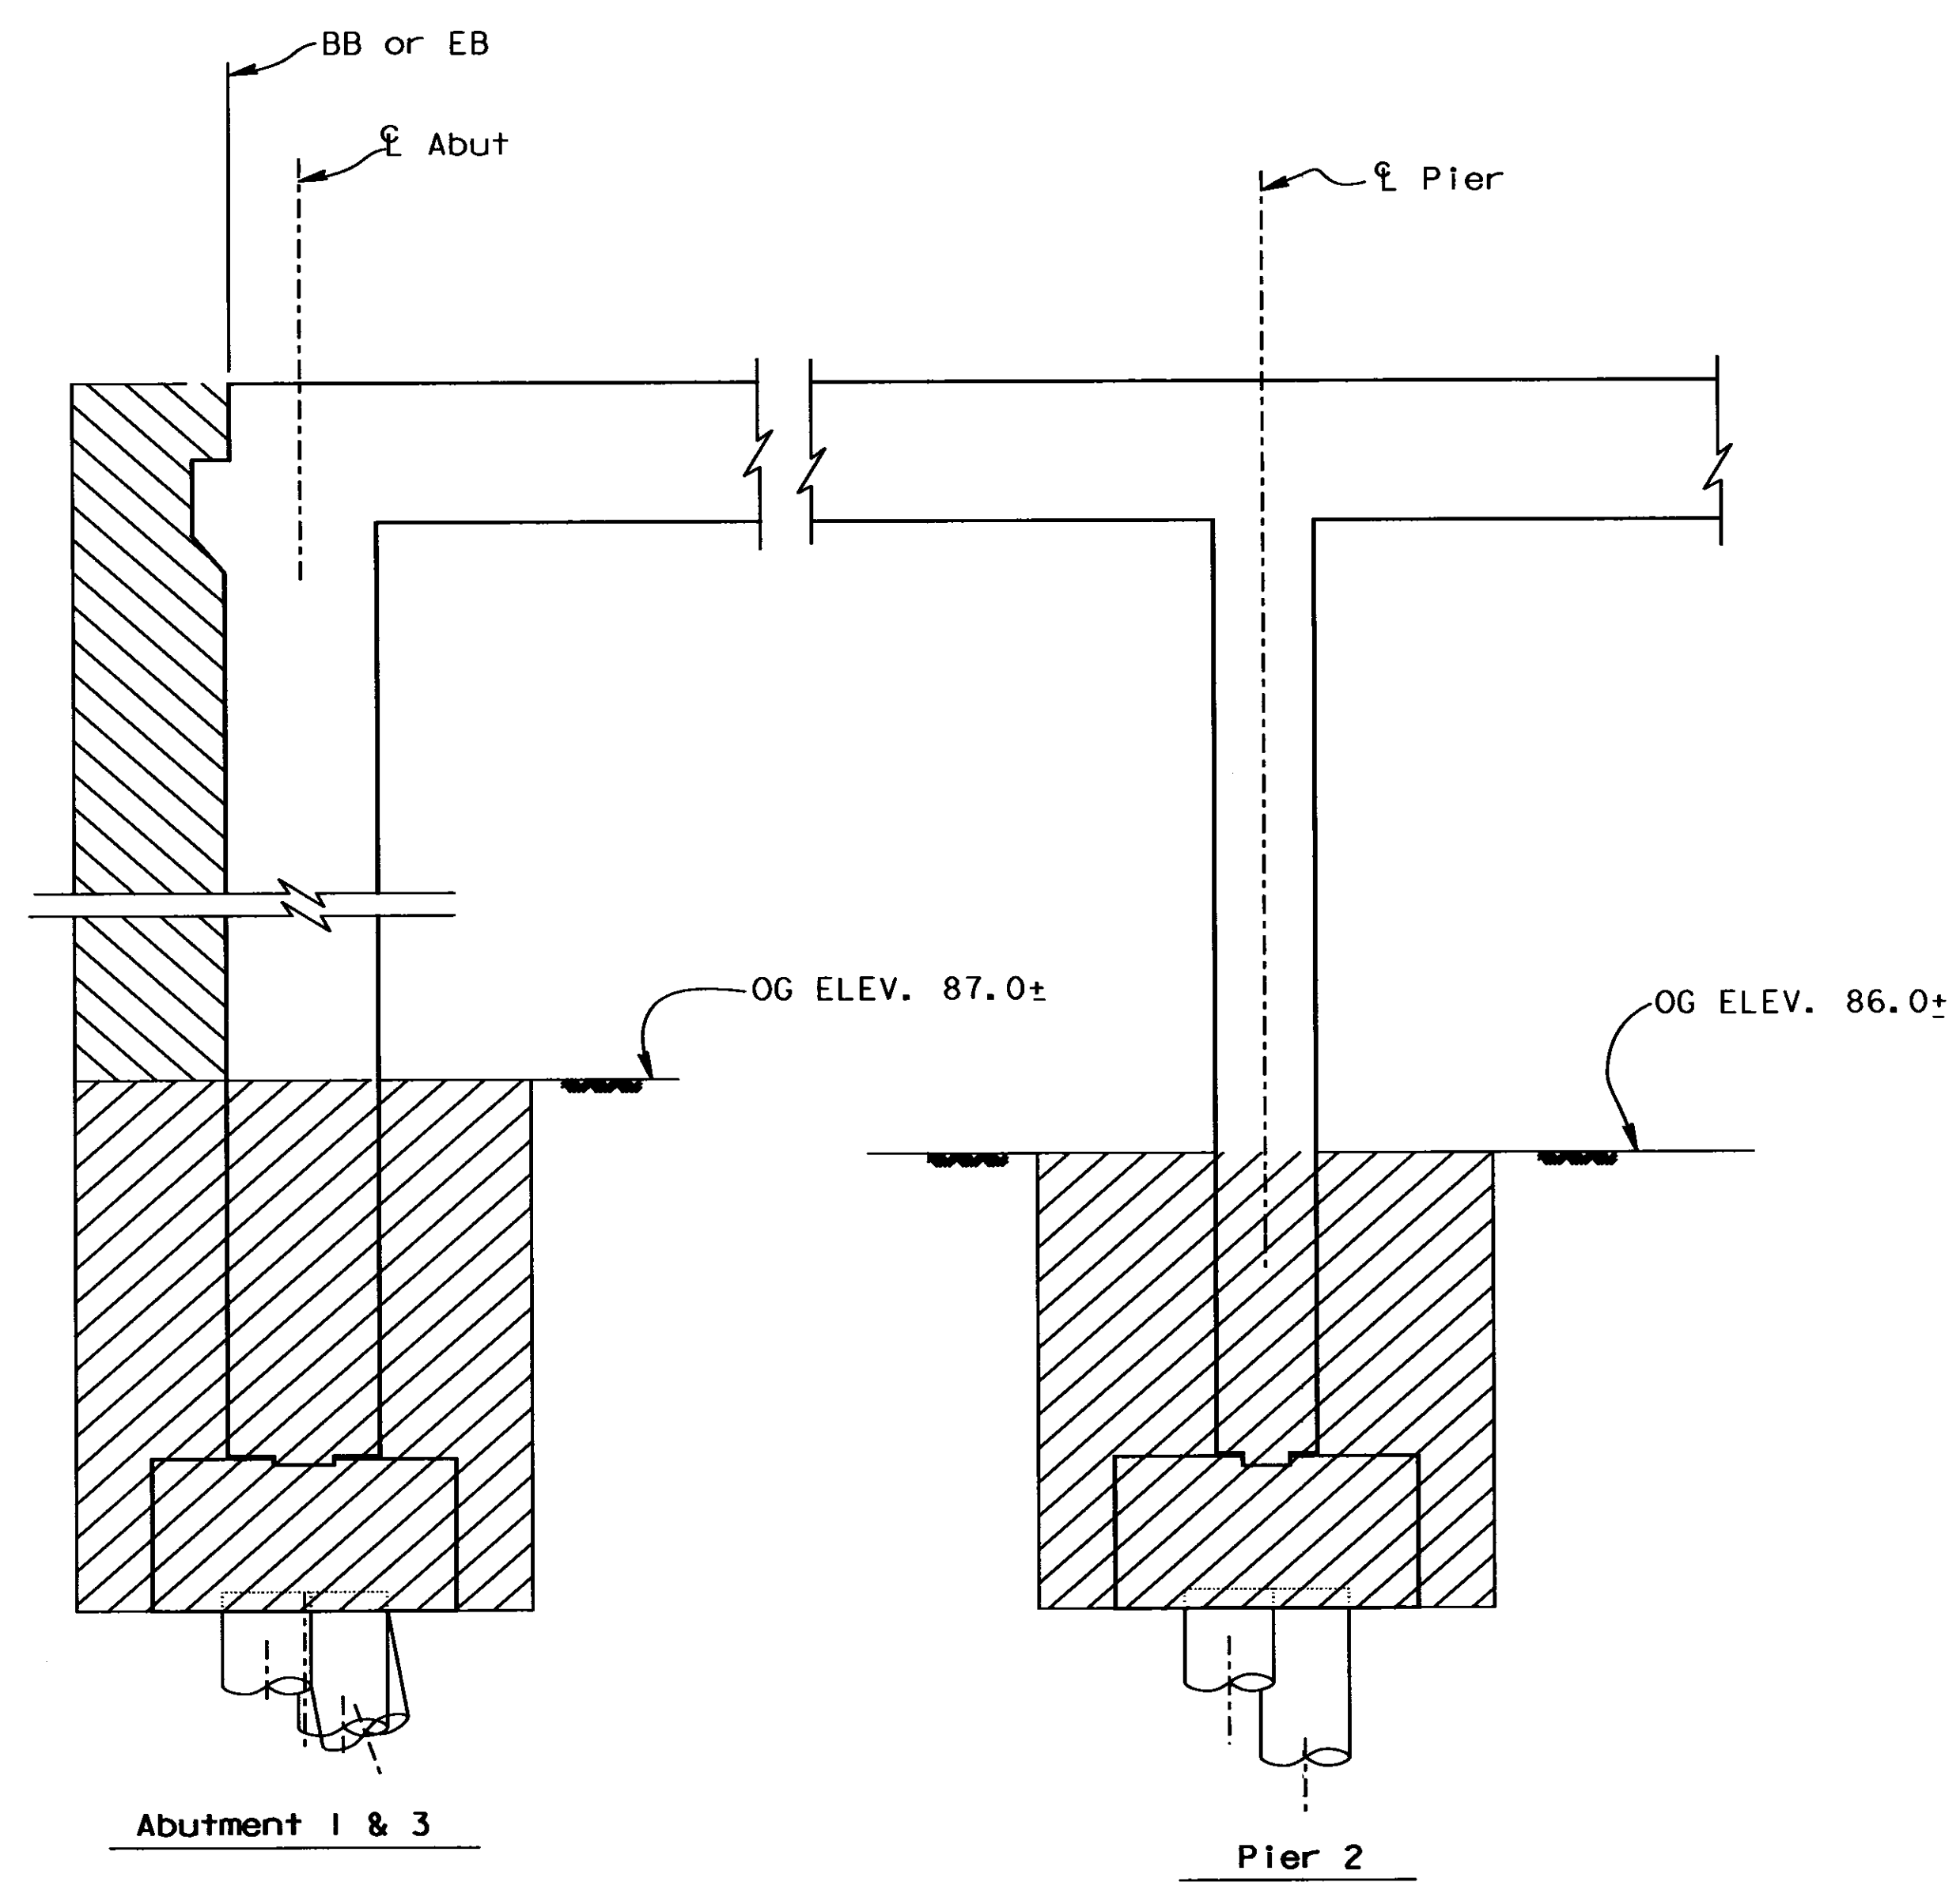

*No Change*  
**AS BUILT**  
CORRECTIONS BY *Michael Assad*  
CONTRACT NO. *04-149304*  
DATE *12-08-97* *3-2-98*

Note:  
For Details not shown, See "Limits of Payment for Structure Excavation and Backfill Bridge" A62-C

Structure Excavation Bridge  
Structure Excavation Bridge (Type D)

**LIMITS OF PAYMENT FOR STRUCTURE EXCAVATION BRIDGE**

No Scale

<b>EARTHQUAKE RETROFIT PROJECT NO. 412</b>	
<b>DRY CREEK BRIDGE</b>	
<b>MISCELLANEOUS DETAILS</b>	


DESIGN	BY Garry Tolen	3-96	CHECKED Mike Whiteside	5-96
DETAILS	BY Janice Sam	3-96	CHECKED Mike Whiteside	5-96
QUANTITIES	BY Garry Tolen	6-96	CHECKED Kristie Westoby	6-96

STATE OF CALIFORNIA  
DEPARTMENT OF TRANSPORTATION

DISTRICT 2  
SEISMIC DESIGN

BRIDGE NO.	21-0014
POST MILE	16.5

ORIGINAL SCALE IN INCHES FOR REDUCED PLANS

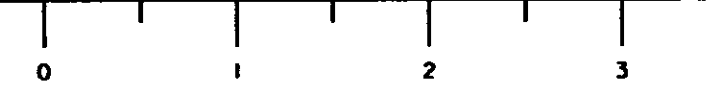

CU 04  
EA 149301

DISREGARD PRINTS BEARING EARLIER REVISION DATES

REVISION DATES (PRELIMINARY STAGE ONLY)							
3-27-96	6-1-96	6-2-96	6-20-96	6-20-96	7-1-96	7-10-96	10-22-96

SHEET	OF
11	16

USERNAME => trlenard  
amsc18065839

amsc

DATE PLOTTED -> 18-NOV-1996  
TIME PLOTTED -> 06:58



DIST.	COUNTY	ROUTE	POST MILES TOTAL PROJECT	SHEET NO.	TOTAL SHEETS
04	Nap	29	16.3/16.7	64	68

*Garry Tolen*  
 REGISTERED ENGINEER - CIVIL  
 No. 25298  
 Exp. 12-31-97  
 CIVIL  
 STATE OF CALIFORNIA





11-18-96  
 PLANS APPROVAL DATE

The State of California or its officers or agents shall not be responsible for the accuracy or completeness of electronic copies of this plan sheet.

NOTES:

- Stage 1 Removal
- Stage 3 Removal

All Elevations given are referenced from 1938 As-Built

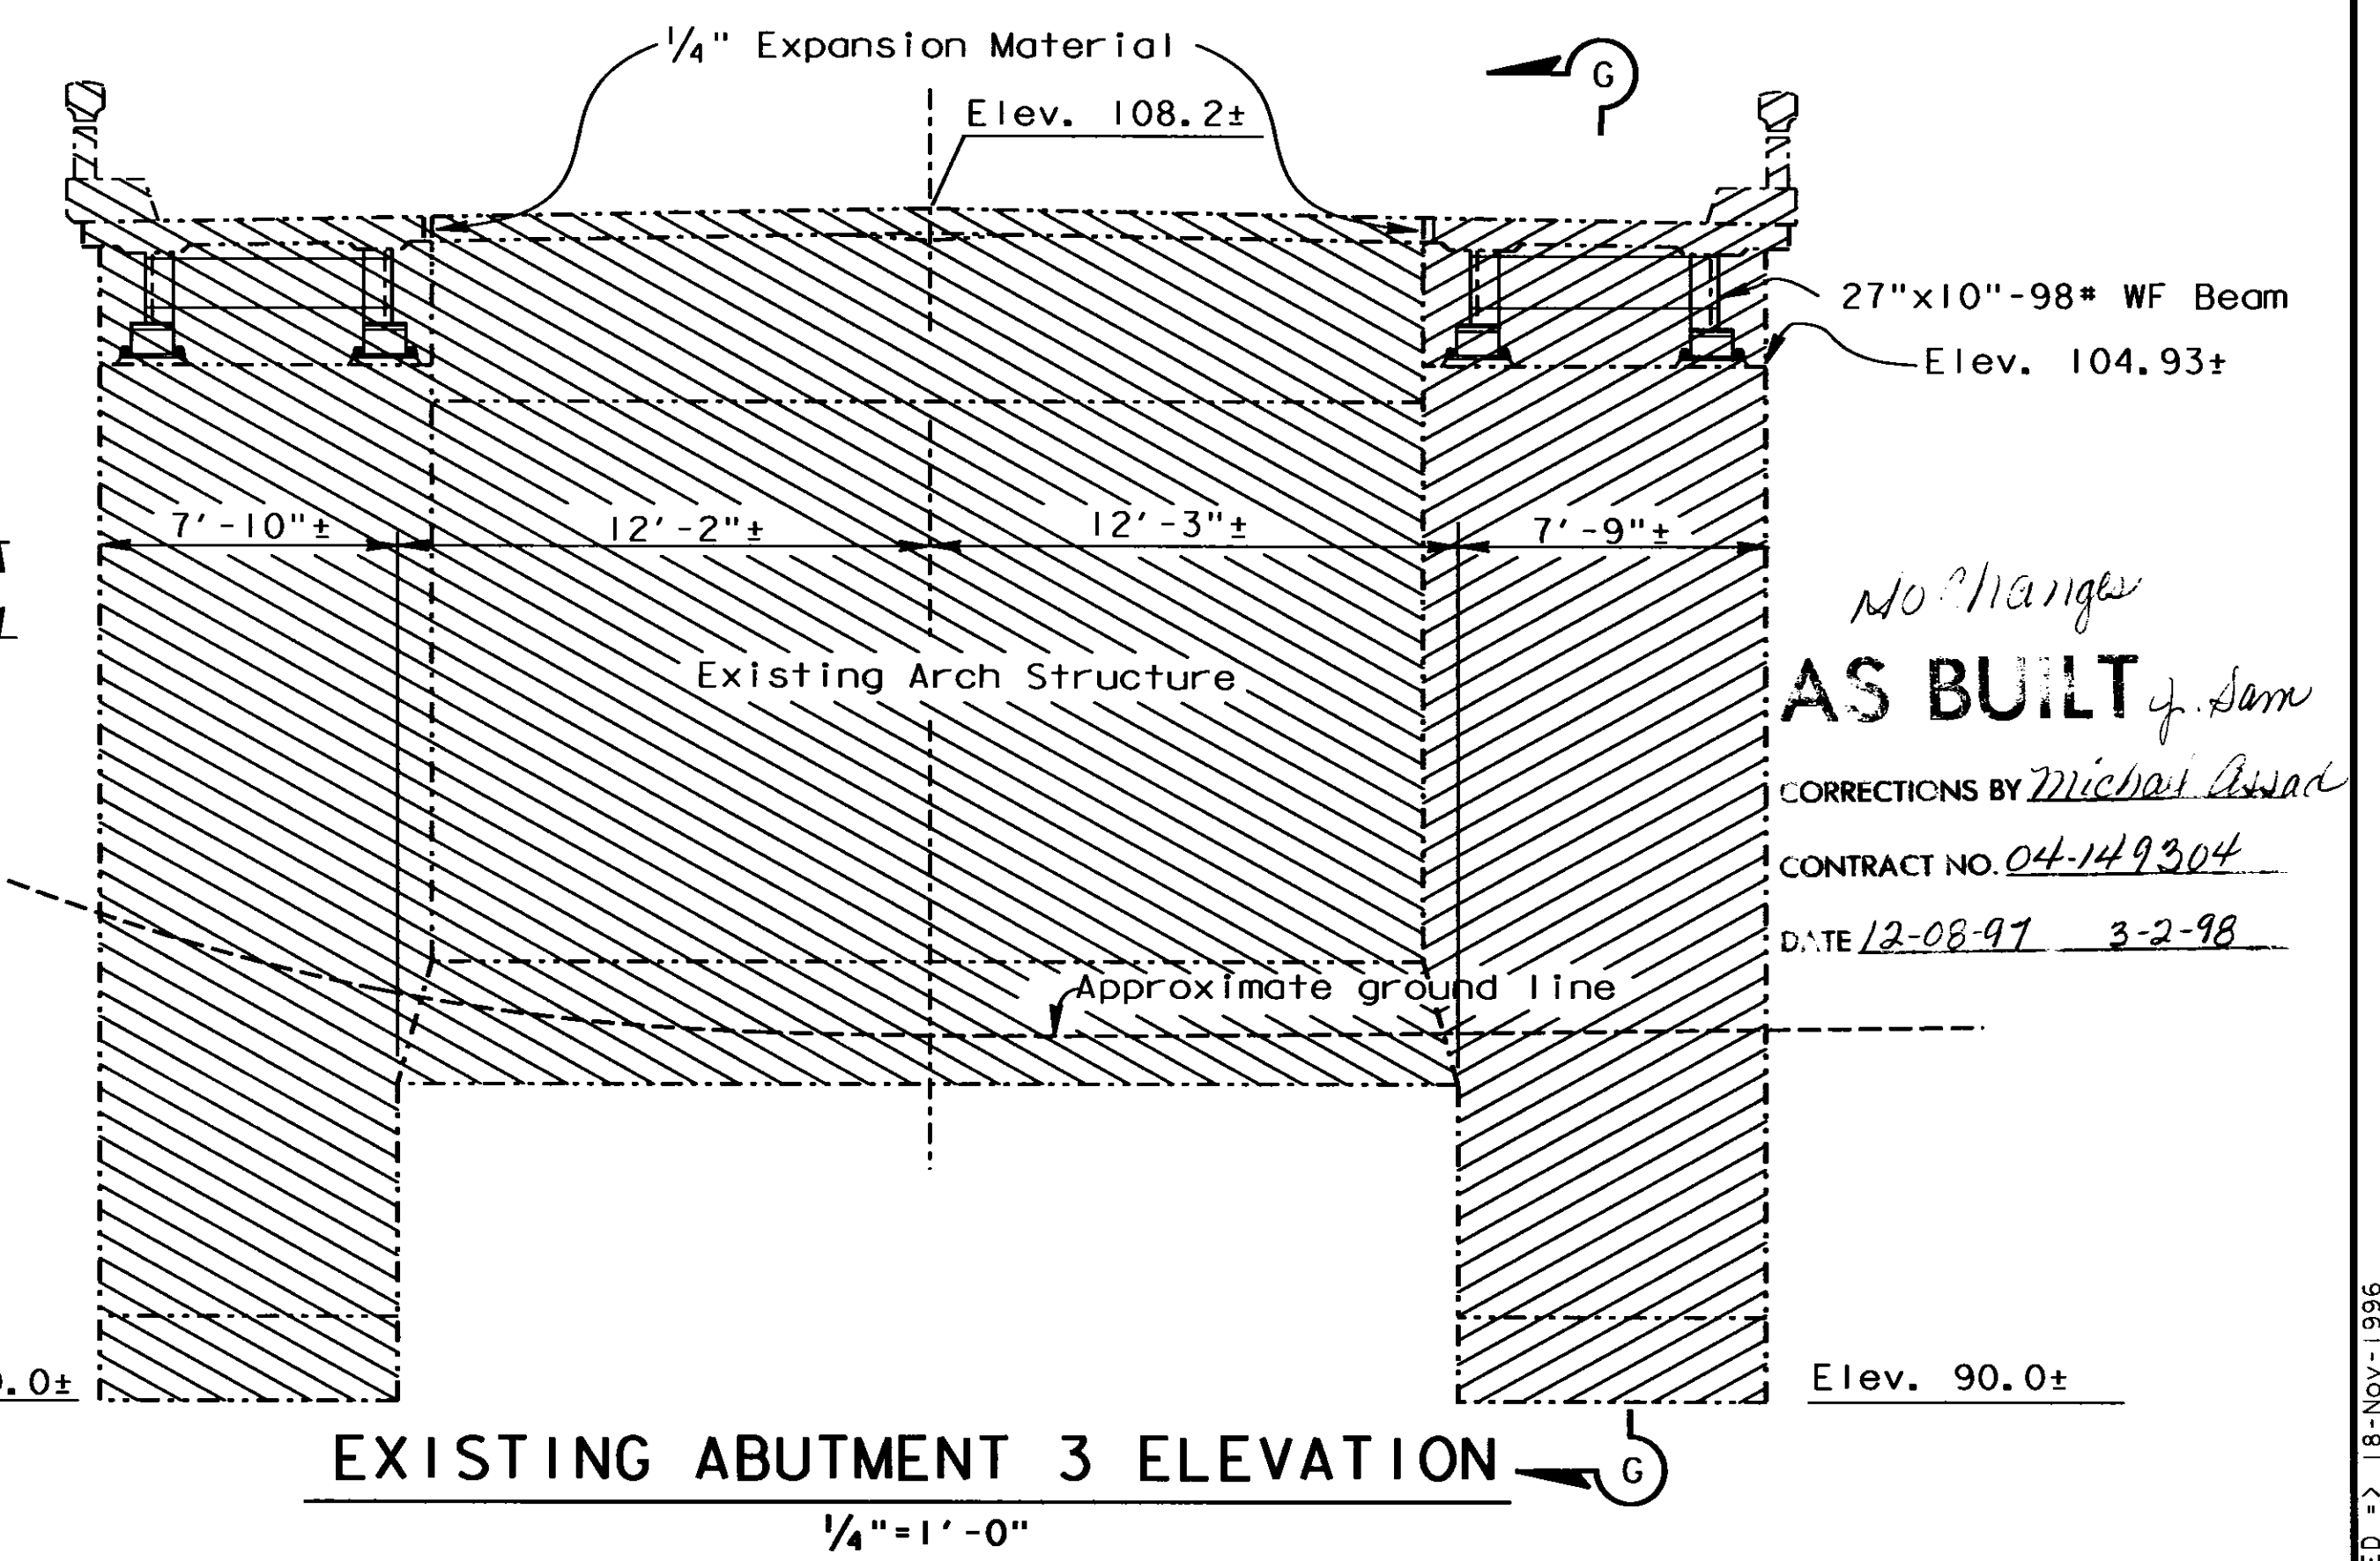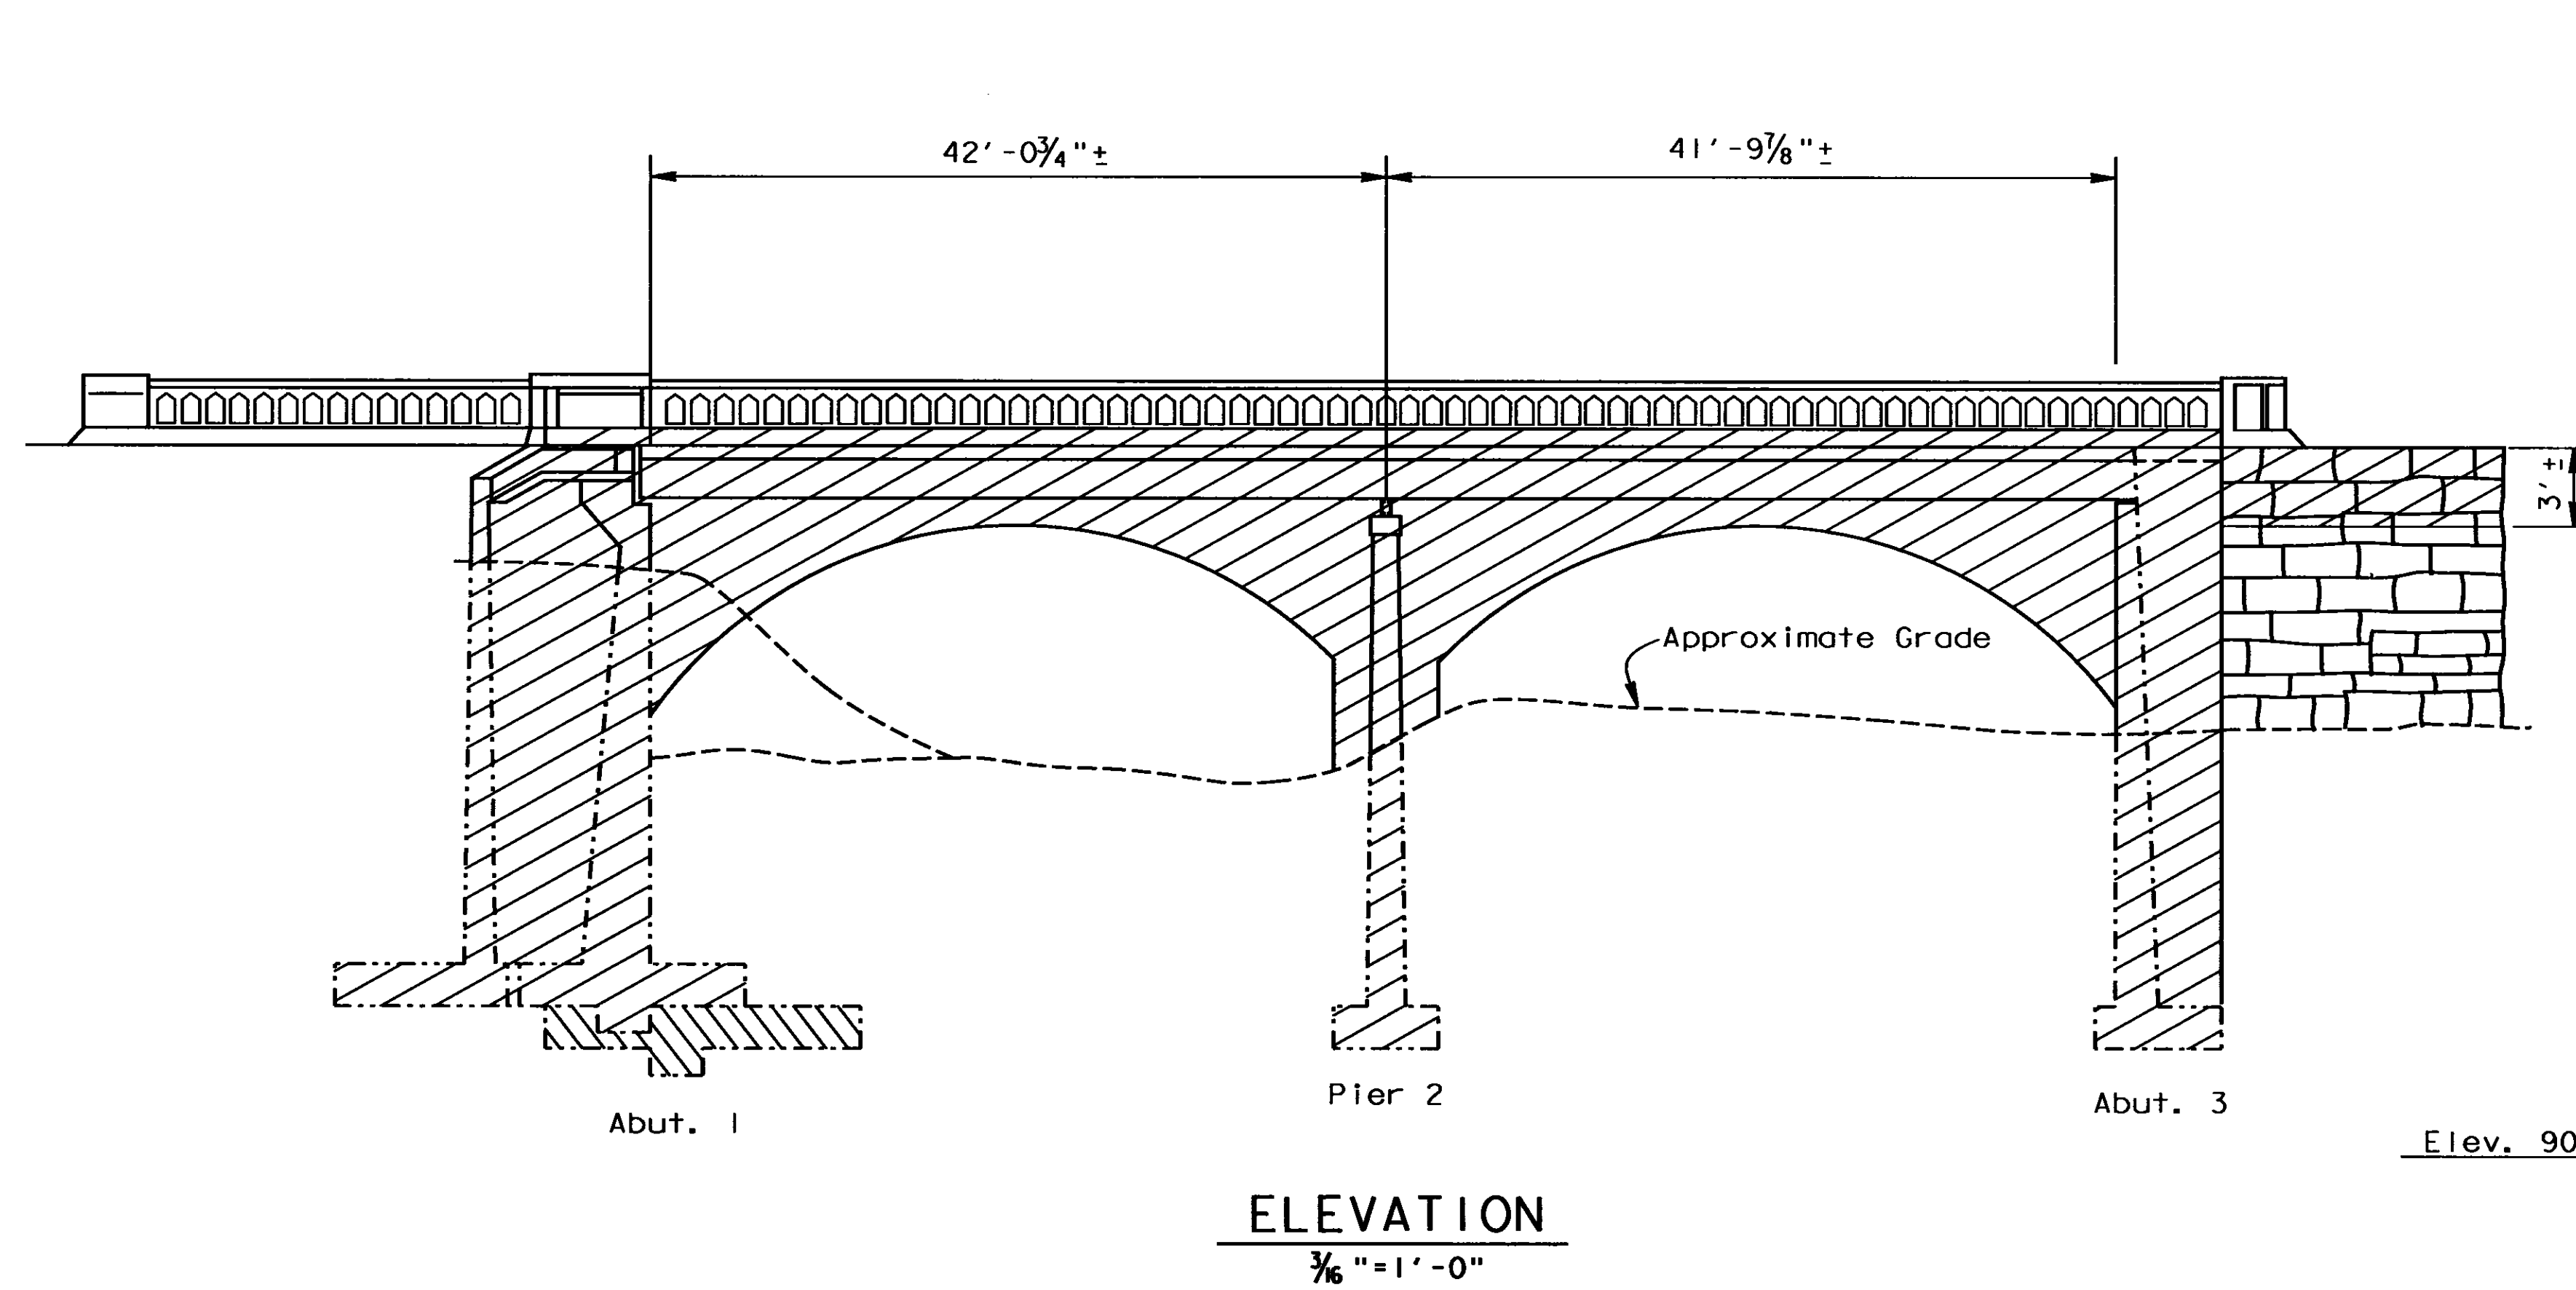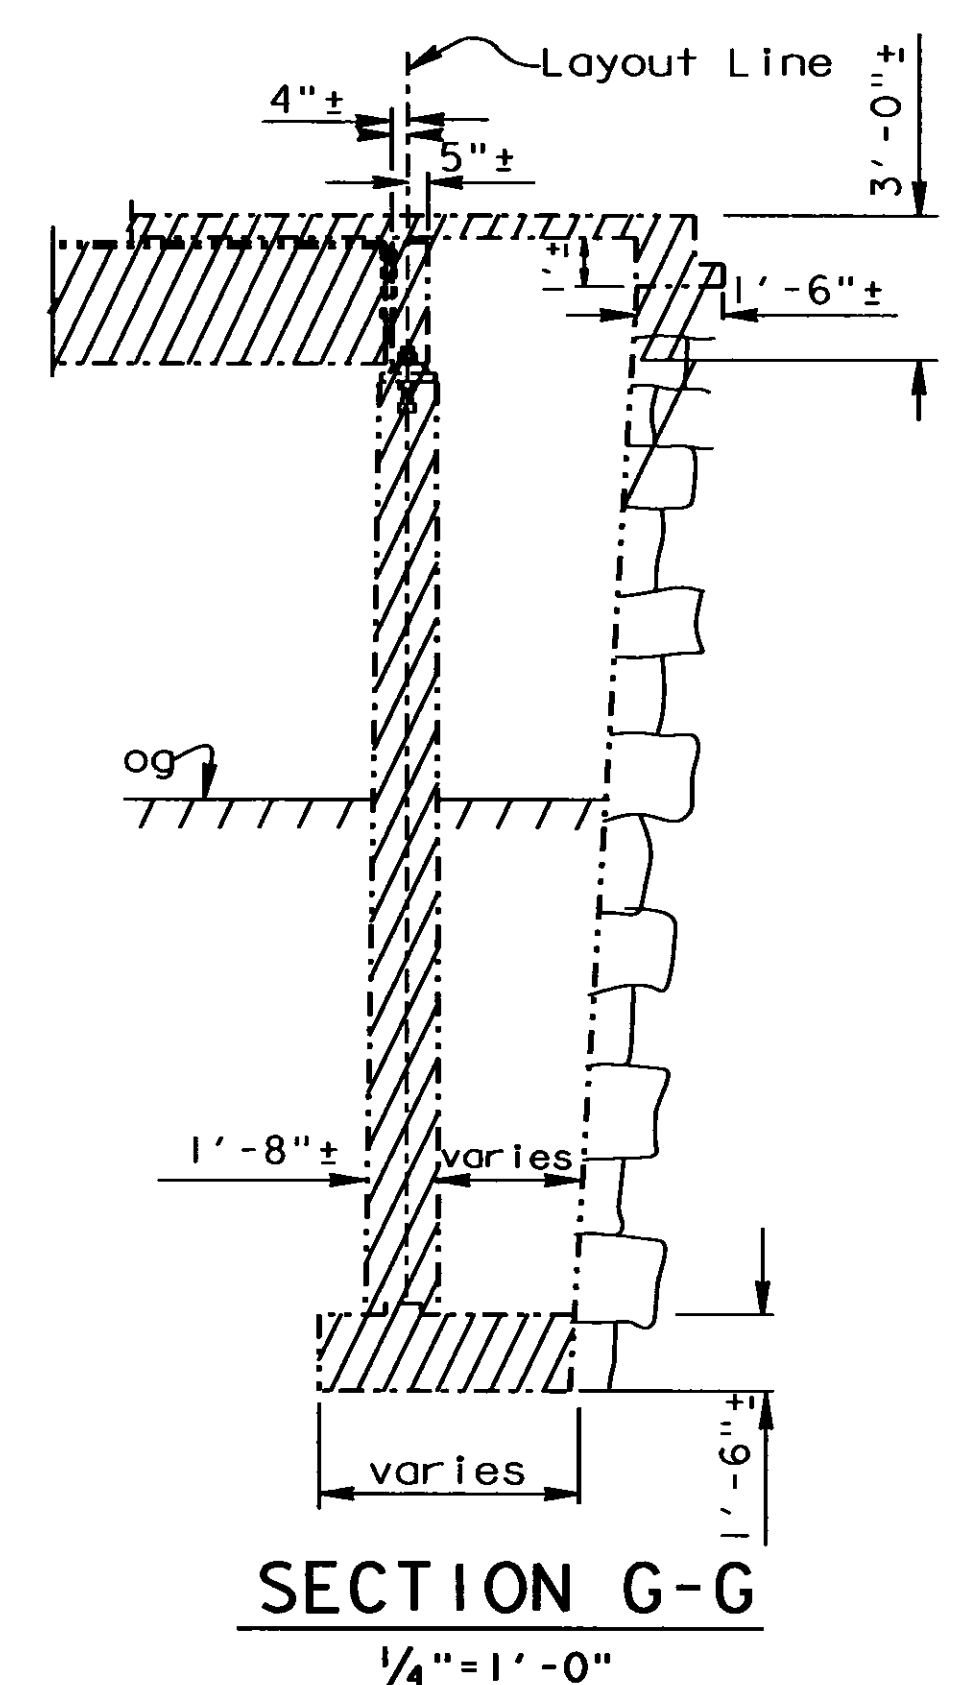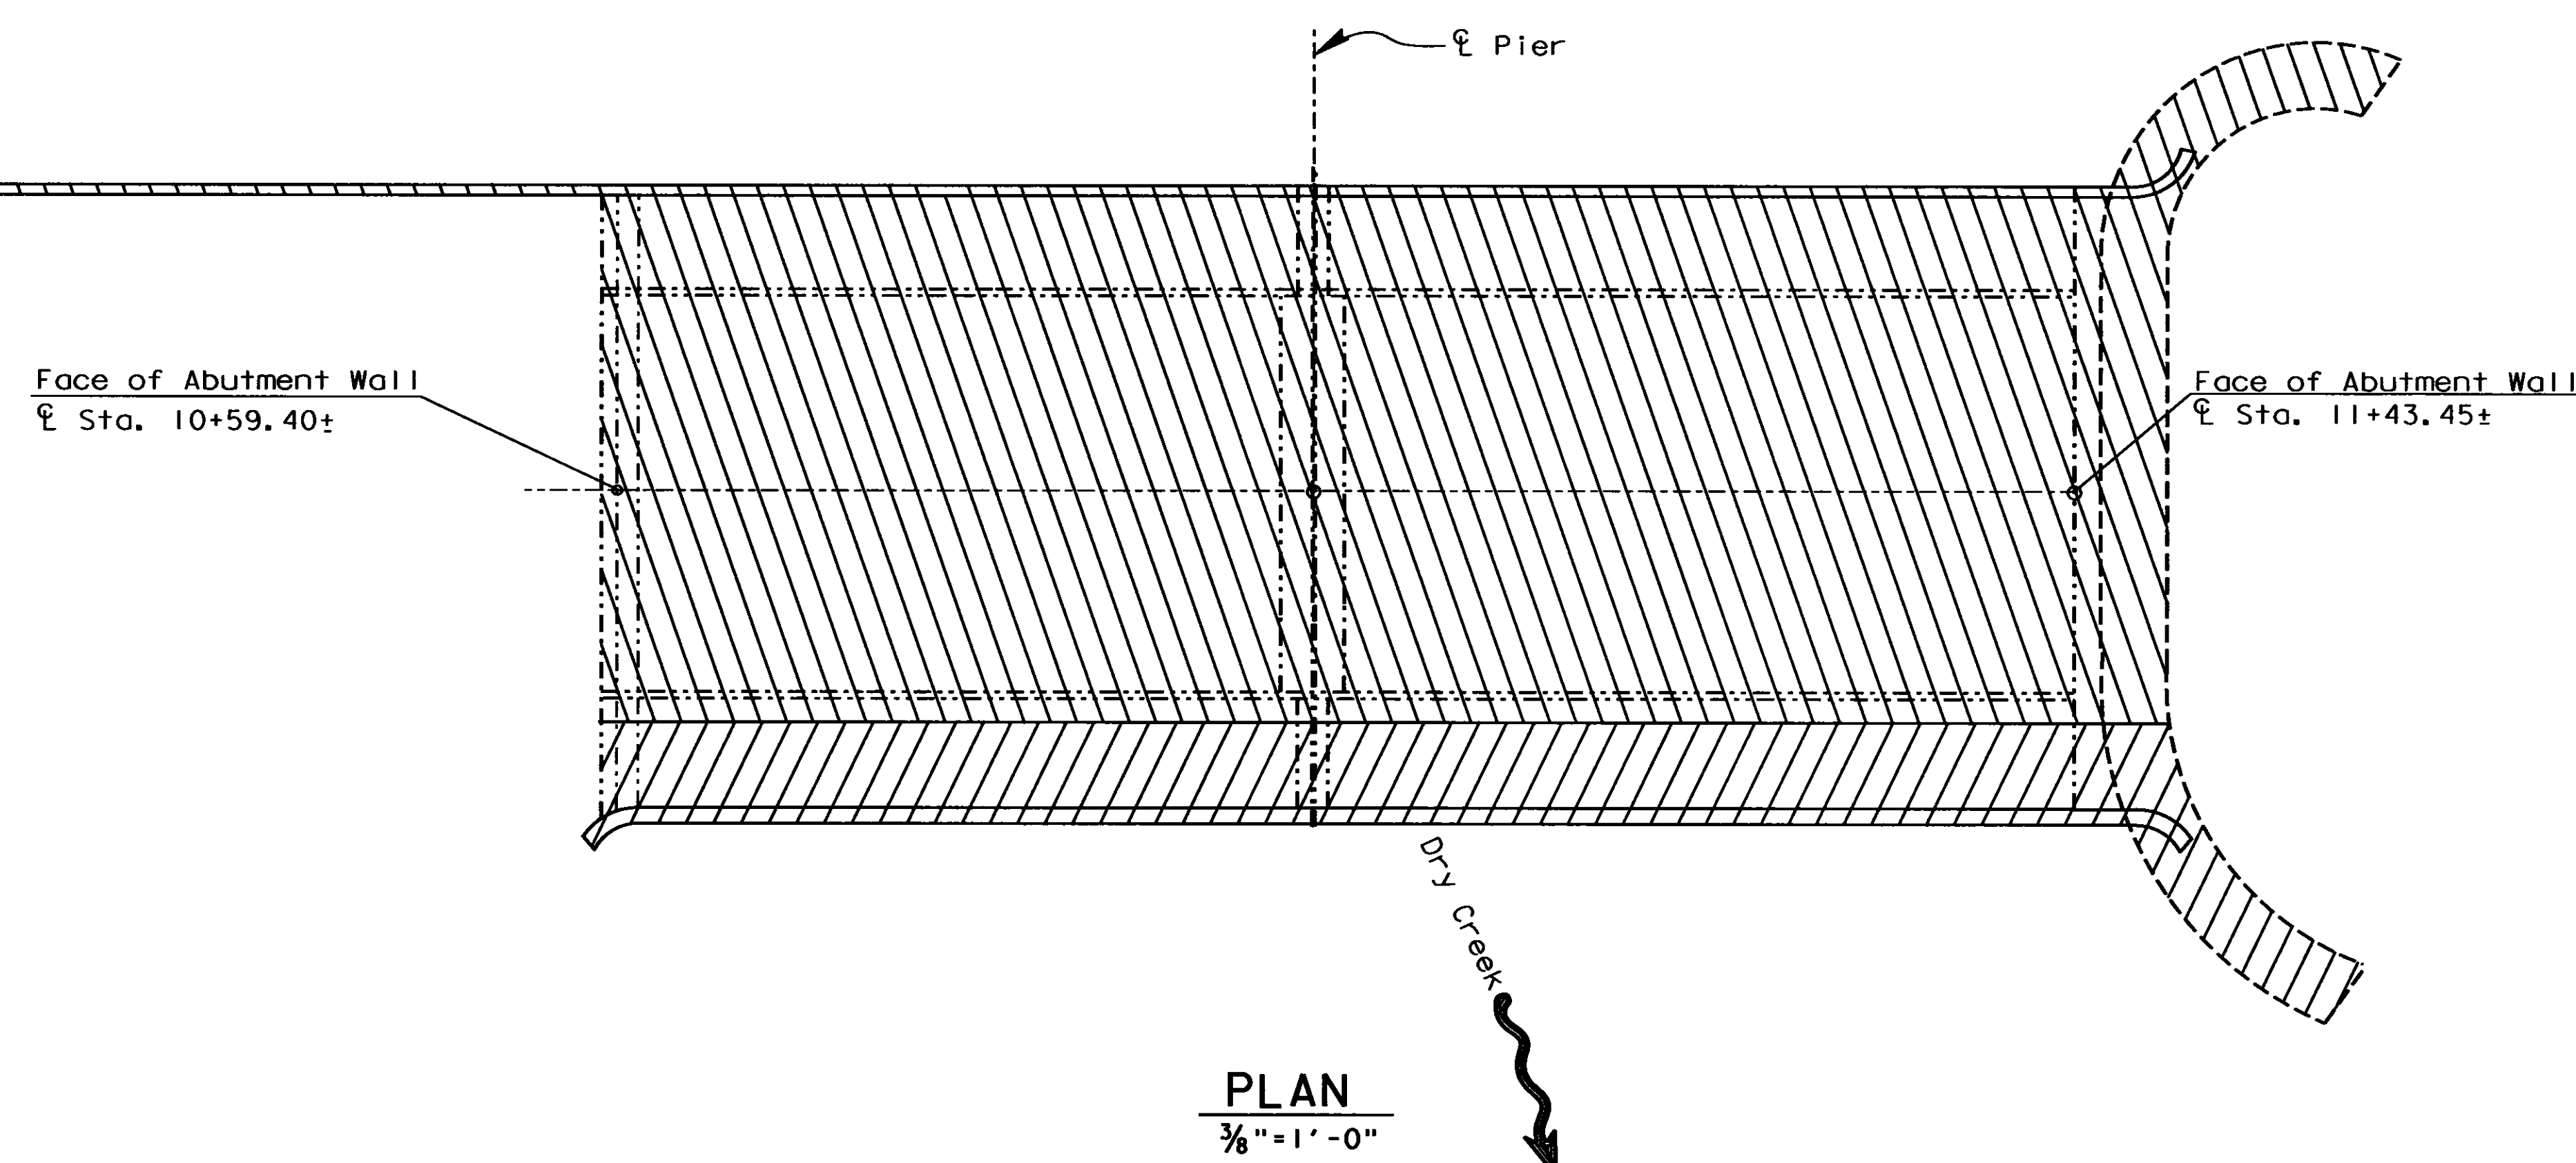

DESIGN BY Garry Tolen 5-96 CHECKED Mike Whiteside 5-96 DETAILS BY Janice Sam 5-96 CHECKED Mike Whiteside 5-96 QUANTITIES BY Garry Tolen 6-96 CHECKED Kristi Westoby 6-96				<b>STATE OF CALIFORNIA</b> DEPARTMENT OF TRANSPORTATION		DISTRICT 2 <b>SEISMIC DESIGN</b>		BRIDGE NO. 21-0014 POST MILE 16.5		<b>EARTHQUAKE RETROFIT PROJECT NO. 412</b> <b>DRY CREEK BRIDGE</b> <b>BRIDGE REMOVAL DETAILS NO. 1</b>					
ORIGINAL SCALE IN INCHES FOR REDUCED PLANS						CU 04 EA 149301		DISREGARD PRINTS BEARING EARLIER REVISION DATES				REVISION DATES (PRELIMINARY STAGE ONLY) 5-25-96 7-1-96 7-30-96		SHEET 12 OF 16	
DS OSD 2139 (CADD 9/95)						USERNAME => trlenard aamscremv118070103		DATE PLOTTED => 18-NOV-1996 TIME PLOTTED => 07:01				aamscremv1			





DIST.	COUNTY	ROUTE	POST MILES TOTAL PROJECT	SHEET NO.	TOTAL SHEETS
04	Nap	29	16.3/16.7	65	68



*Garry Tolen*  
REGISTERED ENGINEER - CIVIL  
No. 25298  
Exp. 12-31-97  
CIVIL  
STATE OF CALIFORNIA

11-18-96  
PLANS APPROVAL DATE

The State of California or its officers or agents shall not be responsible for the accuracy or completeness of electronic copies of this plan sheet.

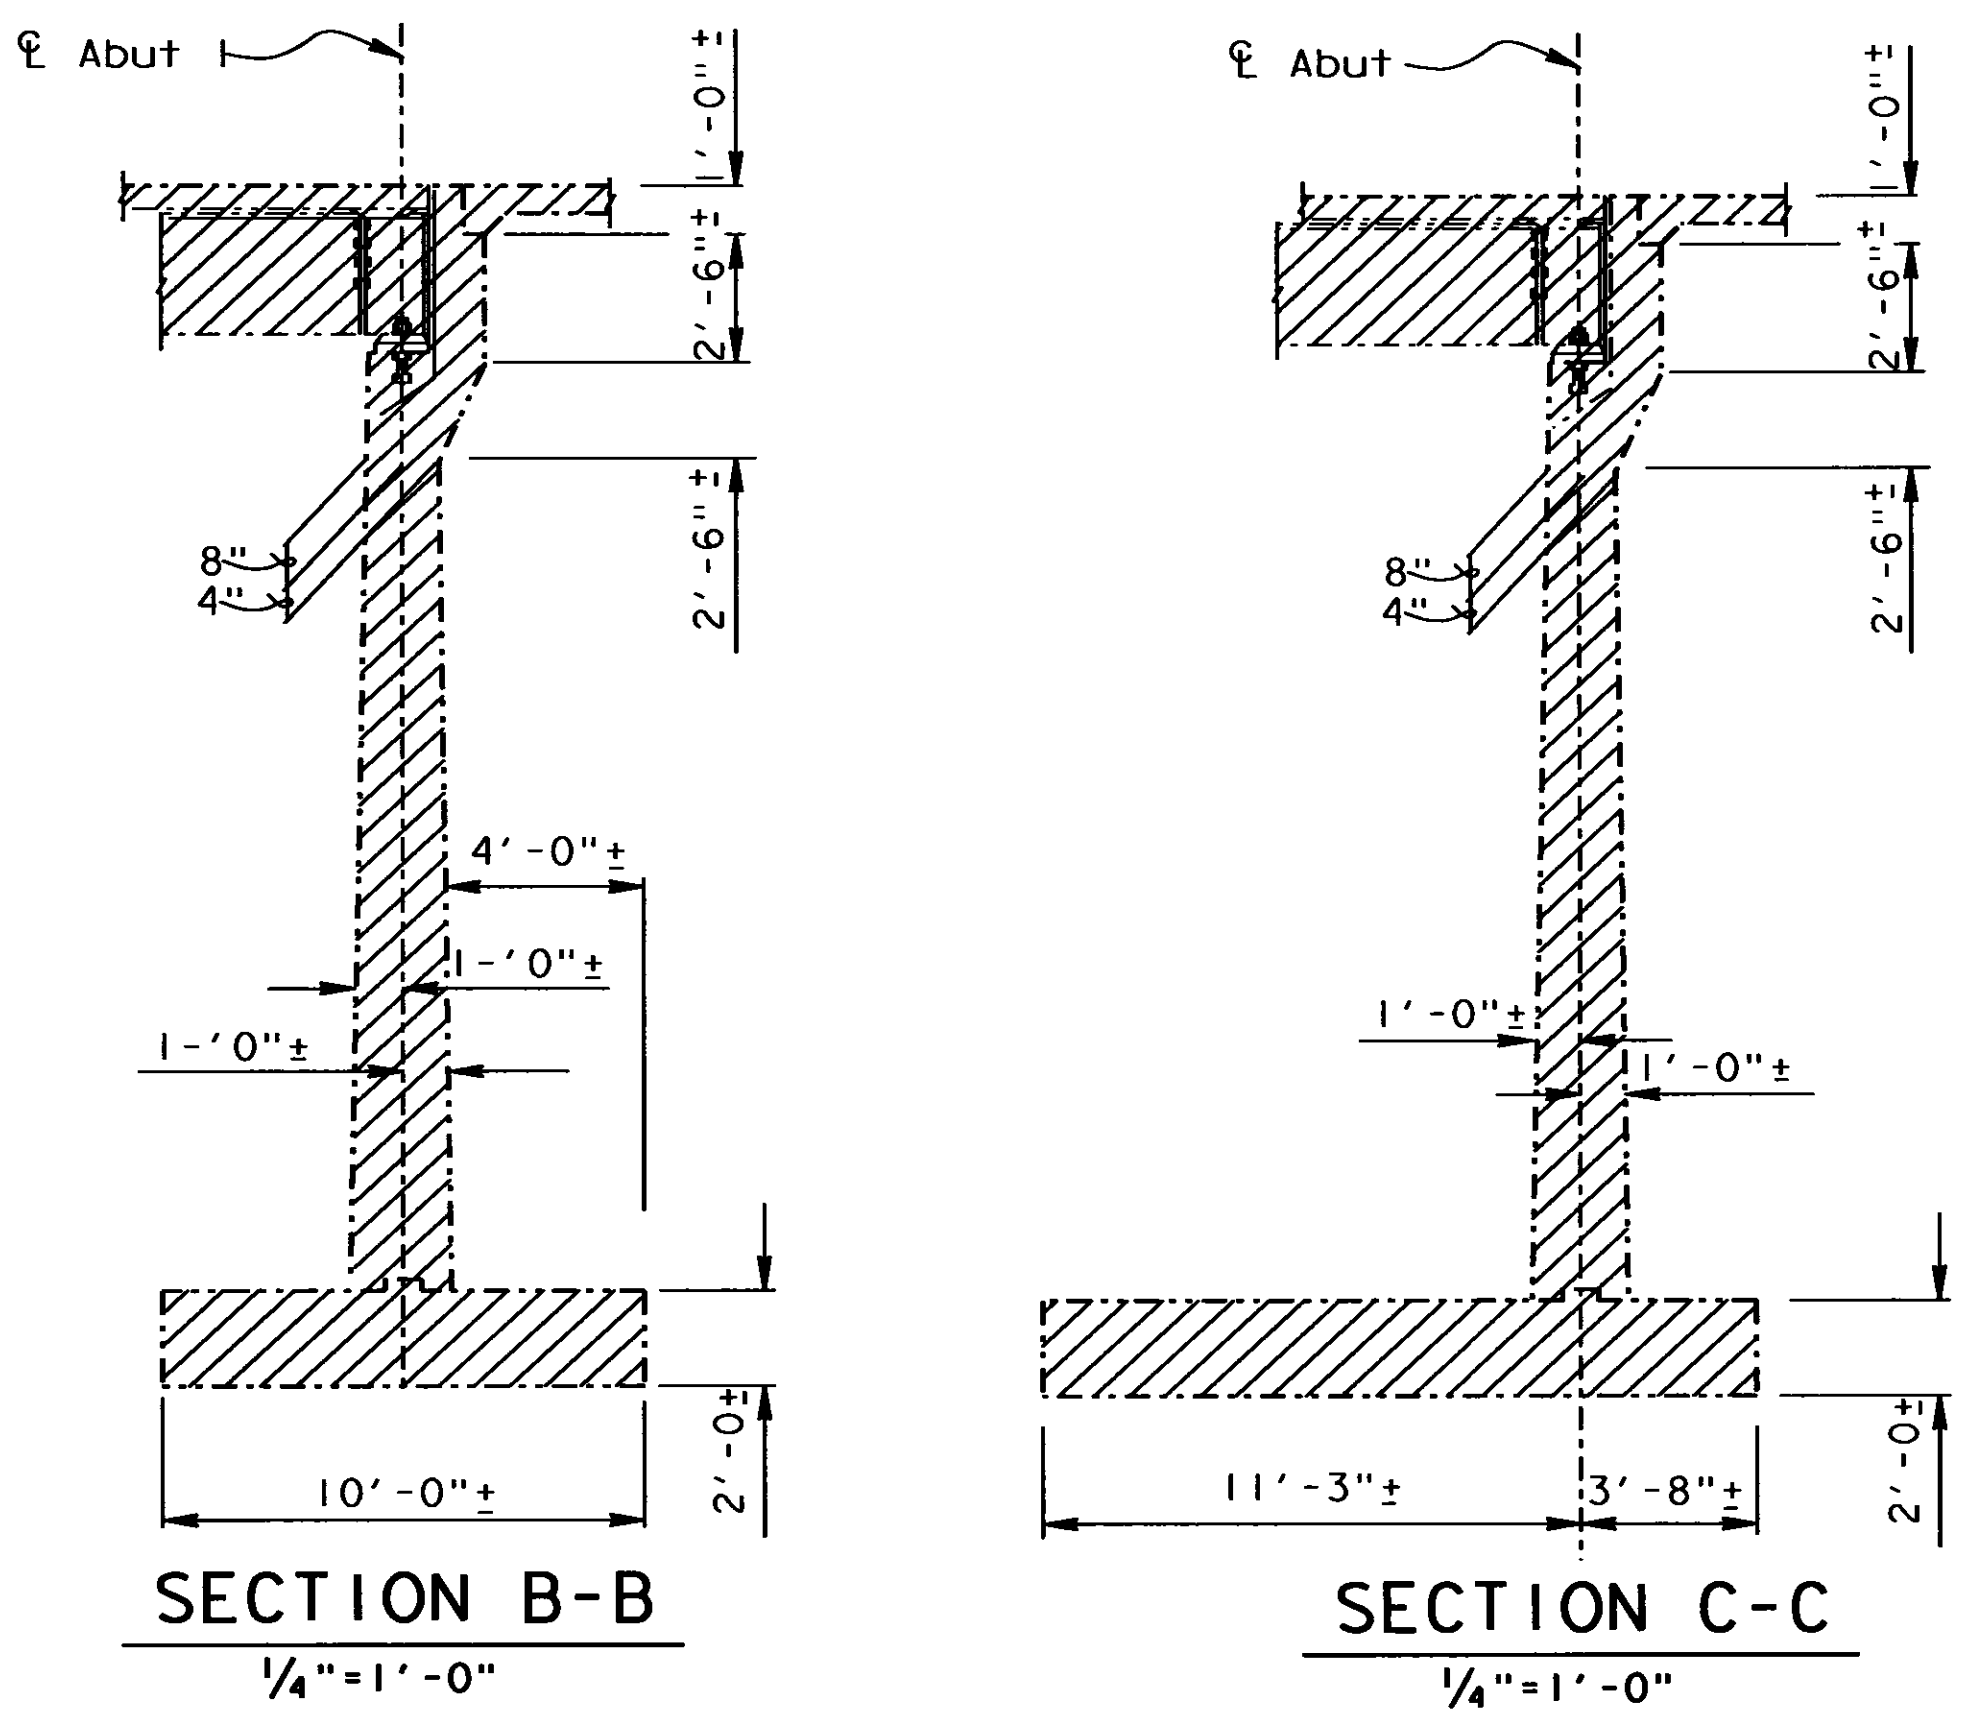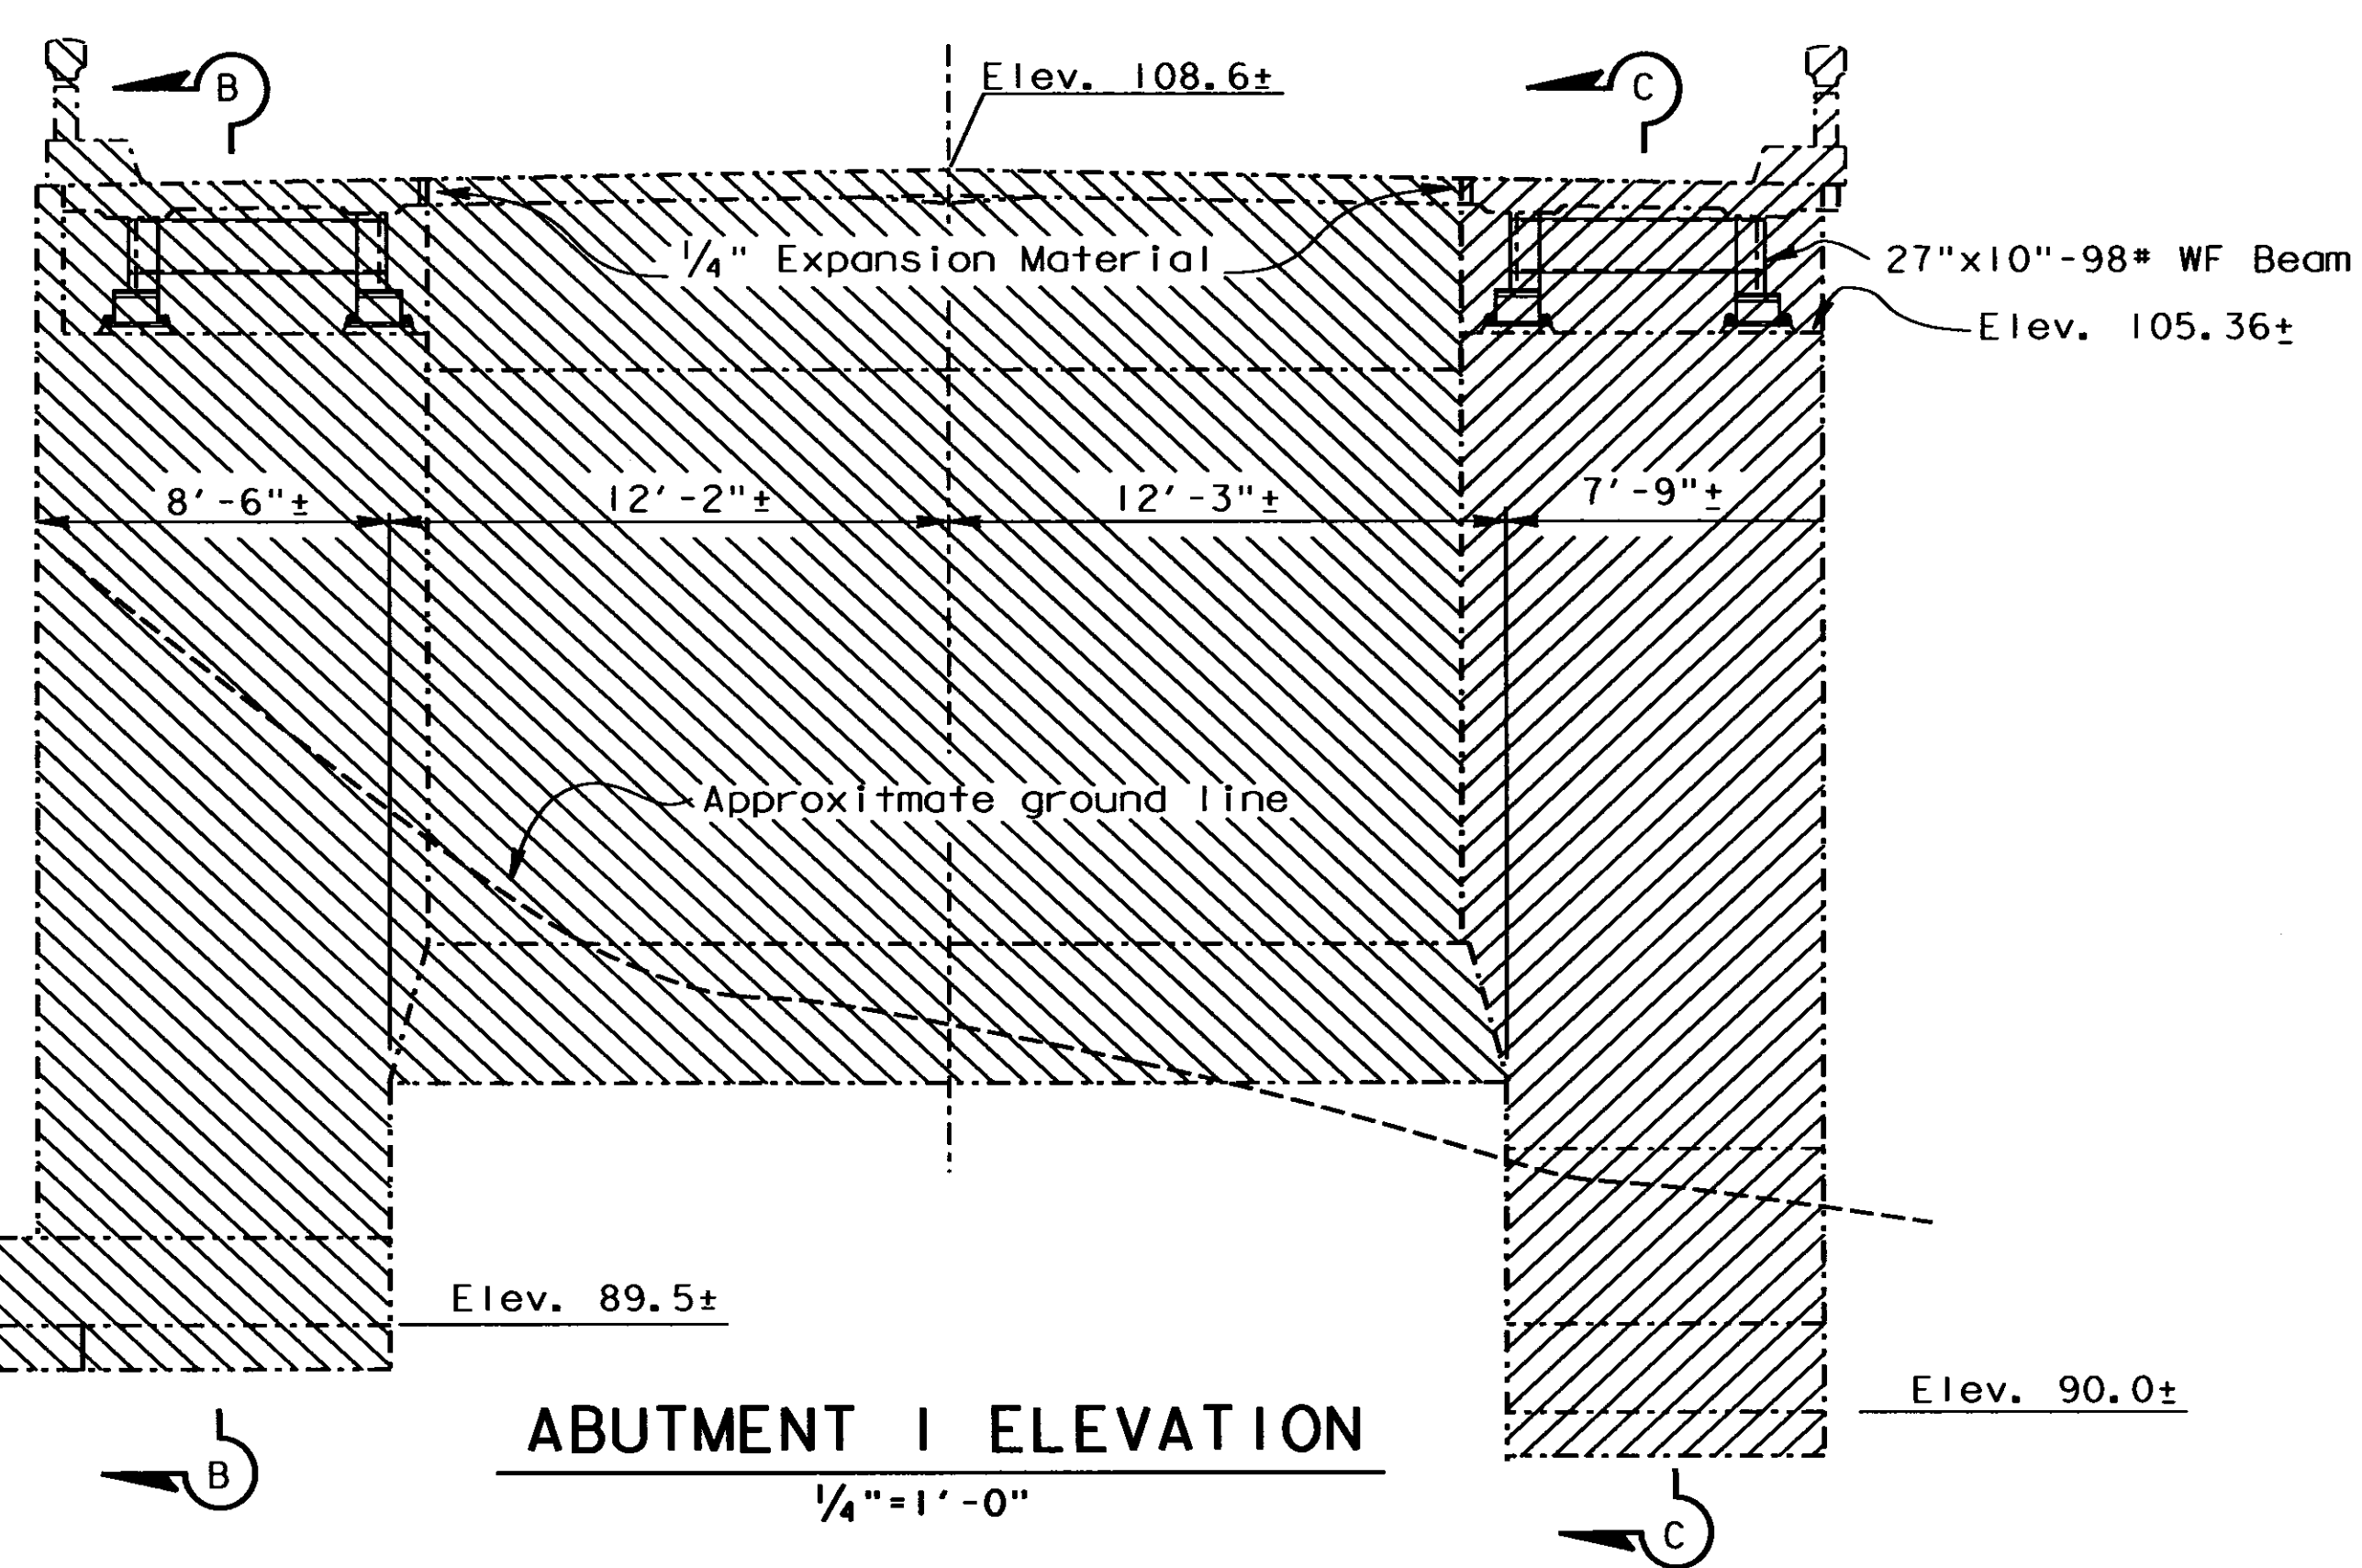

EXISTING ABUTMENT I DETAILS

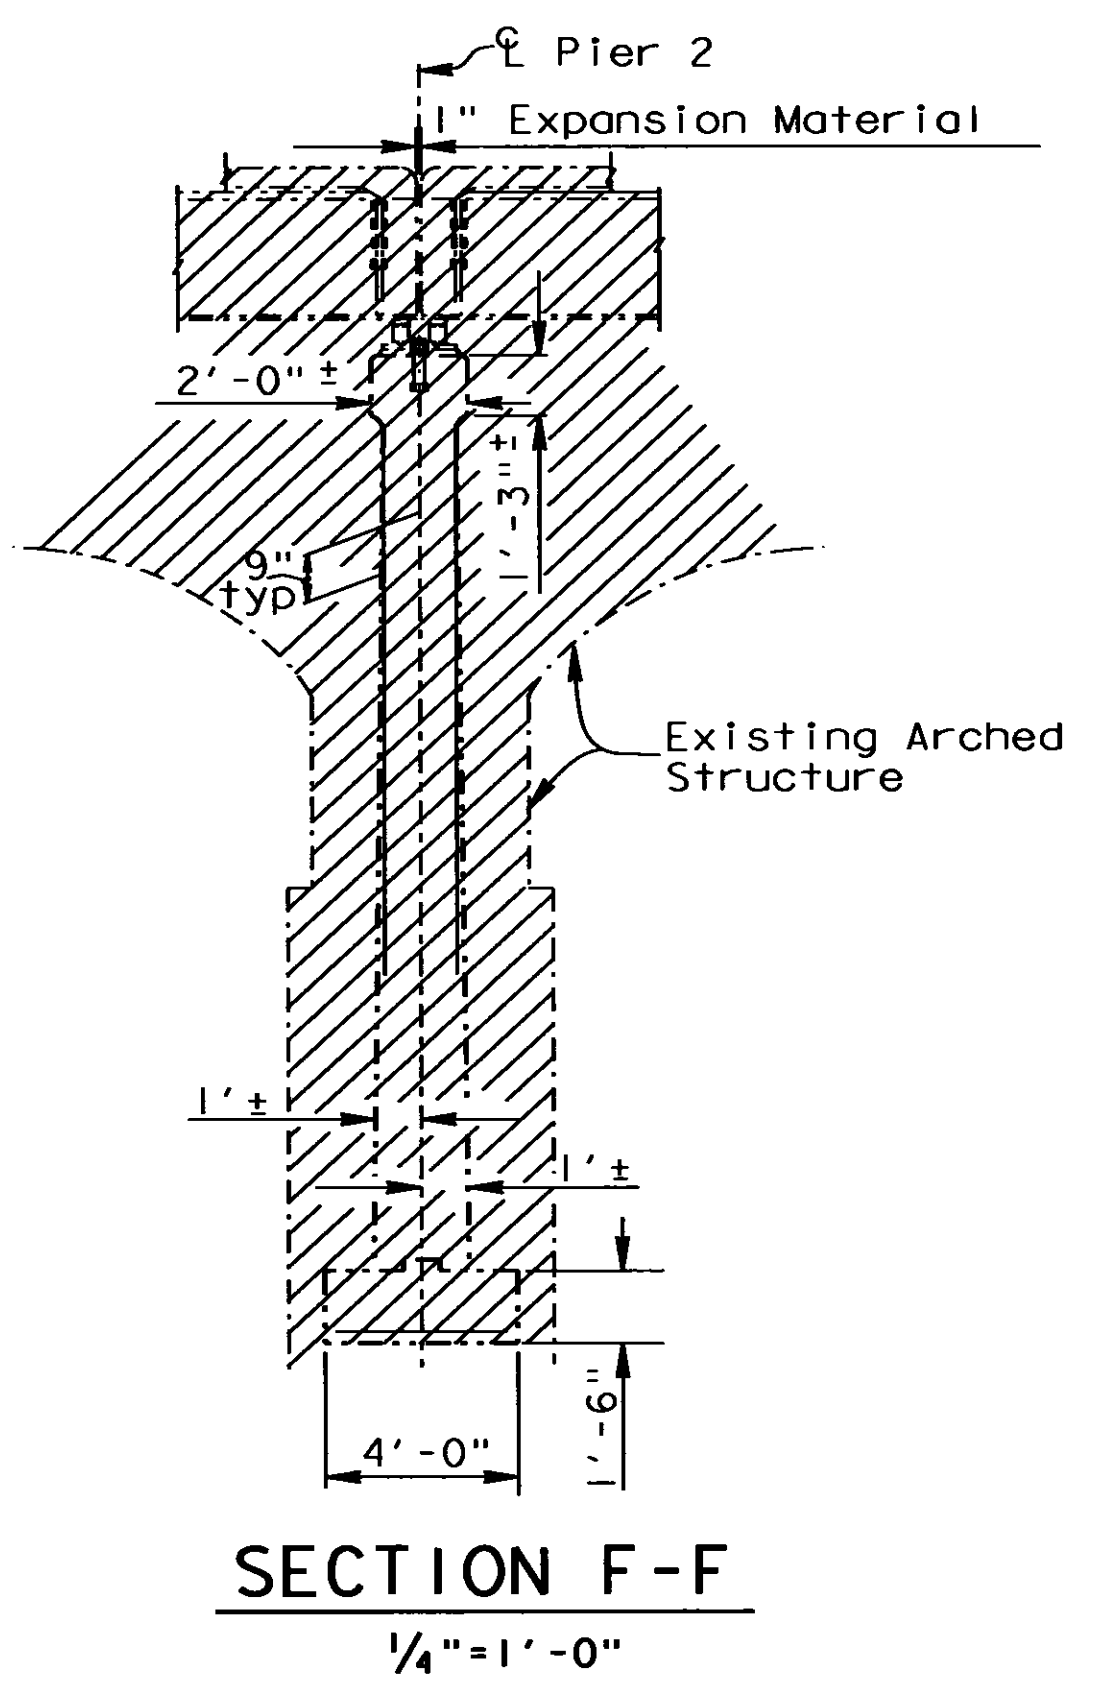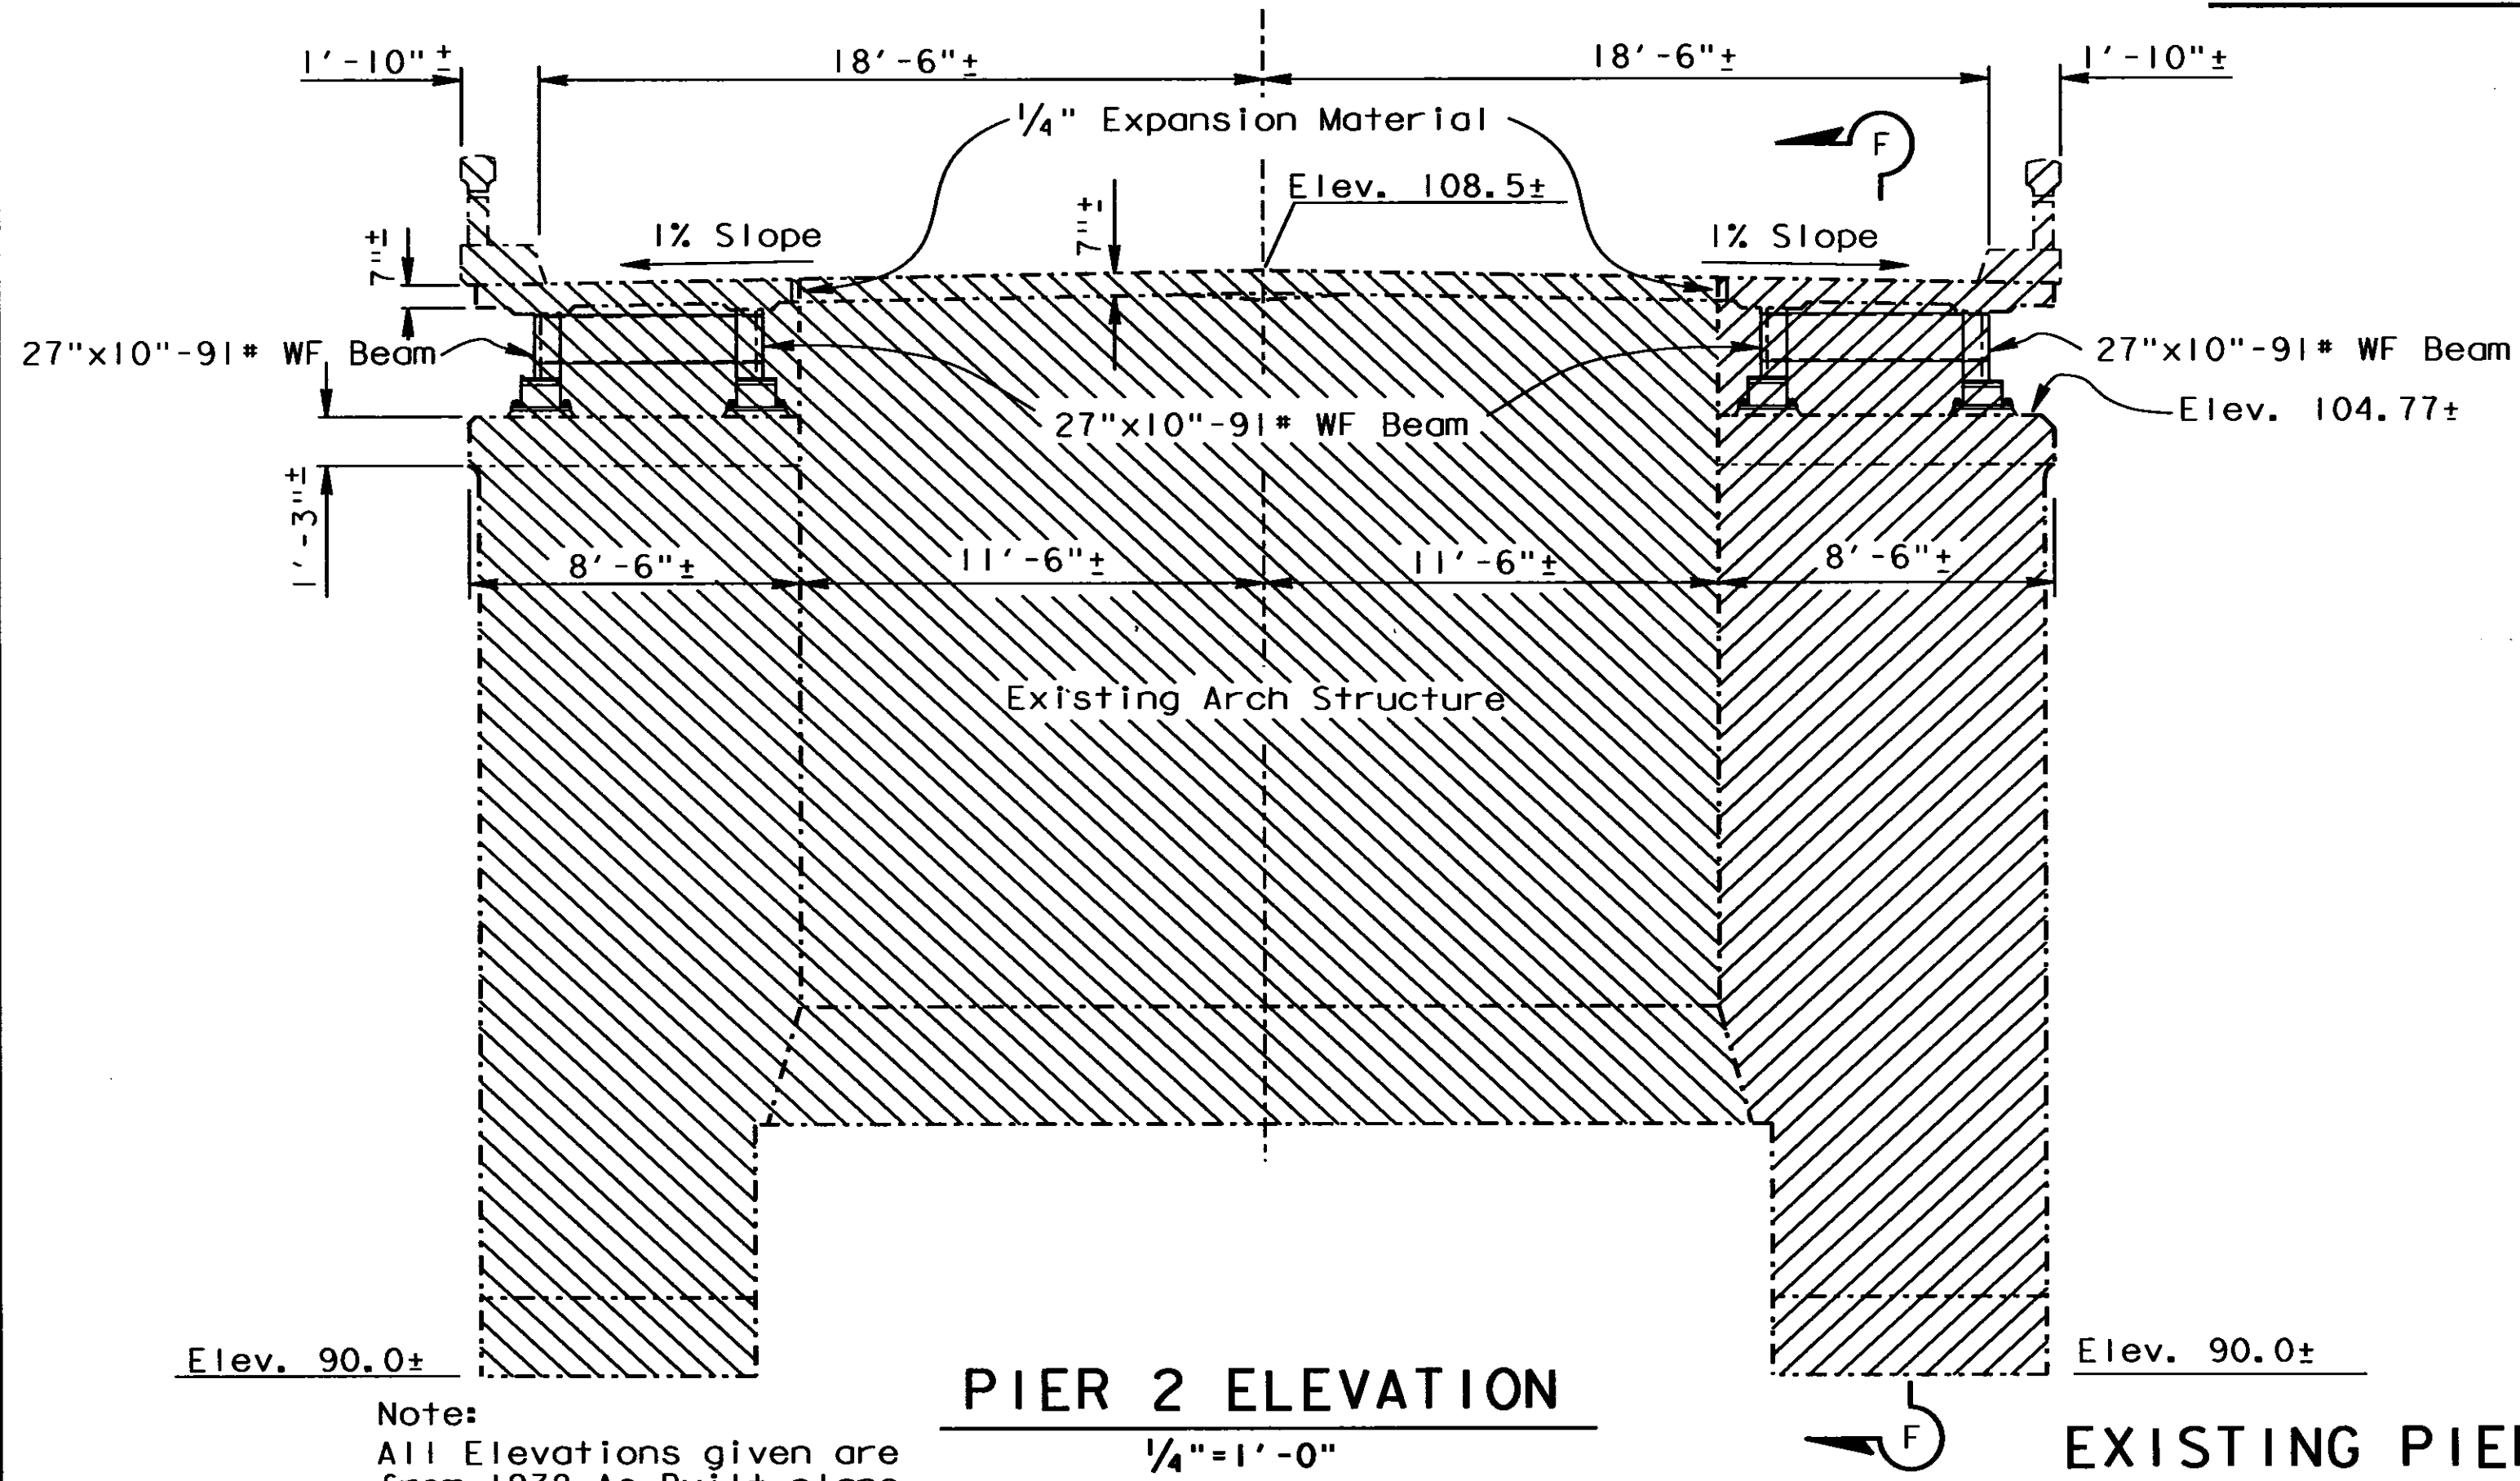

EXISTING PIER 2 DETAILS

NOTES:

- Stage 1 Removal
- Stage 3 Removal

*No Changes*  
**AS BUILT** *G. Sam*  
CORRECTIONS BY *Michael Assad*  
CONTRACT NO. *04-149304*  
DATE *12-08-97* *3-2-98*

All Elevations given are from 1938 As-Built plans

**EARTHQUAKE RETROFIT PROJECT NO. 412**

**DRY CREEK BRIDGE**

**BRIDGE REMOVAL DETAILS NO. 2**

DESIGN	BY Mike Whiteside	5-96	CHECKED Mike Whiteside	5-96
DETAILS	BY Janice Sam	5-96	CHECKED Mike Whiteside	5-96
QUANTITIES	BY Garry Tolen	6-96	CHECKED Kristi Westoby	6-96

STATE OF CALIFORNIA  
DEPARTMENT OF TRANSPORTATION

DISTRICT 2  
SEISMIC DESIGN







DIST.	COUNTY	ROUTE	POST MILES TOTAL PROJECT	SHEET NO.	TOTAL SHEETS
04	Nap	29	16.3/16.7	66	68

*Garry Tolen*  
REGISTERED ENGINEER - CIVIL  
No. 25298  
Exp. 12-31-97  
CIVIL  
STATE OF CALIFORNIA

11-18-96  
PLANS APPROVAL DATE

The State of California or its officers or agents shall not be responsible for the accuracy or completeness of electronic copies of this plan sheet.

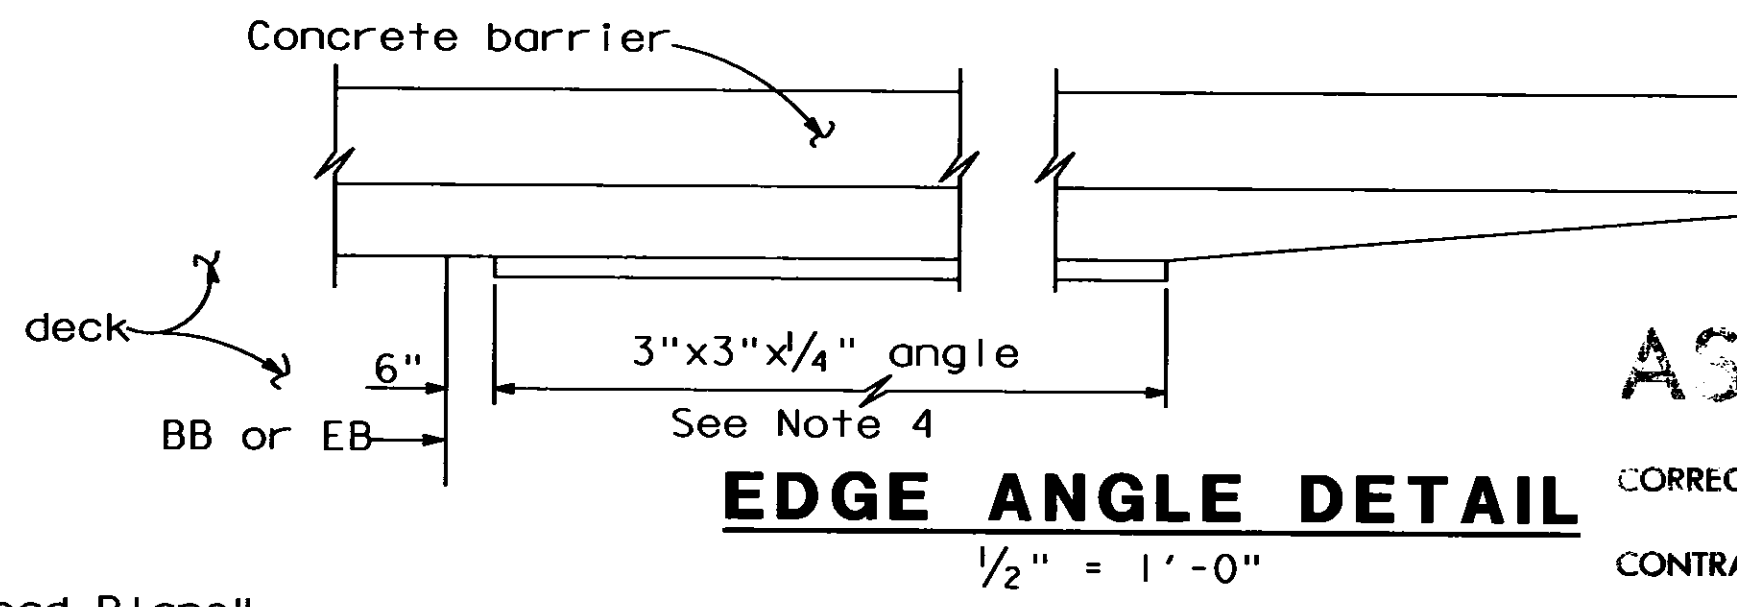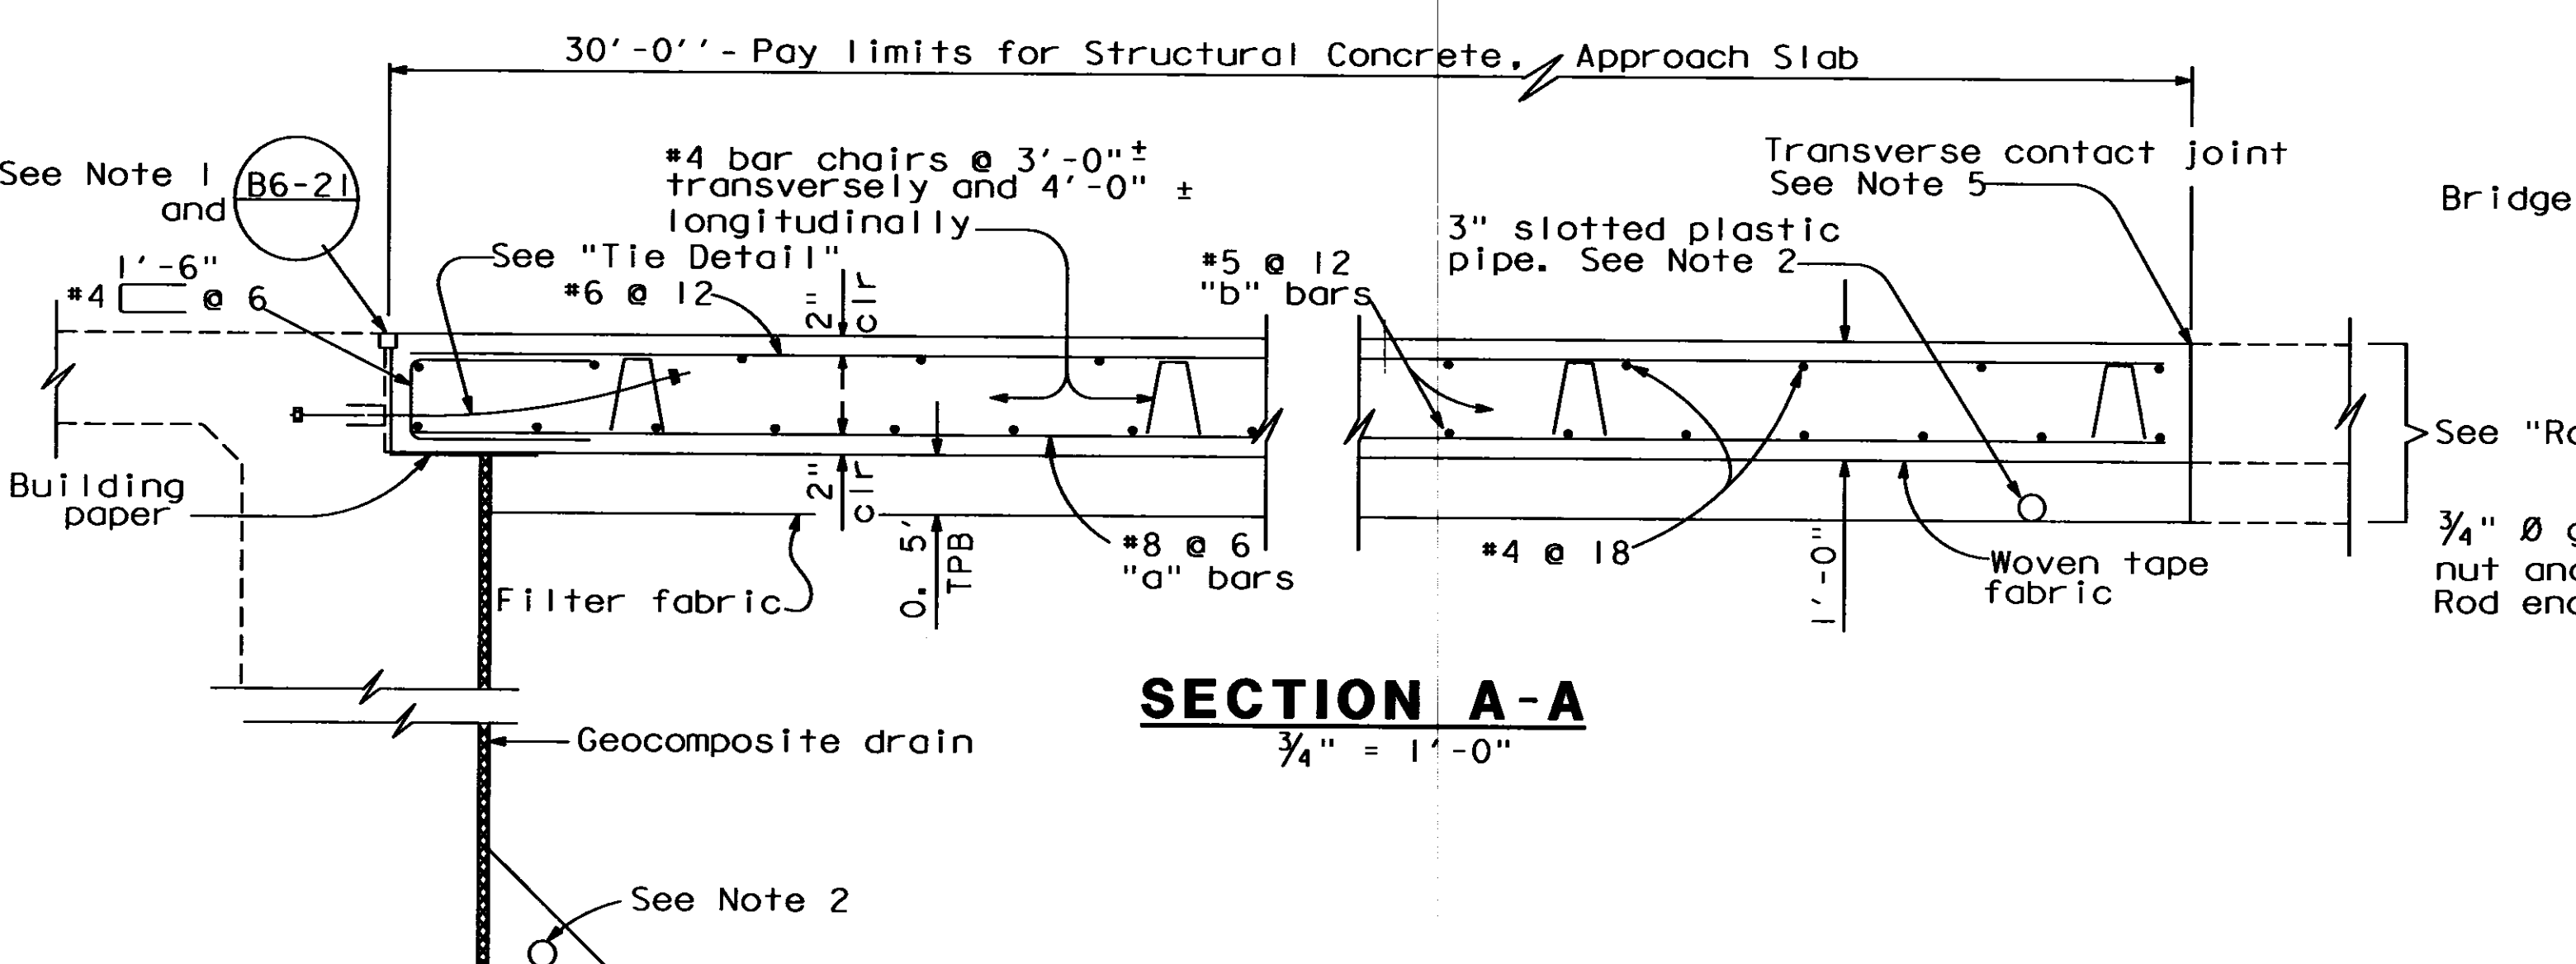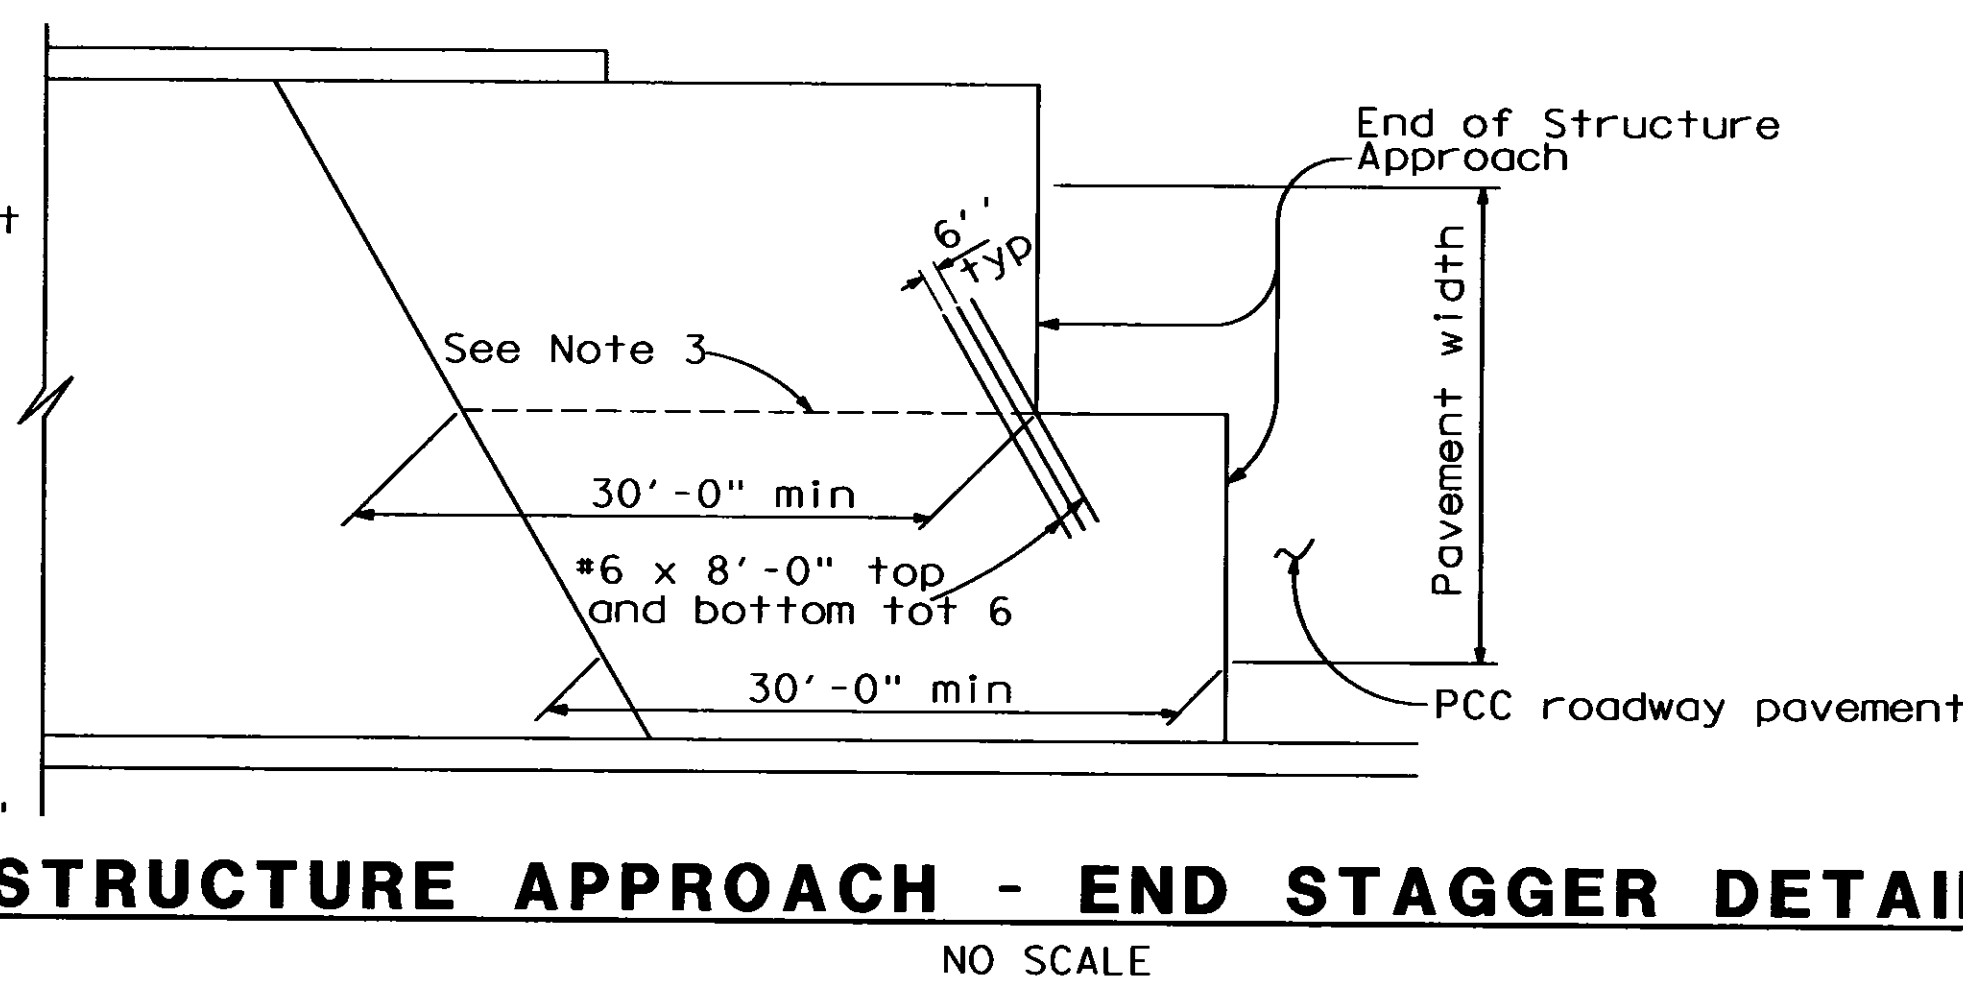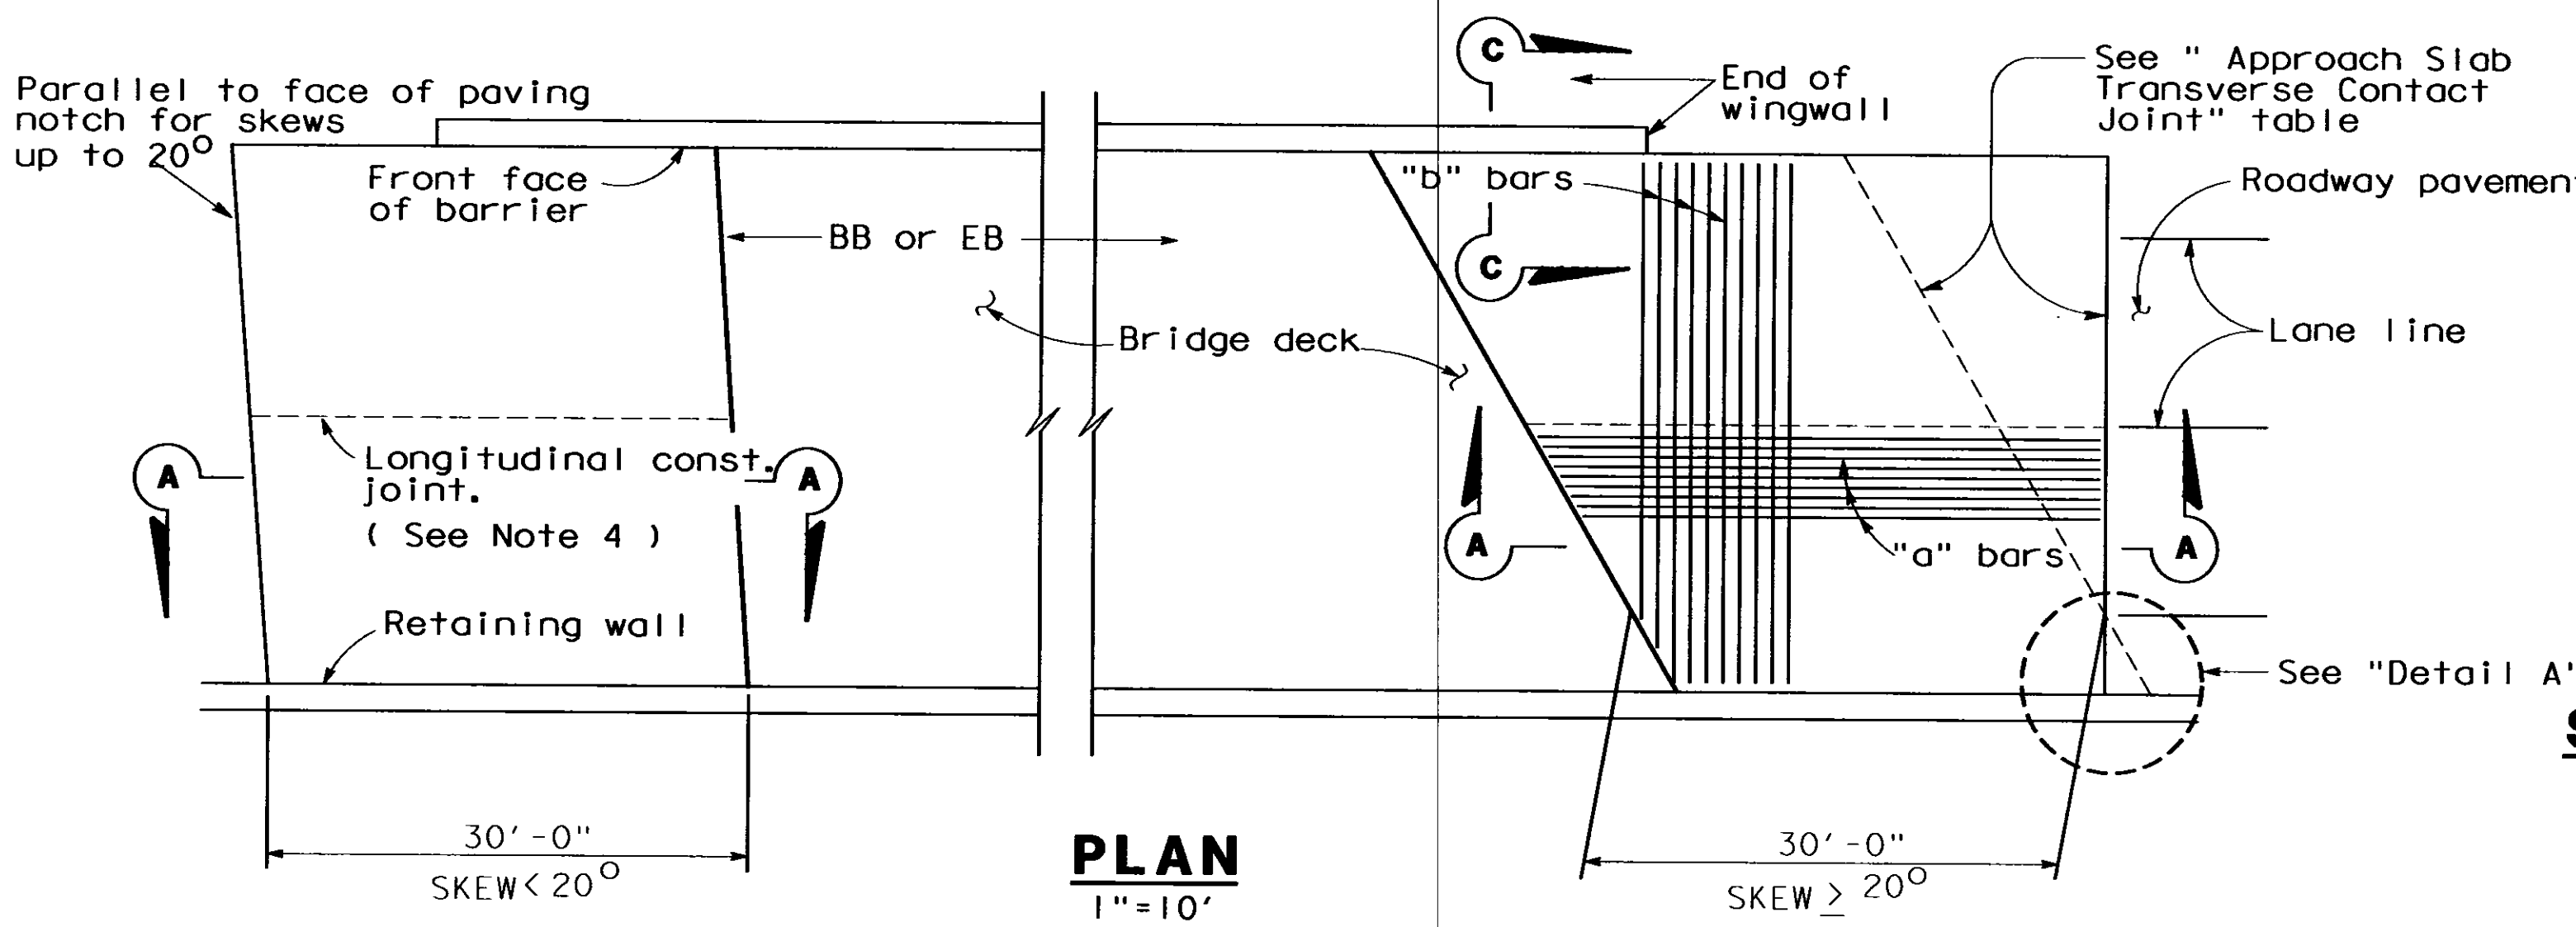

AS BUILT

CORRECTIONS BY *Michael Assad*

CONTRACT NO. 04-149304

DATE 12-08-97 3-2-98

BAR CHAIR DETAIL

1/2" = 1'-0"

4"




#4 bar

2 1/2"

4"

NO CHANGE

APPROACH SLAB TRANSVERSE CONTACT JOINT		
APPROACH SKEW	WITH AC ROADWAY PAVEMENT	WITH PCC ROADWAY PAVEMENT
< 20°	Parallel to face of paving notch	Parallel to face of paving notch
20° - 45°	Parallel to face of PN use (Detail A)	Stagger lines 24' to 36' apart
> 45°	Parallel to face of PN use (Detail A)	Stagger at each lane line

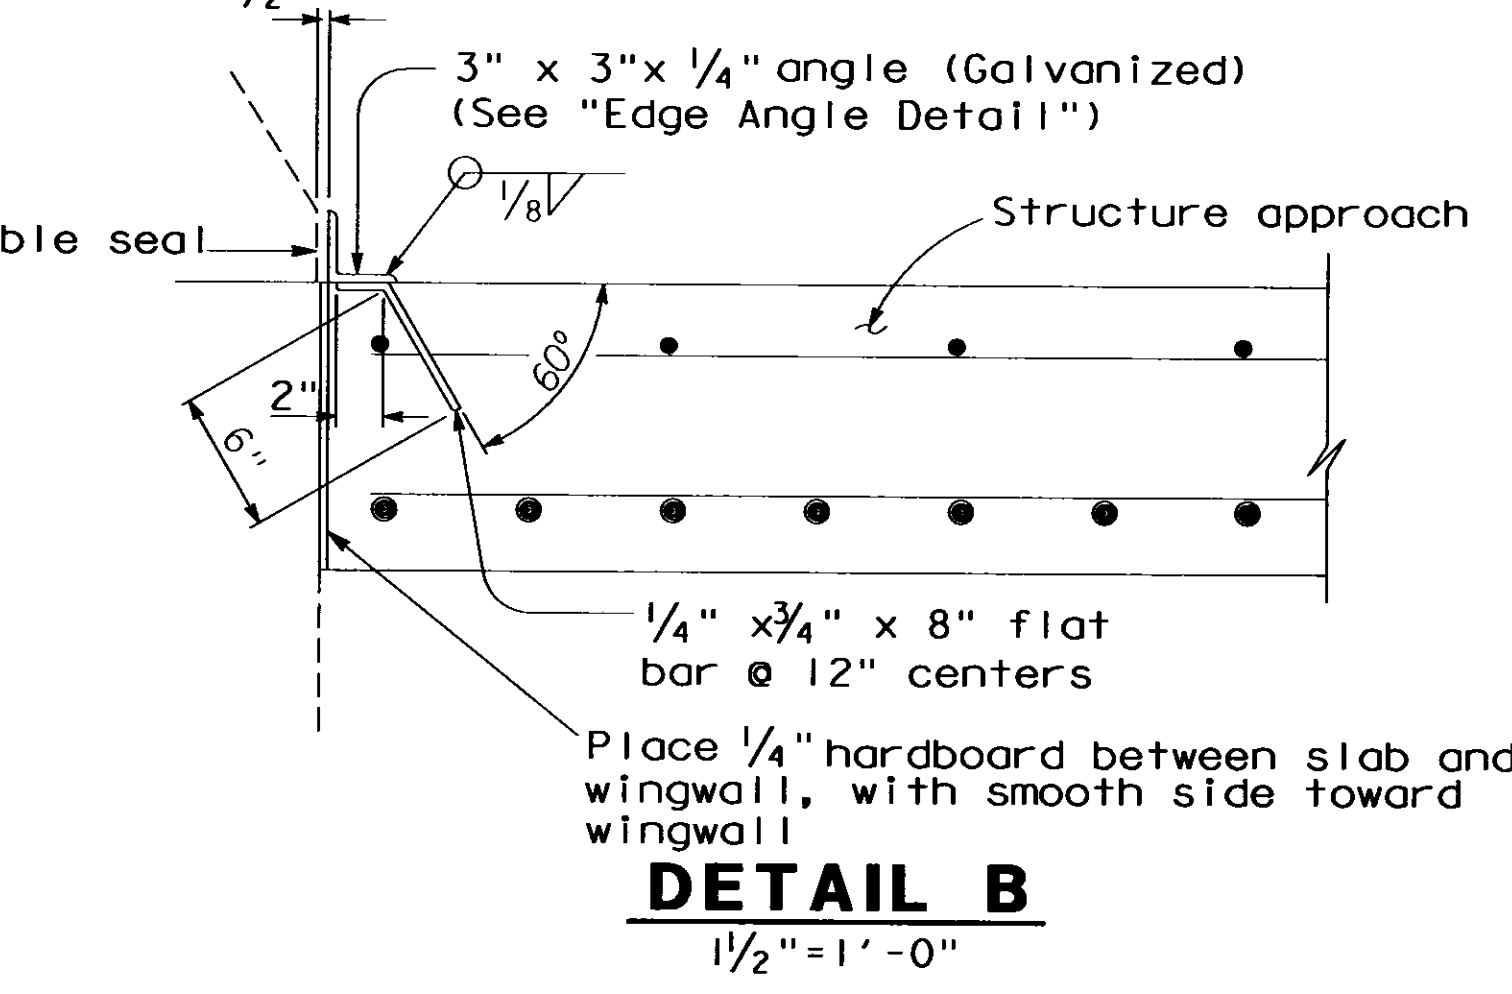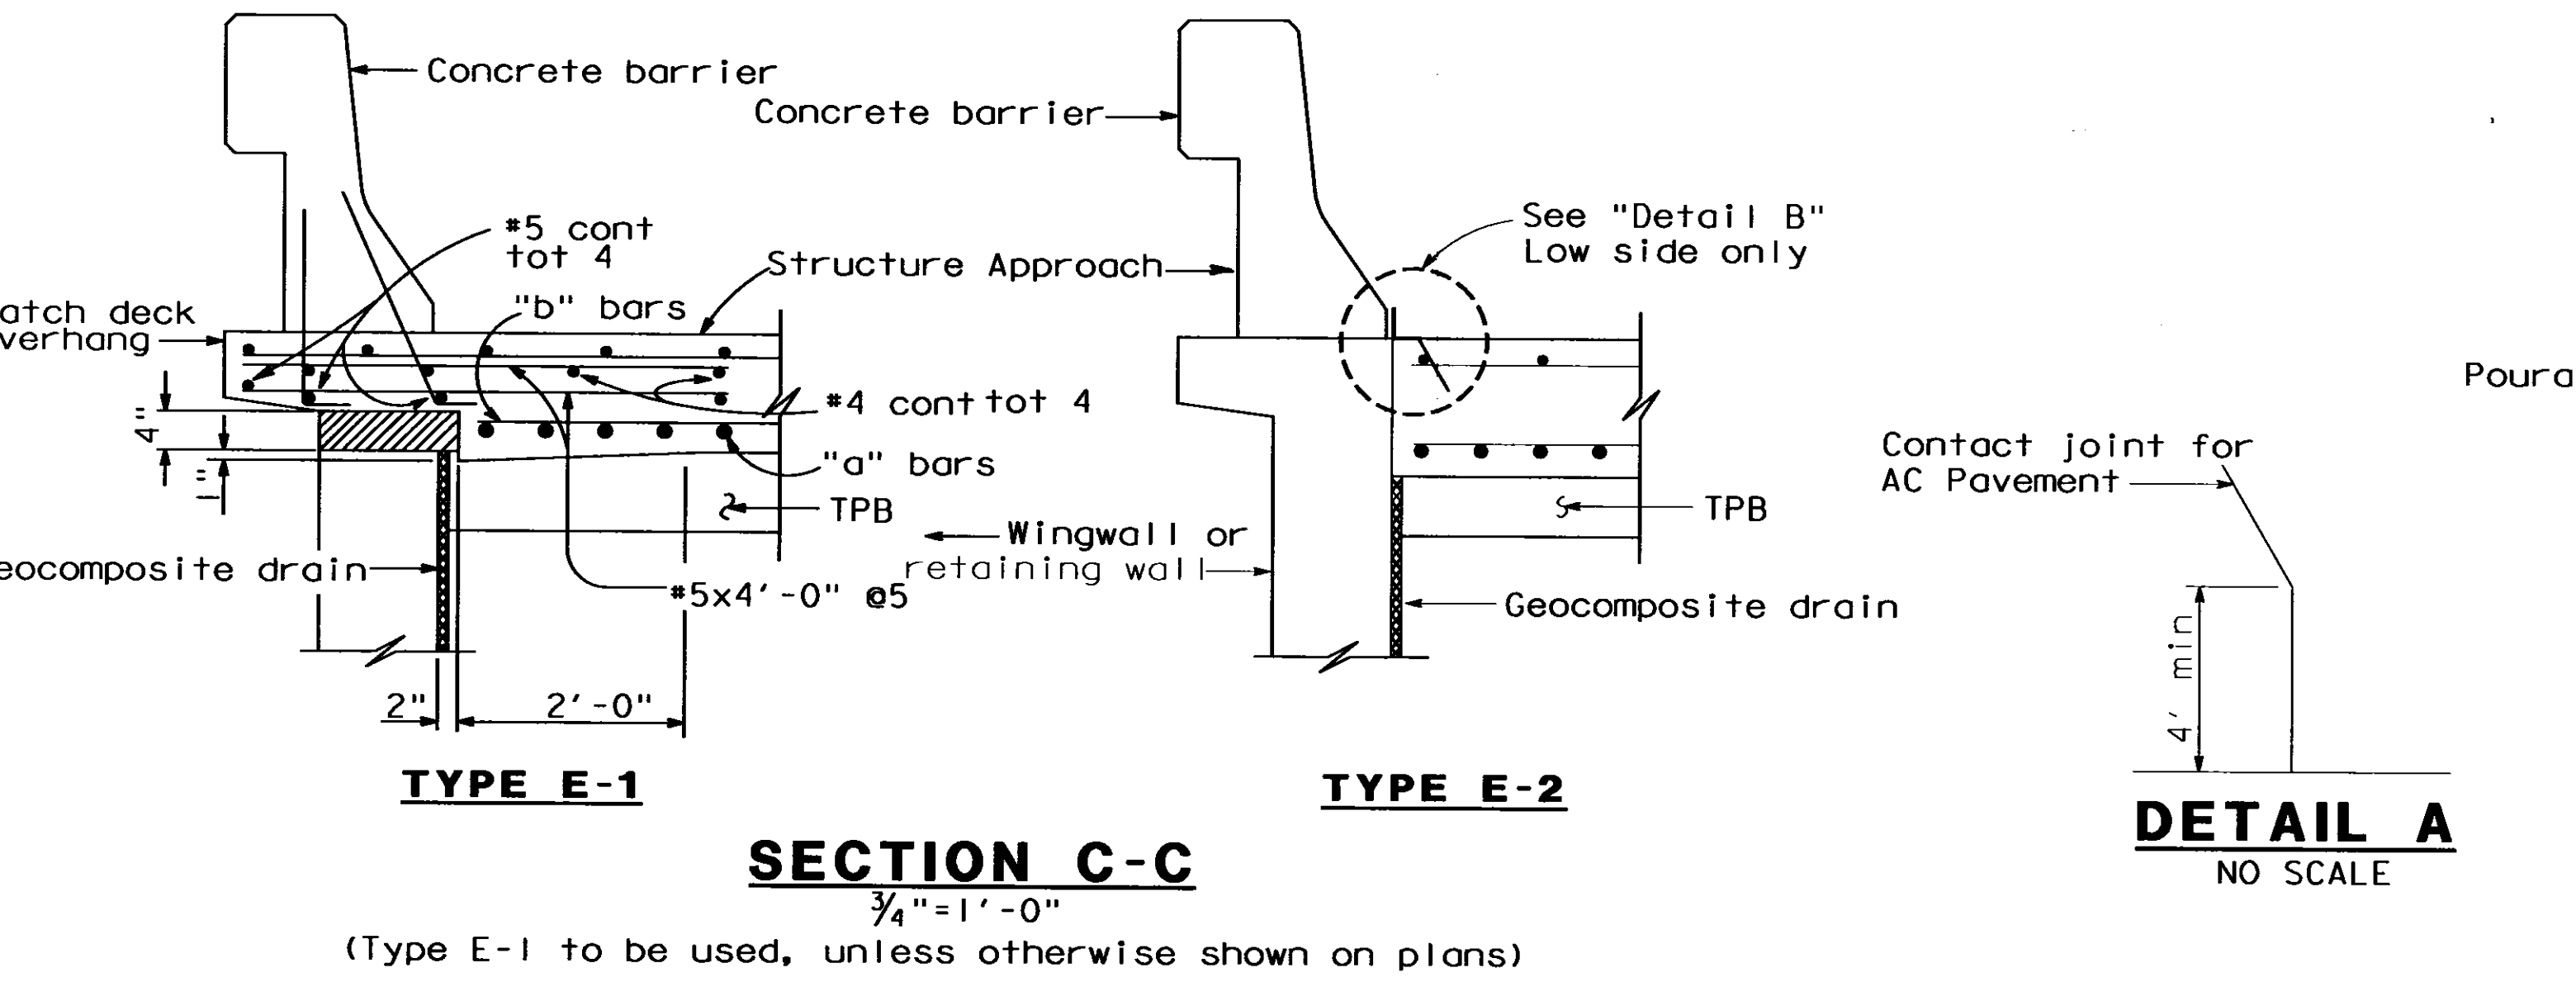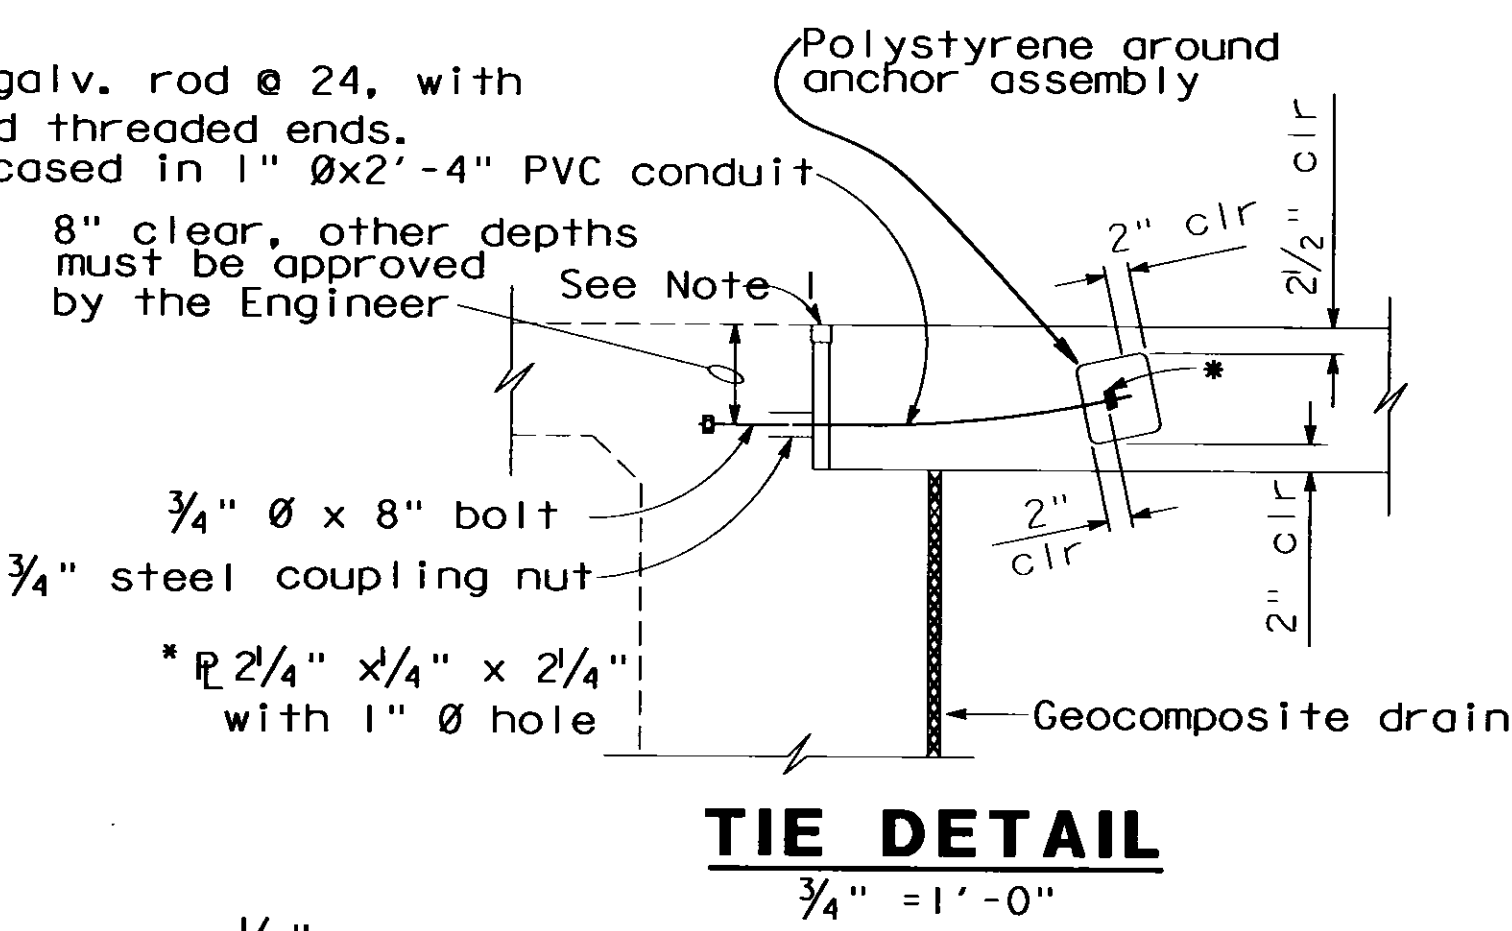

- NOTES:**
- For details not noted or shown, see Structure Plans.
  - For drainage details, see "Structure Approach Drainage Details" sheet.
  - Longitudinal construction joints, when permitted by the Engineer, shall be located on lane lines.
  - End angle at beginning of barrier transition, end of wingwall or end of structure approach, as applicable.
  - For transverse contact joint with new PCC paving, refer to Standard Plan A35-A.
  - At the contractor's option, approach slab transverse reinforcement may be placed parallel to paving notch. Spacing of transverse reinforcement is measured along roadway.
- Polystyrene to be removed.

STANDARD DRAWING			
FILE NO. XS 22-24	DESIGN BY M. Traffalls	CHECKED E. Thorkildsen	APPROVAL RECOMMENDED BY
DESIGN DATE 8/92	DETAILS BY R. Yee	CHECKED E. Thorkildsen	<i>Richard D. Ford</i>
	SUBMITTED BY M. Ha		DESIGN SUPERVISOR

STATE OF CALIFORNIA  
DEPARTMENT OF TRANSPORTATION

DISTRICT 2  
SEISMIC DESIGN

BRIDGE NO. 21-0014  
POST MILE 16.5

CU 04  
EA 149301

ORIGINAL SCALE IN INCHES FOR REDUCED PLANS 0 1 2 3

EARTHQUAKE RETROFIT PROJECT NO. 412	
DRY CREEK BRIDGE	
STRUCTURE APPROACH TYPE N(30D)	
DISCARD PRINTS BEARING EARLIER REVISION DATES	REVISION DATES (PRELIMINARY STAGE ONLY)
	SHEET 14 OF 16


DIST.	COUNTY	ROUTE	POST MILES TOTAL PROJECT	SHEET NO.	TOTAL SHEETS
04	Nap	29	16.3/16.7	67	68

*Garry L. Tolen*  
REGISTERED ENGINEER - CIVIL

PROFESSIONAL ENGINEER  
Garry Tolen  
No. 25298  
Exp. 12-31-97  
CIVIL  
STATE OF CALIFORNIA


11-18-96  
PLANS APPROVAL DATE

The State of California or its officers or agents shall not be responsible for the accuracy or completeness of electronic copies of this plan sheet.

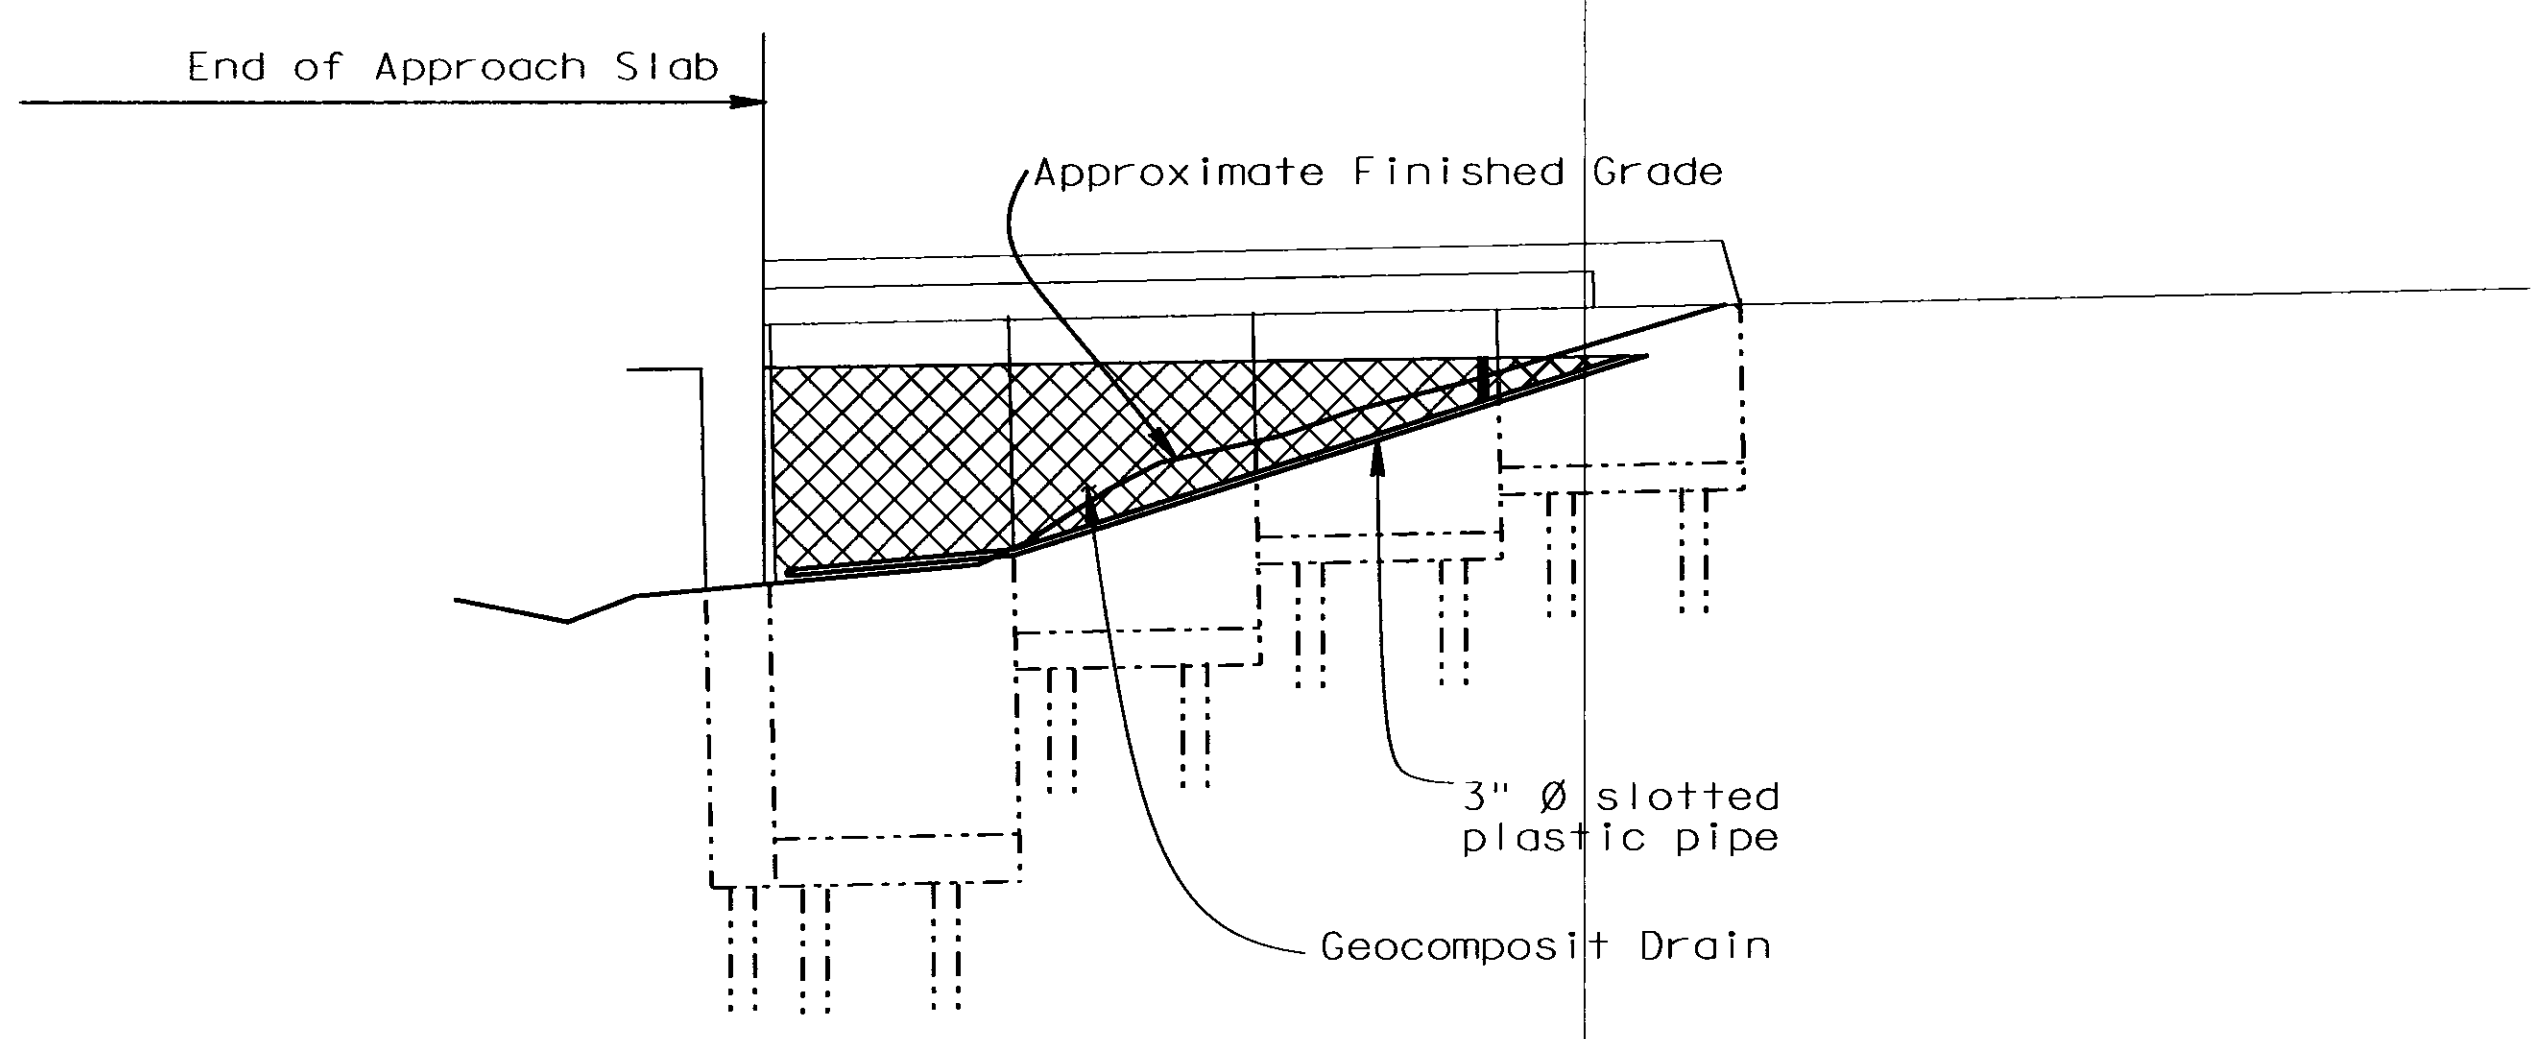


**VIEW A-A**  
1/8" = 1'-0"

NOTES:  
Abutment 3 shown. Abutment 1 similar

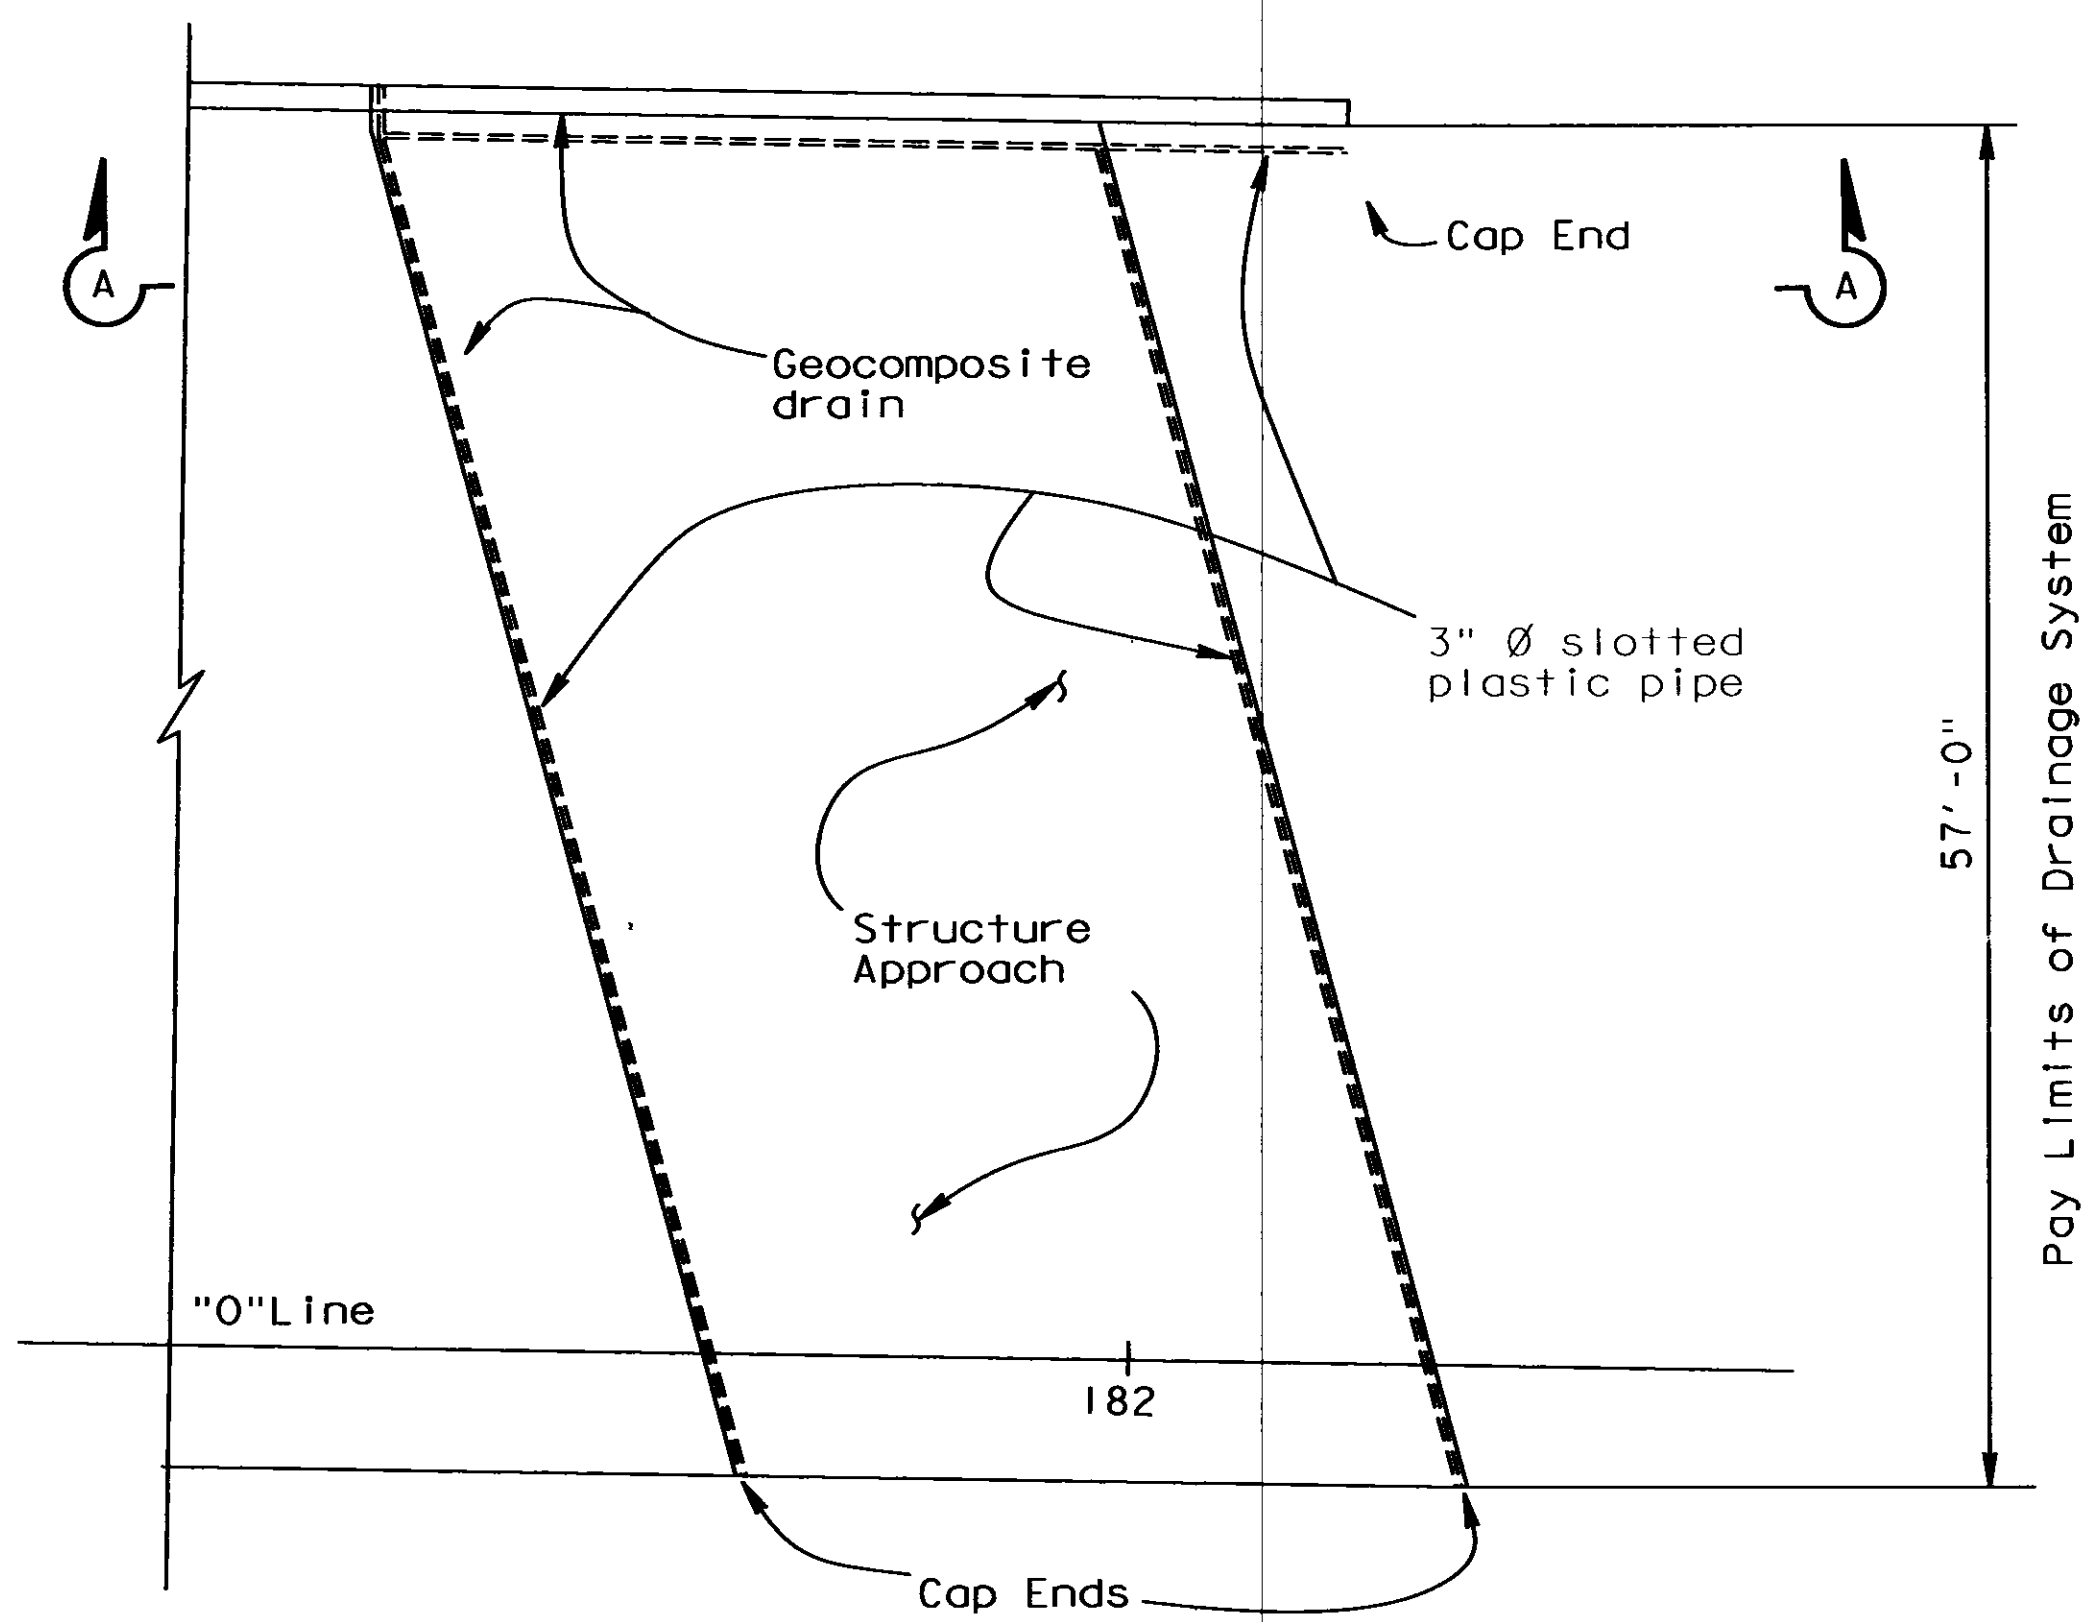


**PLAN**  
1/8" = 1'-0"


Notes:  
A. Geocomposite drain, cement treated permeable base, and 3" diameter slotted plastic pipe continuous behind retaining wall or abutment. Cap ends of pipe. Provide "Tee" connection at each 4" diameter drain.

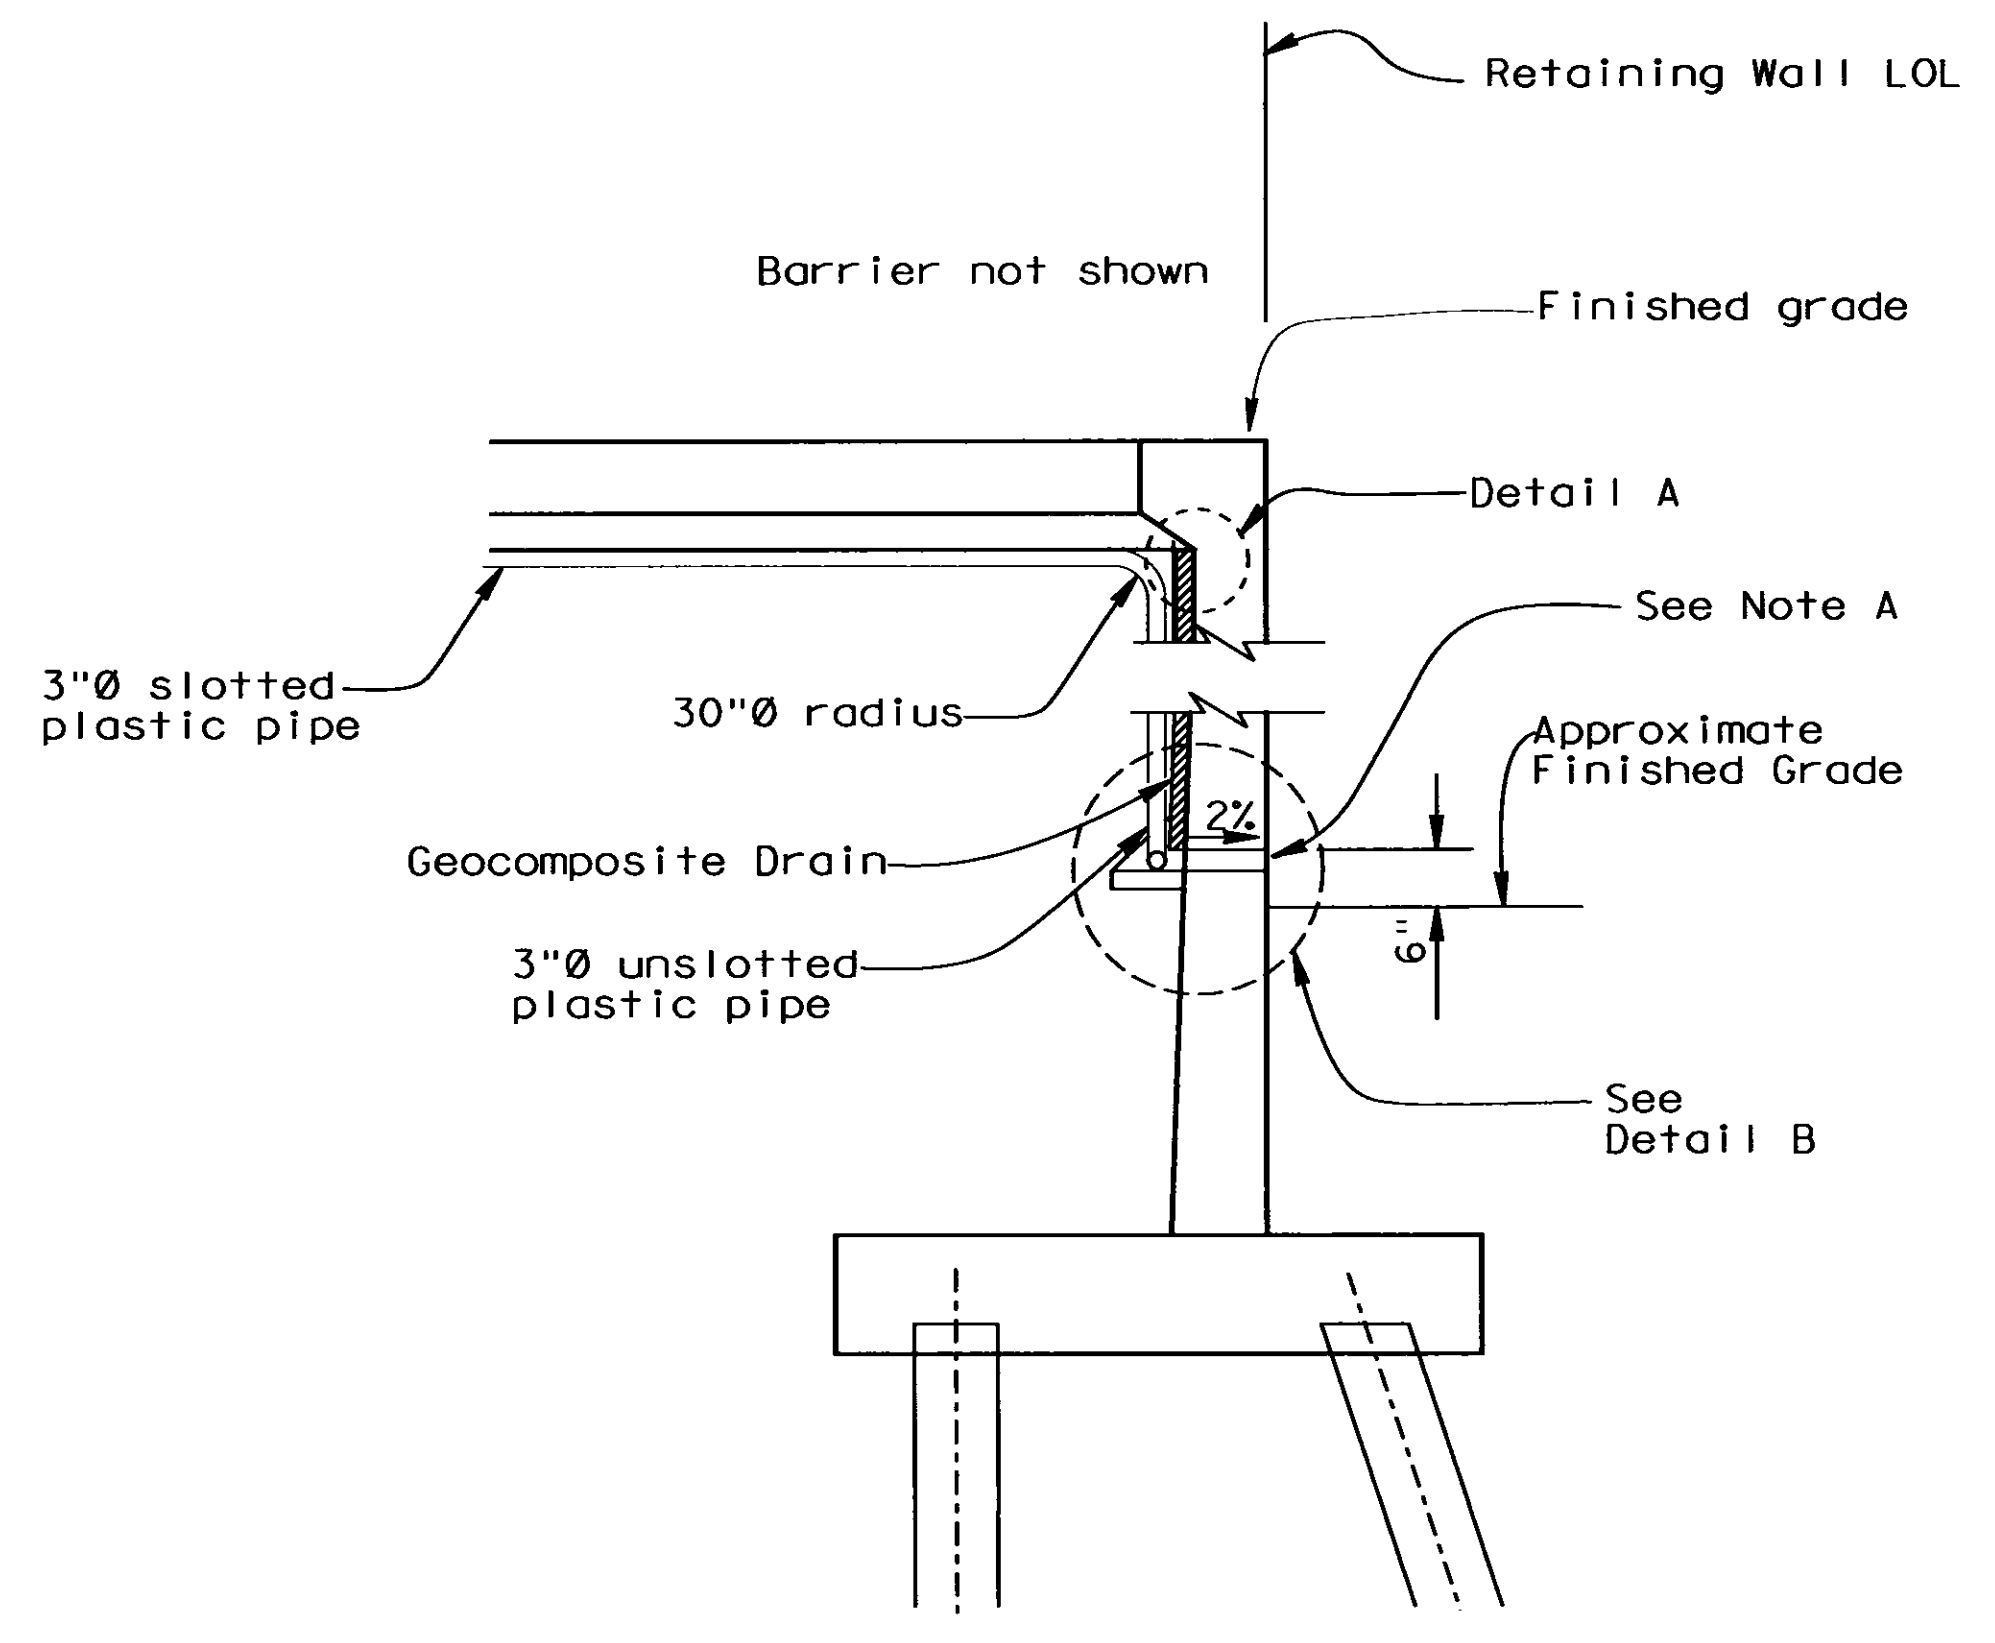

**WALL SECTION**

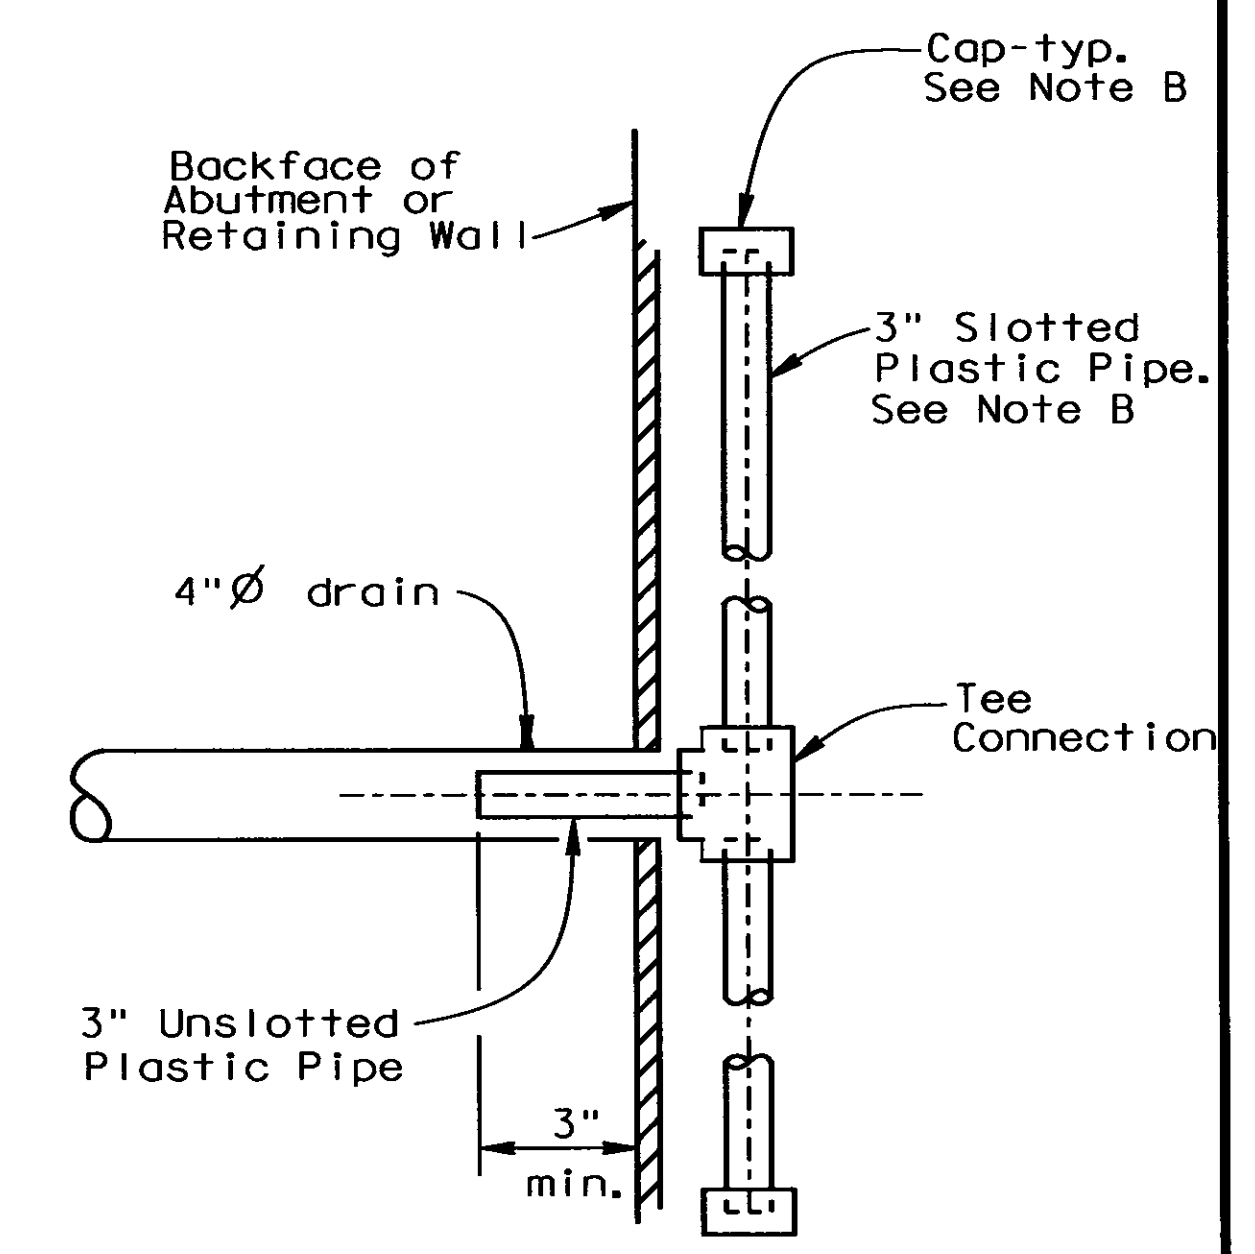

**SECTION B-B**

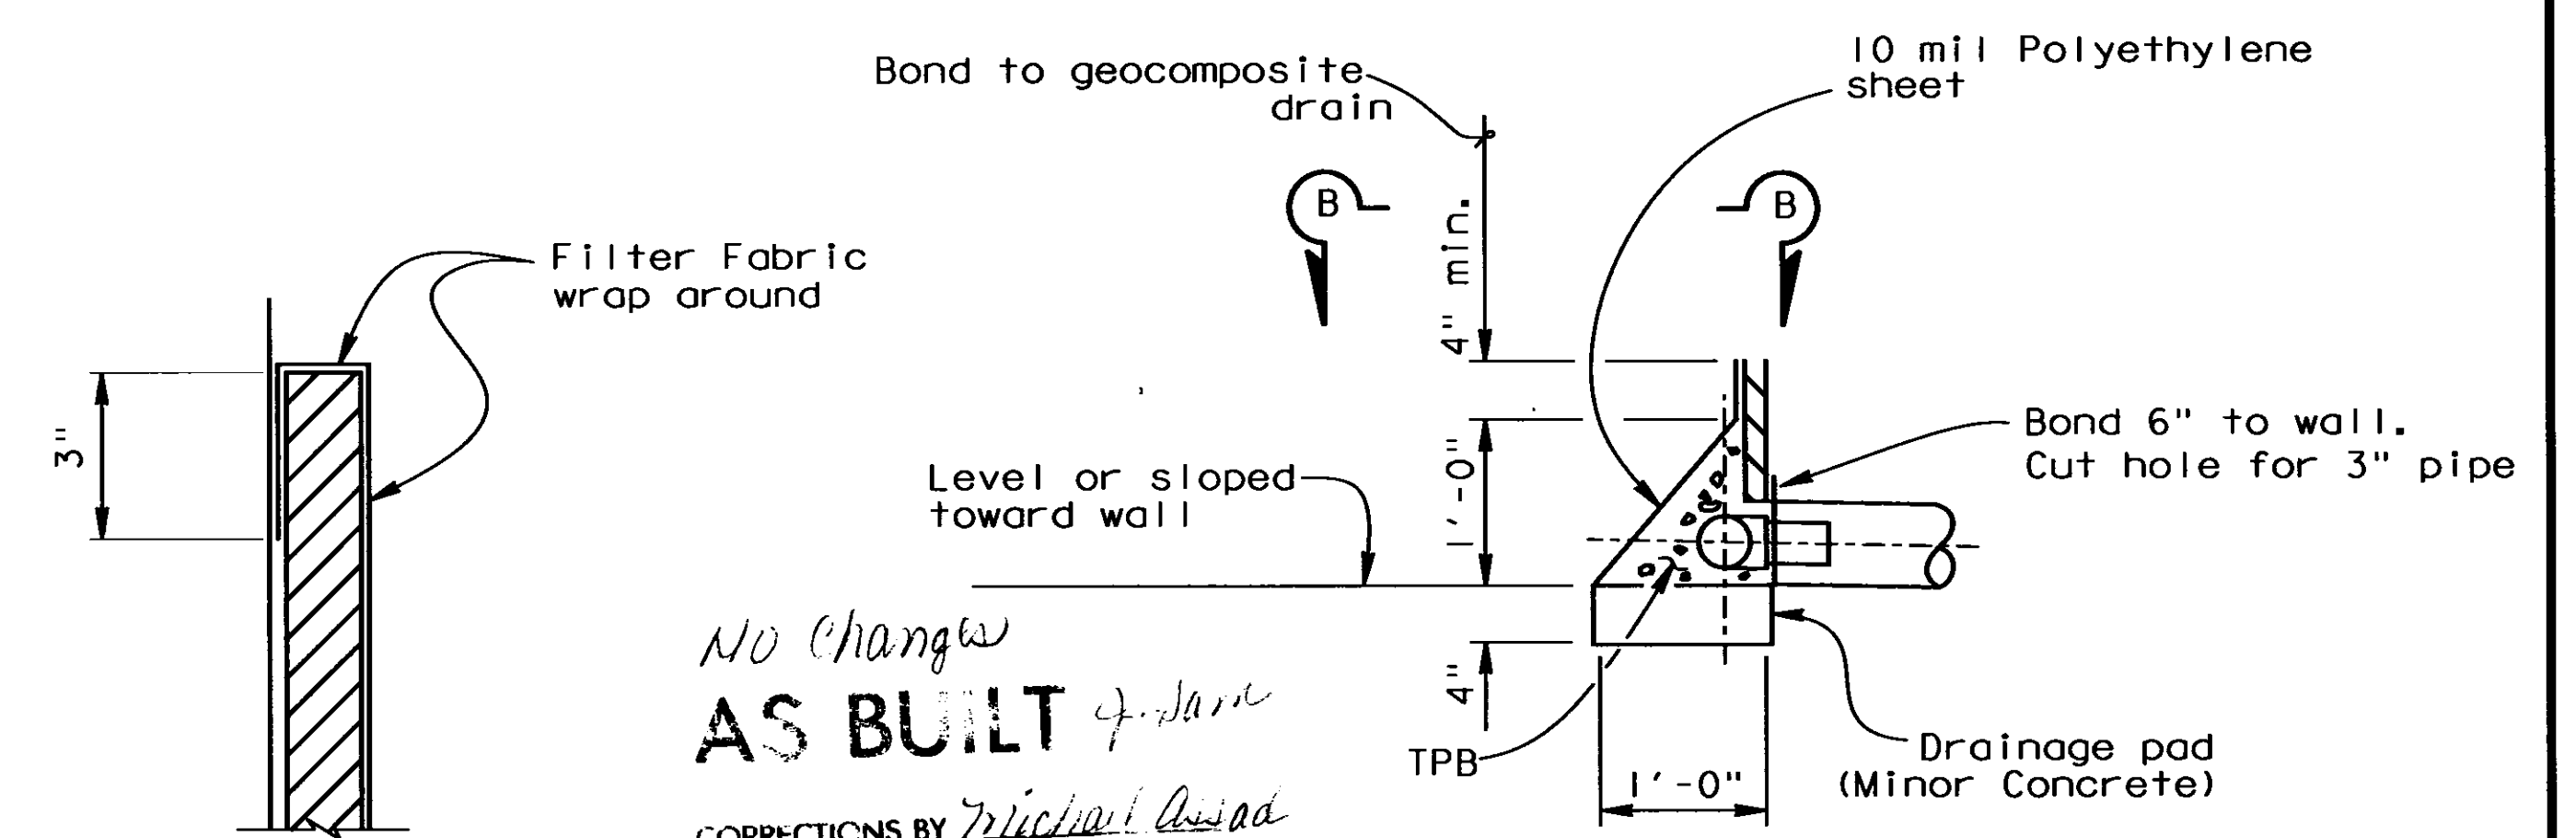

**DETAIL "A"**

**DETAIL "B"**

*No change*  
**AS BUILT**  
CORRECTIONS BY *Michael Assad*  
CONTRACT NO. *04-149304*  
DATE *12-08-97* *3-2-98*

**WEEP HOLE AND GEOCOMPOSITE DRAIN**

ALTERNATIVE TO BRIDGE DETAIL **(B0-3 / 3-1)**

**EARTHQUAKE RETROFIT PROJECT NO. 412**

**DRY CREEK BRIDGE**

**DRAINAGE DETAILS**

DESIGN	BY Garry Tolen	3-96	CHECKED Mike Whiteside	5-96
DETAILS	BY Janice Sam	3-96	CHECKED Mike Whiteside	5-96
QUANTITIES	BY Garry Tolen	6-96	CHECKED Kristi Westoby	6-96

**STATE OF CALIFORNIA**  
**DEPARTMENT OF TRANSPORTATION**


**DISTRICT 2**  
**SEISMIC DESIGN**

BRIDGE NO.	21-0014
POST MILE	16.5









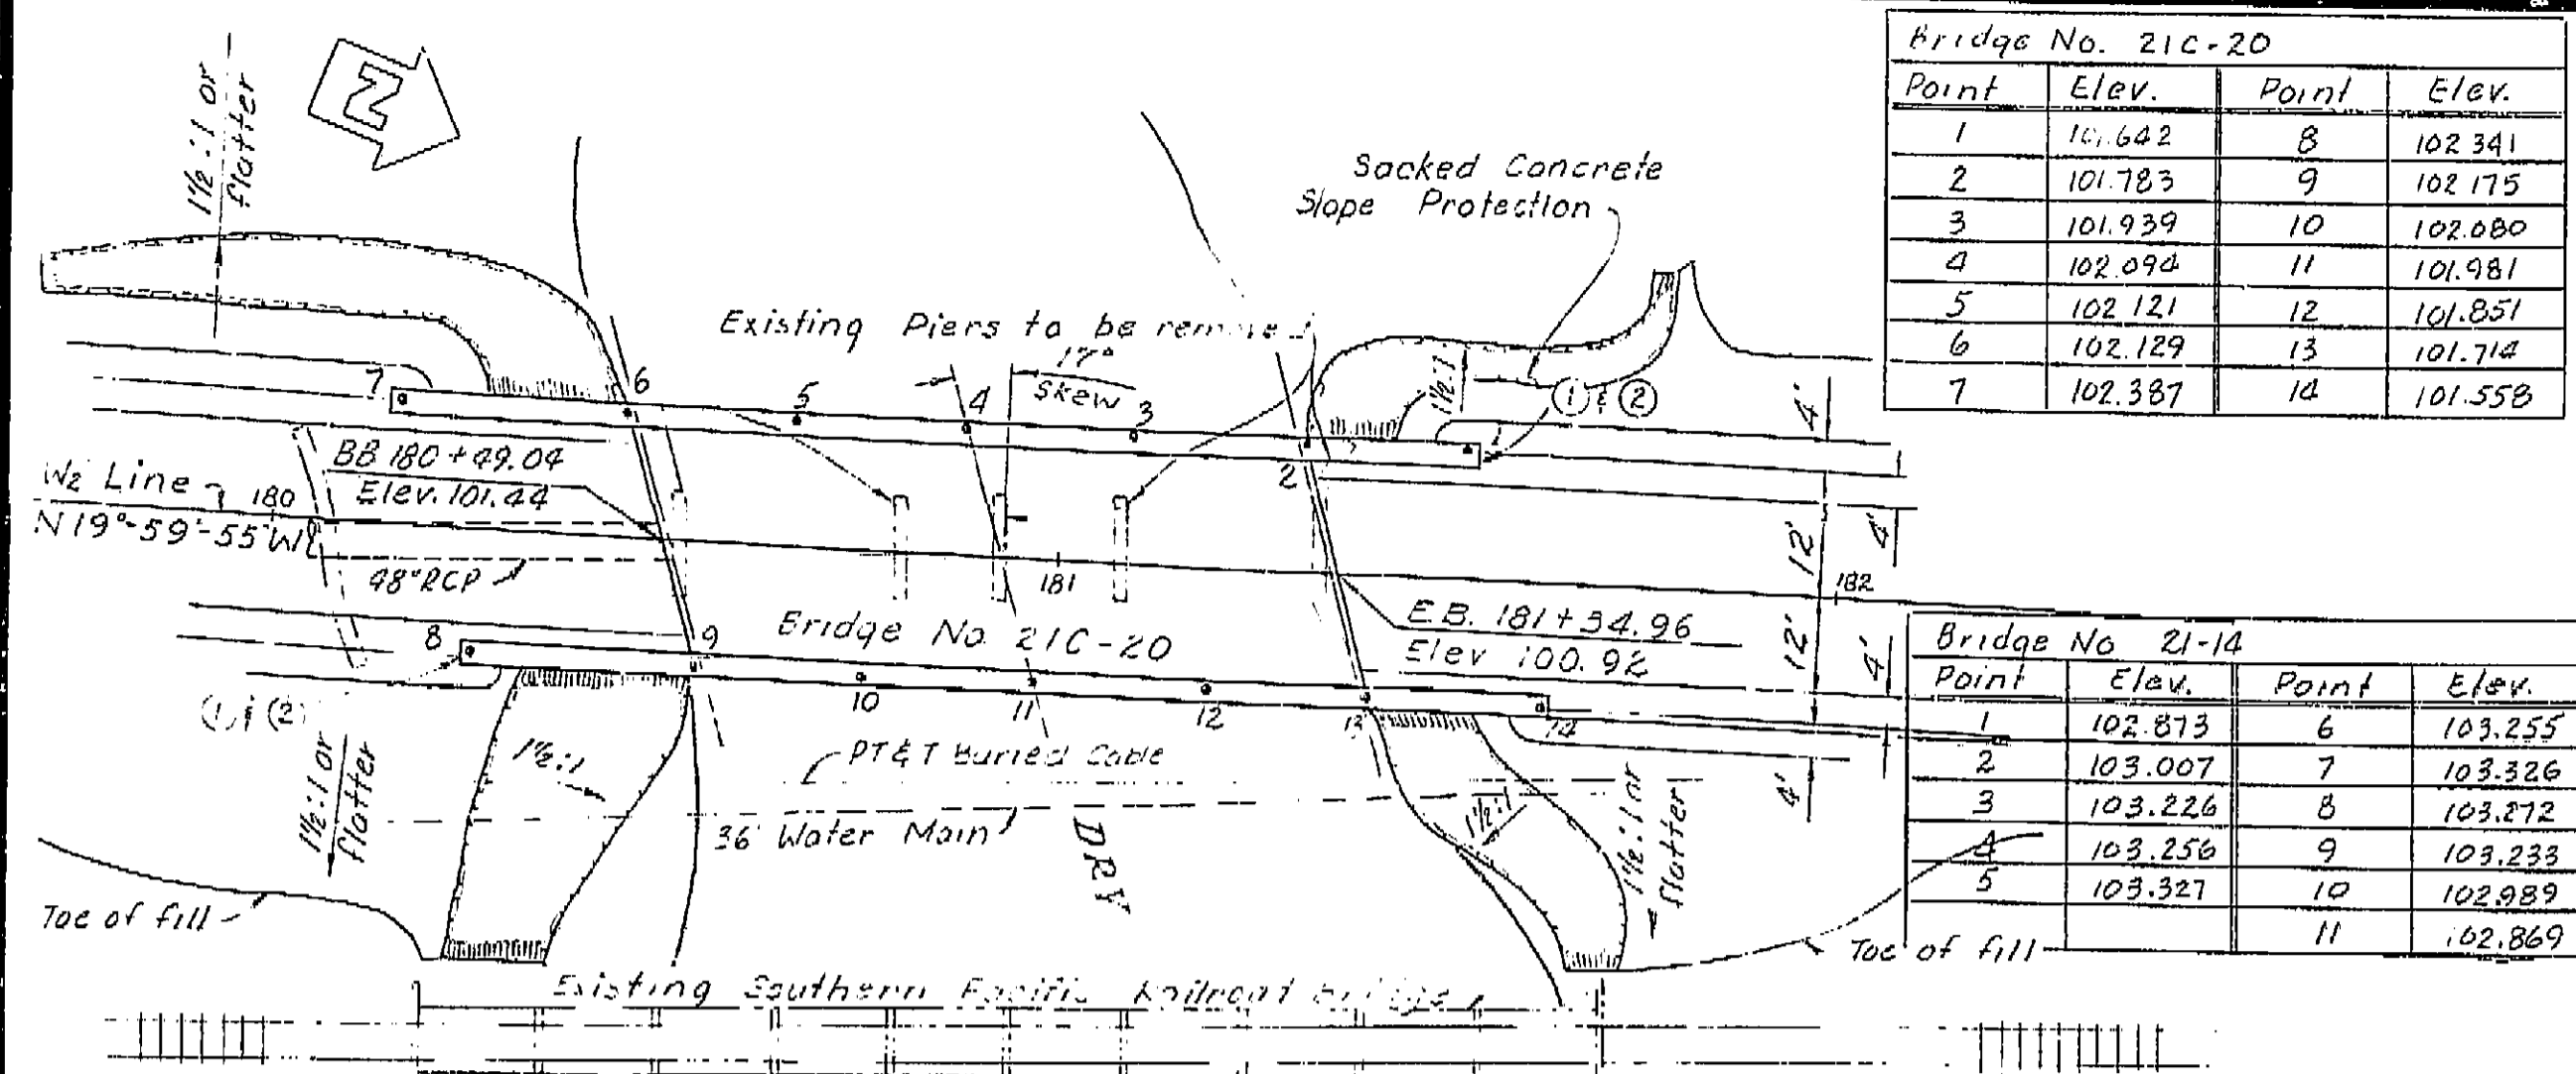


Point	Elev.	Point	Elev.
1	101.642	8	102.341
2	101.783	9	102.175
3	101.939	10	102.080
4	102.094	11	101.981
5	102.121	12	101.851
6	102.129	13	101.714
7	102.387	14	101.558


Point	Elev.	Point	Elev.
1	102.873	6	103.255
2	103.007	7	103.326
3	103.226	8	103.272
4	103.256	9	103.233
5	103.327	10	102.989
		11	102.869

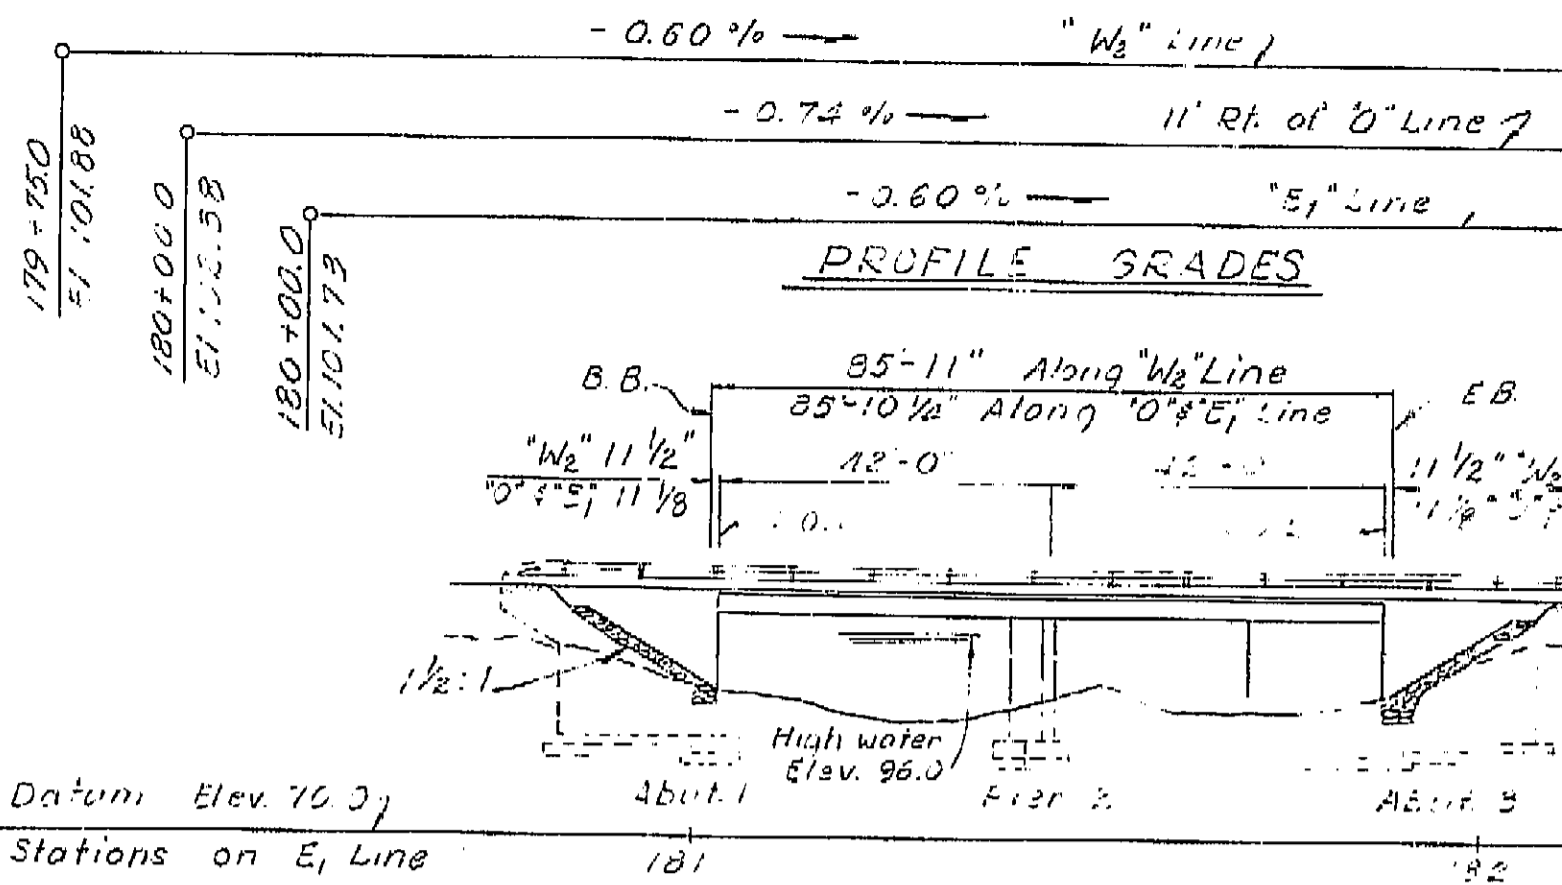

TEMPORARY RAILING (TYPE J)	236 LF	LUMP SUM	-80.00
REMOVING PORTIONS OF BRIDGES			
2" GALVANIZED STEEL PIPE (WATER LINE)	Deleted		
3" SUPPLY LINE (BRIDGE)	100 LF		224 LF
CLASS "A" CONCRETE (FOOTING BLOCK)			580 CY
REFINISHING BRIDGE DECK			235 SF
DRILLING AND GROUTING DOWELS			280 LF
CONTRAST TREATMENT Deleted - cco #31			128-SY
BRIDGE APPROACH GUARD RAILING (TYPE B)			291 LF
BARRIER RAILING (TYPE 9)			432 LF
BARRIER RAILING (TYPE 10)			518 LF

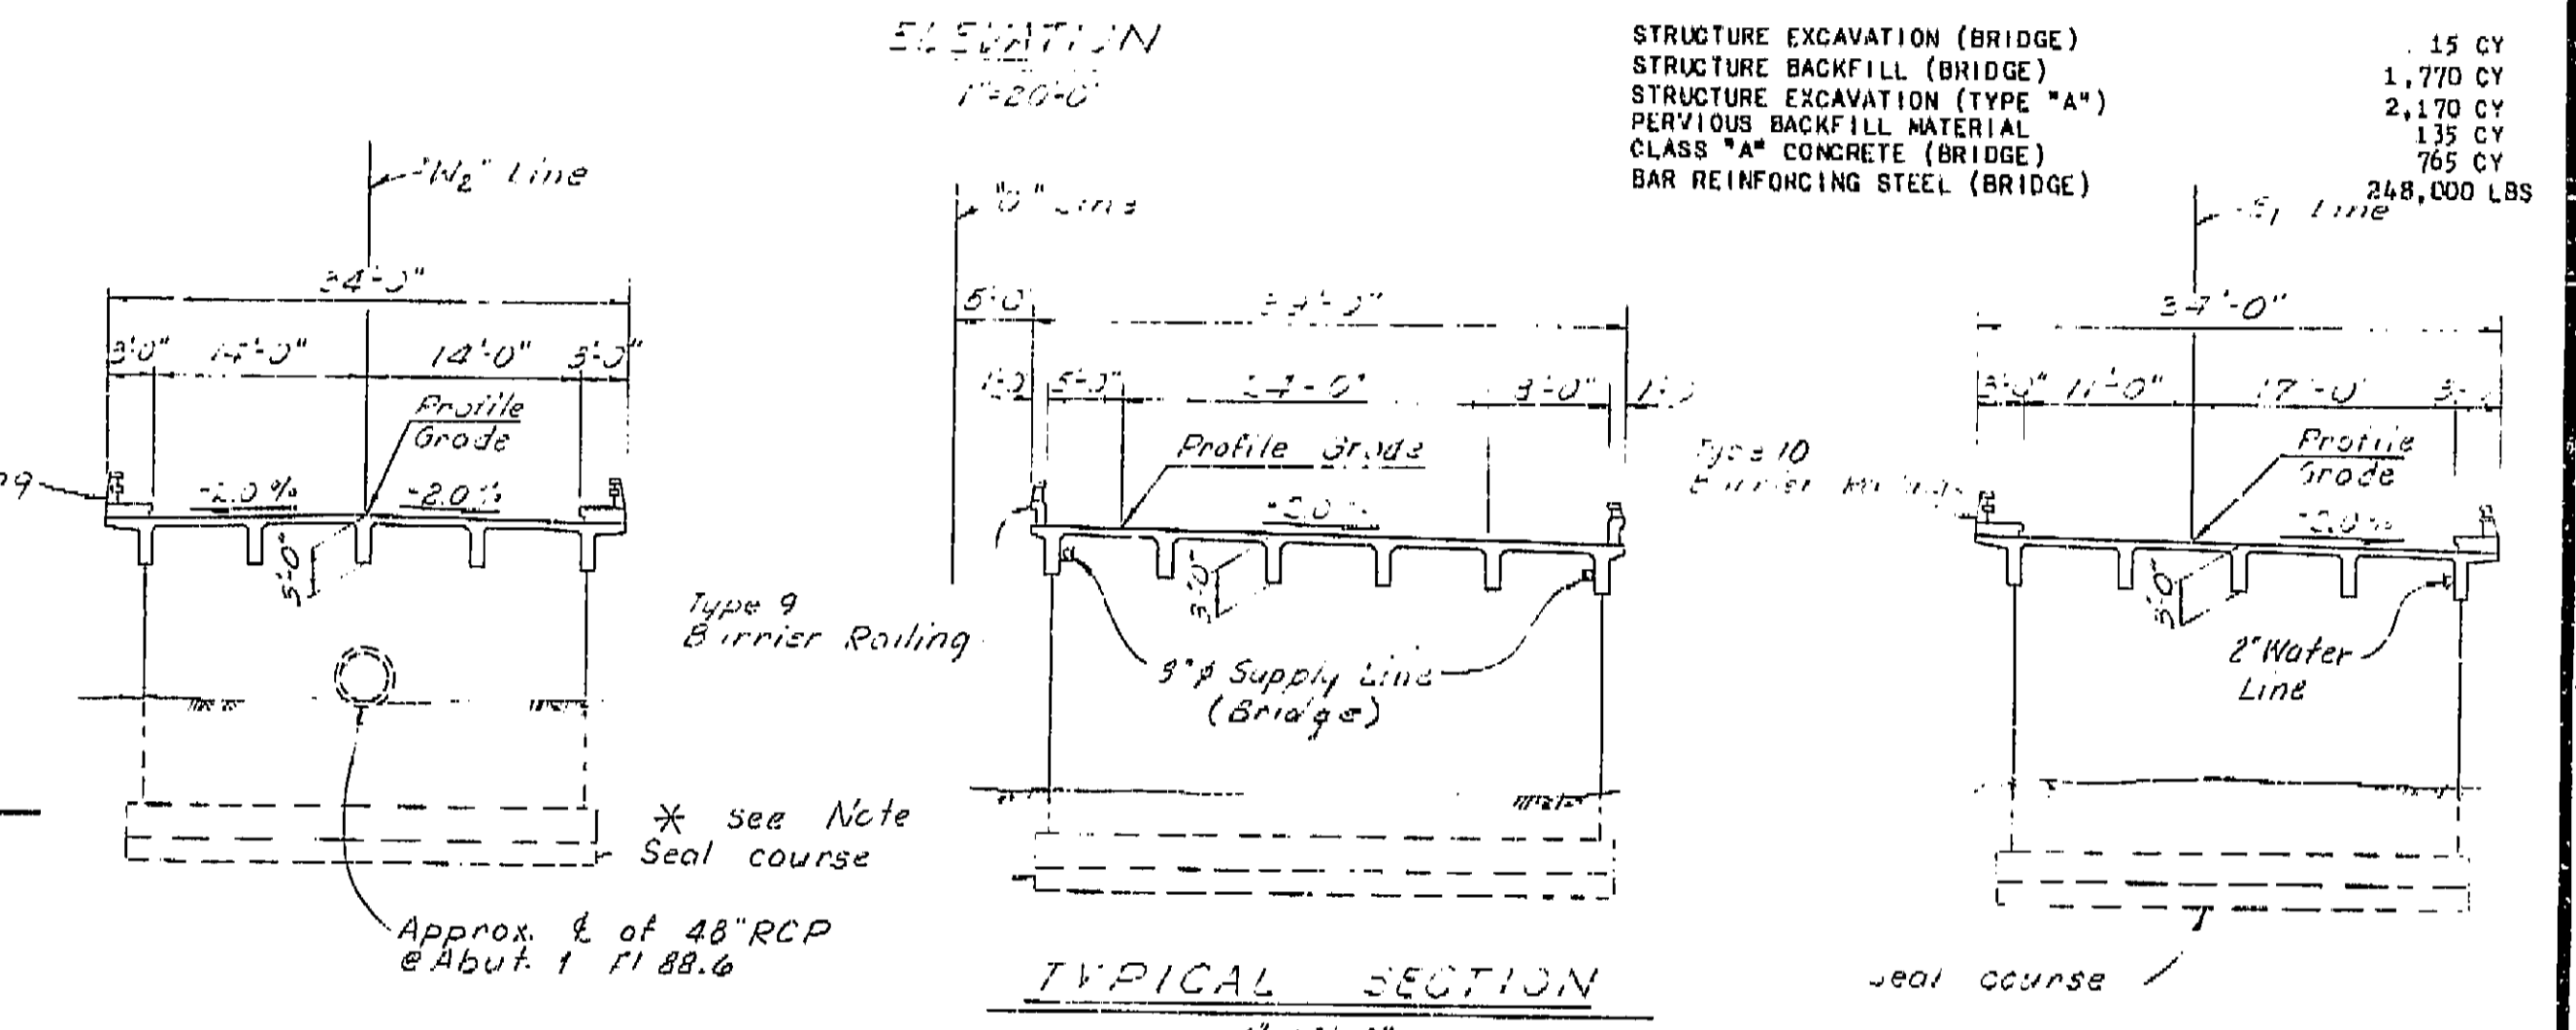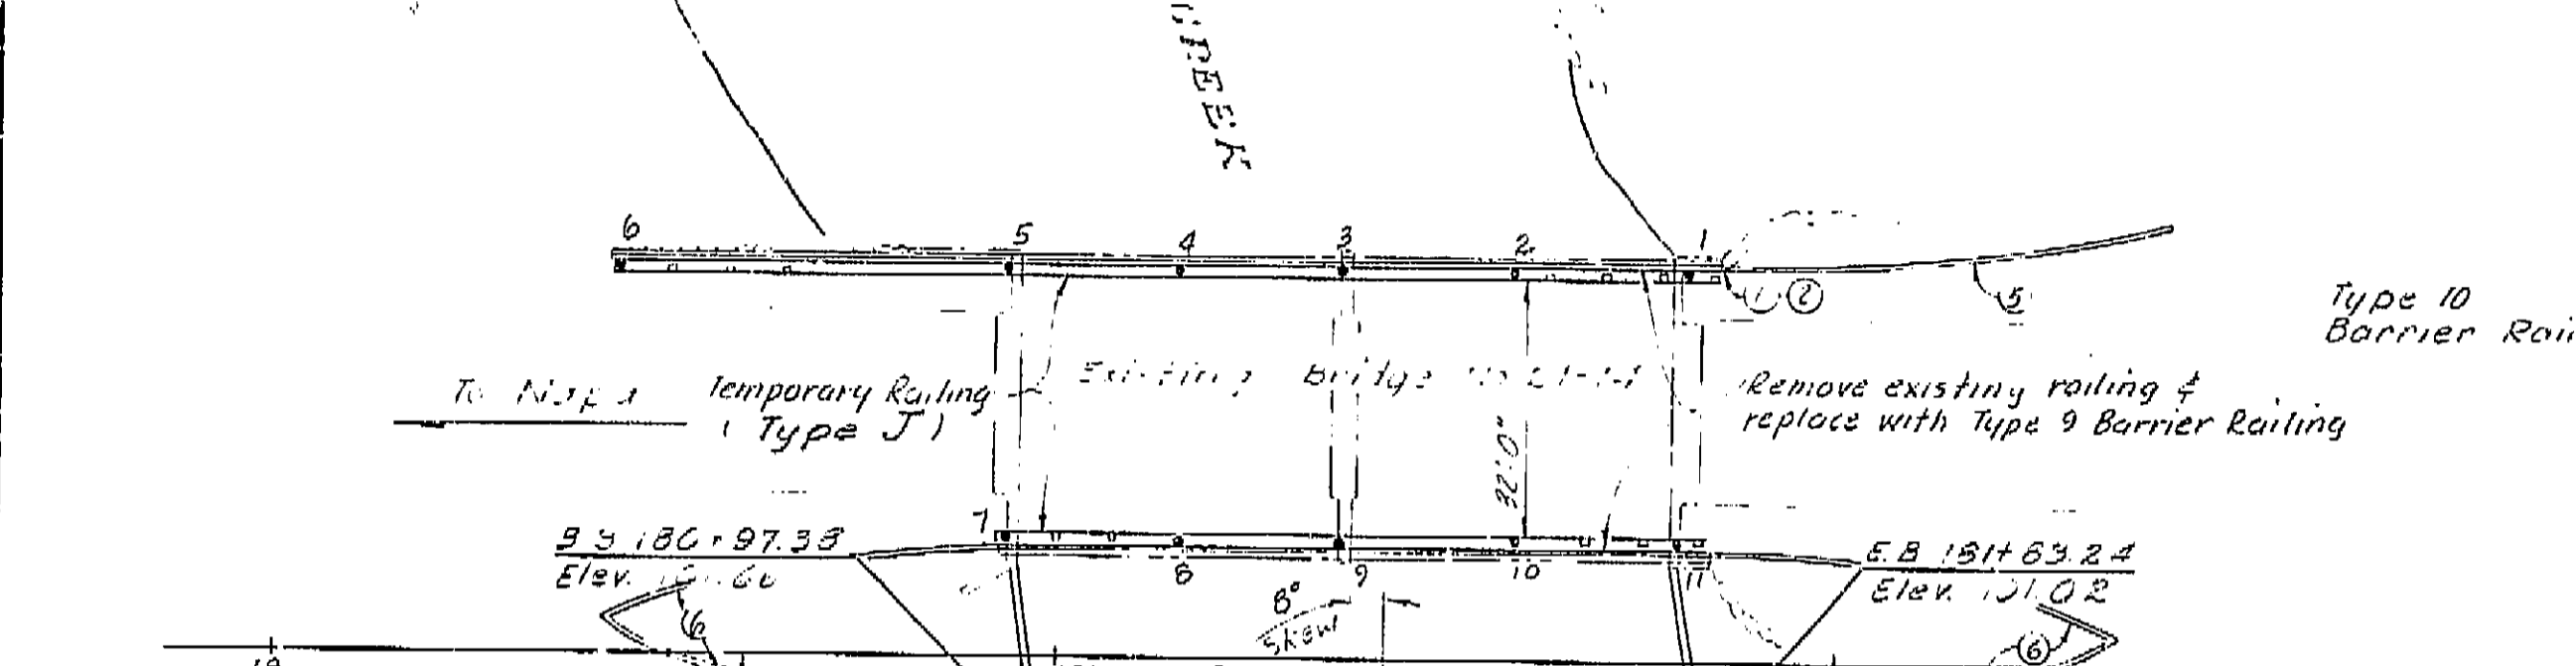

STRUCTURE EXCAVATION (BRIDGE)	15 CY
STRUCTURE BACKFILL (BRIDGE)	1,770 CY
STRUCTURE EXCAVATION (TYPE "A")	2,170 CY
PERVIOUS BACKFILL MATERIAL	135 CY
CLASS "A" CONCRETE (BRIDGE)	765 CY
BAR REINFORCING STEEL (BRIDGE)	248,000 LBS

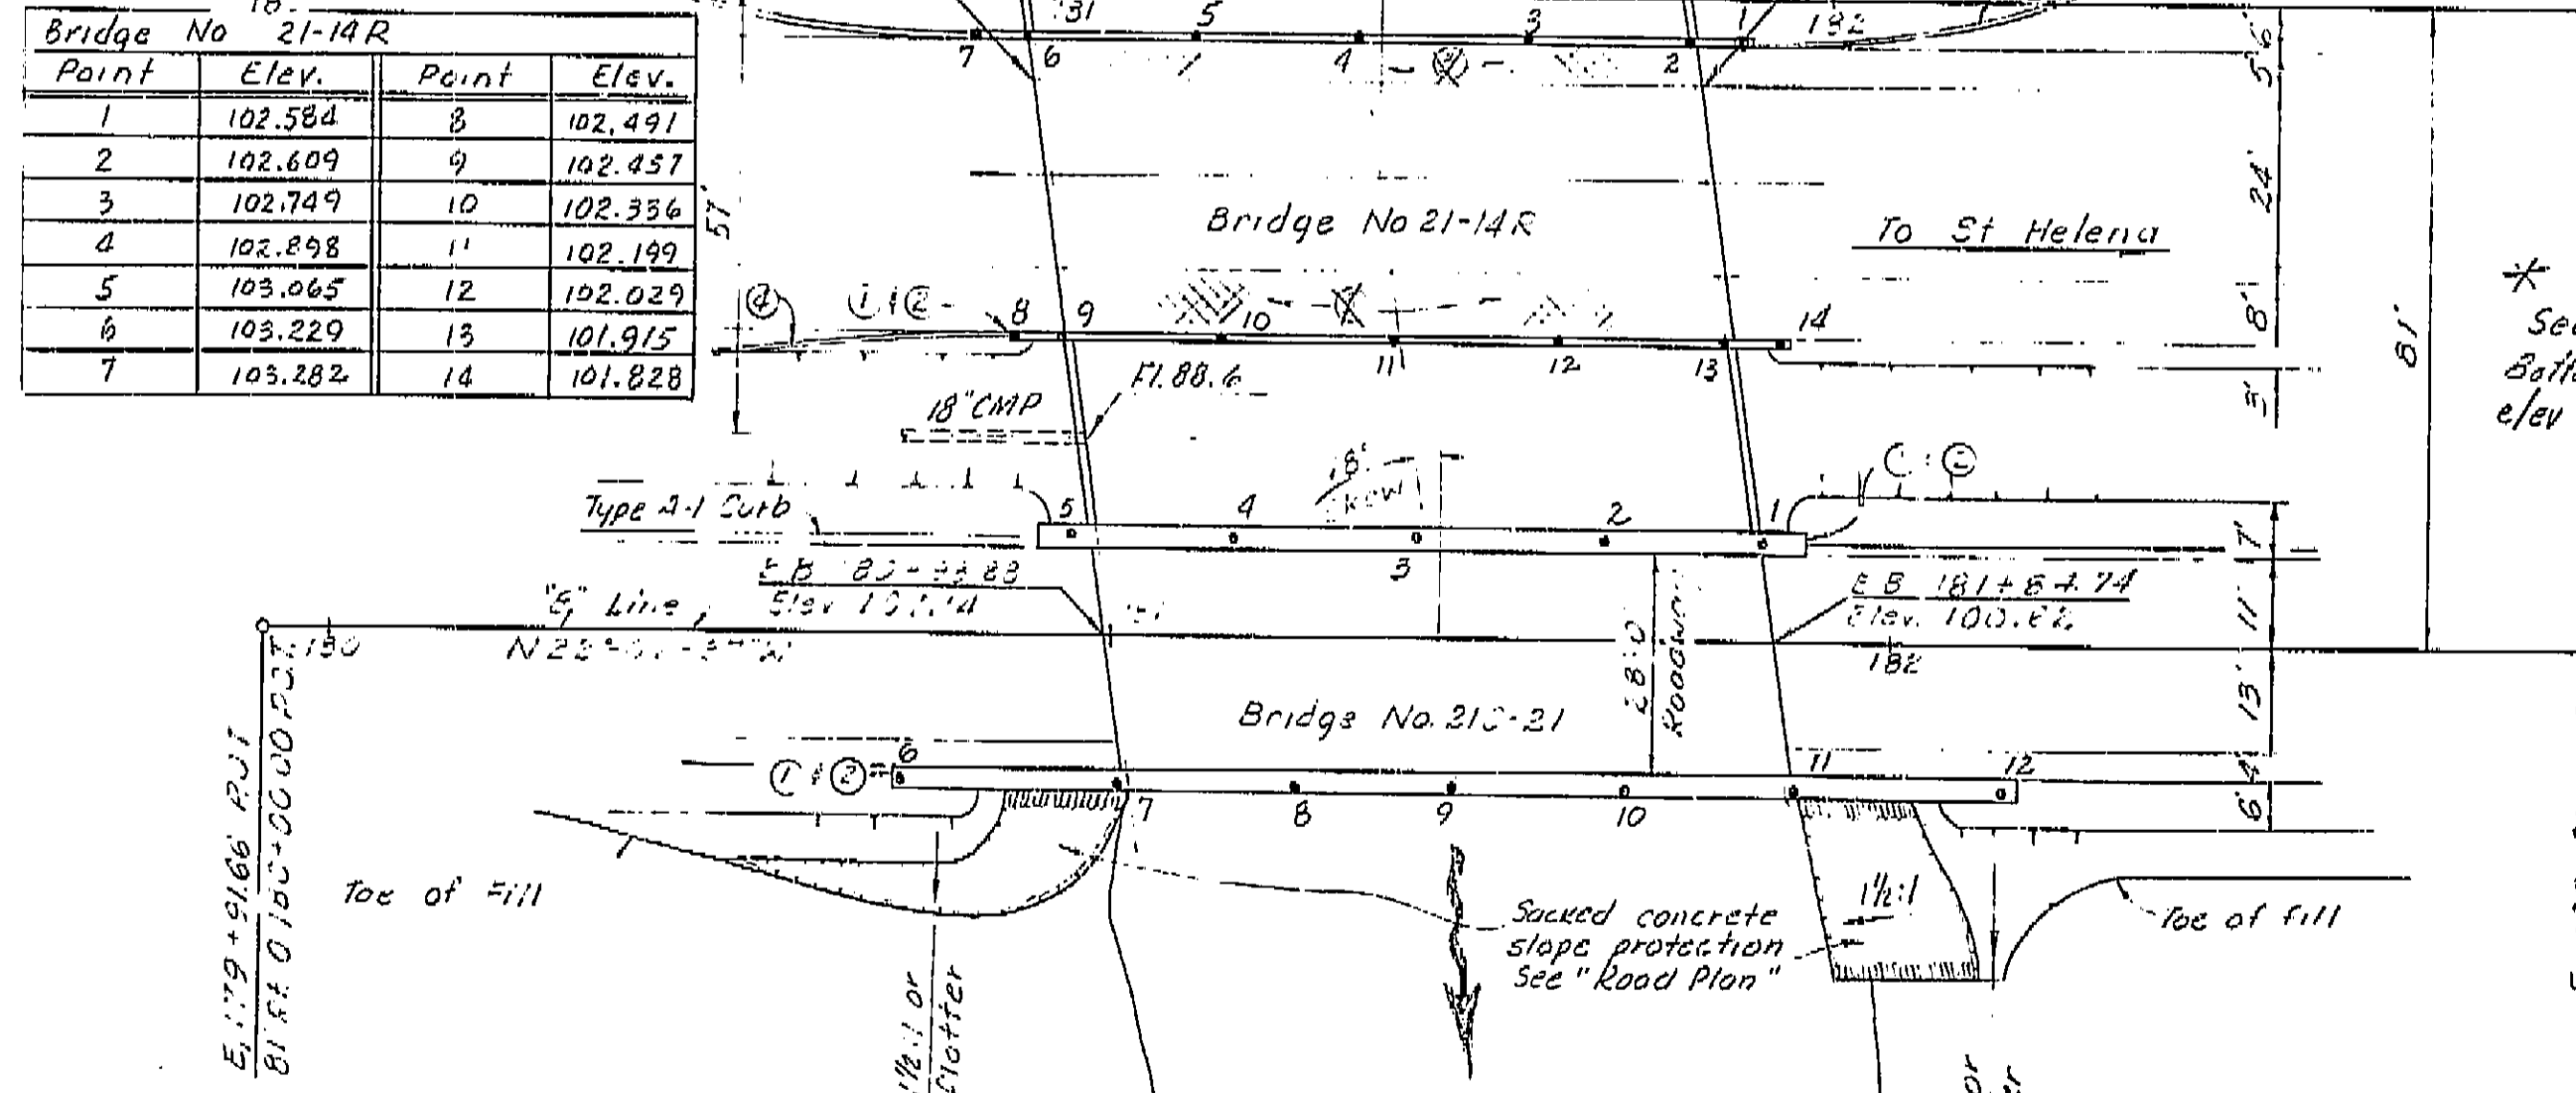

Point	Elev.	Point	Elev.
1	102.584	8	102.491
2	102.609	9	102.437
3	102.749	10	102.336
4	102.898	11	102.199
5	103.065	12	102.029
6	103.229	13	101.915
7	103.282	14	101.828

\* Seal course eliminated at all footings  
Bottom of all footings built at planned elev of seal course.

CONTRACTOR: L.S. Foster  
DATE: 5-13-70  
TIME: 7/9/70

STANDARD PLANS dated February 1968  
A22-B2 Excavation & Backfill Bridges & Walls  
B3-1 Retaining Wall Type I H=4'-30"  
B3-8 Retaining Wall Details No. 1  
B3-9 Retaining Wall Details No. 2  
B6-1 T-Beam Details No. 1  
B11-03 Barrier Railing Details for Types 9, 10, 11 & 12  
B11-04 Barrier Railing Type 10  
B11-30 Temporary Railings

Sheet No.	Title
1.	General Plan
2.	Foundation Plan
3.	Abutment Details W2 Line
4.	Abutment Details E1 & O Line
5.	Pier Details
6.	Typical Section
7.	Girder Layout
8.	Girder Reinforcement
9.	Strutted Abutment Spread Footing
10.	Barrier Railing Type 9
11.	Bridge Approach Guard Railing Type 9 (Details)
12.	Bridge Approach Guard Railing Type 5 (Layout)
13.	Layout Test Bearing

- Note:
- 1) E. 11. & 12. are structural
  - 2) C. U. 51
  - 3) Contrast treatments Deleted - cco #31
  - 4) B.A.G.R. Type 8 L=38'-6" W=3'-0" Type 1 Flare
  - 5) B.A.G.R. Type 8 L=58'-6" W=5'-0" Type 1 Flare
  - 6) B.A.G.R. Type 8 L=48'-6" W=20'-0" Type 3 Flare

**AS BUILT PLANS**  
Contract No. 04-102134  
Date Completed \_\_\_\_\_  
Document No. 40001324

FOR GENERAL NOTES SEE Foundation Plan Sheet

LIVE LOADING H20 - 44 AND ALTERNATIVE

BRIDGE DEPARTMENT  
**DESIGN SECTION 12**

Section Supervisor: *J. L. Cascard*  
Project Designer: *E. J. ...*

DESIGN	By <i>J. L. Cascard</i>	Checked <i>J. L. Cascard</i>
DETAILS	By <i>J. L. Cascard</i>	Checked <i>J. L. Cascard</i>
LAYOUT	By <i>J. L. Cascard</i>	Checked <i>J. L. Cascard</i>
QUANTITIES	By <i>J. L. Cascard</i>	Checked <i>J. L. Cascard</i>
SPECIFICATIONS	By <i>J. L. Cascard</i>	Checked <i>J. L. Cascard</i>

Approved Recommended by: *R. C. ...*  
Date: *...*

STATE OF CALIFORNIA  
DEPARTMENT OF PUBLIC WORKS  
DIVISION OF HIGHWAYS

**DRY CREEK BRIDGES**  
LOCATED 2.2 MILES NORTH OF THE NORTH CITY LIMITS OF NAPA  
IN NAPA COUNTY

**GENERAL PLAN**

SCALE AS NOTED 21C-20, 21-14R, BRIDGE 21C-21 FILE DRAWING 2114-1


I HEREBY CERTIFY THAT THIS IS A TRUE AND ACCURATE COPY OF THE ABOVE DOCUMENT TAKEN UNDER MY DIRECTION AND CONTROL ON THIS DATE IN SACRAMENTO, CALIFORNIA PURSUANT TO AUTHORIZATION BY THE DIRECTOR OF PUBLIC WORKS.  
DATE: *March 8, 1971* SIGNATURE: *...* TITLE: *Highways Administration Officer*



DIST.	COUNTY	ROUTE	SECTION	SHEET NO.	TOTAL SHEETS
04	Napa	29	15.9/19.6	47	69

REGISTERED CIVIL ENGINEER'S 11104  
 DATE APPROVED: September 23, 1968

**AS BUILT PLANS**  
 Contract No. 04-102134  
 Date Completed  
 Document No. 40001324

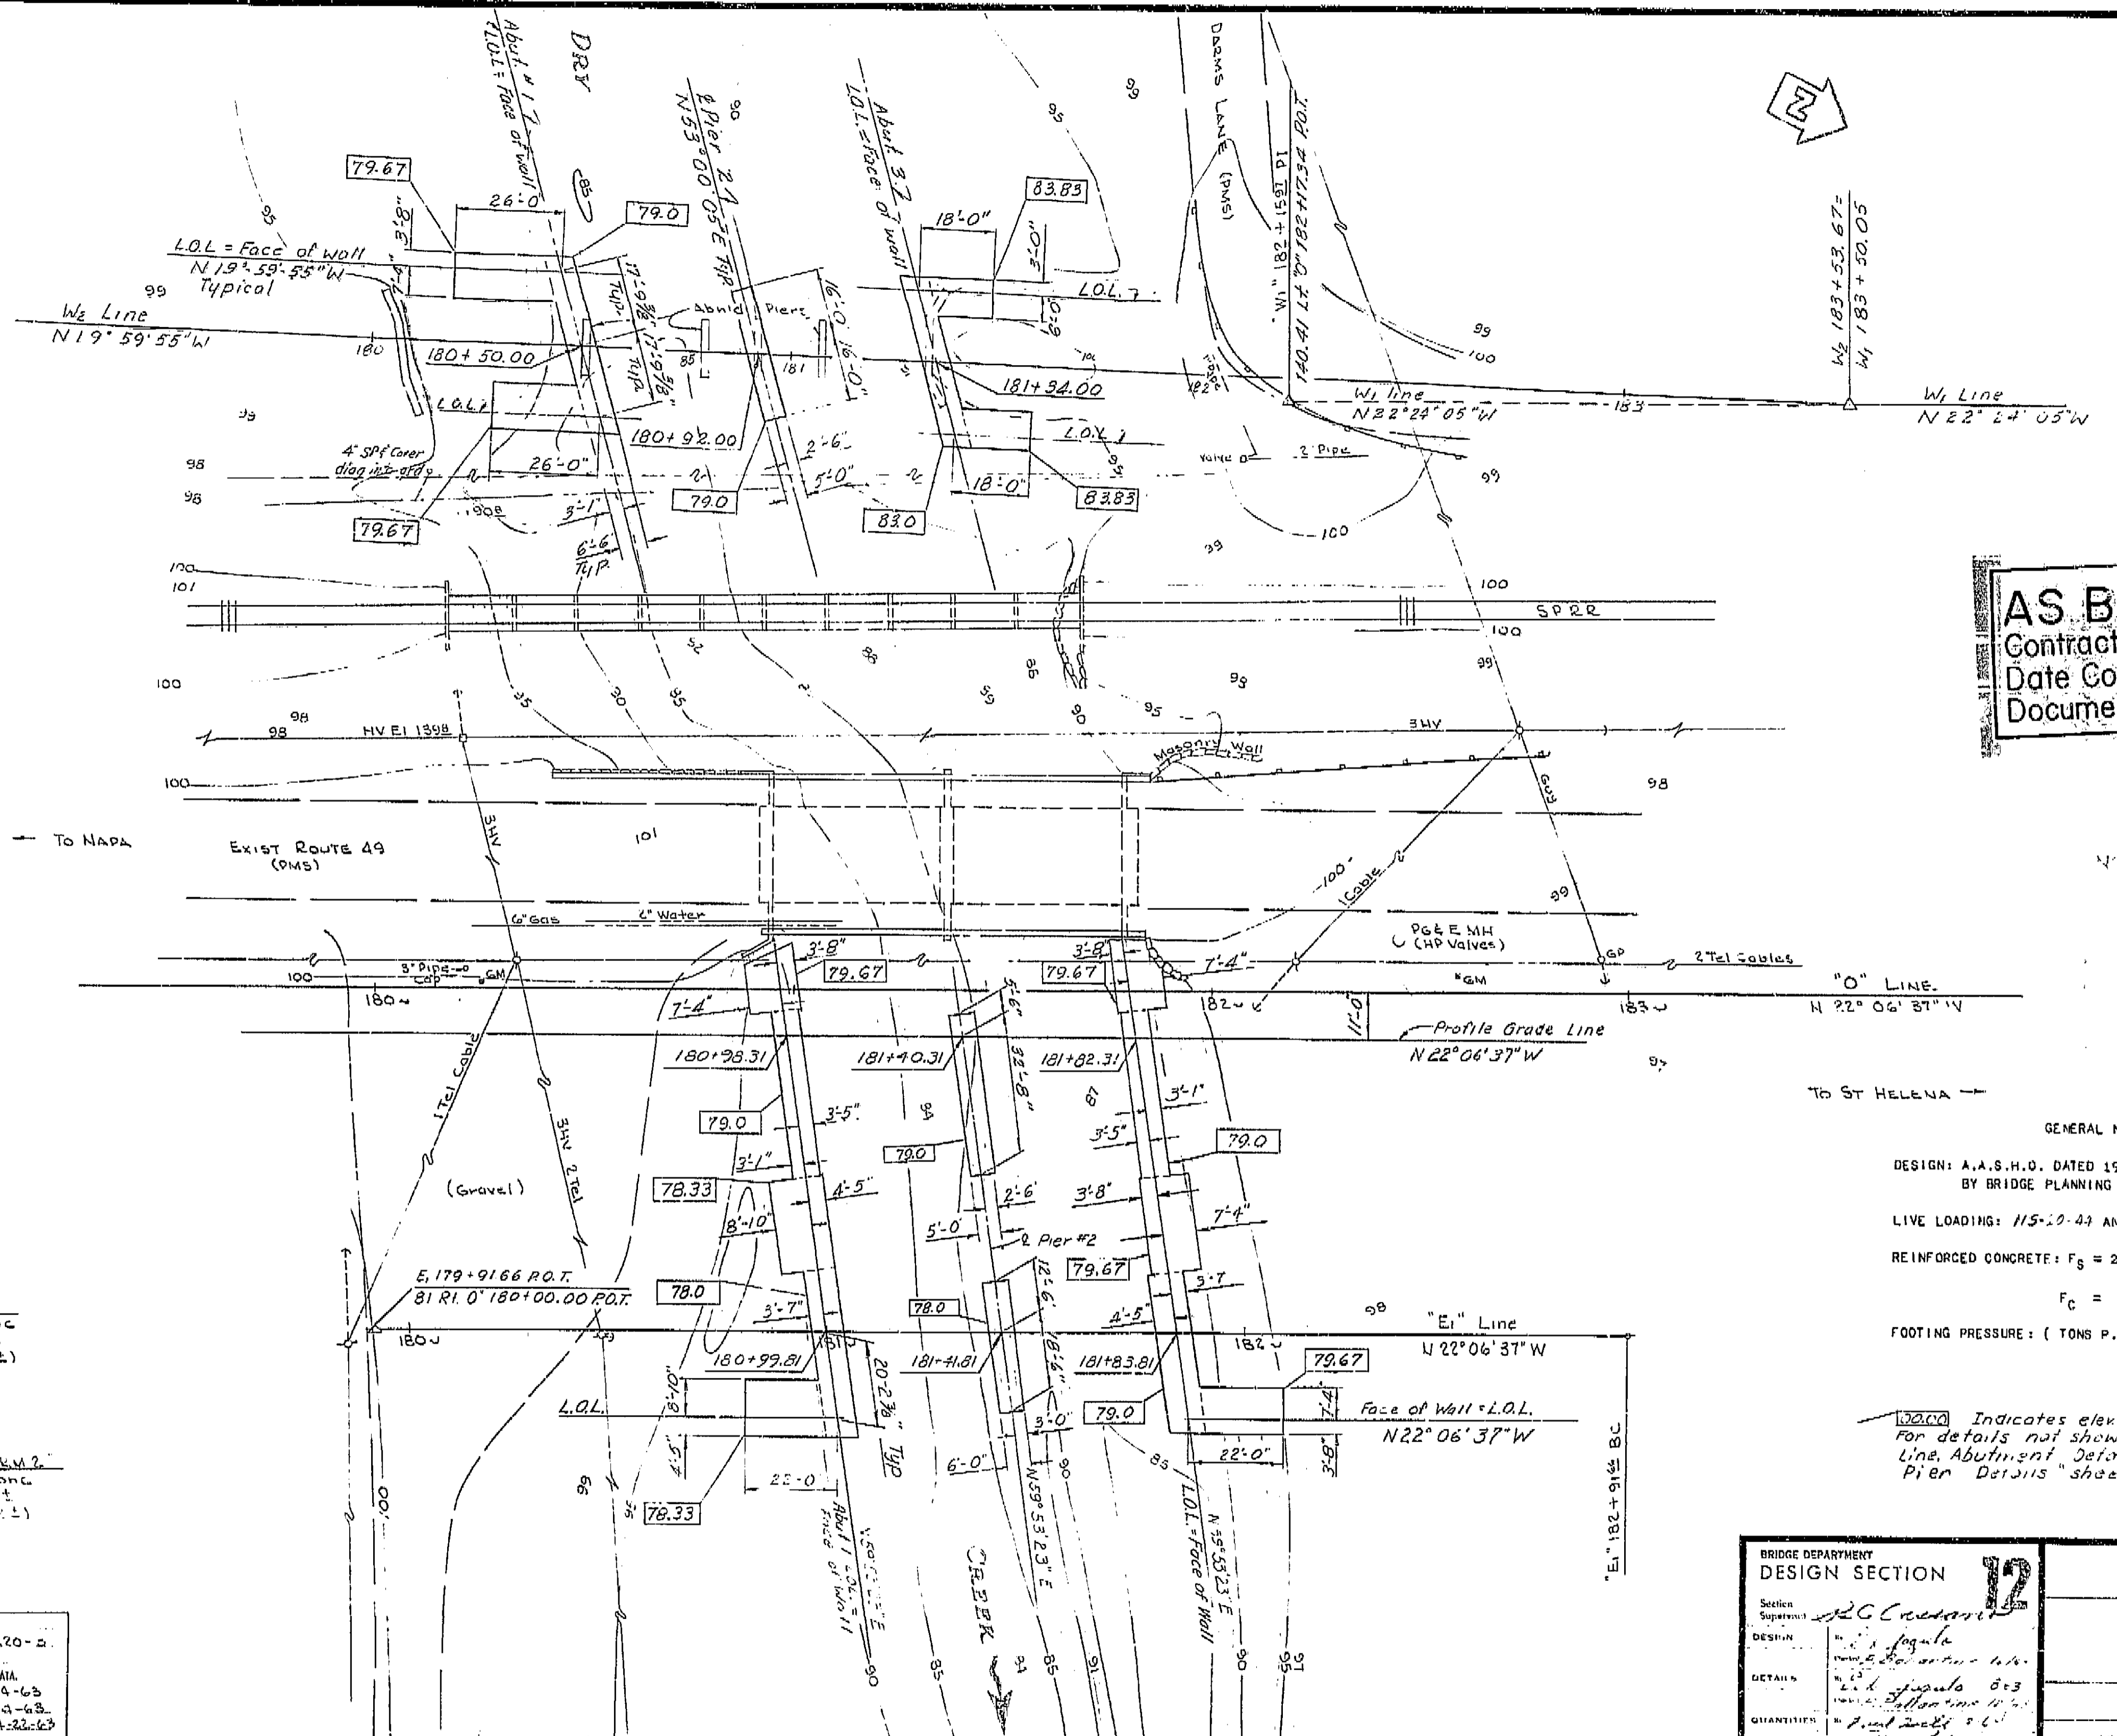

**GENERAL NOTES**

DESIGN: A.A.S.H.O. DATED 1958 WITH REVISIONS AND AS SUPPLEMENTED BY BRIDGE PLANNING AND DESIGN MANUAL.

LIVE LOADING: 115-20-44 AND ALTERNATIVE

REINFORCED CONCRETE:  $F_c = 20,000$  P.S.I.,  $N = 10$

$F_c = 1,200$  P.S.I.

FOOTING PRESSURE: (TONS P.S.F.)  
 Br. No. 21-14R 2.5  
 Br. No. 21C-20 2.5  
 Br. No. 21C-21 2.0

100.00 Indicates elev for bottom of footing  
 For details not shown see "Abut Details W2"  
 Line, Abutment Details E1 & C Line and  
 Pier Details sheet.

USCGS "Dox"  
 Ed. 1-1964  
 171° 17' 0" (178+54±)  
 INST. EL. 99.72

USCGS "Dev. KM. 2"  
 Ed. 1-1964  
 174° 17' 0" (178+80±)  
 INST. EL. 99.55

LEVEL DATUM: DISTRICT  
 FOR ALIGNMENT TIES SEE PR 21C-20-2  
 CONTIGUOUS AS OF 4-63  
 SITE PLAN TO SUPPLEMENT DISTRICT DATA  
 SURVEY BY JHE DATE 4-63  
 DRAWN BY VBT DATE 4-63  
 TRACKED BY JS DATE 4-23-63

BRIDGE DEPARTMENT  
**DESIGN SECTION 12**  
 Section Supervisor: J.C. Cassari  
 DESIGN: J. J. Fogarty  
 DETAIL: J. J. Fogarty  
 QUANTITIES: J. J. Fogarty

STATE OF CALIFORNIA  
 DEPARTMENT OF PUBLIC WORKS  
 DIVISION OF HIGHWAYS

**DRY CREEK BRIDGES**

**FOUNDATION PLAN**



SCALE 1" = 20'  
 BRIDGE 21C-21  
 FILE E-21  
 DRAWING 2114-2

I HEREBY CERTIFY THAT THIS IS A TRUE AND ACCURATE COPY OF THE ABOVE DOCUMENT AS  
 PREPARED BY THE ENGINEER AND CONTROLLED BY THE DIRECTOR OF PUBLIC WORKS  
 DATE 10/23/68 SIGNATURE [Signature]




7	CALIF.				
DIST.	COUNTY	ROUTE	SECTION	SHEET NO.	TOTAL SHEETS
04	Nap	29	159	48	69

DATE APPROVED: September 23, 1968

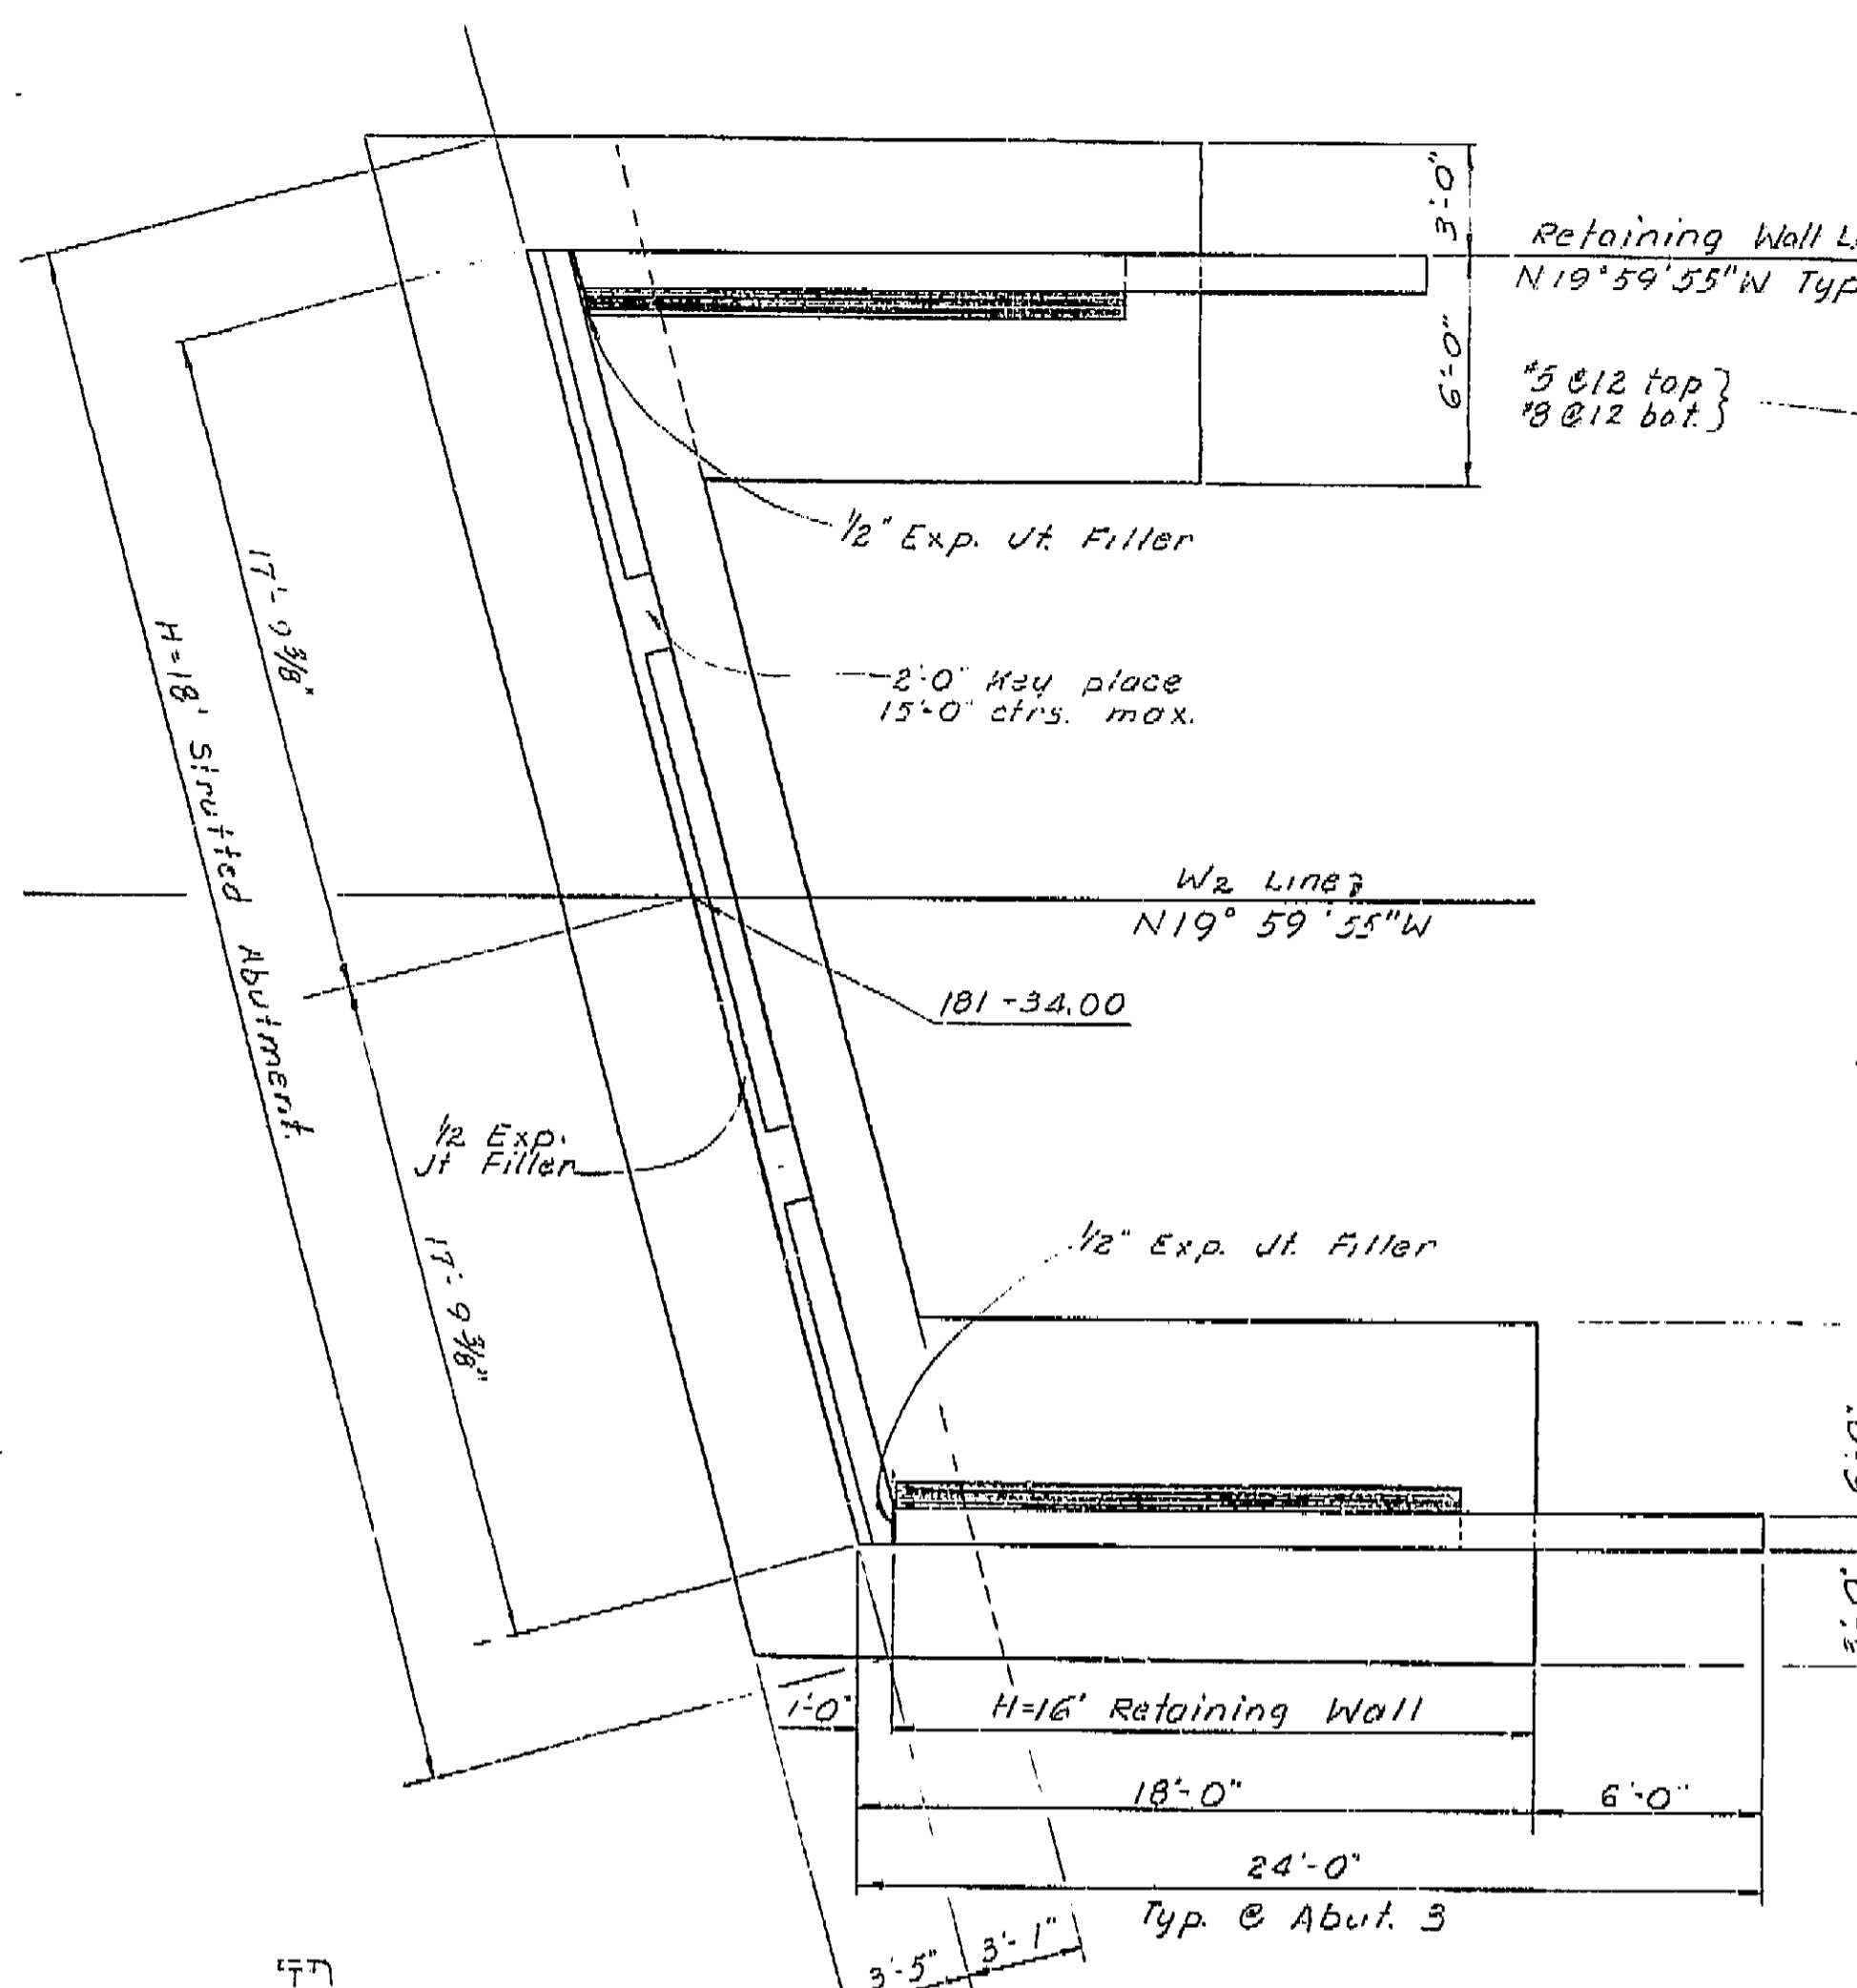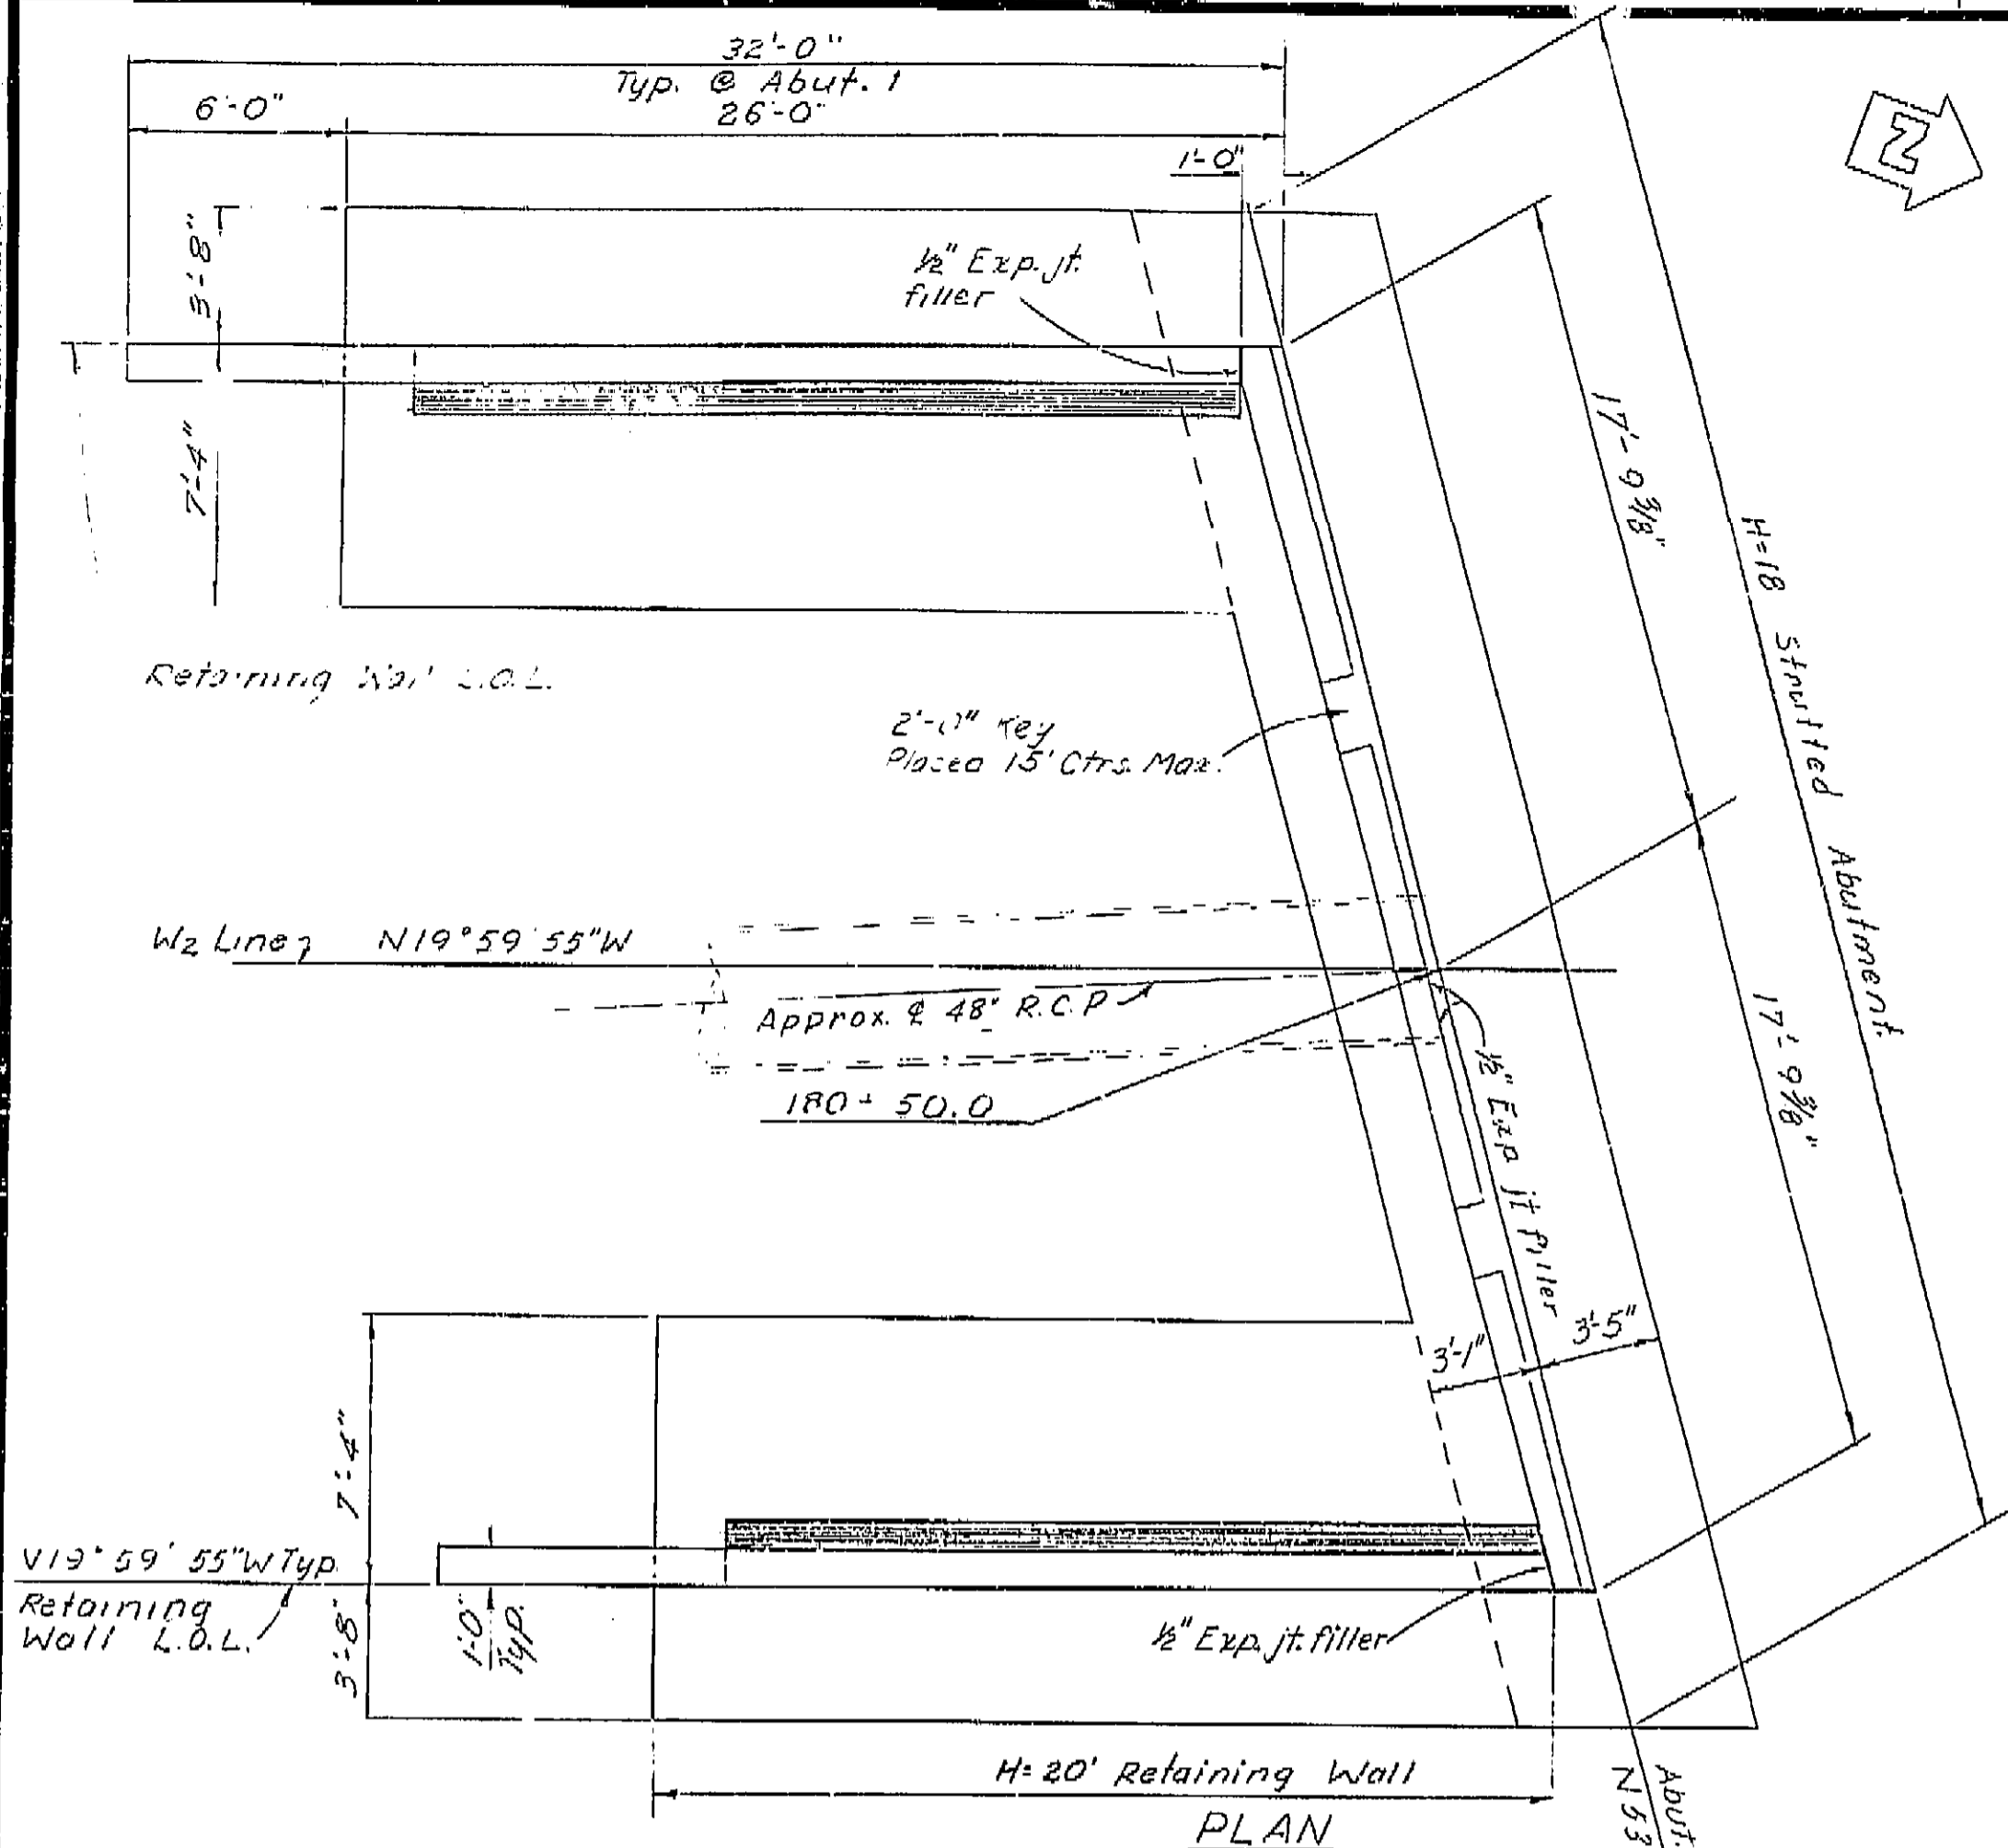

**TYPICAL CORNER DETAILS**  
 84 Corners Br. No. 21C-20  
 32 Corners Br. No. 21C-21

NOTE: Seal course to be placed only when ordered by the Engineer. Seal thickness shown for estimating purposes only. The thickness to be used will be determined by the contractor. When seal is used use bottom seal. Seal shall be placed at the elevation shown for bottom of seal.

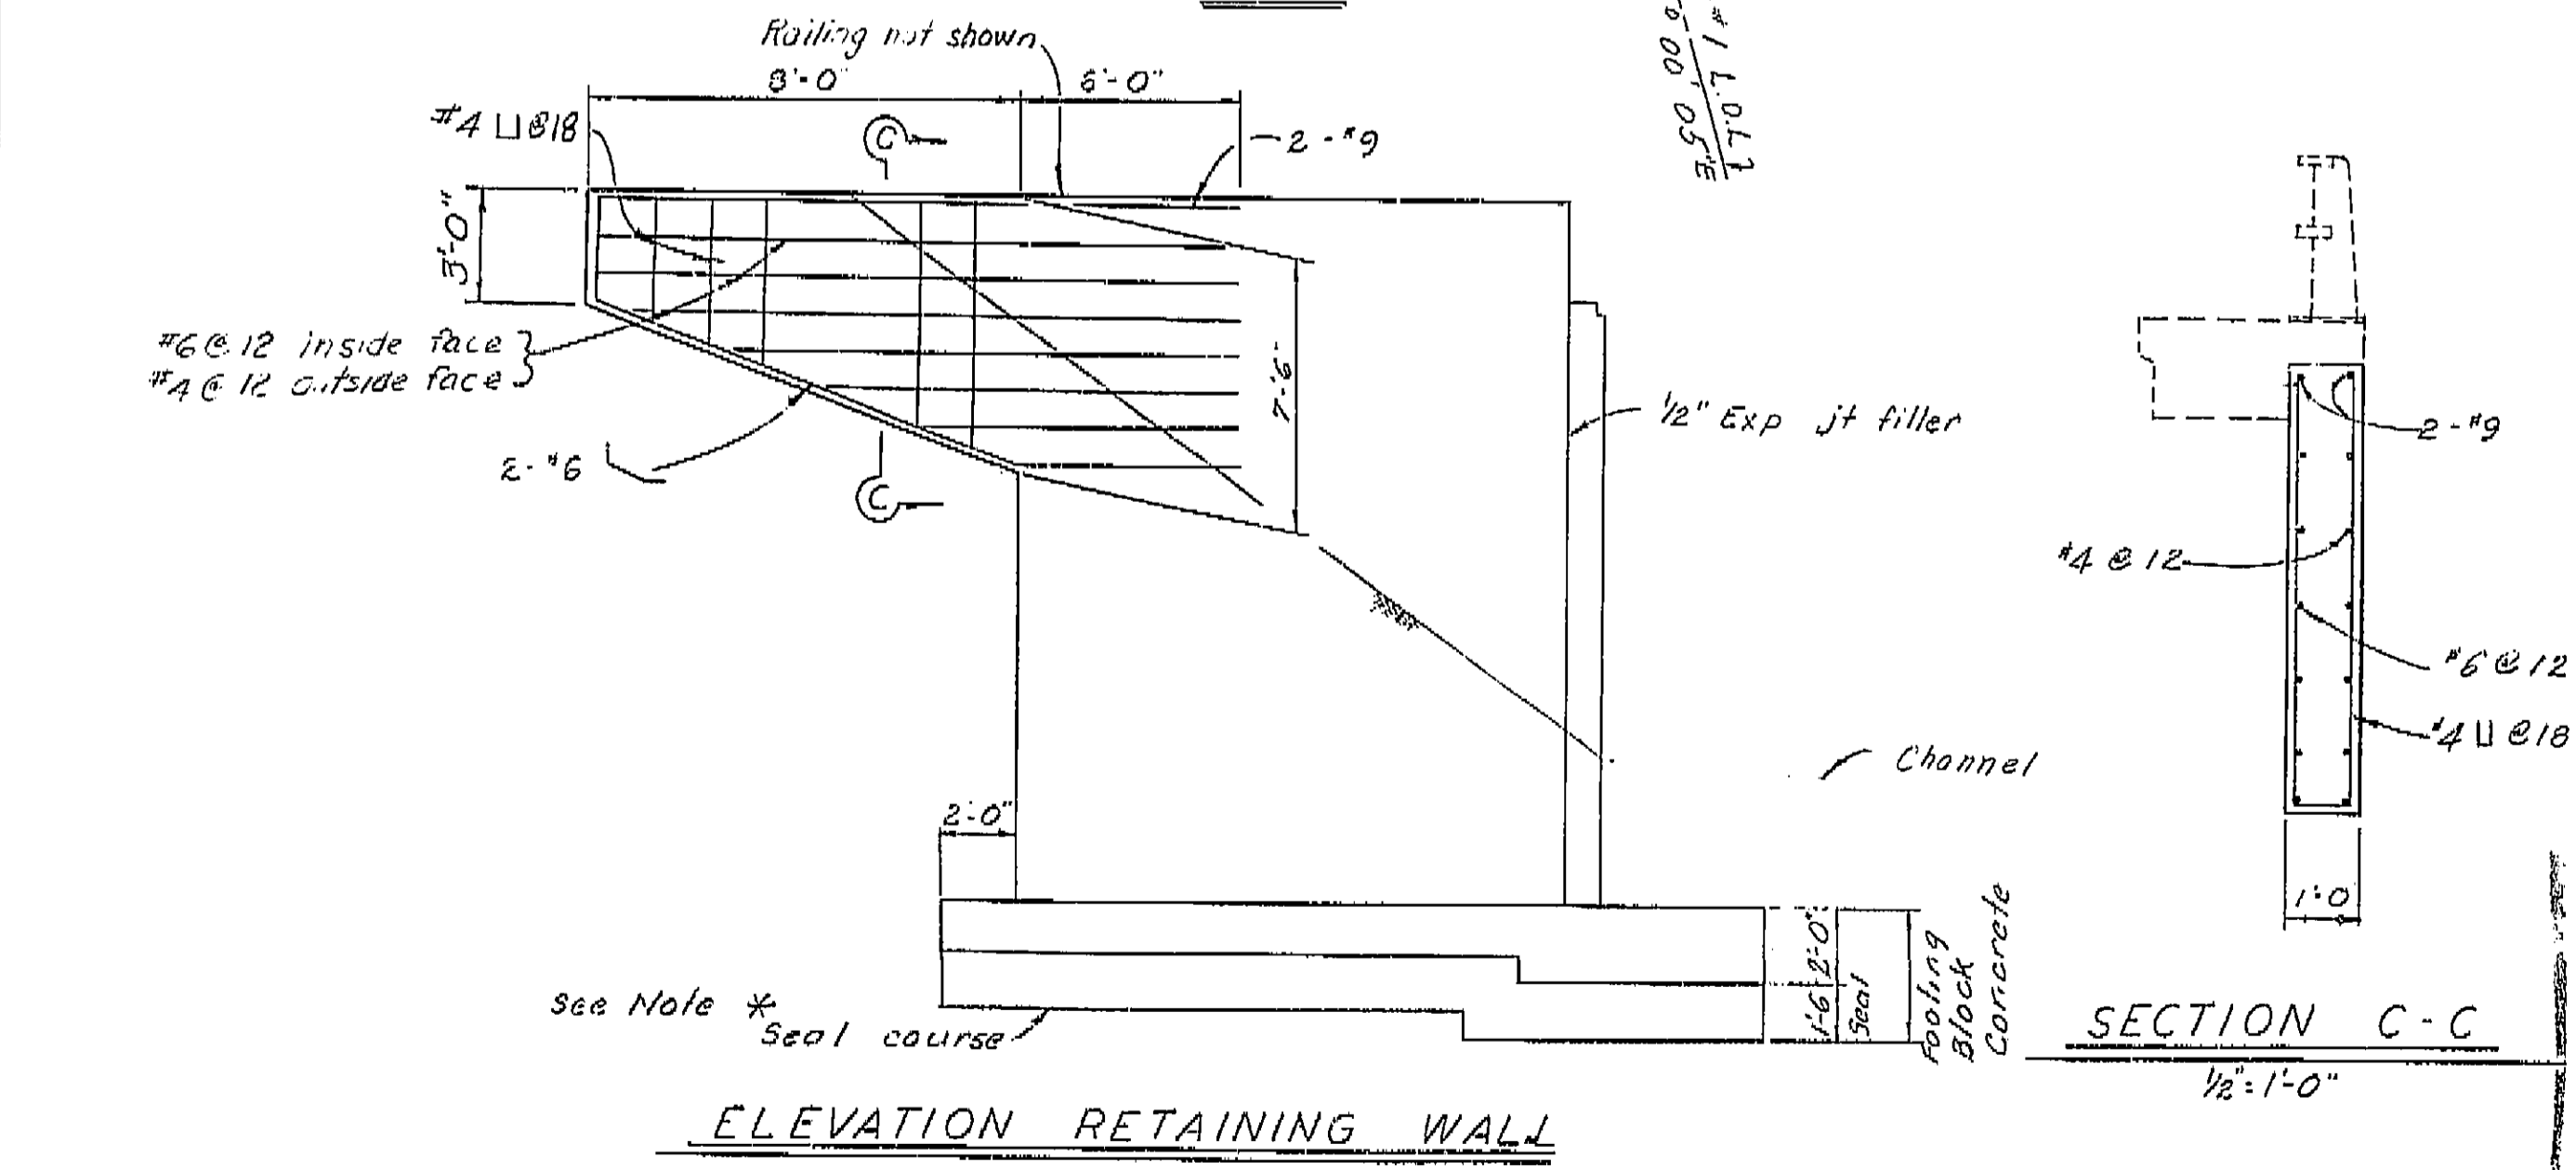

**AS BUILT**  
 L.S. Foster  
 5-13-70  
 Term 7/9/70

Note: For details not shown see "Strutted Abutment-Spread Footing" and "Type 1 Retaining Wall (H=4'-30') sheets. For utility opening see Retaining Wall Details No. 2 sheet.

\* Seal course eliminated at all footings  
 Bottom of all footings built at planned elev. of seal course

**AS BUILT PLANS**  
 Contract No. 04-102134  
 Date Completed \_\_\_\_\_  
 Document No. 40021324

BRIDGE DEPARTMENT DESIGN SECTION 12	
Section Supervisor	R.C. Casanova
DESIGN	Checked: [Signature]
DETAILS	Checked: [Signature]
QUANTITIES	Checked: [Signature]

STATE OF CALIFORNIA DEPARTMENT OF PUBLIC WORKS DIVISION OF HIGHWAYS			
DRY CREEK BRIDGES			
ABUTMENT DETAILS W2 LINE			
SCALE	1/2"=1'-0"	21C-20, 21-14R, BRIDGE 21C-21	FILE
PRELIMINARY DRAWING NO.	P-2114-	REVISION DATES	DRAWING 2114-3

WO 102131  
 CU 04204


Disregard prints bearing earlier revision dates

I HEREBY CERTIFY THAT THIS IS A TRUE AND ACCURATE COPY OF THE ABOVE DOCUMENT TAKEN UNDER MY DIRECTION AND CONTROL ON THIS DATE IN SACRAMENTO, CALIFORNIA PURSUANT TO AUTHORIZATION BY THE DIRECTOR OF PUBLIC WORKS.  
 DATE March 8, 1971 SIGNATURE [Signature] TITLE Highway Administration Officer







DESIGN SECTION 12  
 REGISTERED CIVIL ENGINEER NO. 10104  
 DATE APPROVED September 23, 1968

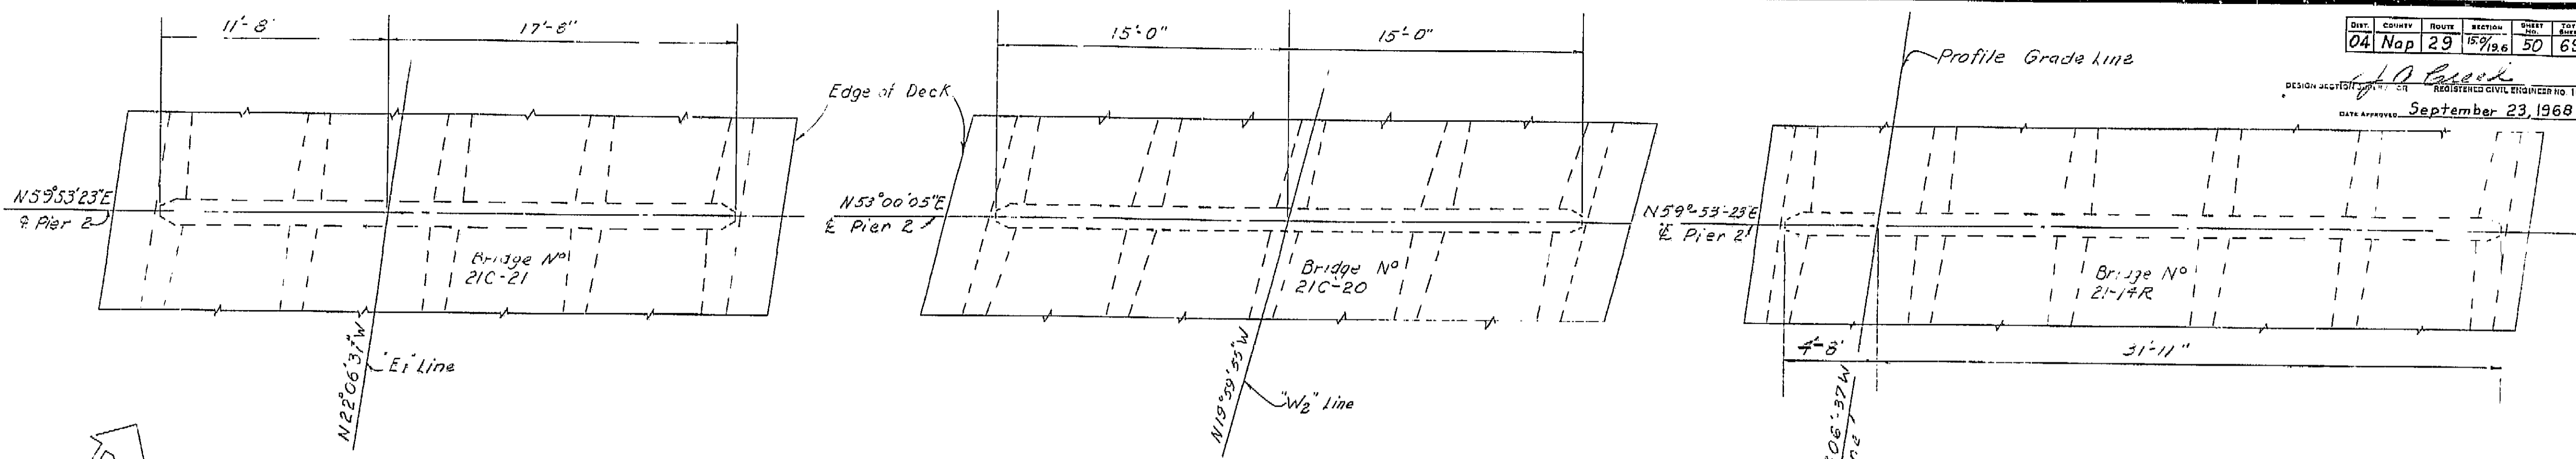


PLAN

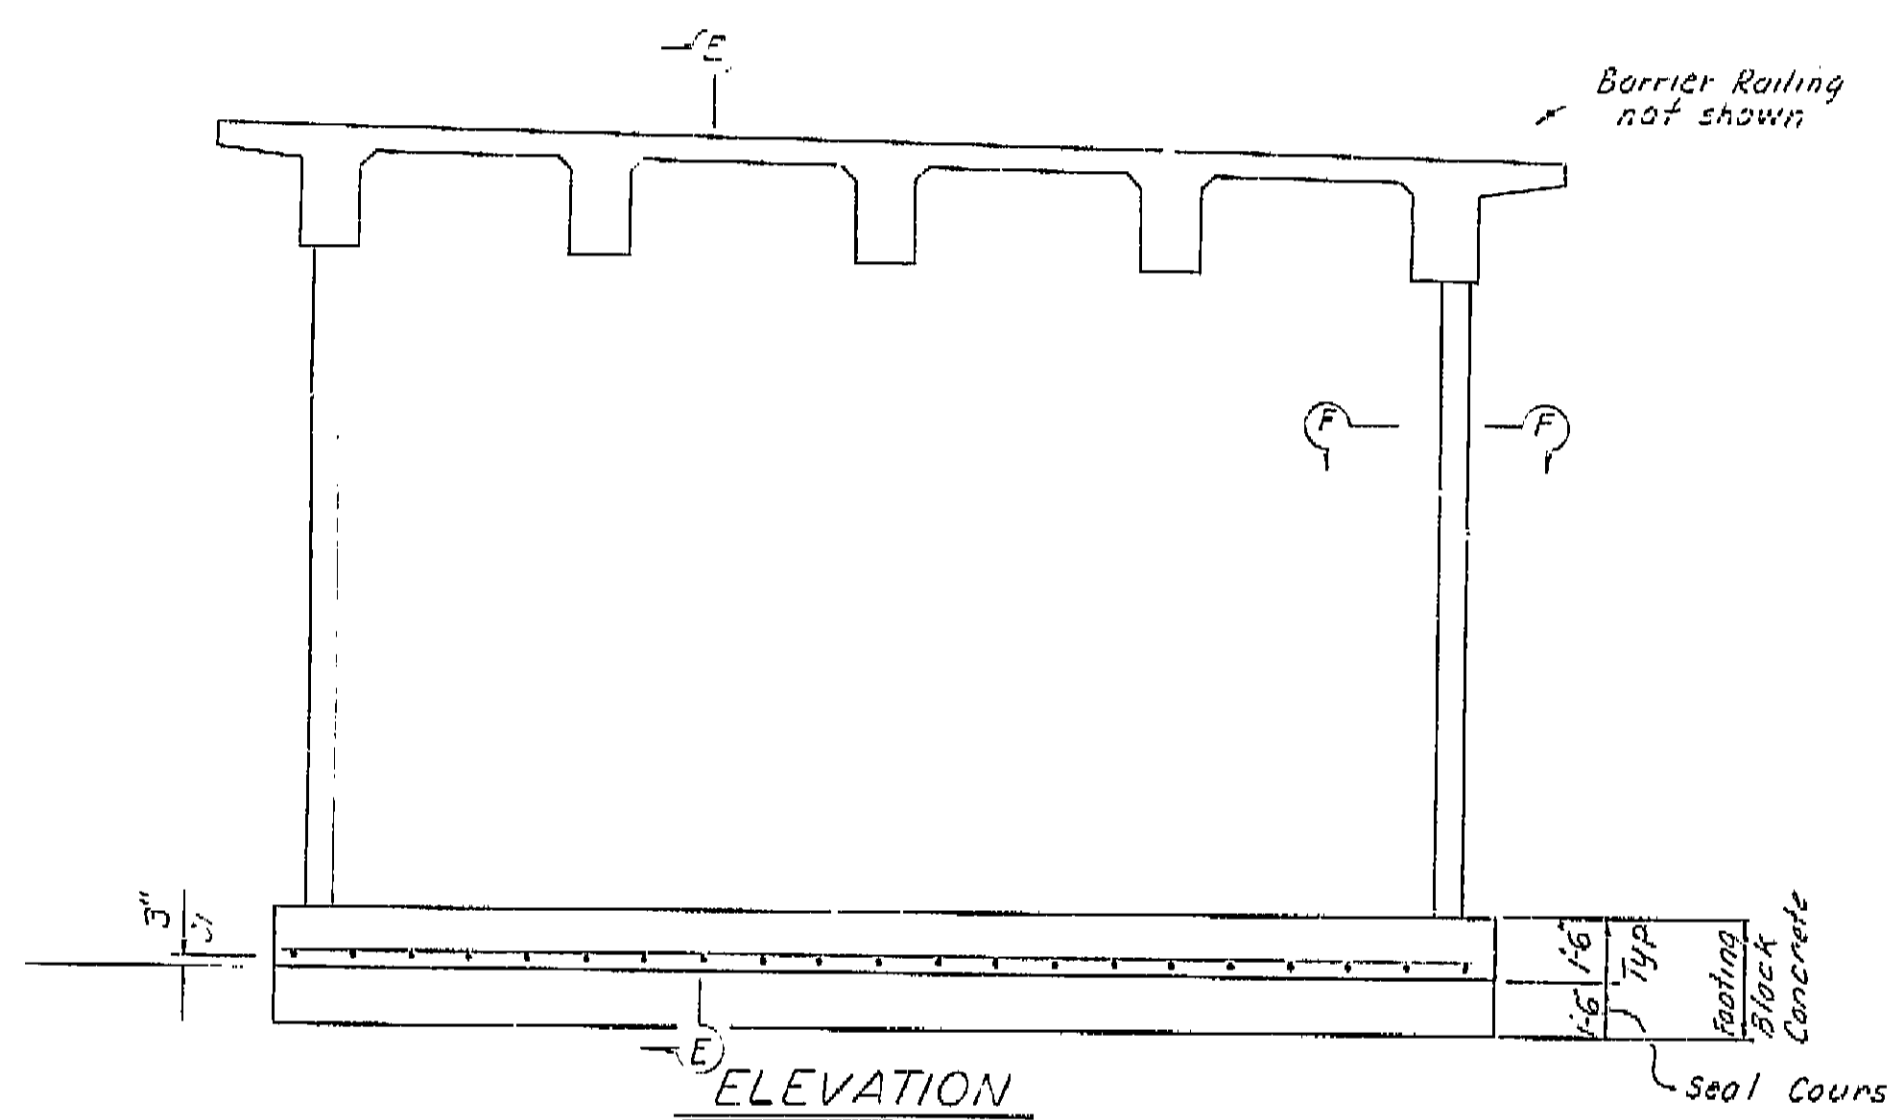


ELEVATION

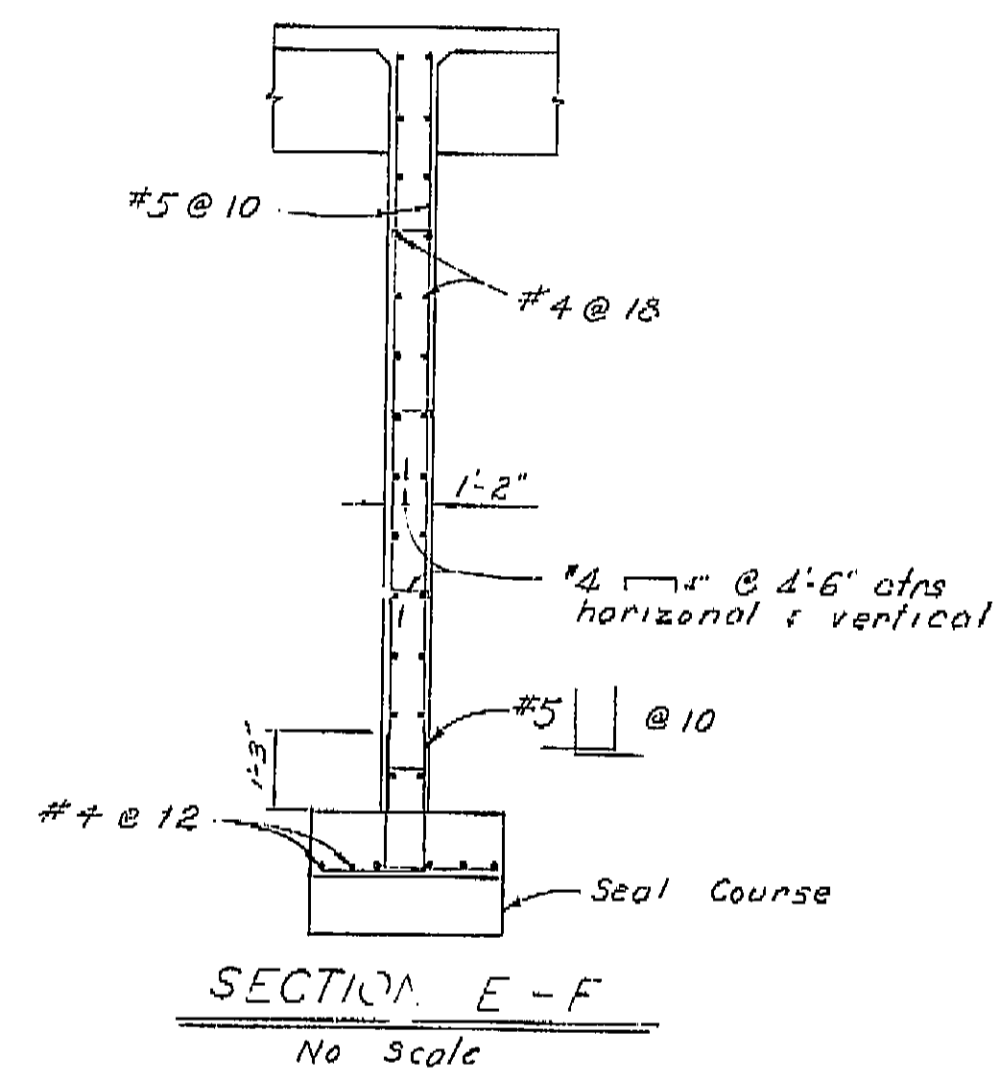

SECTION E-F  
No Scale

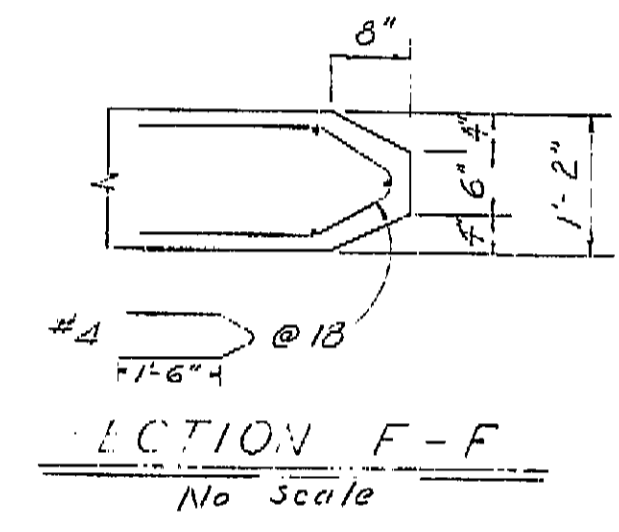

SECTION F-F  
No Scale

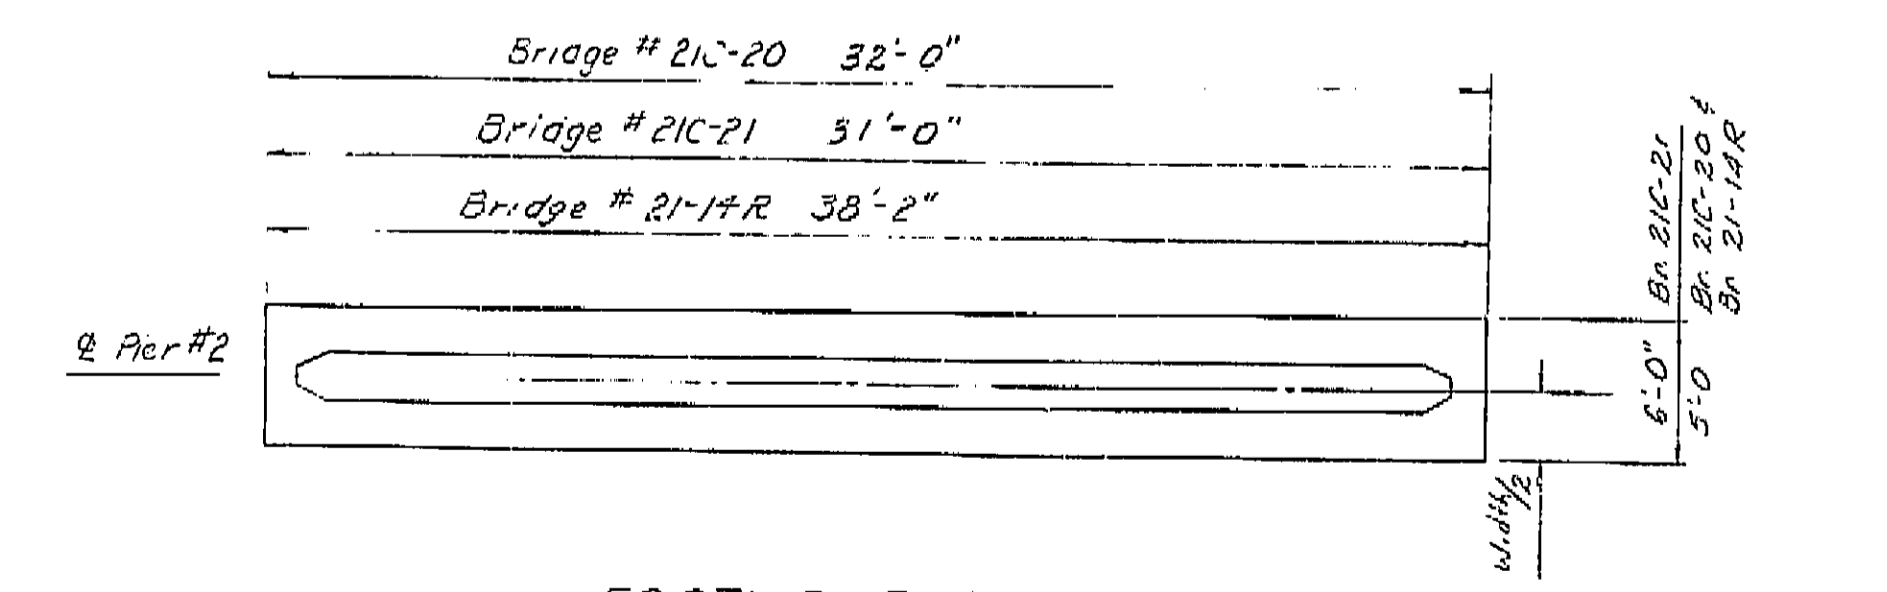

FOOTING PLAN  
No Scale

NO ADJUST CHANGES

AS BUILT

By S. Fowler  
 04-102134  
 5-13-70  
 TBM 7/9/70


**AS BUILT PLANS**  
 Contract No. 04-102134  
 Date Completed \_\_\_\_\_  
 Document No. 40001324

BRIDGE DEPARTMENT DESIGN SECTION 12	
Section Supervisor	<i>N. C. Cassano</i>
DESIGN	By <i>Ernest J. Jankovic</i>
DETAILS	By <i>Ernest J. Jankovic</i>
QUANTITIES	By <i>Ernest J. Jankovic</i>


STATE OF CALIFORNIA DEPARTMENT OF PUBLIC WORKS DIVISION OF HIGHWAYS	
DRY CREEK BRIDGES	
PIER DETAILS	
SCALE or as noted	FILE
PRELIMINARY DRAWING No. P-211A	REVISION DATES

I HEREBY CERTIFY THAT THIS IS A TRUE AND ACCURATE COPY OF THE ABOVE DOCUMENT TAKEN UNDER MY DIRECTION AND CONTROL ON THIS DATE IN SACRAMENTO, CALIFORNIA PURSUANT TO AUTHORIZATION BY THE DIRECTOR OF PUBLIC WORKS.  
 DATE March 8, 1971 SIGNATURE [Signature] TITLE Highways Administration Officer




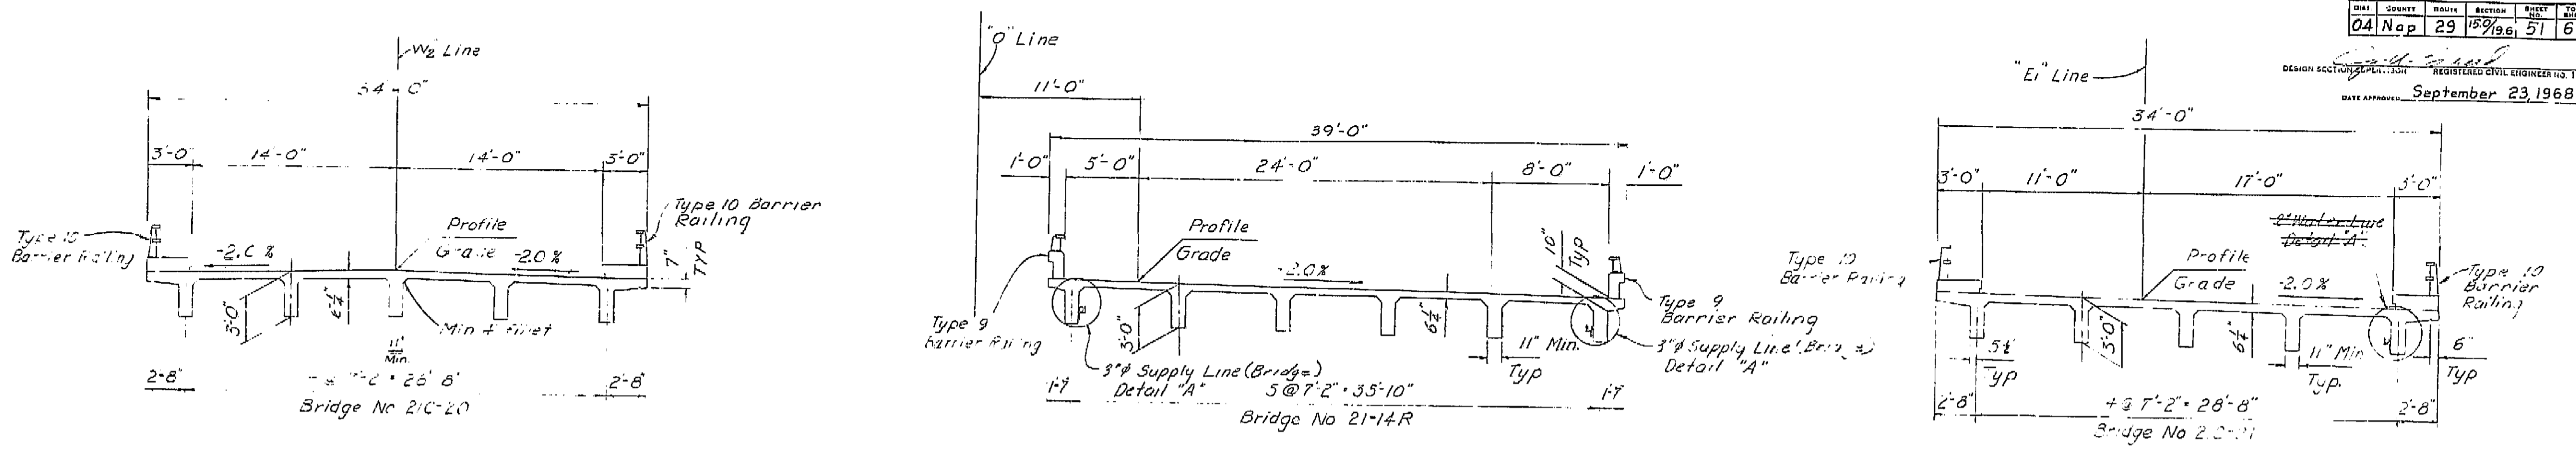


TYPICAL SECTION  
Scale: 3/8" = 1'-0"

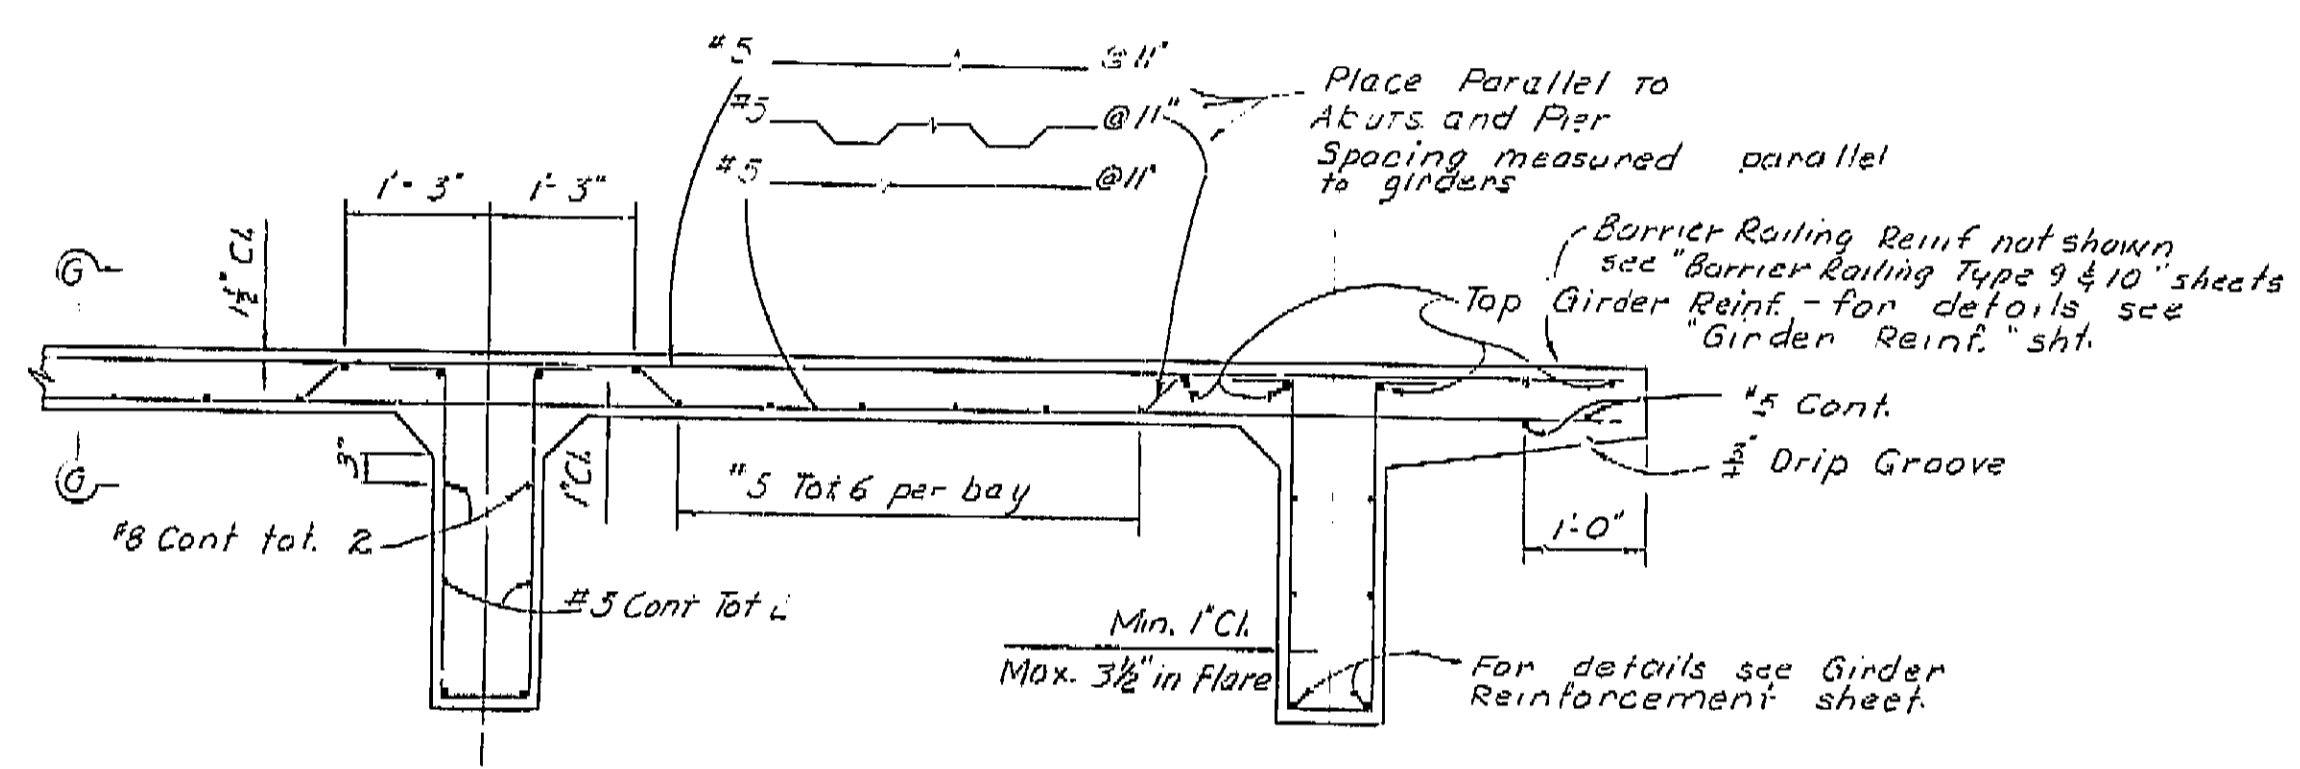

PART SECTION  
Scale: 3/8" = 1'-0"

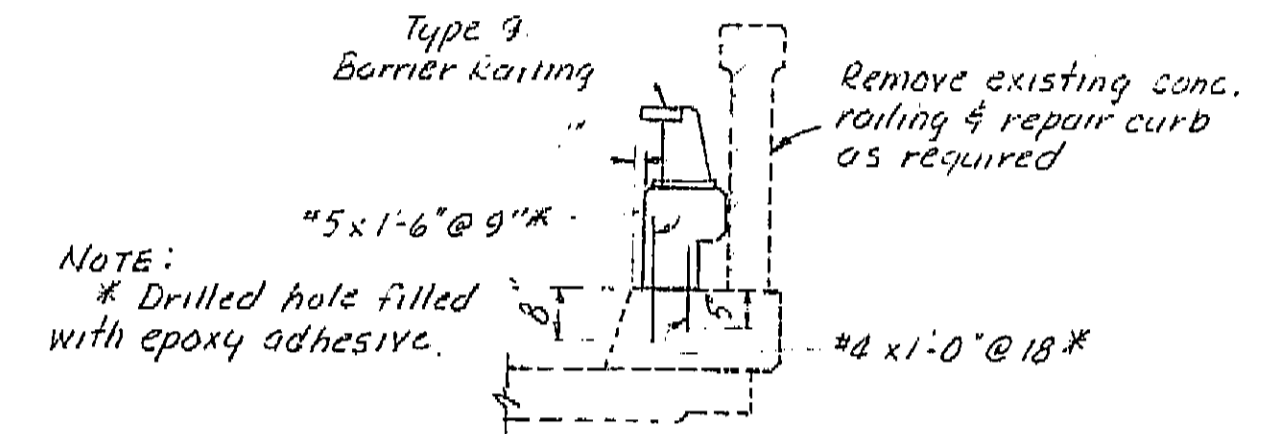

RAILING REPLACEMENT FOR EXISTING BR. NO. 21-14  
(Typical)

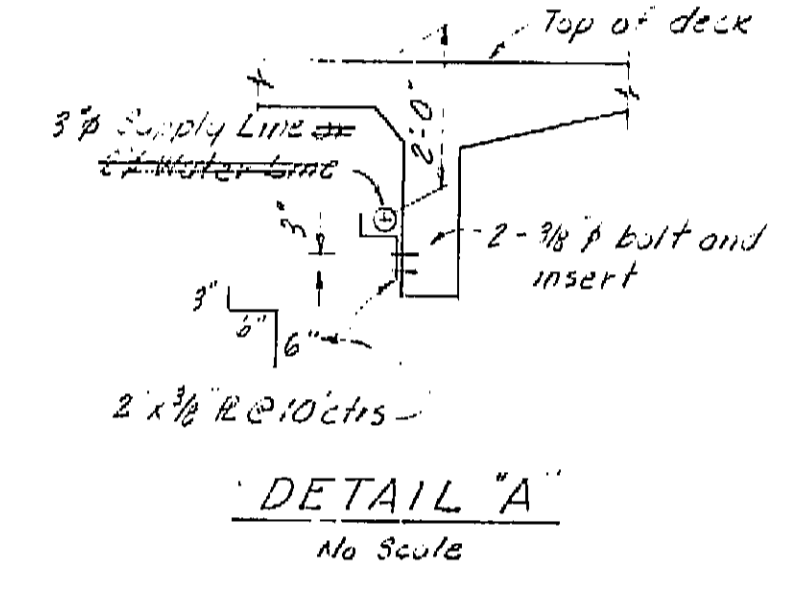

DETAIL "A"  
No Scale


TEE-BEAM SUPERSTRUCTURE PLACING DIAGRAM

NUMBERS (1) AND (2) INDICATE SEQUENCE OF PLACING GIRDER STEM CONCRETE. (2) MAY BE PLACED SIMULTANEOUSLY WITH (1) WHEN APPROVED BY THE ENGINEER, AND PROVIDED THAT THE (1) SECTIONS ARE PLACED IN ADJOINING SPANS.  
TOP SLAB CONCRETE (3) MAY BE PLACED SEPARATELY FROM (1) AND (2). (3) MAY BE PLACED CONTINUOUSLY OR IN PARTS AS APPROVED BY THE ENGINEER, HOWEVER THE ONLY JOINTS PERMITTED SHALL BE LOCATED WITHIN 2'-0" OF THE GIRDER JOINTS BETWEEN (1) AND (2).  
U = 1/4 SPAN LENGTH

FOR ANY DEVIATION FROM THE ABOVE THE CONTRACTOR SHALL SUBMIT A DIAGRAM TO THE ENGINEER.

THIS DETAIL DOES NOT APPLY

AS BUILT PLANS  
Contract No. 04-102134  
Date Completed  
Document No. 40001324

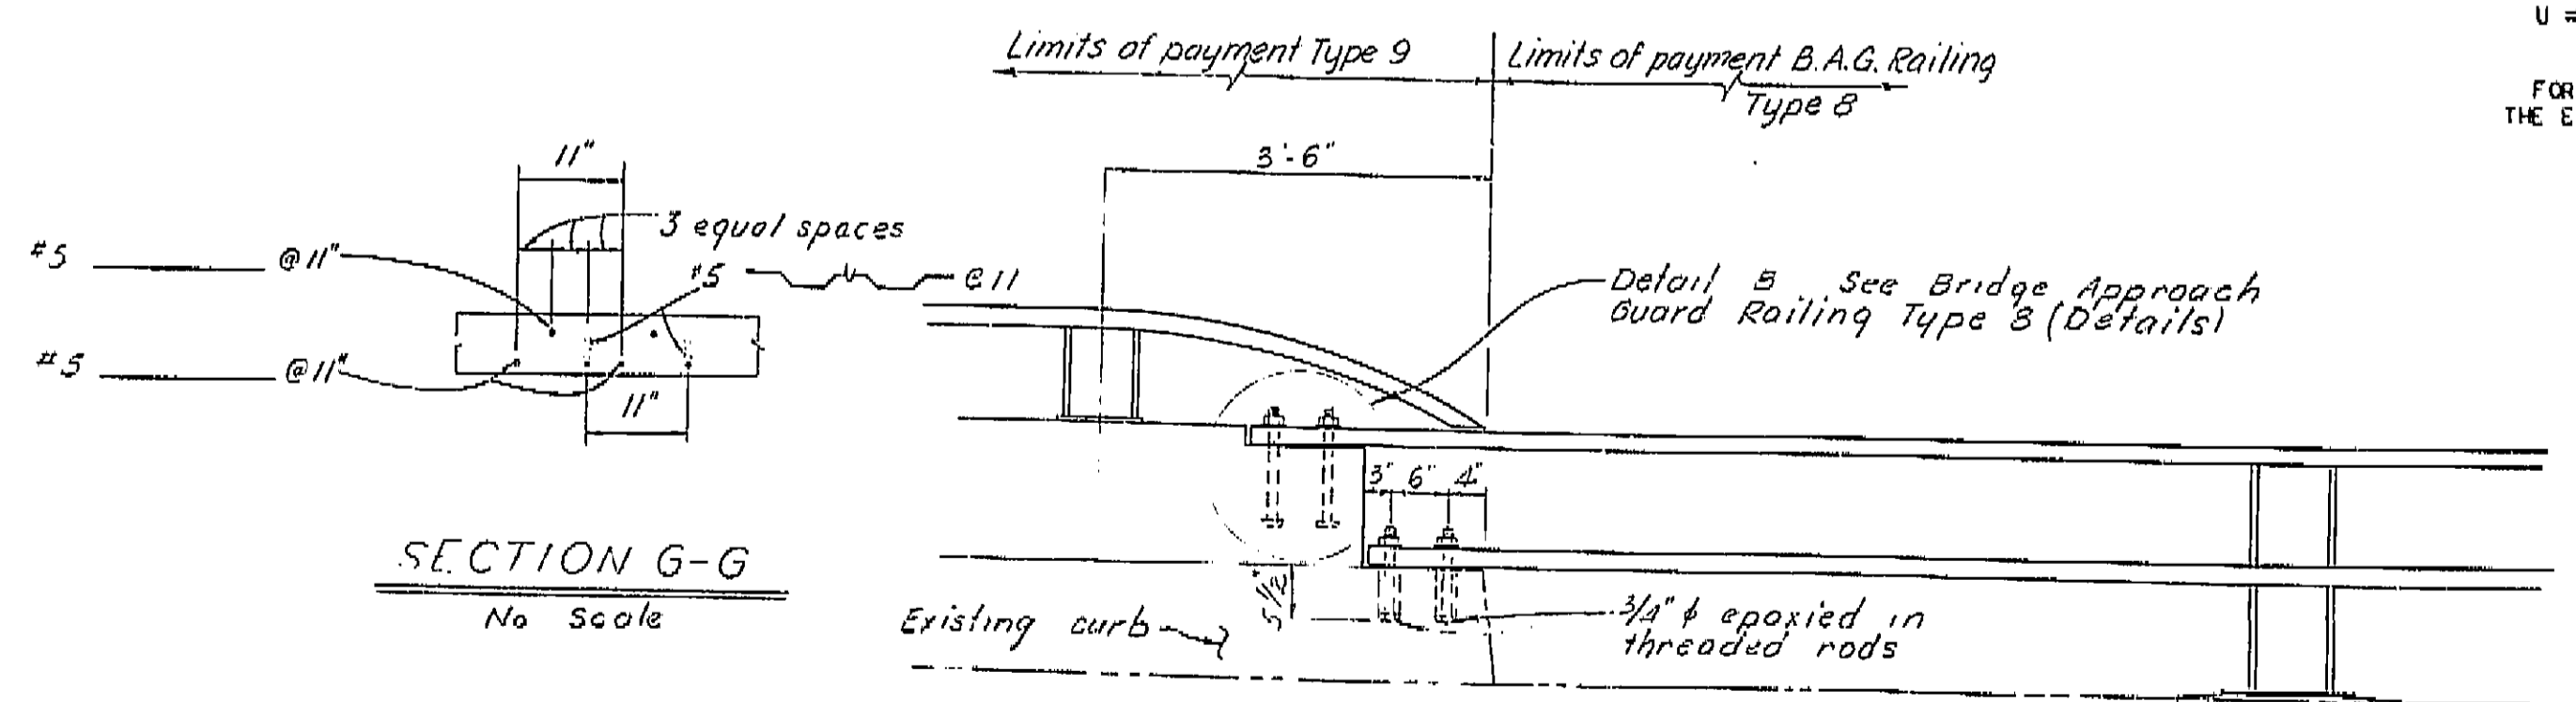

SECTION G-G  
No Scale

CONNECT TYPE 9 TO B.A.G. RAILING TYPE 8  
EXISTING BR. NO. 21-14

BRIDGE DEPARTMENT	
DESIGN SECTION 12	
Section Supervisor	<i>R.C. Casanova</i>
DESIGN	By <i>Samuel J. ...</i>
DETAILS	By <i>Samuel J. ...</i>
QUANTITIES	By <i>Samuel J. ...</i>

STATE OF CALIFORNIA DEPARTMENT OF PUBLIC WORKS DIVISION OF HIGHWAYS	
CRY CREEK BRIDGES	
TYPICAL SECTION	
SCALE As Noted	BRIDGE 21C-20, 21-14R, 21C-21
FILE	DRAWING 2114-6

WO 102131  
CU 04204


Disregard prints bearing earlier revision dates

PRELIMINARY DRAWING No.	P-2114
REVISION DATES	


I HEREBY CERTIFY THAT THIS IS A TRUE AND ACCURATE COPY OF THE ABOVE DOCUMENT TAKEN UNDER MY DIRECTION AND CONTROL ON THIS DATE IN SACRAMENTO, CALIFORNIA PURSUANT TO AUTHORIZATION BY THE DIRECTOR OF PUBLIC WORKS.  
DATE March 8, 1971 SIGNATURE *David S. ...* TITLE Highway Administrator




DESIGN SECTION DIVISION REGISTERED CIVIL ENGINEER NO. 10304  
 DATE APPROVED: September 23, 1968

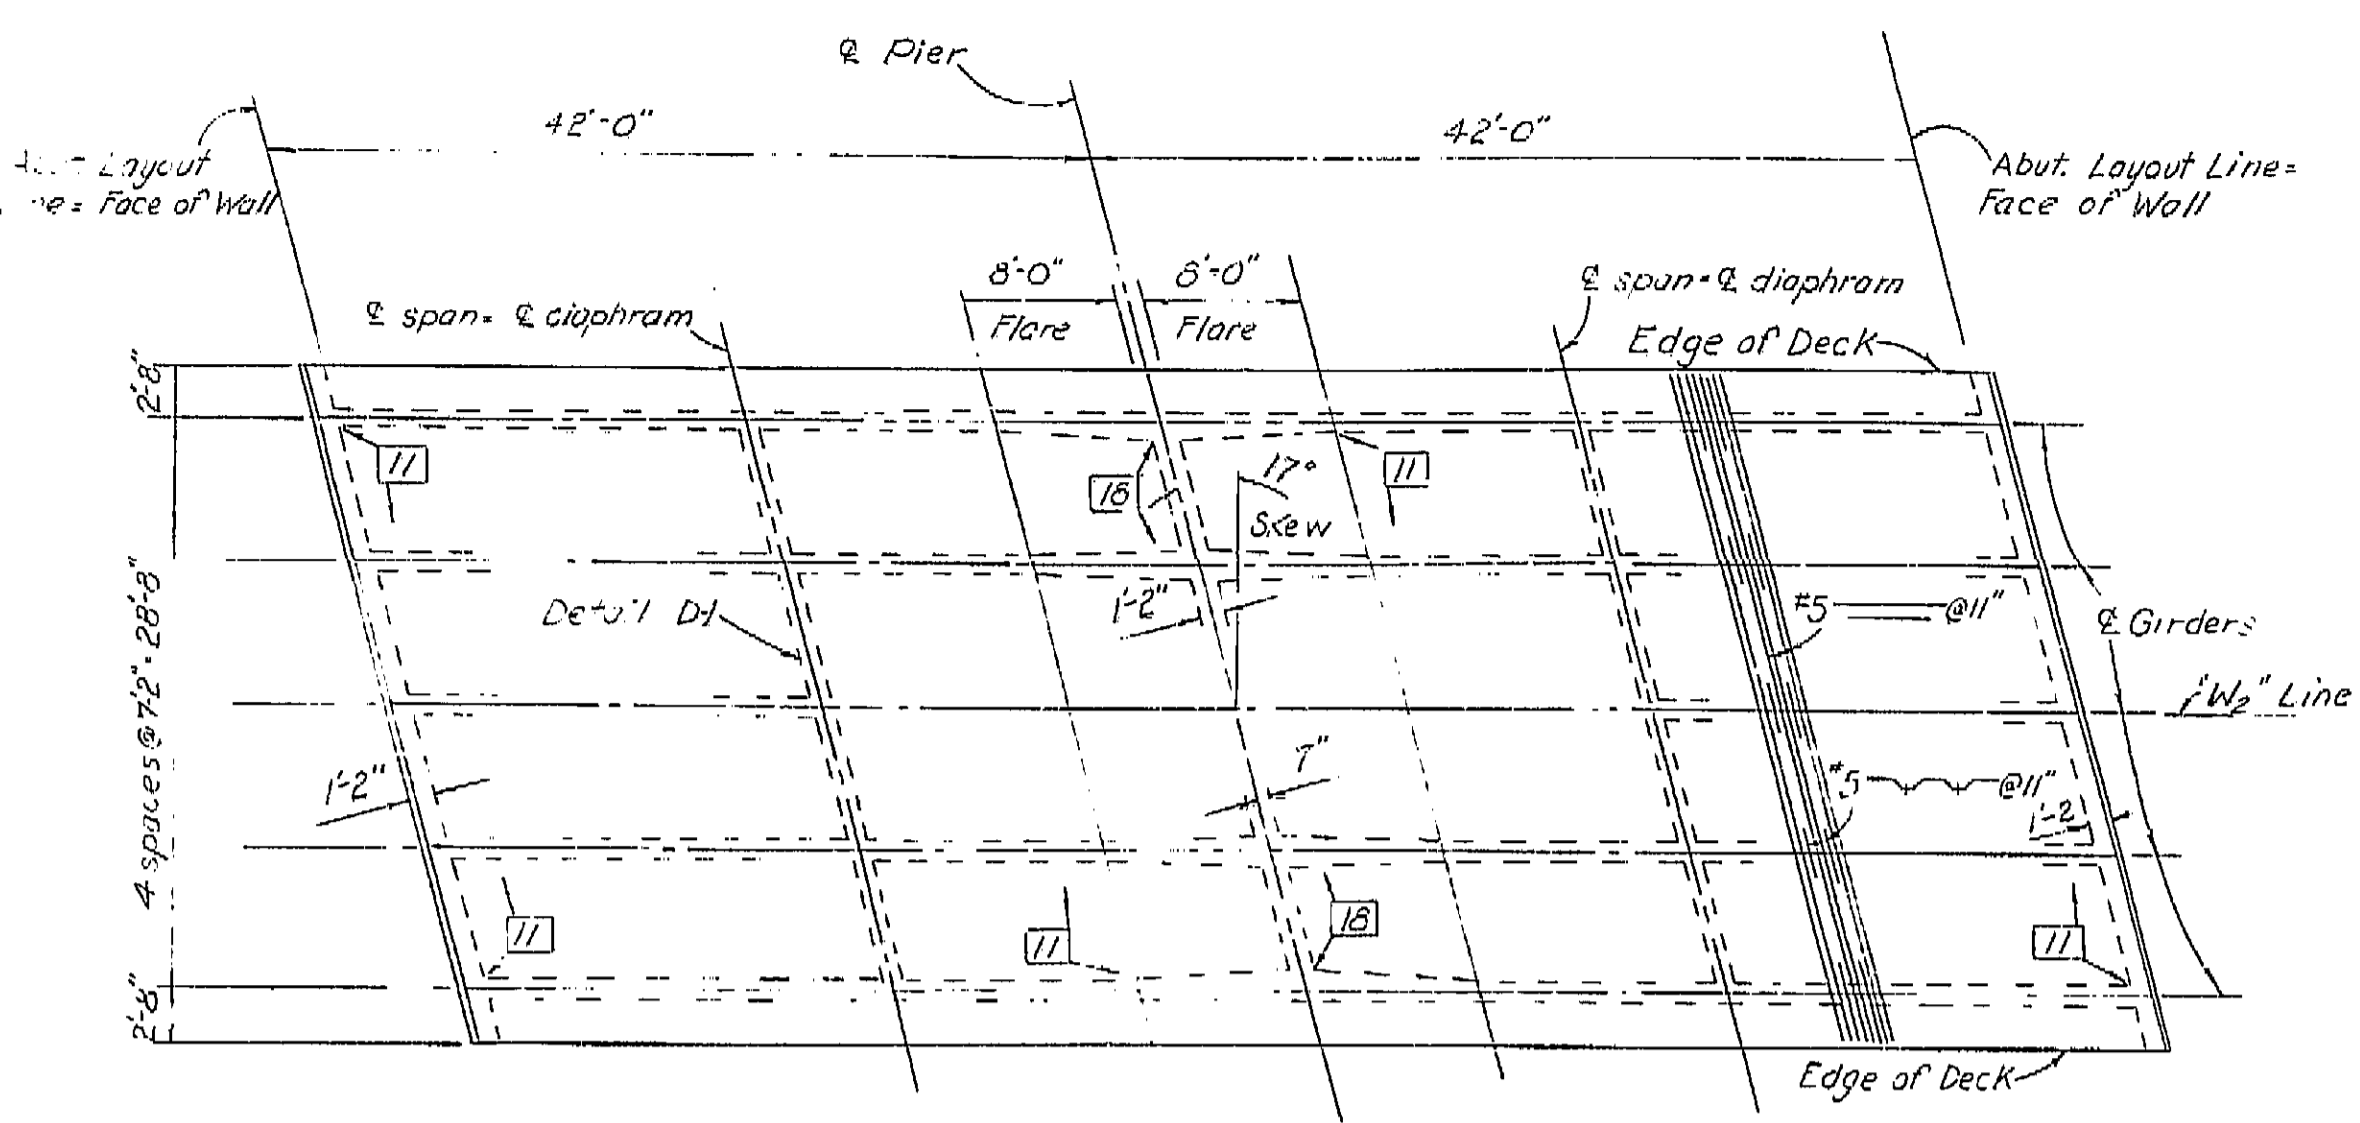


PLAN  
 3/8" = 1'-0"  
 Bridge No. 21C-20

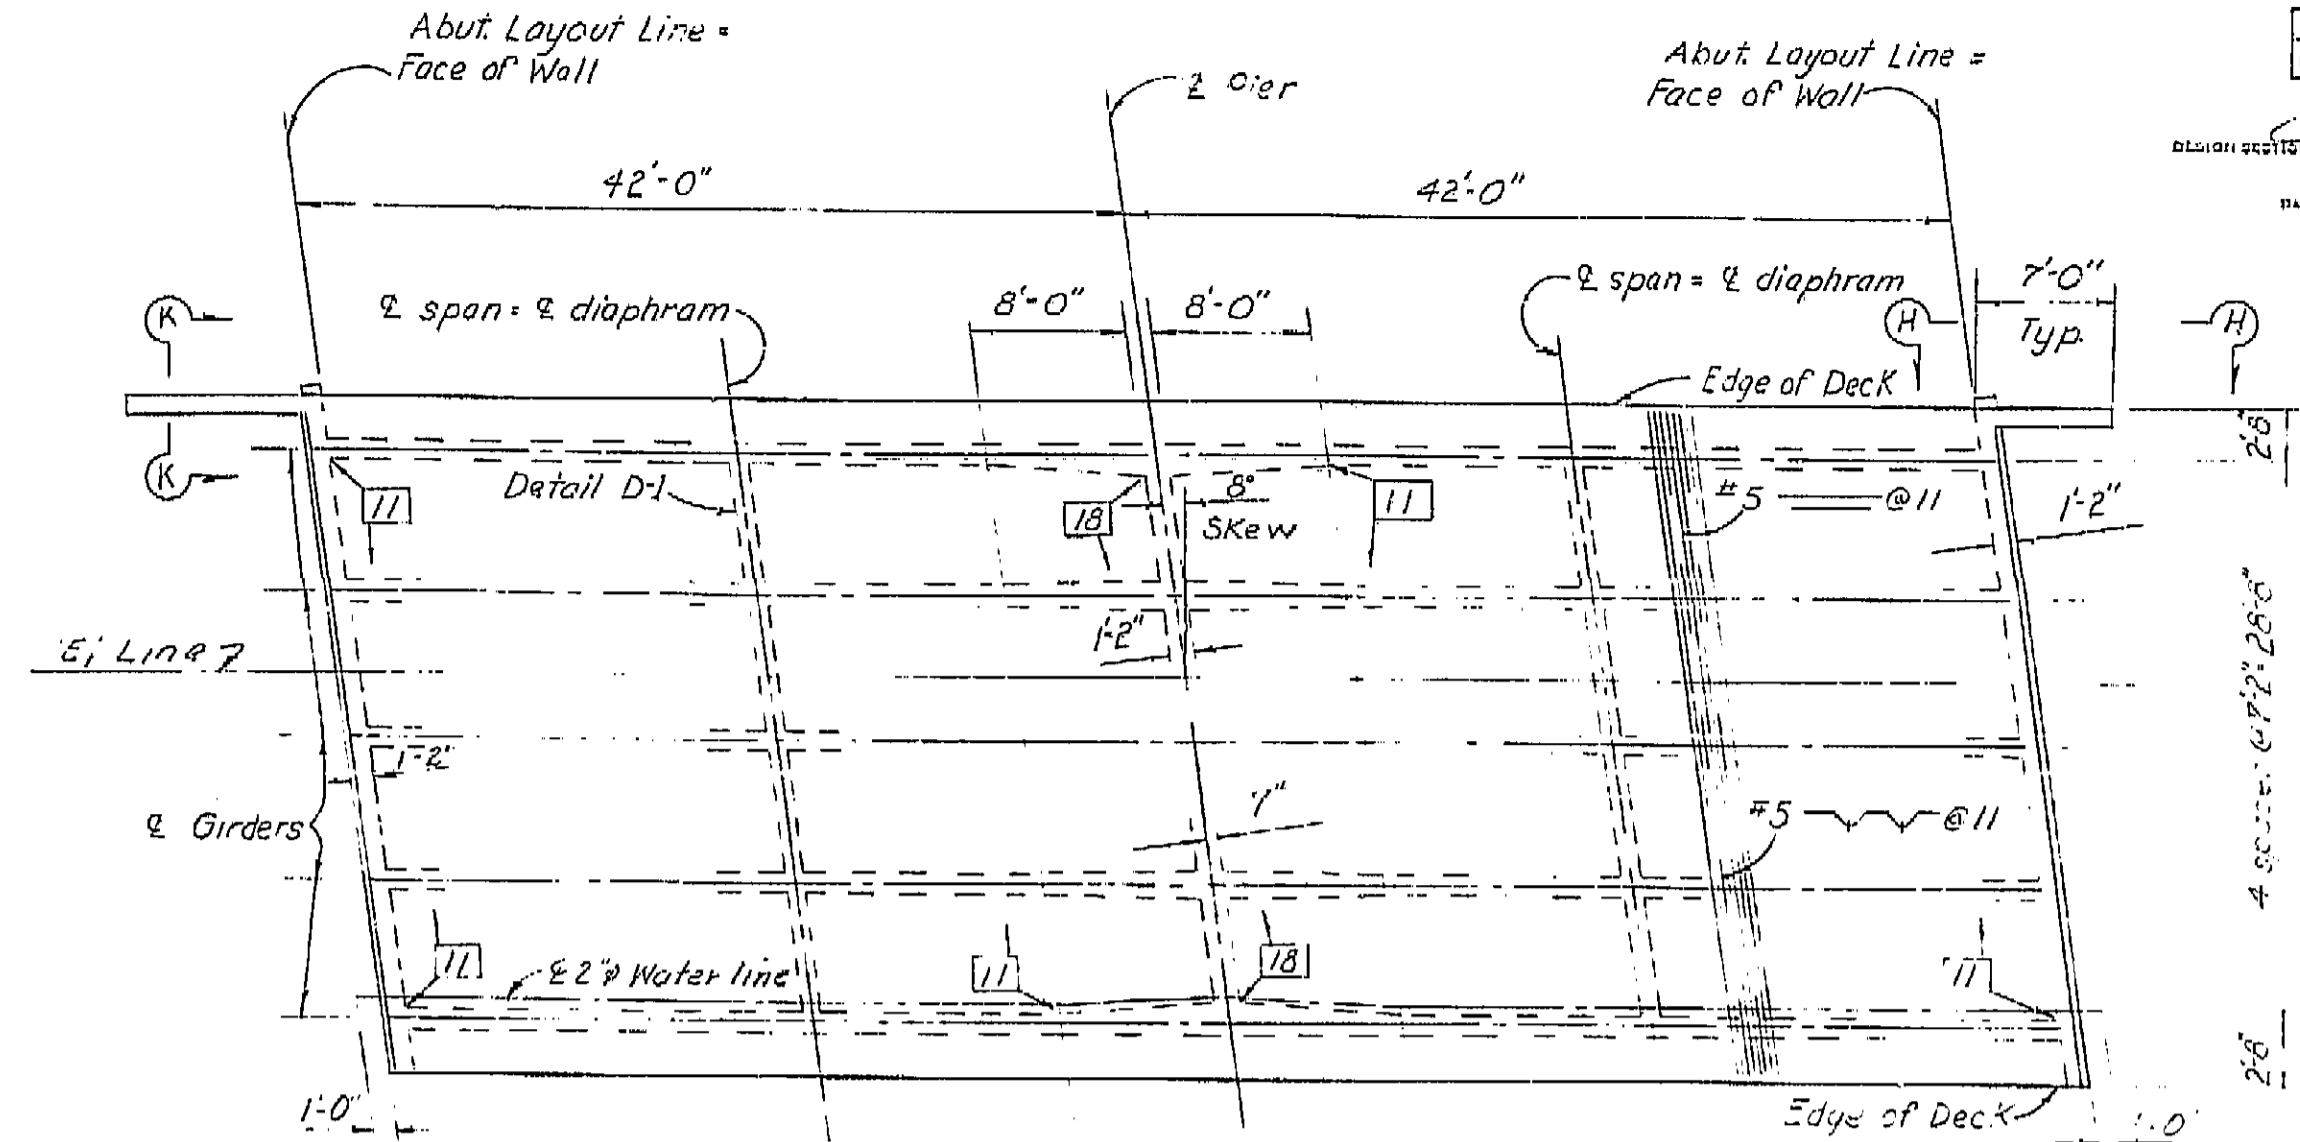


PLAN  
 3/8" = 1'-0"  
 Bridge No. 21C-21

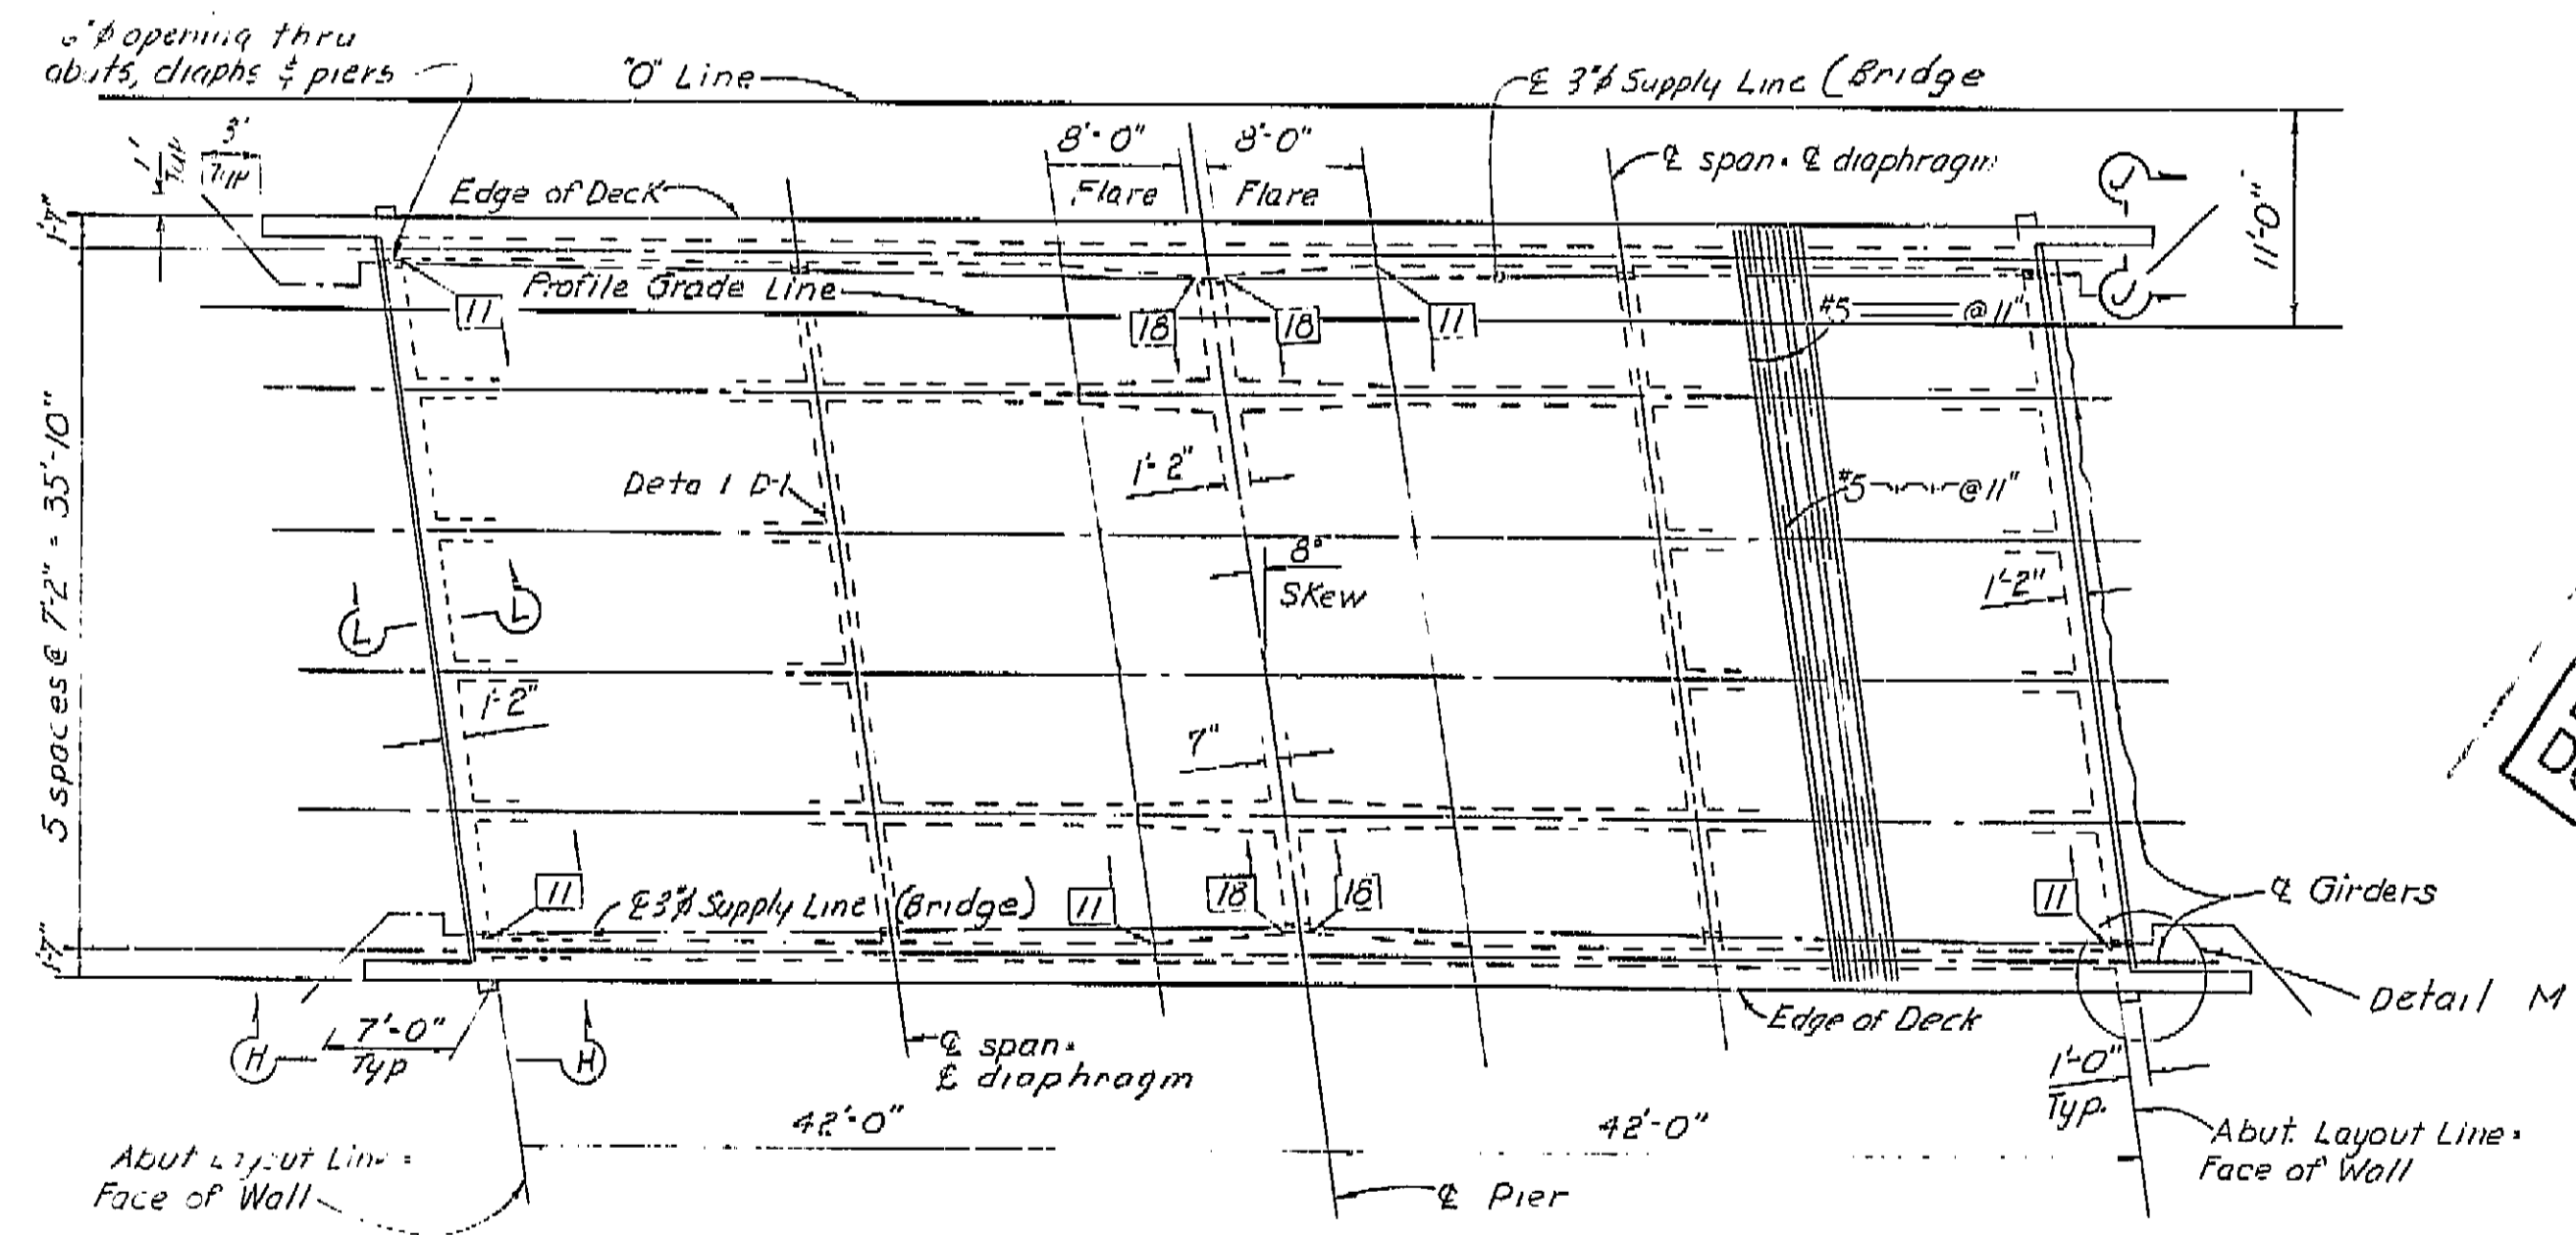


PLAN  
 3/8" = 1'-0"  
 Bridge No. 21-14R

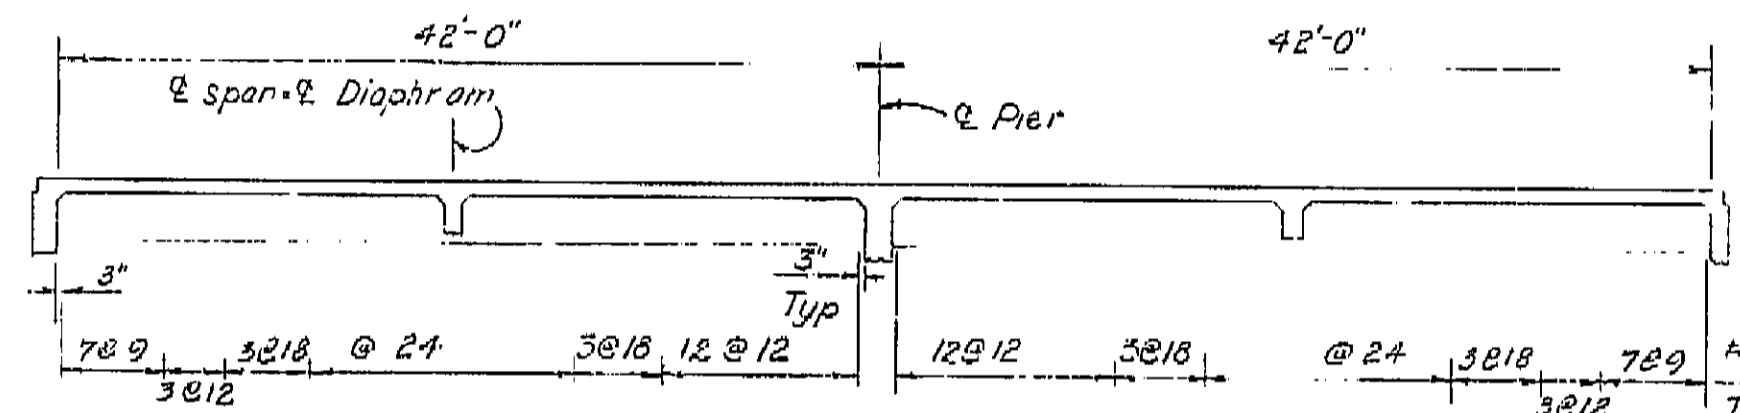

LONGITUDINAL SECTION

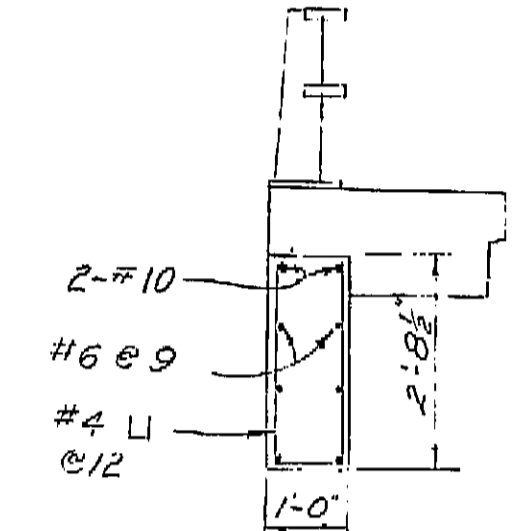

SECTION K-K  
 No Scale

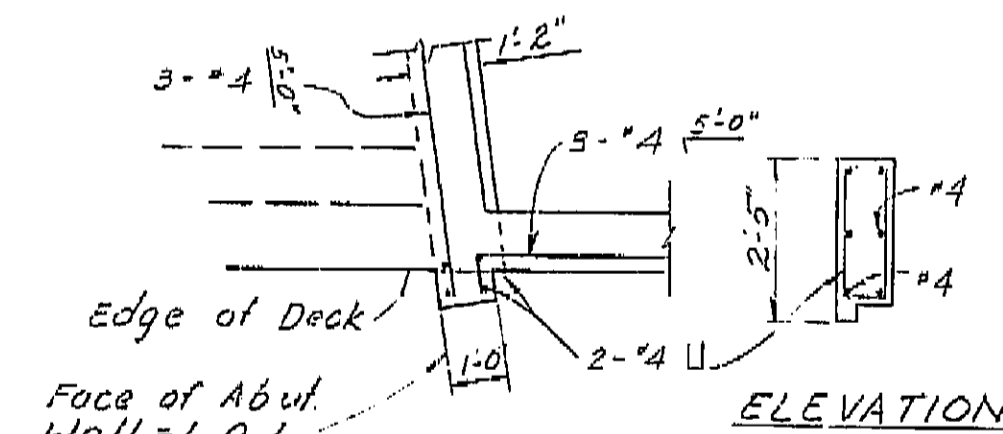


ELEVATION


**AS BUILT PLANS**  
 Contract No. 04-102134  
 Date Completed  
 Document No. 40001324

NO AS BUILT CHANGES

**AS BUILT**  
 REVISIONS BY L.S. Foster  
 CONTRACT NO. 04-102134  
 5-13-70  
 -gjm 7/9/70

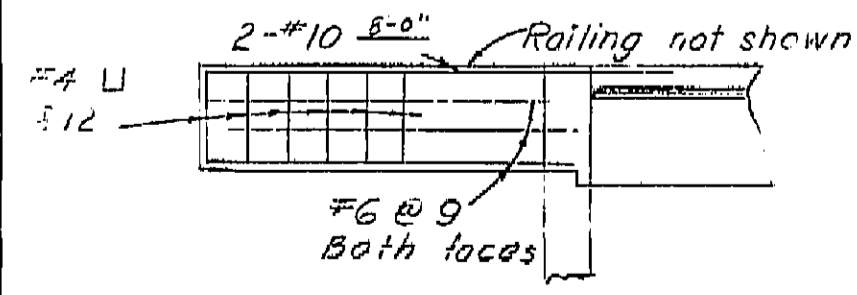

VIEW H-H  
 No Scale

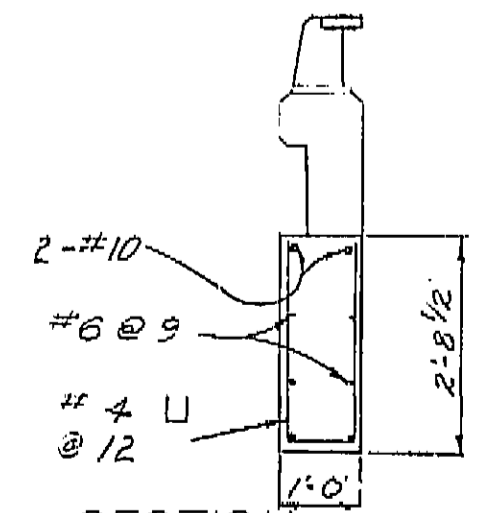

SECTION J-J  
 No Scale


Note: For Section L-L refer to Girder Reinforcement sheet

BRIDGE DEPARTMENT	
<b>DESIGN SECTION 12</b>	
Section Supervisor	<i>R.C. Cassaday</i>
DESIGN	Checked by <i>Robert G. ...</i>
DETAILS	Checked by <i>...</i>
QUANTITIES	Checked by <i>...</i>

STATE OF CALIFORNIA DEPARTMENT OF PUBLIC WORKS DIVISION OF HIGHWAYS	
DRY CREEK BRIDGES	
GIRDER LAYOUT	
SCALE As Noted	21C-20, 21-14R, BRIDGE 21C-21
FILE	DRAWING 2114-7
PRELIMINARY DRAWING NO.	P-2114-
REVISION DATES	


I HEREBY CERTIFY THAT THIS IS A TRUE AND ACCURATE COPY OF THE ABOVE DOCUMENT TAKEN UNDER MY DIRECTION AND CONTROL ON THIS DATE IN SACRAMENTO, CALIFORNIA PURSUANT TO AUTHORIZATION BY THE DIRECTOR OF PUBLIC WORKS.  
 DATE March 8, 1971 SIGNATURE *Ward E. ...* TITLE Highway Administrator

REGISTERED CIVIL ENGINEER NO. 19104  
 DATE APPROVED: September 23, 1968

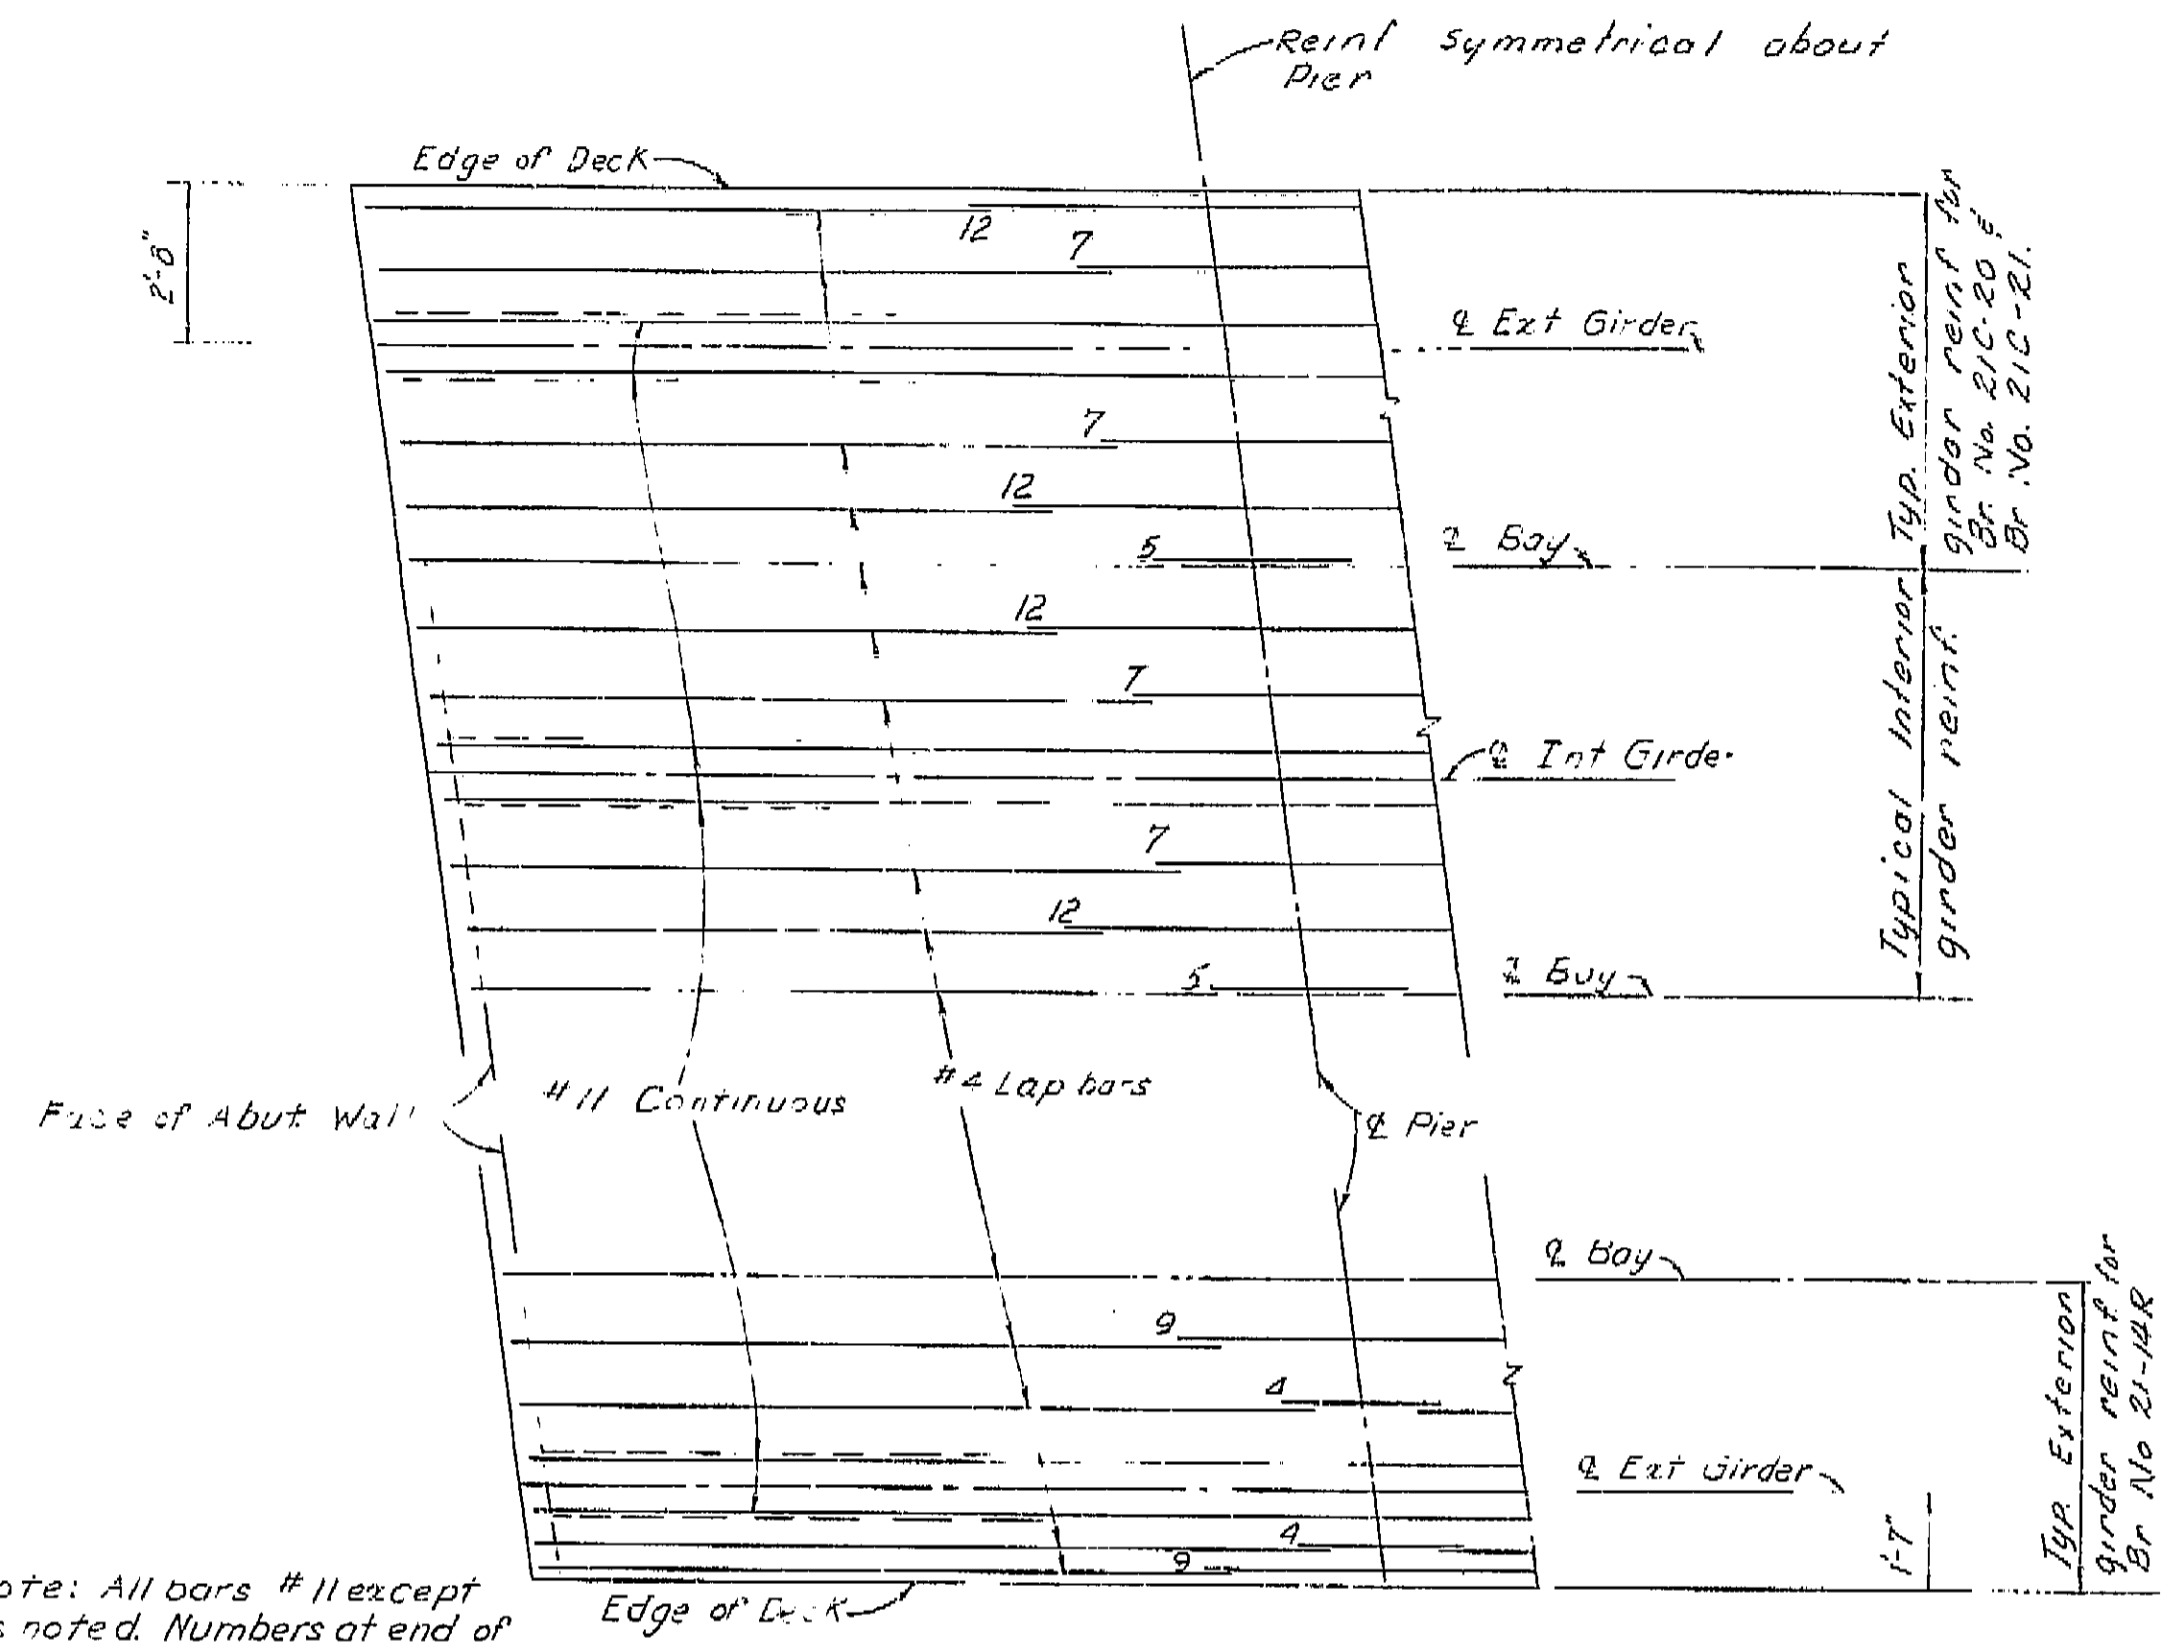

Note: All bars #11 except as noted. Numbers at end of bars indicate distance in feet from 2 Pier.


TOP REINFORCEMENT  
 Scale: None

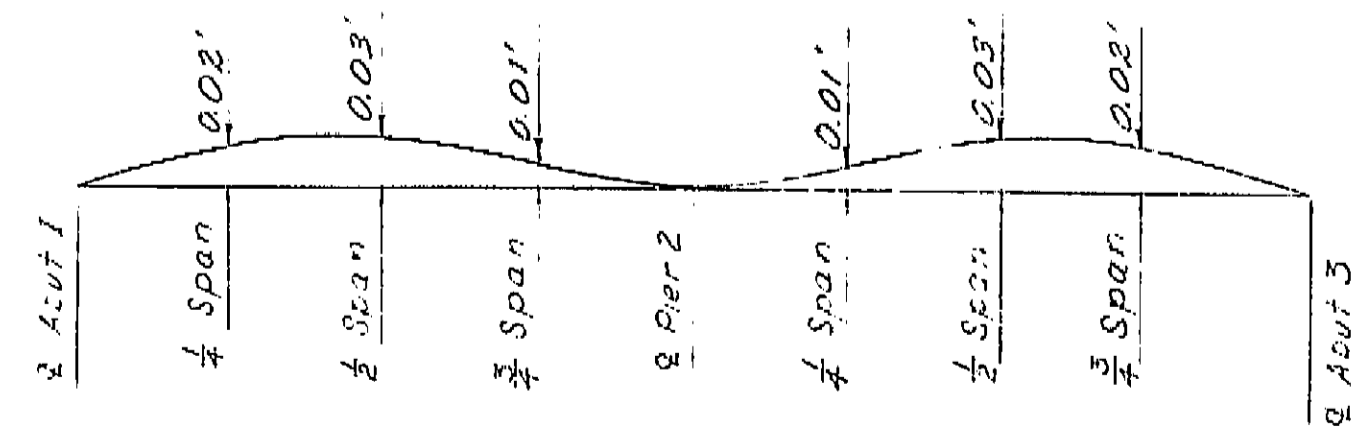


CAMBER DIAGRAM  
 Scale: None  
 Total girder deflection due to dead loads

**AS BUILT PLANS**  
 Contract No. 04-102134  
 Date Completed \_\_\_\_\_  
 Document No. 40001324


Note:  
 The total deflection will be reached about four years after falsework removal. For values at time of falsework removal, divide those shown by 4.  
 The amount of camber for construction will be determined by the Engineer.

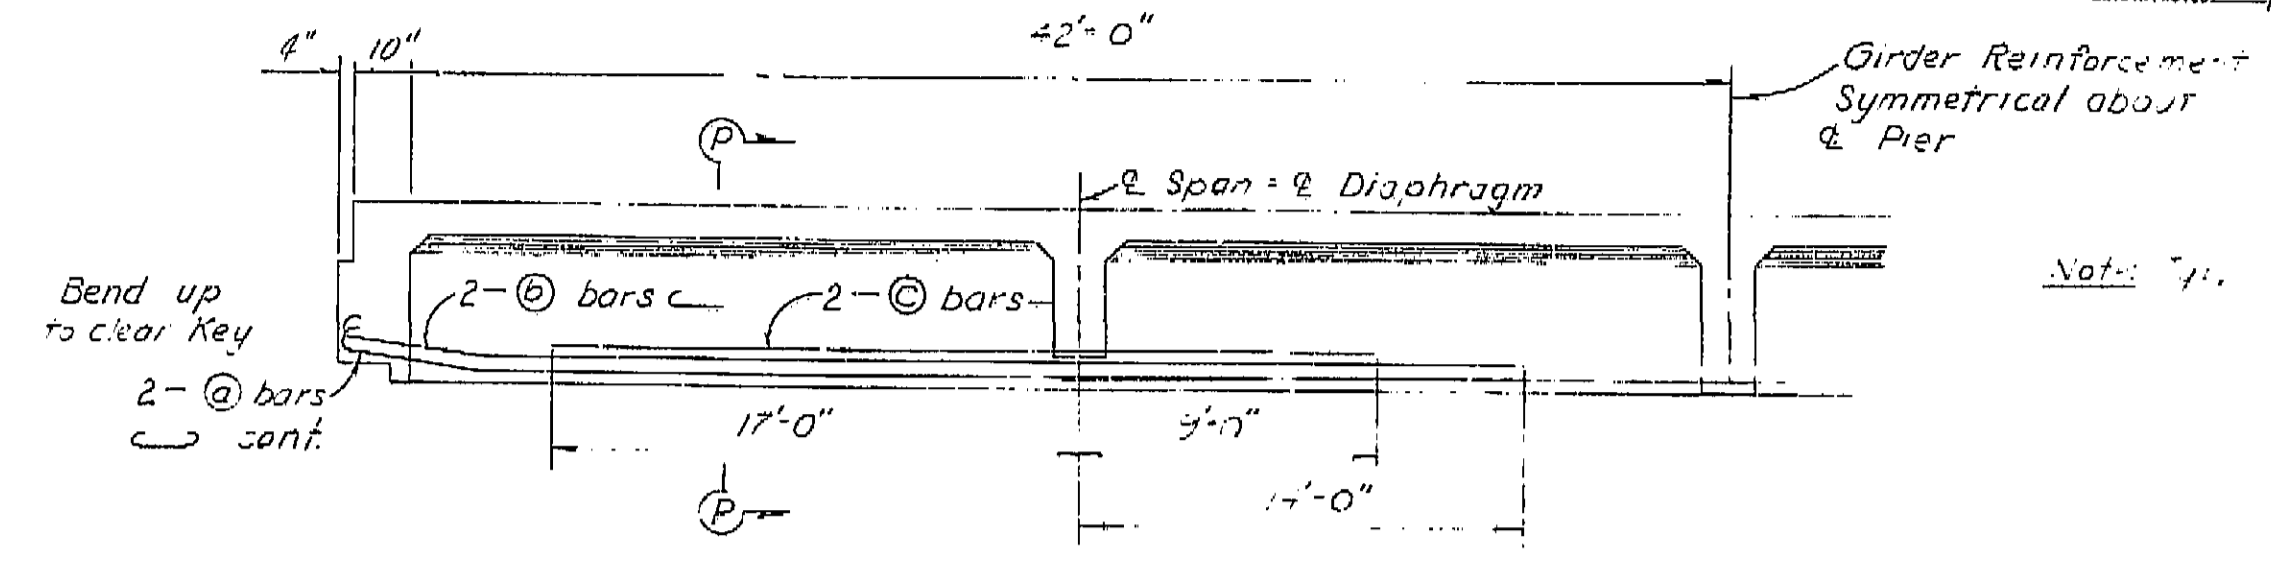

LONGITUDINAL SECTION  
 Scale: None

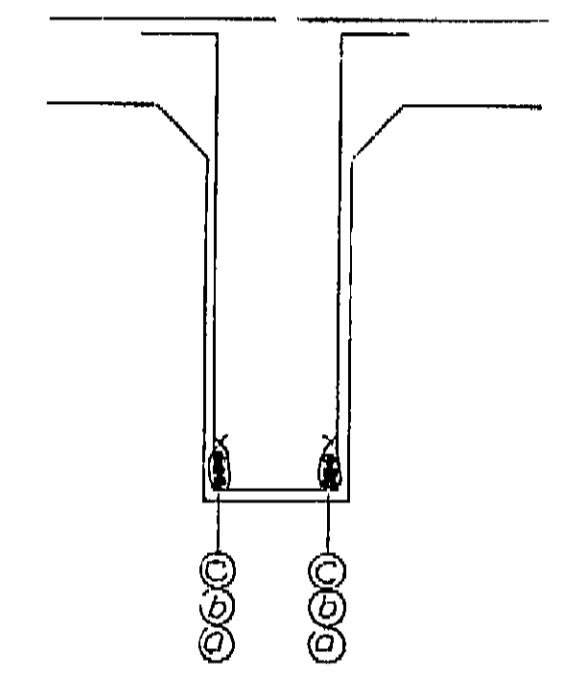

SECTION P-P  
 Scale: None

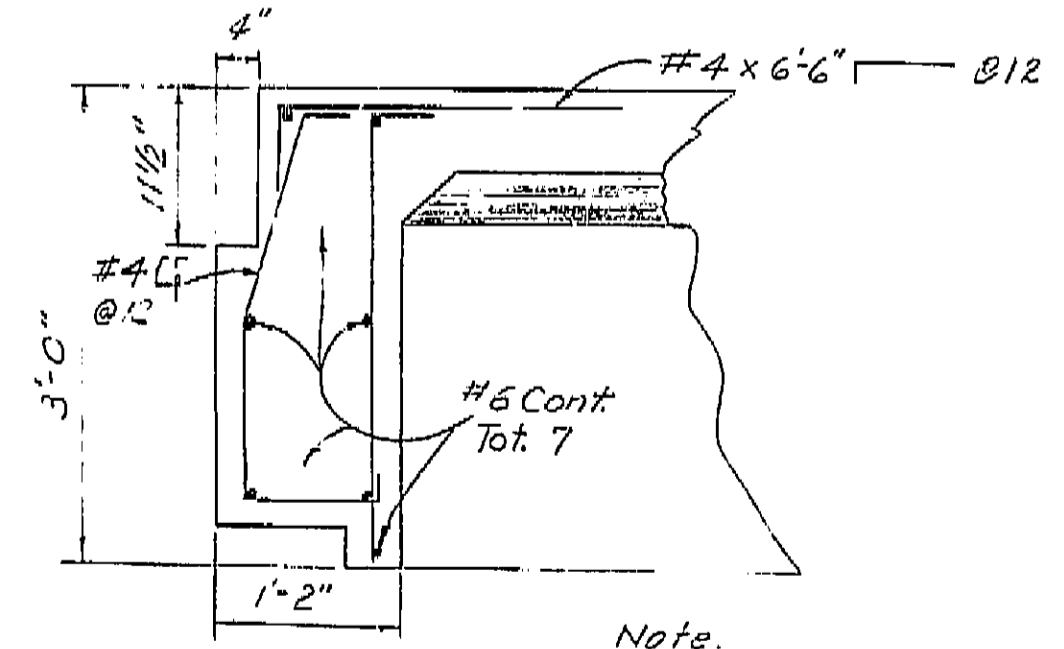

SECTION L-L  
 Scale: 1" = 1'-0"

NO AS BUILT CHANGES

**AS BUILT**  
 CONTRACTING BY L.S. Foster  
 CONTRACT NO. 04-102134  
 5-13-70  
 TBM 7/19/70

Note: Section located on 'Girder Layout' sheet.

BRIDGE DEPARTMENT <b>DESIGN SECTION 12</b>		STATE OF CALIFORNIA DEPARTMENT OF PUBLIC WORKS DIVISION OF HIGHWAYS	
Section Supervisor <i>R.C. Casavant</i>	DRY CREEK BRIDGES		
DESIGN Checked by <i>William J. Gagnier</i> 4/68	REINFORCEMENT		
DETAILS Checked by <i>Robert J. Gagnier</i>	SCALE As Noted		
QUANTITIES Checked by <i>Paul J. Gagnier</i> 4/68	21C-20, 21-14R BRIDGE 21C-21	FILE	DRAWING 2114-8

WO 102131  
 CU 04-204


Disregard prints bearing earlier revision dates

PRELIMINARY DRAWING NO. P-2114-	REVISION DATES


I HEREBY CERTIFY THAT THIS IS A TRUE AND ACCURATE COPY OF THE ABOVE DOCUMENT TAKEN UNDER MY DIRECTION AND CONTROL ON THIS DATE IN SACRAMENTO, CALIFORNIA PURSUANT TO AUTHORIZATION BY THE DIRECTOR OF PUBLIC WORKS.  
 DATE: 7/11/81 BY: [Signature]



Note Added 10/21  
 Design Date J.T.J.  
 or note in  
 "Drain Thru Curb"  
 1. Rev. note in "Drainage"  
 detail. Revised  
 note to read exp. jt.  
 1-61 RIK  
 moved key and added  
 st. 10-17-61 J.T.J.  
 m. Rubber from  
 waterstop wires,  
 water signature  
 pack + blocks above  
 Et. Sac. Eau.  
 et. Sac. + Title  
 Dec. J.T.J. 9-5-63  
 u. Note in  
 "Drainage and Backfill"  
 detail. 10-63 J.T.J.  
 v. Notes + Dim.  
 "Drainage + Backfill"  
 detail. 10-63 J.T.J.  
 w. Notes + Dim.  
 "Drainage + Backfill"  
 detail. 10-63 J.T.J.  
 x. Notes + Dim.  
 "Drainage + Backfill"  
 detail. 10-63 J.T.J.  
 y. Notes + Dim.  
 "Drainage + Backfill"  
 detail. 10-63 J.T.J.  
 z. Notes + Dim.  
 "Drainage + Backfill"  
 detail. 10-63 J.T.J.

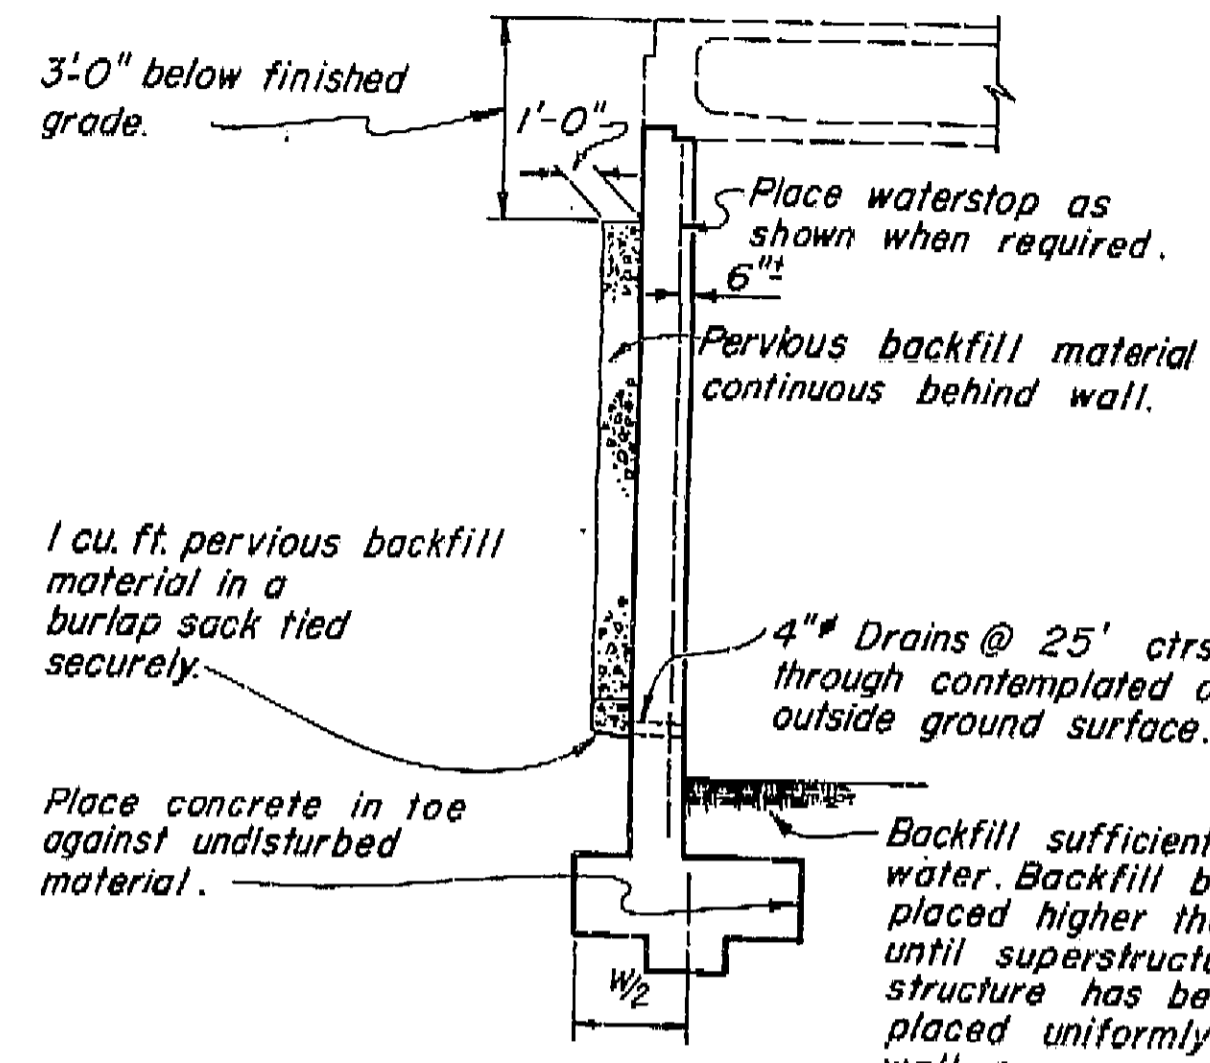

**DRAINAGE AND BACKFILL**

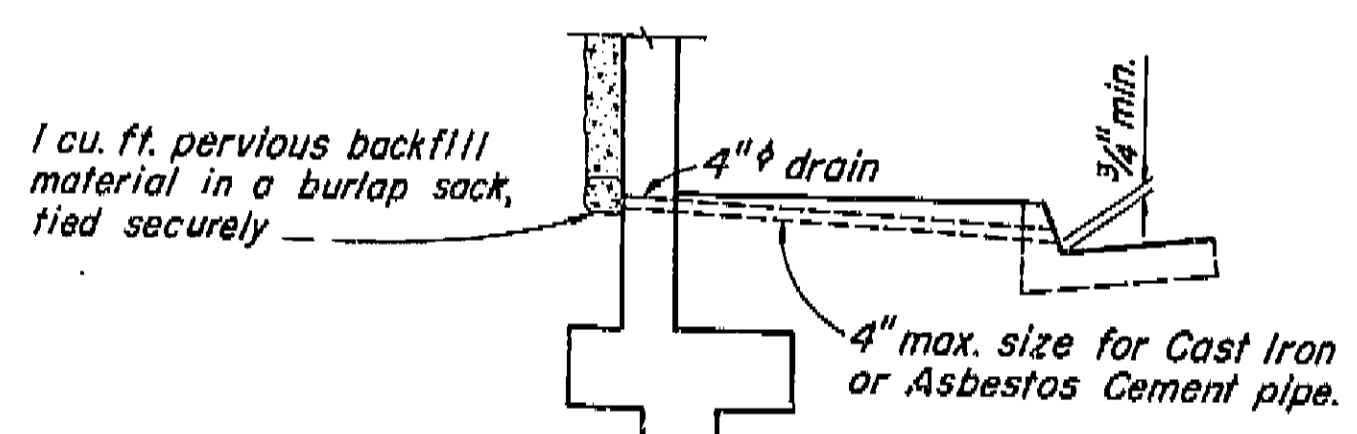


**DRAIN THROUGH CURB**


**Loading Notes**

Superstructure load assumed to vary between  
 50<sup>k</sup>-200<sup>k</sup> per lineal foot, H=22 to H=28  
 50<sup>k</sup>-17.5<sup>k</sup> per lineal foot, H=18 & H=20  
 2' Level surcharge used.  
 Depth of superstructure: 2' min., 7' max.


**AS BUILT PLANS**  
 Contract No. 04-102134  
 Date Completed  
 Document No. 4000/32-4

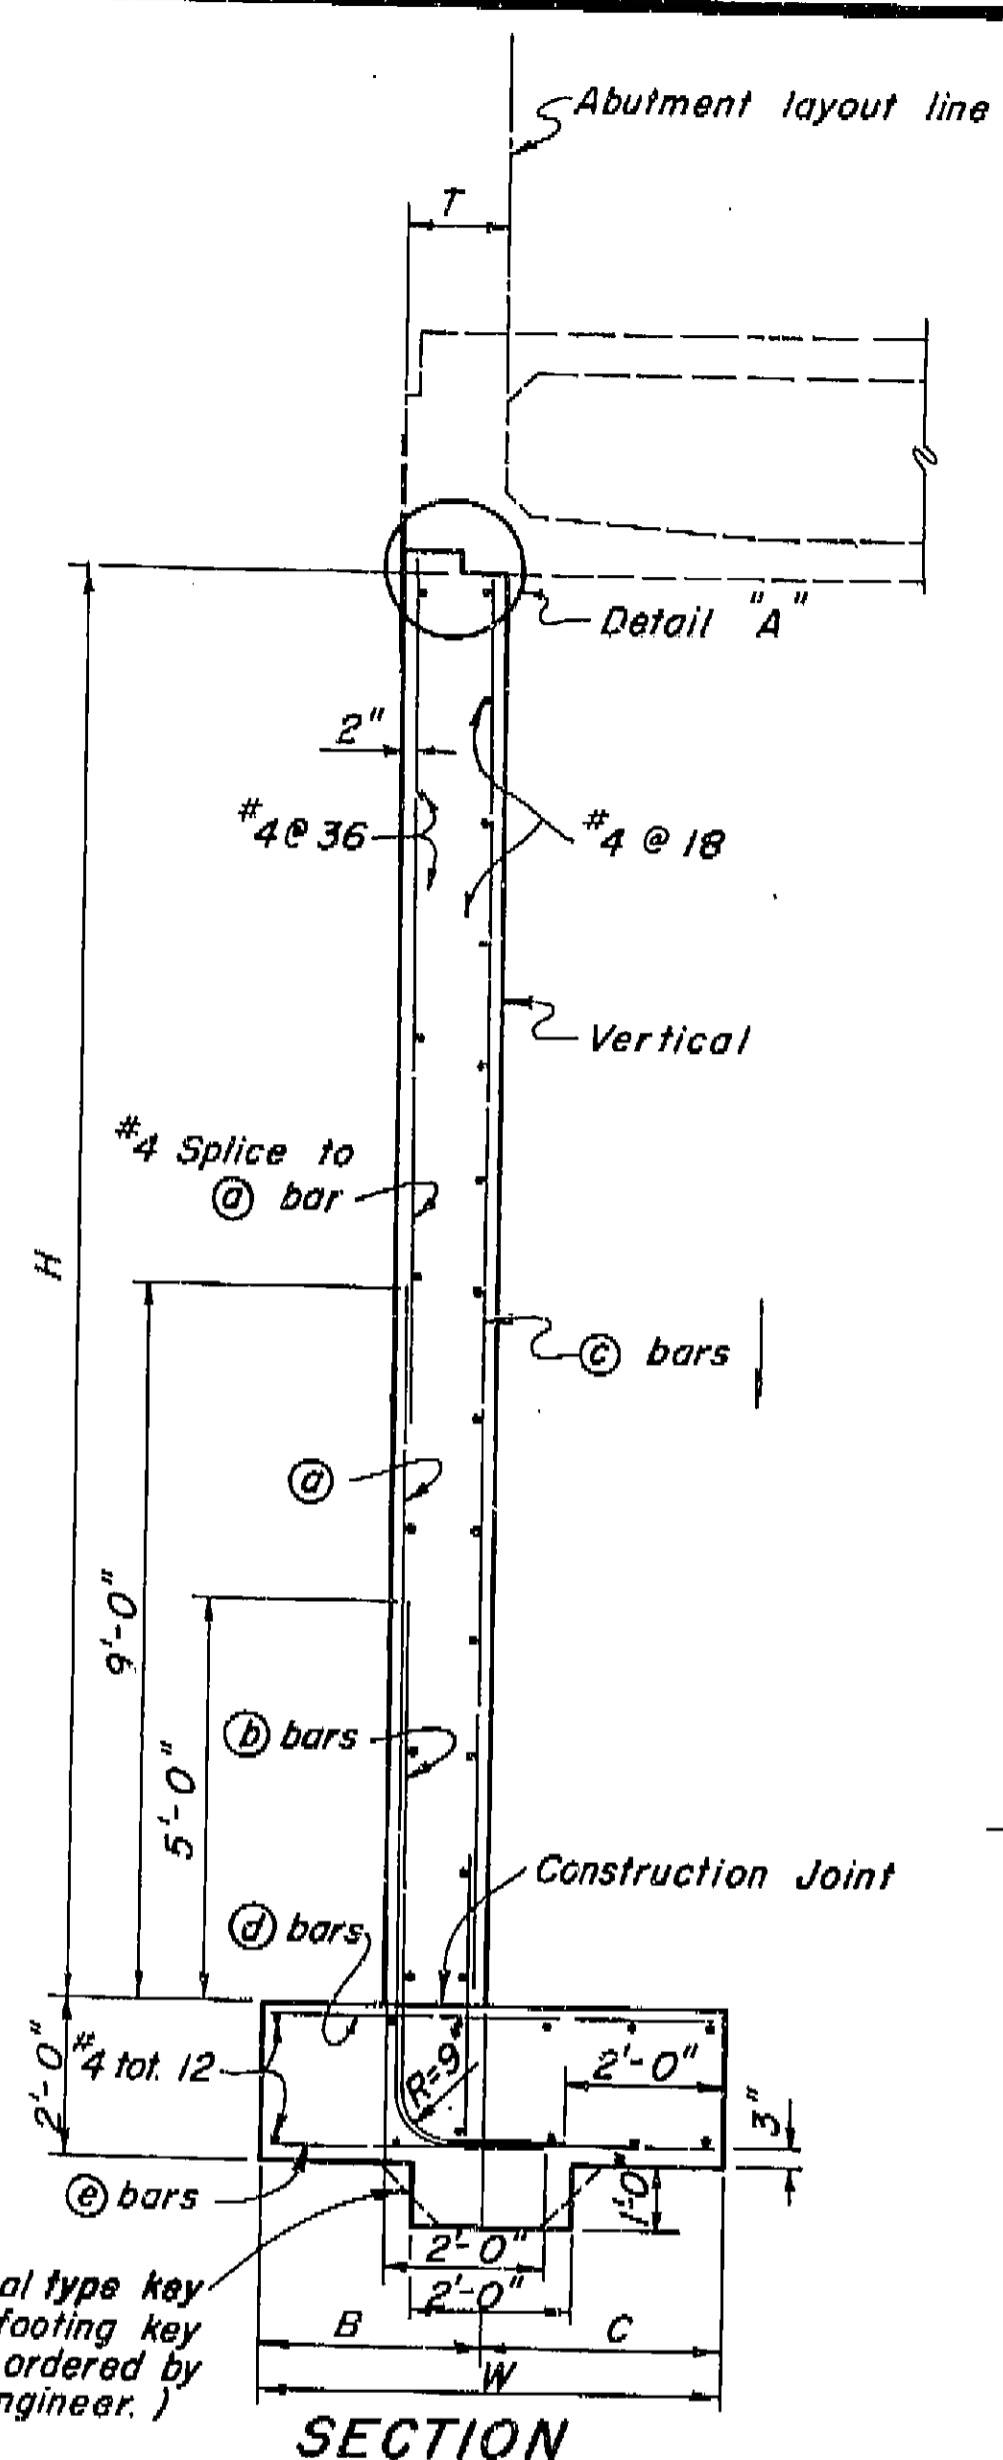


**SECTION**

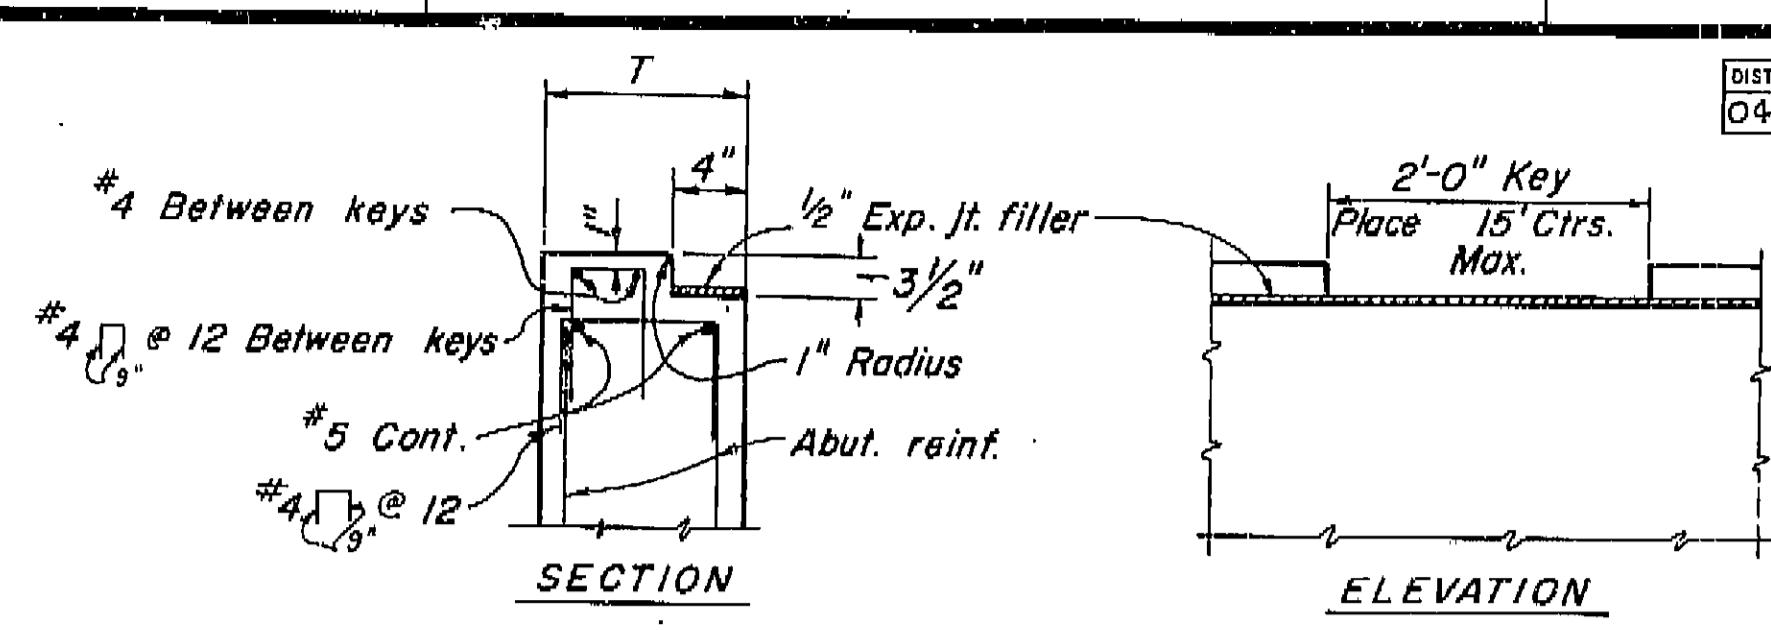


**DETAIL "A"**

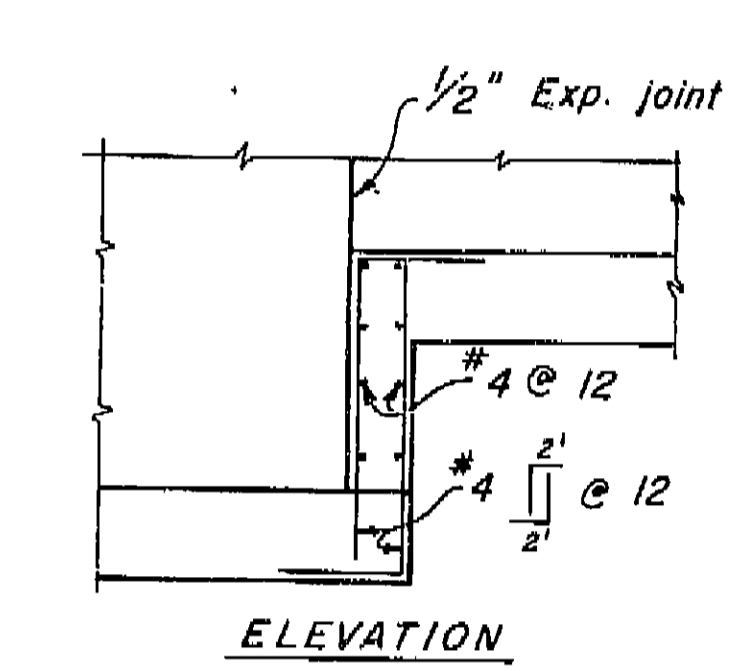


**ELEVATION**

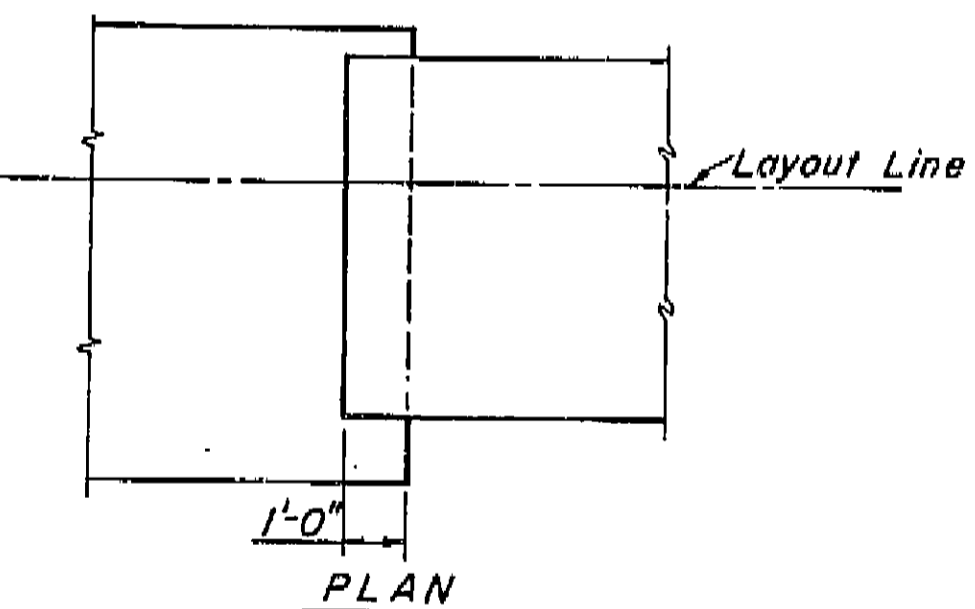


**FOOTING STEP**

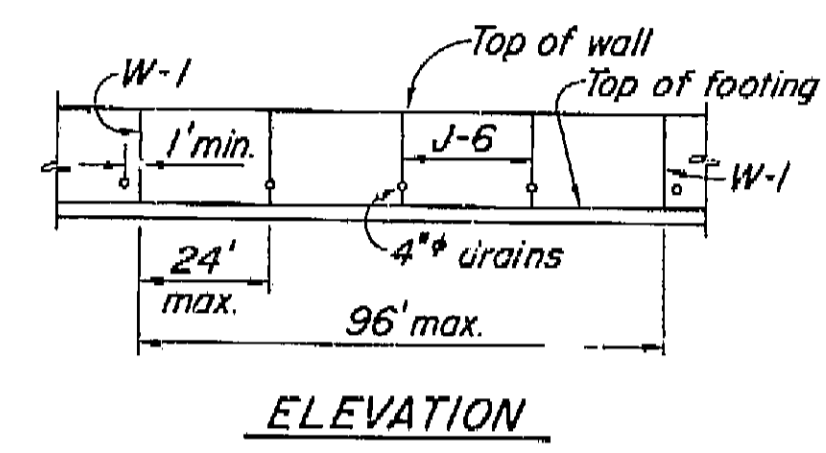

**ELEVATION**

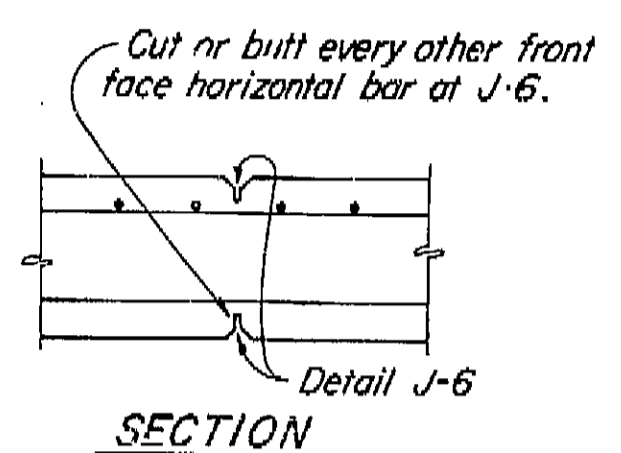


**SECTION**

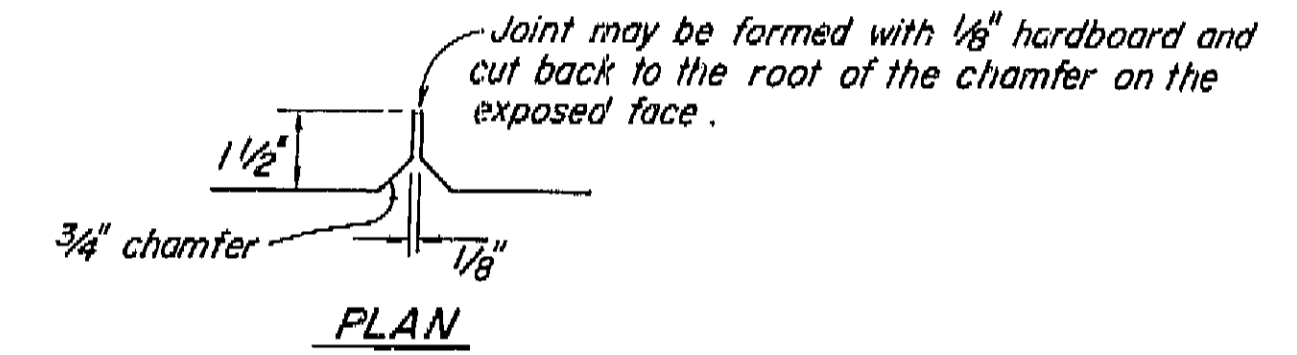

**PLAN**

**DETAIL J-6**

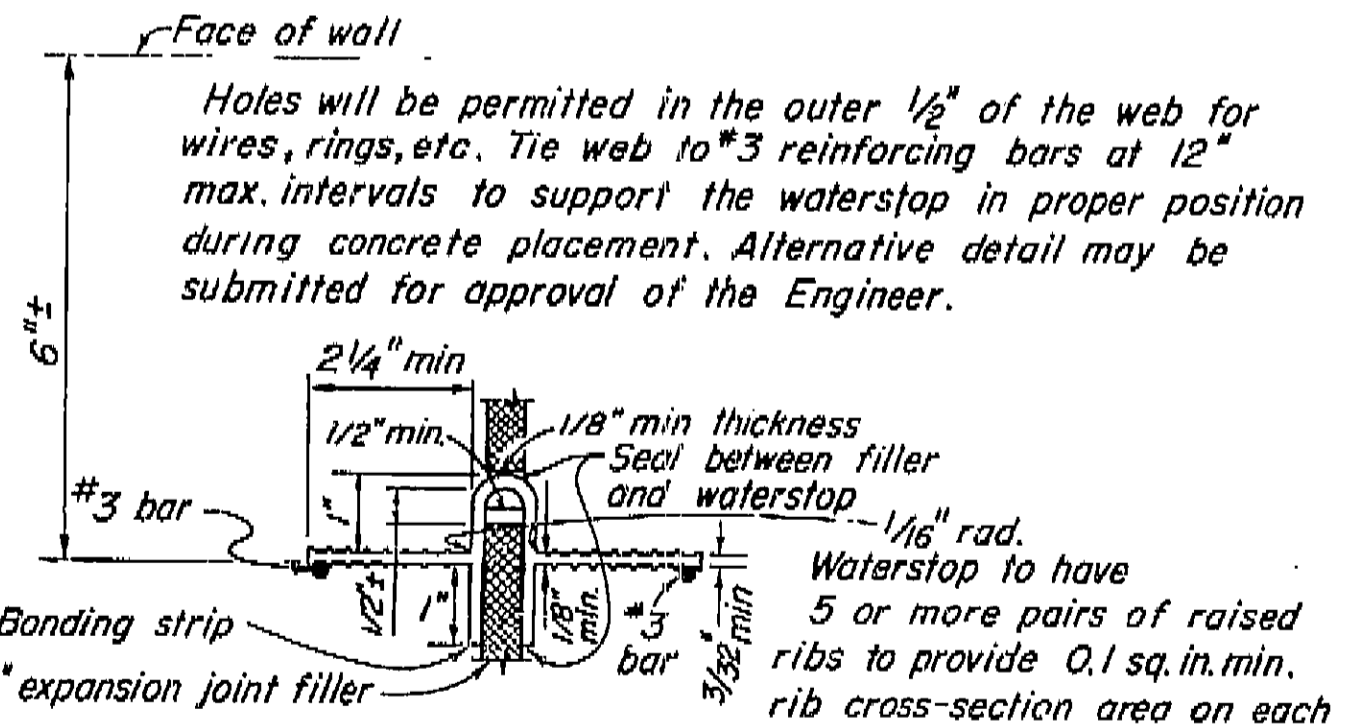

**DETAIL W-1**

NO AS BUILT CHANGES

**AS BUILT**

CORRECTIONS BY L.S. Foster  
 CONTRACT NO. 04-102134  
 DATE 5-13-70  
 7/27/70








TABLE OF REINFORCING STEEL, DIMENSIONS AND DATA							
H	18'	20'	22'	24'	26'	28'	Special
T	1'-2"	1'-4"	1'-6"	1'-8"	1'-10"	2'-0"	1'-2"
W	6'-6"	7'-3"	8'-0"	8'-9"	9'-6"	10'-3"	8'-0"
C	3'-5"	3'-10"	4'-3"	4'-7"	5'-0"	5'-5"	4'-5"
B	3'-1"	3'-5"	3'-9"	4'-2"	4'-6"	4'-10"	3'-7"
⊙ Bars	# 9 @ 15	# 10 @ 17	# 10 @ 15	# 11 @ 16	# 11 @ 15	# 11 @ 14	# 9 @ 15
⊙ Bars	# 9 @ 15	# 10 @ 17	# 10 @ 15	# 11 @ 16	# 11 @ 15	# 11 @ 14	# 9 @ 15
⊙ Bars	# 9 @ 7 1/2	# 10 @ 8 1/2	# 10 @ 7 1/2	# 11 @ 8	# 11 @ 7 1/2	# 11 @ 7	# 9 @ 7 1/2
⊙ Bars	# 4 @ 7 1/2	# 4 @ 8 1/2	# 4 @ 7 1/2	# 5 @ 8	# 5 @ 7 1/2	# 5 @ 7	# 5 @ 7 1/2
⊙ Bars	# 5 @ 7 1/2	# 5 @ 8 1/2	# 5 @ 7 1/2	# 6 @ 8	# 6 @ 7 1/2	# 6 @ 7	# 6 @ 7 1/2
Conc. cf./ft.	36.2	43.3	51.3	59.8	68.0	78.8	
Steel lbs./ft.	233	271	326	399	451	510	

12/67  
 STATE OF CALIFORNIA  
 TRANSPORTATION AGENCY  
 DEPARTMENT OF PUBLIC WORKS  
 DIVISION OF HIGHWAYS  
 File  
 XS-22-1  
**DRY CREEK BRIDGES**  
**STRUTTED ABUTMENT - SPREAD-FOOTING**  
 BRIDGE 21-142  
 NO. 21C-20, 21C-21  
 POST MILE  
 DRAWING NO. 2114-9  
 SHEET 9 OF 13



DIST.	COUNTY	ROUTE	POST MILES—TOTAL PROJECT	SHEET NO.	TOTAL SHEETS
04	Nap	29	15.0/19.6	55	69

BRIDGE ENGINEER  
 REGISTERED PROFESSIONAL ENGINEER—CIVIL  
 DATE APPROVED: September 23, 1968

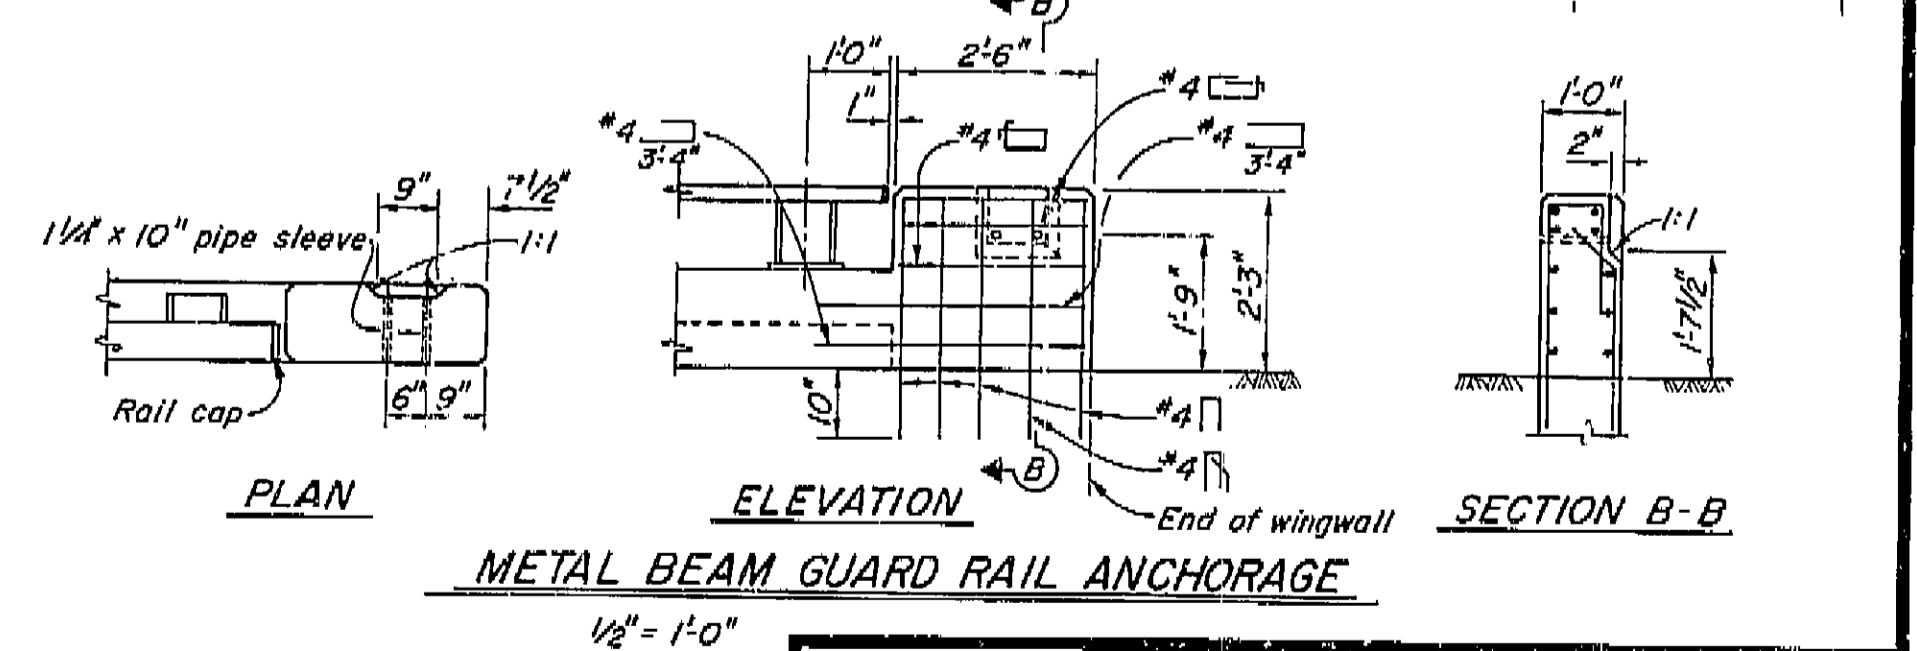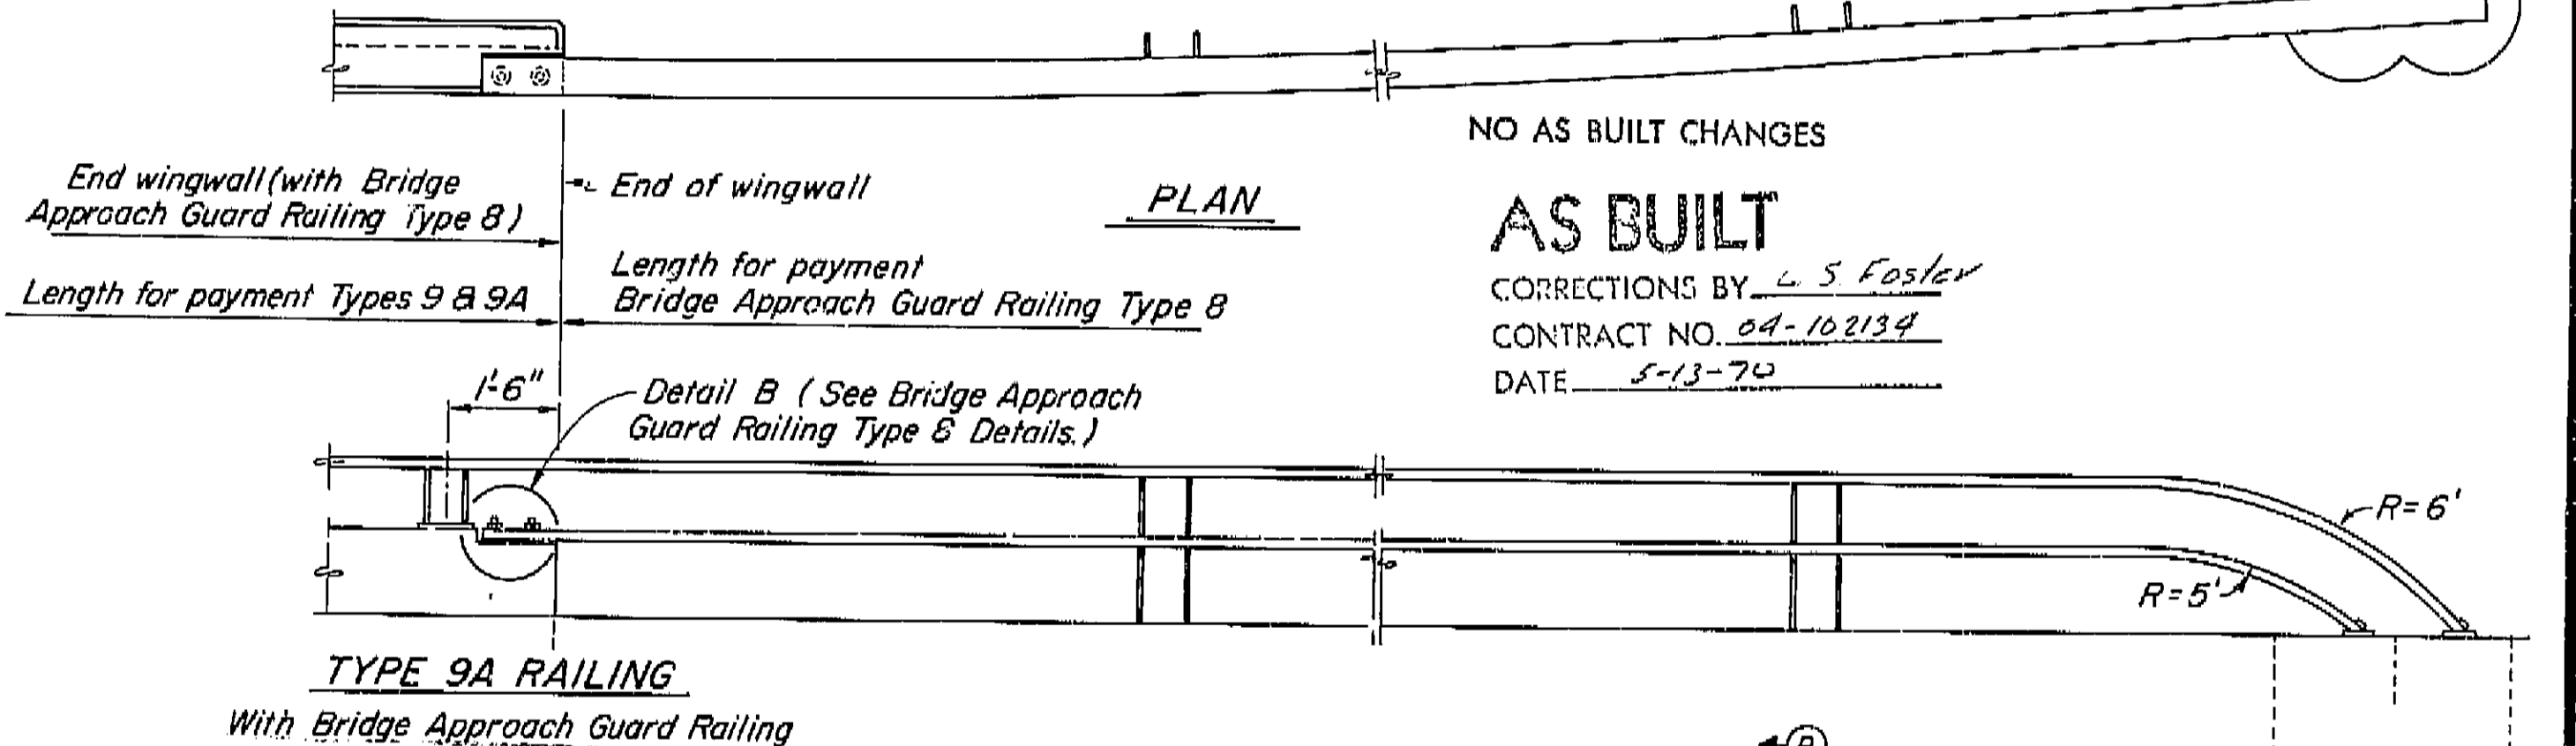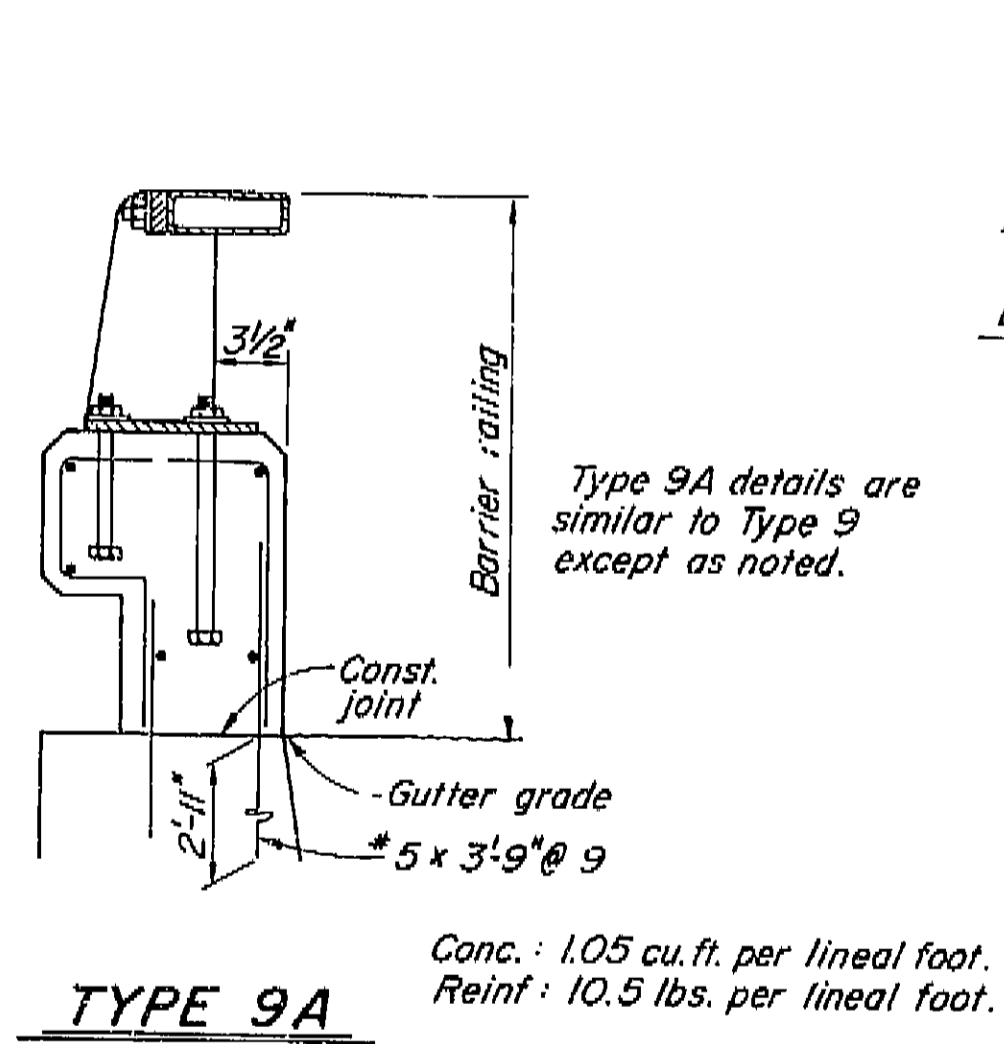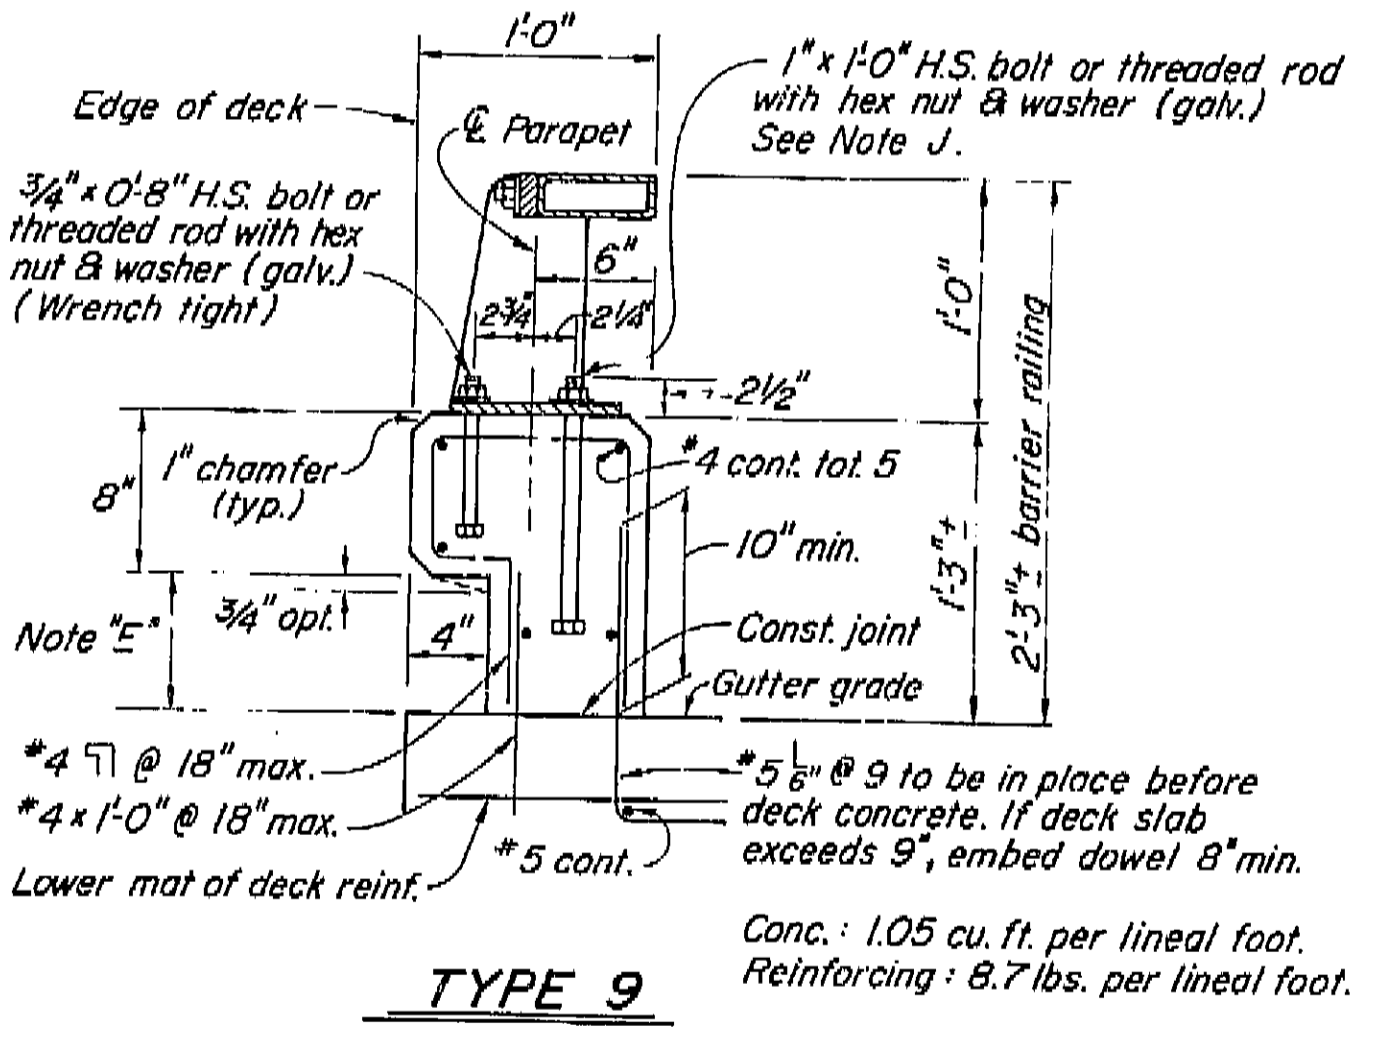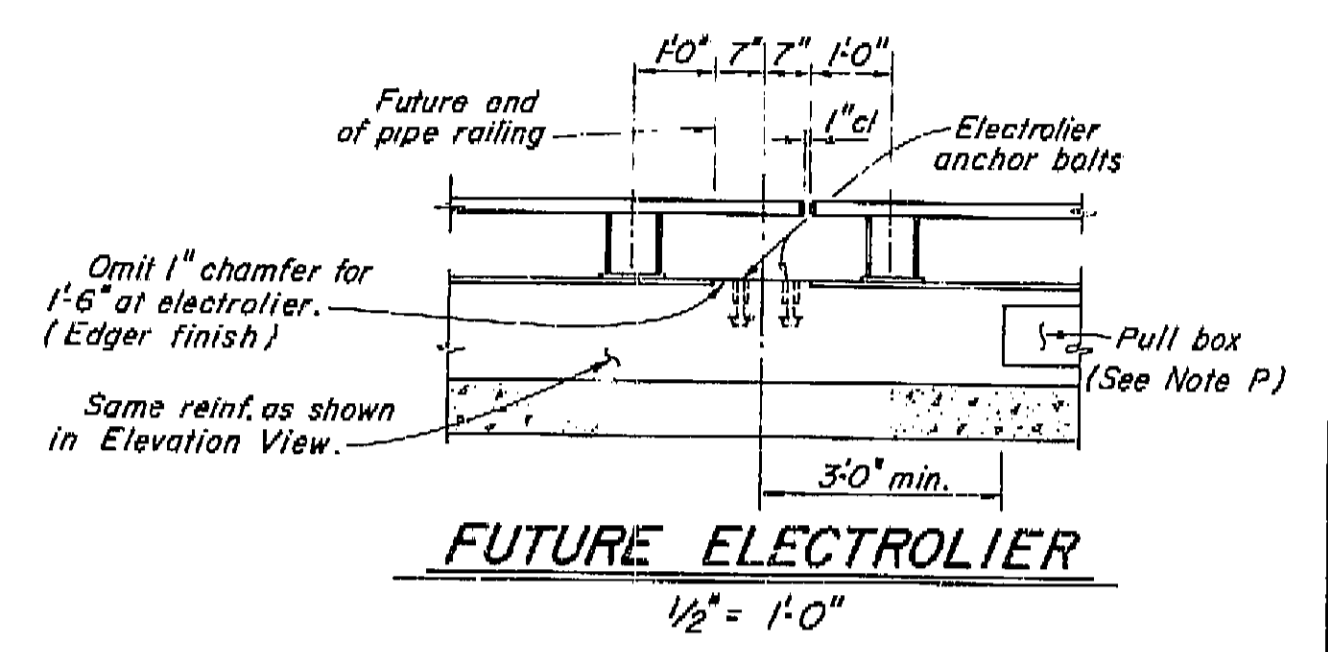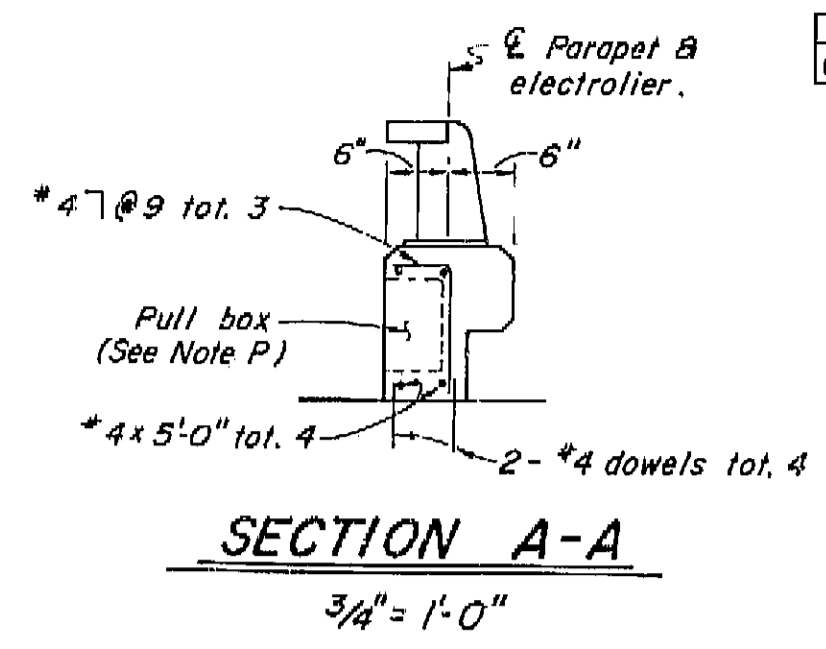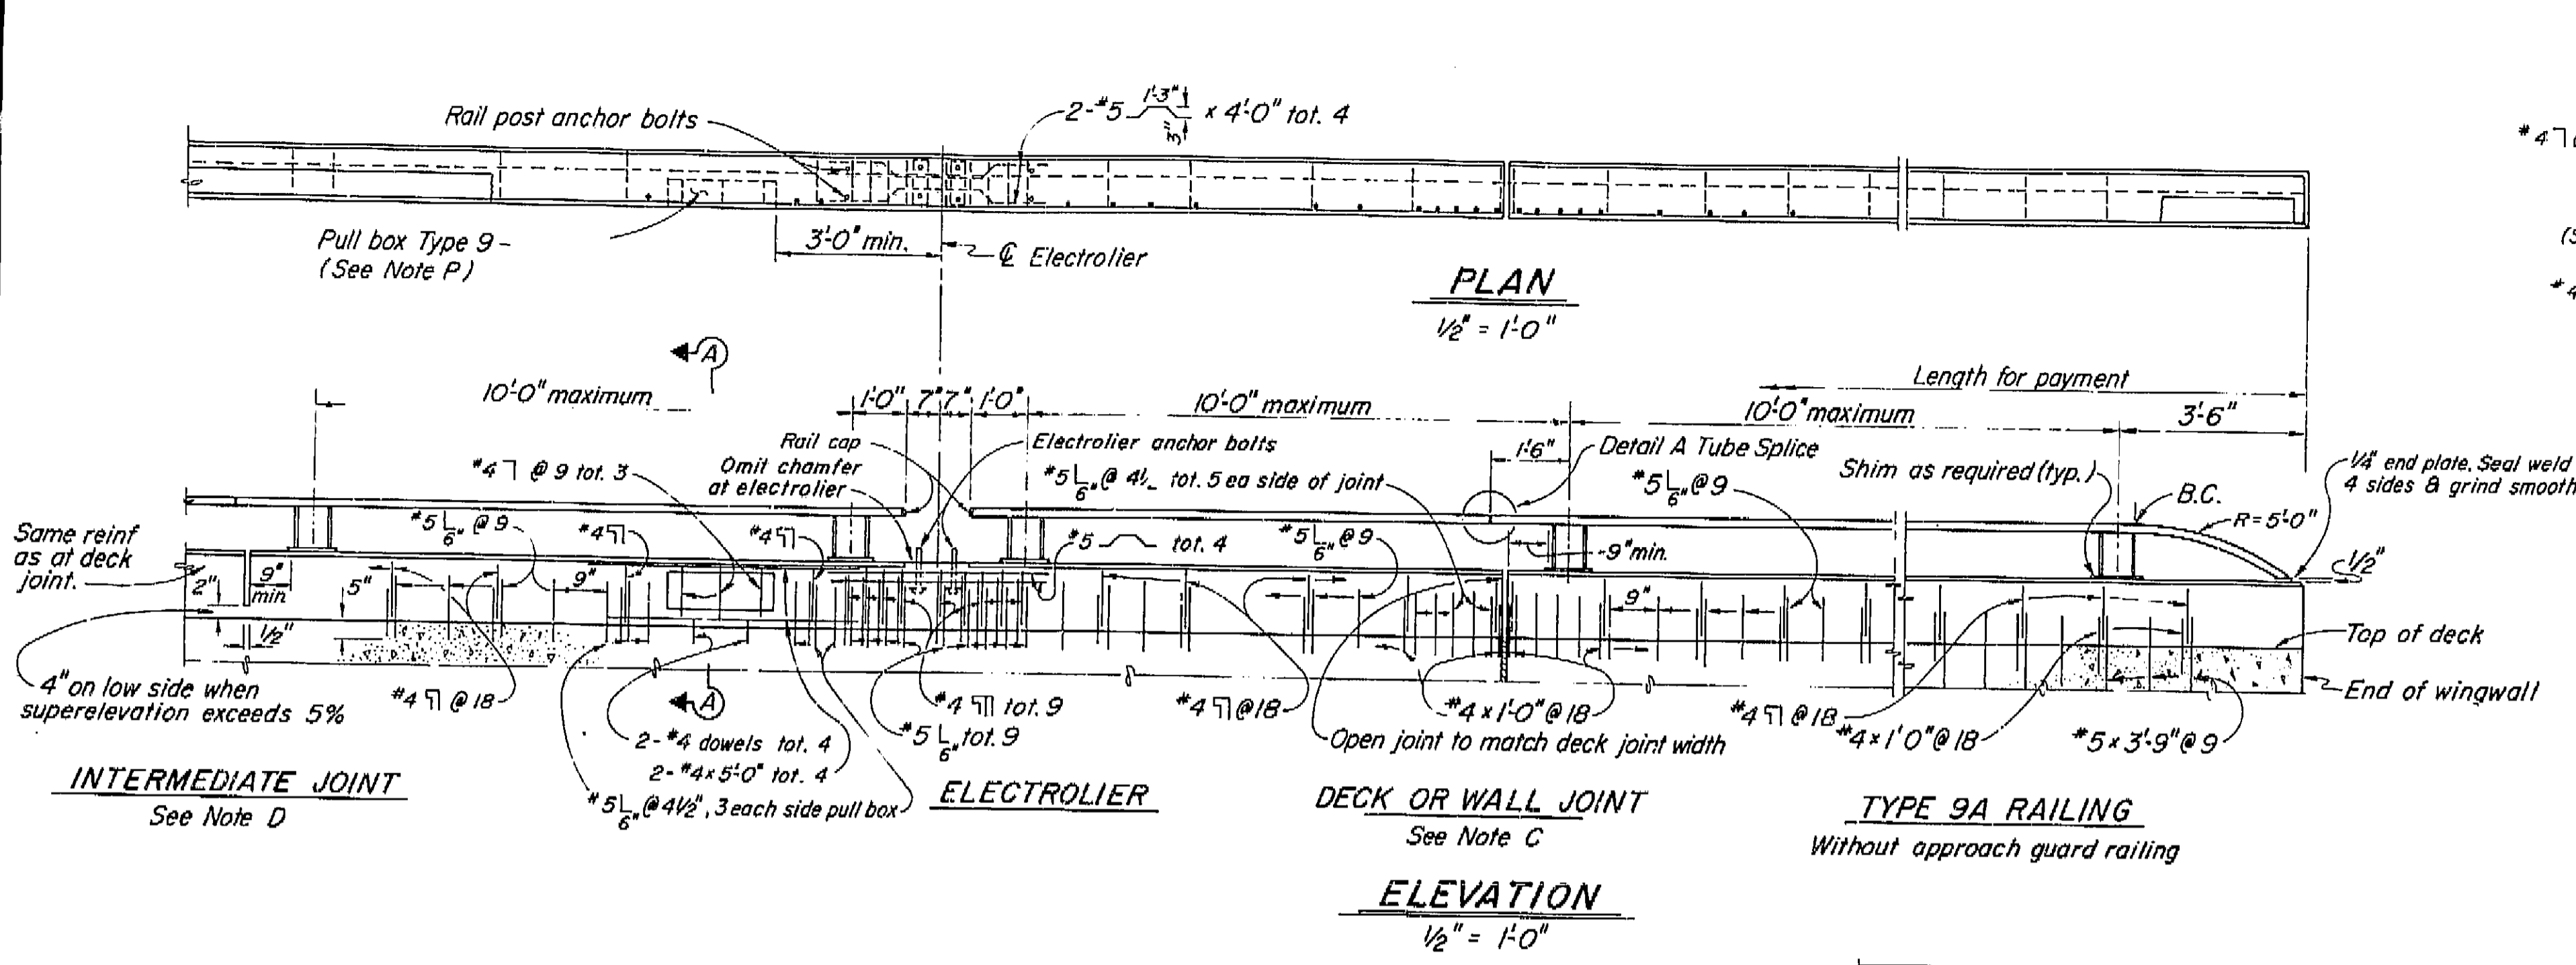

- A. Tubing shall be bent to fit horizontal curve when radius is less than 950'.
- B. Posts shall be normal to railing.
- C. Tube splice shall be located in the tube spanning deck joints. Increase joint width in tube to match deck opening and increase sleeve length correspondingly.
- D. Open intermediate joints in concrete shall be located at  $\mathcal{E}$  piers, abutments or bents and at uniform spacing (40'-0" max.).
- E. Dimensions will vary with cross slope.
- F. Construct 3" deep x 12" wide overflow scupper 2" above deck at low points in grade.
- G. Walls are to be backfilled before railing is placed.
- H. Clearance to reinforcing steel in curb and railing to be 1". Longitudinal reinforcement to stop at all joints.
- J. High strength rods threaded both ends with 2 nuts and washers (all galv.) may be substituted for high strength anchor bolts.
- K. Torque rail to post nuts to 175 ft. lbs.
- L. Tubing shall be continuous over not less than 2 intermediate posts, with a minimum length of 2 panels, except as noted.
- M. All exposed corners shall be ground smooth.
- N. Galvanize rail assembly after fabrication.
- O. Locate pull box near mid-point between posts, but not in same panel as deck joints or electroliers.
- P. Reinforcement is shown for Type 9 pull box. If Type 9A pull box is to be used refer to "Type 9A Pull Box" sheet.

Note: For Metal Beam Guard Rail connection details see STANDARD PLANS.

5/68		STATE OF CALIFORNIA TRANSPORTATION AGENCY DEPARTMENT OF PUBLIC WORKS DIVISION OF HIGHWAYS		XS-9-84	
<b>DRY CREEK BRIDGES</b>					
<b>BARRIER RAILING TYPE 9</b>					
BRIDGE 21-14R NO. 21C-20, 21C-21	POST MILE	DRAWING NO.	SHEET	OF	
			10	13	
REVISION DATES					

WO 102131  
 CU 04204









Disregard prints bearing earlier revision dates

I HEREBY CERTIFY THAT THIS IS A TRUE AND ACCURATE COPY OF THE ABOVE DOCUMENT TAKEN UNDER MY DIRECTION AND CONTROL ON THIS DATE IN SACRAMENTO, CALIFORNIA PURSUANT TO AUTHORIZATION BY THE DIRECTOR OF PUBLIC WORKS.



DIST.	COUNTY	ROUTE	POST MILES - TOTAL PROJECT	SHEET	TOTAL SHEETS
04	Nap	29	150/19.6	56	69

September 23, 1968

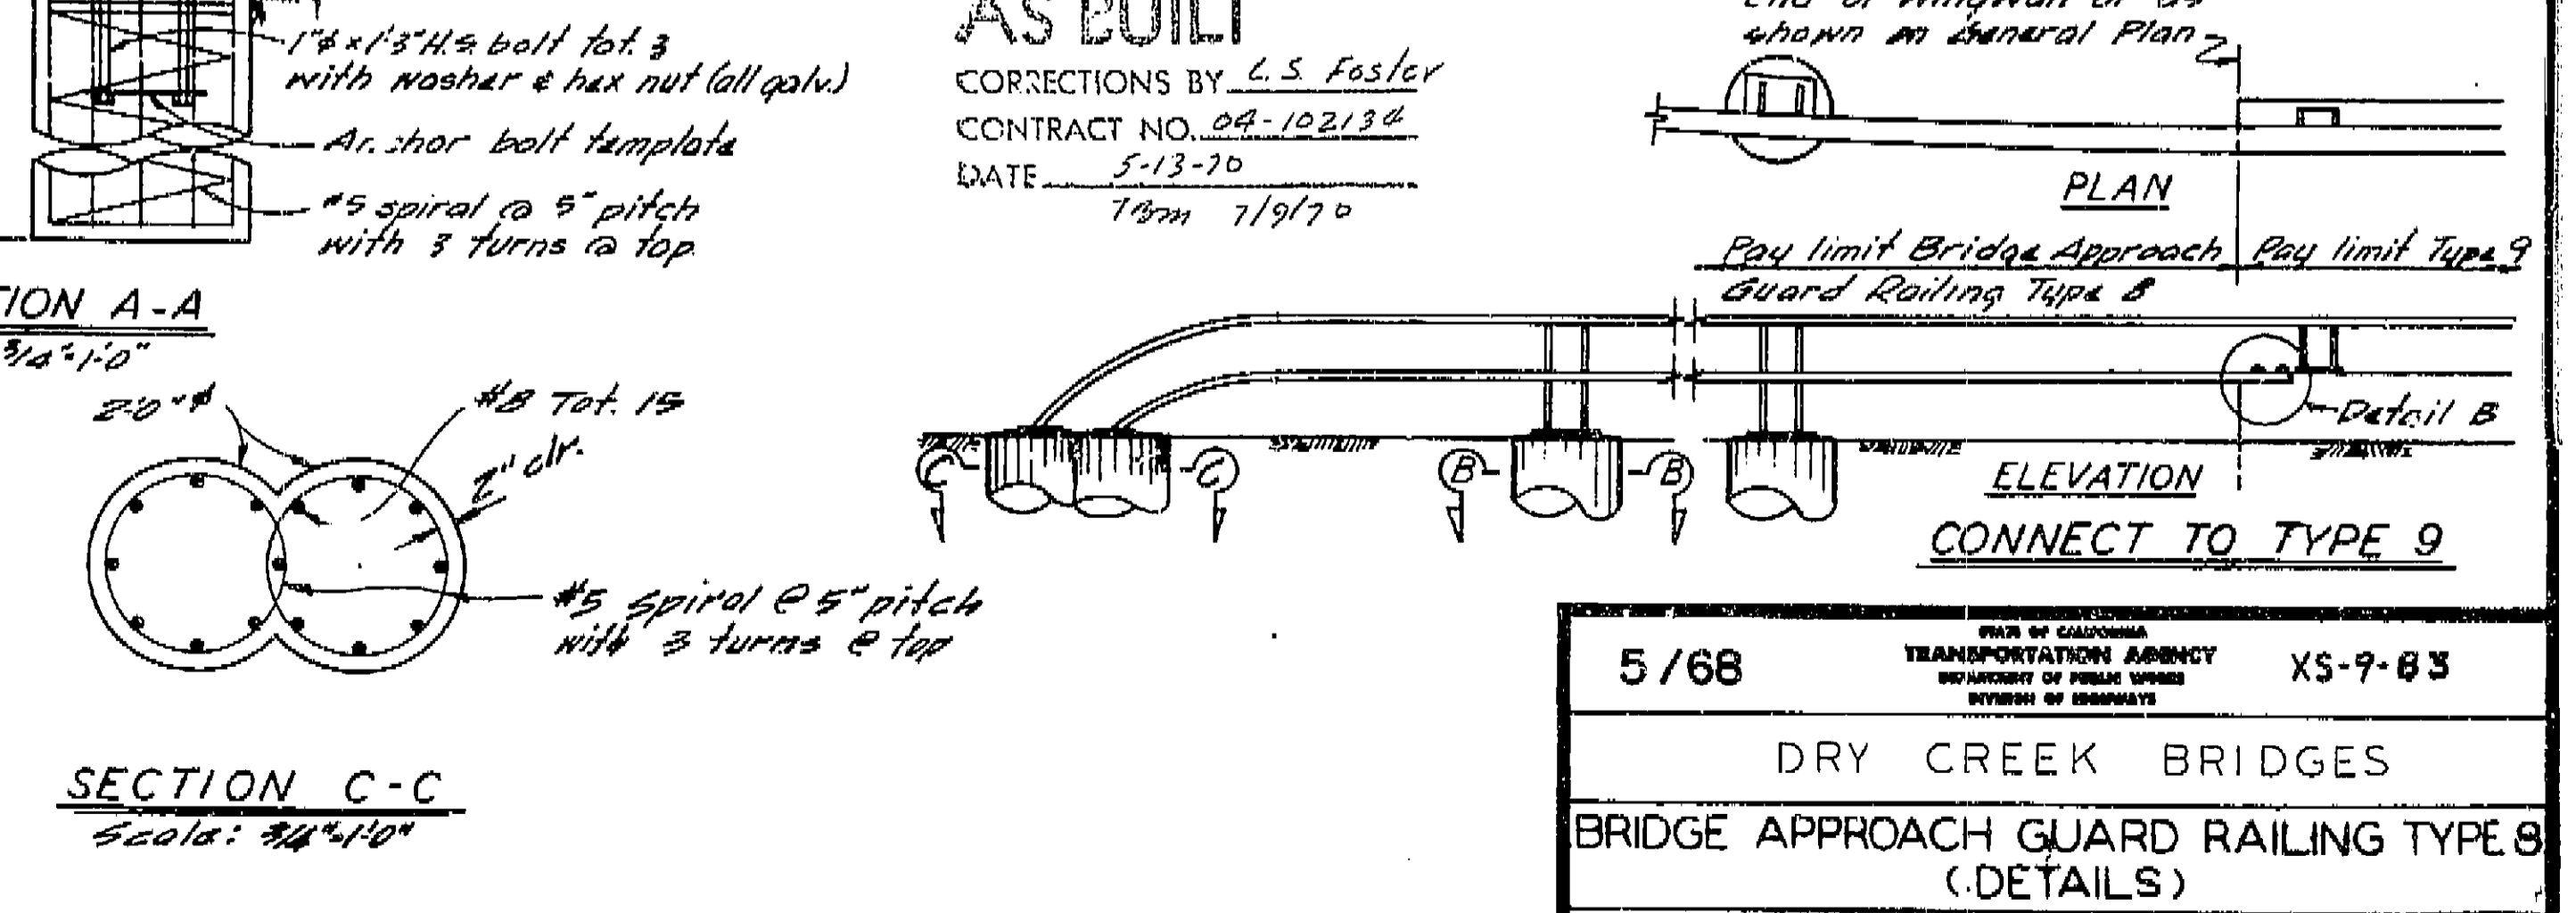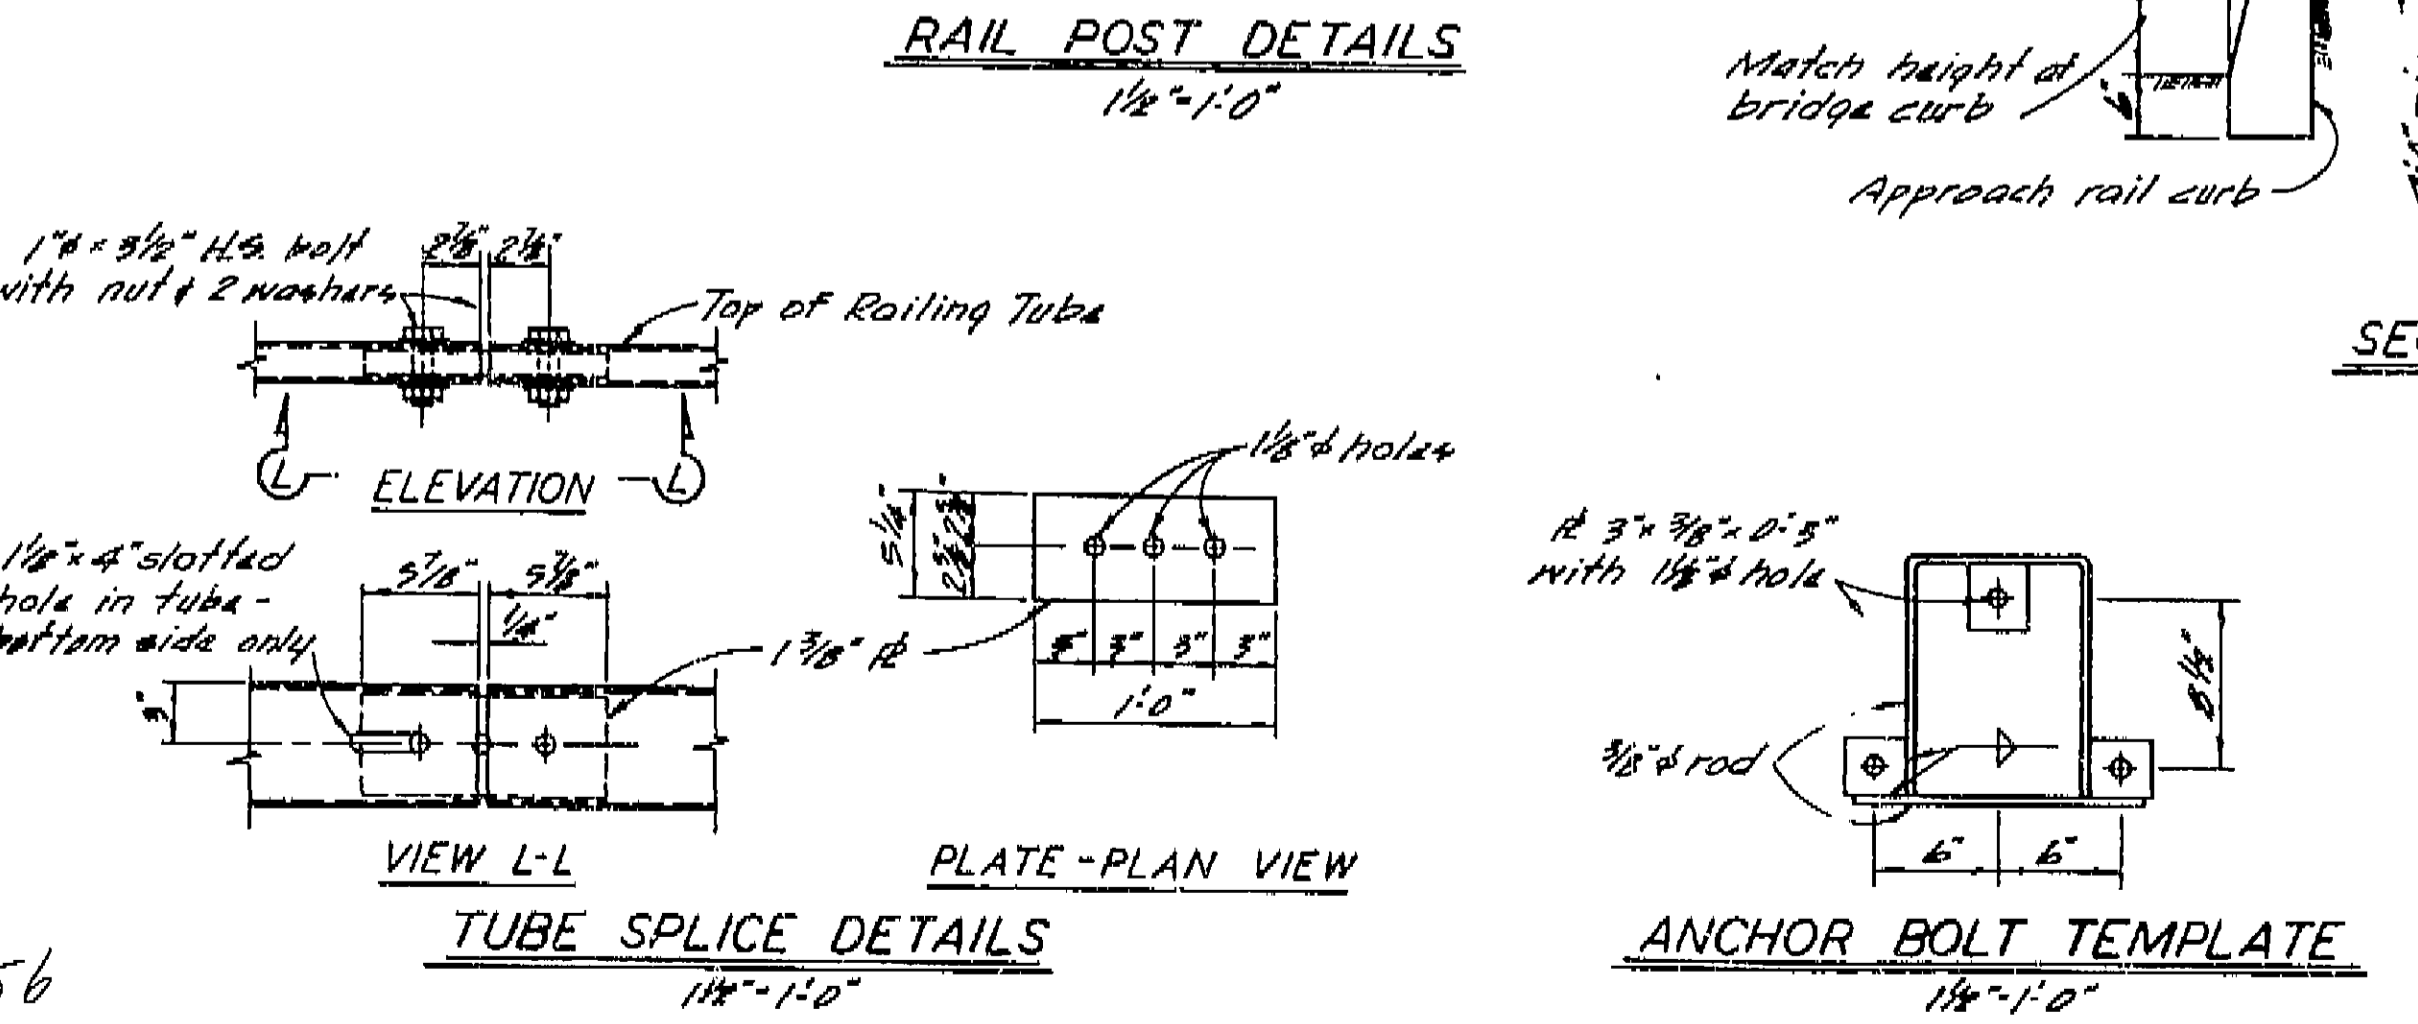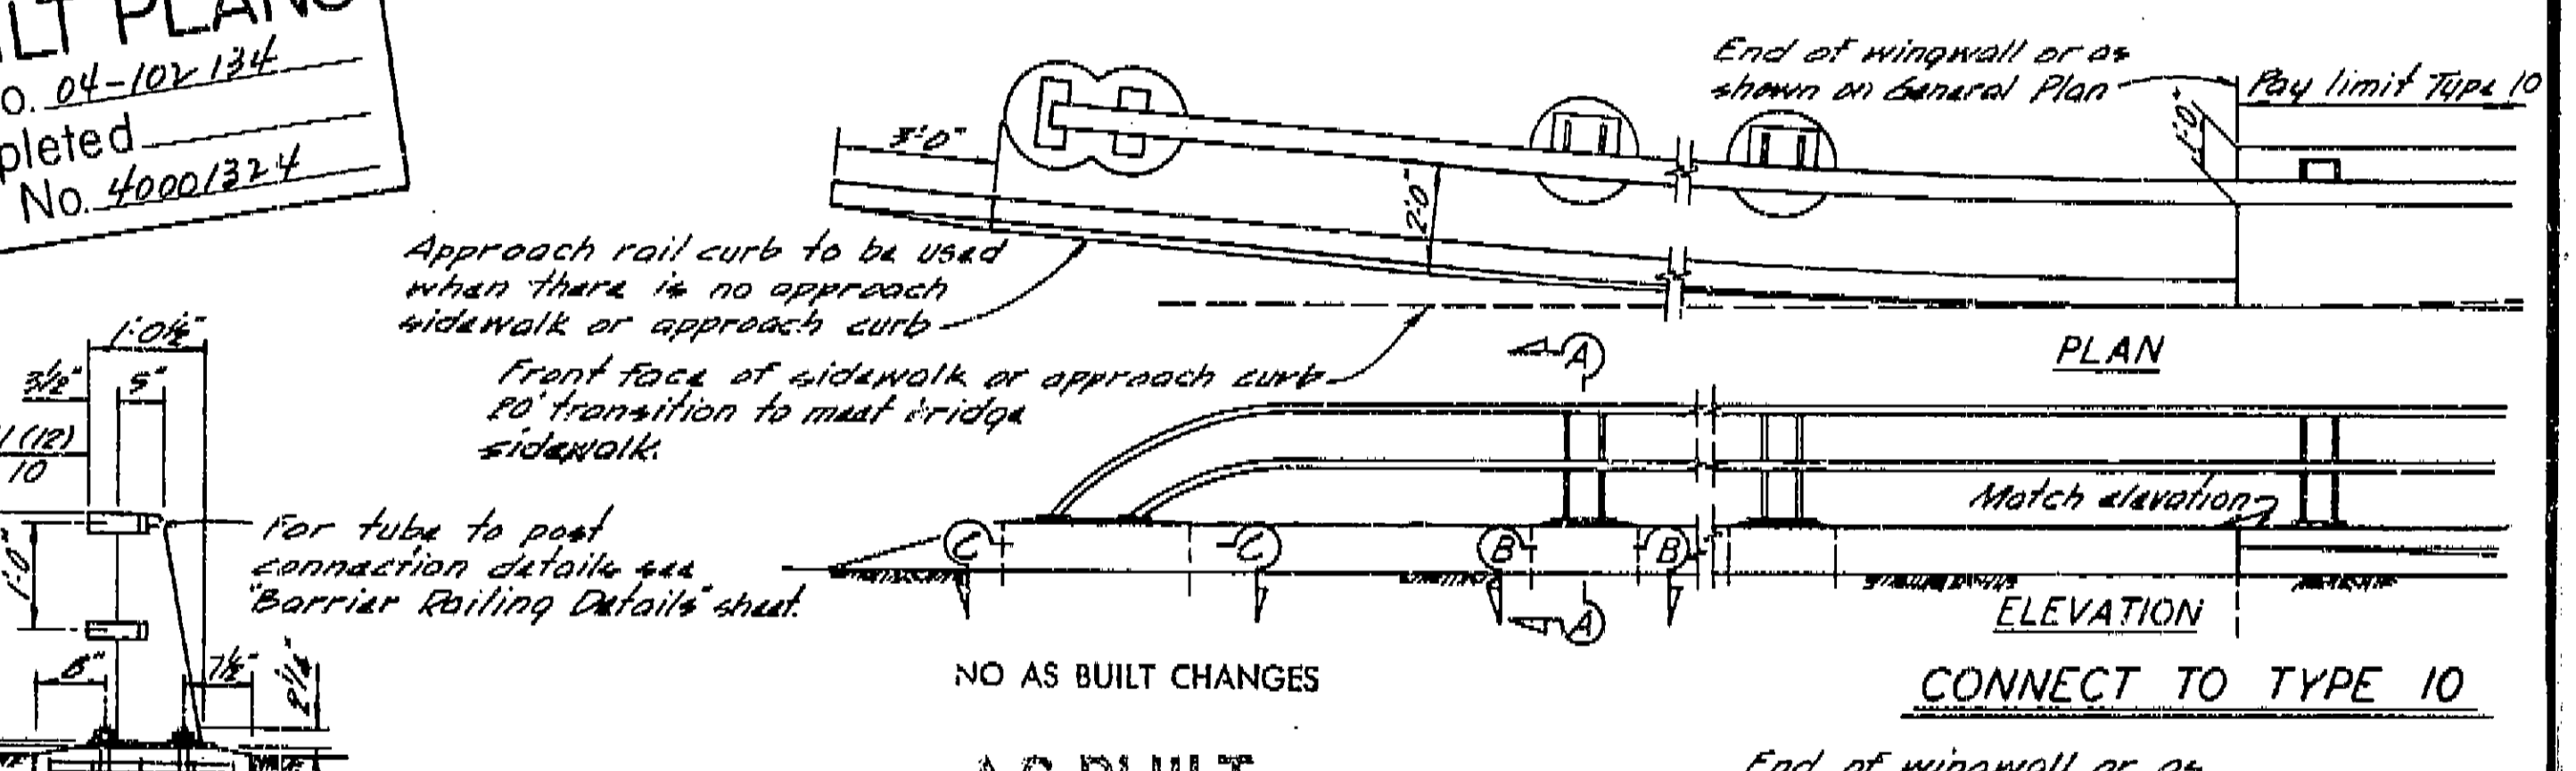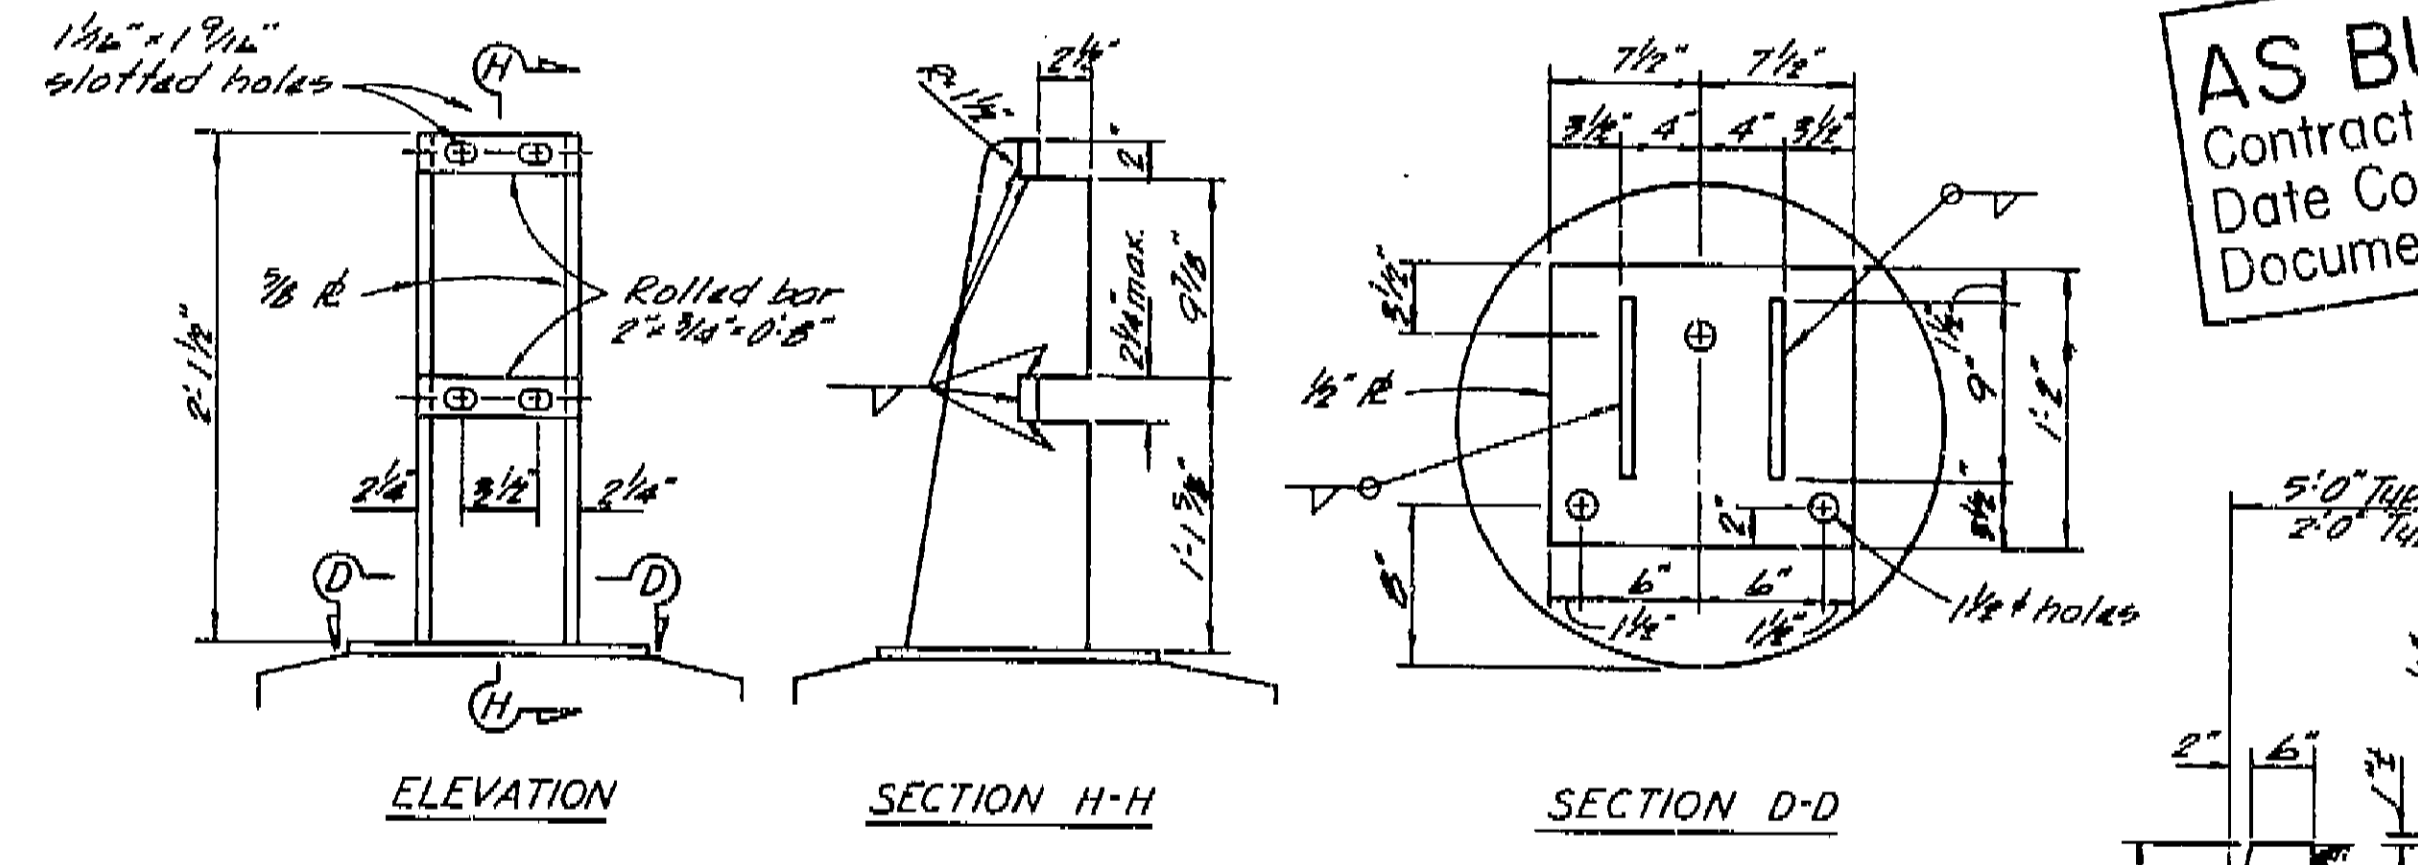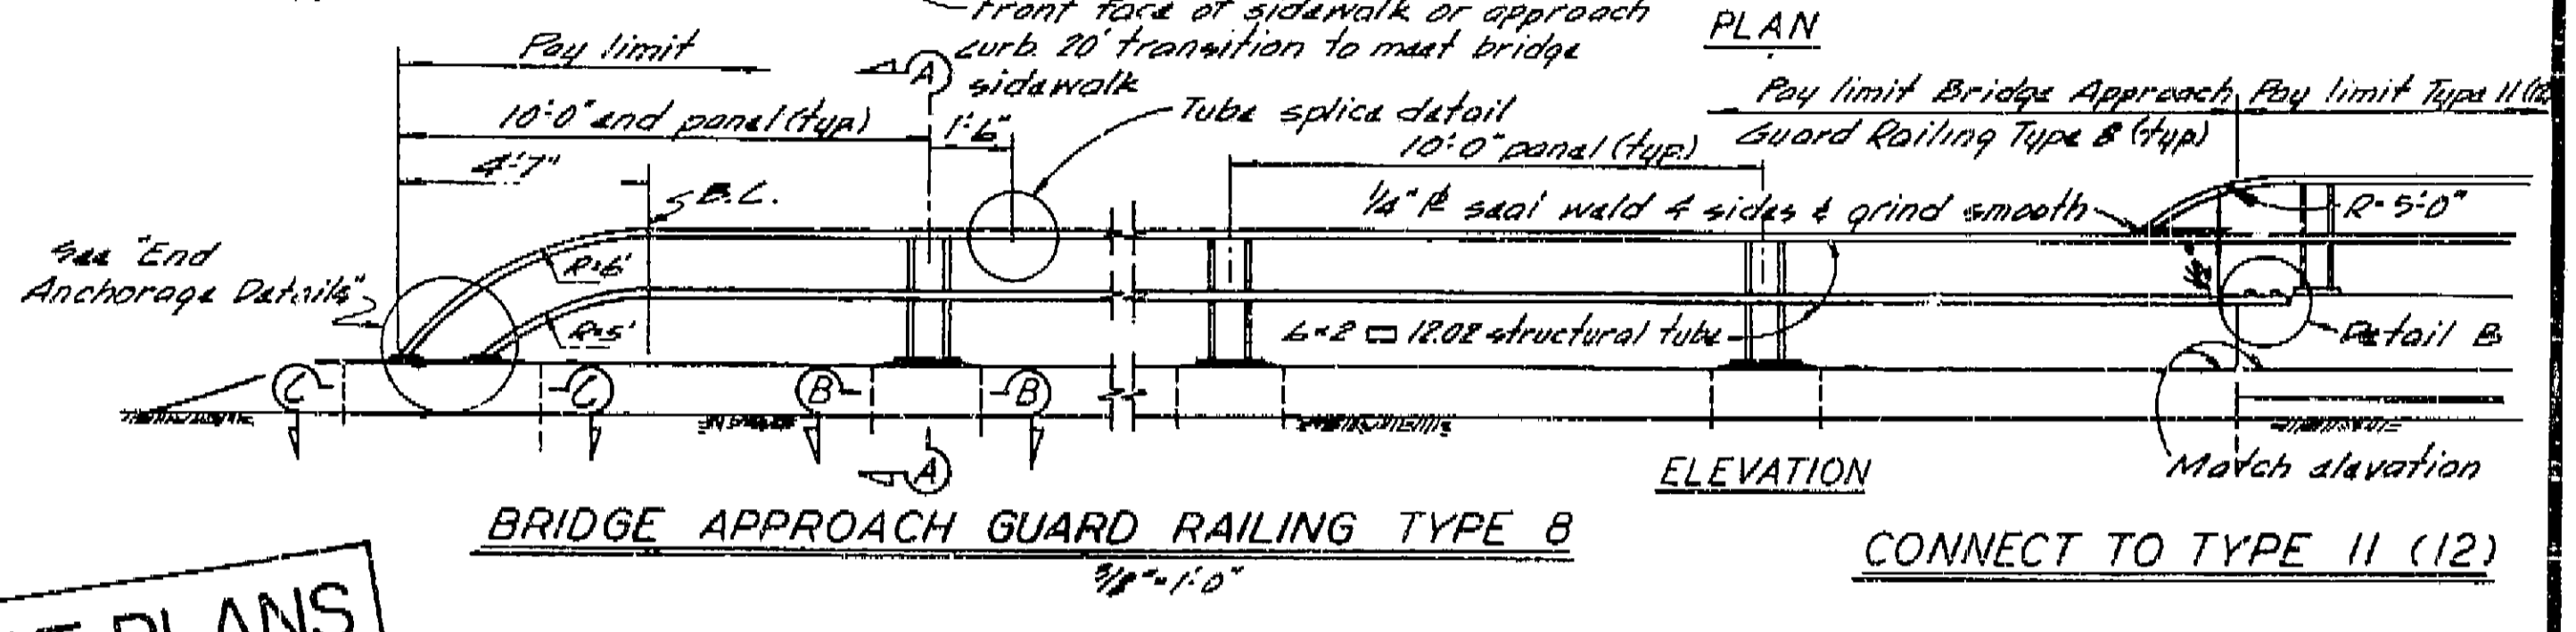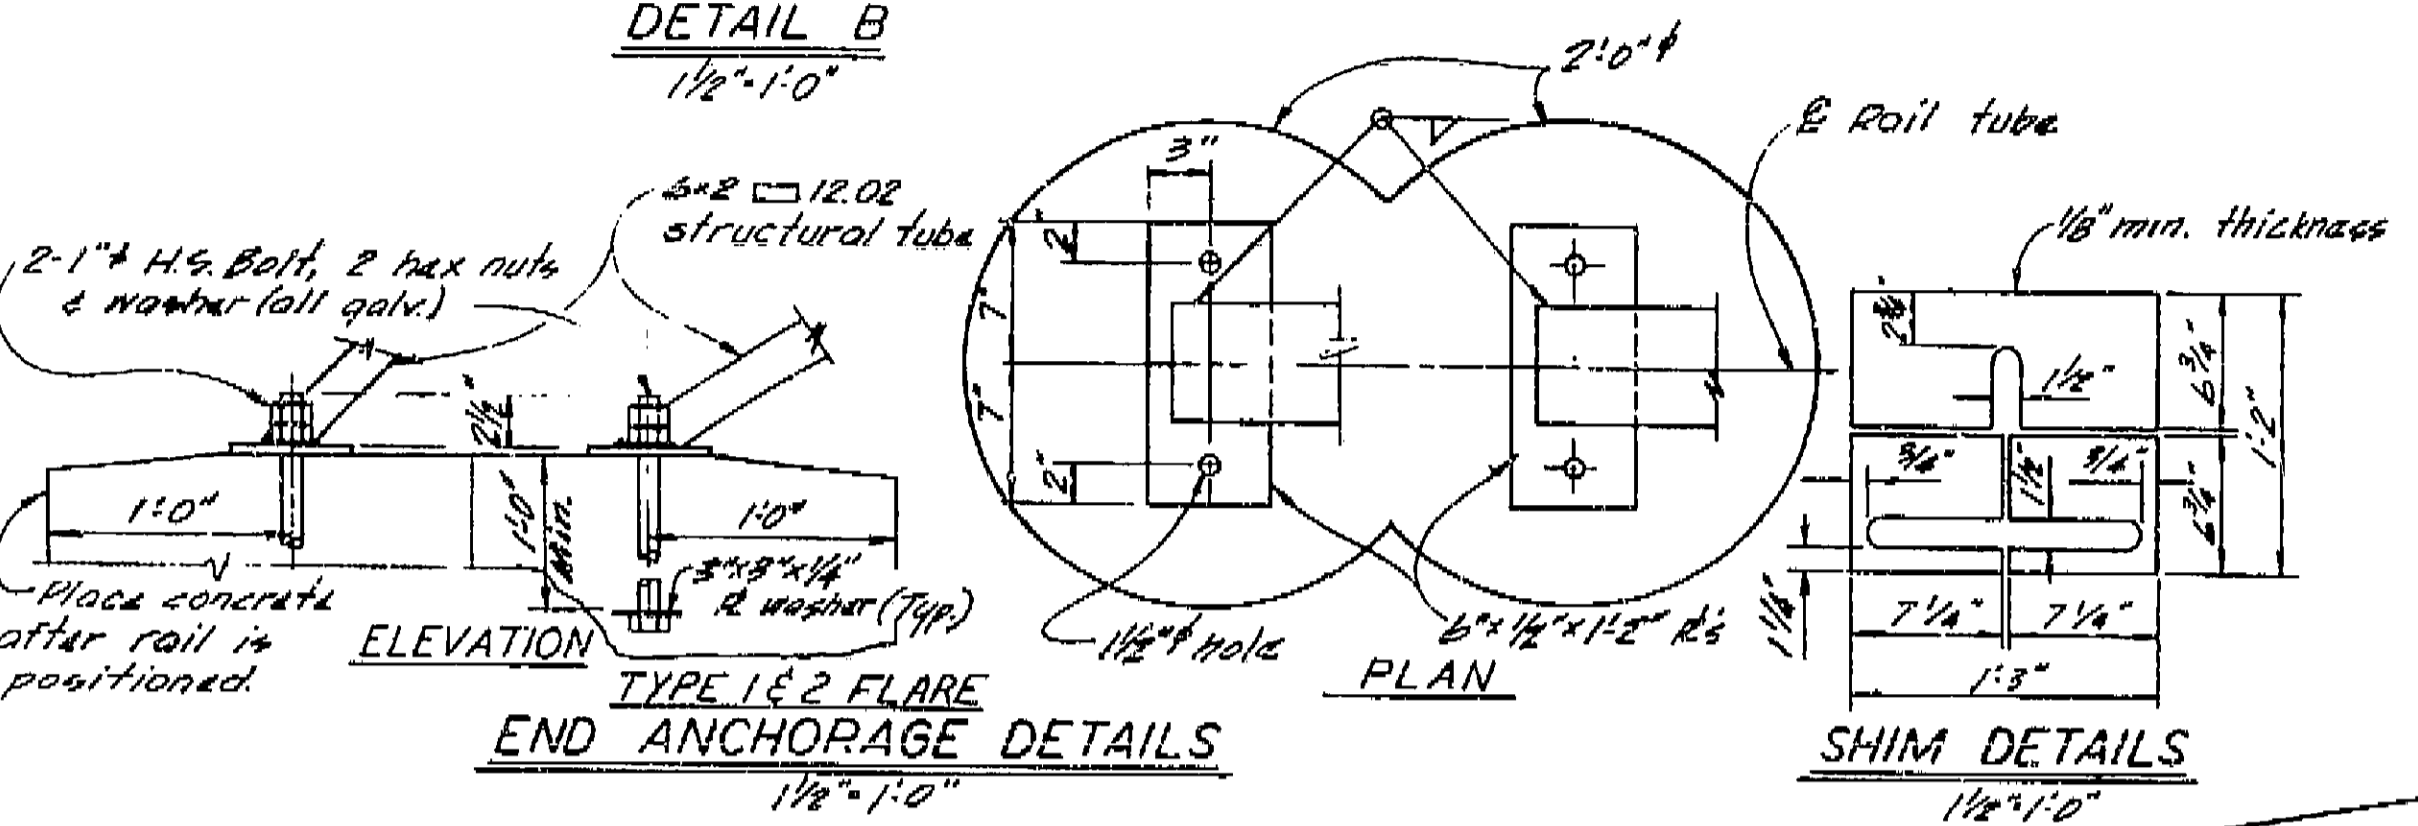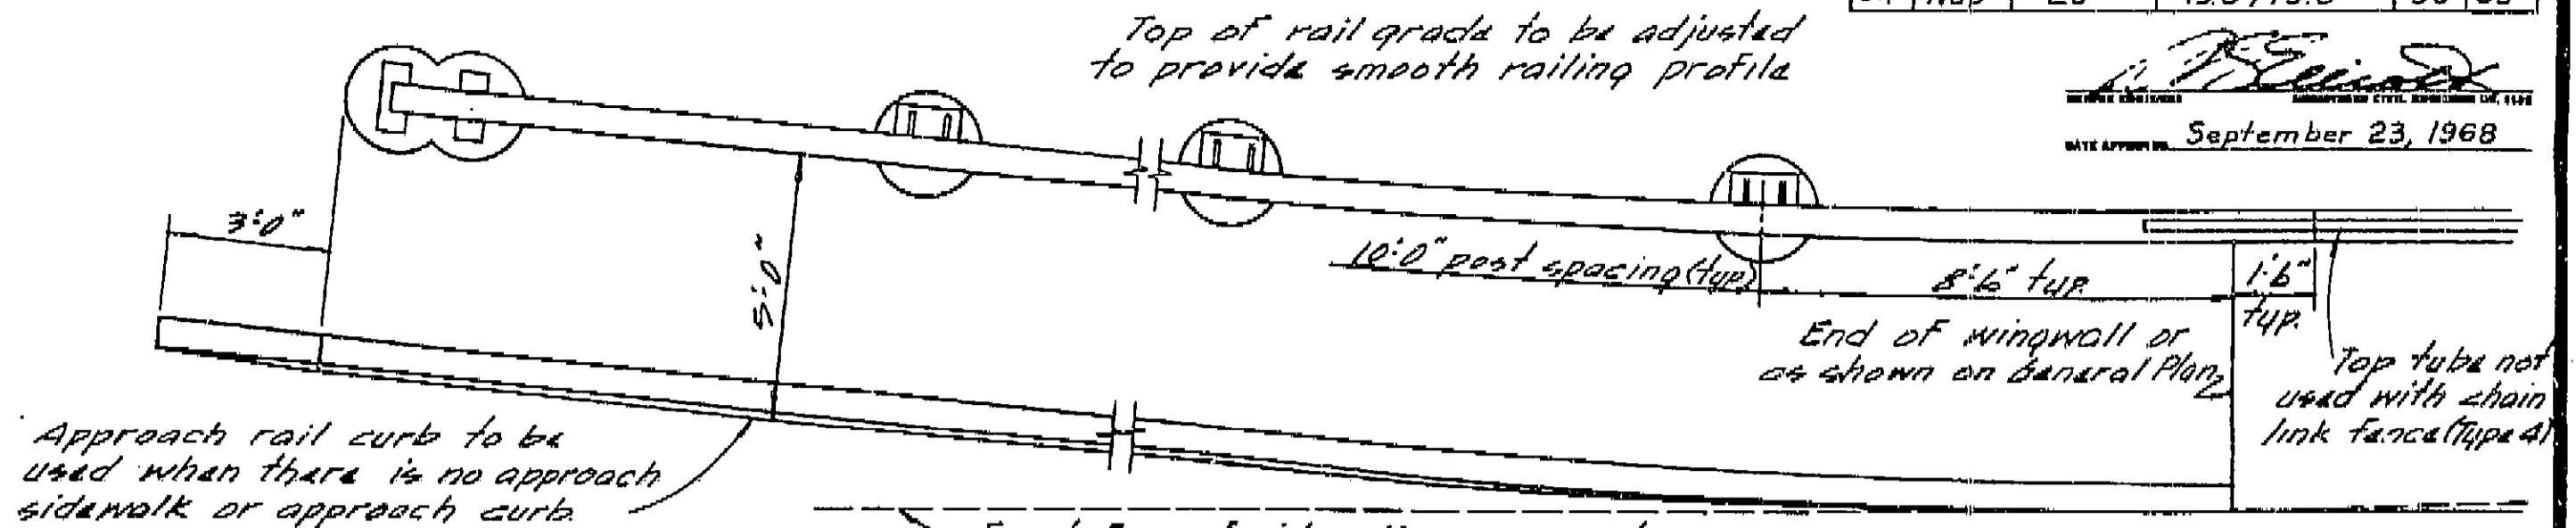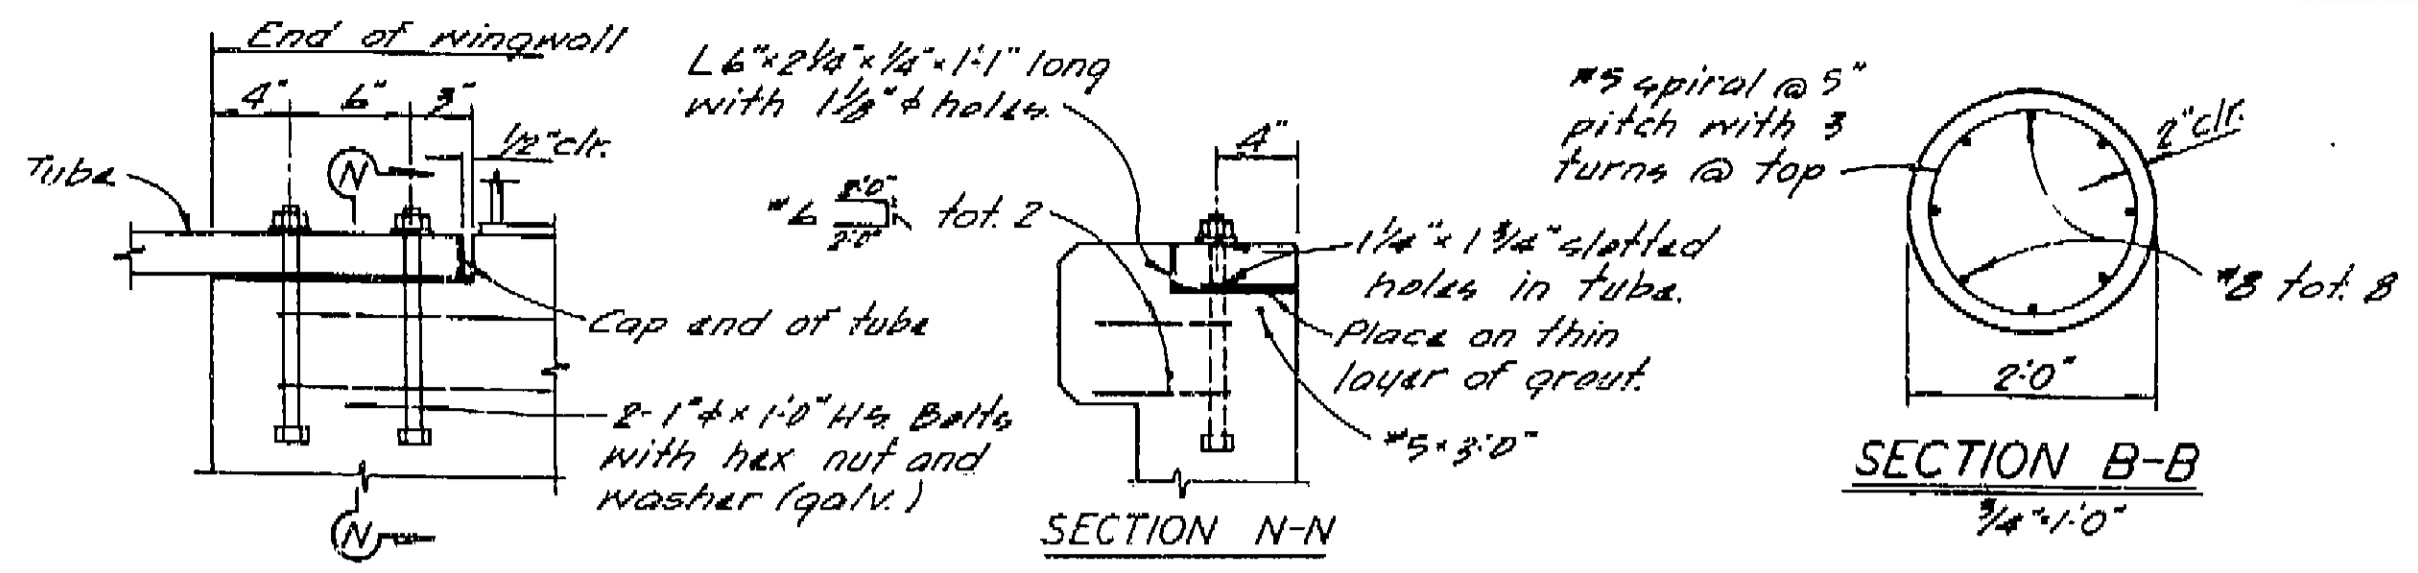


5/68	STATE OF CALIFORNIA TRANSPORTATION AGENCY DEPARTMENT OF PUBLIC WORKS DIVISION OF HIGHWAYS	XS-9-83
DRY CREEK BRIDGES		
BRIDGE APPROACH GUARD RAILING TYPE B (DETAILS)		
DESIGNED 21-14 R NO. 21C-20, 21C-21	POST MILES	DRAWN BY 11 CHECKED BY 13

WO 102131  
CU 04204




DIST.	COUNTY	ROUTE	POST MILES—TOTAL PROJECT	SHEET NO.	TOTAL SHEETS
04	Map	29	15.0/19.6	57	69


DATE APPROVED: September 23, 1968

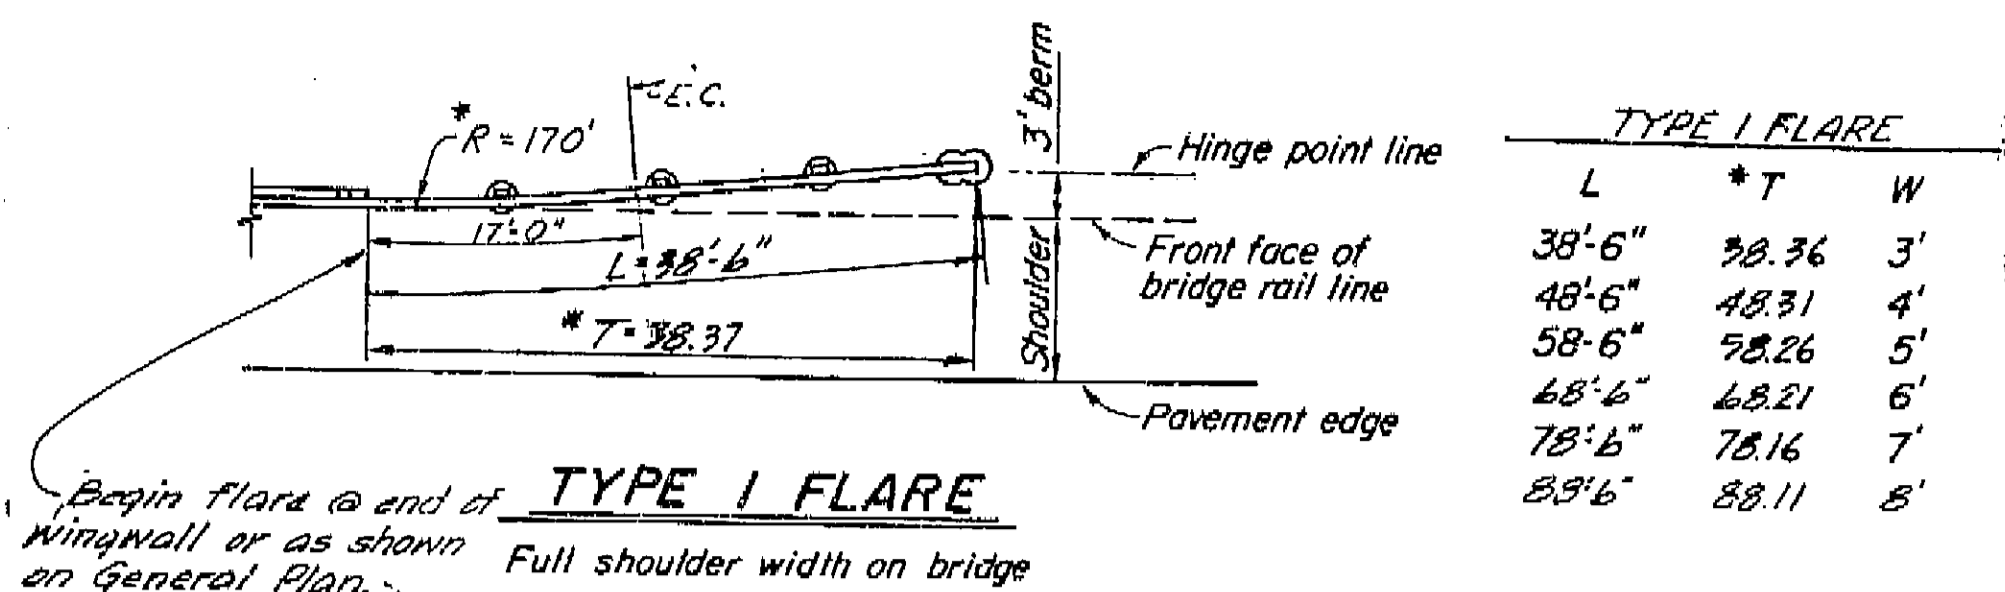

TYPE 1 FLARE		
L	*T	W
38'-6"	38.36	3'
48'-6"	48.31	4'
58'-6"	58.26	5'
68'-6"	68.21	6'
78'-6"	78.16	7'
88'-6"	88.11	8'

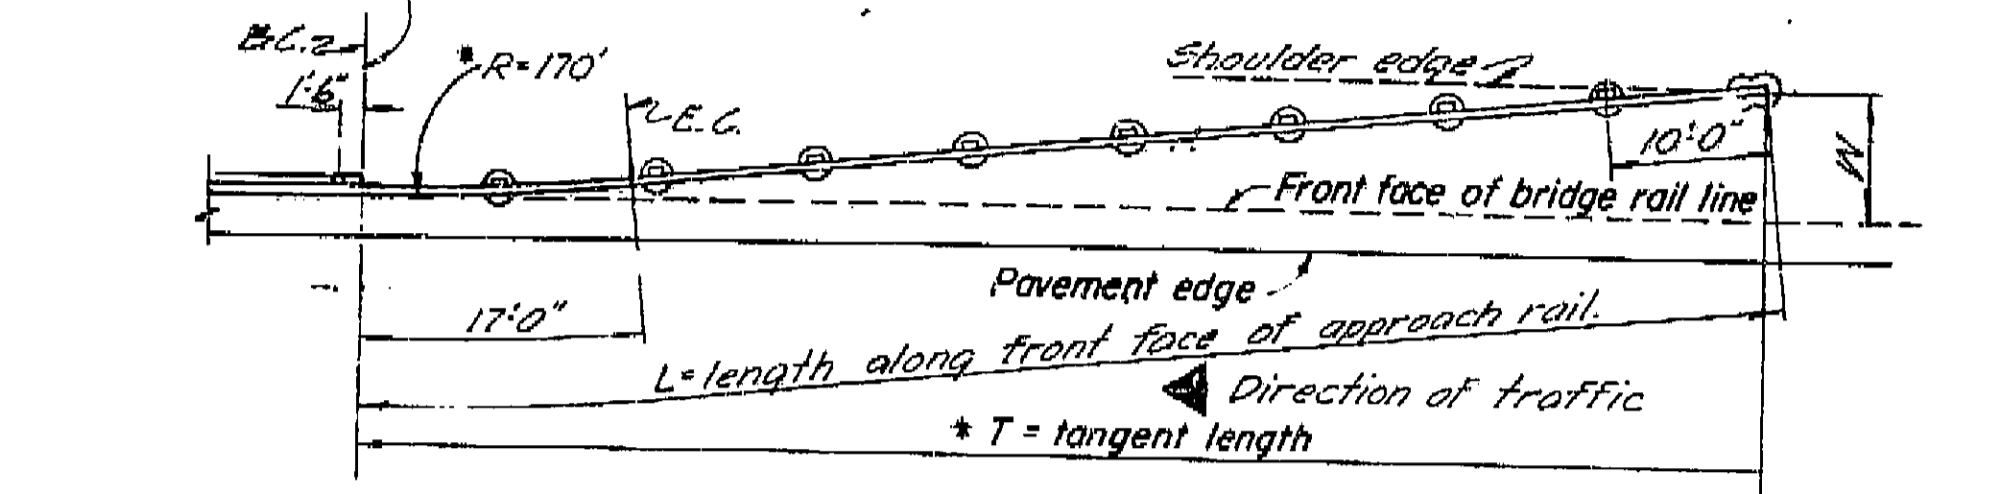


**TYPE 1 FLARE**  
Reduced shoulder width on bridge (right or left)

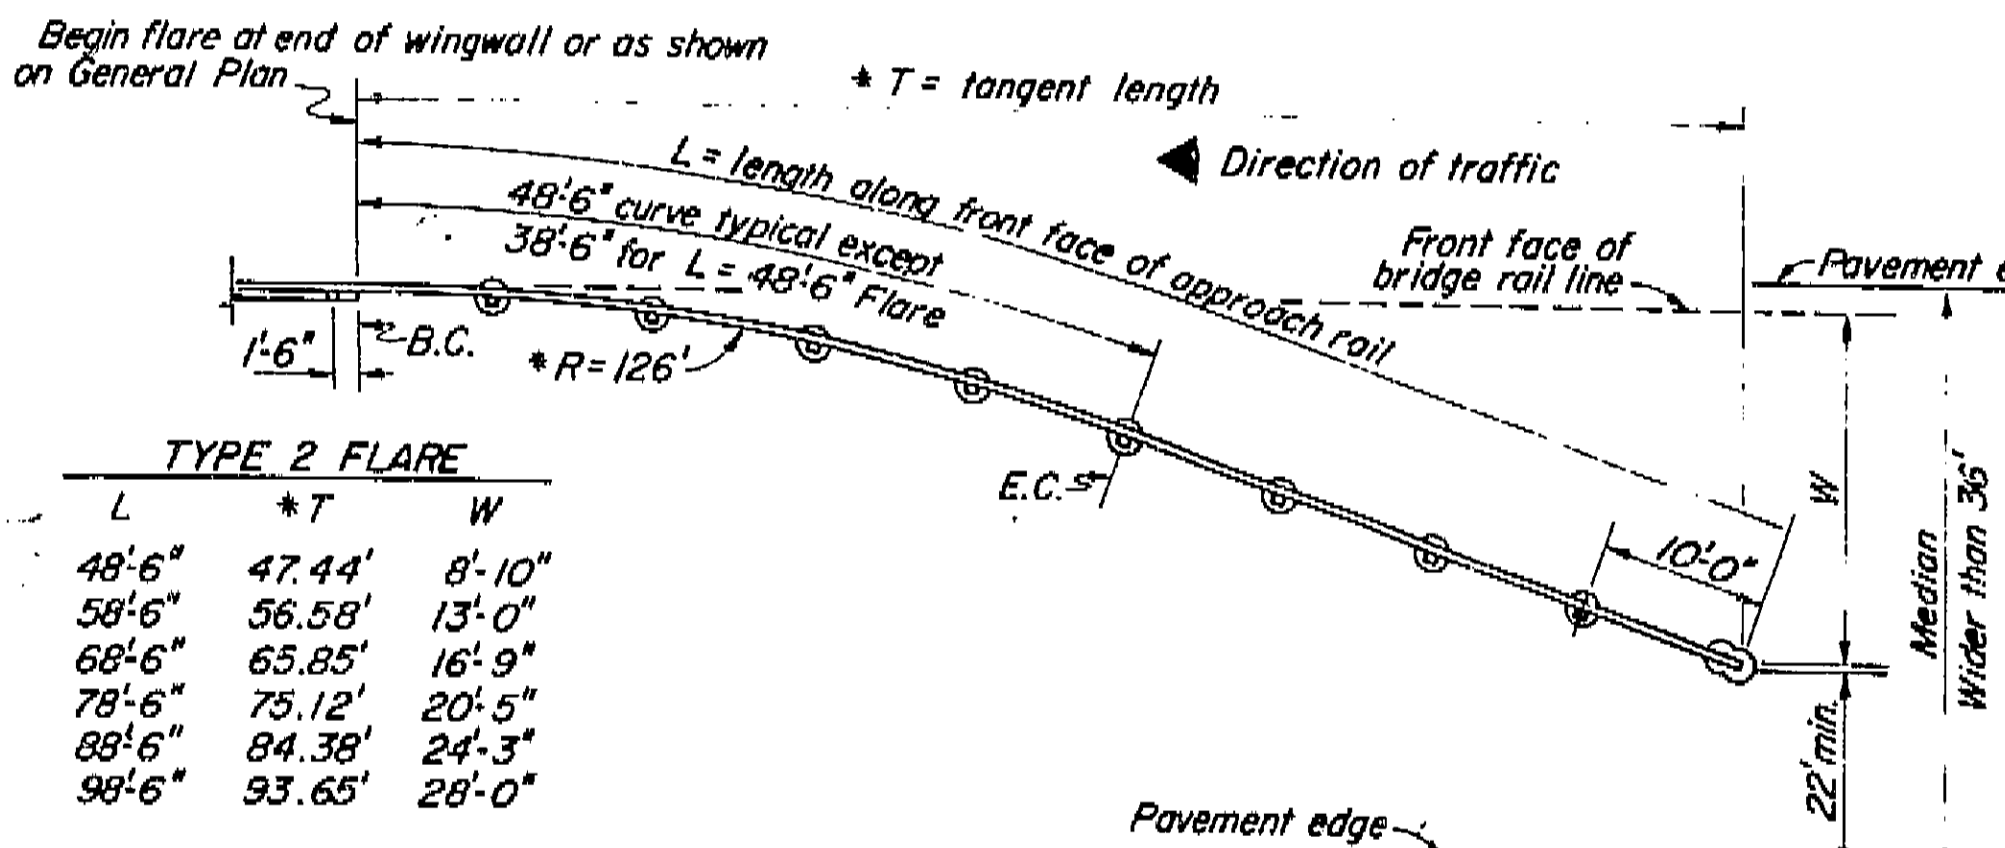


TYPE 2 FLARE		
L	*T	W
48'-6"	47.44'	8'-10"
58'-6"	56.58'	13'-0"
68'-6"	65.85'	16'-9"
78'-6"	75.12'	20'-5"
88'-6"	84.38'	24'-3"
98'-6"	93.65'	28'-0"


**TYPE 2 FLARE**  
Approach rail in median

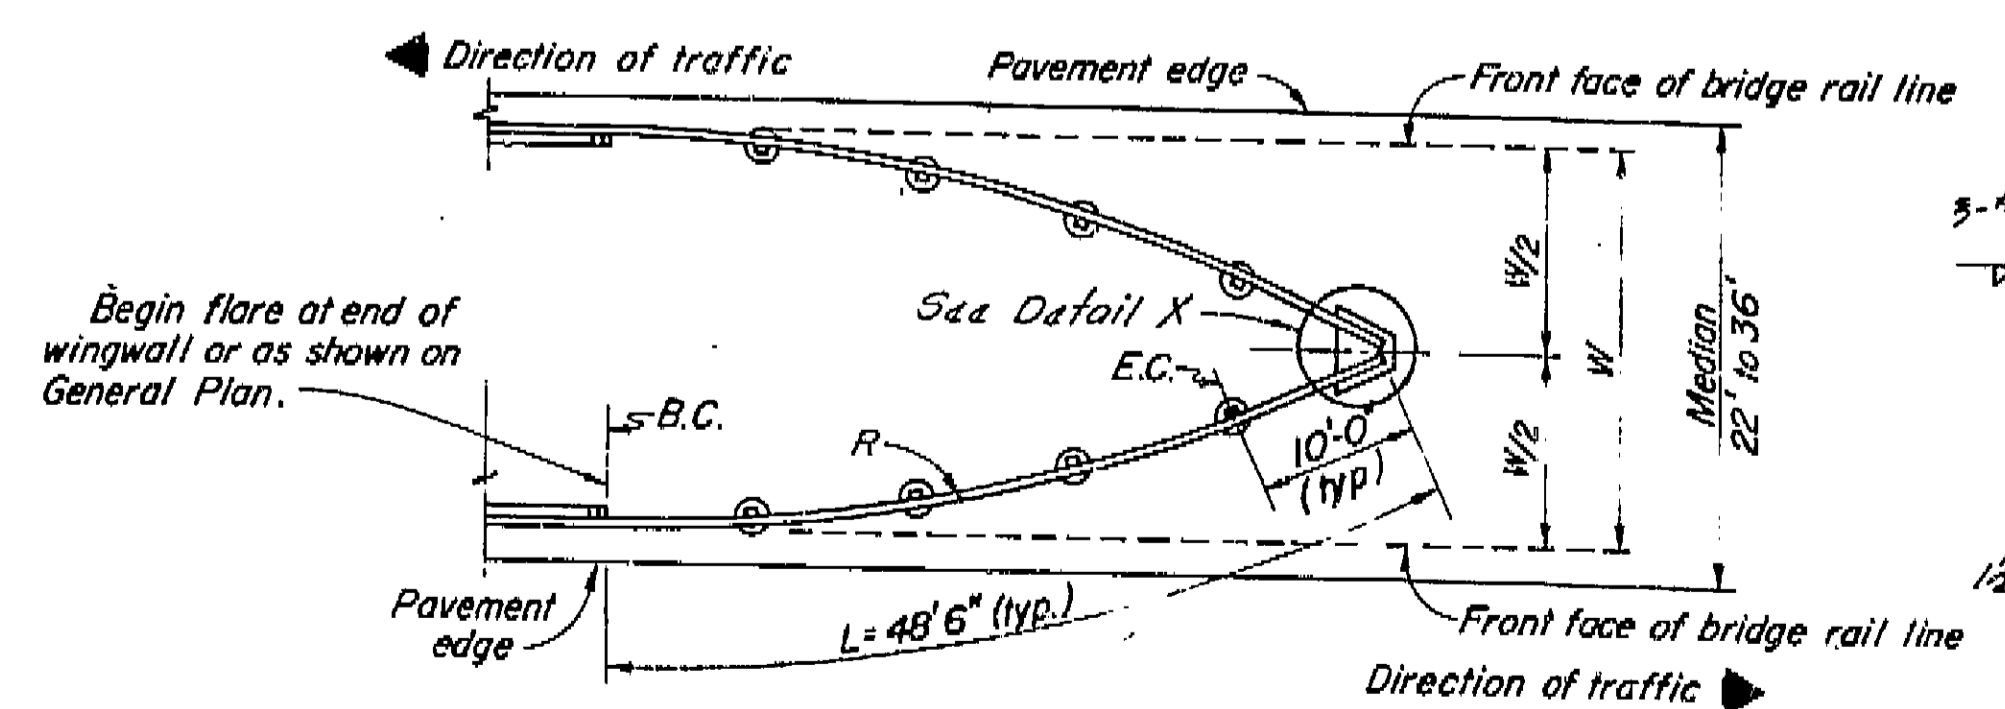

**TYPE 3 FLARE**  
Approach rail in median

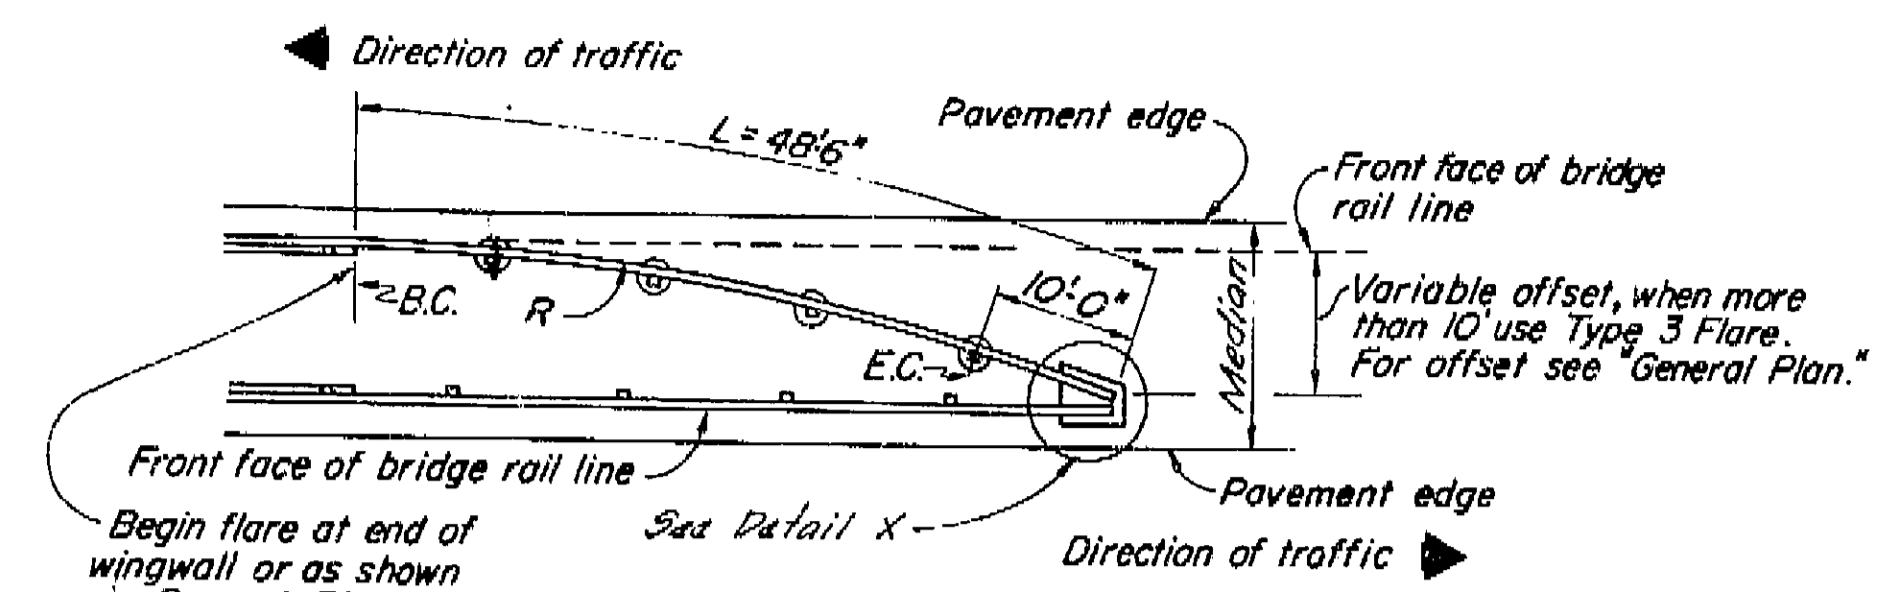


**TYPE 4 FLARE**  
Approach rail in median

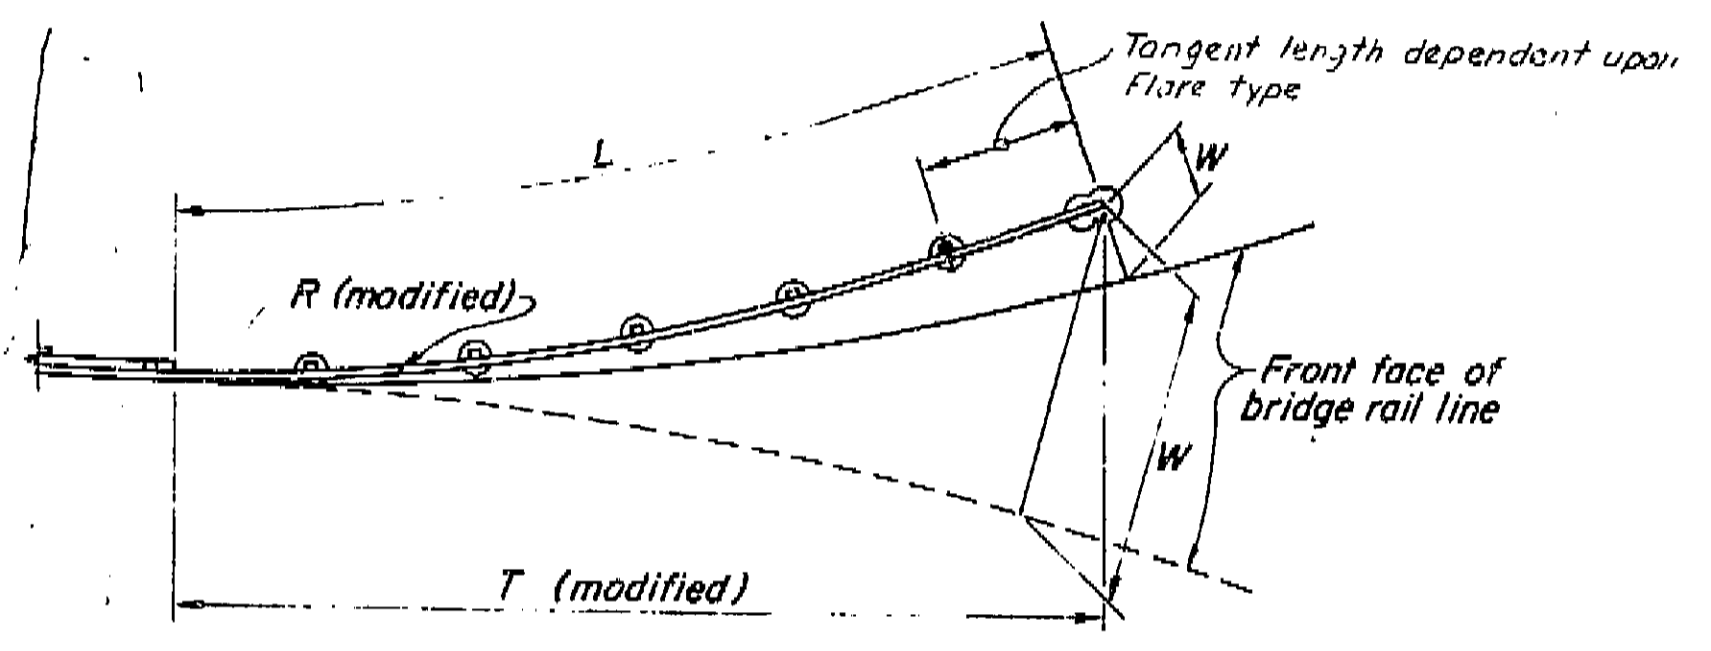

**FLARE LAYOUT ON CURVED ROADWAY**

Note: W is radial to front face of bridge rail line  
Railing shown for roadway curve to left

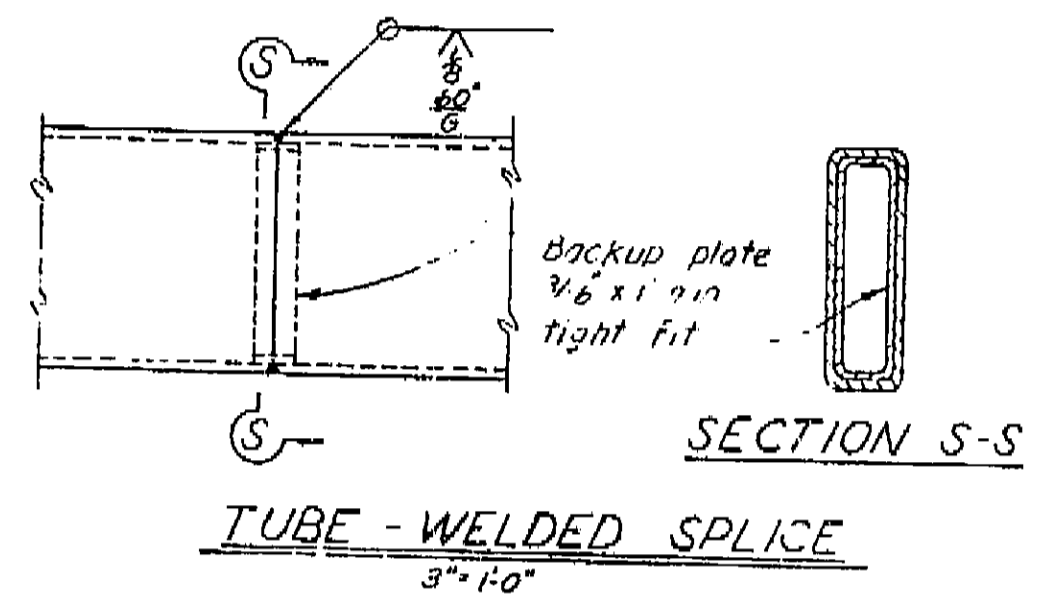


**TUBE - WELDED SPLICE**  
3'-10"

**AS BUILT PLANS**  
Contract No. 04-102134  
Date Completed \_\_\_\_\_  
Document No. 40001324

- Notes:
- A. Tubing shall be shop bent or fabricated to fit horizontal curves of less than 950' radius.
  - B. Posts shall be vertical and spaced at 10'-0" c.c. max.
  - C. Top of rail elevations to be determined by the Engineer unless shown on the plans.
  - D. Torque rail to post nuts to 175 ft. lbs.
  - E. No more than one tube splice per panel is permitted.
  - F. All exposed edges shall be ground smooth.
  - G. Galvanize rail assembly after fabrication.
  - H. For details not shown see "Barrier Railing" sheet.
  - J. Front face of bridge rail line is parallel or concentric to pavement edge.
  - K. Dimensions marked \* are valid for tangent roadway alignment only. Modify for curved roadway.
  - L. R for Type 3 & 4 Flare must be calculated for each offset.

NO AS BUILT CHANGES

**AS BUILT**  
CORRECTIONS BY L.S. Foster  
CONTRACT NO. 04-102134  
DATE 5-13-70  
7/9/70

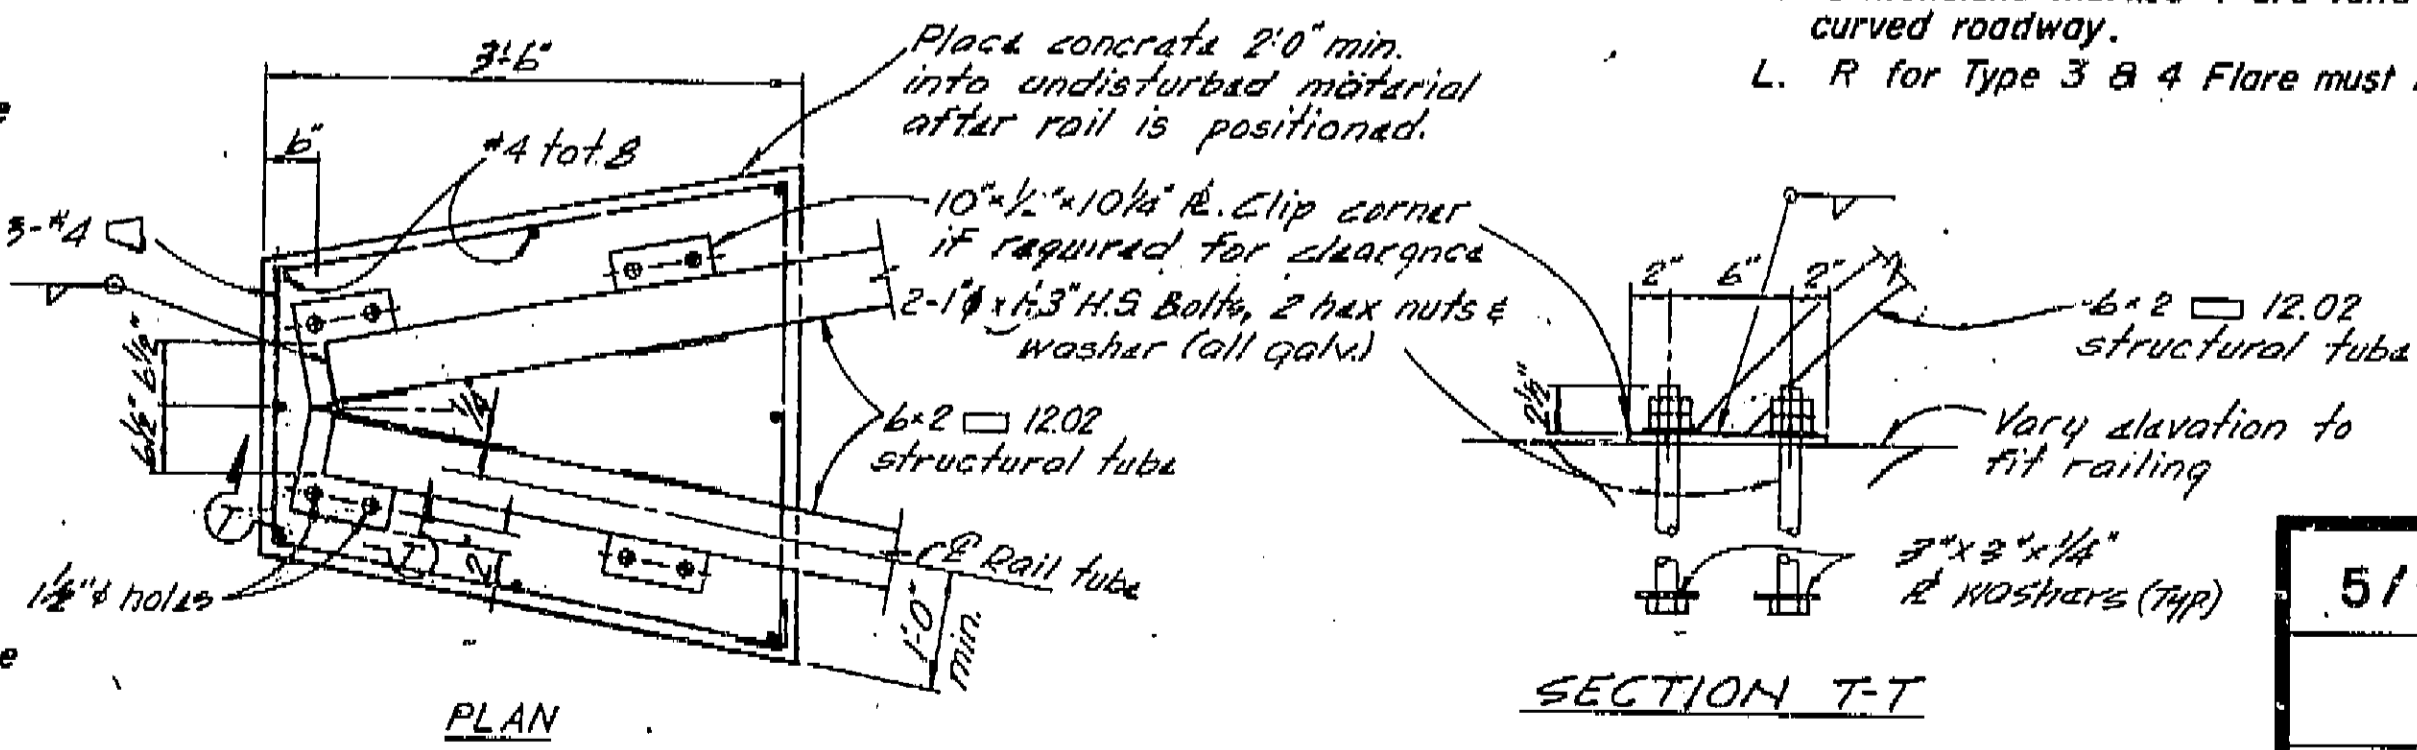

PLAN

**DETAIL X**  
No Scale

**SECTION T-T**

5/68	STATE OF CALIFORNIA TRANSPORTATION AGENCY DEPARTMENT OF PUBLIC WORKS DIVISION OF HIGHWAYS	XS-9-87
<b>DRY CREEK BRIDGES</b>		
<b>BRIDGE APPROACH GUARD RAILING TYPE 8 (LAYOUT)</b>		
BRIDGE 21-14R NO. 21C-20, 21C-21	POST MILE	DRAWING NO.
		SHEET 12 OF 13

WO 102131  
CU 04204



FED. ROAD DIST. NO.	STATE	F. A. PROJECT NO.	SHEET NO.	TOTAL SHEETS	
7	CALIF.				
DIST.	COUNTY	ROUTE	SECTION	SHEET NO.	TOTAL SHEETS
04	Nap	29	150/136	58	65

DESIGN SECTION SUPERVISOR REGISTERED CIVIL ENGINEER NO. 10104  
DATE APPROVED September 23, 1968

B.M.  
USC & G5 "Dry"  
5th disc in concrete  
77' Lt "O" 178 + 54.5  
Elev. 99.79

**AS BUILT PLANS**  
Contract No. 04-102134  
Date Completed \_\_\_\_\_  
Document No. 40001324

INFORMATION ON ALL CONDITIONS IN BRIDGE

**LEGEND OF BORING OPERATIONS**

**ROTARY BORING**  
As shown on this sheet, rotary borings are made with a 4" diameter bit, 2" diameter sampler, and 2" diameter core barrel. The sampler is of the "open" type and is used to obtain samples of soil for laboratory tests. The core barrel is used to obtain continuous cores of soil for field tests.

**1" SOIL TUBE**  
As shown on this sheet, 1" soil tubes are obtained by driving a 1" diameter sampler into the soil. The sampler is of the "open" type and is used to obtain samples of soil for laboratory tests.

**TEST PIT**  
As shown on this sheet, test pits are excavated to a depth of 3 feet below the ground surface. The soil is then classified according to the Unified Soil Classification System (USCS).


**LEGEND OF EARTH MATERIALS**

SILTY CLAY OR CLAYEY SILT  
ORGANIC MATTER  
FILL MATERIAL  
IGNEOUS ROCK  
SEDIMENTARY ROCK  
METAMORPHIC ROCK



GRAVEL  
SAND  
SILT  
CLAY  
SANDY CLAY OR CLAYEY SAND  
SANDY SILT OR SILTY SAND

**CLASSIFICATION OF MATERIAL BASED ON STANDARD GRADE SIZE LIMITS**

Diagram shows the basis for estimating limits of class name. If gravel is present in appreciable amounts the term "GRAVELLY" may be used. If sand is present in appreciable amounts the term "SANDY" may be used. The terms "COARSE", "MEDIUM", and "FINE" refer to the size of the sand, silt, and clay particles.

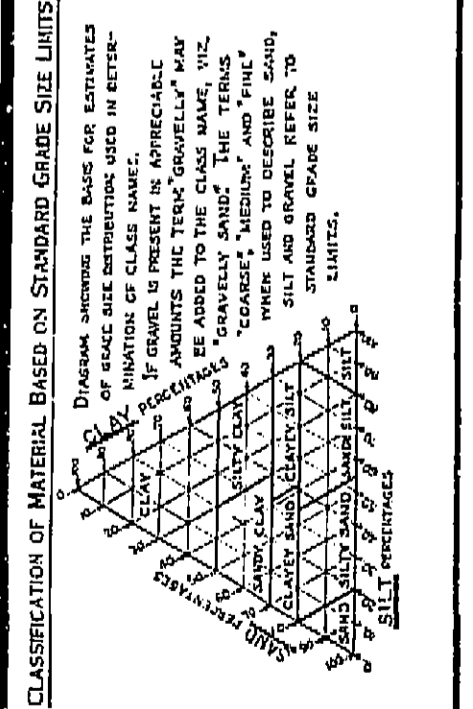

NOTE: Classification of earth material as shown on this sheet is based upon field inspection and is not to be construed to imply mechanical analysis.

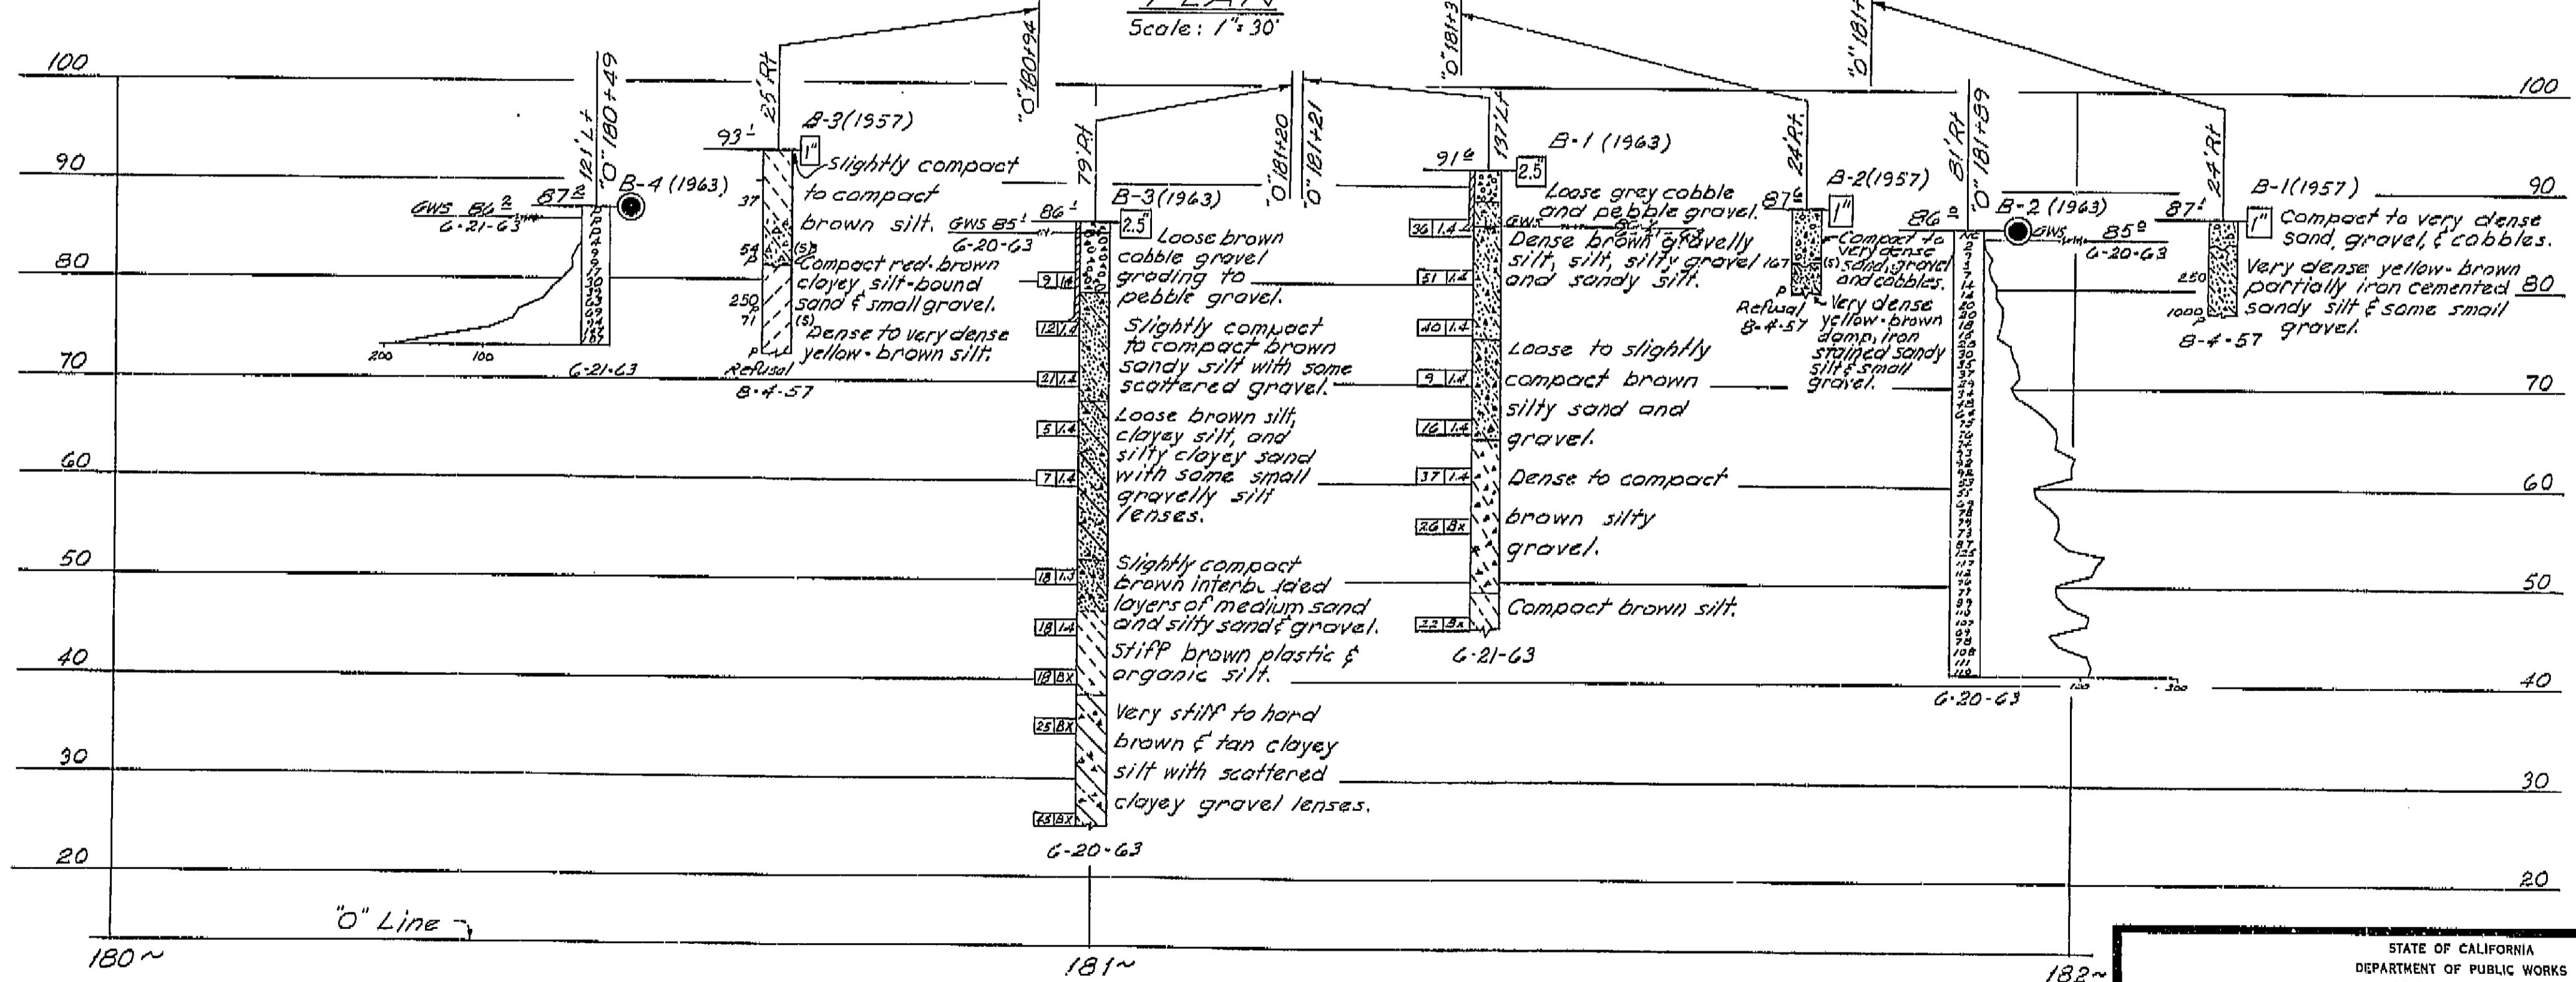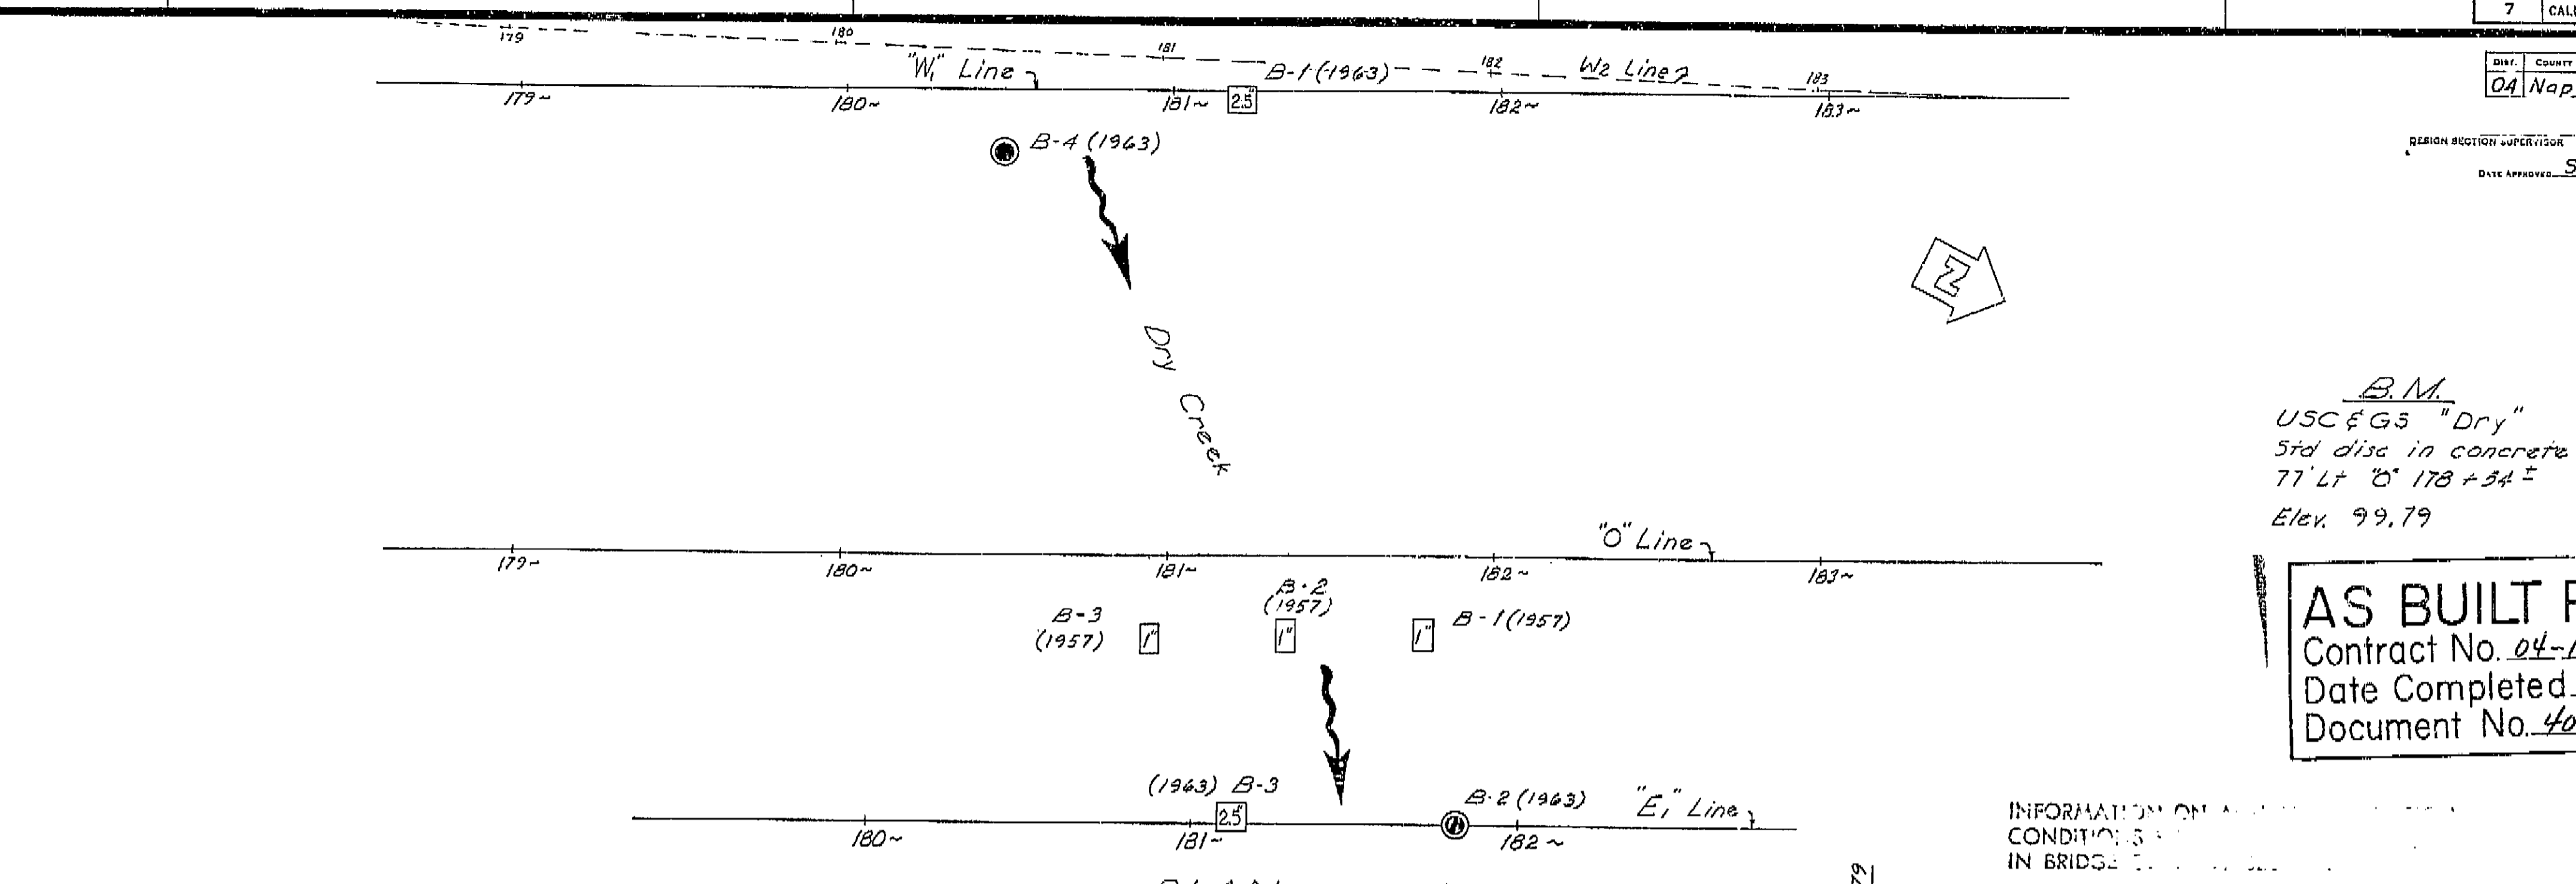

**PROFILE**  
Scale: 1" = 10'

STATE OF CALIFORNIA  
DEPARTMENT OF PUBLIC WORKS  
DIVISION OF HIGHWAYS

**DRY CREEK BRIDGES**

**LOG OF TEST BORINGS**



SCALE As Noted  
21C-20, 21-14R  
BRIDGE 21C-21 FILE DRAWING 2/14-14

PREL. DRAWING NO. PR-2/14-14

WO 102131  
CU 04204

**Attachment 3: 2014 Onsite Survey**



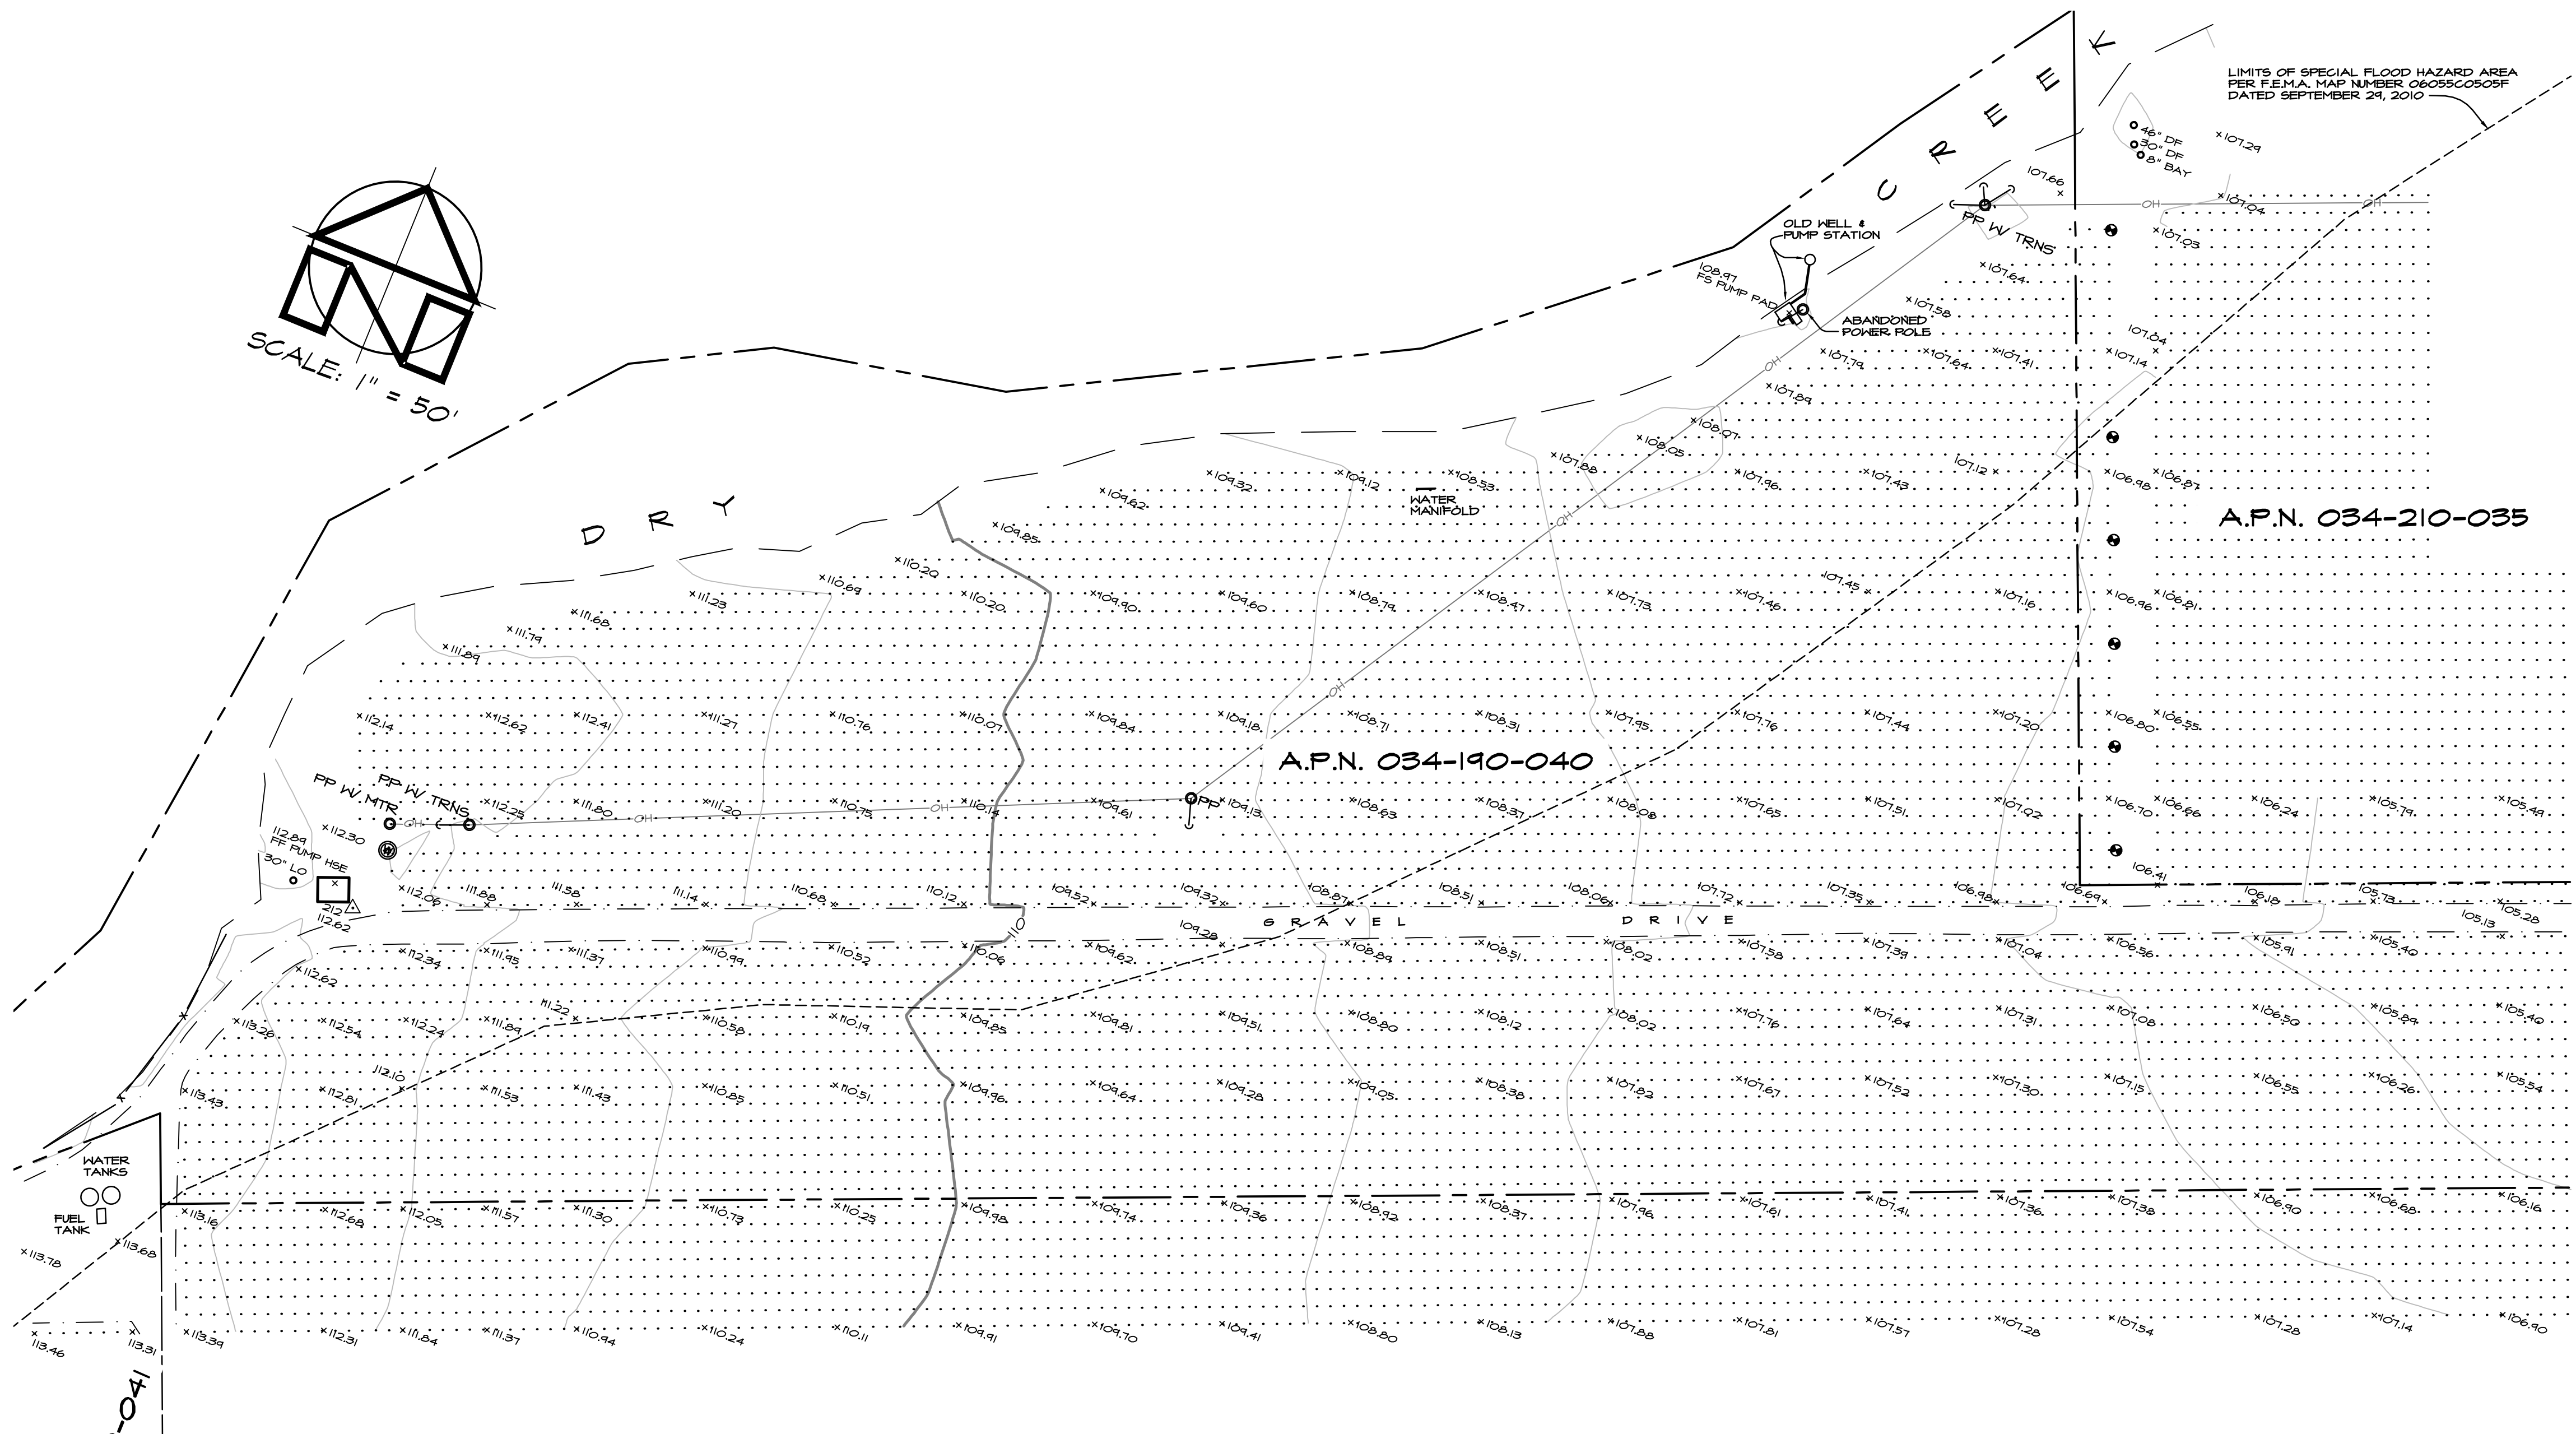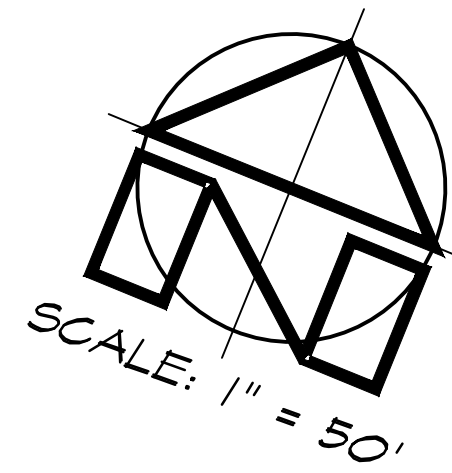

A.P.N. 034-190-041

A.P.N. 034-190-042


A.P.N. 034-210-035

**LEGEND**

.....	VINEYARD	—	SIGN
— x —	WIRE FENCE	⊙	WELL
---	TOE OF BANK	←	GUY WIRE
---	TOP OF BANK	○	UTILITY POLE
---	PROPERTY LINE	⊕	WATER VALVE
---	EDGE OF ROAD	○ 10' TREE	TREE (AS NOTED)
— o —	CHAINLINK FENCE	△	SURVEY CONTROL STATION
---	FLOOD HAZARD LINE		
— OH —	OVERHEAD UTILITY LINES		
---	UNDERGROUND COMMUNICATIONS MARKINGS		

**NOTES**

1. BENCHMARK: CITY OF NAPA BM #1165. ELEVATION = 75.89' (NAVD 1988) PUBLISHED ELEVATION = 73.27 (NGVD 1929).
2. CONTOURS ARE SHOWN EVERY ONE FOOT (1'), HIGHLIGHTED EVERY FIVE FEET (5').
3. TREES ADJACENT TO THE TOP OF BANK OF DRY CREEK WERE NOT LOCATED ON THIS SURVEY.

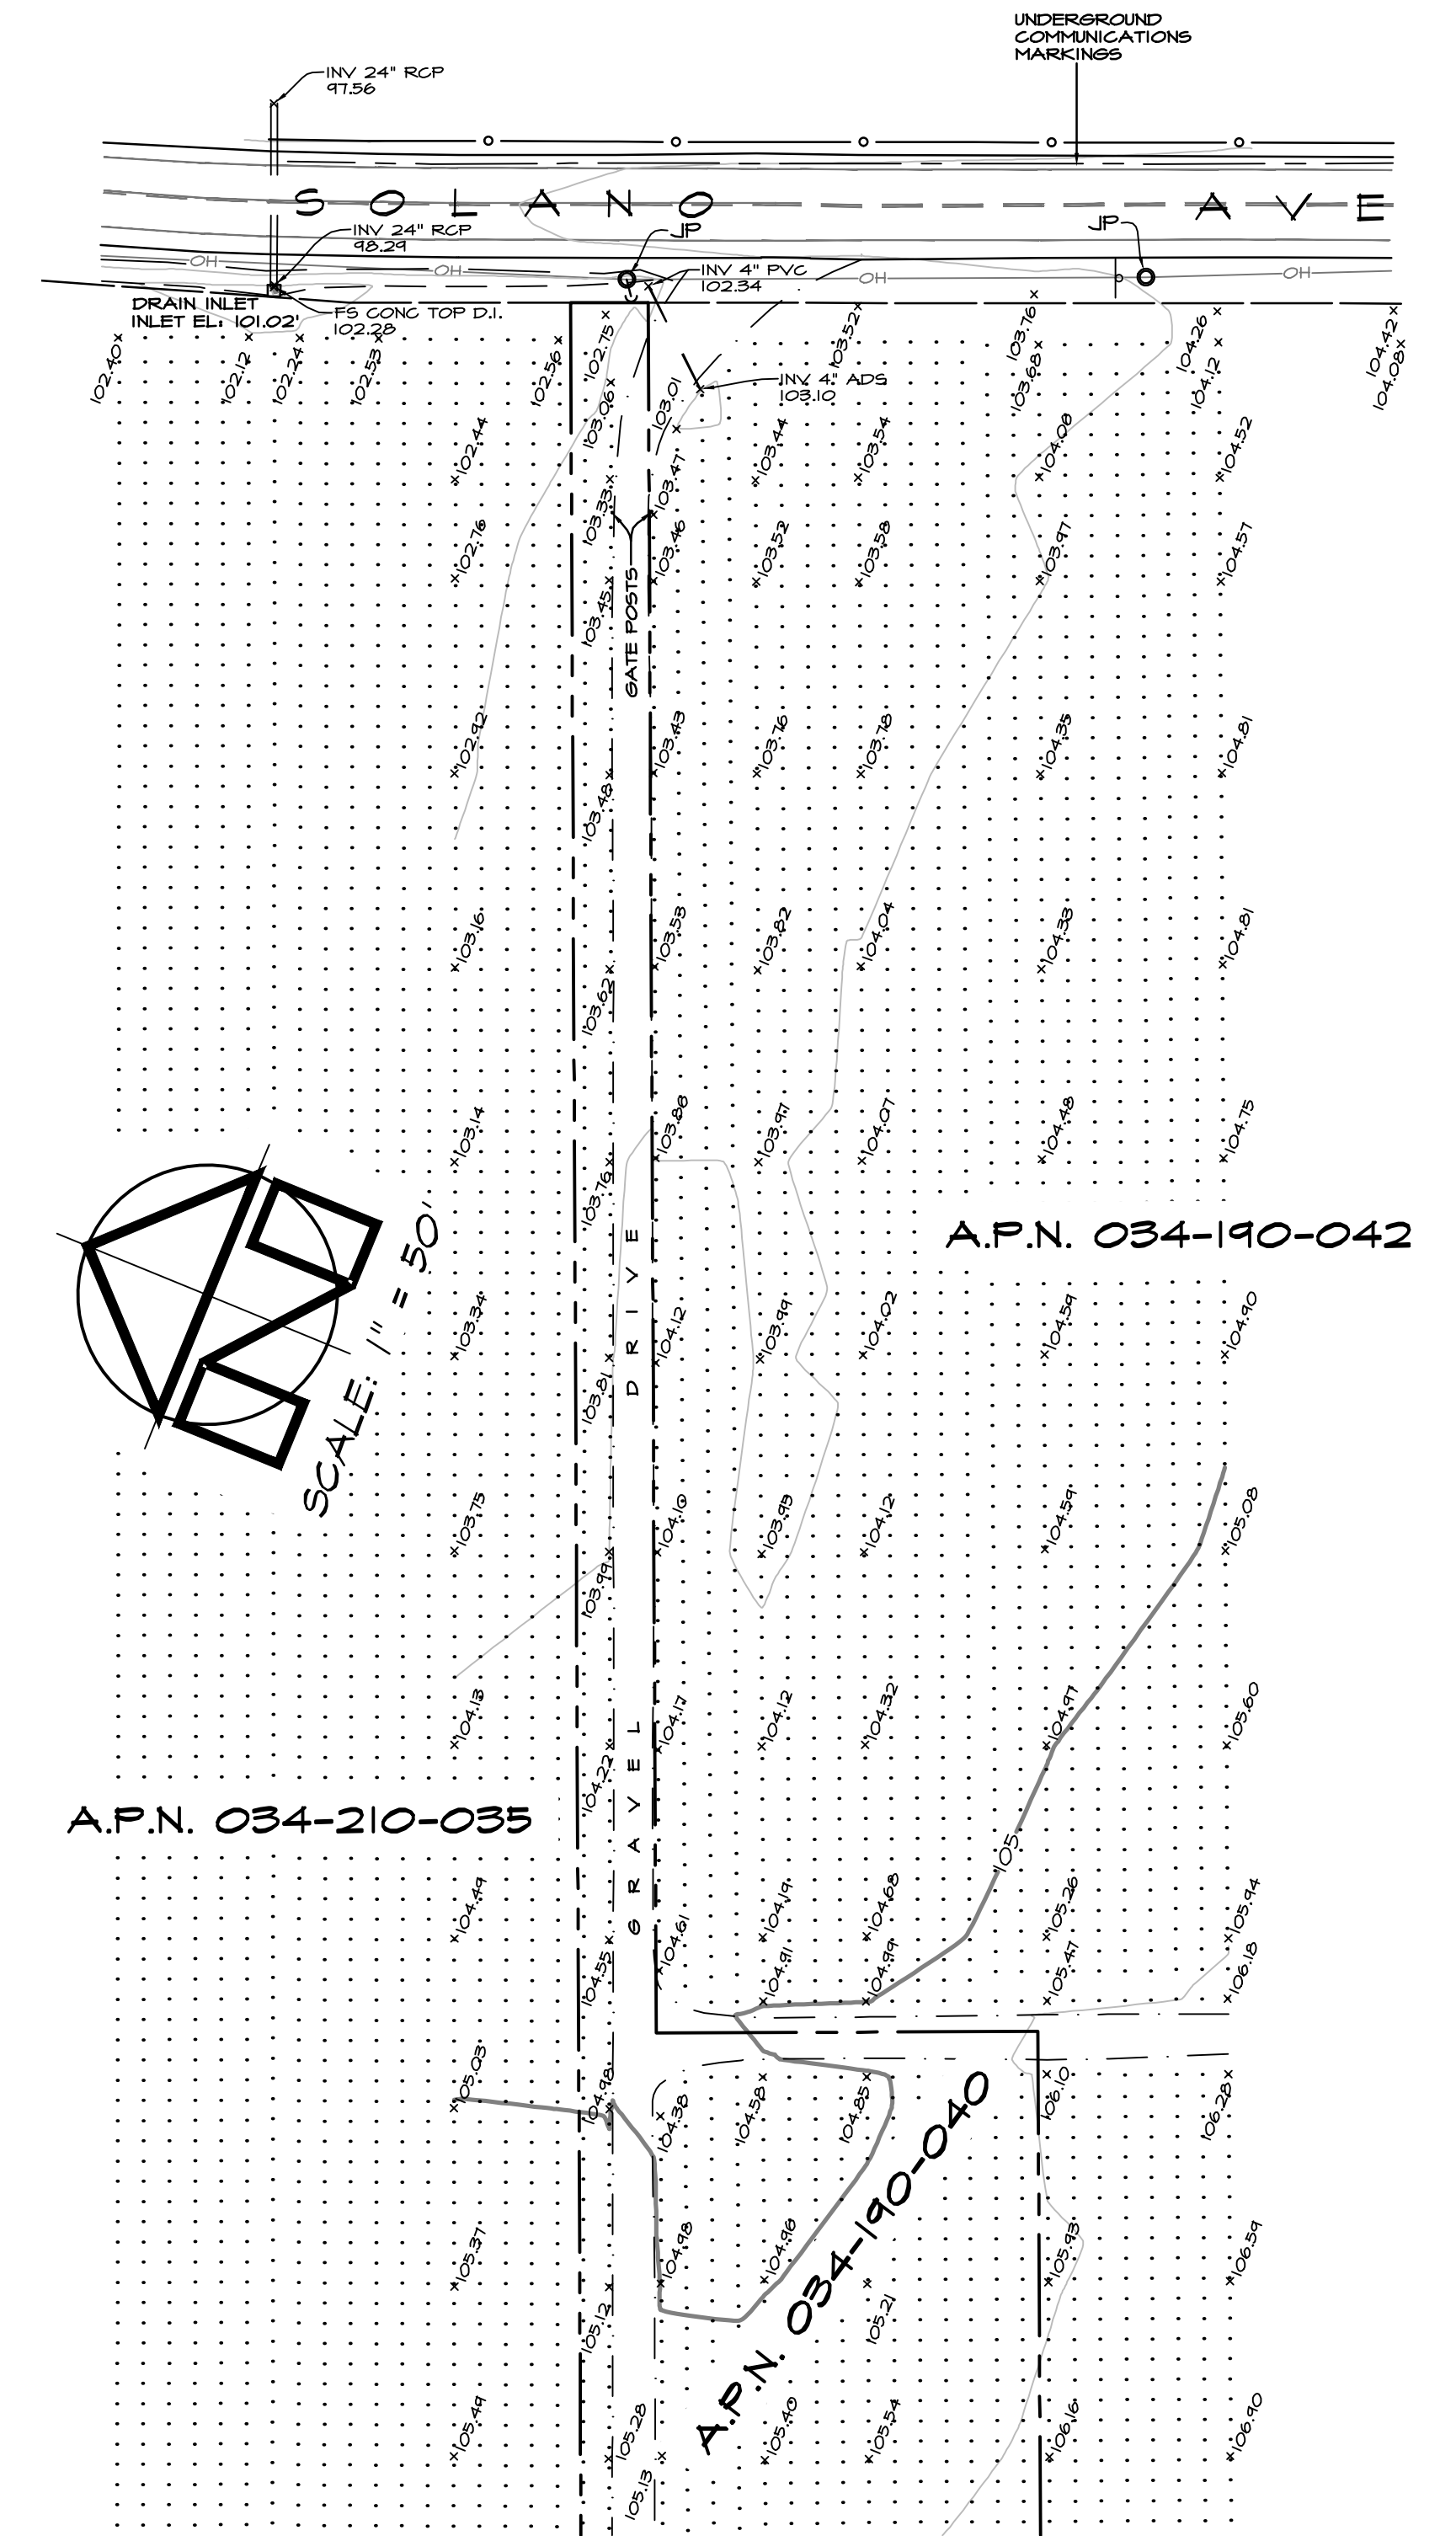


A.P.N. 034-210-035

A.P.N. 034-190-042

A.P.N. 034-190-040

**TOPOGRAPHIC MAP**  
 OF A PORTION OF THE LANDS OF  
**L'ATTITUDE VINEYARDS, LLC**  
 A.P.N. 034-190-040  
 NAPA COUNTY, CALIFORNIA  
 PREPARED BY:

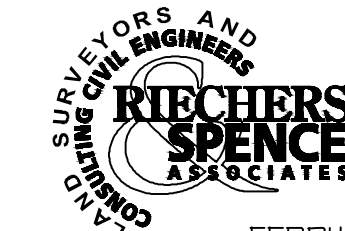

1515 Fourth Street  
 Napa, Calif. 94554  
 v 707.252.3301  
 f 707.252.4466

**Attachment 4: LOMA 14-09-0308A-06025**





# Federal Emergency Management Agency

Washington, D.C. 20472

## LETTER OF MAP AMENDMENT DETERMINATION DOCUMENT (REMOVAL)

COMMUNITY AND MAP PANEL INFORMATION		LEGAL PROPERTY DESCRIPTION
COMMUNITY	NAPA COUNTY, CALIFORNIA (Unincorporated Areas)	A parcel of land, as described in the Grant Deed recorded as Document No. 2013-0004244, in the Office of the Recorder, Napa County, California (APN:034-212-011)
	COMMUNITY NO.: 060205	
AFFECTED MAP PANEL	NUMBER: 06055C0505F DATE: 9/29/2010	
FLOODING SOURCE: DRY CREEK		APPROXIMATE LATITUDE & LONGITUDE OF PROPERTY: 38.363, -122.343 SOURCE OF LAT & LONG: GOOGLE EARTH PRO DATUM: NAD 83

### DETERMINATION

LOT	BLOCK/ SECTION	SUBDIVISION	STREET	OUTCOME WHAT IS REMOVED FROM THE SFHA	FLOOD ZONE	1% ANNUAL CHANCE FLOOD ELEVATION (NAVD 88)	LOWEST ADJACENT GRADE ELEVATION (NAVD 88)	LOWEST LOT ELEVATION (NAVD 88)
--	--	--	1088 Darms Lane	Structure (Residence)	X (unshaded)	106.2 feet	110.5 feet	--

**Special Flood Hazard Area (SFHA)** - The SFHA is an area that would be inundated by the flood having a 1-percent chance of being equaled or exceeded in any given year (base flood).

ADDITIONAL CONSIDERATIONS (Please refer to the appropriate section on Attachment 1 for the additional considerations listed below.)

DETERMINATION TABLE (CONTINUED)  
PORTIONS REMAIN IN THE SFHA  
ZONE A

This document provides the Federal Emergency Management Agency's determination regarding a request for a Letter of Map Amendment for the property described above. Using the information submitted and the effective National Flood Insurance Program (NFIP) map, we have determined that the structure(s) on the property(ies) is/are not located in the SFHA, an area inundated by the flood having a 1-percent chance of being equaled or exceeded in any given year (base flood). This document amends the effective NFIP map to remove the subject property from the SFHA located on the effective NFIP map; therefore, the Federal mandatory flood insurance requirement does not apply. However, the lender has the option to continue the flood insurance requirement to protect its financial risk on the loan. A Preferred Risk Policy (PRP) is available for buildings located outside the SFHA. Information about the PRP and how one can apply is enclosed.

This determination is based on the flood data presently available. The enclosed documents provide additional information regarding this determination. If you have any questions about this document, please contact the FEMA Map Assistance Center toll free at (877) 336-2627 (877-FEMA MAP) or by letter addressed to the Federal Emergency Management Agency, LOMC Clearinghouse, 847 South Pickett Street, Alexandria, VA 22304-4605.

Luis Rodriguez, P.E., Chief  
Engineering Management Branch  
Federal Insurance and Mitigation Administration



# Federal Emergency Management Agency

Washington, D.C. 20472

## LETTER OF MAP AMENDMENT DETERMINATION DOCUMENT (REMOVAL)

ATTACHMENT 1 (ADDITIONAL CONSIDERATIONS)

### DETERMINATION TABLE (CONTINUED)

LOT	BLOCK/ SECTION	SUBDIVISION	STREET	OUTCOME WHAT IS REMOVED FROM THE SFHA	FLOOD ZONE	1% ANNUAL CHANGE FLOOD ELEVATION (NAVD 88)	LOWEST ADJACENT GRADE ELEVATION (NAVD 88)	LOWEST LOT ELEVATION (NAVD 88)
--	--	--	1088 Darms Lane	Structure (Garage)	X (unshaded)	106.2 feet	111.3 feet	--

### PORTIONS OF THE PROPERTY REMAIN IN THE SFHA (This Additional Consideration applies to the preceding 2 Properties.)

Portions of this property, but not the subject of the Determination/Comment document, may remain in the Special Flood Hazard Area. Therefore, any future construction or substantial improvement on the property remains subject to Federal, State/Commonwealth, and local regulations for floodplain management.

### ZONE A (This Additional Consideration applies to the preceding 2 Properties.)

The National Flood Insurance Program map affecting this property depicts a Special Flood Hazard Area that was determined using the best flood hazard data available to FEMA, but without performing a detailed engineering analysis. The flood elevation used to make this determination is based on approximate methods and has not been formalized through the standard process for establishing base flood elevations published in the Flood Insurance Study. This flood elevation is subject to change.

This attachment provides additional information regarding this request. If you have any questions about this attachment, please contact the FEMA Map Assistance Center toll free at (877) 336-2627 (877-FEMA MAP) or by letter addressed to the Federal Emergency Management Agency, LOMC Clearinghouse, 847 South Pickett Street, Alexandria, VA 22304-4605.


Luis Rodriguez, P.E., Chief  
Engineering Management Branch  
Federal Insurance and Mitigation Administration



## Attachment 5: HEC-RAS Cross Sections

HEC-RAS Model Plan: ExistingNapaBE

River = Dry Creek Reach = Dry Creek RS = 5292

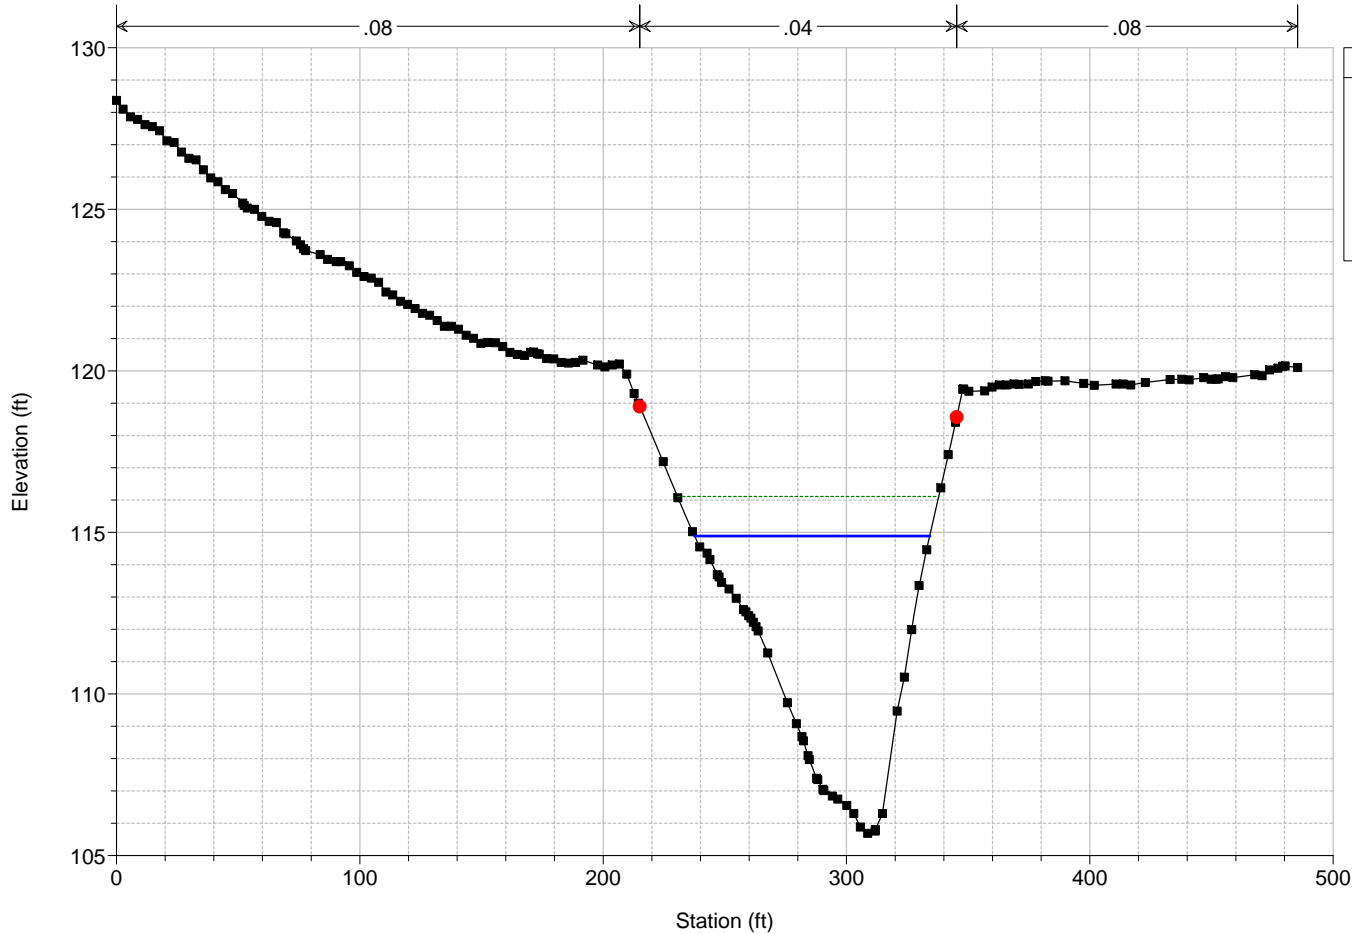


**Legend**

- EG 100yr\_Gage
- WS 100yr\_Gage
- Ground
- Bank Sta

HEC-RAS Model Plan: ExistingNapaBE

River = Dry Creek Reach = Dry Creek RS = 4499

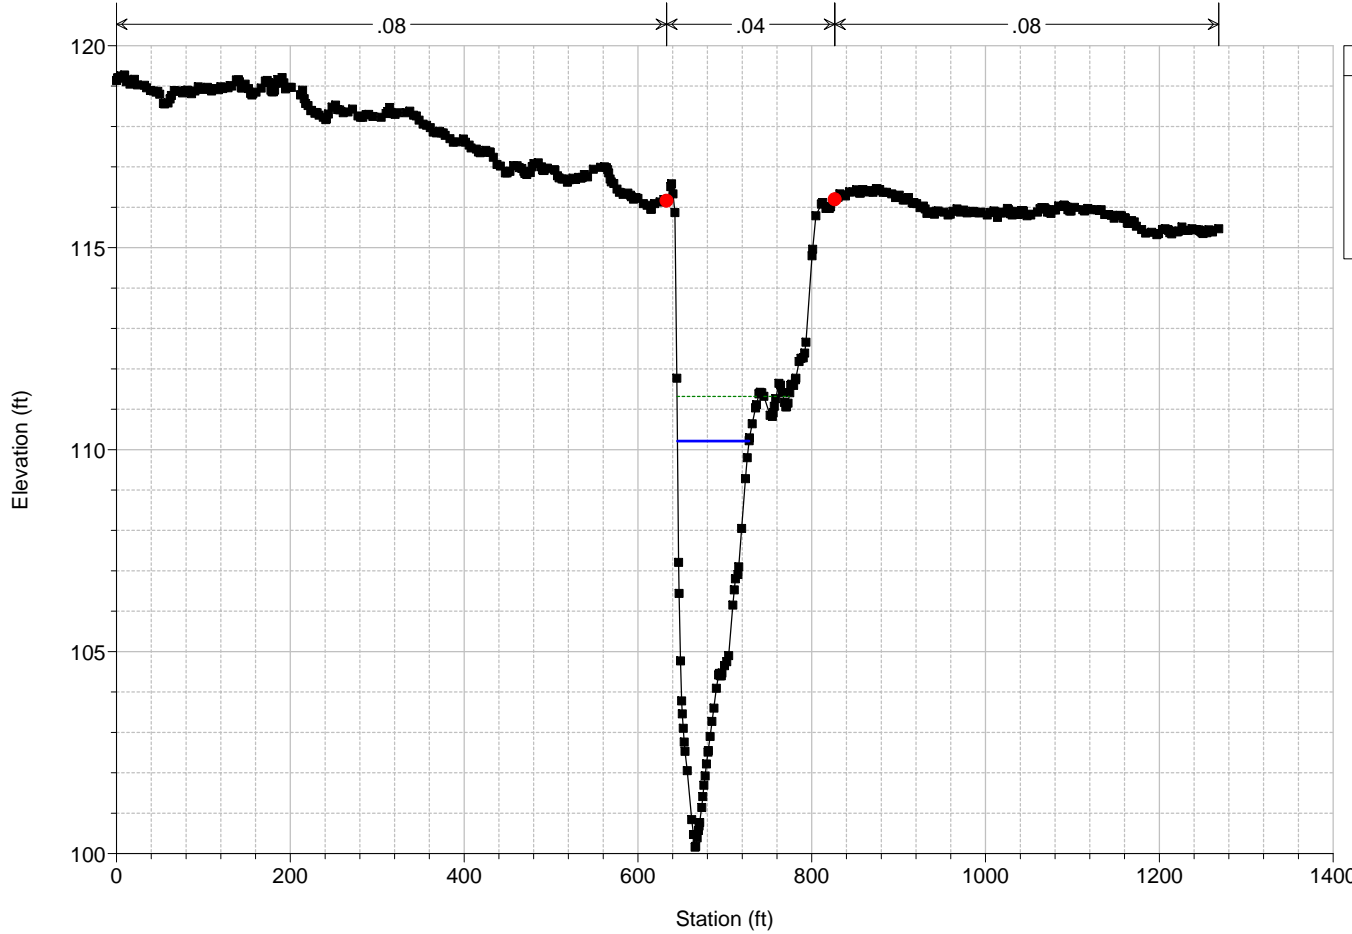



**Legend**

- EG 100yr\_Gage
- WS 100yr\_Gage
- Ground
- Bank Sta





HEC-RAS Model Plan: ExistingNapaBE

River = Dry Creek Reach = Dry Creek RS = 4105

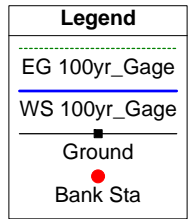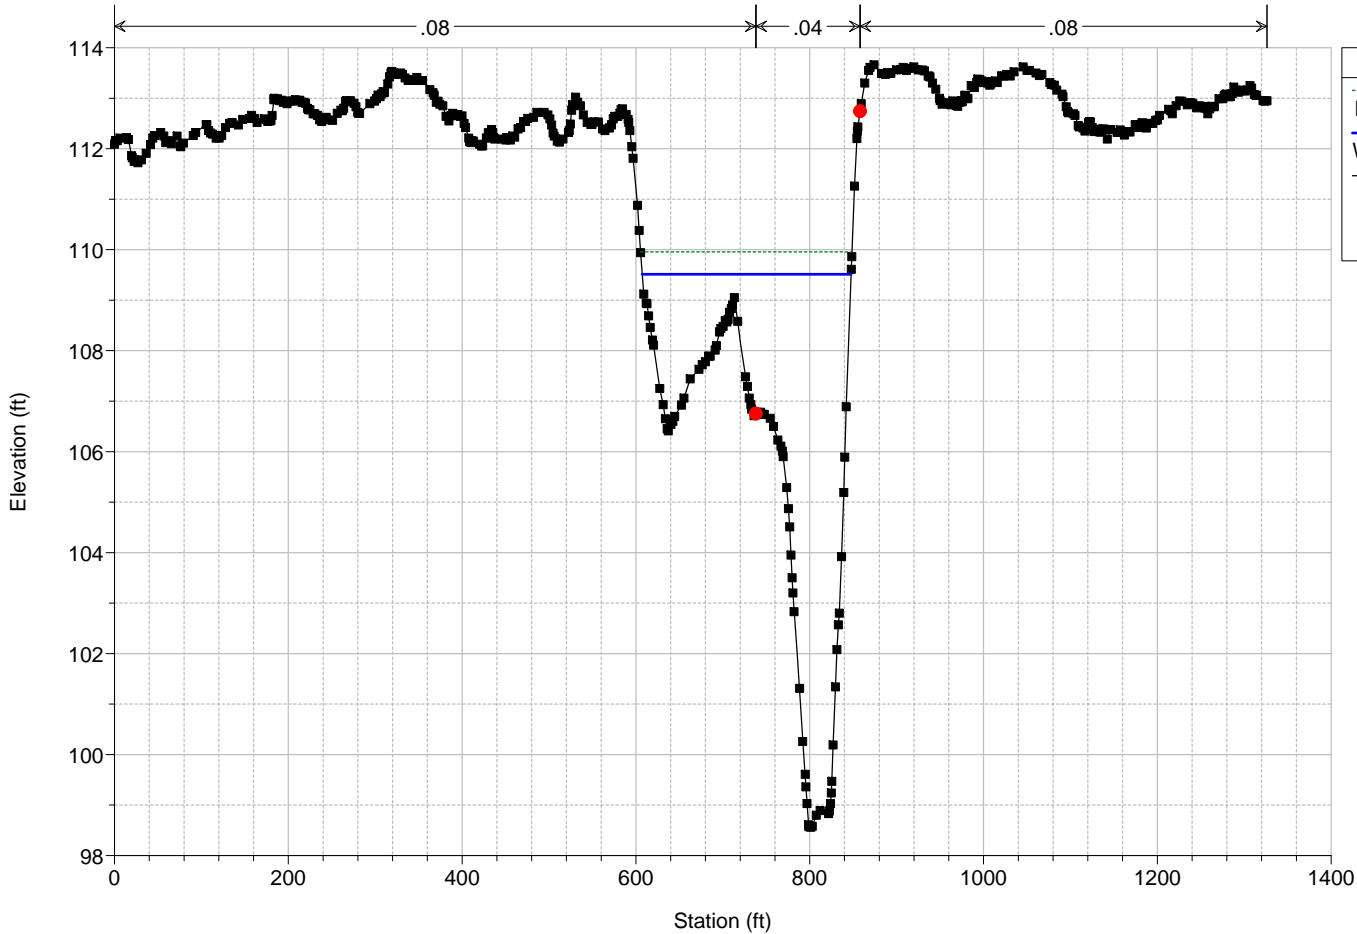


HEC-RAS Model Plan: ExistingNapaBE

River = Dry Creek Reach = Dry Creek RS = 3645

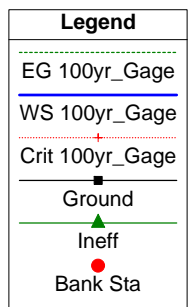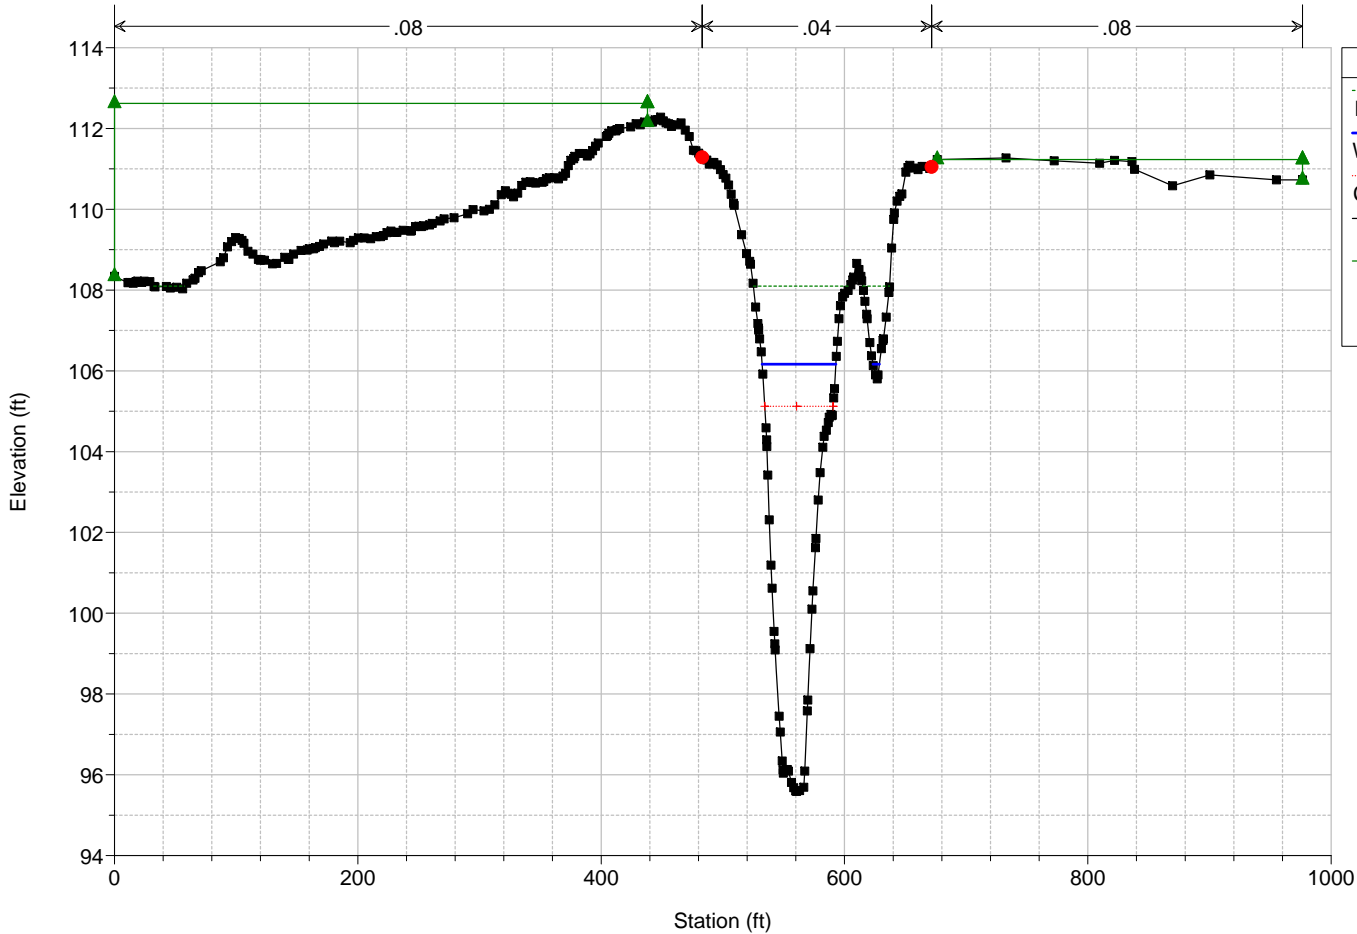


HEC-RAS Model Plan: ExistingNapaBE

River = Dry Creek Reach = Dry Creek RS = 3299

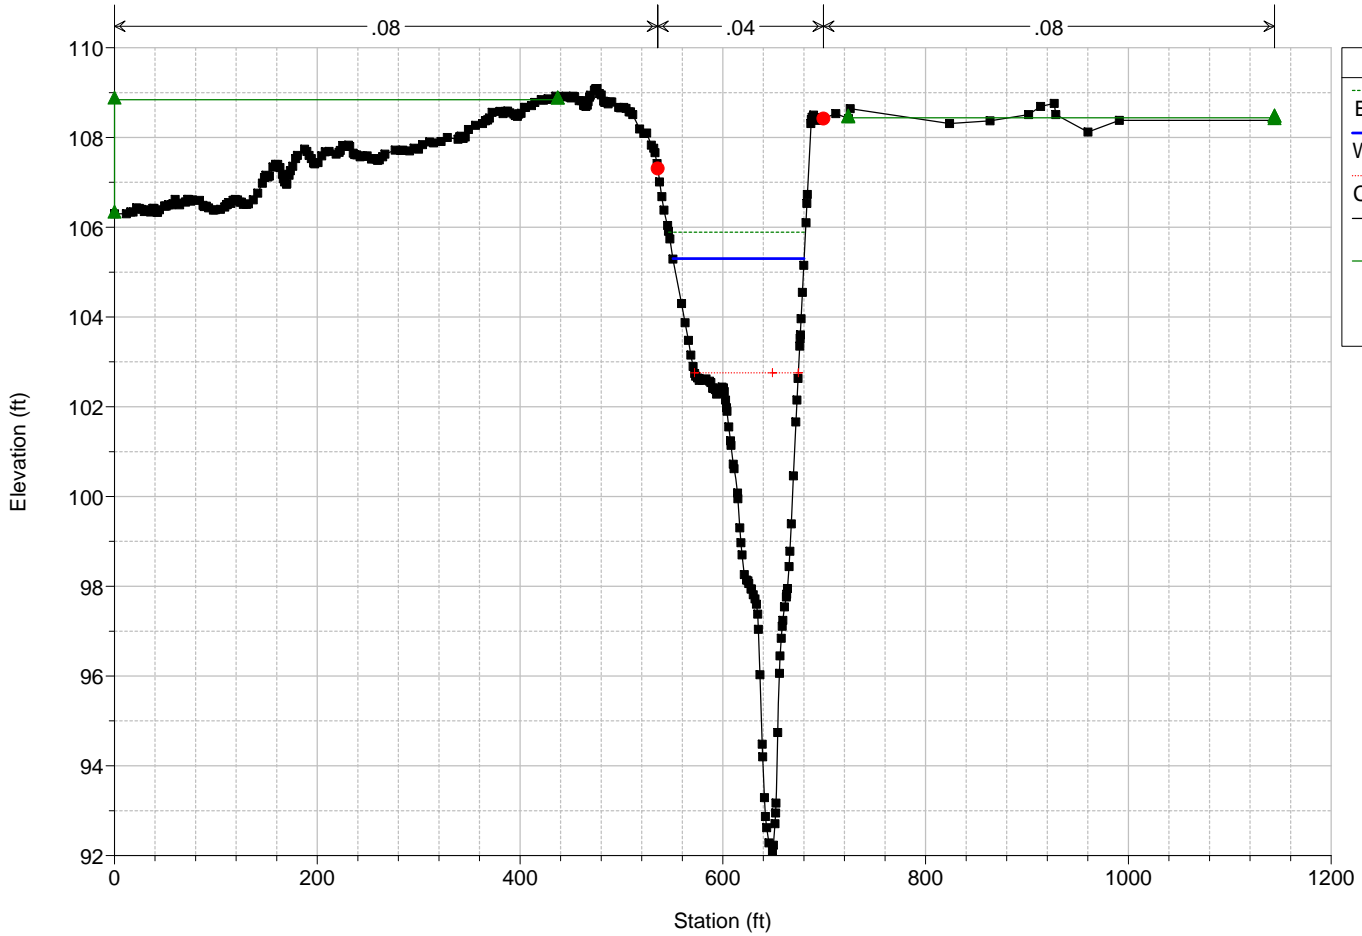

HEC-RAS Model Plan: ExistingNapaBE



River = Dry Creek Reach = Dry Creek RS = 2786

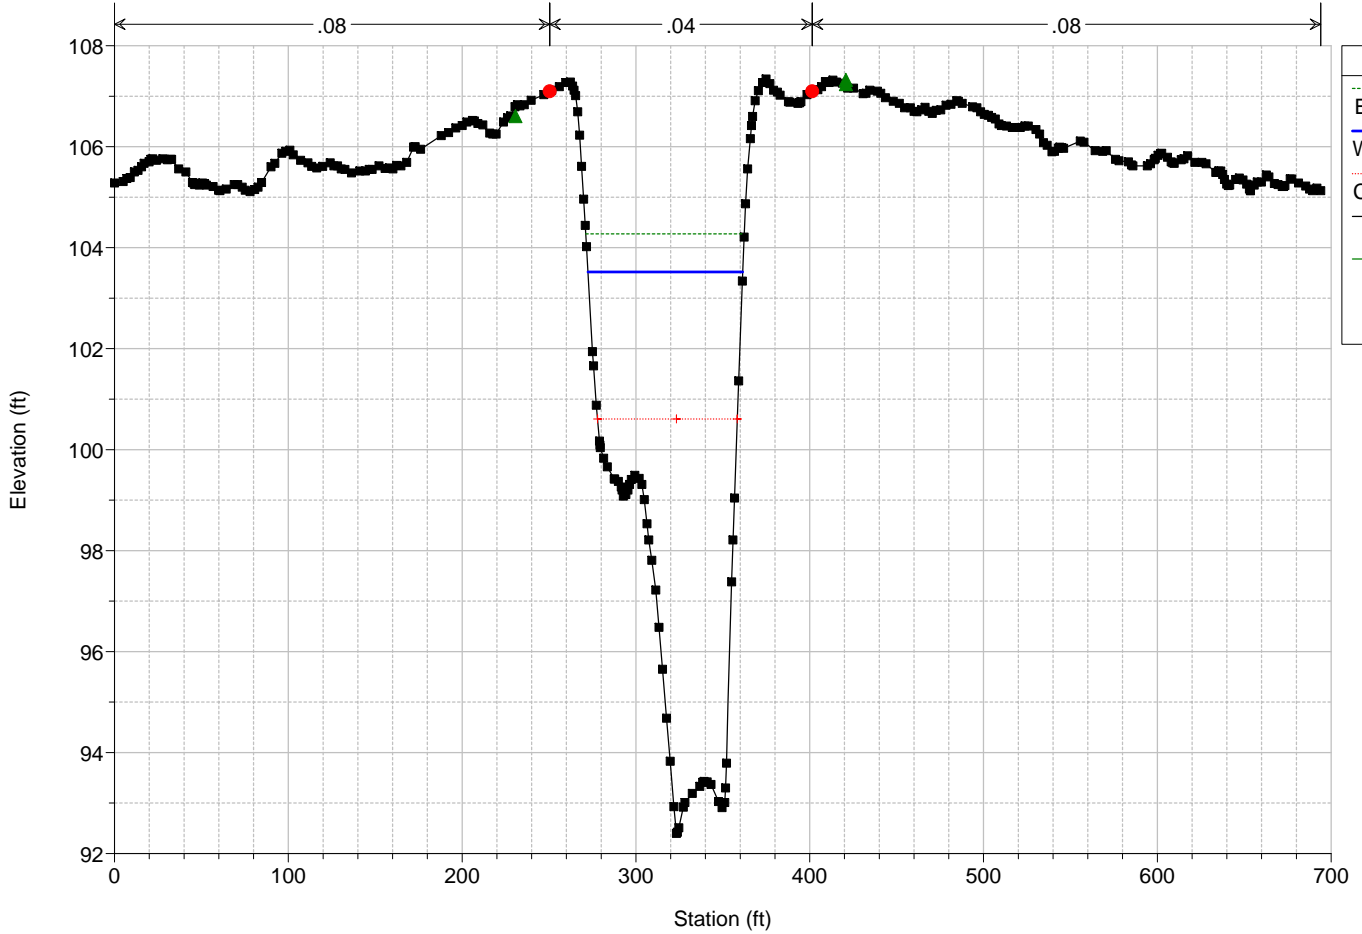





HEC-RAS Model Plan: ExistingNapaBE

River = Dry Creek Reach = Dry Creek RS = 2417

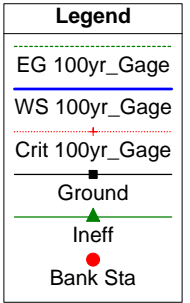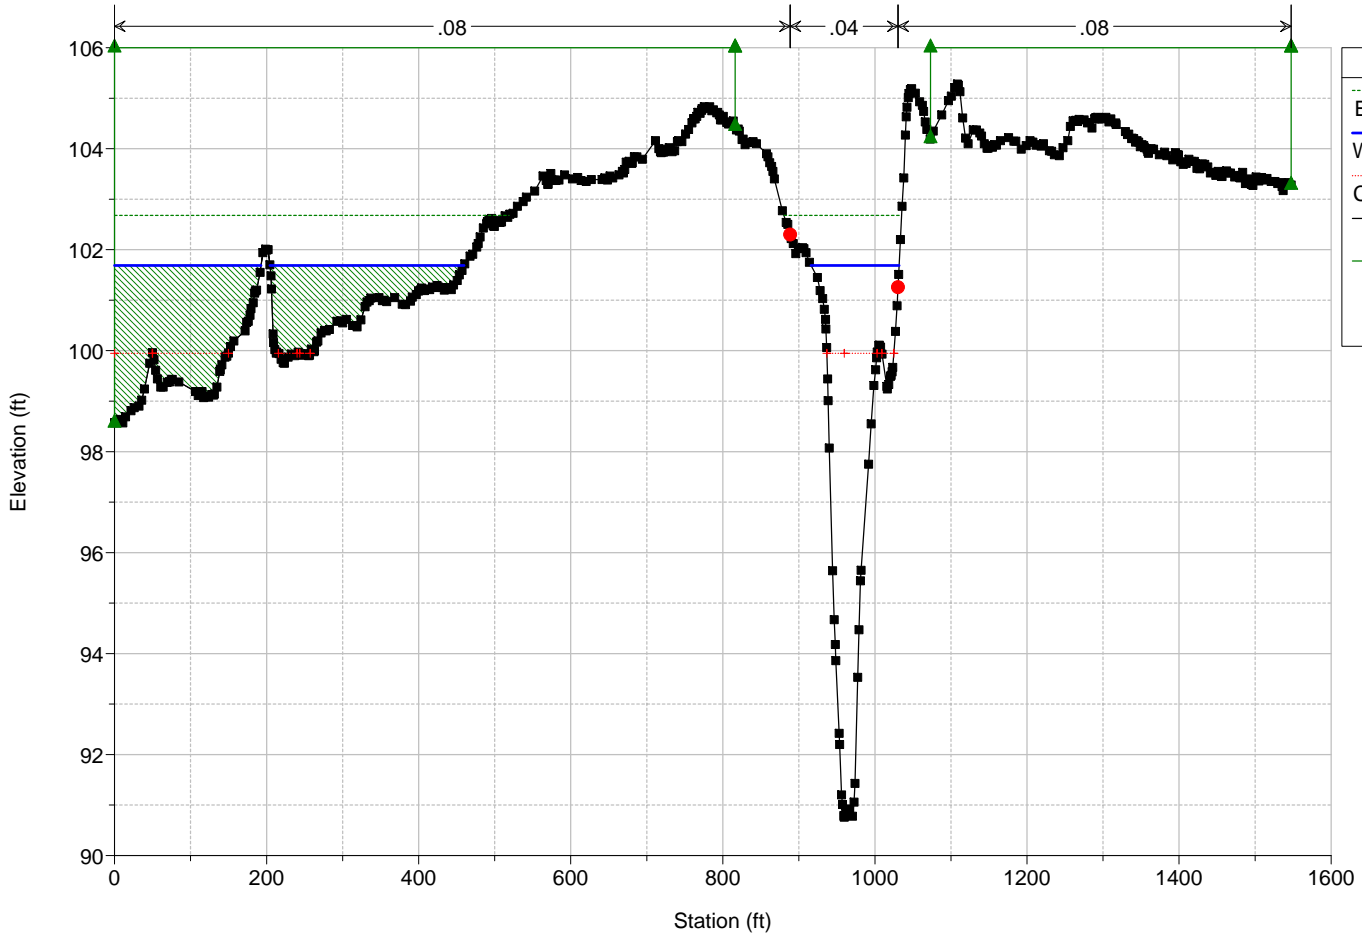


HEC-RAS Model Plan: ExistingNapaBE

River = Dry Creek Reach = Dry Creek RS = 2078

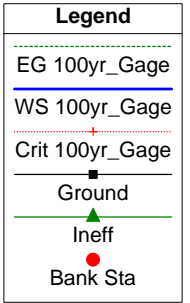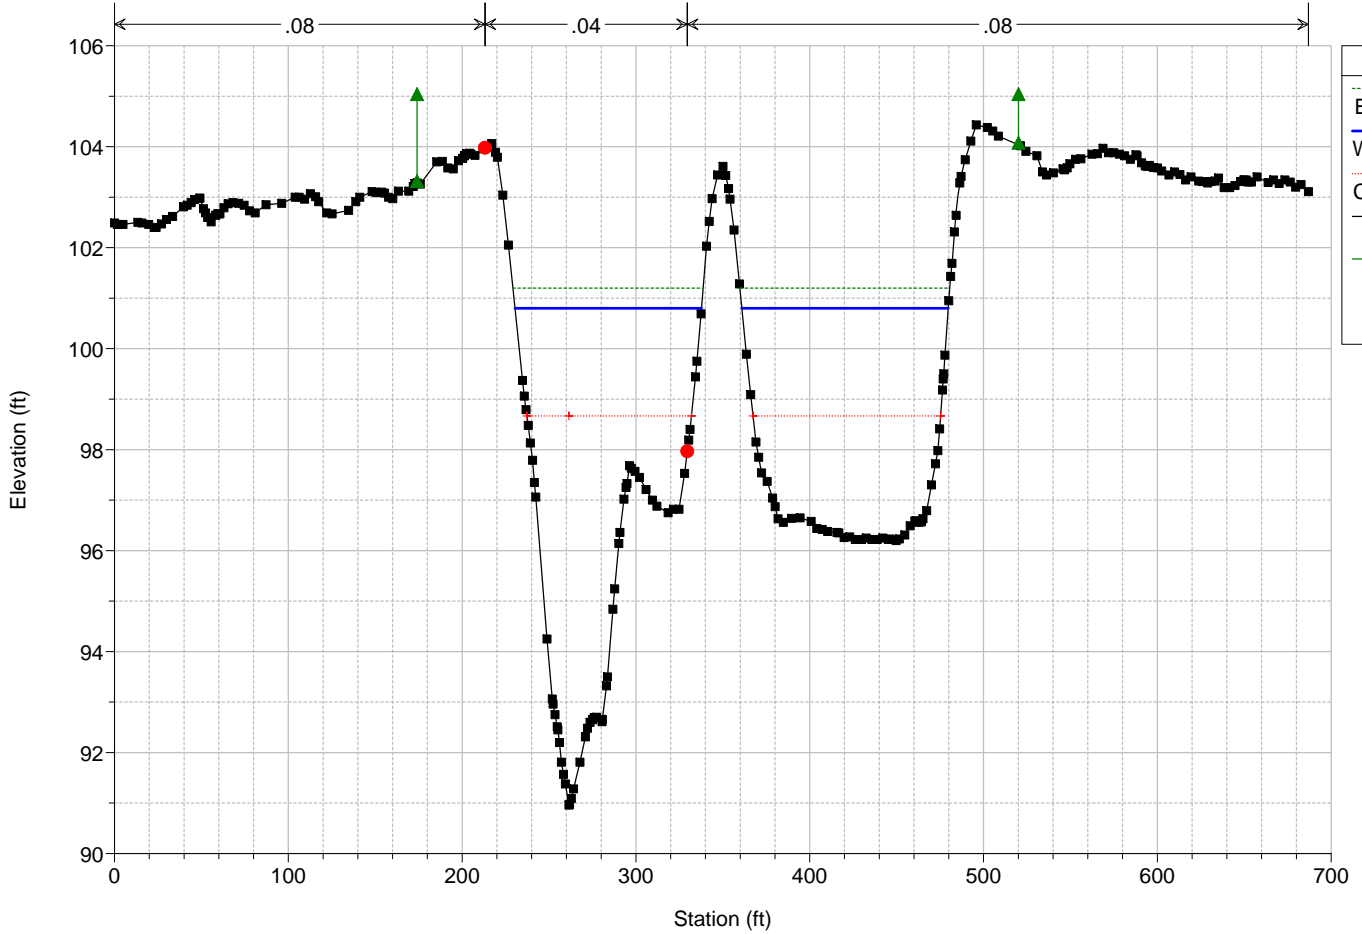


HEC-RAS Model Plan: ExistingNapaBE

River = Dry Creek Reach = Dry Creek RS = 2017

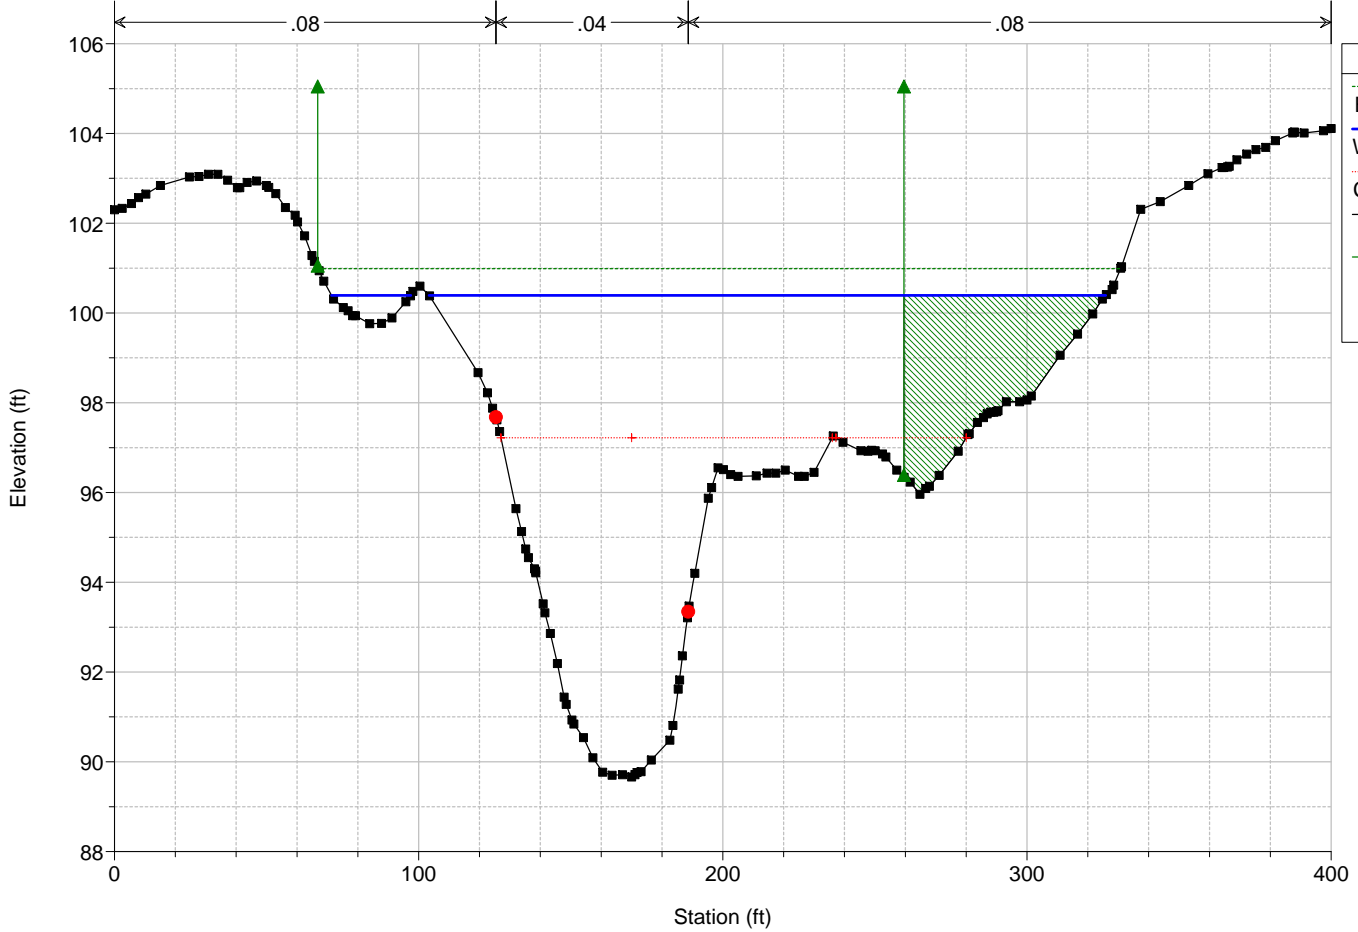



HEC-RAS Model Plan: ExistingNapaBE

River = Dry Creek Reach = Dry Creek RS = 1979


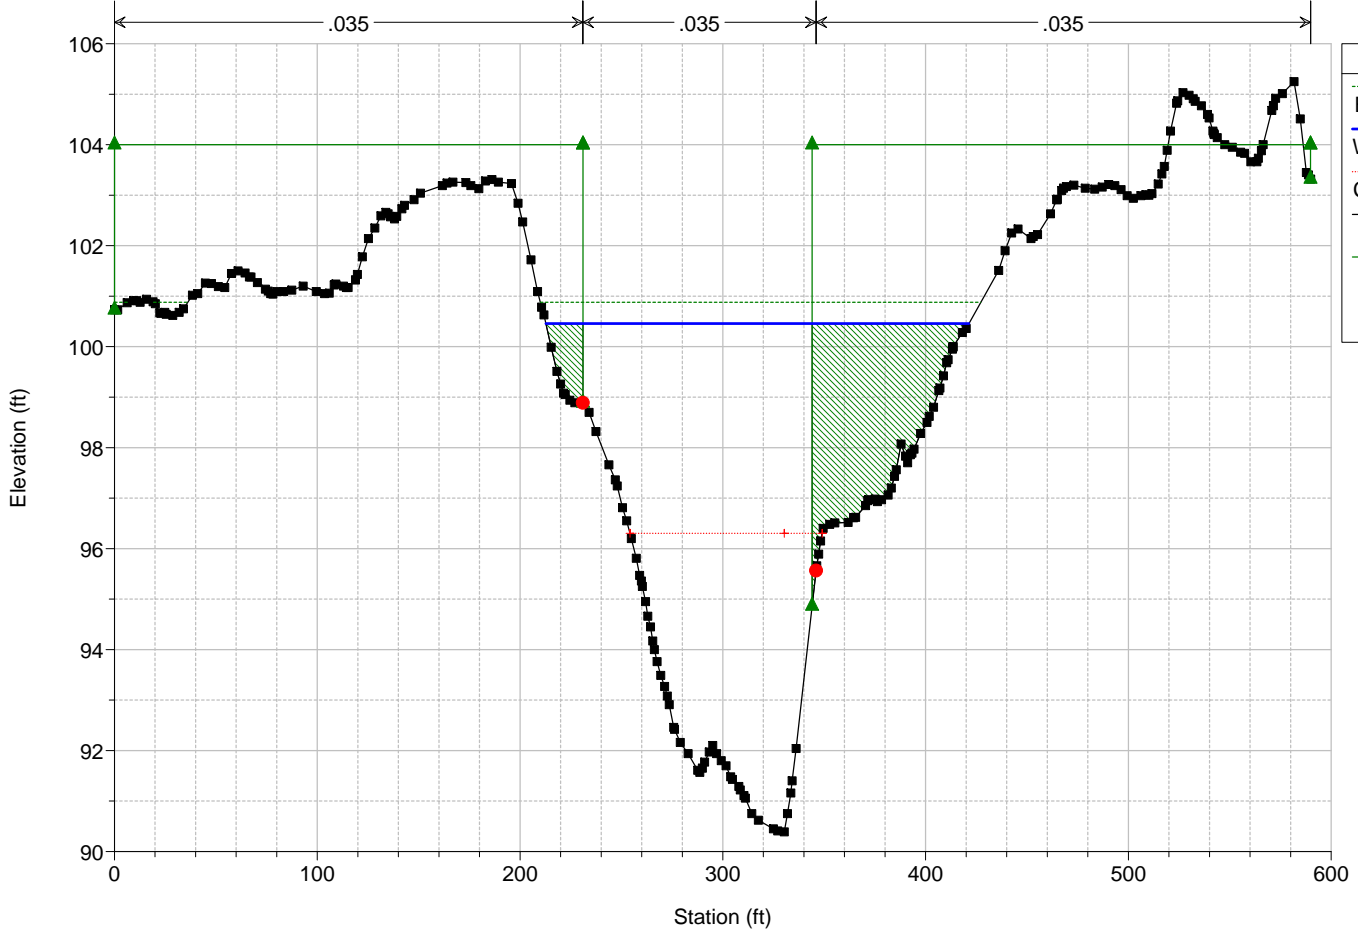




HEC-RAS Model Plan: ExistingNapaBE  
 River = Dry Creek Reach = Dry Creek RS = 1928 BR

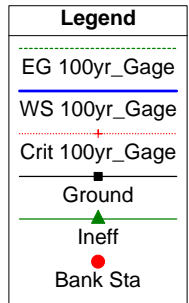
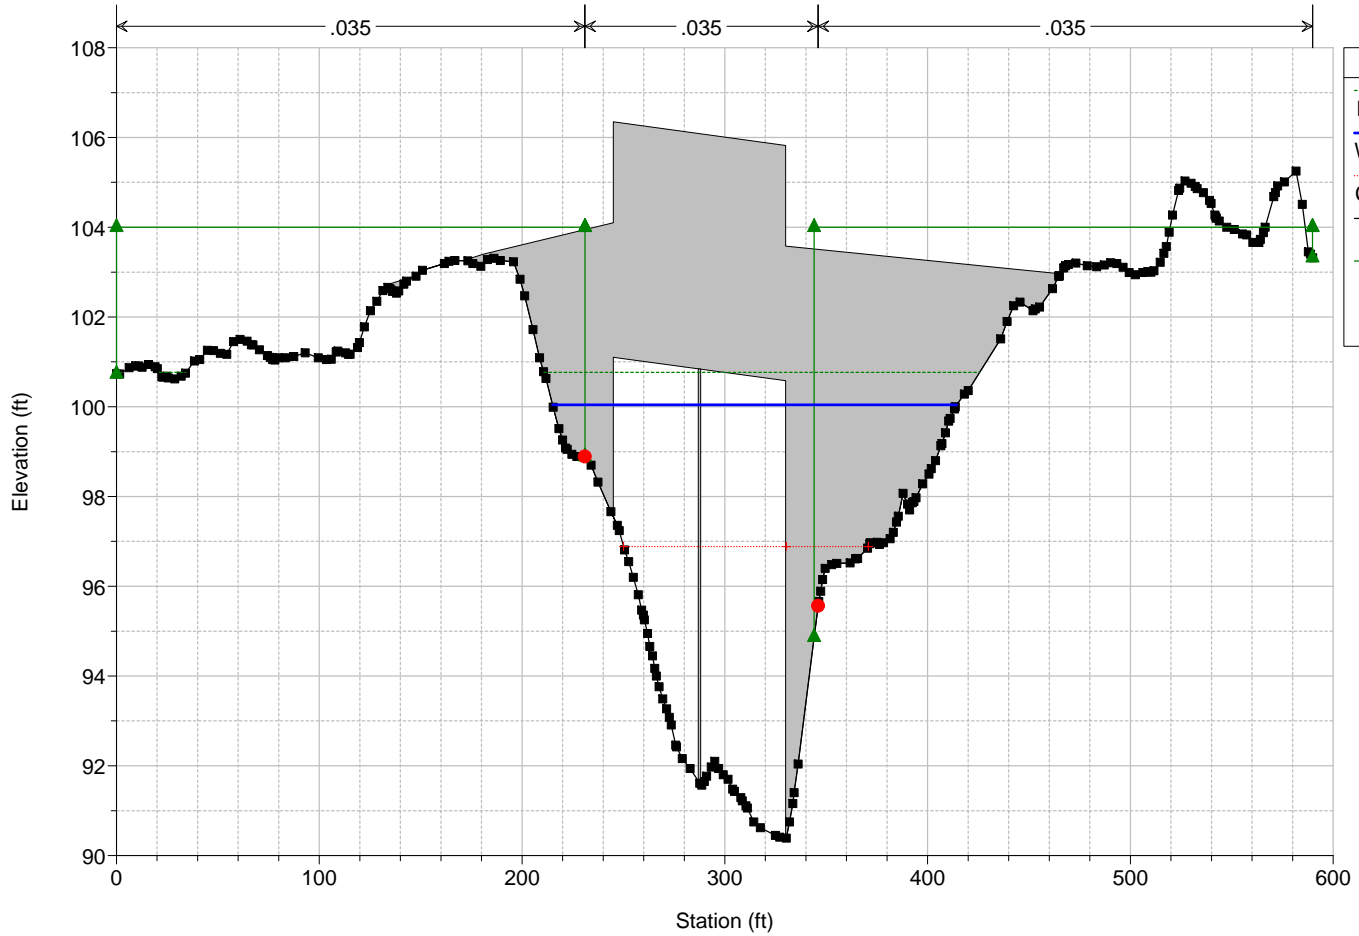


HEC-RAS Model Plan: ExistingNapaBE  
 River = Dry Creek Reach = Dry Creek RS = 1928 BR

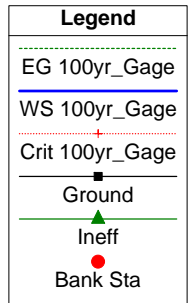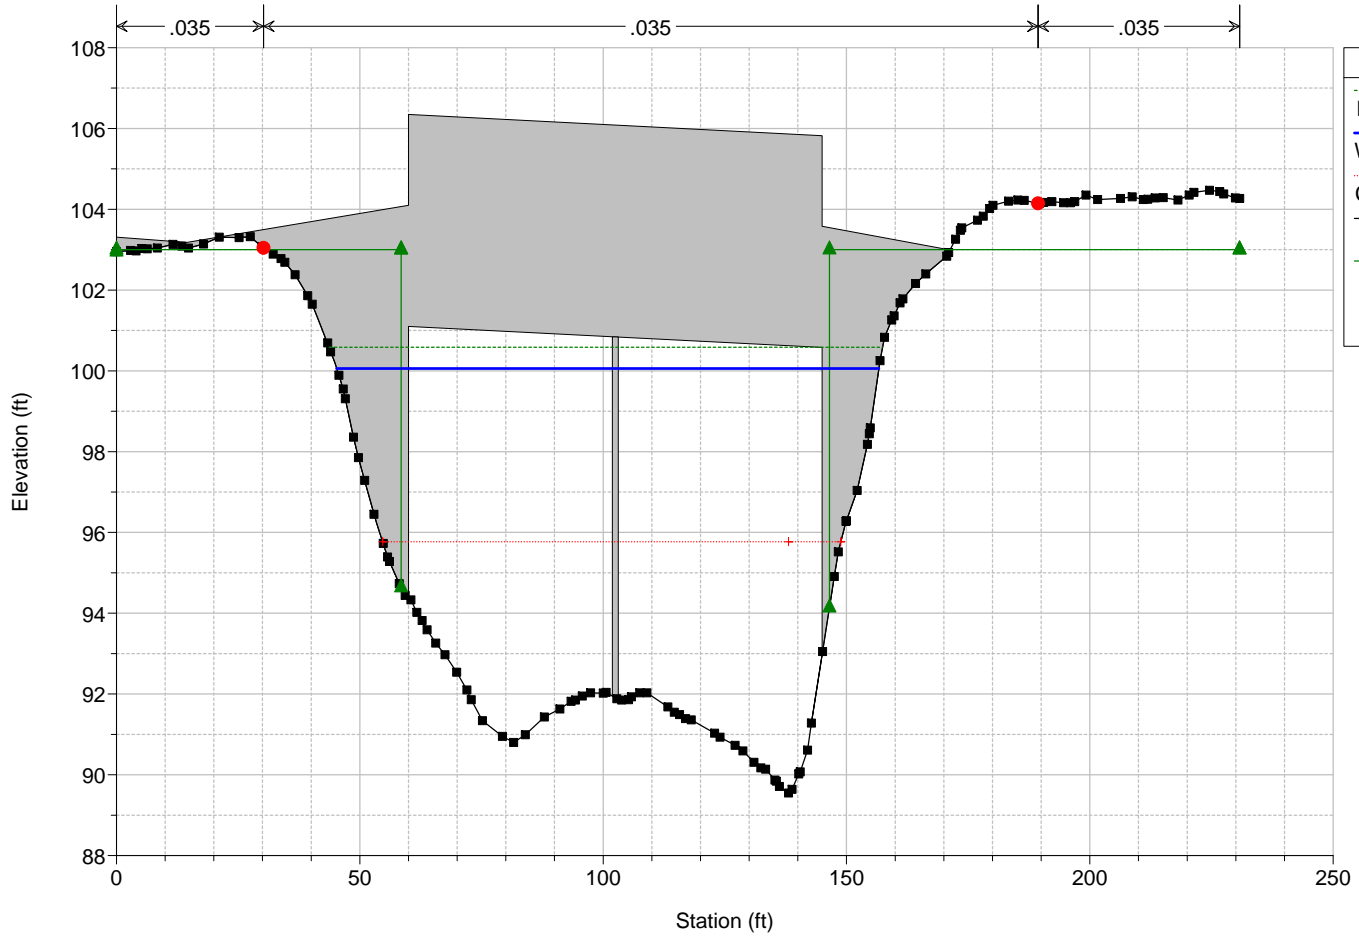



HEC-RAS Model Plan: ExistingNapaBE

River = Dry Creek Reach = Dry Creek RS = 1892

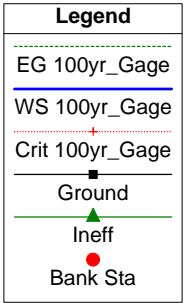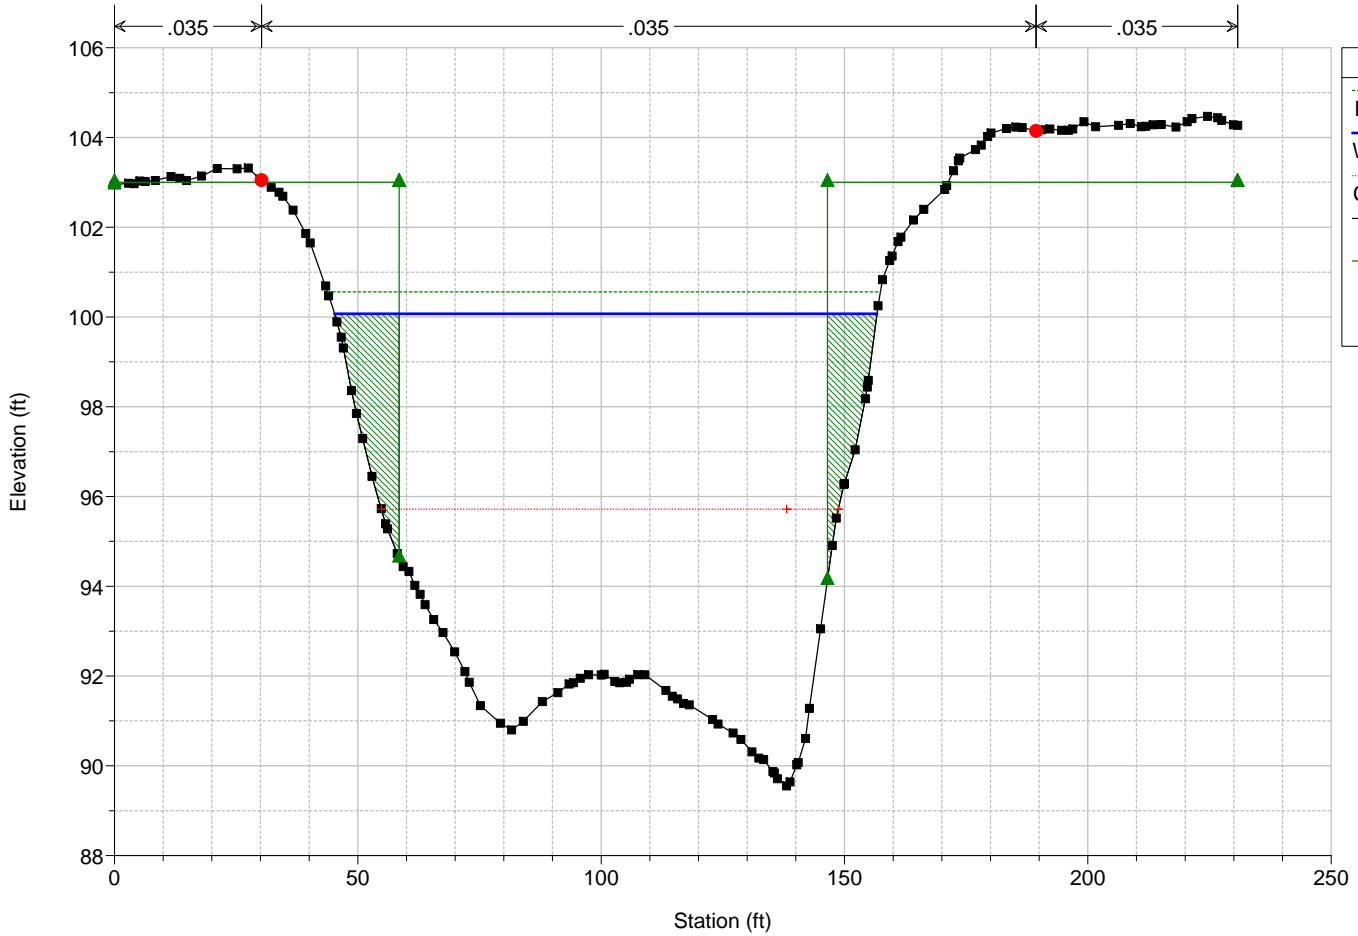



HEC-RAS Model Plan: ExistingNapaBE

River = Dry Creek Reach = Dry Creek RS = 1886

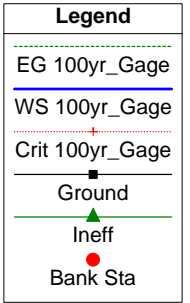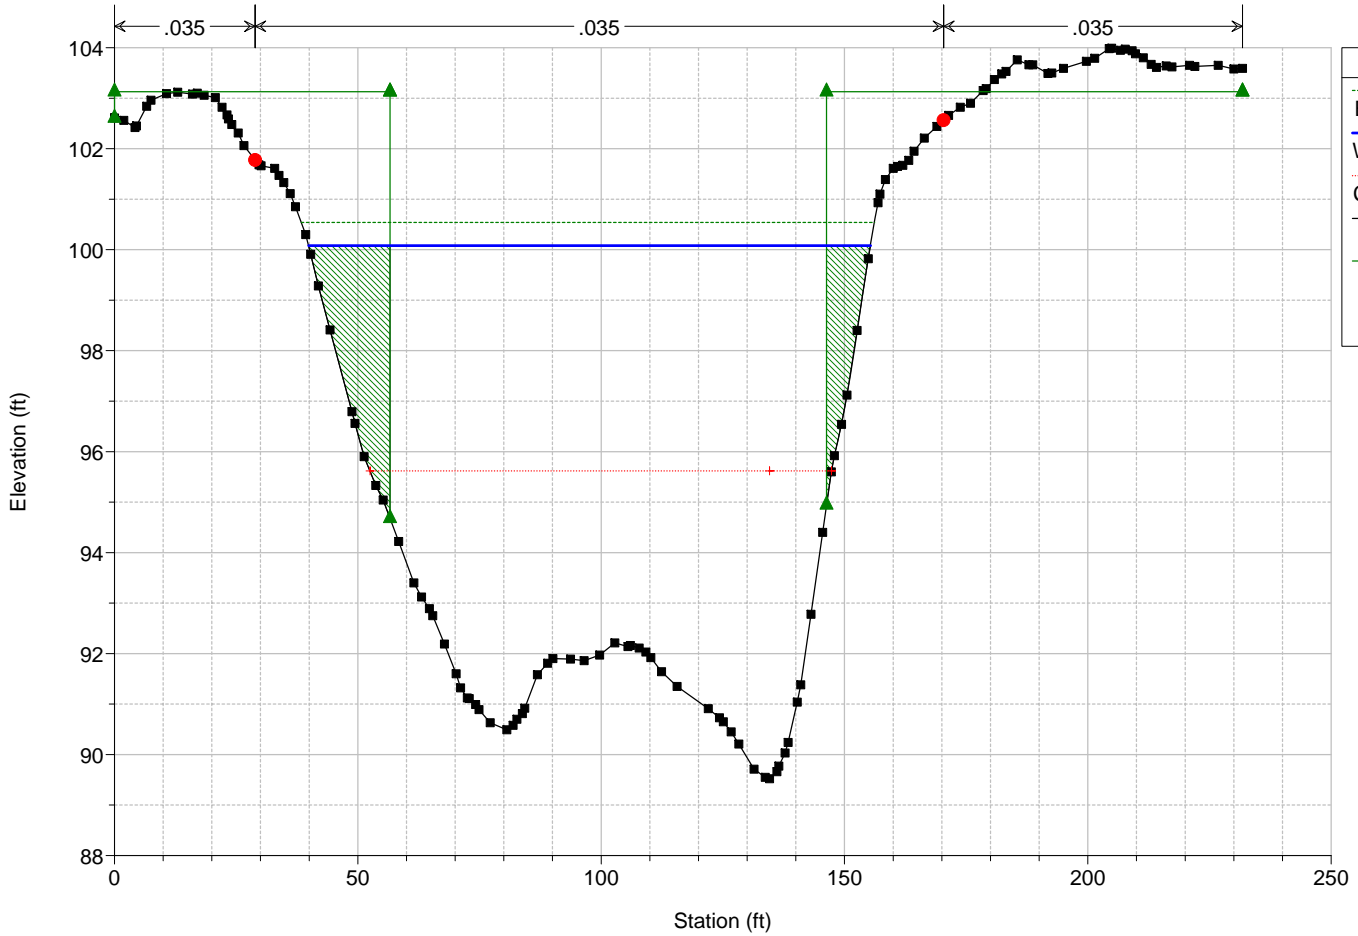



HEC-RAS Model Plan: ExistingNapaBE

River = Dry Creek Reach = Dry Creek RS = 1881

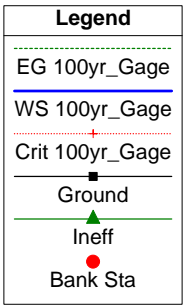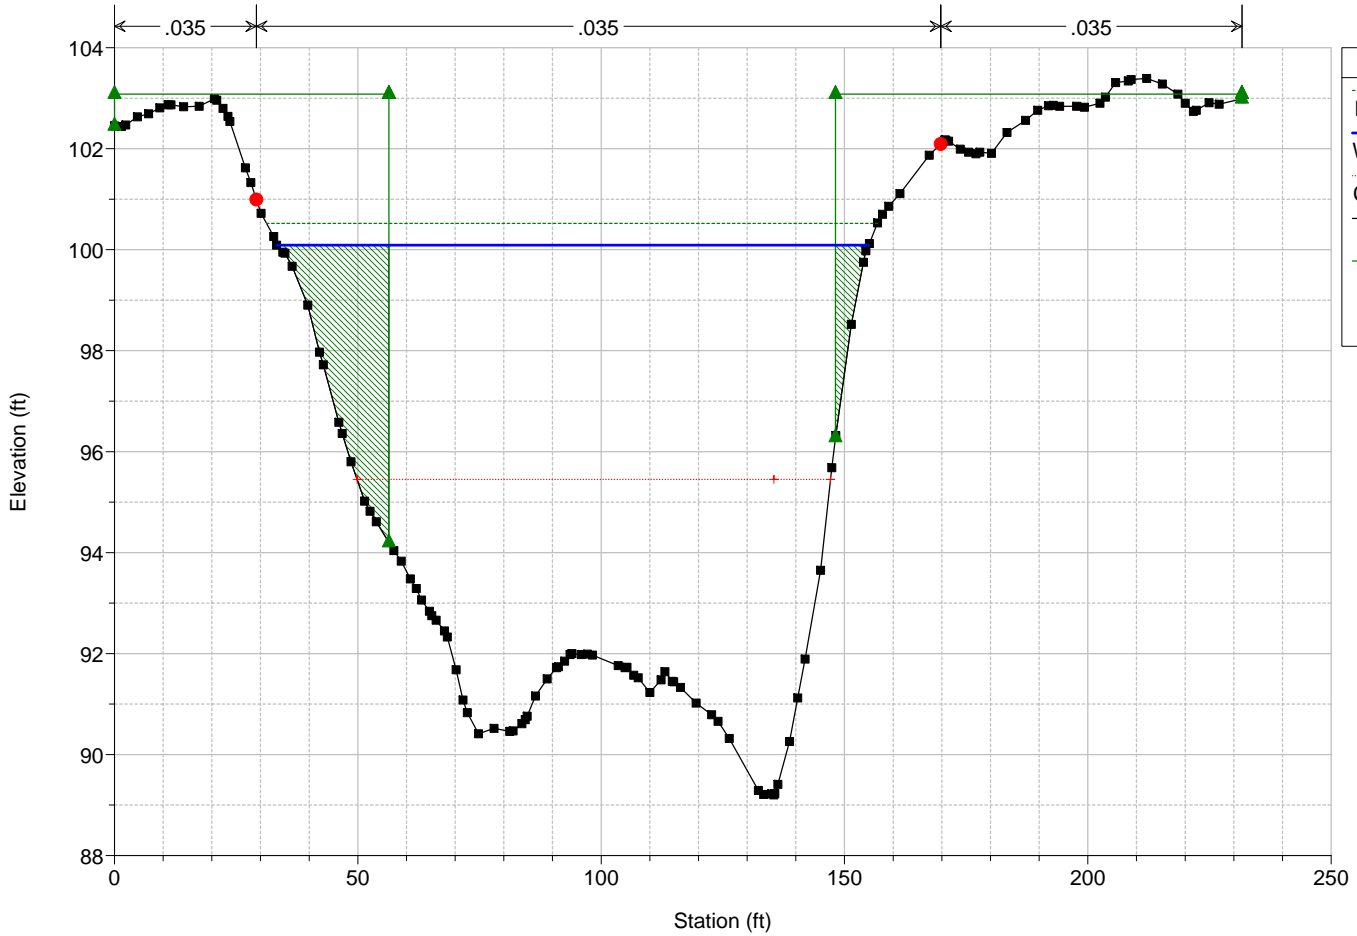

HEC-RAS Model Plan: ExistingNapaBE



River = Dry Creek Reach = Dry Creek RS = 1876

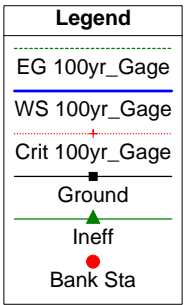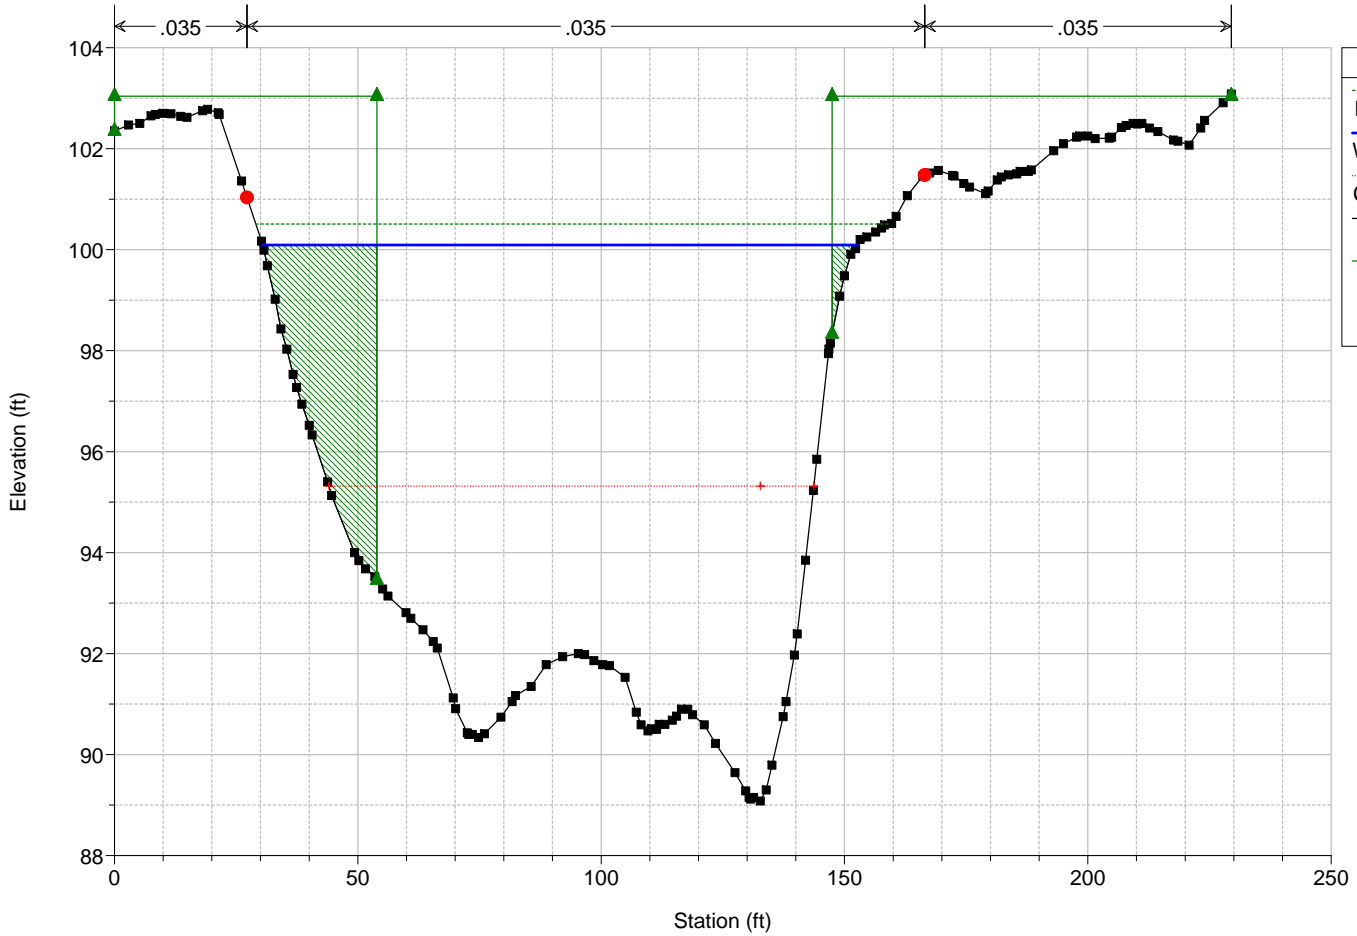





HEC-RAS Model Plan: ExistingNapaBE

River = Dry Creek Reach = Dry Creek RS = 1870

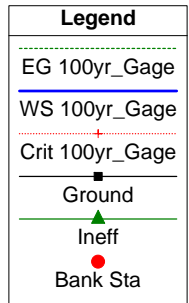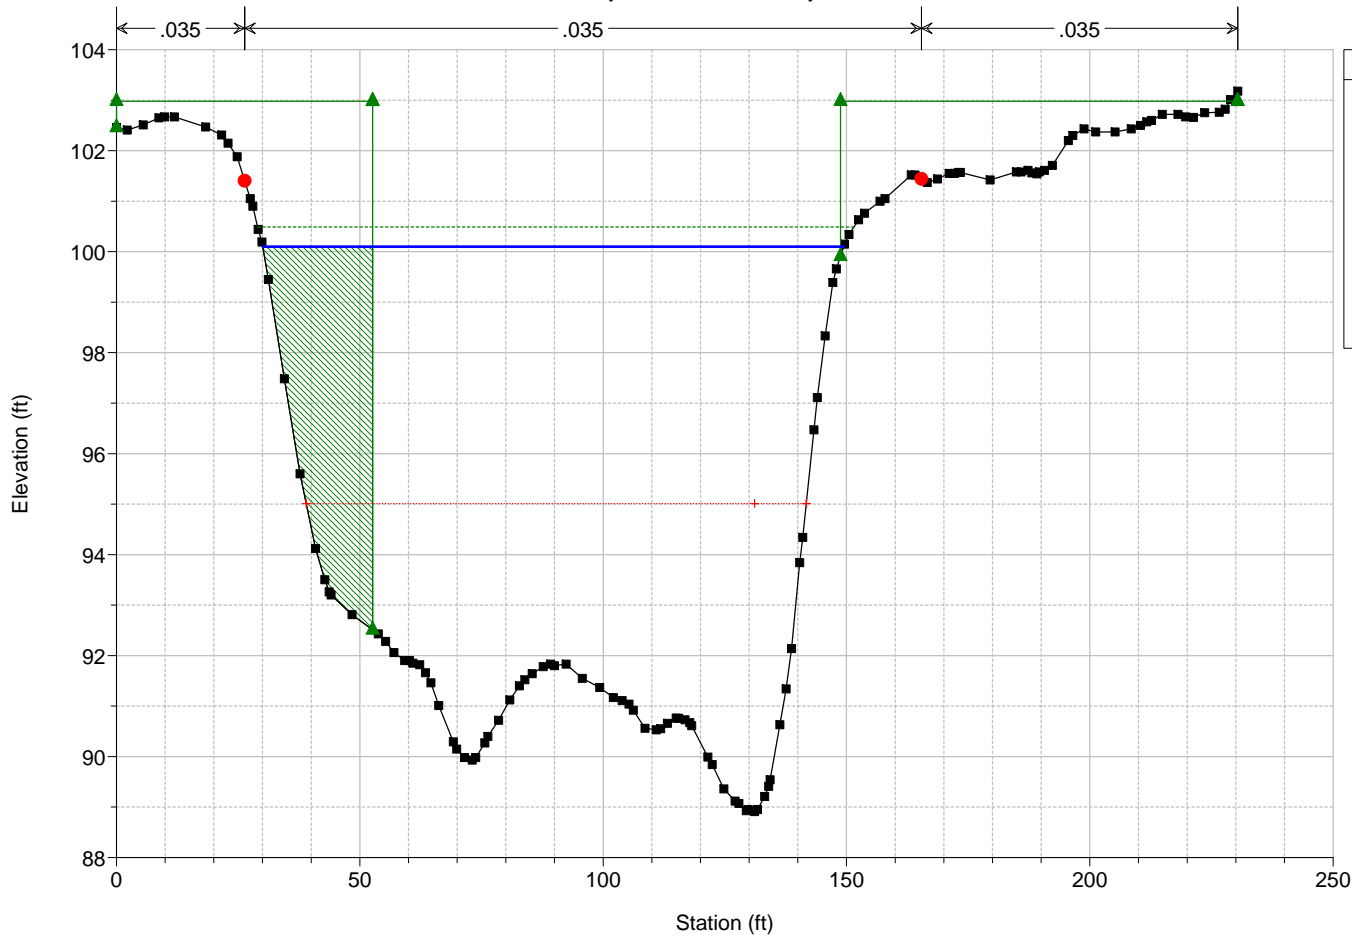


HEC-RAS Model Plan: ExistingNapaBE


River = Dry Creek Reach = Dry Creek RS = 1857 BR

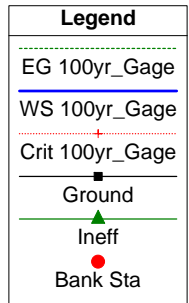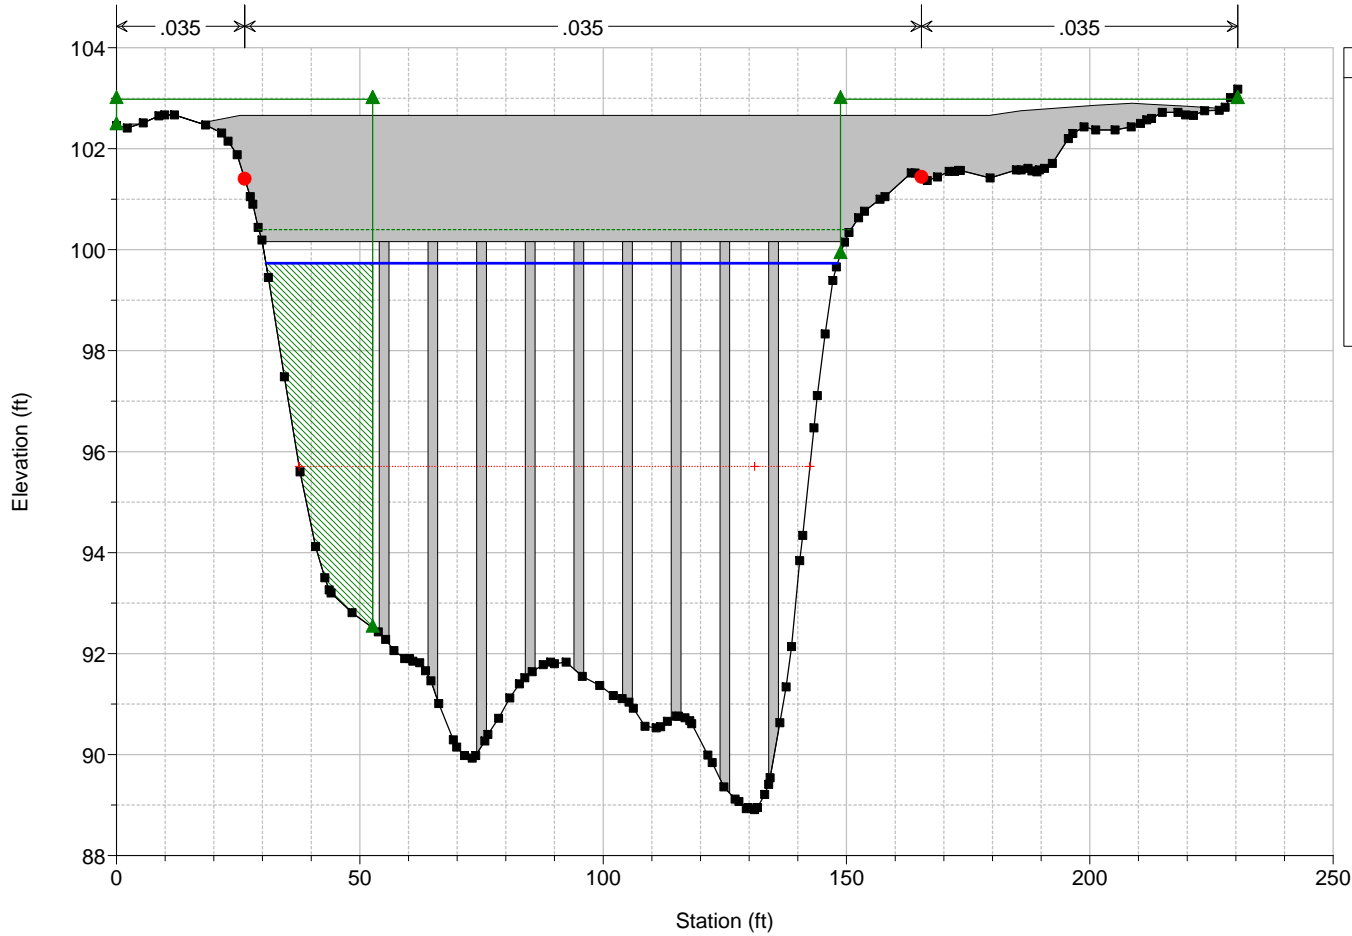

HEC-RAS Model Plan: ExistingNapaBE  
 River = Dry Creek Reach = Dry Creek RS = 1857 BR


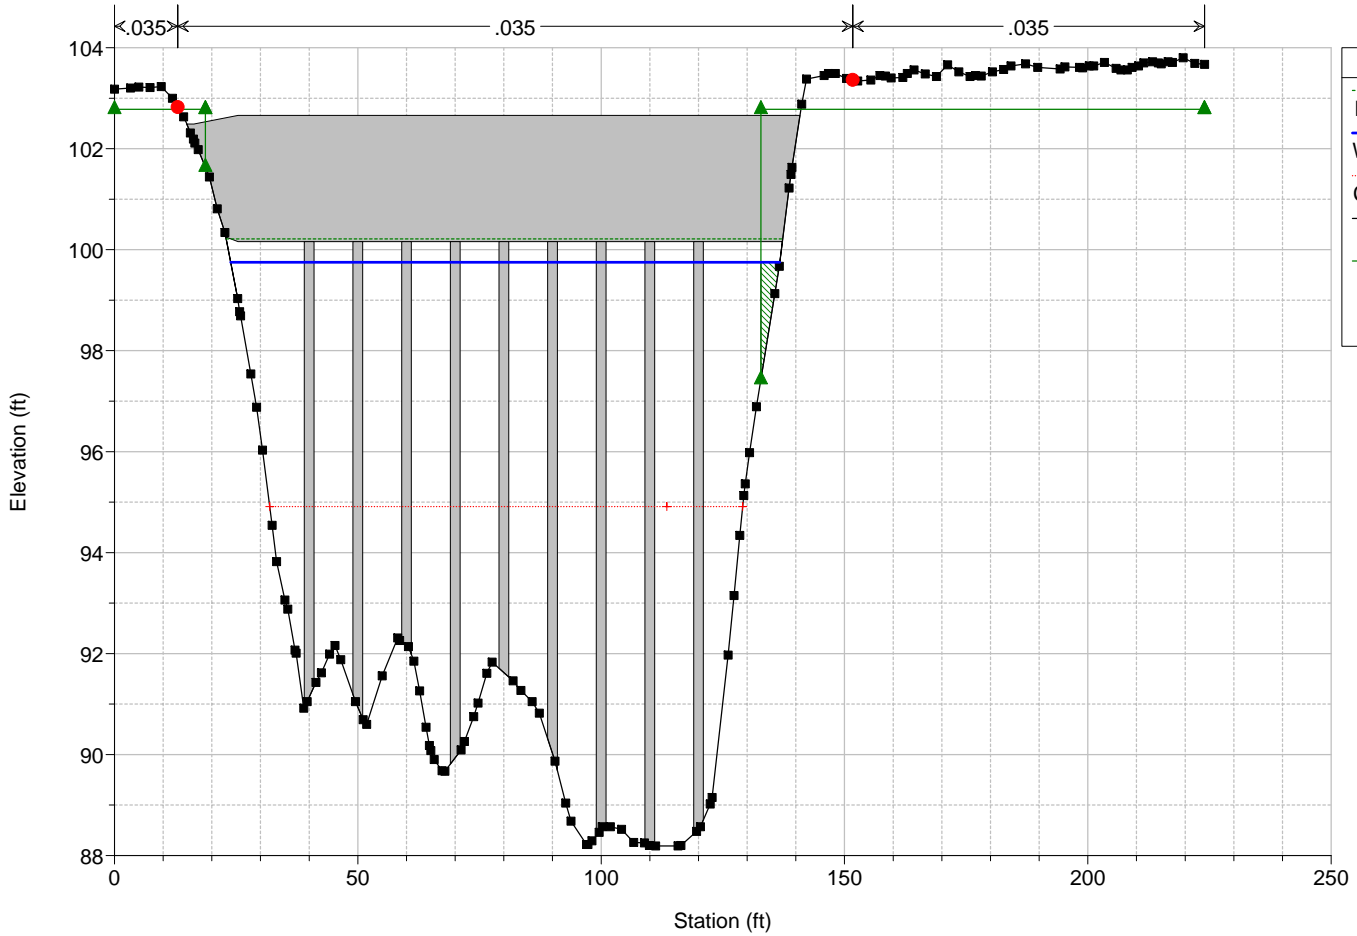


HEC-RAS Model Plan: ExistingNapaBE  
 River = Dry Creek Reach = Dry Creek RS = 1844

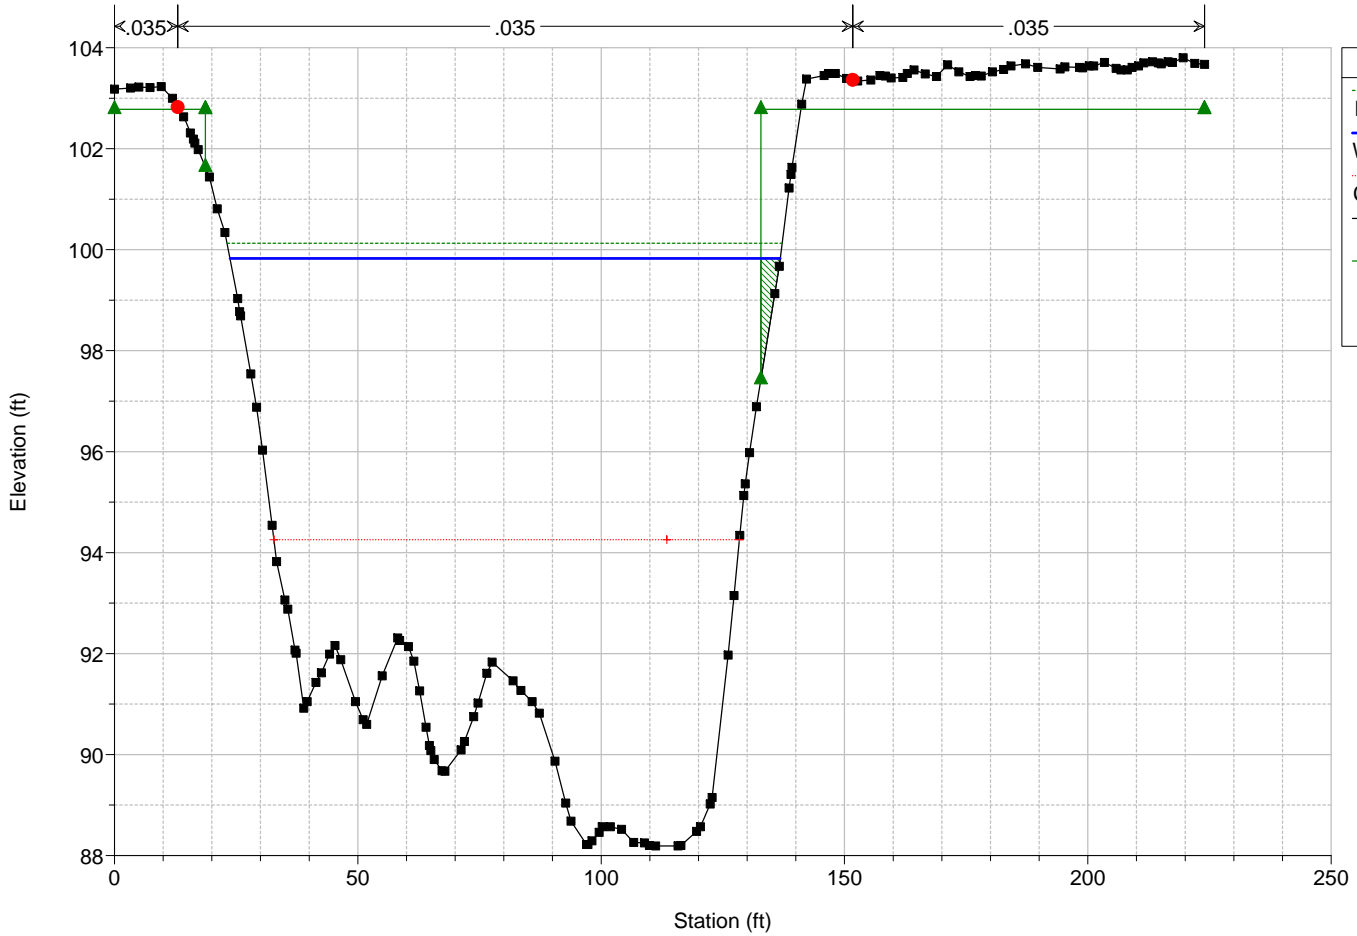



HEC-RAS Model Plan: ExistingNapaBE

River = Dry Creek Reach = Dry Creek RS = 1840

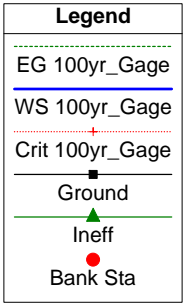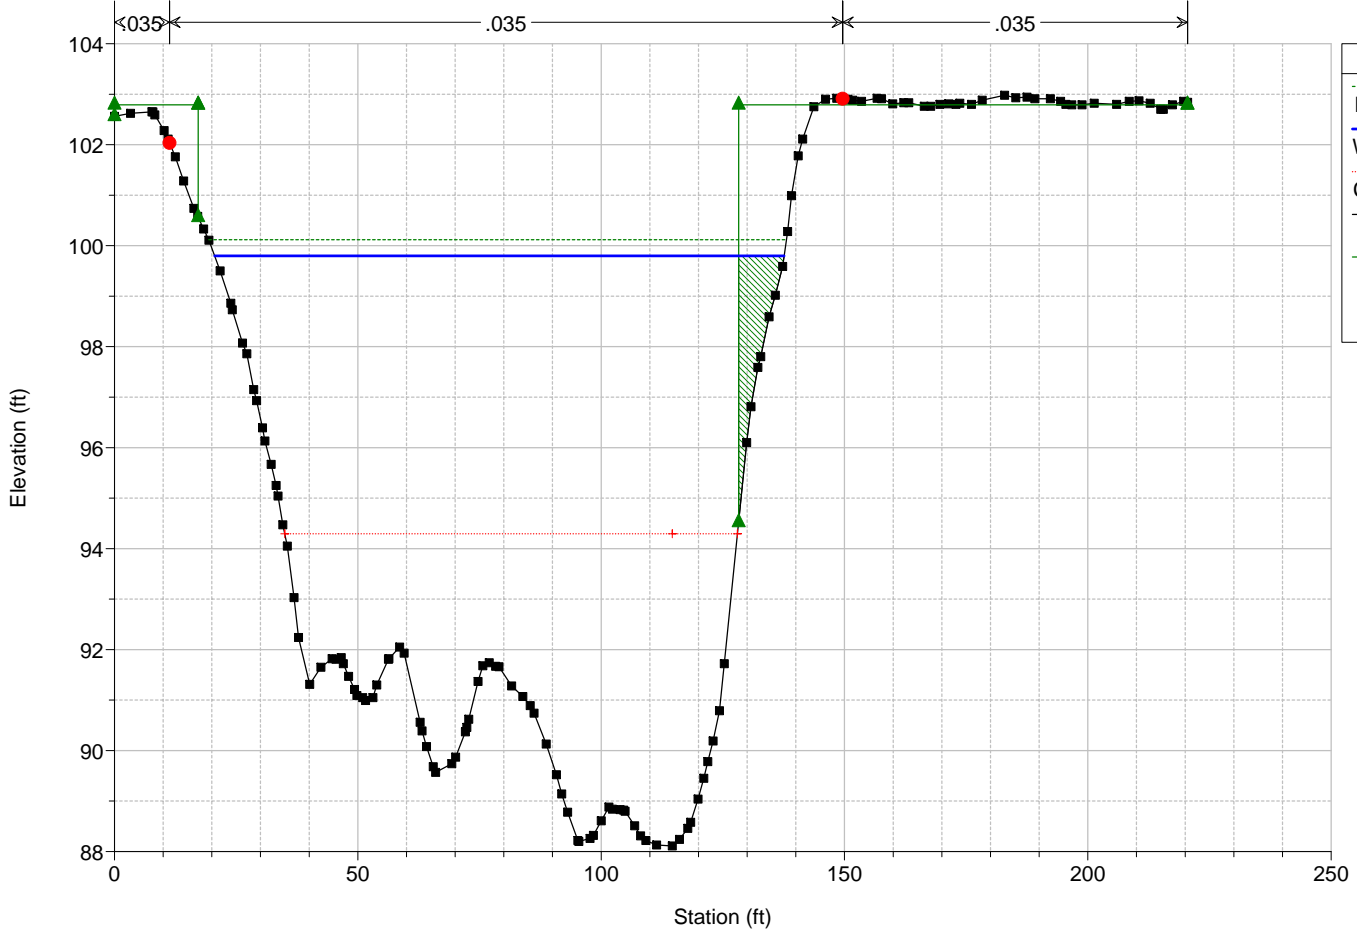

HEC-RAS Model Plan: ExistingNapaBE



River = Dry Creek Reach = Dry Creek RS = 1836

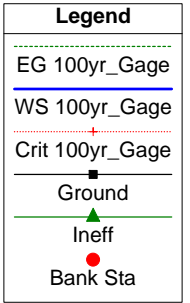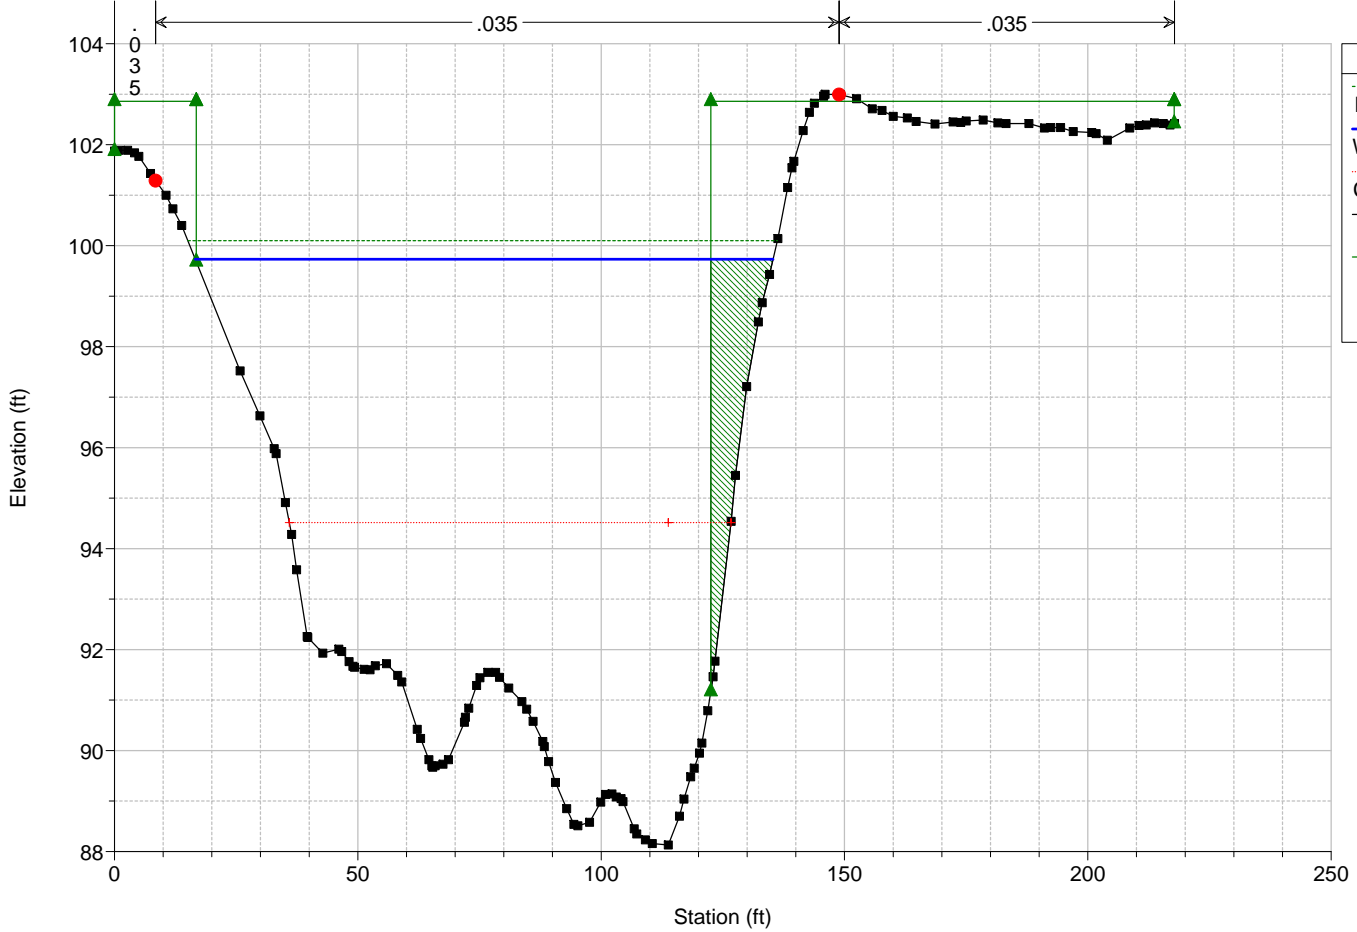





HEC-RAS Model Plan: ExistingNapaBE

River = Dry Creek Reach = Dry Creek RS = 1832

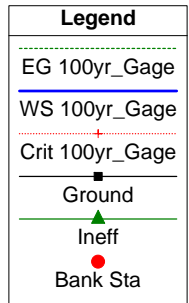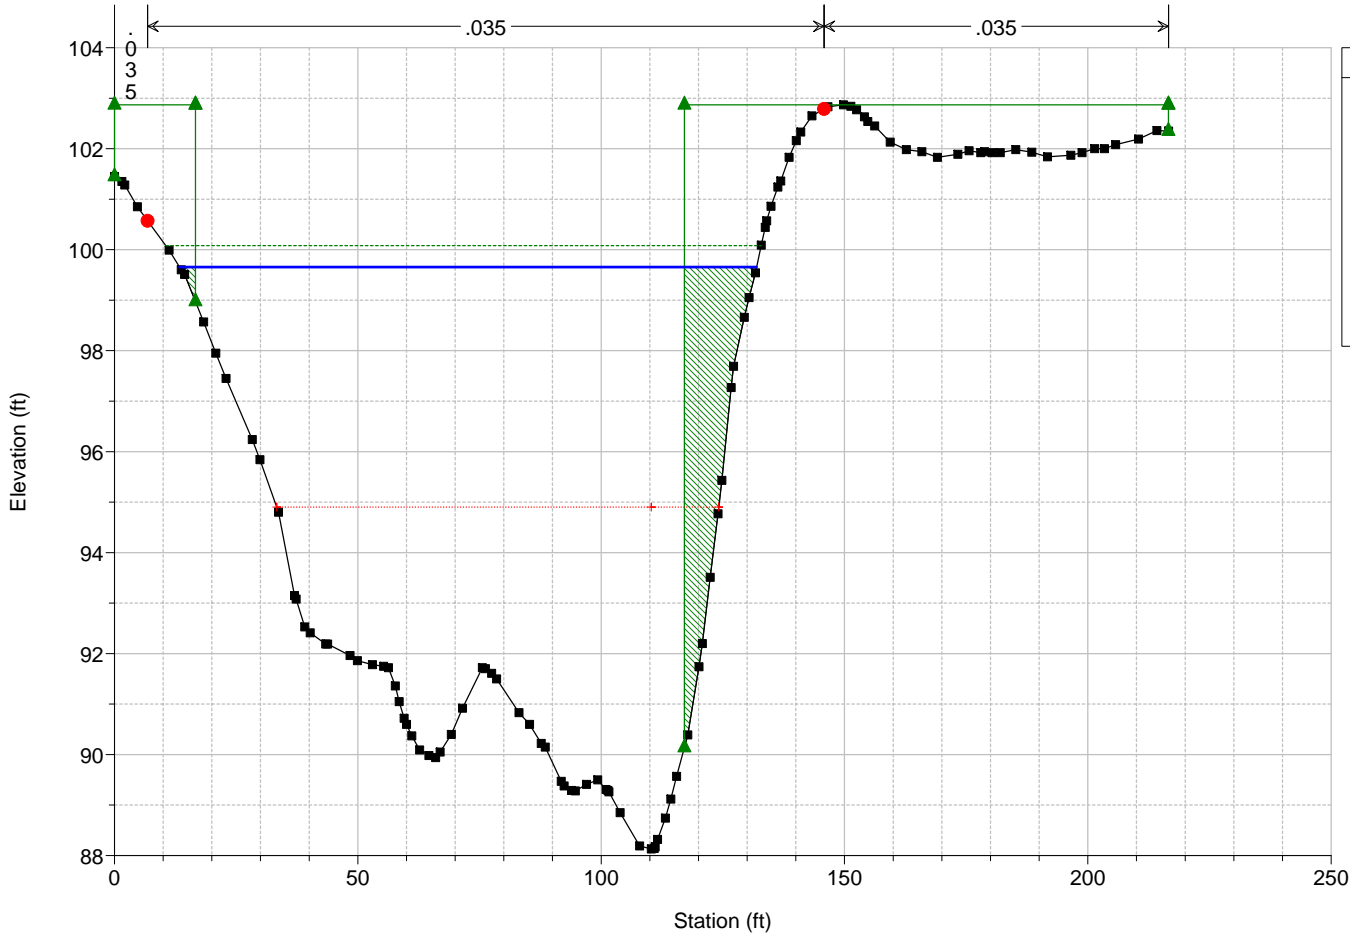



HEC-RAS Model Plan: ExistingNapaBE

River = Dry Creek Reach = Dry Creek RS = 1827

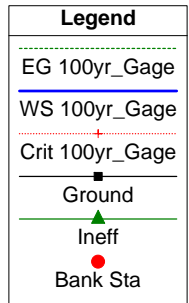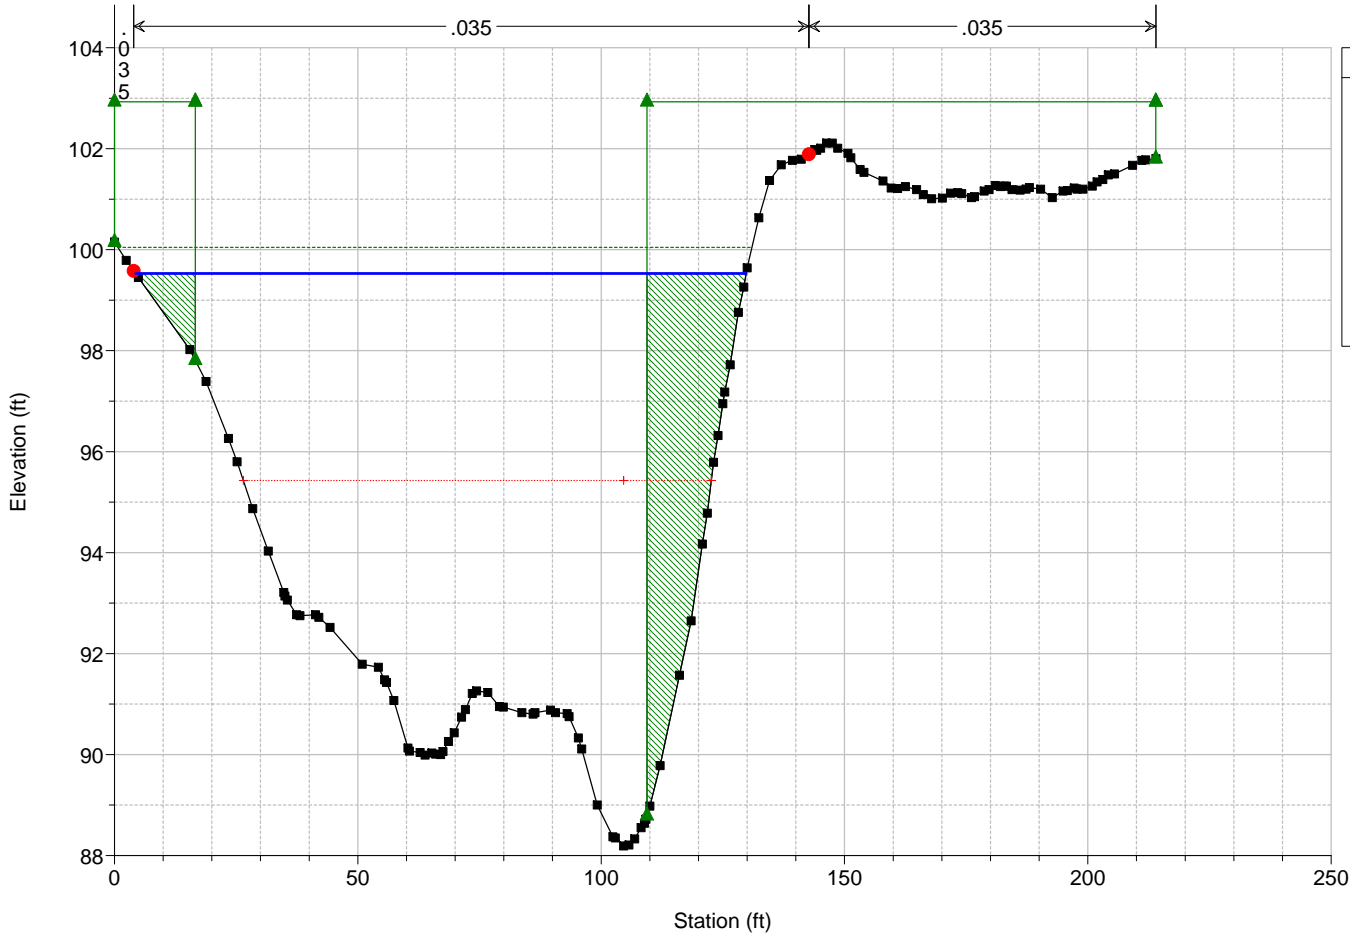



HEC-RAS Model Plan: ExistingNapaBE

River = Dry Creek Reach = Dry Creek RS = 1765 BR

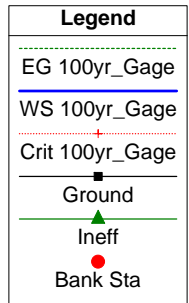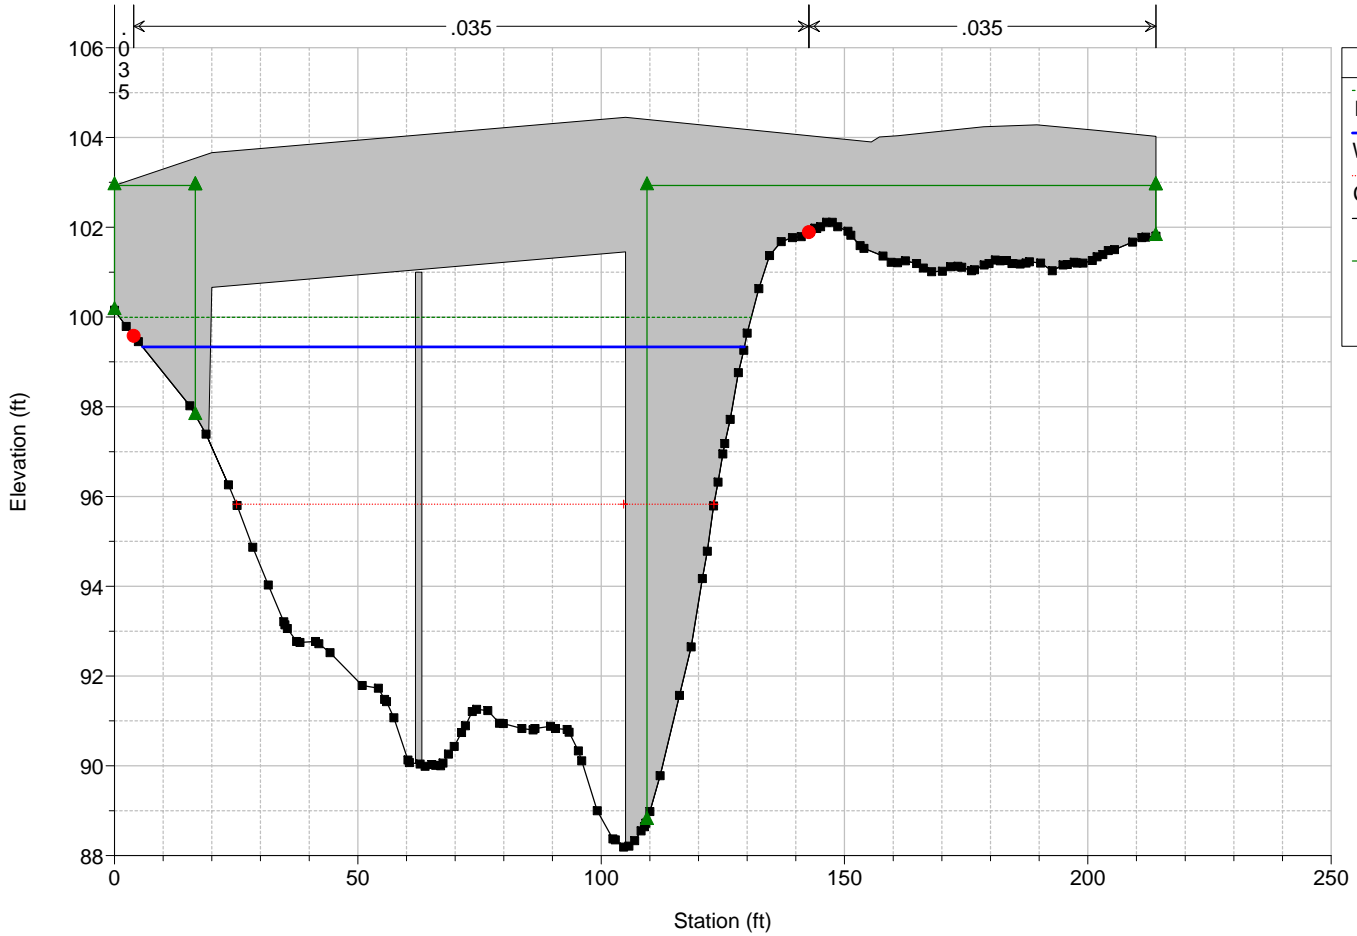



HEC-RAS Model Plan: ExistingNapaBE

River = Dry Creek Reach = Dry Creek RS = 1765 BR

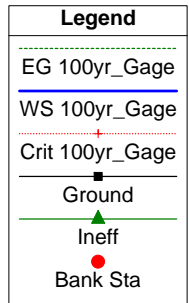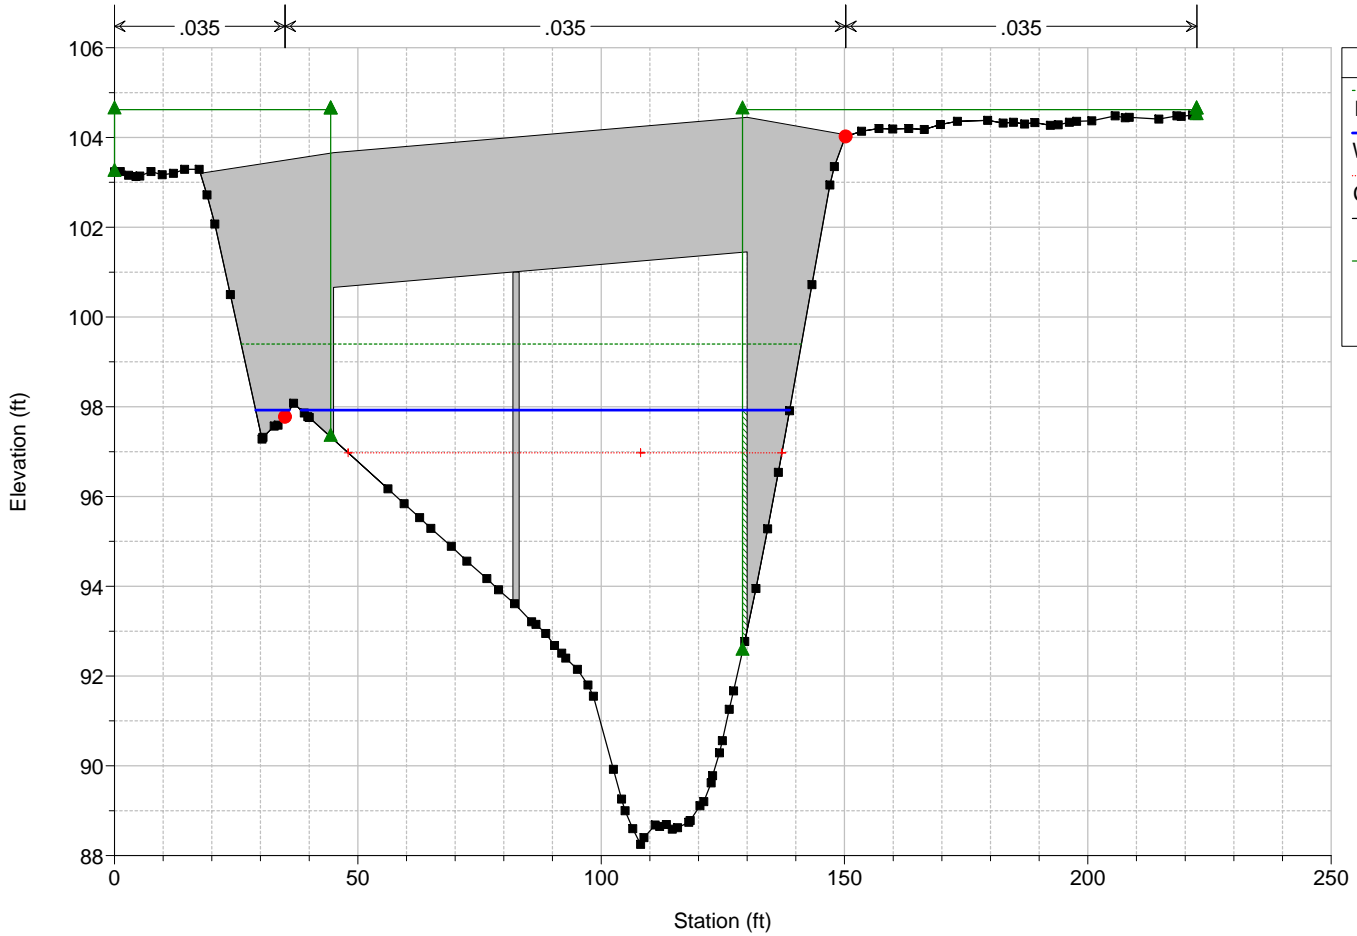



HEC-RAS Model Plan: ExistingNapaBE

River = Dry Creek Reach = Dry Creek RS = 1709

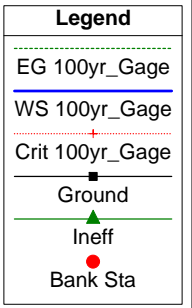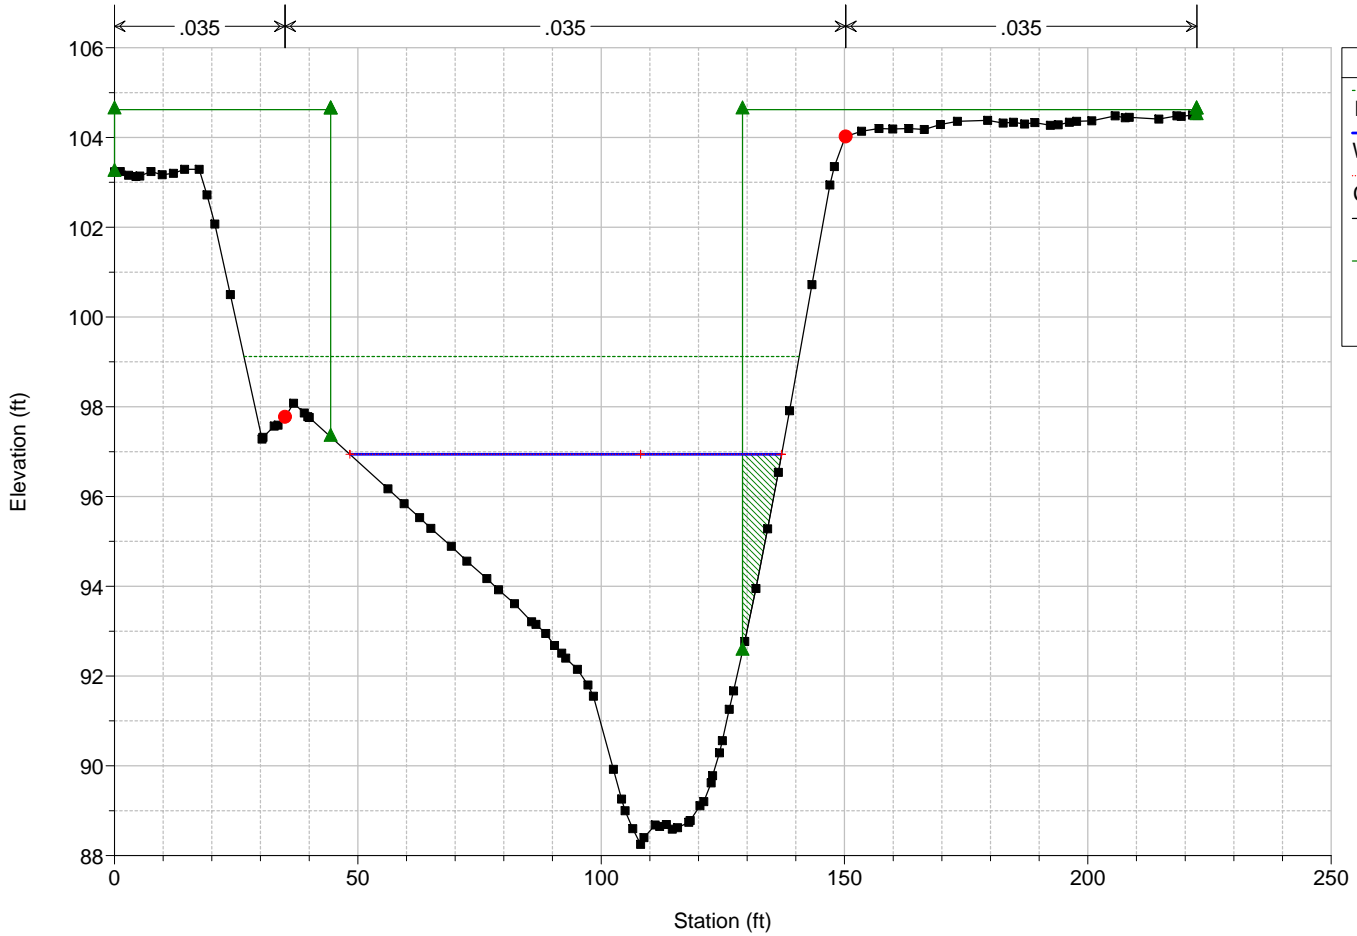

HEC-RAS Model Plan: ExistingNapaBE



River = Dry Creek Reach = Dry Creek RS = 1703

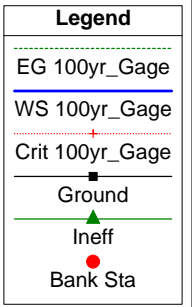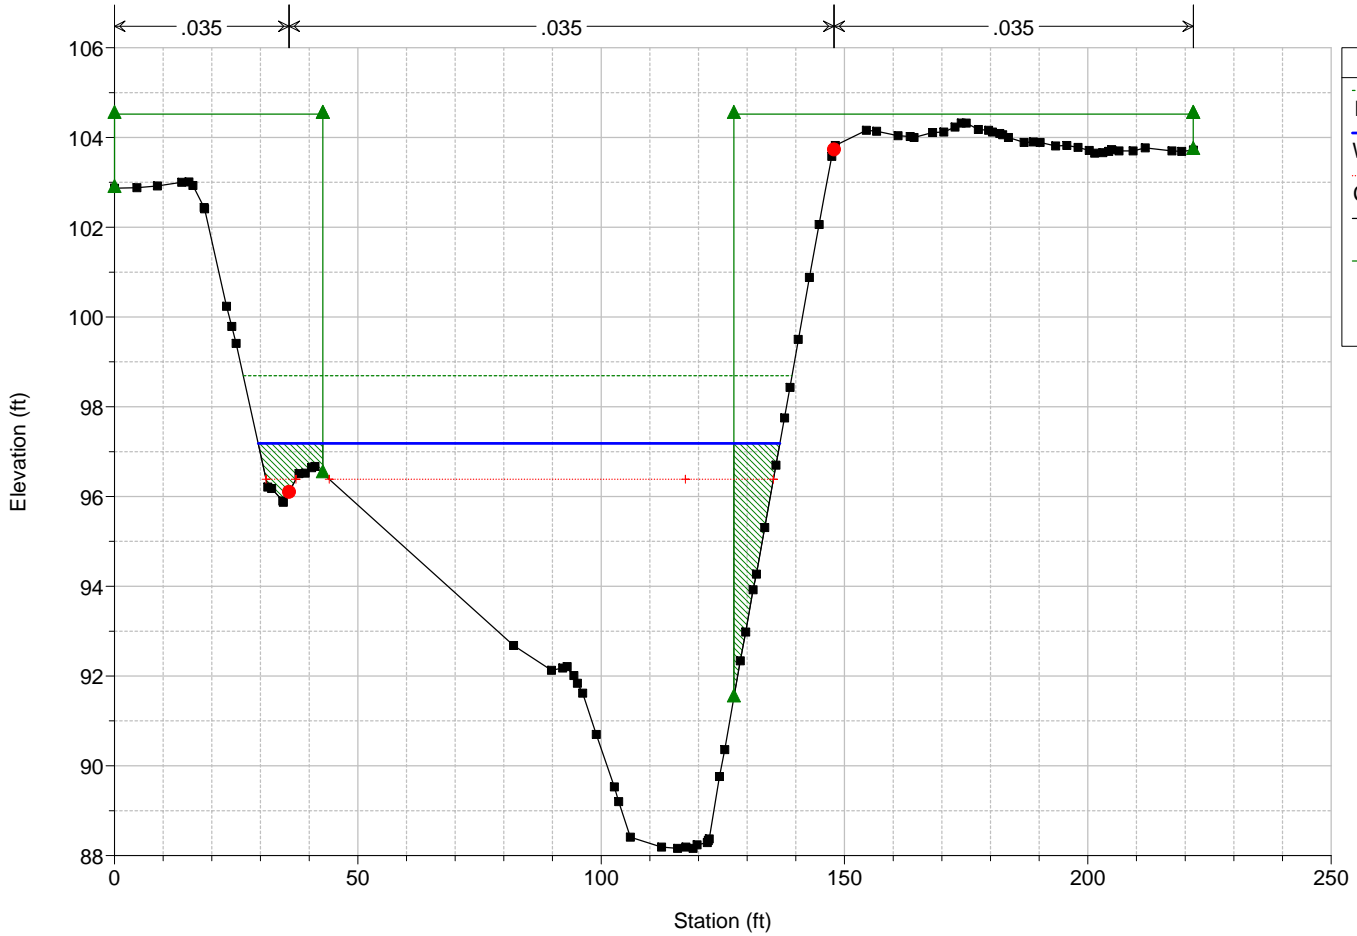





HEC-RAS Model Plan: ExistingNapaBE

River = Dry Creek Reach = Dry Creek RS = 1700

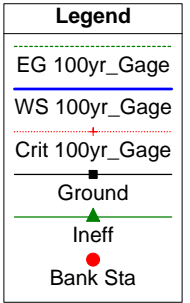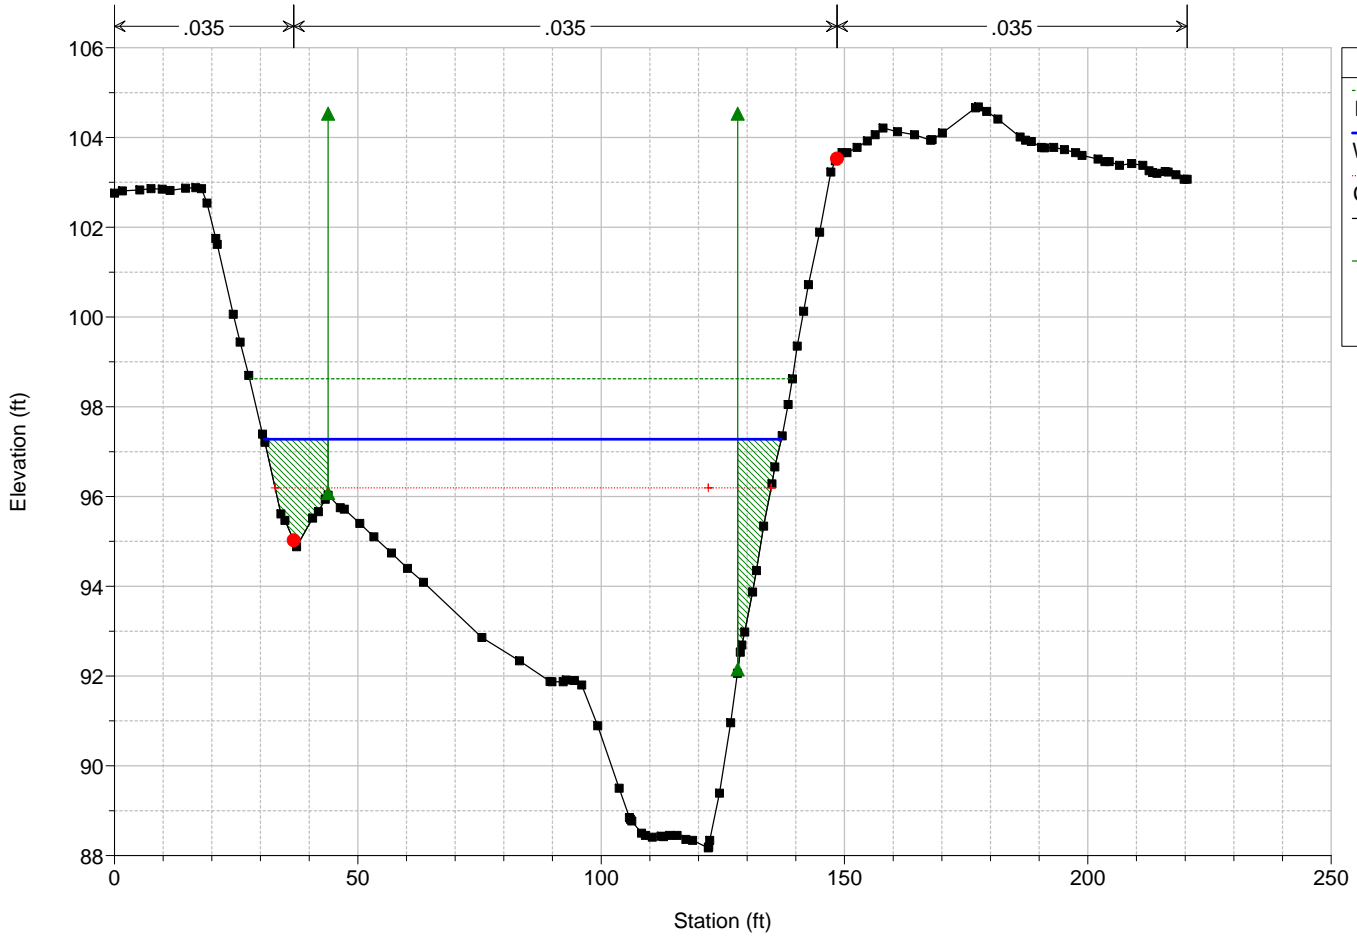



HEC-RAS Model Plan: ExistingNapaBE

River = Dry Creek Reach = Dry Creek RS = 1697

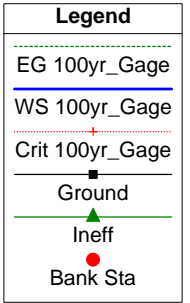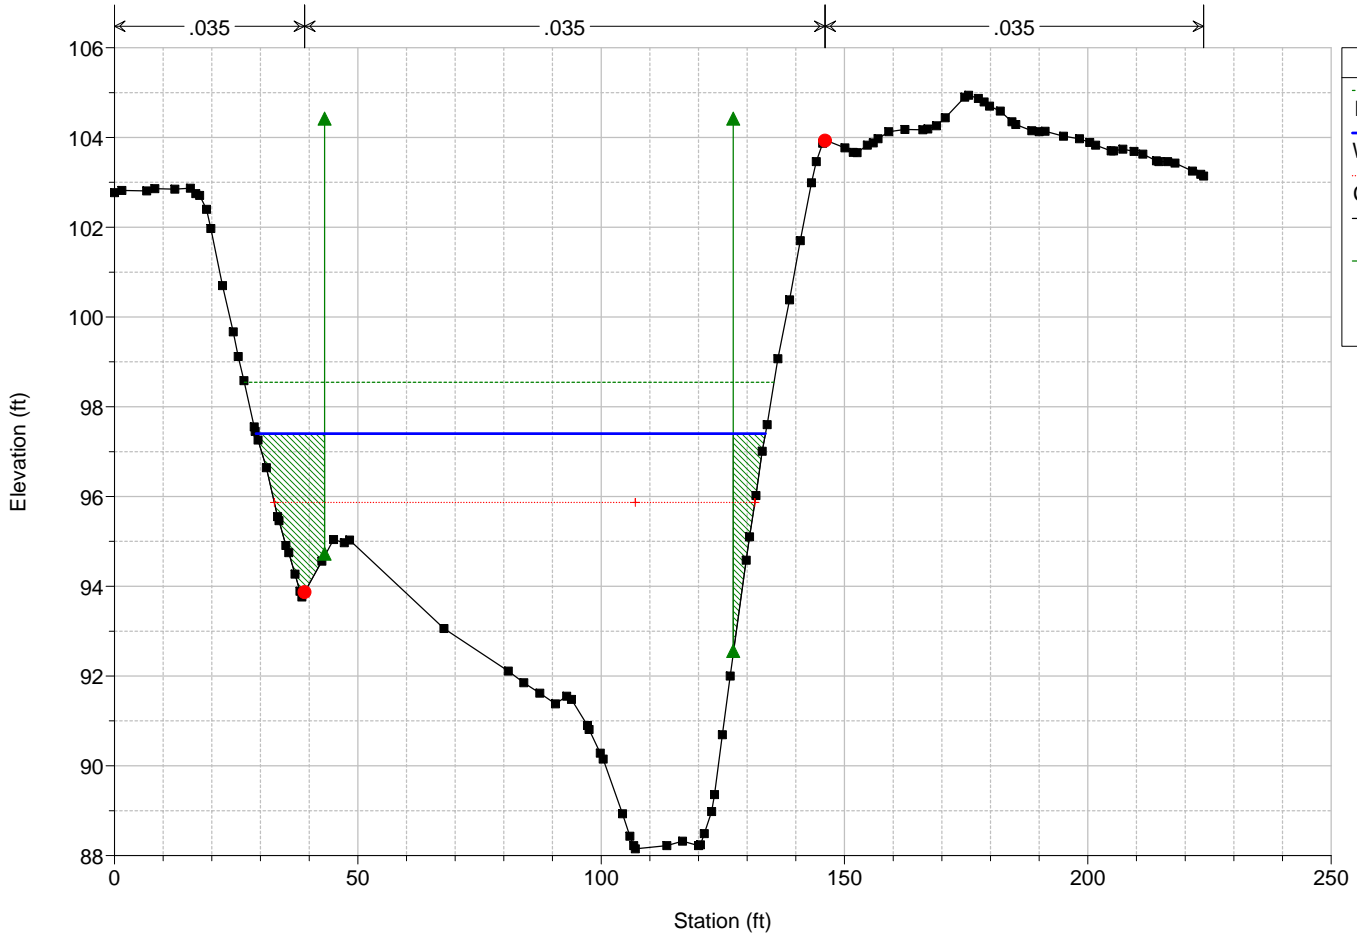



HEC-RAS Model Plan: ExistingNapaBE

River = Dry Creek Reach = Dry Creek RS = 1691

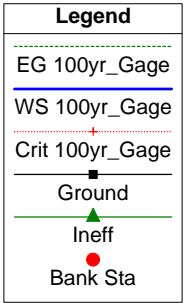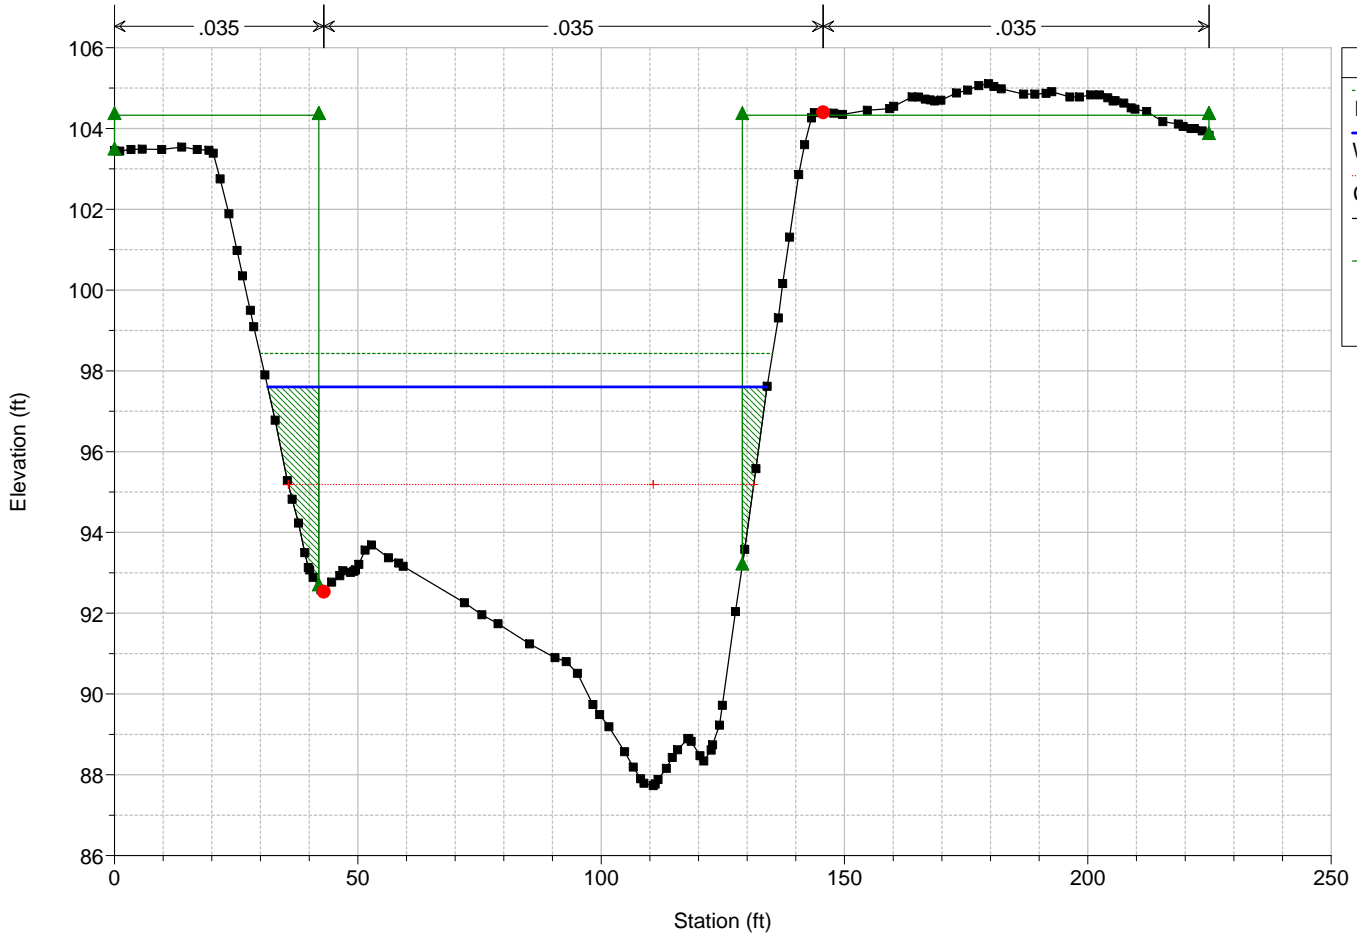


HEC-RAS Model Plan: ExistingNapaBE

River = Dry Creek Reach = Dry Creek RS = 1674 BR

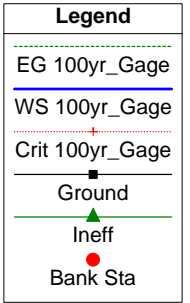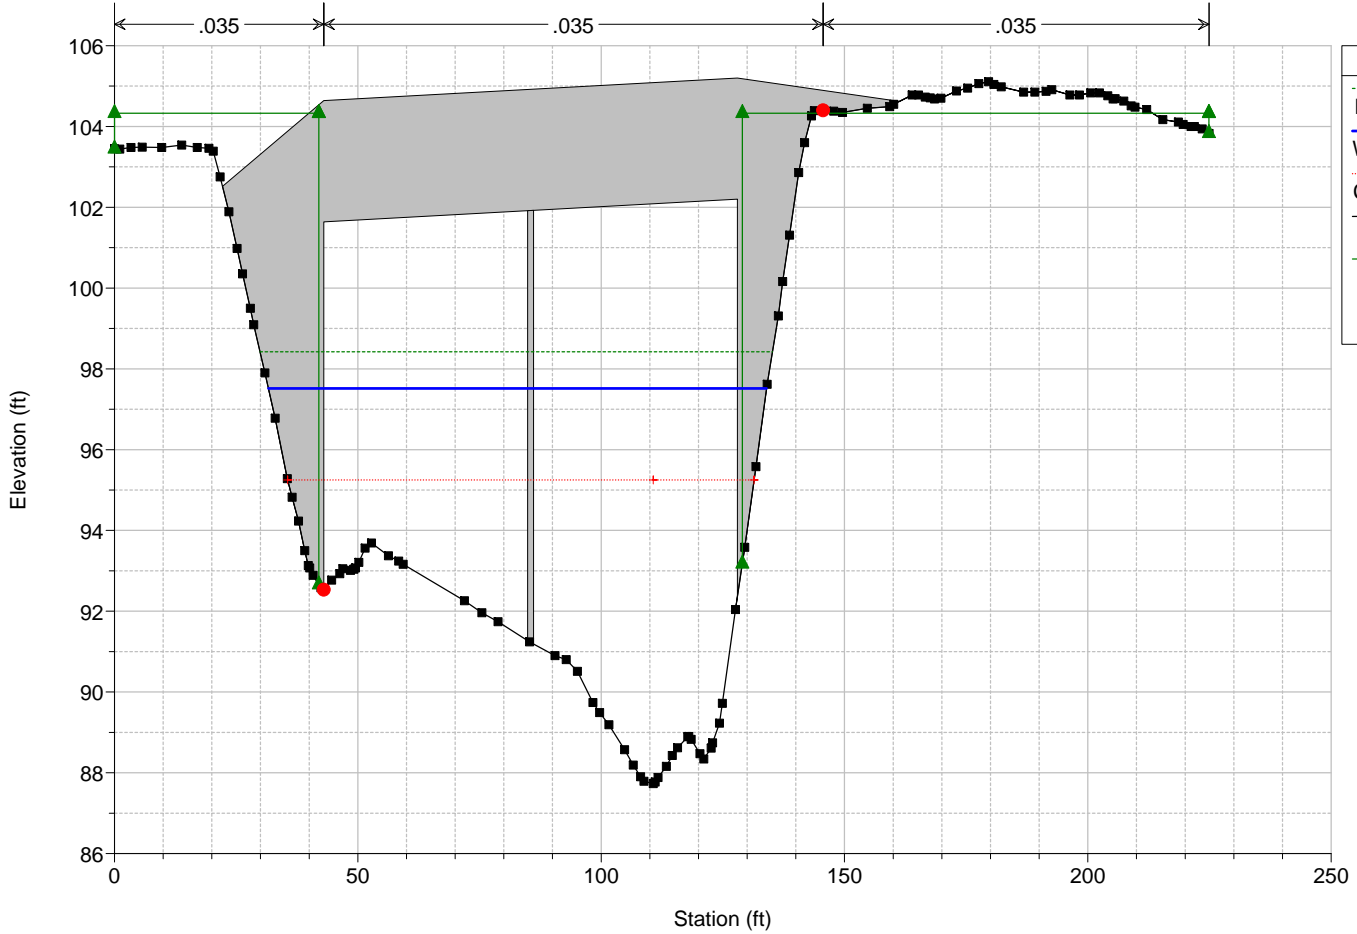


HEC-RAS Model Plan: ExistingNapaBE  
 River = Dry Creek Reach = Dry Creek RS = 1674 BR

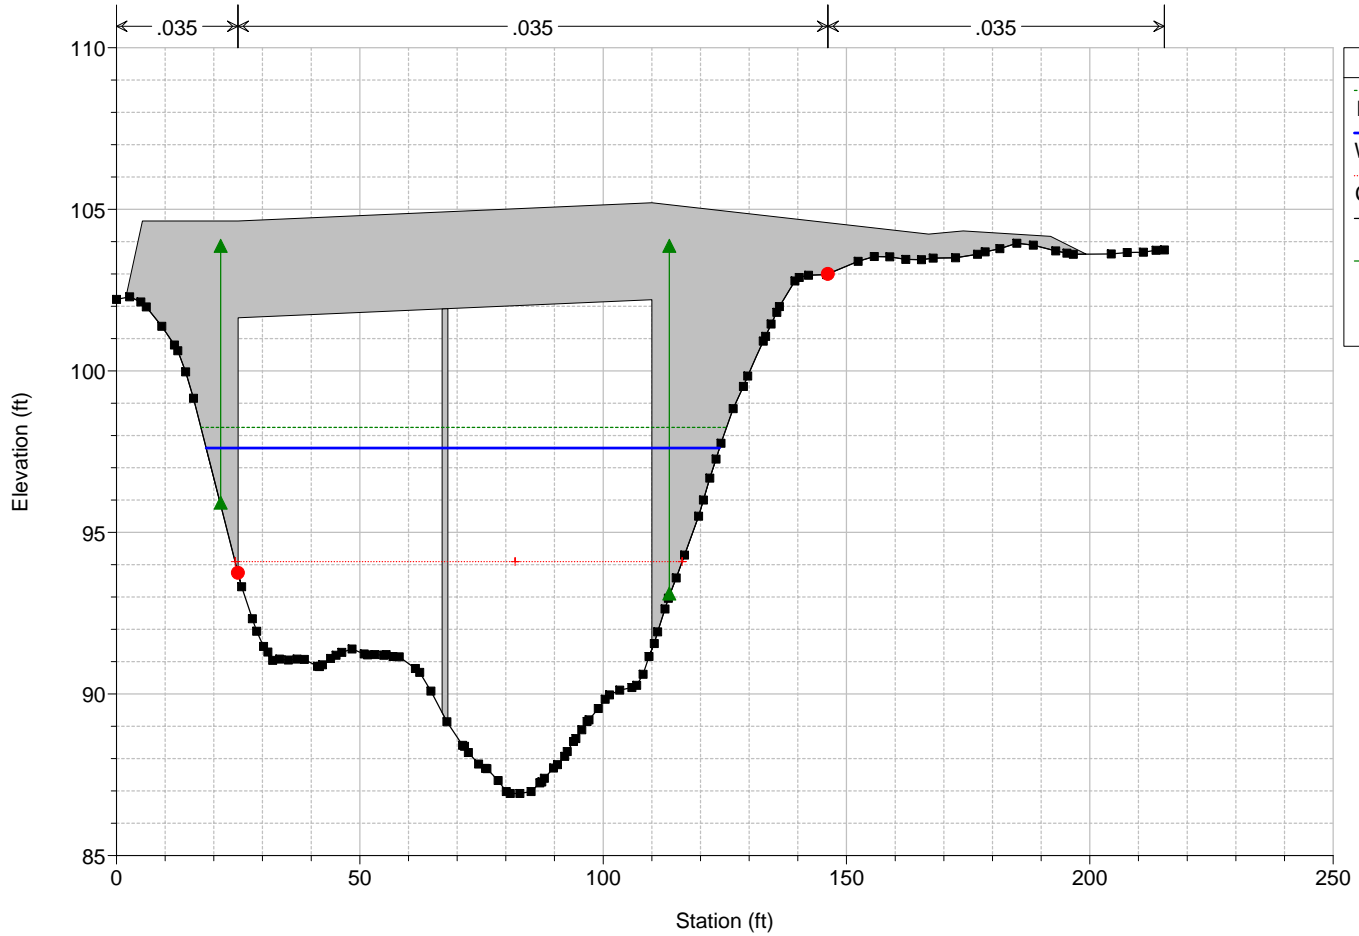

Legend	
EG 100yr_Gage	--- (dashed green line)
WS 100yr_Gage	— (solid blue line)
Crit 100yr_Gage	—+ (dotted red line with cross)
Ground	■ (black square)
Ineff	▲ (green triangle with vertical line)
Bank Sta	● (red circle)

HEC-RAS Model Plan: ExistingNapaBE  
 River = Dry Creek Reach = Dry Creek RS = 1645


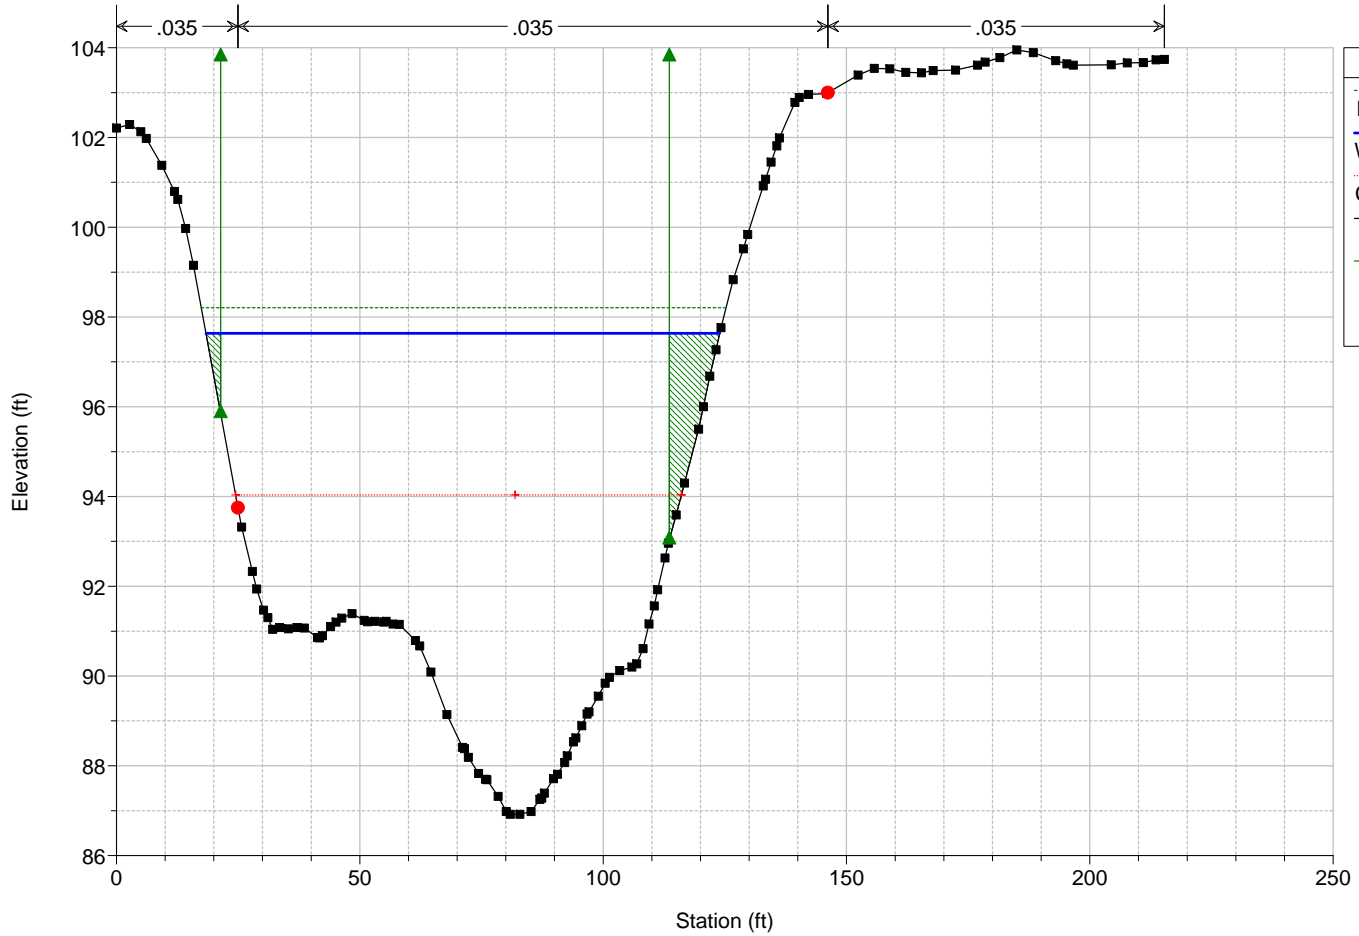


Legend	
EG 100yr_Gage	--- (dashed green line)
WS 100yr_Gage	— (solid blue line)
Crit 100yr_Gage	—+ (dotted red line with cross)
Ground	■ (black square)
Ineff	▲ (green triangle with vertical line)
Bank Sta	● (red circle)





HEC-RAS Model Plan: ExistingNapaBE

River = Dry Creek Reach = Dry Creek RS = 1615

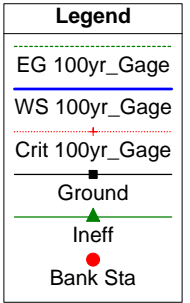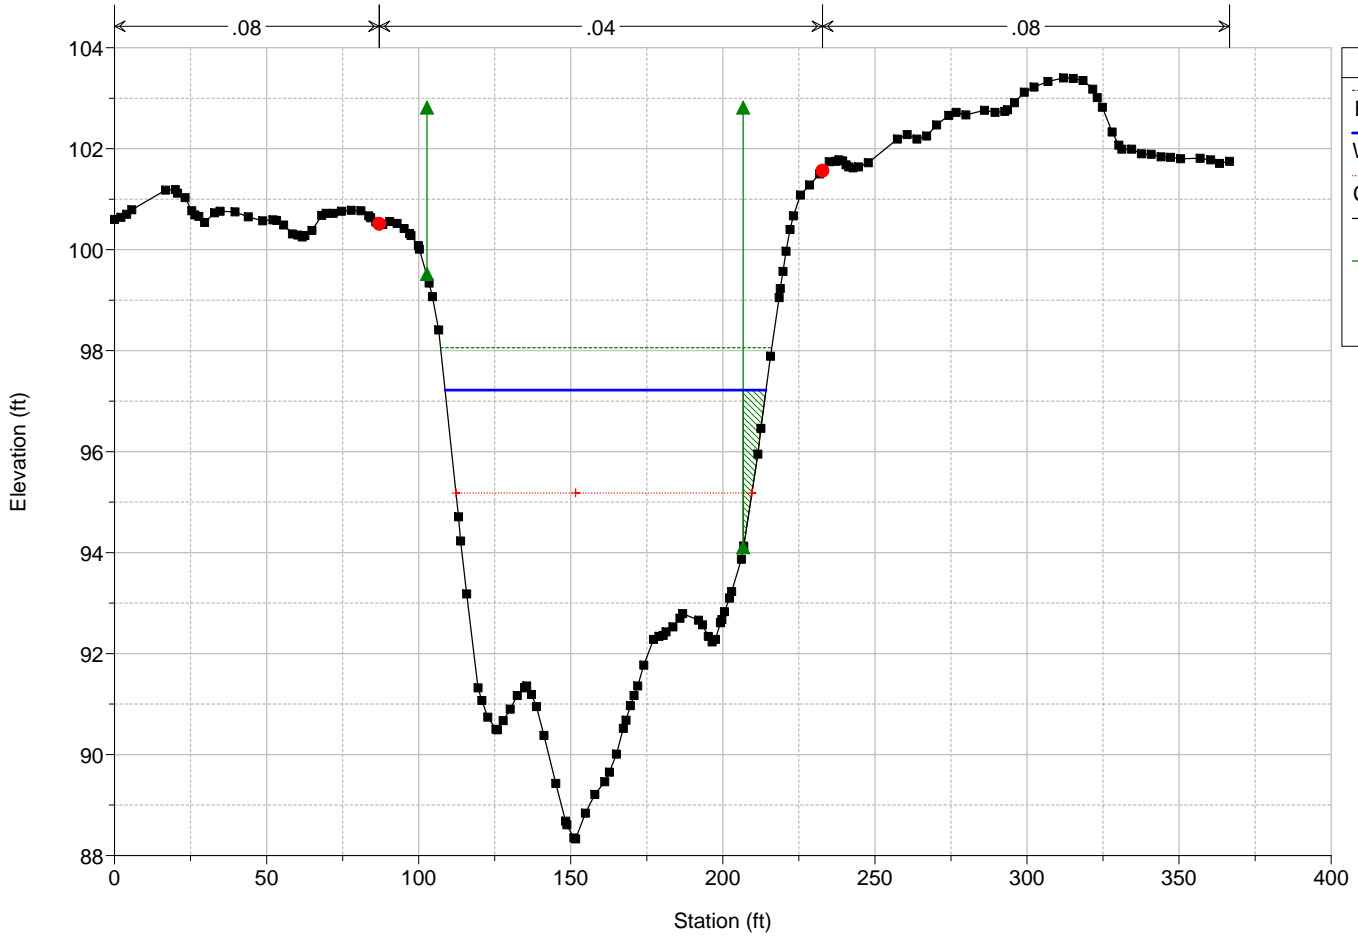


HEC-RAS Model Plan: ExistingNapaBE

River = Dry Creek Reach = Dry Creek RS = 1539

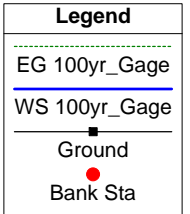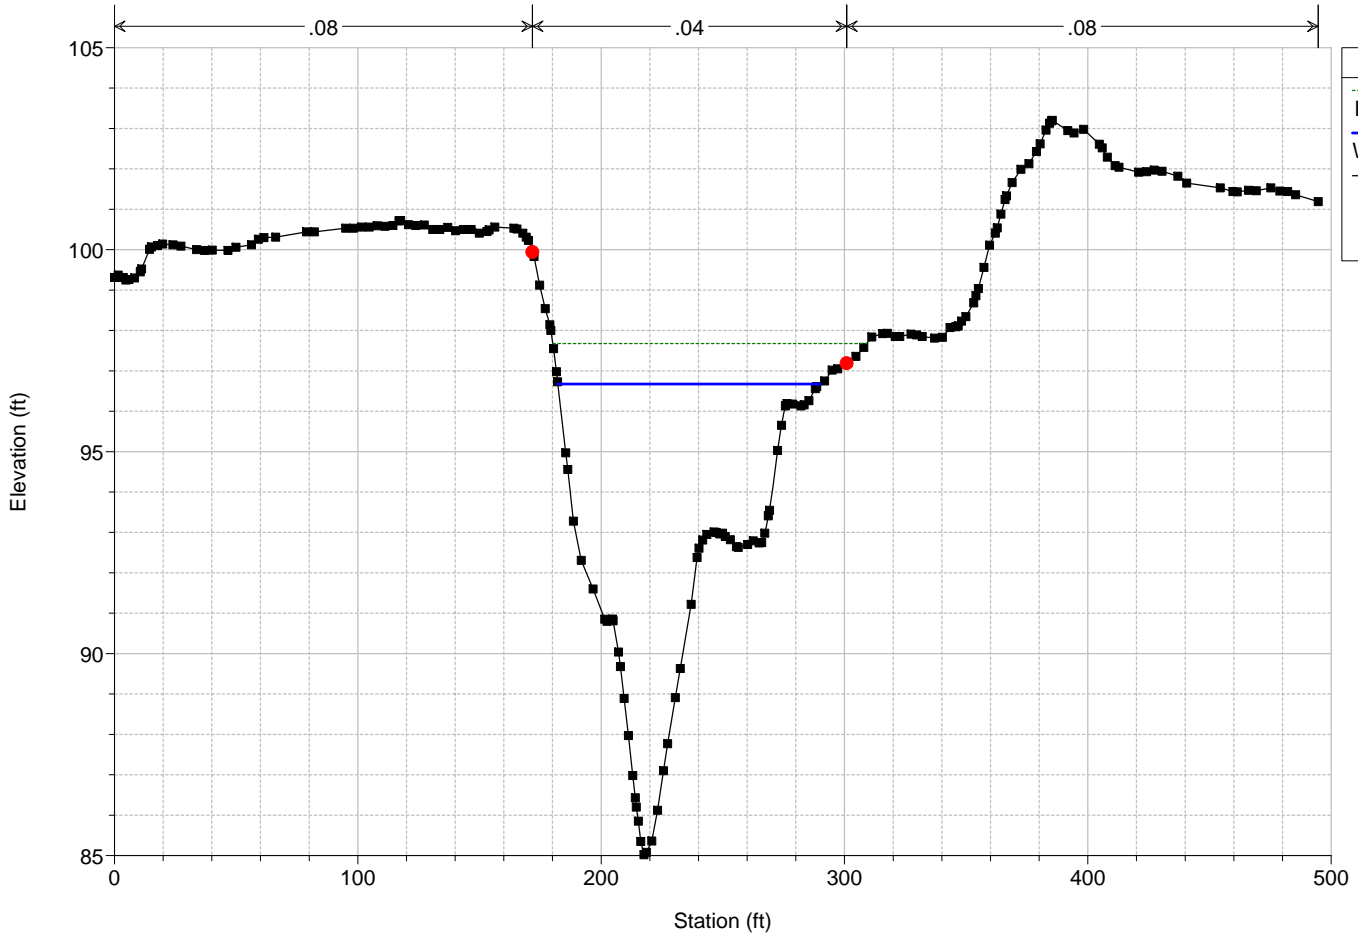

HEC-RAS Model Plan: ExistingNapaBE

River = Dry Creek Reach = Dry Creek RS = 1000

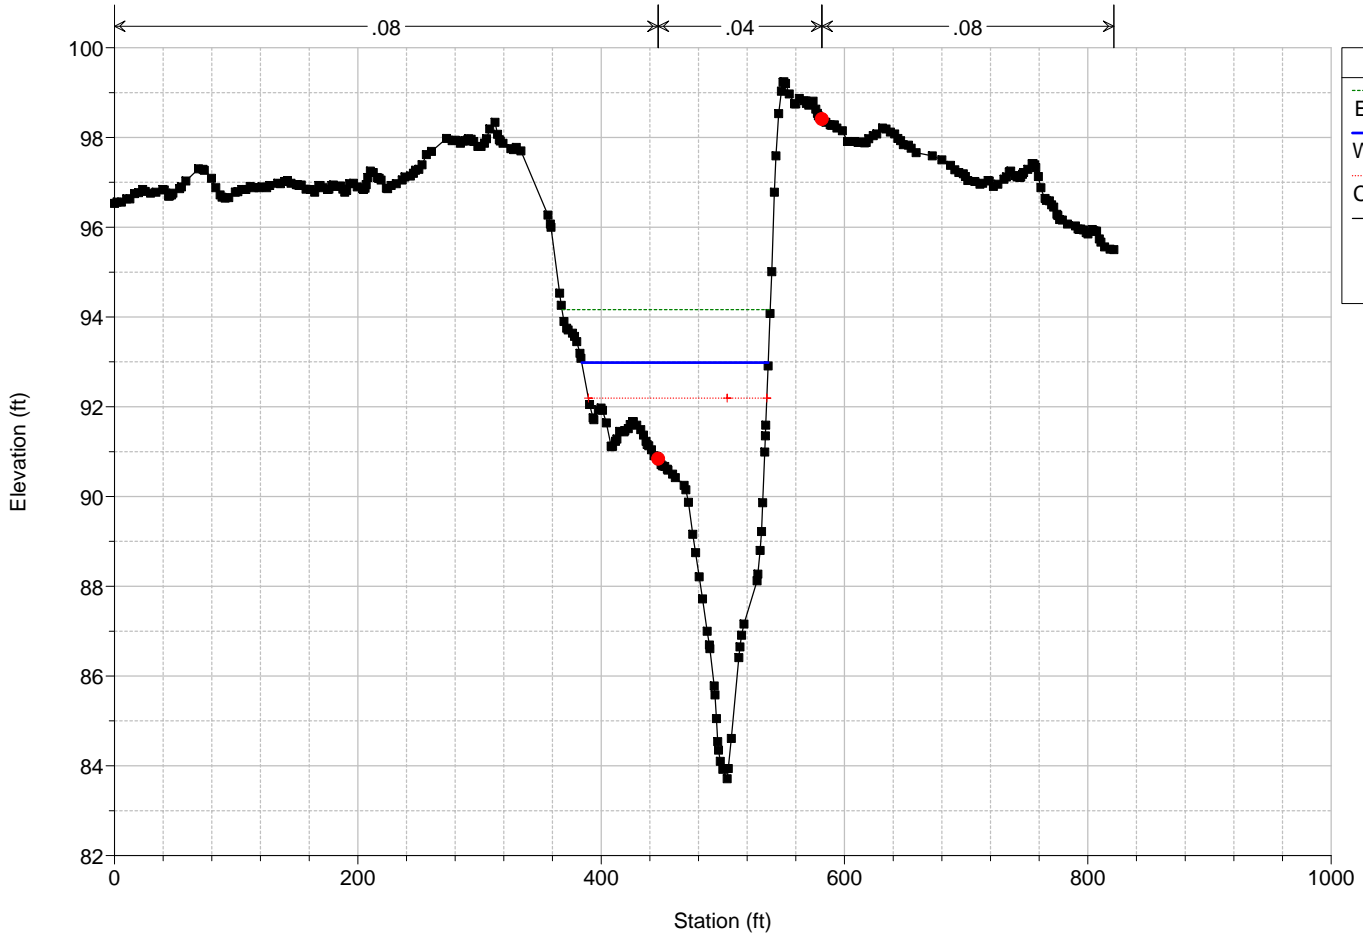


Legend	
EG 100yr_Gage	
WS 100yr_Gage	
Crit 100yr_Gage	
Ground	
Bank Sta	

**Attachment 6: HEC-RAS Stream Profile**



HEC-RAS Model Plan: ExistingNapaBE

Dry Creek Dry Creek

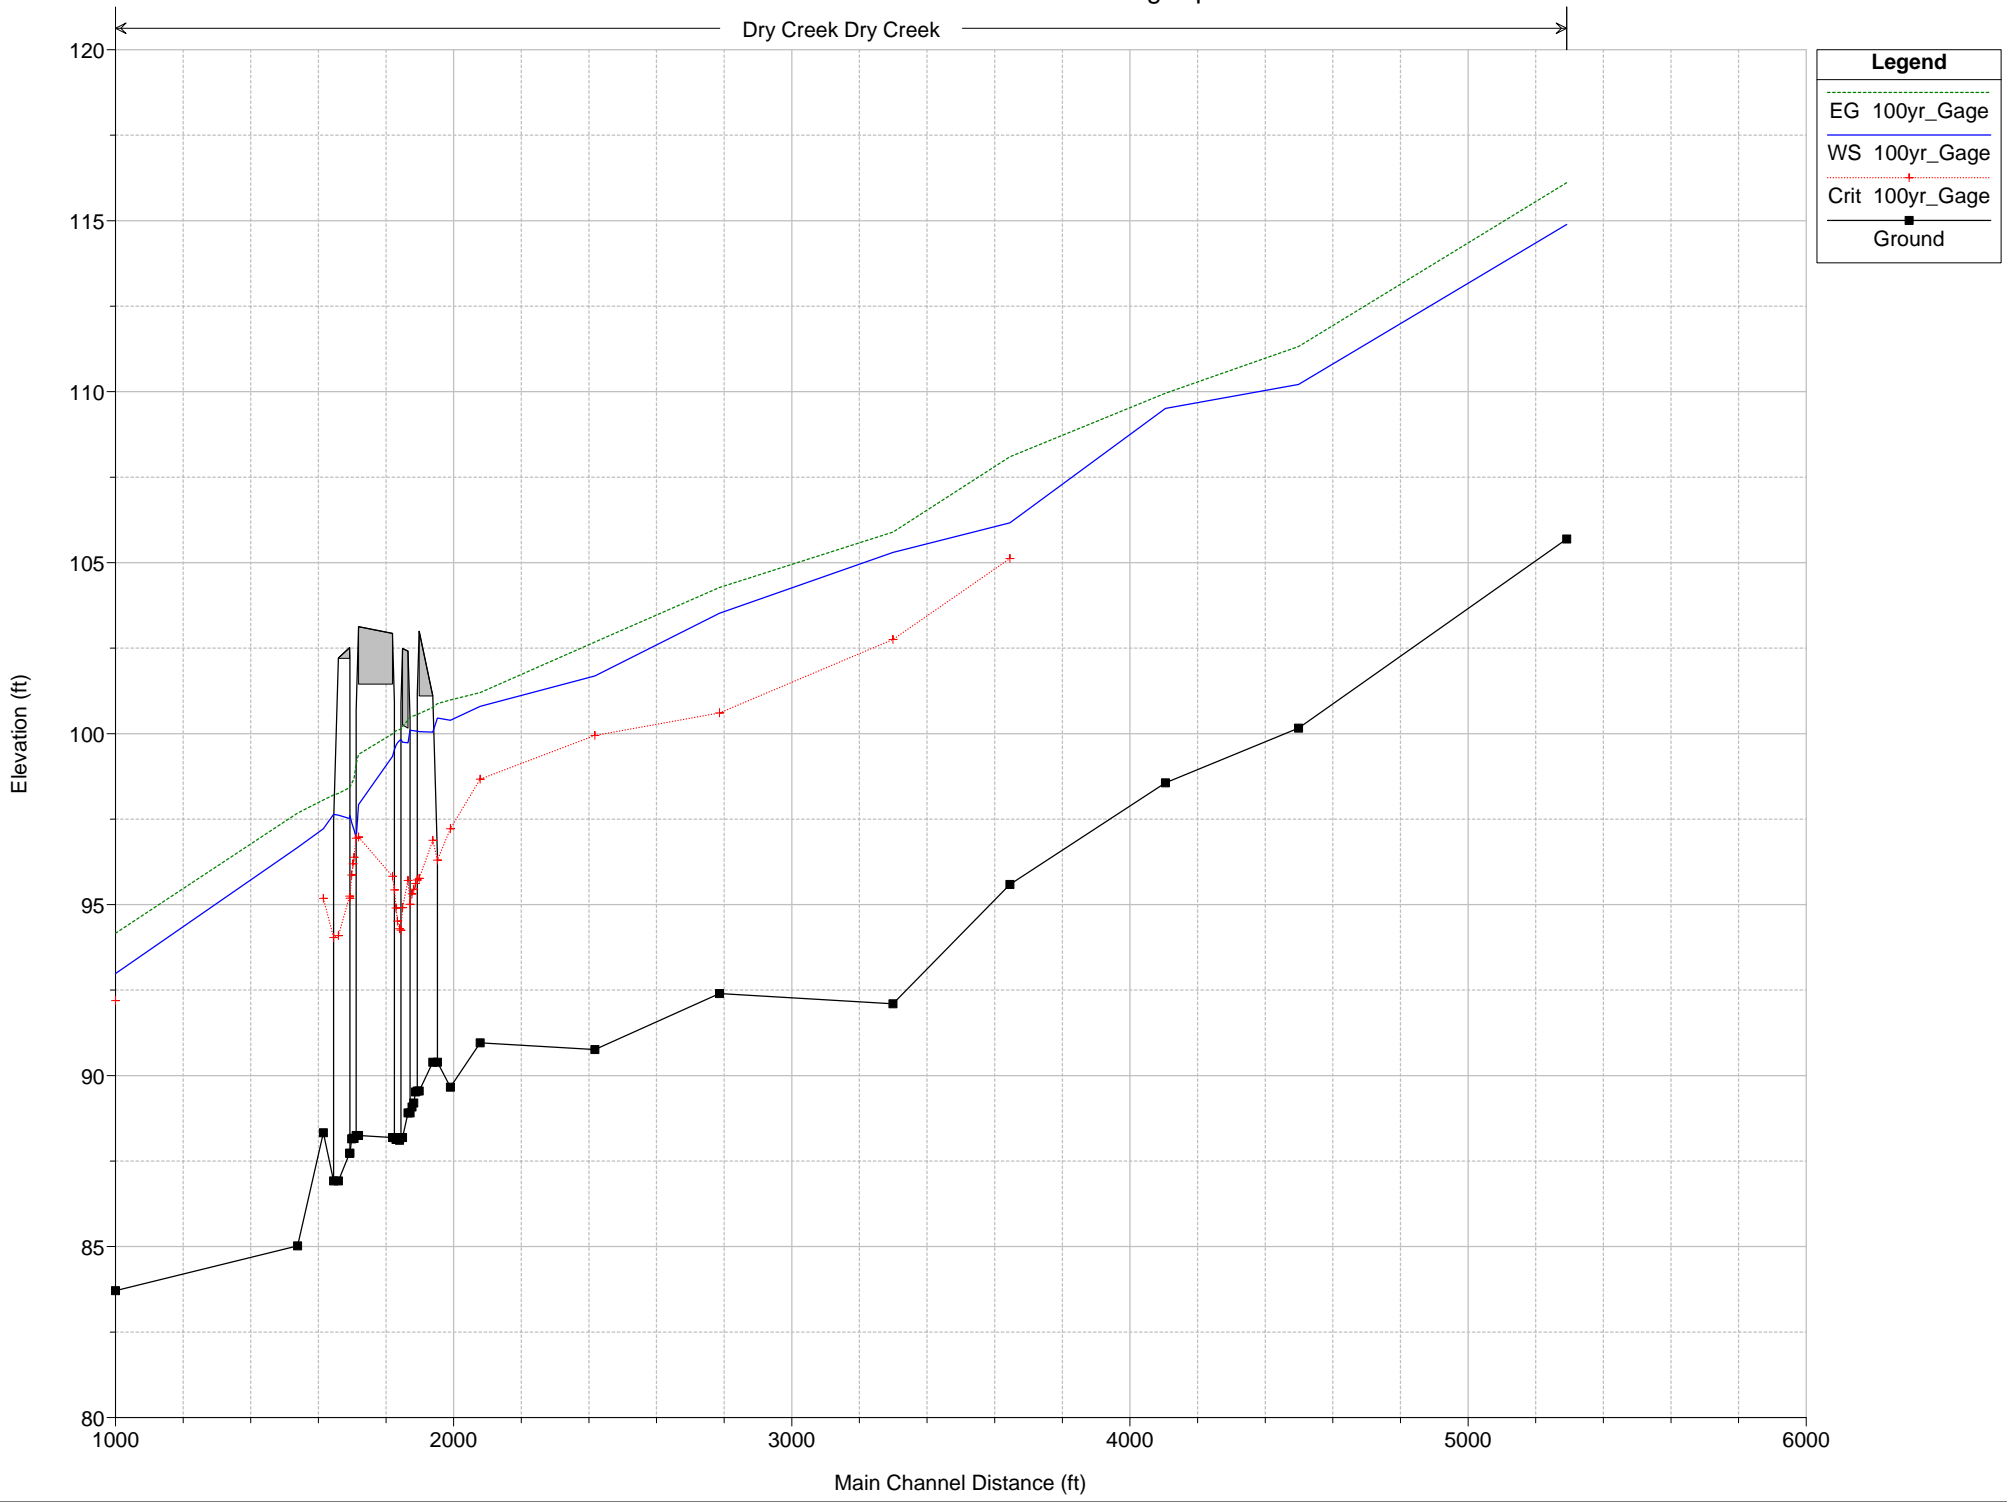

**Legend**

- EG 100yr\_Gage
- WS 100yr\_Gage
- Crit 100yr\_Gage
- Ground