

APPENDIX I

SEWER ASSESSMENT

SANITARY SEWER CAPACITY STUDY

for

Shapell Norwalk Apartments

Norwalk, California

At the corner of Alondra Blvd and Maidstone Ave

December 30, 2021

Prepared for:

Shapell Properties

11200 Corbin Ave. Suite 201

Porter Ranch, CA 91326

KHA Project # 094896004

© 2021 Kimley-Horn and Associates, Inc.

TABLE OF CONTENTS

Narrative Sections

- I. Project Description
- II. Existing Conditions
- III. Proposed Conditions
- IV. Analysis
- V. Conclusion

Appendix Sections

- 1) Aerial of Project Area and Existing Sewer Lines
- 2) City of Norwalk Master Plan: Loading for Each Class of Land Use Table
- 3) FlowMaster Calculations and Results
- 4) Record Drawings and County Facilities Exhibit

I. Project Description

The Norwalk Apartments (hereinafter referenced as the proposed Project) is located on the South-east corner of Alondra Blvd and Maidstone Ave, Norwalk, California. The Site was initially used for a commercial multi-tenant building with parking lot surrounding the building. That building has since been demolished with only the pad remaining. Now, the site is currently used as a storage lot.

II. Existing Conditions

The 8.07 acre site is bound by Alondra Blvd. to the North, Maidstone Ave. and existing Weinerschnitzel to the west, single family residential to the south, and a parking lot to the east. The existing project site is a building pad from the previous development and surrounding parking stalls. Most of the site is impervious with gentle slopes that generally run from Northwest to Southeast. A portion of the site slopes to the southwest to Maidstone.

There is an existing 8” sewer line running down Maidstone Ave that runs south down to Harvard Dr. (Note: Harvard Dr. was previously 165th St.) where it connects to sewer manhole B5-NW6439 (See Exhibit 2 in Appendix 1). On the southwest end of the project, there is an existing 8” sewer main that runs south down Flallon Ave. to Harvard Dr. where it connects the Harvard Dr. sewer main at manhole B5-NW6436(See Exhibit 2 in Appendix 1). Flallon Ave. and Maidstone Ave. sewer mains connect to an existing 8” sewer main in Harvard Dr. The Harvard Dr. main then sizes up from a 8” to a 10” sewer main at the McRae intersection and that 10” main continues west until it reaches a lift station at the Gridley Rd at manhole B5-MO2185. Existing sewer system information has been taken from as-builts as well as from the Norwalk Sewer Master Plan. The Sewer Master Plan provided crucial information about the existing sewer system such as flow in each sewer segment (GPM) as well as flow depth in each sewer segment (d/D). The sewer system in this area was sized with the assumption that the City Master Plan analyzed this site as commercial.

III. Proposed Conditions

The Proposed Site will install a 8-inch sewer line, connecting to the existing 8” sewer line in Flallon Ave. The proposed sewer connects to each building and runs down towards Flallon Ave. The minimum sewer slope in the proposed onsite sewer system is 0.5%. Given the minimum slope, and a max d/D of 0.5, the maximum capacity allowable for the private sewer system is 166 GPM. (See Flowmaster calculations in Appendix 3)

IV. Analysis

The purpose of this report is to conduct a sewer study on the impact of use change from commercial to multi-family residential on the existing public sewer system. Based on the city master plan flow rate Table 3-72, the proposed use change will generate an additional 5.4 GPM peak flow. Refer to calculations in Appendix 3. As shown in the Flowmaster calculations in Appendix 3, the max allowed capacity for an 8 in pipe with a d/D of 0.5 maximum would be 166 GPM, this far exceeds our proposed 13.79 GPM produced by the multi-family site. Excerpts from the Norwalk master plan (See Appendix 4) provided flows, velocities, and d/D ratios for every pipe segment in the sewer system in the general vicinity of the proposed project. Adding the additional flow produced as a result of the zoning change (see table below), to the flows provided in the excerpts from the master plan, we can determine if the existing sewer system has the additional capacity to take the additional flow.

Table 1: Produced Flow Table

City of Norwalk Adjusted Generation Rates	
High Density Residential	2461 GPD
Commercial	1500 GPD
Project Area	8.07 AC
Peak Flow Factor	3
Residential Peak Flow	13.79 GPM
Commercial Peak Flow	8.41 GPM
Flow Difference from Conversion	5.39 GPM

V. Conclusion

Knowing the size and slope of the existing sewer lines in Flallon and Harvard Dr., and utilizing the data pulled from the Norwalk Sewer Master Plan (See Appendix 4), we can determine the affects of the additional flow on the sewer system as well as the new d/D ratios for all of the sewer segments. The maximum d/D is 0.5 for pipes 6” to 15” from Table 6-2 of City Sewer Master Plan.


Table 2: System Load Check

City of Norwalk Sewer Station B5-NW7307		
	d/D Ratio	Flow (GPM)
Pre-Use Change	0.25	166.48
Post-Use Change	0.47	171.87
Station at Capacity	0.50	190.56

The only pipe segment close to max capacity is the segment between manholes B5-NW6451 and B5-NW7307 which has a d/D ratio of 0.25 including the anticipated flow produced from the project site commercially zoned (Refer to Appendix 3 for calculations and Appendix 4 for the Master plan sewer Map with manhole labels). With the addition of the 5.39 GPM produced due to the use change, and knowing that this 10” sewer line has a slope of 0.24% the d/D ratio of this segment only rises to 0.47. The existing pump station has a capacity for an additional 5.0 GPM flow. In conclusion, since the d/D ratio remains under 0.5, and this was the only segment of concern in the vicinity, the existing sewer system has the capacity to accommodate the zoning change for the proposed project.

Appendix 1

Aerial of Project Area and Existing Sewer Lines

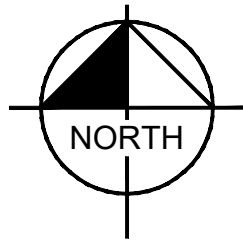

SCALE: 1"=150'

LEGEND

	PROPERTY LINE

SITE INFORMATION

LOT SIZE: 8.07 AC
BUILDING: 102,516 SF

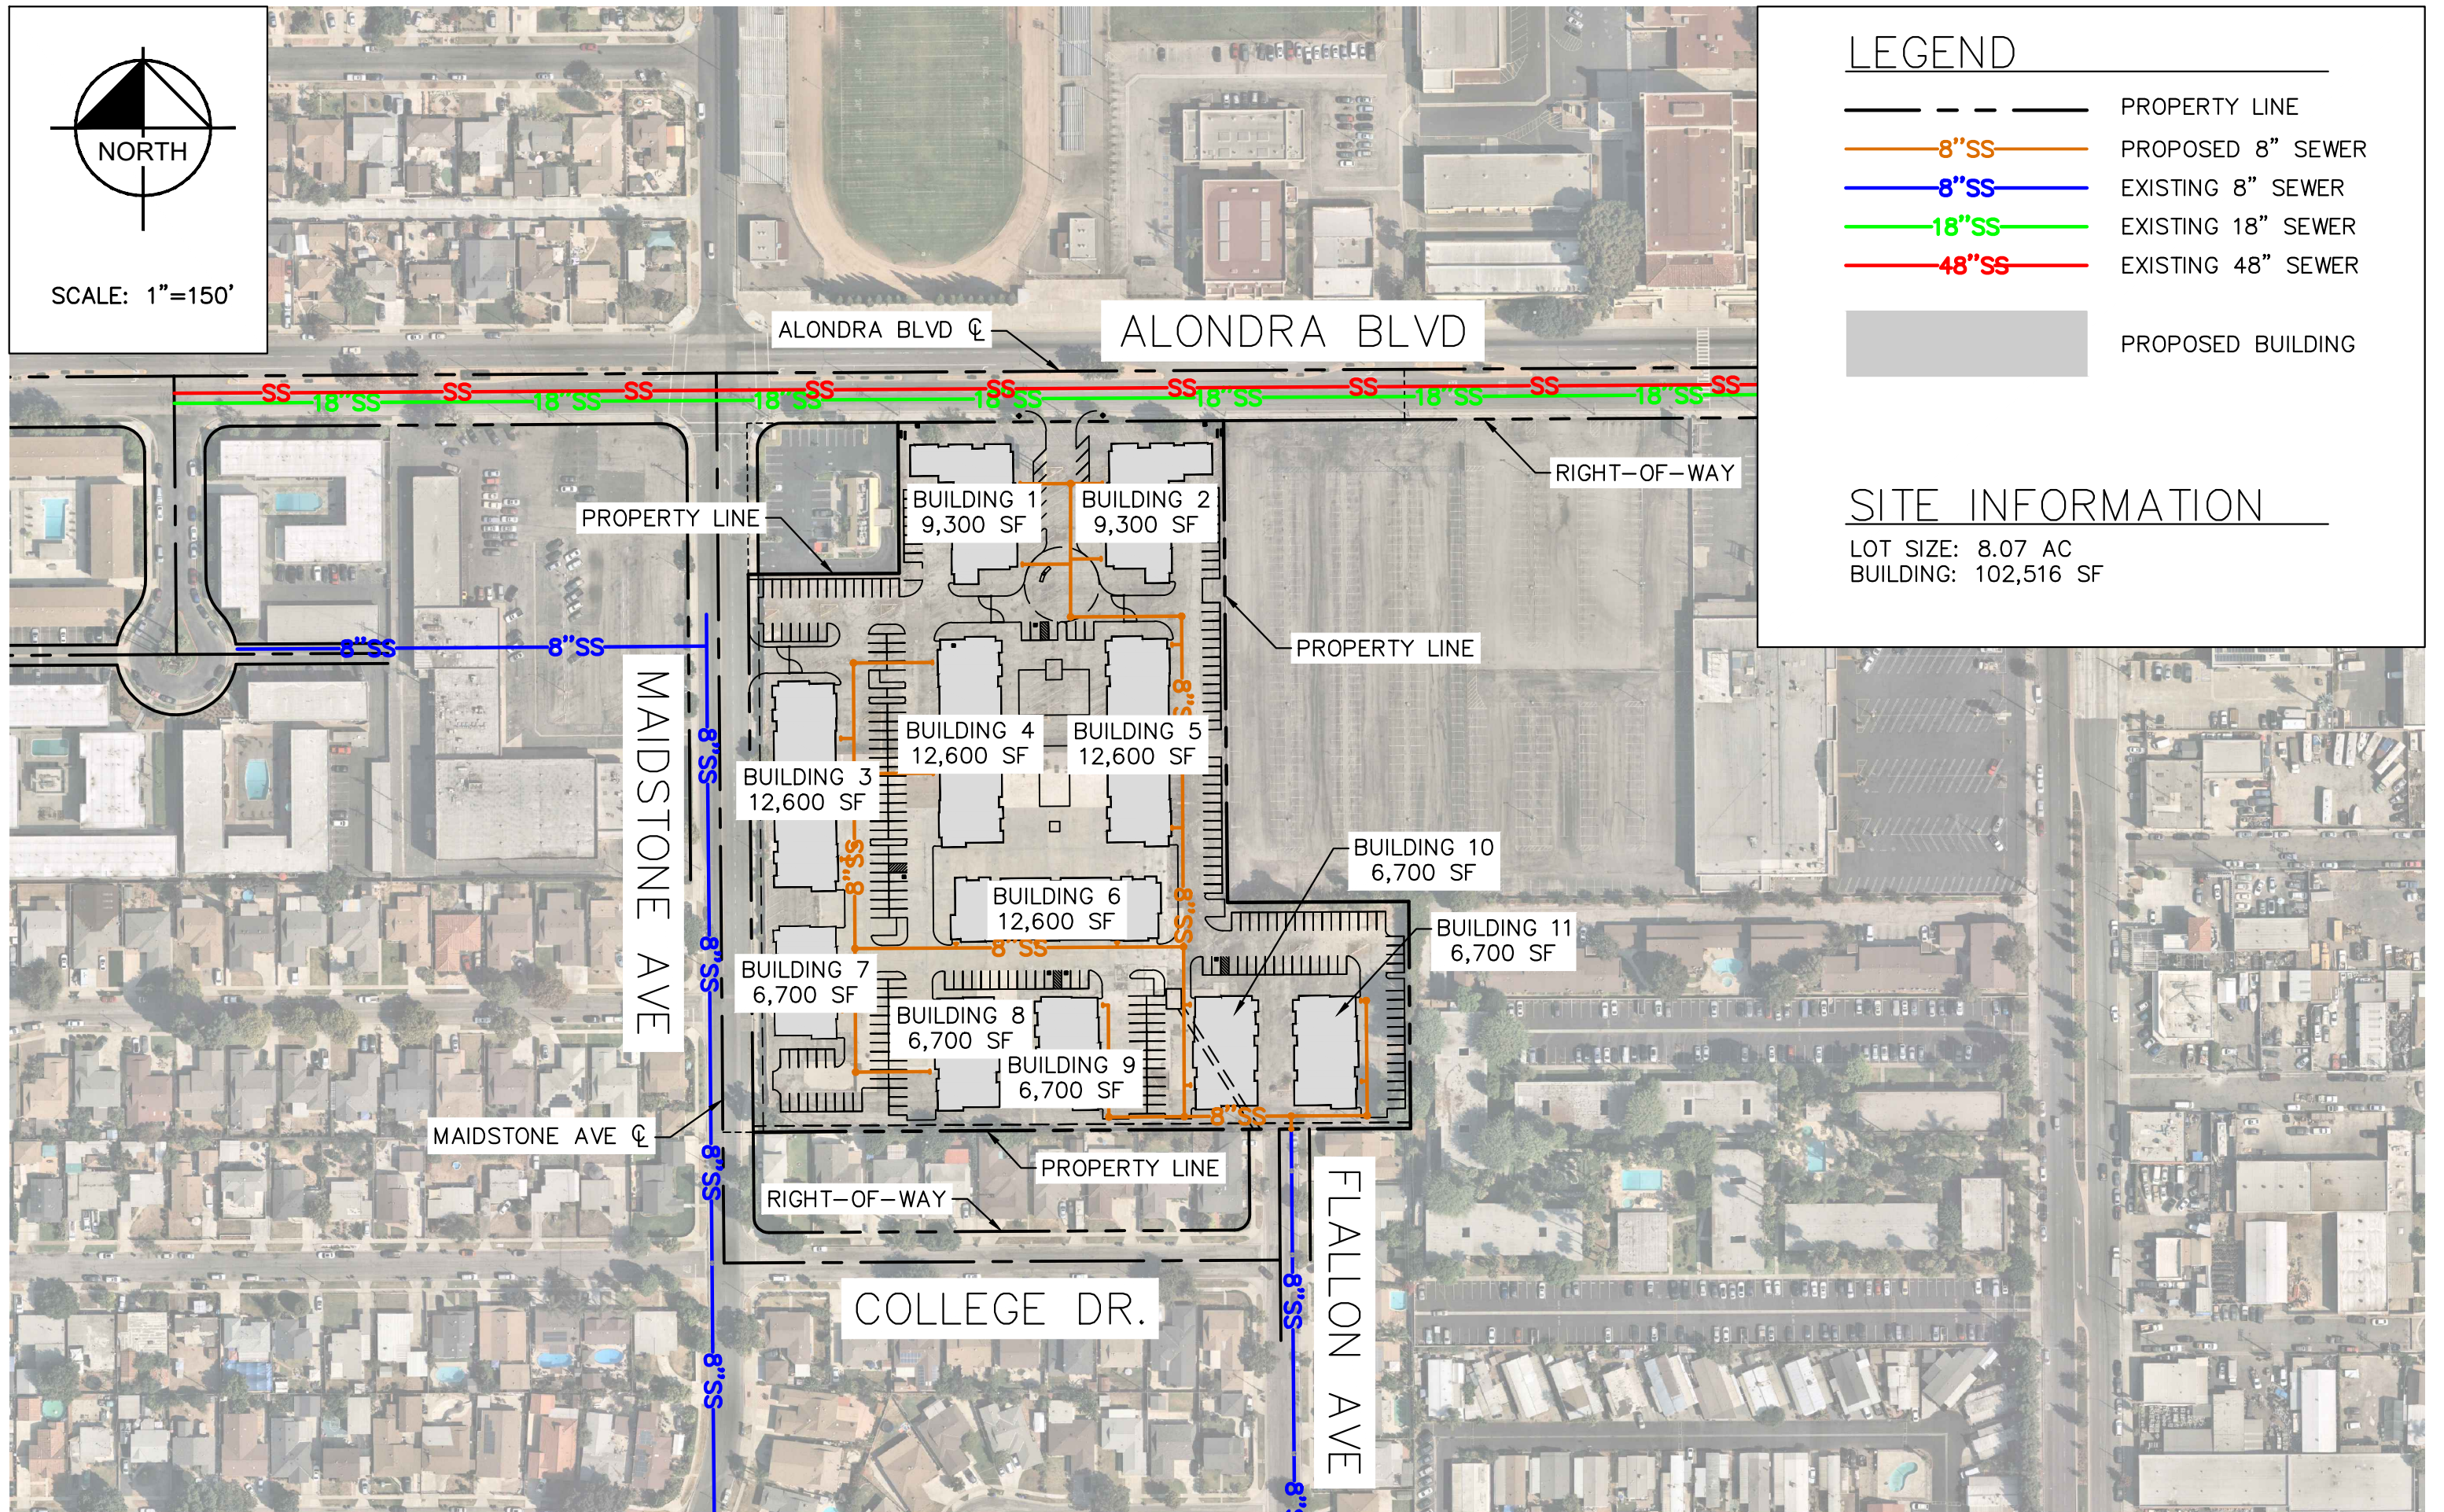


EXHIBIT A: PROPOSED ONSITE SEWER LAYOUT

Appendix 2
City of Norwalk Sewer Master Plan
Sanitary Sewer Typical Loading Table



CHAPTER 3 – FLOW MONITORING

Table 3-7. Ultimate Wastewater Generation Factors and Average Flows

Land Use Category	Acres	Wastewater Generation Factor ^(a) (gpd/ac)	Flow (gpd)
Residential			
Low Density Residential	2,615.1	1,231	3,217,881
Medium Residential	32.0	1,712	54,784
High Density Residential	331.3	2,461	815,206
Subtotal	2,978.4	1,373	4,087,871
Commercial	467.6	1,500	701,370
Industrial			
Light Industrial	155.8	1,500	233,670
Heavy Industrial	139.6	1,500	209,460
Subtotal	295.4	1,500	443,130
Institutional			
Institutional/Public Facility/School	435.9	550	239,729
Church	12.4	550	6,809
Subtotal	448.3	550	246,538
Hospitals			
LD Residential Hospital	155.5	1,800	279,972
Commercial Hospital	15.1	1,800	27,216
Subtotal	170.7	1,800	307,188
Other			
LD Resident. Fuel Storage Facility	47.3	500	23,650
Open Space	74.8	-	-
Streets	1,775.9	-	-
Subtotal	1,898.0	12	23,650
Total	6,258.2	928	5,809,746

(a) Ultimate System residential unit wastewater generation factors were calculated by multiplying Existing System residential unit wastewater generation factors by the estimated year 2035 population increase of 7.0%

Appendix 3
Calculations and Results

Onsite 8" Sewer Line Capacity

Project Description	
Friction Method	Manning Formula
Solve For	Discharge
Input Data	
Roughness Coefficient	0.015
Channel Slope	0.0050 ft/ft
Normal Depth	4.0 in
Diameter	8.0 in
Results	
Discharge	166.18 gpm
Flow Area	0.2 ft ²
Wetted Perimeter	1.0 ft
Hydraulic Radius	2.0 in
Top Width	0.67 ft
Critical Depth	3.4 in
Percent Full	50.0 %
Critical Slope	0.0089 ft/ft
Velocity	2.12 ft/s
Velocity Head	0.07 ft
Specific Energy	0.40 ft
Froude Number	0.731
Maximum Discharge	357.52 gpm
Discharge Full	332.36 gpm
Slope Full	0.0013 ft/ft
Flow Type	Subcritical
GVF Input Data	
Downstream Depth	0.0 in
Length	0.0 ft
Number Of Steps	0
GVF Output Data	
Upstream Depth	0.0 in
Profile Description	N/A
Profile Headloss	0.00 ft
Average End Depth Over Rise	0.0 %
Normal Depth Over Rise	50.0 %
Downstream Velocity	Infinity ft/s
Upstream Velocity	Infinity ft/s
Normal Depth	4.0 in
Critical Depth	3.4 in
Channel Slope	0.0050 ft/ft
Critical Slope	0.0089 ft/ft

Offsite Harvard 8" Sewer line Capacity

Project Description	
Friction Method	Manning Formula
Solve For	Discharge
Input Data	
Roughness Coefficient	0.015
Channel Slope	0.0024 ft/ft
Normal Depth	4.0 in
Diameter	8.0 in
Results	
Discharge	115.13 gpm
Flow Area	0.2 ft ²
Wetted Perimeter	1.0 ft
Hydraulic Radius	2.0 in
Top Width	0.67 ft
Critical Depth	2.8 in
Percent Full	50.0 %
Critical Slope	0.0086 ft/ft
Velocity	1.47 ft/s
Velocity Head	0.03 ft
Specific Energy	0.37 ft
Froude Number	0.506
Maximum Discharge	247.70 gpm
Discharge Full	230.27 gpm
Slope Full	0.0006 ft/ft
Flow Type	Subcritical
GVF Input Data	
Downstream Depth	0.0 in
Length	0.0 ft
Number Of Steps	0
GVF Output Data	
Upstream Depth	0.0 in
Profile Description	N/A
Profile Headloss	0.00 ft
Average End Depth Over Rise	0.0 %
Normal Depth Over Rise	50.0 %
Downstream Velocity	Infinity ft/s
Upstream Velocity	Infinity ft/s
Normal Depth	4.0 in
Critical Depth	2.8 in
Channel Slope	0.0024 ft/ft
Critical Slope	0.0086 ft/ft

Offsite Harvard 10" Sewer Line Capacity

Project Description	
Friction Method	Manning Formula
Solve For	Discharge
Input Data	
Roughness Coefficient	0.015
Channel Slope	0.0020 ft/ft
Normal Depth	5.0 in
Diameter	10.0 in
Results	
Discharge	190.56 gpm
Flow Area	0.3 ft ²
Wetted Perimeter	1.3 ft
Hydraulic Radius	2.5 in
Top Width	0.83 ft
Critical Depth	3.4 in
Percent Full	50.0 %
Critical Slope	0.0080 ft/ft
Velocity	1.56 ft/s
Velocity Head	0.04 ft
Specific Energy	0.45 ft
Froude Number	0.480
Maximum Discharge	409.98 gpm
Discharge Full	381.13 gpm
Slope Full	0.0005 ft/ft
Flow Type	Subcritical
GVF Input Data	
Downstream Depth	0.0 in
Length	0.0 ft
Number Of Steps	0
GVF Output Data	
Upstream Depth	0.0 in
Profile Description	N/A
Profile Headloss	0.00 ft
Average End Depth Over Rise	0.0 %
Normal Depth Over Rise	50.0 %
Downstream Velocity	Infinity ft/s
Upstream Velocity	Infinity ft/s
Normal Depth	5.0 in
Critical Depth	3.4 in
Channel Slope	0.0020 ft/ft
Critical Slope	0.0080 ft/ft

City of Norwalk Adjusted Generation Rates	2015 Master plan	2009 Eval
	Flow (gpd/ac)	Flow (gpd/ac)
High Density Residential (23-30 DU/AC)	2461	3300
Commerical	1500	1050

Sewer Analysis Assumptions		
Manning N Used	0.015	
Peak Factor	3	
Peak flow from Commerical	8.41 GPM	
Peak flow from Resi	13.79 GPM	
Difference from Conversion	5.39 GPM	
Project Area (No Dedication)	8.07 AC	
Project Area with 10' Dedication	7.94 AC	

Street name	Start	End	GPM	Velocity	d/D	Flow Area from velocity	Theta (rad)	Calculated Pipe Diameter (inch)	Expected Diameter	Calculated Hydraulic radius	Flow Area from d/D	Calced Slope	Actual Slope	Additional flow changing from Commerical to	Total Pipe Flow	New d/D from flow master
Flallon Ave.	B5-NW9050	B5-NW6411	9.4713	0.5575	0.1486	0.037851	1.582940945	8.6	8	0.06138518	0.032389705	0.18%	0.24%	5.39	14.86	0.17
Flallon Ave.	B5-NW6411	B5-NW6410	11.2377	0.3326	0.1858	0.075278	1.782603347	10.4	8	0.075259846	0.044719484	0.10%	0.24%	5.39	16.62	0.18
Flallon Ave.	B5-NW6412	B5-NW6412	17.4795	0.6992	0.2166	0.055698	1.936359723	8.0	8	0.086281938	0.055690956	0.13%	0.24%	5.39	22.87	0.21
Flallon Ave.	B5-NW6412	B5-NW6435	27.4332	0.1751	0.2252	0.349065	1.977821922	19.5	8	0.089283361	0.058862196	0.27%	0.24%	5.39	32.82	0.26
Flallon Ave.	B5-NW6435	B5-NW6434	30.3215	0.1935	0.2402	0.349129	2.048827205	18.6	8	0.09443815	0.064495817	0.26%	0.24%	5.39	35.71	0.27
Flallon Ave.	B5-NW6434	B5-NW6433	34.1892	0.2182	0.2665	0.3491	2.169802556	17.3	8	0.103227996	0.074661457	0.22%	0.24%	5.39	39.57	0.28
Flallon Ave.	B5-NW6433	B5-NW6432	38.7021	1.059	0.2835	0.081424	2.245956603	8.0	8	0.108739803	0.081408273	0.22%	0.24%	5.39	44.09	0.30
Flallon Ave.	B5-NW6432	B5-NW6436	42.3365	0.7762	0.2865	0.121523	2.259247639	9.7	8	0.109698521	0.082612042	0.25%	0.24%	5.39	47.72	0.31
Flallon Ave and Harvard Dr Intersection	B5-NW6436	B5-NW6437	44.0757	1.1353	0.2961	0.086498	2.30150603	8.0	8	0.112738143	0.086489172	0.24%	0.24%	5.39	49.46	0.31
Harvard Dr.	B5-NW6437	B5-NW6438	45.6078	0.2911	0.3591	0.34907	2.570253407	14.1	8	0.131601442	0.112749685	0.12%	0.24%	5.39	50.99	0.32
Harvard Dr.	B5-NW6438	B5-NW6439	84.8785	1.0709	0.4326	0.176589	2.871169419	8.8	8	0.151159668	0.144668339	0.22%	0.24%	5.39	90.26	0.44
Harvard Dr. and Maidstone Ave.	B5-NW6439	B5-NW6452	91.5718	1.1343	0.44	0.179866	2.901012889	8.8	8	0.152978015	0.147930397	0.24%	0.24%	5.39	96.96	0.45
Harvard Dr.	B5-NW6452	B5-NW6451	120.7724	0.4934	0.371	0.545361	2.619689561	17.2	10	0.168687194	0.184128367	0.23%	0.20%	5.39	126.16	0.40
Harvard Dr.	B5-NW6451	B5-NW7307	126.6731	1.4545	0.3857	0.194038	2.680313934	10.0	10	0.173737452	0.194029548	0.22%	0.20%	5.39	132.06	0.41
Harvard Dr.	B5-NW7307	B5-9088b	166.4796	2.4353	0.2486	0.152309	2.087922722	12.0	10	0.121600055	0.105788133	2.07%	0.20%	5.39	171.87	0.47

Appendix 4

Record Drawings and Norwalk Sewer Master Plan References

Norwalk Sewer Master Plan: Manhole Stations Data Extract

Norwalk Wastewater Hydraulic Model

	ID	From ID	To ID	Maximum Flow (gpm)	Maximum Adjusted Velocity (ft/s)	Maximum Adjusted d/D
2969	B5-NW6332_B5-NW7306	B5-NW6332	B5-NW7306	6.1378	0.0392	0.1300
2970	B5-NW6333_B5-NW6332	B5-NW6333	B5-NW6332	1.9745	0.6884	0.0493
2971	B5-NW6334_B5-NW6333	B5-NW6334	B5-NW6333	0.7212	0.0045	0.0417
2972	B5-NW6335_B5-NW6332	B5-NW6335	B5-NW6332	3.6881	0.0235	0.1026
2973	B5-NW6336_B5-NW6335	B5-NW6336	B5-NW6335	2.7257	0.0174	0.0851
2974	B5-NW6337_B5-NW7306	B5-NW6337	B5-NW7306	3.5843	0.0229	0.1017
2975	B5-NW6338_B5-NW6329	B5-NW6338	B5-NW6329	6.3615	0.0406	0.1533
2976	B5-NW6339_B5-NW6336	B5-NW6339	B5-NW6336	1.2340	0.0078	0.0635
2977	B5-NW6340_B5-NW6337	B5-NW6340	B5-NW6337	1.9372	0.0122	0.0726
2978	B5-NW6341_B5-NW6338	B5-NW6341	B5-NW6338	4.1935	0.0265	0.0968
2979	B5-NW6342_B5-NW6343	B5-NW6342	B5-NW6343	0.9380	0.0059	0.0524
2980	B5-NW6343_B5-NW6344	B5-NW6343	B5-NW6344	2.0681	0.0132	0.0777
2981	B5-NW6344_B5-NW6345	B5-NW6344	B5-NW6345	3.6807	0.0235	0.0989
2982	B5-NW6345_B5-NW6346	B5-NW6345	B5-NW6346	5.4082	0.0345	0.1118
2983	B5-NW6346_B5-NW6347	B5-NW6346	B5-NW6347	6.7610	0.0432	0.3518
2984	B5-NW6347_B5-NW7319	B5-NW6347	B5-NW7319	267.3552	1.8163	0.3126
2985	B5-NW6349_B5-NW6347	B3-NW6349	B5-NW6347	260.5994	1.6810	0.3246
2986	B5-NW6356_B5-NW6358	B5-NW6356	B5-NW6358	2.5595	0.0163	0.0780
2987	B5-NW6357_B5-NW6356	B5-NW6357	B5-NW6356	1.6451	0.0102	0.0562
2988	B5-NW6358_B5-NW6360	B5-NW6358	B5-NW6360	5.0912	0.0325	0.1038
2989	B5-NW6359_B5-NW6358	B5-NW6359	B5-NW6358	1.5635	0.5031	0.0518
2990	B5-NW6360_B5-NW6362	B5-NW6360	B5-NW6362	7.6383	0.0488	0.1171
2991	B5-NW6361_B5-NW6360	B5-NW6361	B5-NW6360	1.8452	0.5694	0.0533
2992	B5-NW6362_B5-NW6363	B5-NW6362	B5-NW6363	8.0421	0.0513	0.1250
2993	B5-NW6363_B5-NW6364	B5-NW6363	B5-NW6364	9.8075	0.8152	0.1305
2994	B5-NW6364_B5-M02195	B5-NW6364	B5-NW7210	10.0536	1.3656	0.0933
2995	B5-NW6365_B5-NW7319	B5-NW6365	B5-NW7319	0.9480	0.3955	0.0435
2996	B5-NW6366_B5-NW6363	B5-NW6366	B5-NW6363	1.1650	0.4737	0.0442
2997	B5-NW6367_B5-NW6368	B5-NW6367	B5-NW6368	17.8657	0.8310	0.1949
2998	B5-NW6368_B5-NW9037	B5-NW6368	B5-NW9037	17.9503	0.9994	0.1720
2999	B5-NW6369_B5-NW6367	B5-NW6369	B5-NW6367	2.1466	0.0137	0.1310
3000	B5-NW6370_B5-NW6369	B5-NW6370	B5-NW6369	0.9050	0.0057	0.0566
3001	B5-NW6371_B5-NW6367	B5-NW6371	B5-NW6367	14.6137	0.0933	0.1732
3002	B5-NW6372_B5-NW6371	B5-NW6372	B5-NW6371	10.9232	0.0697	0.1398
3003	B5-NW6373_B5-NW6372	B5-NW6373	B5-NW6372	6.3566	0.0406	0.1136
3004	B5-NW6374_B5-NW6373	B5-NW6374	B5-NW6373	2.9485	0.0188	0.0832
3005	B5-NW6375_B5-NW6374	B5-NW6375	B5-NW6374	1.8689	0.0119	0.0613
3006	B5-NW6376_B5-NW6373	B5-NW6376	B5-NW6373	2.1481	0.5796	0.0586
3007	B5-NW6377_B5-NW6372	B5-NW6377	B5-NW6372	3.3167	0.6672	0.0714
3008	B5-NW6378_B5-NW6371	B5-NW6378	B5-NW6371	2.3772	0.0152	0.1062
3009	B5-NW6379_B5-NW6375	B5-NW6379	B5-NW6375	0.7845	0.0049	0.0464
3010	B5-NW6380_B5-NW6376	B5-NW6380	B5-NW6376	0.8646	0.0054	0.0490
3011	B5-NW6381_B5-NW6377	B5-NW6381	B5-NW6377	2.0420	0.0129	0.0655
3012	B5-NW6382_B5-NW6378	B5-NW6382	B5-NW6378	1.0924	0.0068	0.0527
3013	B5-NW6383_B5-NW6384	B5-NW6383	B5-NW6384	5.0707	0.0320	0.1017
3014	B5-NW6384_B5-NW6385	B5-NW6384	B5-NW6385	8.5593	0.0546	0.1353
3015	B5-NW6385_B5-NW6386	B5-NW6385	B5-NW6386	10.7960	0.0689	0.1591
3016	B5-NW6386_B5-NW6387	B5-NW6386	B5-NW6387	13.5456	0.8329	0.1606
3017	B5-NW6387_B5-NW6388	B5-NW6387	B5-NW6388	15.3207	0.4636	0.1776
3018	B5-NW6388_B5-NW6395	B5-NW6388	B5-NW6395	23.2989	0.1487	0.2726
3019	B5-NW6389_B5-NW6388	B5-NW6389	B5-NW6388	6.8164	0.6931	0.1136
3020	B5-NW6390_B5-NW6389	B5-NW6390	B5-NW6389	4.8258	0.0308	0.1094
3021	B5-NW6391_B5-NW6390	B5-NW6391	B5-NW6390	2.5767	0.0163	0.0881
3022	B5-NW6392_B5-NW6393	B5-NW6392	B5-NW6393	1.5696	0.0098	0.0665
3023	B5-NW6393_B5-NW6394	B5-NW6393	B5-NW6394	3.0779	0.0196	0.0837
3024	B5-NW6394_B5-NW6395	B5-NW6394	B5-NW6395	4.5861	0.6919	0.0869

Norwalk Sewer Master Plan: Manhole Stations Data Extract

Norwalk Wastewater Hydraulic Model

	ID	From ID	To ID	Maximum Flow (gpm)	Maximum Adjusted Velocity (ft/s)	Maximum Adjusted d/D
3025	B5-NW6395_B5-NW6396	B5-NW6395	B5-NW6396	28.5261	0.6245	0.3331
3026	B5-NW6396_B5-NW6397	B5-NW6396	B5-NW6397	14.4252	0.0921	0.1568
3027	B5-NW6396_B5-NW6419	B5-NW6396	B5-NW6419	15.2340	0.0972	0.1474
3028	B5-NW6397_B5-NW6398	B5-NW6397	B5-NW6398	15.7874	0.8402	0.1775
3029	B5-NW6398_B5-NW6399	B5-NW6398	B5-NW6399	17.3018	1.0164	0.1657
3030	B5-NW6399_B5-NW9091	B5-NW6399	B5-NW9091	17.9448	0.5823	0.1331
3031	B5-NW6400_B5-NW6403	B5-NW6400	B5-NW6403	0.6300	0.0040	0.0435
3032	B5-NW6401_B5-M02189	B5-NW6401	B5-M02189	976.6387	2.1668	0.5537
3033	B5-NW6402_B5-NW6401	B5-NW6402	B5-NW6401	1.9571	0.6649	0.0502
3034	B5-NW6403_B5-NW6402	B5-NW6403	B5-NW6402	1.5398	0.5149	0.0507
3035	B5-NW6404_B5-NW6405	B5-NW6404	B5-NW6405	19.1181	0.1220	0.1916
3036	B5-NW6405_B5-NW6446	B5-NW6405	B5-NW6446	23.6692	0.9206	0.2209
3037	B5-NW6406_B5-NW6405	B5-NW6406	B5-NW6405	2.2114	0.7543	0.0500
3038	B5-NW6407_B5-NW6406	B5-NW6407	B5-NW6406	1.4096	0.0087	0.0474
3039	B5-NW6408_B5-NW6409	B5-NW6408	B5-NW6409	1.4437	0.0091	0.0685
3040	B5-NW6409_B5-NW6410	B5-NW6409	B5-NW6410	3.2779	0.5246	0.0835
3041	B5-NW6410_B5-NW6412	B5-NW6410	B5-NW6412	17.4795	0.6992	0.2166
3042	B5-NW6411_B5-NW6410	B5-NW6411	B5-NW6410	11.2377	0.3326	0.1858
3043	B5-NW6412_B5-NW6435	B5-NW6412	B5-NW6435	27.4332	0.1751	0.2252
3044	B5-NW6413_B5-NW6412	B5-NW6413	B5-NW6412	8.5057	0.0536	0.1641
3045	B5-NW6414_B5-NW6415	B5-NW6414	B5-NW6415	1.1693	0.0074	0.0584
3046	B5-NW6415_B5-NW6416	B5-NW6415	B5-NW6416	2.4332	0.0155	0.0871
3047	B5-NW6416_B5-NW6417	B5-NW6416	B5-NW6417	5.2390	0.0334	0.1181
3048	B5-NW6417_B5-NW6418	B5-NW6417	B5-NW6418	8.8196	0.7301	0.1308
3049	B5-NW6418_B5-NW6422	B5-NW6418	B5-NW6422	27.1724	0.1734	0.2094
3050	B5-NW6419_B5-NW6418	B5-NW6419	B5-NW6418	16.5676	0.1057	0.1787
3051	B5-NW6420_B5-NW6421	B5-NW6420	B5-NW6421	0.9423	0.0059	0.0525
3052	B5-NW6421_B5-NW6417	B5-NW6421	B5-NW6417	2.0671	0.0132	0.0970
3053	B5-NW6422_B5-NW6426	B5-NW6422	B5-NW6426	32.4366	0.2070	0.2275
3054	B5-NW6423_B5-NW6422	B5-NW6423	B5-NW6422	4.0505	0.7023	0.0790
3055	B5-NW6424_B5-NW6423	B5-NW6424	B5-NW6423	2.5183	0.0161	0.0720
3056	B5-NW6425_B5-NW6424	B5-NW6425	B5-NW6424	1.0150	0.0063	0.0538
3057	B5-NW6426_B5-NW6438	B5-NW6426	B5-NW6438	38.1462	1.2059	0.2578
3058	B5-NW6427_B5-NW6426	B5-NW6427	B5-NW6426	4.3372	0.7420	0.0824
3059	B5-NW6428_B5-NW6427	B5-NW6428	B5-NW6427	2.9454	0.0188	0.0749
3060	B5-NW6429_B5-NW6428	B5-NW6429	B5-NW6428	1.4100	0.0088	0.0599
3061	B5-NW6430_B5-NW6416	B5-NW6430	B5-NW6416	1.5119	0.4433	0.0553
3062	B5-NW6431_B5-NW6432	B5-NW6431	B5-NW6432	1.1913	0.3133	0.1640
3063	B5-NW6432_B5-NW6436	B5-NW6432	B5-NW6436	42.3365	0.7662	0.2865
3064	B5-NW6433_B5-NW6432	B5-NW6433	B5-NW6432	38.7021	1.0590	0.2835
3065	B5-NW6434_B5-NW6433	B5-NW6434	B5-NW6433	34.1892	0.2182	0.2665
3066	B5-NW6435_B5-NW6434	B5-NW6435	B5-NW6434	30.3215	0.1935	0.2402
3067	B5-NW6436_B5-NW6437	B5-NW6436	B5-NW6437	44.0757	1.1353	0.2961
3068	B5-NW6437_B5-NW6438	B5-NW6437	B5-NW6438	45.6078	0.2911	0.3591
3069	B5-NW6438_B5-NW6439	B5-NW6438	B5-NW6439	84.8785	1.0709	0.4326
3070	B5-NW6439_B5-NW6452	B5-NW6439	B5-NW6452	91.5718	1.1343	0.4400
3071	B5-NW6440_B5-NW6444	B5-NW6440	B5-NW6444	1.5933	0.0099	0.0608
3072	B5-NW6441_B5-M10042	B5-NW6441	B5-M10042	78.6583	0.5760	0.0548
3073	B5-NW6442_B5-NW6441	B5-NW6442	B5-NW6441	64.3963	3.6139	0.1711
3074	B5-NW6443_B5-NW6442	B5-NW6443	B5-NW6442	0.8947	0.4354	0.0392
3075	B5-NW6444_B5-NW6445	B5-NW6444	B5-NW6445	3.2649	0.0208	0.0765
3076	B5-NW6445_B5-NW6439	B5-NW6445	B5-NW6439	5.0166	0.6159	0.1852
3077	B5-NW6446_B5-NW6447	B5-NW6446	B5-NW6447	25.6450	0.1637	0.2261
3078	B5-NW6447_B5-NW6452	B5-NW6447	B5-NW6452	27.5255	0.7567	0.2750
3079	B5-NW6448_B5-NW6449	B5-NW6448	B5-NW6449	1.1295	0.0070	0.0559
3080	B5-NW6449_B5-NW6450	B5-NW6449	B5-NW6450	2.8579	0.0182	0.0678

Norwalk Sewer Master Plan: Manhole Stations Data Extract

Norwalk Wastewater Hydraulic Model

	ID	From ID	To ID	Maximum Flow (gpm)	Maximum Adjusted Velocity (ft/s)	Maximum Adjusted d/D
3081	B5-NW6450_B5-NW6451	B5-NW6450	B5-NW6451	4.7232	0.9530	0.0878
3082	B5-NW6451_B5-NW7307	B5-NW6451	B5-NW7307	126.6731	1.4545	0.3857
3083	B5-NW6452_B5-NW6451	B5-NW6452	B5-NW6451	120.7724	0.4934	0.3710
3084	B5-NW6453_B5-NW7307	B5-NW6453	B5-NW7307	39.6575	0.2531	0.3229
3085	B5-NW6454_B5-M02185	B5-NW6454	B5-M02185	381.4435	4.6168	0.3707
3086	B5-NW6455_B5-NW6453	B5-NW6455	B5-NW6453	39.0078	0.2490	0.2493
3087	B5-NW6456_B5-NW6455	B5-NW6456	B5-NW6455	4.6842	1.0328	0.0702
3088	B5-NW6457_B5-NW6456	B5-NW6457	B5-NW6456	2.9473	0.6545	0.0668
3089	B5-NW6458_B5-NW6457	B5-NW6458	B5-NW6457	1.1804	0.0073	0.0556
3090	B5-NW6459_B5-NW6462	B5-NW6459	B5-NW6462	0.5935	0.0037	0.0408
3091	B5-NW6460_B5-NW6461	B5-NW6460	B5-NW6461	0.6809	0.0042	0.0345
3092	B5-NW6461_B5-NW6405	B5-NW6461	B5-NW6405	1.5654	0.7398	0.0402
3093	B5-NW6462_B5-NW6463	B5-NW6462	B5-NW6463	2.0704	0.0132	0.0887
3094	B5-NW6463_B5-NW6467	B5-NW6463	B5-NW6467	10.9055	0.0696	0.1316
3095	B5-NW6464_B5-NW6463	B5-NW6464	B5-NW6463	6.0493	0.0386	0.1136
3096	B5-NW6465_B5-NW6464	B5-NW6465	B5-NW6464	2.8475	0.0180	0.0842
3097	B5-NW6465_B5-NW6473	B5-NW6465	B5-NW6473	2.8478	0.0180	0.0816
3098	B5-NW6466_B5-NW6472	B5-NW6466	B5-NW6472	1.6020	0.0100	0.0627
3099	B5-NW6467_B5-NW6468	B5-NW6467	B5-NW6468	12.8231	0.0818	0.1427
3100	B5-NW6468_B5-NW6469	B5-NW6468	B5-NW6469	14.7093	0.9980	0.1500
3101	B5-NW6469_B5-NW9052	B5-NW6469	B5-NW9052	32.5718	1.0514	0.2157
3102	B5-NW6470_B5-NW6469	B5-NW6470	B5-NW6469	16.9646	0.1083	0.1848
3103	B5-NW6471_B5-NW6470	B5-NW6471	B5-NW6470	5.2005	0.8694	0.0810
3104	B5-NW6472_B5-NW6471	B5-NW6472	B5-NW6471	3.3548	0.0214	0.0765
3105	B5-NW6473_B5-NW6474	B5-NW6473	B5-NW6474	5.7894	0.0370	0.1036
3106	B5-NW6474_B5-NW6475	B5-NW6474	B5-NW6475	8.6232	0.0550	0.1180
3107	B5-NW6475_B5-NW6470	B5-NW6475	B5-NW6470	10.3273	0.0659	0.1405
3108	B5-NW6478_B5-NW6477	B5-NW6478	B5-NW6477	28.1753	0.9756	0.2398
3109	B5-NW6479_B5-NW6478	B5-NW6479	B5-NW6478	21.5011	0.1372	0.2254
3110	B5-NW6480_B5-NW6481	B5-NW6480	B5-NW6481	0.2977	0.0019	0.0495
3111	B5-NW6481_B5-NW6482	B5-NW6481	B5-NW6482	2.8668	0.0183	0.1048
3112	B5-NW6482_B5-NW6483	B5-NW6482	B5-NW6483	8.6728	0.0554	0.1483
3113	B5-NW6483_B5-NW6484	B5-NW6483	B5-NW6484	12.3128	0.0786	0.1655
3114	B5-NW6484_B5-NW6485	B5-NW6484	B5-NW6485	14.6007	0.0932	0.1753
3115	B5-NW6485_B5-NW6479	B5-NW6485	B5-NW6479	17.7710	0.1134	0.1959
3116	B5-NW6487_B5-NW6488	B5-NW6487	B5-NW6488	0.7102	0.3273	0.0690
3117	B5-NW6488_B5-NW6495	B5-NW6488	B5-NW6495	6.8819	0.0439	0.1358
3118	B5-NW6489_B5-NW6488	B5-NW6489	B5-NW6488	3.5464	0.6537	0.0758
3119	B5-NW6490_B5-NW6489	B5-NW6490	B5-NW6489	2.1861	0.0138	0.0695
3120	B5-NW6491_B5-NW6488	B5-NW6491	B5-NW6488	2.1838	0.5662	0.0602
3121	B5-NW6492_B5-NW6491	B5-NW6492	B5-NW6491	1.1334	0.0071	0.0514
3122	B5-NW6493_B5-NW6494	B5-NW6493	B5-NW6494	1.9671	0.0124	0.0738
3123	B5-NW6494_B5-NW6495	B5-NW6494	B5-NW6495	3.6173	0.5318	0.0884
3124	B5-NW6495_B5-NW6500	B5-NW6495	B5-NW6500	17.6638	0.1127	0.1815
3125	B5-NW6496_B5-NW6495	B5-NW6496	B5-NW6495	5.9830	0.7955	0.0947
3126	B5-NW6497_B5-NW6496	B5-NW6497	B5-NW6496	4.9241	0.6432	0.0958
3127	B5-NW6498_B5-NW6499	B5-NW6498	B5-NW6499	1.7980	0.0113	0.0729
3128	B5-NW6499_B5-NW6500	B5-NW6499	B5-NW6500	3.5715	0.5277	0.0881
3129	B5-NW6500_B5-NW6584	B5-NW6500	B5-NW6584	24.7279	0.1578	0.2073
3130	B5-NW6501_B5-NW6500	B5-NW6501	B5-NW6500	2.3211	0.6651	0.0563
3131	B5-NW6502_B5-NW6501	B5-NW6502	B5-NW6501	1.2815	0.0080	0.0521
3132	B5-NW6503_B5-NW6497	B5-NW6503	B5-NW6497	3.7959	0.0242	0.0954
3133	B5-NW6504_B5-NW6503	B5-NW6504	B5-NW6503	0.9671	0.3851	0.0450
3134	B5-NW6505_B5-NW6503	B5-NW6505	B5-NW6503	2.1229	0.0135	0.0797
3135	B5-NW6506_B5-NW9066	B5-NW6506	B5-NW9066	0.2651	0.2174	0.0321
3136	B5-NW6507_B5-NW6509	B5-NW6507	B5-NW6509	1.1690	0.0075	0.0655

Norwalk Sewer Master Plan: Manhole Stations Data Extract

Norwalk Wastewater Hydraulic Model

	ID	From ID	To ID	Maximum Flow (gpm)	Maximum Adjusted Velocity (ft/s)	Maximum Adjusted d/D
3753	B5-NW7144_B5-NW9238	B5-NW7144	B5-NW9238	141.8614	1.3698	0.3350
3754	B5-NW7145_B5-NW7144	B5-NW7145	B5-NW7144	8.0045	1.8160	0.0659
3755	B5-NW7146_B5-NW7145	B5-NW7146	B5-NW7145	6.3398	0.7380	0.1036
3756	B5-NW7147_B5-NW7146	B5-NW7147	B5-NW7146	4.8800	0.0311	0.0976
3757	B5-NW7148_B5-NW7147	B5-NW7148	B5-NW7147	4.4560	0.2580	0.0893
3758	B5-NW7149_B5-NW7148	B5-NW7149	B5-NW7148	4.0464	0.0258	0.0862
3759	B5-NW7150_B5-NW7149	B5-NW7150	B5-NW7149	3.2292	0.0206	0.0790
3760	B5-NW7151_B5-NW7150	B5-NW7151	B5-NW7150	2.2499	0.0143	0.0636
3761	B5-NW7152_B5-NW7151	B5-NW7152	B5-NW7151	0.9658	0.0061	0.0490
3762	B5-NW7153_B5-NW7154	B5-NW7153	B5-NW7154	0.8586	0.0053	0.0495
3763	B5-NW7154_B5-NW7155	B5-NW7154	B5-NW7155	2.4620	0.0157	0.0728
3764	B5-NW7155_B5-NW7156	B5-NW7155	B5-NW7156	4.4597	0.7293	0.0822
3765	B5-NW7156_B5-NW7157	B5-NW7156	B5-NW7157	6.2124	0.0397	0.0773
3766	B5-NW7157_B5-NW7168	B5-NW7157	B5-NW7168	7.3713	0.9825	0.0945
3767	B5-NW7168_B5-M15159	B5-NW7168	B5-M15159	340.7258	0.9403	0.1062
3768	B5-NW7174_B5-NW6731	B5-NW7174	B5-NW6731	2.2255	0.0142	0.0826
3769	B5-NW7175_B5-M10059	B5-NW7175	B5-M10059	2,563.9462	1.6474	0.3200
3770	B5-NW7178_B5-NW6706	B5-NW7178	B5-NW6706	1.0991	0.0070	0.0596
3771	B5-NW7179_B5-M10056	B5-NW7179	B5-M10056	2,562.7493	1.0354	0.3149
3772	B5-NW7196_B5-NW6748	B5-NW7196	B5-NW6748	42.0769	0.2686	0.2882
3773	B5-NW7197_B5-NW6634	B5-NW7197	B5-M02210	799.1649	1.0070	0.5603
3774	B5-NW7198_B5-NW6634	B5-NW6632	B5-M02210	138.1044	1.0481	0.5004
3775	B5-NW7210_B5-HF1015	B5-NW7210	B5-M10037	2,563.1306	2.4474	0.2403
3776	B5-NW7215_B5-NW7216	B5-NW7215	B5-NW7216	1.4728	0.0094	0.0798
3777	B5-NW7216_B5-NW6176	B5-NW7216	B5-NW6176	18.6877	1.8253	0.1168
3778	B5-NW7218_B5-NW6243	B5-NW7218	B5-NW6243	0.1878	0.0012	0.0227
3779	B5-NW7219_B5-NW6245	B5-NW7219	B5-NW6245	28.0011	0.1787	0.2881
3780	B5-NW7220_B5-NW6244	B5-NW7220	B5-NW6244	3.6043	0.6477	0.0771
3781	B5-NW7222_B5-M10139	B5-NW7222	B5-M10139	123.9112	0.8353	0.1047
3782	B5-NW7249_B5-NW6789	B5-NW7249	B5-NW6789	7.0755	0.0452	0.1997
3783	B5-NW7252_B5-M02219	B5-NW7252	B5-NW6783	550.2088	2.0466	0.3720
3784	B5-NW7253_B5-M02220	B5-NW7253	B5-NW7252	541.1271	1.7623	0.4108
3785	B5-NW7257_B5-NW7222	B5-NW7257	B5-NW7222	116.7781	1.1800	0.3241
3786	B5-NW7259_B5-NW6829	B5-NW7259	B5-NW6829	28.4180	1.0996	0.2217
3787	B5-NW7263_B5-NW5083	B5-NW7263	B5-NW5083	82.9726	1.5847	0.3682
3788	B5-NW7264_B5-NW7263	B5-NW7264	B5-NW7263	1.5628	0.6651	0.0811
3789	B5-NW7265_B5-NW5025	B5-NW7265	B5-NW5025	2.7479	0.5349	0.0729
3790	B5-NW7269_B5-M10176	B5-NW7269	B5-M10176	646.6326	1.9902	0.3409
3791	B5-NW7280_B5-NW6978	B5-NW7280	B5-NW6978	31.6696	0.3210	0.3341
3792	B5-NW7283_B5-NW7284	B5-NW7283	B5-NW7284	51.7976	0.3306	0.3699
3793	B5-NW7284_B5-NW7285	B5-NW7284	B5-NW7285	52.0548	0.7397	0.4600
3794	B5-NW7285_B5-NW6569	B5-NW7285	B5-NW6569	52.2678	0.3336	0.3129
3795	B5-NW7287_B5-NW7072	B5-NW7287	B5-NW7072	0.9487	0.0061	0.1509
3796	B5-NW7288_B5-NW7289	B5-NW7288	B5-NW7289	0.5716	0.0036	0.0454
3797	B5-NW7289_B5-NW7290	B5-NW7289	B5-NW7290	1.3518	0.3681	0.0648
3798	B5-NW7290_B5-NW7122	B5-NW7290	B5-NW7122	34.5878	1.2920	0.2250
3799	B5-NW7298_B5-NW6801	B5-NW7298	B5-NW6801	0.4782	0.3738	0.0663
3800	B5-NW7302_B5-NW7303	B5-NW7302	B5-NW7303	97.2116	1.5463	0.2343
3801	B5-NW7303_B5-NW6783	B5-NW7303	B5-NW6783	98.5391	1.5978	0.2311
3802	B5-NW7304_B5-NW7302	B5-NW7304	B5-NW7302	96.3083	0.8362	0.2229
3803	B5-NW7305_B5-NW7304	B5-NW7305	B5-NW7304	95.1701	1.3862	0.2493
3804	B5-NW7306_B5-NW6330	B5-NW7306	B5-NW6330	10.6614	0.0681	0.1723
3805	B5-NW7307_B5-9088b	B5-NW7307	B5-9088b	166.4796	2.4353	0.2486
3806	B5-NW7308_B5-NW6507	B5-NW7308	B5-NW6507	0.3202	0.4192	0.0351
3807	B5-NW7308_B5-NW7309	B5-NW7308	B5-NW7309	0.0878	0.0006	0.0290
3808	B5-NW7309_B5-NW6505	B5-NW7309	B5-NW6505	0.7443	0.3434	0.0408

Norwalk Sewer Master Plan: Manhole Stations Data Extract

Norwalk Wastewater Hydraulic Model

	ID	From ID	To ID	Maximum Flow (gpm)	Maximum Adjusted Velocity (ft/s)	Maximum Adjusted d/D
3809	B5-NW7310_B5-NW5074	B5-NW7310	B5-NW5074	1.4144	0.0088	0.0575
3810	B5-NW7312_B5-M10008	B5-NW7312	B5-M10008	715.6443	1.2051	0.5670
3811	B5-NW7314_B5-M02225	B5-NW7314	B5-M02225	403.3962	1.7959	0.3261
3812	B5-NW7318_B5-NW6319	B5-NW7318	B5-NW6319	1.9056	0.0122	0.0879
3813	B5-NW7319_B5-HF1015	B5-NW7319	B5-M10038	268.6924	2.0365	0.2889
3814	B5-NW7320_B5-NW6367	B5-NW7320	B5-NW6367	0.5805	0.0037	0.1168
3815	B5-NW7324_B5-NW7325	B5-NW7324	B5-NW7325	2.1292	0.0136	0.0617
3816	B5-NW7325_B5-NW5086	B5-NW7325	B5-NW5086	3.7445	0.0239	0.0754
3817	B5-NW7327_B5-M09989	B5-NW7327	B5-M09989	521.0744	1.0240	0.3895
3818	B5-NW7328_B5-NW7329	B5-NW7328	B5-NW7329	530.4317	1.2135	0.5402
3819	B5-NW7329_B5-NW7330	B5-NW7329	B5-NW7330	542.7001	1.0913	0.4766
3820	B5-NW7330_B5-NW7331	B5-NW7330	B5-NW7331	552.9065	1.4751	0.4785
3821	B5-NW7331_B5-M09984	B5-NW7331	B5-M09984	562.4246	1.2544	0.4683
3822	B5-NW7332_B5-NW7333	B5-NW7332	B5-NW7333	585.6301	1.4901	0.4963
3823	B5-NW7333_B5-NW7334	B5-NW7333	B5-NW7334	588.9051	1.5035	0.4951
3824	B5-NW7334_B5-M09981	B5-NW7334	B5-M09981	597.3054	2.2804	0.3650
3825	B5-NW7335_B5-NW5472	B5-NW7335	B5-NW5472	15.3605	0.2964	0.2703
3826	B5-NW7336_B5-NW5431	B5-NW7336	B5-NW5431	0.5824	0.0037	0.0868
3827	B5-NW7347_B5-NW5423	B2-NW7347	B5-NW5423	3.2375	0.5557	0.0796
3828	B5-NW7351_B5-NW5290	B5-NW7351	B5-NW5290	14.6227	0.8816	0.1628
3829	B5-NW7351_B5-NW9090	B5-NW7351	B5-NW9090	29.1377	1.7567	0.1628
3830	B5-NW7352_B5-NW5600	B5-NW7352	B5-NW5600	36.4129	1.0659	0.2426
3831	B5-NW7354_B5-NW5546	B5-NW7354	B5-NW5546	837.1621	0.3796	0.2516
3832	B5-NW7358_B5-NW7351	B5-NW7358	B5-NW7351	43.4844	1.2467	0.2742
3833	B5-NW9010_B5-NW5609	B5-NW9010	B5-NW5609	1.3122	0.0083	0.0564
3834	B5-NW9011_B5-NW5294	B5-NW9011	B5-NW5294	6.4672	0.0413	0.1257
3835	B5-NW9012_B5-NW7354	B5-NW9012	B5-NW7354	39.4825	0.8194	0.3464
3836	B5-NW9017_B5-NW5199	B5-NW9017	B5-NW5199	4.8313	0.0308	0.0992
3837	B5-NW9018_B5-NW5202	B5-NW9018	B5-NW5202	2.3404	0.0149	0.1002
3838	B5-NW9019_B5-NW5172	B5-NW9019	B5-NW5172	3.0536	0.4492	0.0995
3839	B5-NW9025_B5-NW5000	B5-NW9025	B5-NW5000	688.8938	0.8676	0.4447
3840	B5-NW9034_B5-NW6180	B5-NW9034	B5-NW6180	0.7557	0.3545	0.0403
3841	B5-NW9037_B5-M02196	B5-NW9037	B5-M02196	963.8485	1.2150	0.6219
3842	B5-NW9039_B5-NW6115	B5-NW9039	B5-NW6115	22.2275	0.8024	0.2328
3843	B5-NW9050_B5-NW6411	B5-NW9050	B5-NW6411	9.4713	0.5575	0.1486
3844	B5-NW9052_B5-NW6455	B5-NW9052	B5-NW6455	33.5204	1.0000	0.2228
3845	B5-NW9061_B5-NW6677	B5-NW9061	B5-NW6677	4.0034	0.0256	0.1057
3846	B5-NW9065_B5-NW6847	B5-NW9065	B5-NW6847	0.6045	0.0017	0.1076
3847	B5-NW9066_B5-NW6505	B5-NW9066	B5-NW6505	0.7443	0.0047	0.0524
3848	B5-NW9067_B5-NW6523	B5-NW9067	B5-NW6523	2.5418	0.1630	0.1001
3849	B5-NW9068_B5-NW5387	B5-NW9068	B5-NW5387	2.1360	0.0136	0.0825
3850	B5-NW9069_B5-NW5390	B5-NW9069	B5-NW5390	0.6486	0.2404	0.0445
3851	B5-NW9089_B5-M14998	B5-NW9089	B5-M14998	272.0747	0.6583	0.1237
3852	B5-NW9090_B5-NW5254	B5-NW9090	B5-NW5254	945.5661	2.0684	0.2608
3853	B5-NW9091_B5-NW6404	B5-NW9091	B5-NW6404	18.2293	0.7377	0.1611
3854	B5-NW9092_B5-NW7220	B5-NW9092	B5-NW7220	3.4586	0.5471	0.0841
3855	B5-NW9094_B5-NW1895	B5-NW9094	B5-HF1008	5.9532	0.6402	0.1094
3856	B5-NW9095_B5-NW1396	B5-NW9095	B5-NW1396	1.7356	0.4652	0.0587
3857	B5-NW9096_B5-NW7269	B5-NW9096	B5-NW7269	0.8344	1.1354	0.0197
3858	B5-NW9099_B5-NW5645	B5-NW9099	B5-NW5645	13.9694	0.3119	0.2089
3859	B5-NW9100_B5-NW9099	B5-NW9100	B5-NW9099	12.7681	0.0813	0.1330
3860	B5-NW9101_B5-NW9100	B5-NW9101	B5-NW9100	10.1016	0.7140	0.1458
3861	B5-NW9102_B5-NW1894	B5-NW9102	B5-NW1894	8.0840	0.0516	0.1192
3862	B5-NW9108_B5-NW5371	B5-NW9108	B5-NW5371	9.1732	0.0585	0.1390
3863	B5-NW9109_B5-NW9110	B5-NW9109	B5-NW9110	75.6703	0.2147	0.2601
3864	B5-NW9110_B5-NW1466	B5-NW9110	B5-NW1466	76.0133	0.8044	0.3134

NORWALK BLDG. DIST. NO. 4.06

PROFILE ALIGNMENT AND GRADE OF P.C. 4993

SANITARY SEWERS PAGE 1

TO BE CONSTRUCTED IN

TRACT NO. 24702
PRIVATE CONTRACT NO. 4993

W.S. 33

4 SHEETS; 7 PAGES

SCALE: VERT. 1" = 4'
 HORIZ. 1" = 40'


PREPARED IN THE OFFICES OF

KEMMERER ENGINEERING CO., INC.

By: Hans C. Thomsen
 REG. C. E. NO. 3228

FOR LEGEND SEE PLAN NO. S-A-64

27,777

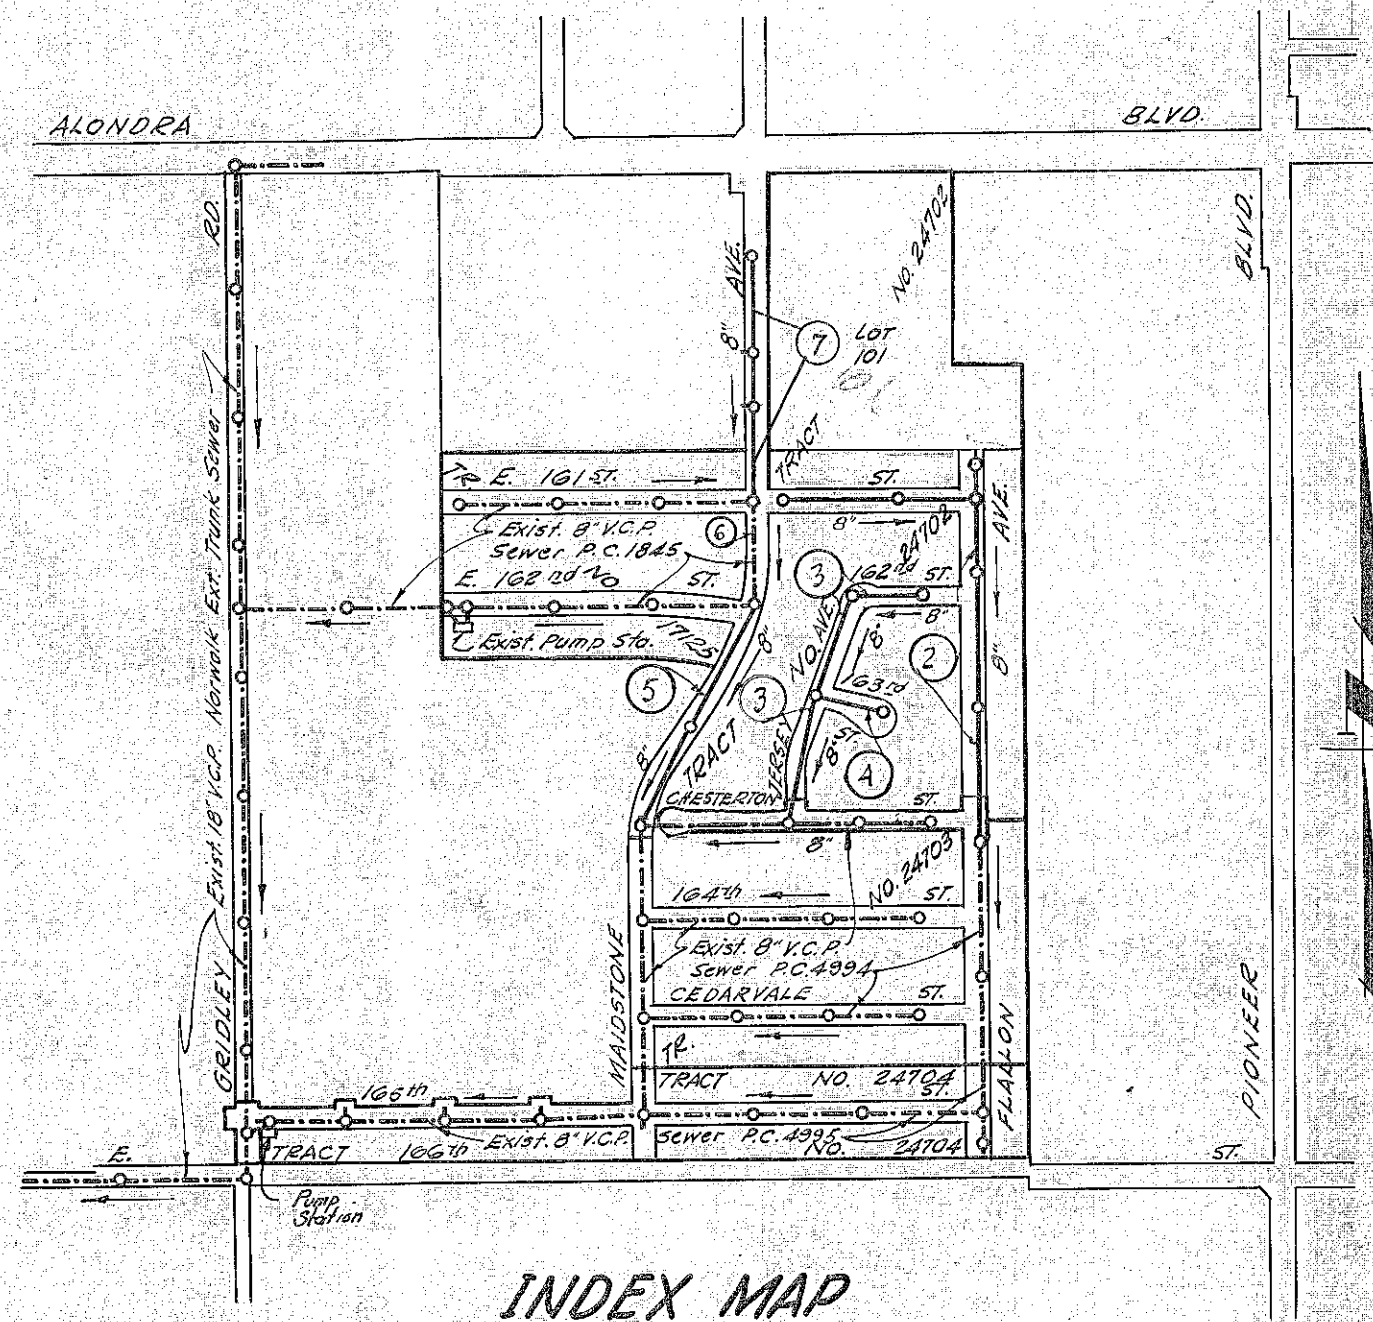

INDEX MAP
 TRACT NO. 24702
 P.C. 4993 SCALE: 1" = 500'

Revision: Page 2, Extend sewer from M.H. of Sta. 16+81.00 to Sta. 17+22.68. Add Page 7 showing sewer extension of 4.644 and 3 M.H.s.
 Approved by: E. Navro 3-18-59
 Office of the City Engineer, P.E. #10015

B.M. 5+X.2188 Spike & Lead 1.45' East of curb return at N.E. Cor. Alondra Blvd & Moidstone Ave. ELEV. 71.679
 ARTESIA QUAD., 1955 ADJ.

Revision: Delete sewer in Chesterton St. Page 4 B. Delete 12 feet of sewer on Fallon Ave. Page 5 between station 7+02 & station 7+12

Approved By: St. Guide 1-20-59
 Office of the City Engineer, P.E. No. 9486
 Note: Revision made before prints received.

- NOTES:
- PROVIDE STAKES ON THE PROPERTY LINE OR PROPERTY LINES PRODUCED AT RIGHT ANGLES TO THE SEWER LINE AT THE CENTER LINE OF EACH MANHOLE.
 - NO REPRESENTATIVE OF THE CITY ENGINEER WILL SURVEY OR LAYOUT ANY PORTION OF THE WORK.
 - THE OWNER OR HIS AUTHORIZED REPRESENTATIVE SHALL FURNISH THE CITY ENGINEER WITH GRADE SHEETS AND STATION FOR ALL HOUSE LATERALS AND Y BRANCHES AND SHALL PROVIDE STAKES FOR THEM AT THEIR PROPER LOCATIONS WITH STATIONING PLAINLY MARKED. ANY CHANGE IN LOCATION SHALL BE REQUESTED IN WRITING BY THE OWNER OR HIS REPRESENTATIVE.
 - NO REVISIONS SHALL BE MADE IN THESE PLANS WITHOUT THE APPROVAL OF THE CITY ENGINEER.
 - USE STANDARD MANHOLE FRAMES AND COVERS, S-A-117.
 - USE STANDARD STRENGTH PIPE.
 - USE CEMENT-MORTAR, 1:3:6 OR 1:4:8 FOR ALL VITRIFIED CLAY PIPE JOINTS PER SPEC. SEC. 30-9-40.
 - RESURFACE ALL TRENCH WITHIN PAVED AREA TO MEET L.A. COUNTY ROAD DEPT. OR CALIF. STATE HIGHWAY DEPT. REQUIREMENTS IN ACCORDANCE WITH PERMITS.
 - ENCASE FOUR FEET OF SEWER AT POINTS OF INTERFERENCE WITH POLES, S-A-110, CASE II.
 - HOUSE LATERALS TO BE CONSTRUCTED WITH INVERTS AT PROPERTY LINE 6 FEET BELOW CURB GRADE EXCEPT AS NOTED.
 - ALL STRUCTURES SHALL BE BRICK SEWER STRUCTURES, S-A-104, EXCEPT AS NOTED.
 - FOR ALLOWABLE LEAKAGE TEST USE FORMULA NO. 2, SPECS., SEC. 4.
 - MANHOLE TOPS IN UNIMPROVED RIGHTS-OF-WAY TO BE 6" ABOVE FINISHED GRADE.
 - THE PRIVATE ENGINEER IS TO FURNISH THE HOUSE LATERAL DEPTH AT THE PROPERTY LINE BELOW THE TOP OF CURB ELEVATION FOR EACH HOUSE LATERAL ON THE GRADE STREET.
 - USE JOINT COMPOUND FOR ALL VITRIFIED CLAY PIPE JOINTS PER SPEC. 33 UNLESS GROUND WATER IS ENCOUNTERED AND TRENCH CHAMBERS BE DONE TO THE SATISFACTION OF THE CITY ENGINEER IN WHICH CASE "WEDGE-LOCK" OR "SPEED-SEAL" SHALL BE USED PER SPEC. SEC. 34, 36 & 48.
 - USE JOINT COMPOUND "WEDGE-LOCK" OR "SPEED-SEAL" FOR ALL VITRIFIED CLAY PIPE JOINTS, PER SPEC. SEC. 34 & 48. IF GROUND WATER IS ENCOUNTERED, METAL FORMS & GASKETS OR "WEDGE-LOCK" OR "SPEED-SEAL" SHALL BE USED PER SPEC. SEC. 34, 35, 36 & 48.

NOTE:
 THE CONTRACTOR SHALL NOTIFY THE CONSTRUCTION AND STORM DRAIN DIVISION BY TELEPHONE, MADISON 9-4747, EXT. 362, AT LEAST 24 HOURS BEFORE STARTING ANY WORK UNDER THIS CONTRACT.


NO CHARGE FOR CONNECTIONS
E. Navro 1-9-59

NOTE:
 GRADES TO WHICH THIS IMPROVEMENT IS TO BE CONSTRUCTED ARE SHOWN ON PLANS AND PROFILES. GRADE POINTS FOR TOP OF CURB, CENTER LINE OF STREETS, OR CENTER LINE OF ALLEYS ARE SHOWN BY CIRCLES ON PROFILES. AT ALL POINTS BETWEEN DESIGNATED POINTS THE GRADE SHALL BE ESTABLISHED SO AS TO CONFORM TO A STRAIGHT LINE DRAWN BETWEEN SAID DESIGNATED POINTS.
 ELEVATIONS ARE IN FEET ABOVE U.S.C. & G.S. SEA LEVEL DATUM OF 1929.
 THIS DRAWING AND THE DATA HEREON ARE HEREBY MADE A PART OF THE SPECIFICATIONS.
 WORK SHALL BE CONSTRUCTED ACCORDING TO SPECIFICATIONS ON FILE IN THE OFFICE OF THE CITY ENGINEER AND SHALL BE PROSECUTED ONLY IN THE PRESENCE OF THE CITY ENGINEER.
 BEFORE WORK CAN BE STARTED, THE CONTRACTOR MUST OBTAIN A PERMIT TO EXCAVATE IN CITY STREETS FROM THE L.A. COUNTY ROAD DEPT., DIST. NO. 4, AND MAKE A DEPOSIT WITH THE CITY OF NORWALK, 7004048.
 THE COST OF CONSTRUCTION INSPECTION AND RECORD PLANS.
 APPROVAL OF THIS PLAN BY THE CITY OF NORWALK DOES NOT CONSTITUTE A REPRESENTATION AS TO THE ACCURACY OF THE LOCATION OF OR THE EXISTENCE OR NON-EXISTENCE OF ANY UNDERGROUND UTILITY PIPE, OR STRUCTURE WITHIN THE LIMITS OF THIS PROJECT. THIS NOTE APPLIES TO ALL PAGES.
 IF WORK IS TO BE DONE IN A STATE HIGHWAY, A PERMIT MUST BE OBTAINED FROM THE STATE OF CALIFORNIA, DIVISION OF HIGHWAYS, 120 SOUTH SPRING STREET.

CITY OF NORWALK, CALIFORNIA

APPROVED, JOHN A. LAMBIE, CITY ENGINEER
 APPROVED, C.R. DUNTON, CHIEF ENGINEER
 CO. SAN. DIST. NO. 2
 BY: Carl Hughes SANITATION ENGINEER
 BY: E.P. Brown OFFICE ENGINEER
 CHECKED BY: St. Guide 1-12-59
 OFFICE OF CITY ENGINEER, REG. C. E. NO. 3406

SUBMITTED BY: John L. Epton 1-7-59
 LOS CERRITOS REGIONAL ENGINEER REG. C.E. NO. 3871

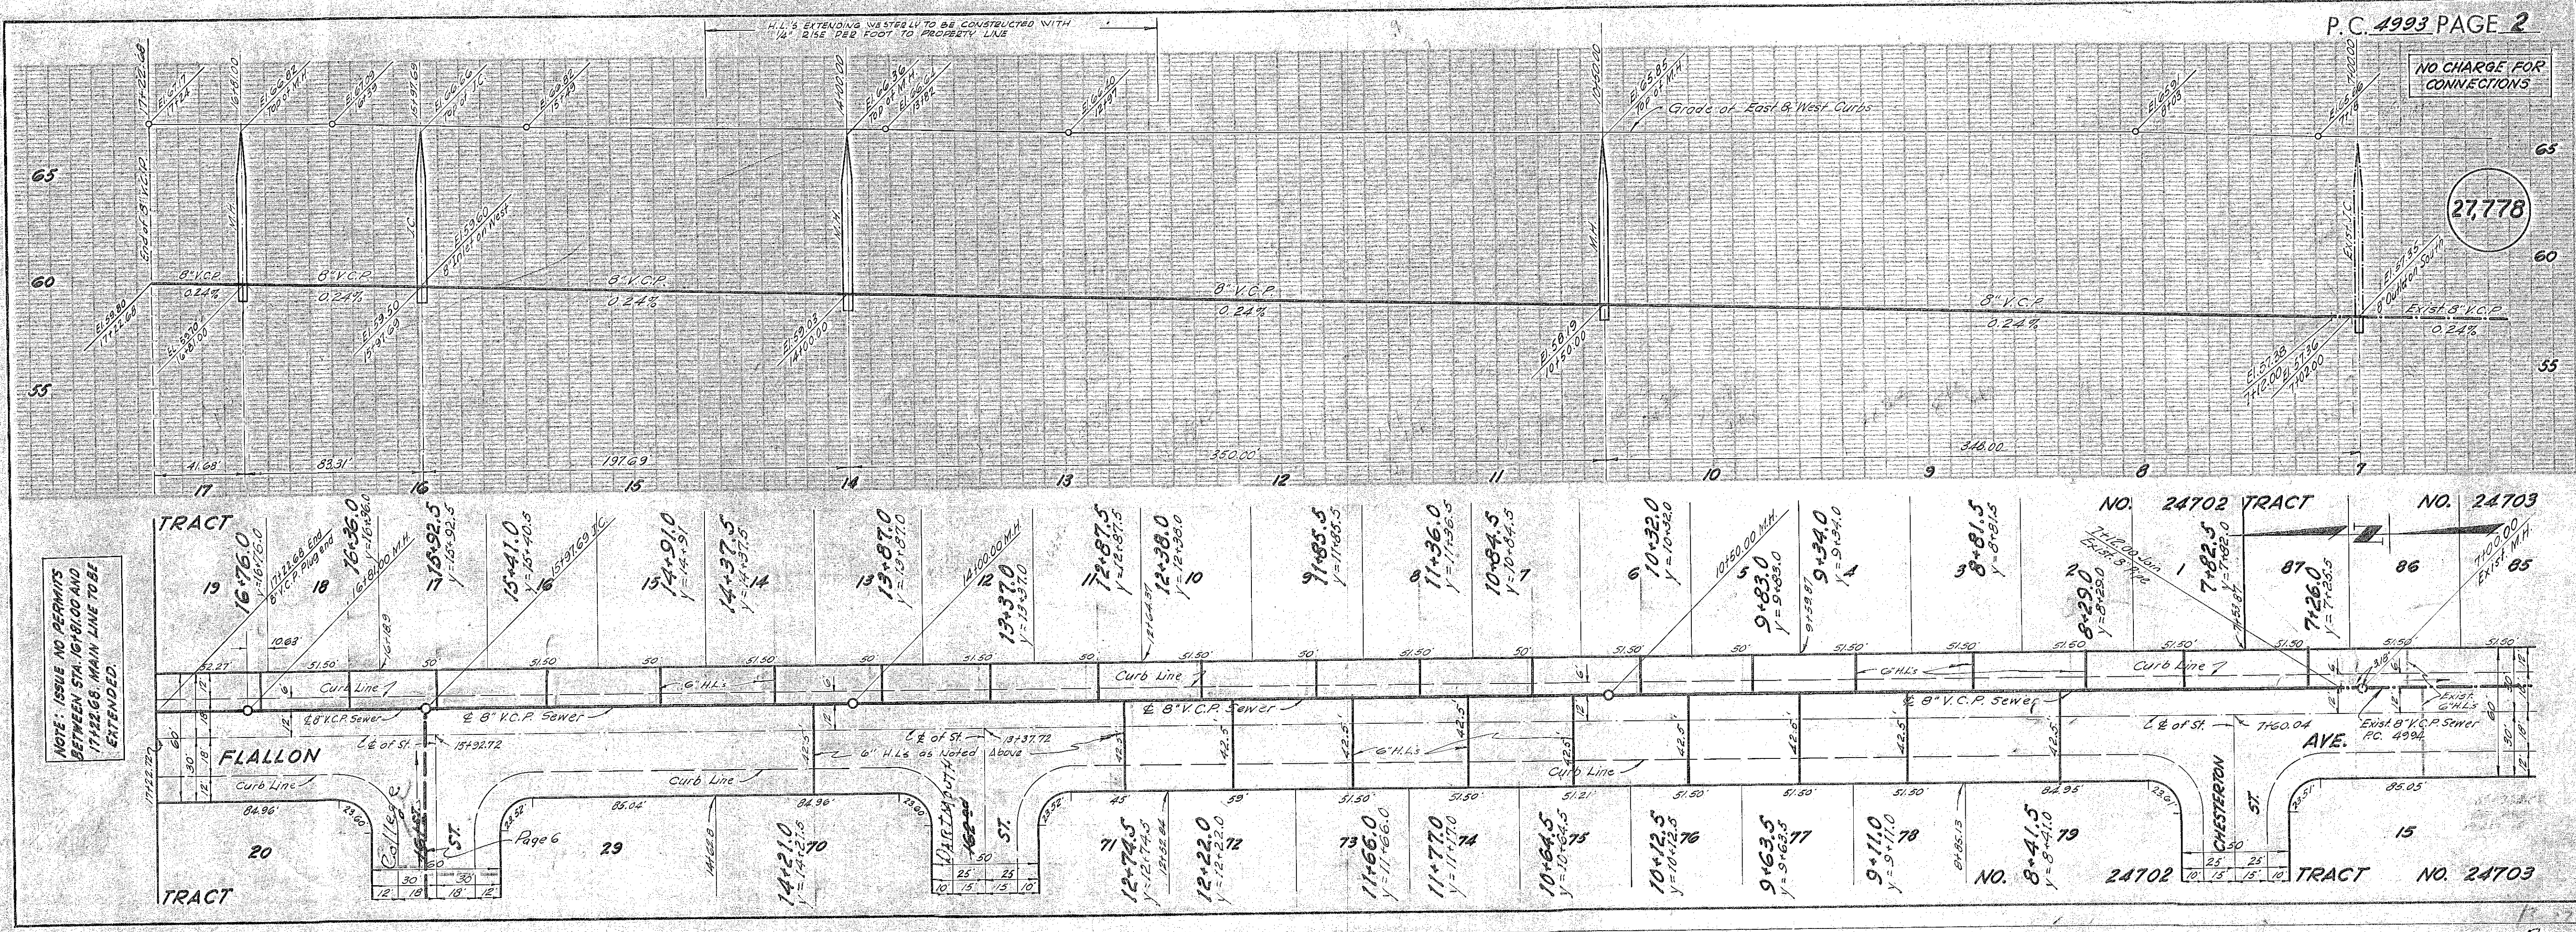

NOTE: ISSUE NO PERMITS BETWEEN STA. 16+81.00 AND 17+22.68. MAIN LINE TO BE EXTENDED.




NO CHARGE FOR CONNECTIONS

27,778

P.C. 4993 PAGE 2



NO CHARGE FOR CONNECTIONS


27,781

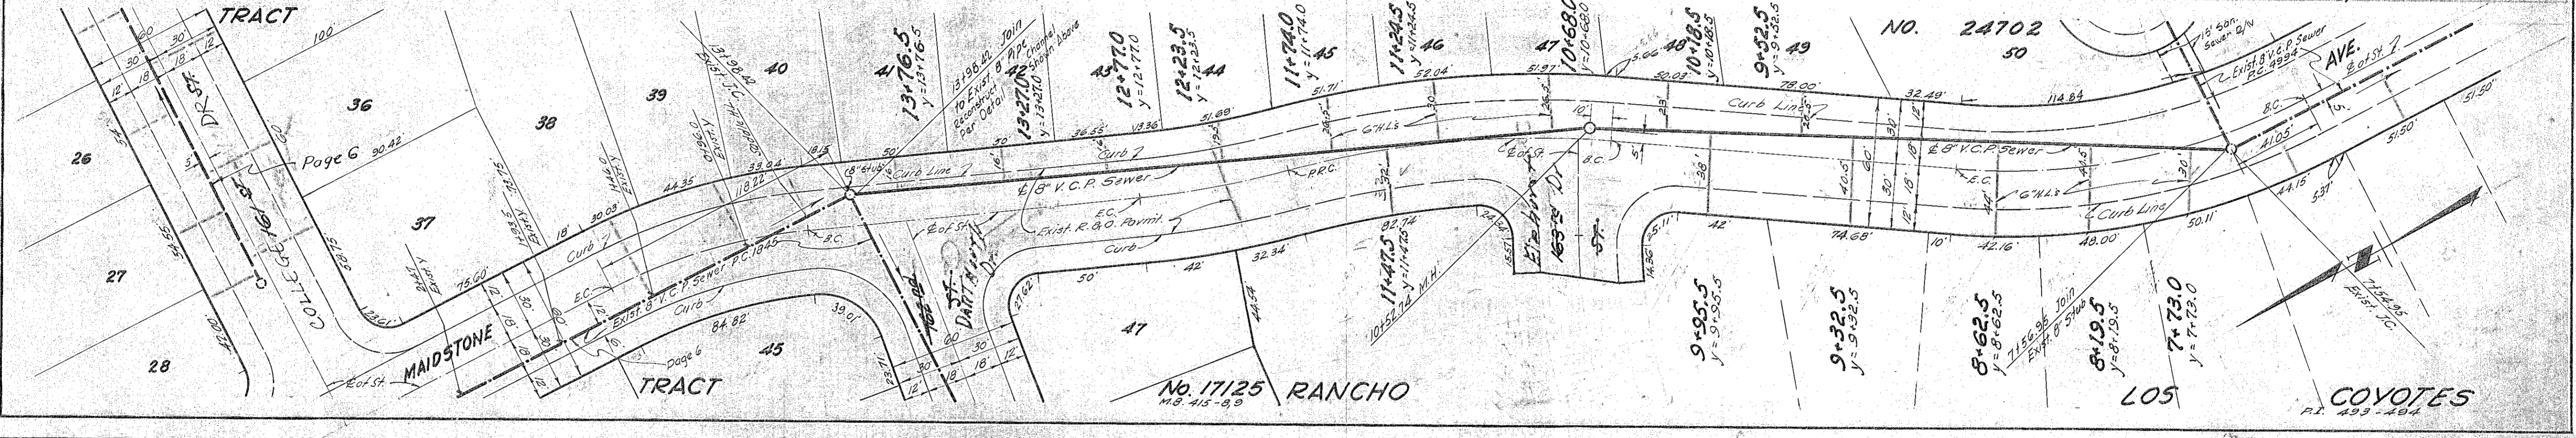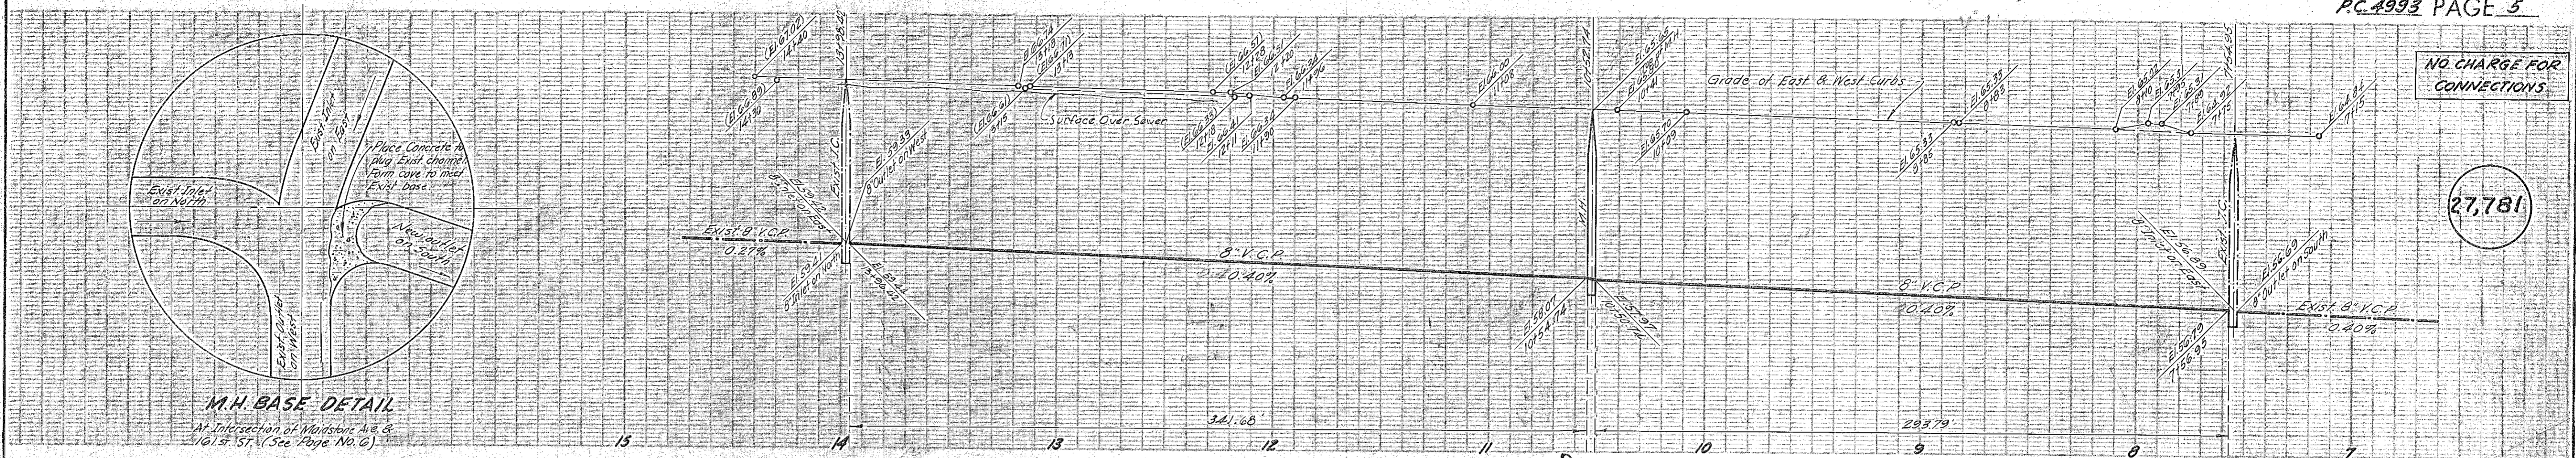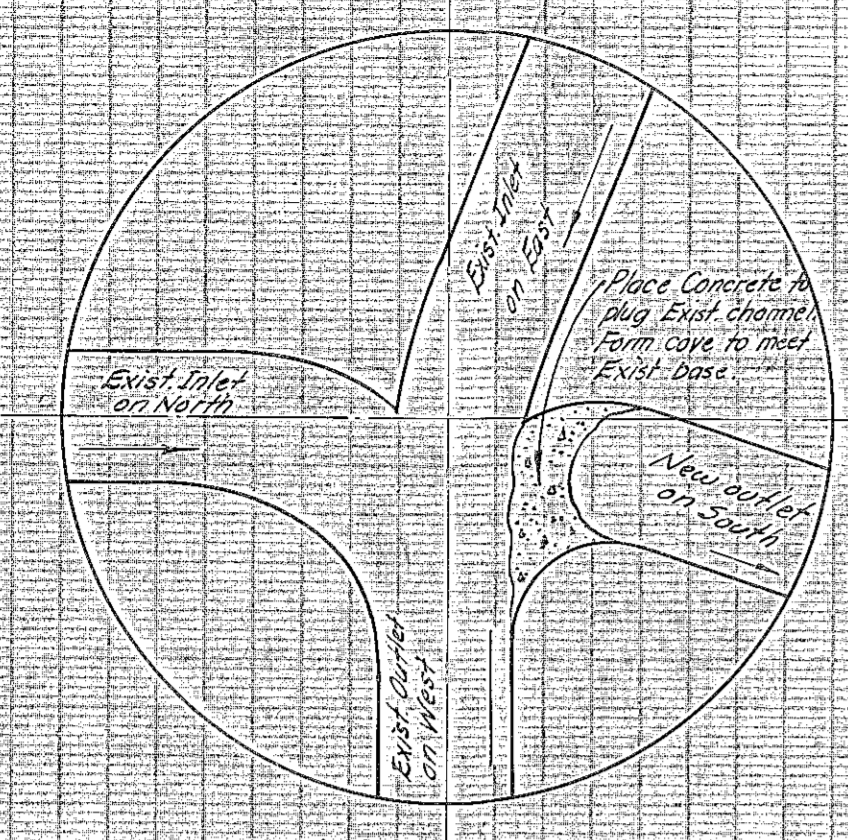

NO CHARGE FOR CONNECTIONS



27,782

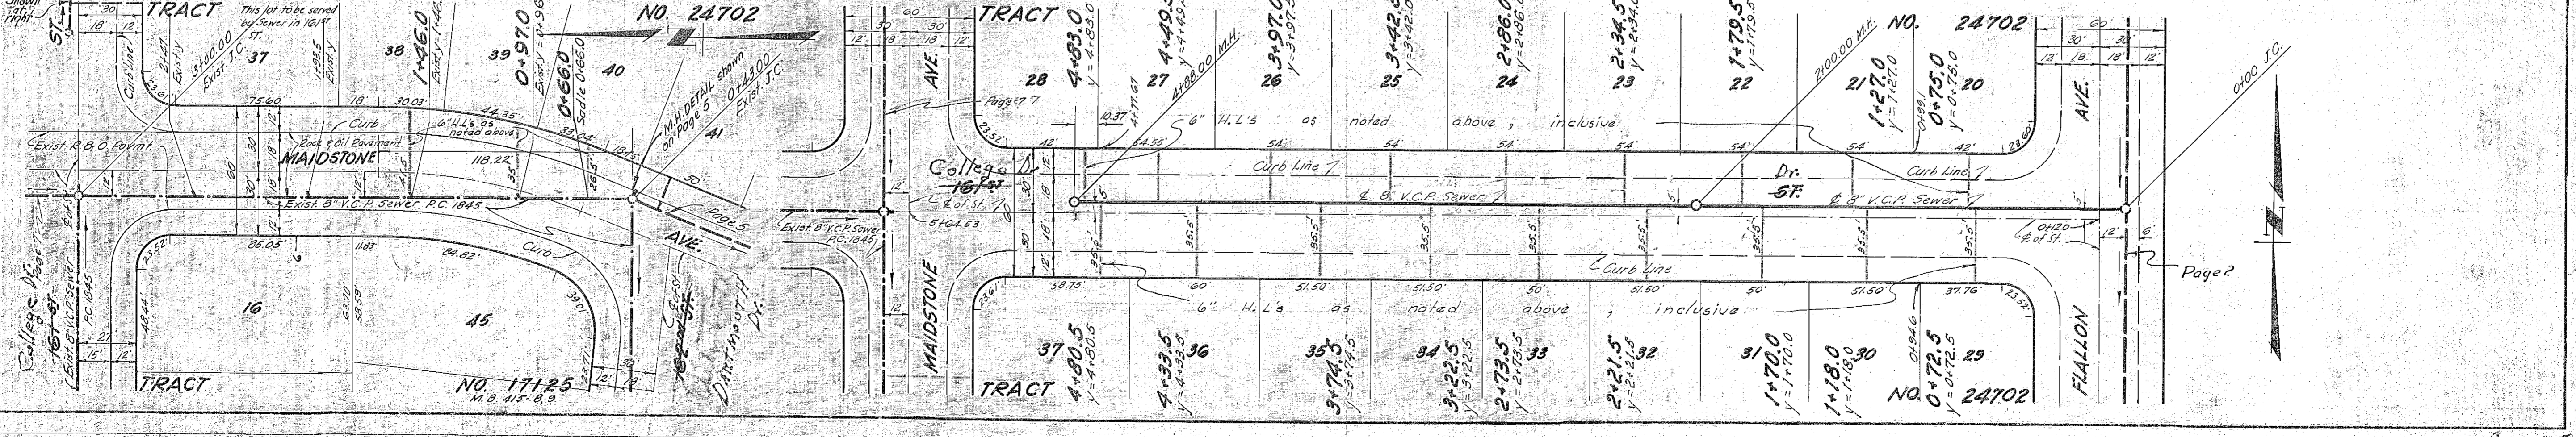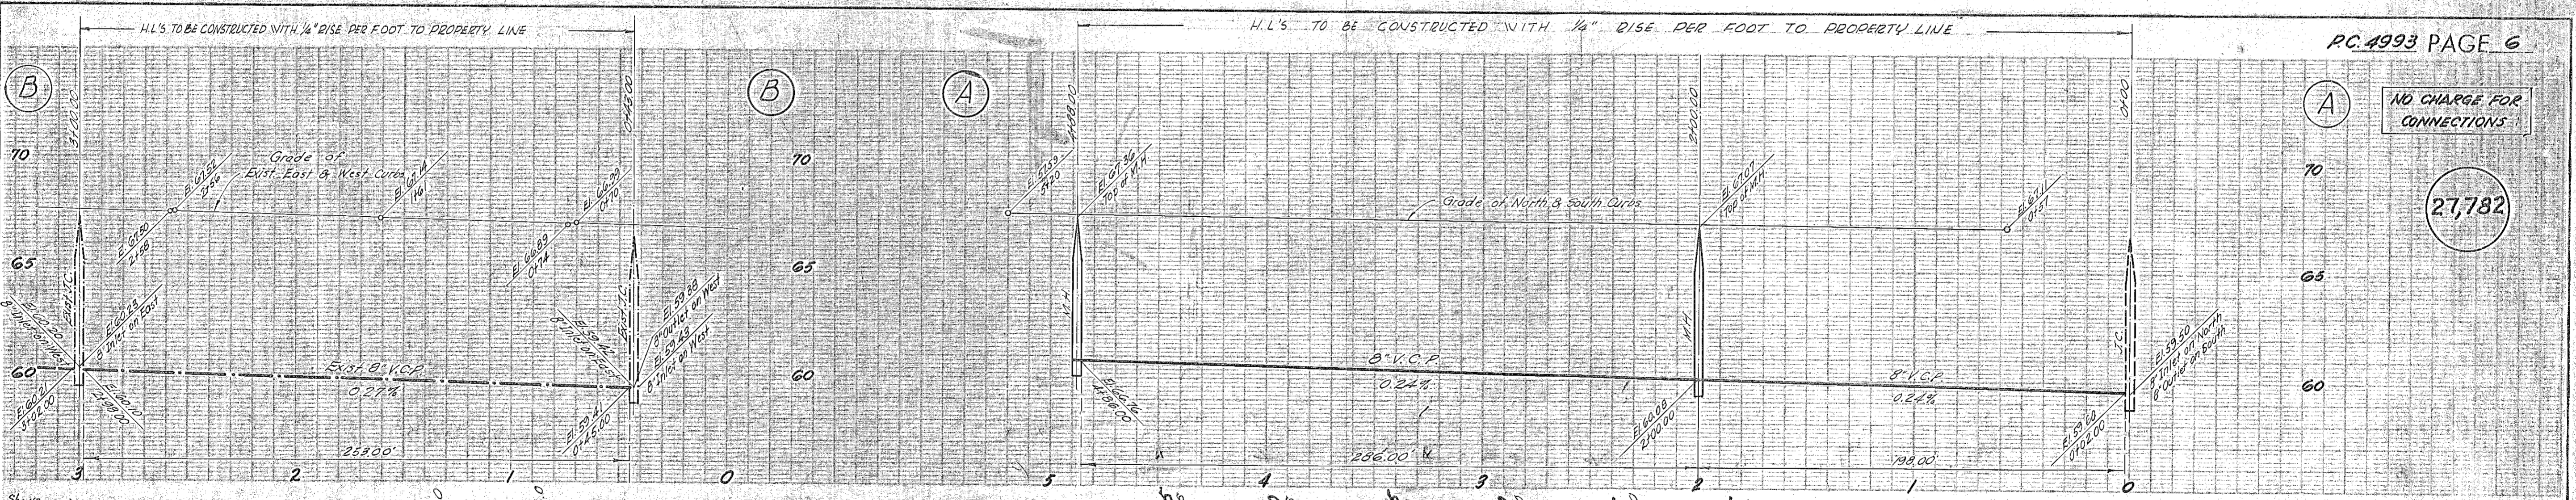

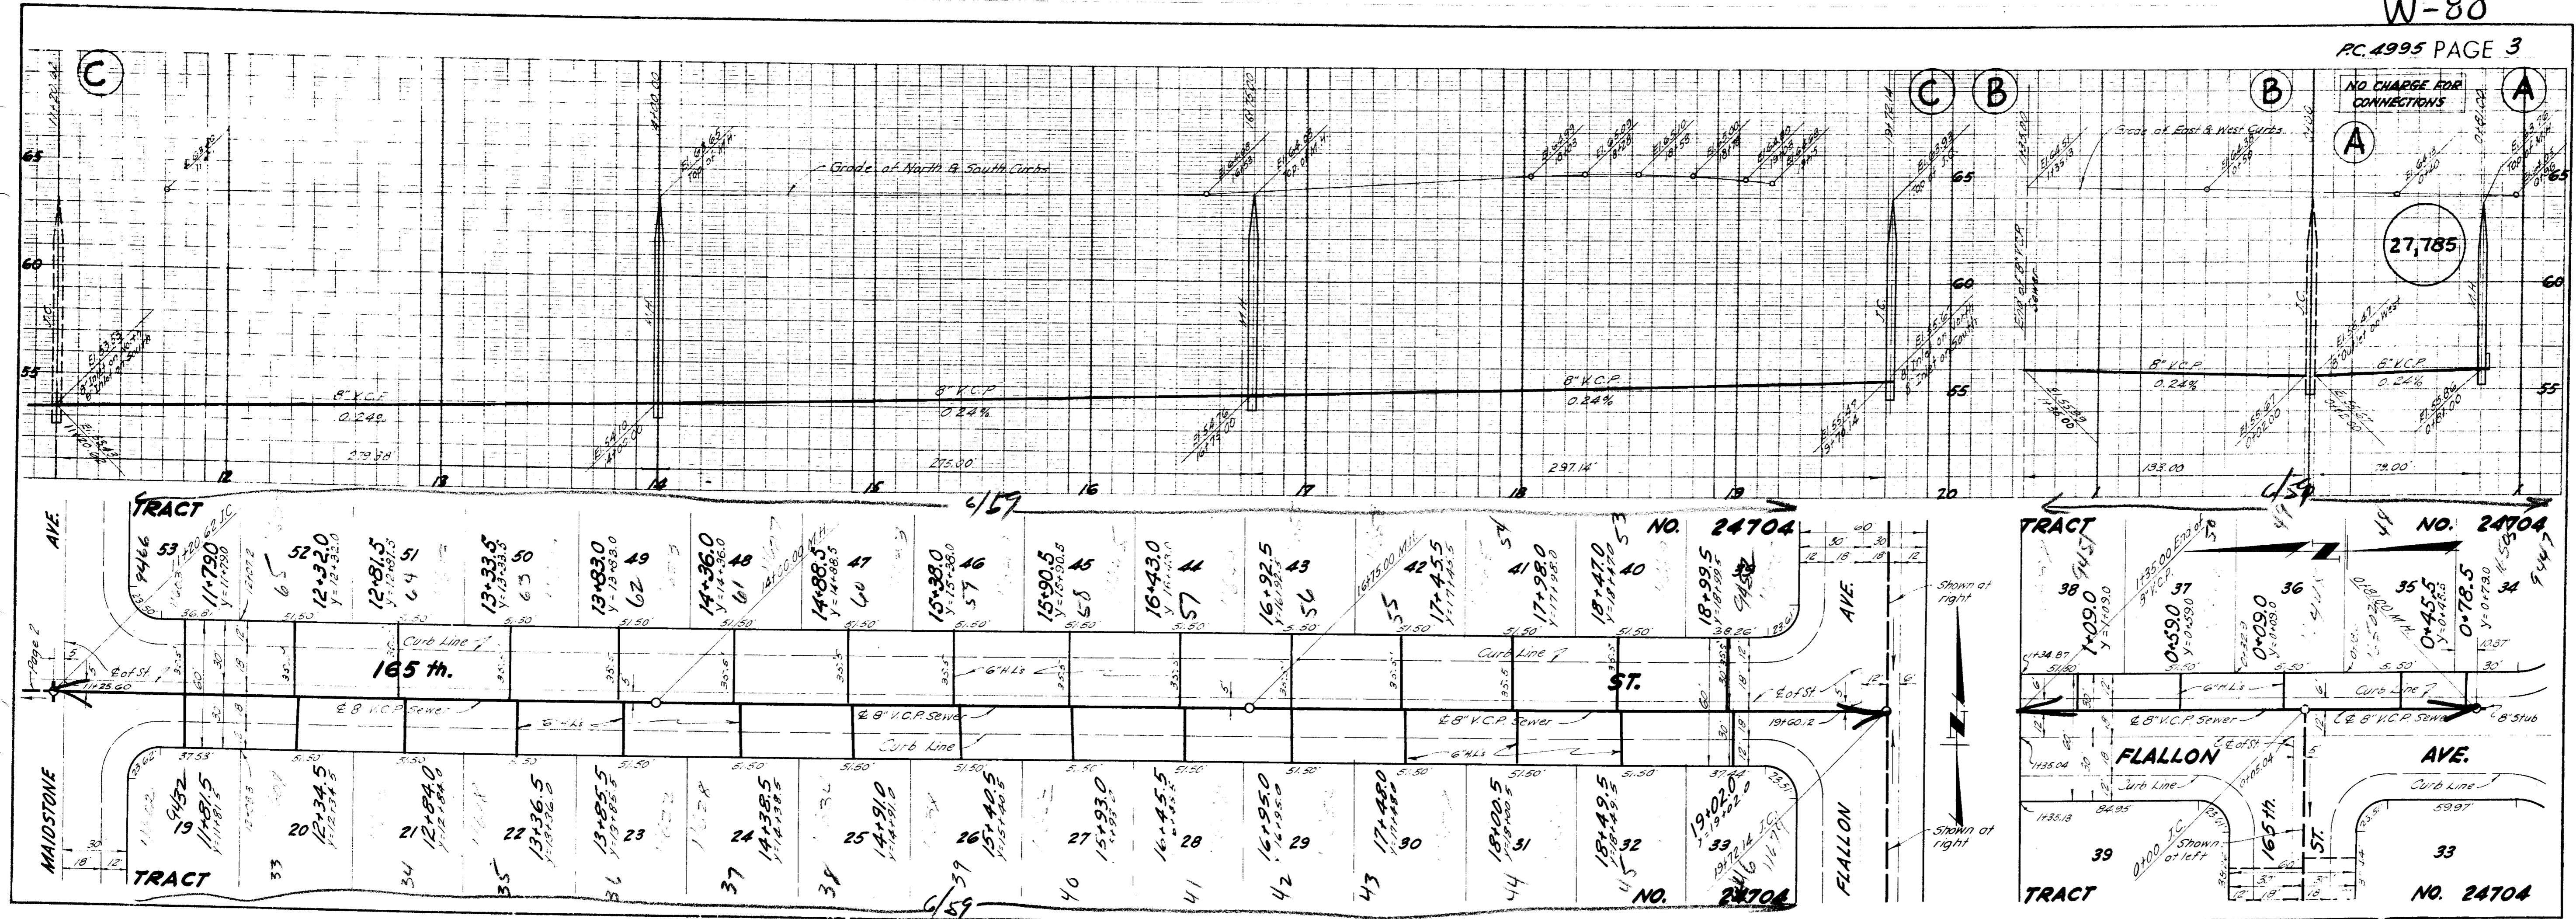



NO CHARGE FOR CONNECTIONS

21790

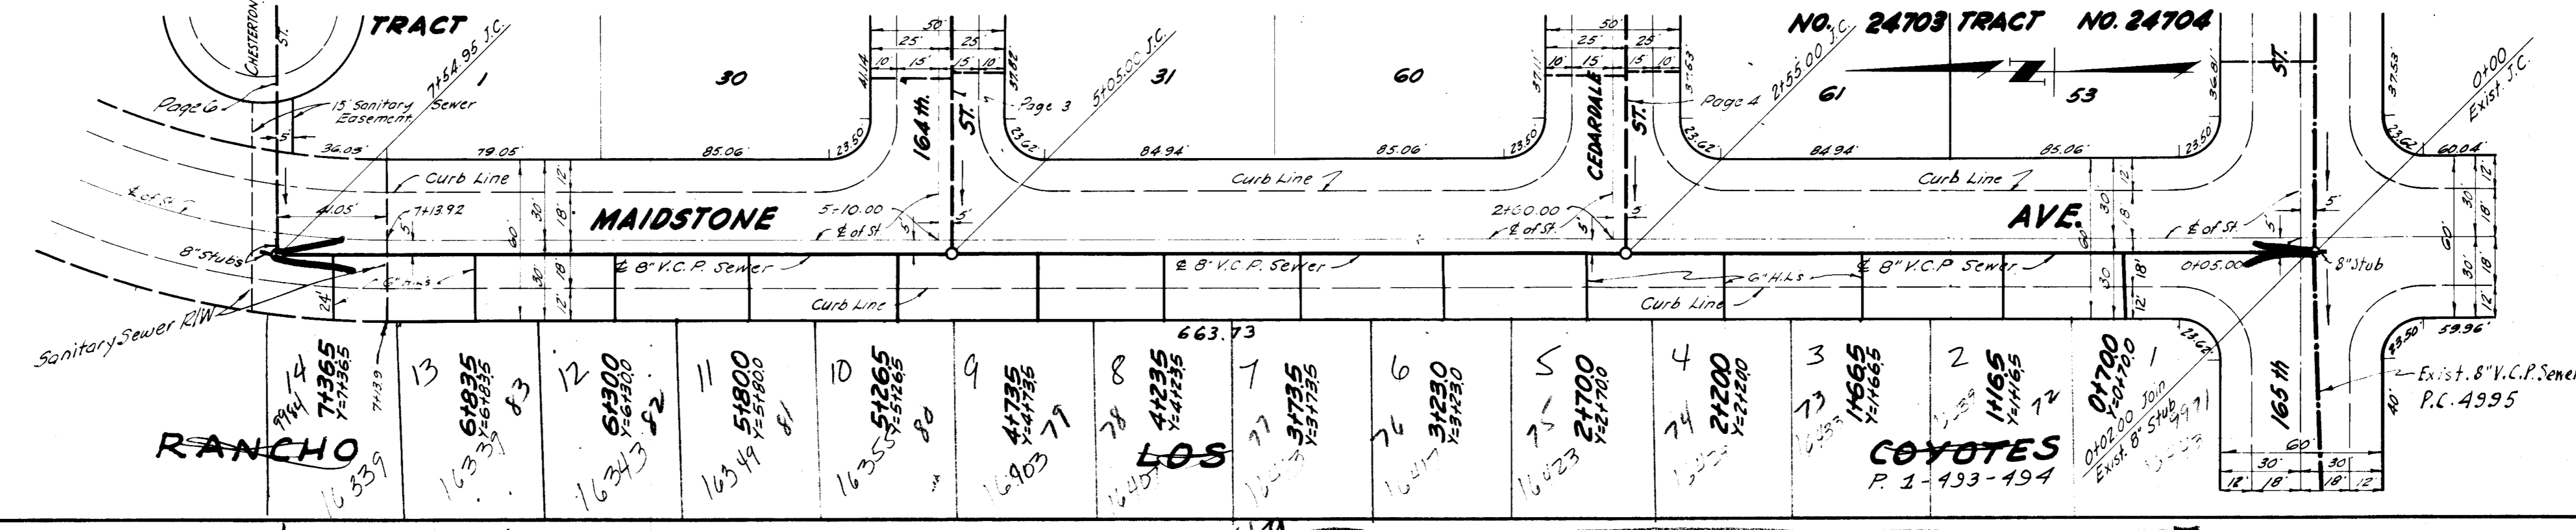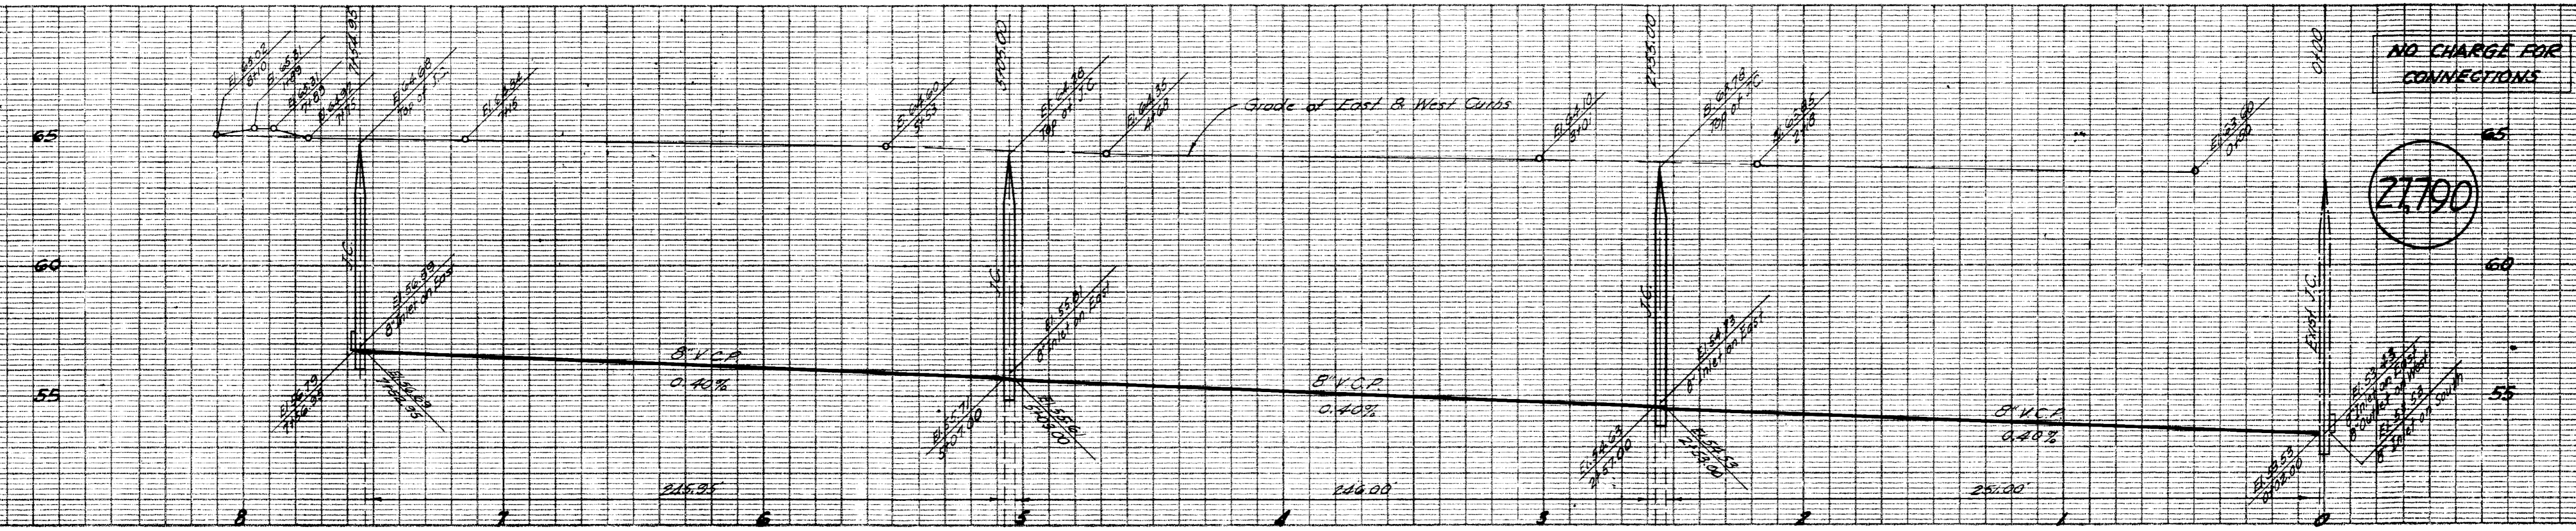

EXTRA STRENGTH PIPE IN MAIN LINE AND HOUSE LATERALS

NO CHARGE FOR CONNECTIONS

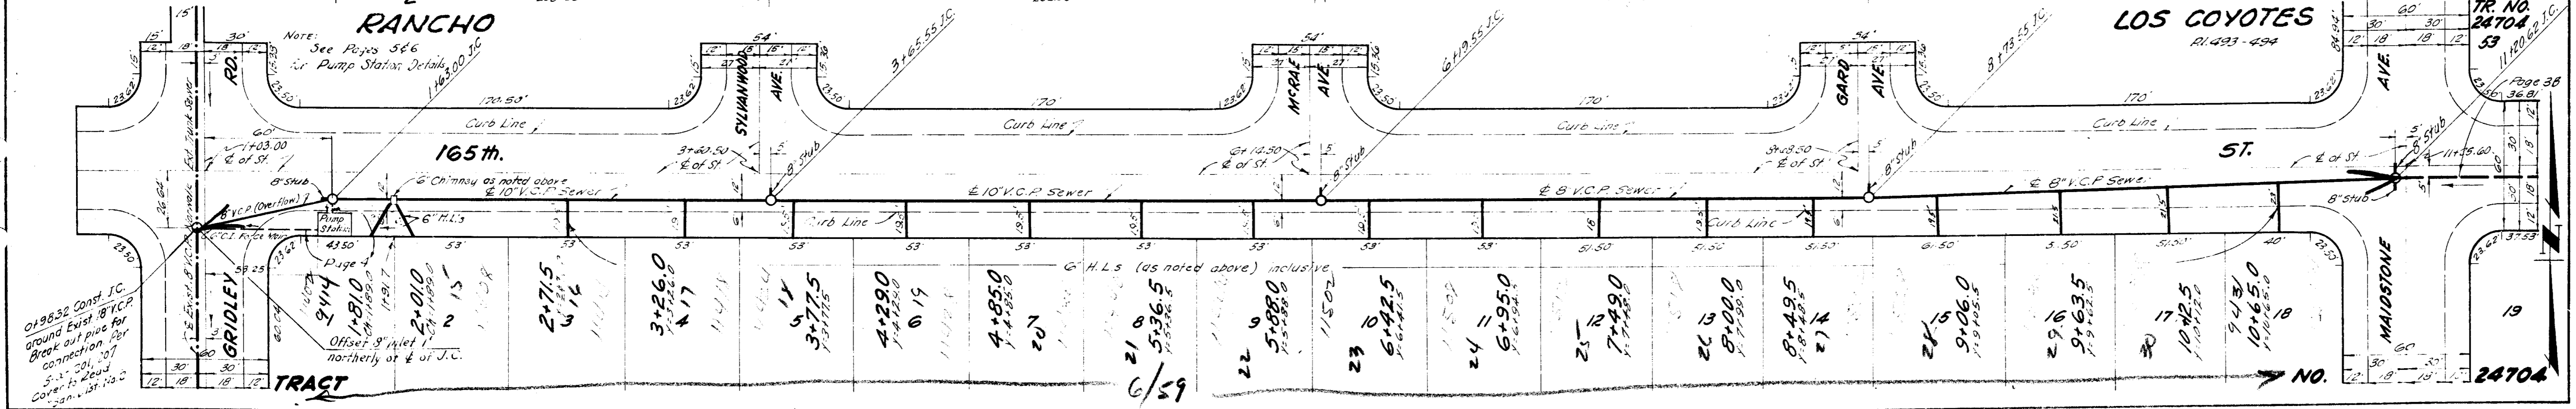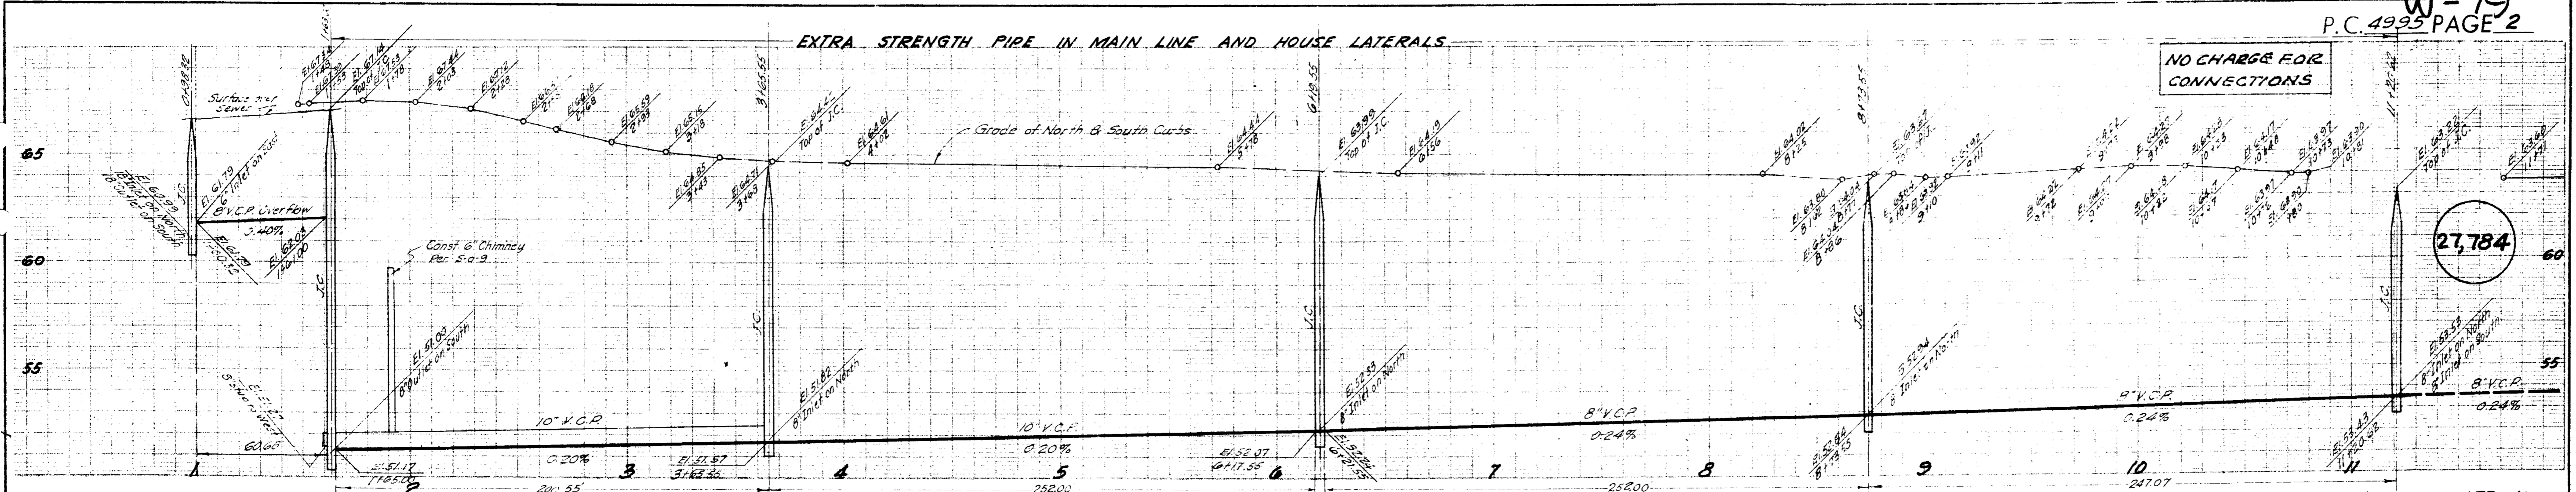

019832 Const. J.C.
around Exist. 18\"/>

NOTE:
See Pages 586
for Pump Station Details

Offset 8\"/>

G.H.L.s (as noted above) inclusive

TRACT

NO.

TR. NO.
24704
53

Page 38
36.81

3551